


SEC 32, 29 & 30 T27N R 5E WM

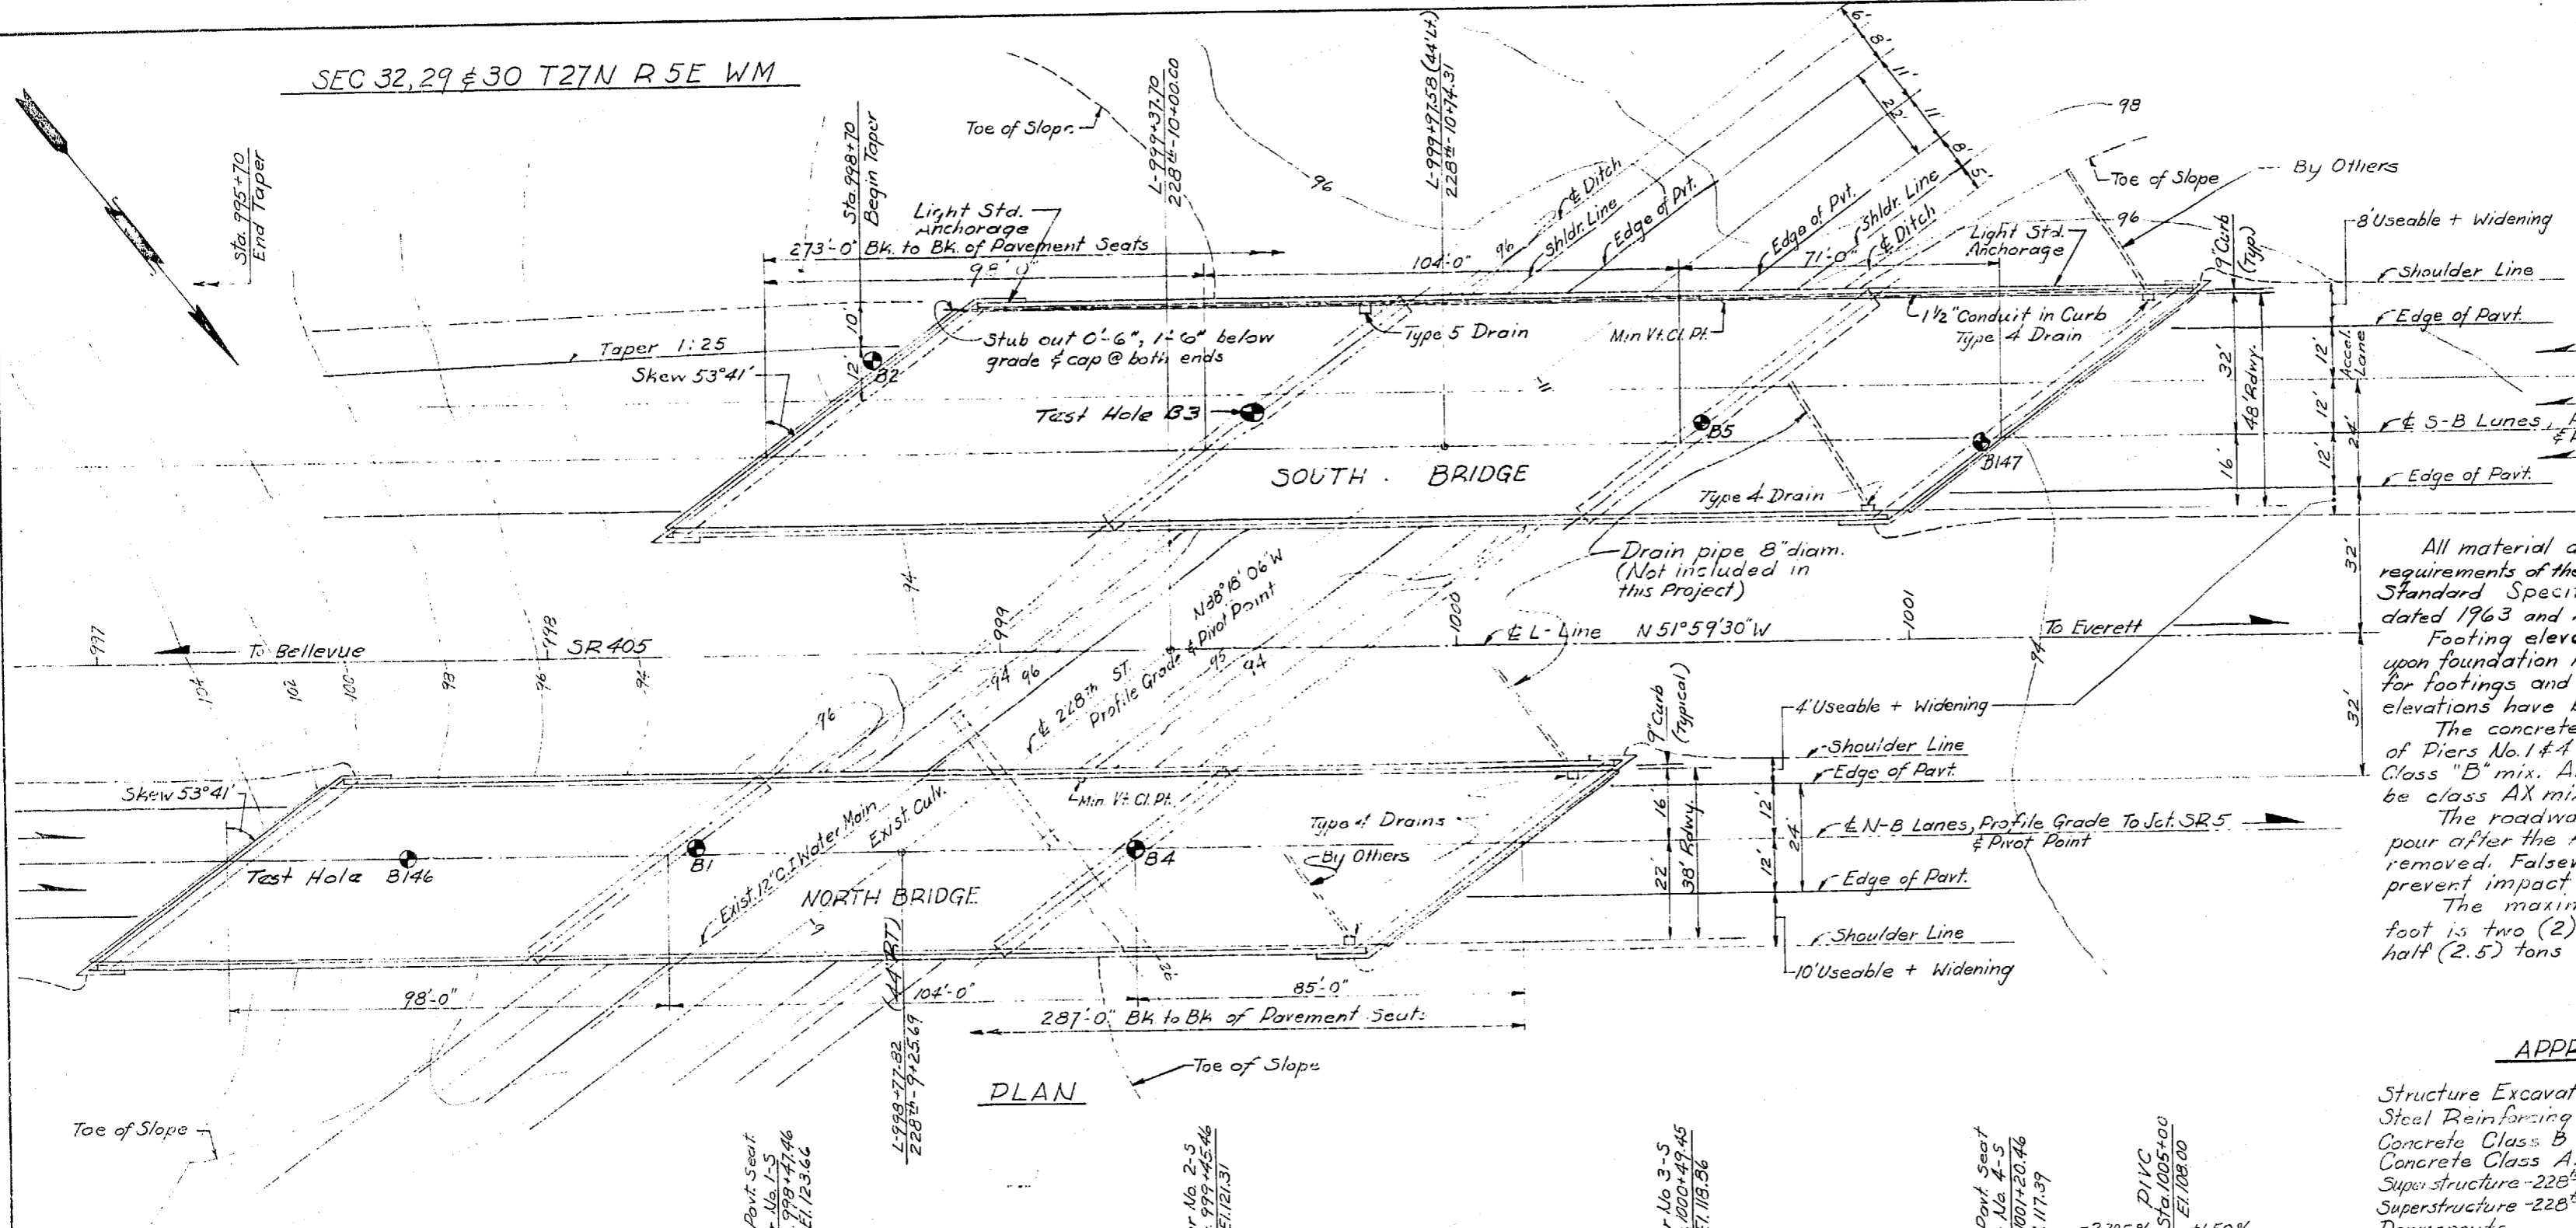

**GENERAL NOTES**

All material and work shall be in accordance with requirements of the State of Washington, Dept. of Highways, Standard Specifications for Road & Bridge Construction, dated 1963 and Amendment No. 1, dated Jan. 1966.

Footings elevations are subject to change depending upon foundation material encountered. Reinforcing steel for footings and columns shall not be cut until final footing elevations have been determined in the field.

The concrete in the footings of all piers and the walls of Piers No. 1 & 4 except as shown in the plans shall be Class "B" mix. All other poured in place concrete shall be class AX mix.

The roadway slab shall be placed in one continuous pour after the falsework for piers No. 2 & 3 has been removed. Falsework shall be carefully released to prevent impact or undue stress in the structure.


The maximum design soil pressure per square foot is two (2) tons for piers No. 1 & 4 and two and one half (2.5) tons for piers No. 2 & 3.

**APPROXIMATE QUANTITIES**

Item	Quantity	Unit
Structure Excavation	900	Cu. Yds.
Steel Reinforcing Bars	50,000	Pounds
Concrete Class B	221	Cu. Yds.
Concrete Class AX	106	Cu. Yds.
Superstructure - 228" St. O'Xing - North Bridge	Lump Sum	
Superstructure - 228" St. O'Xing - South Bridge	Lump Sum	
Downspouts	30	Lin. Ft.
Water Reducing Additive	410	Dollars

LOADING: HS-20  
OR  
TWO-24' AXLES @ 4' CTRS.

Note:  
Grade elevations shown are finish grades on E-B & W-B Lanes and are equal to profile grade.

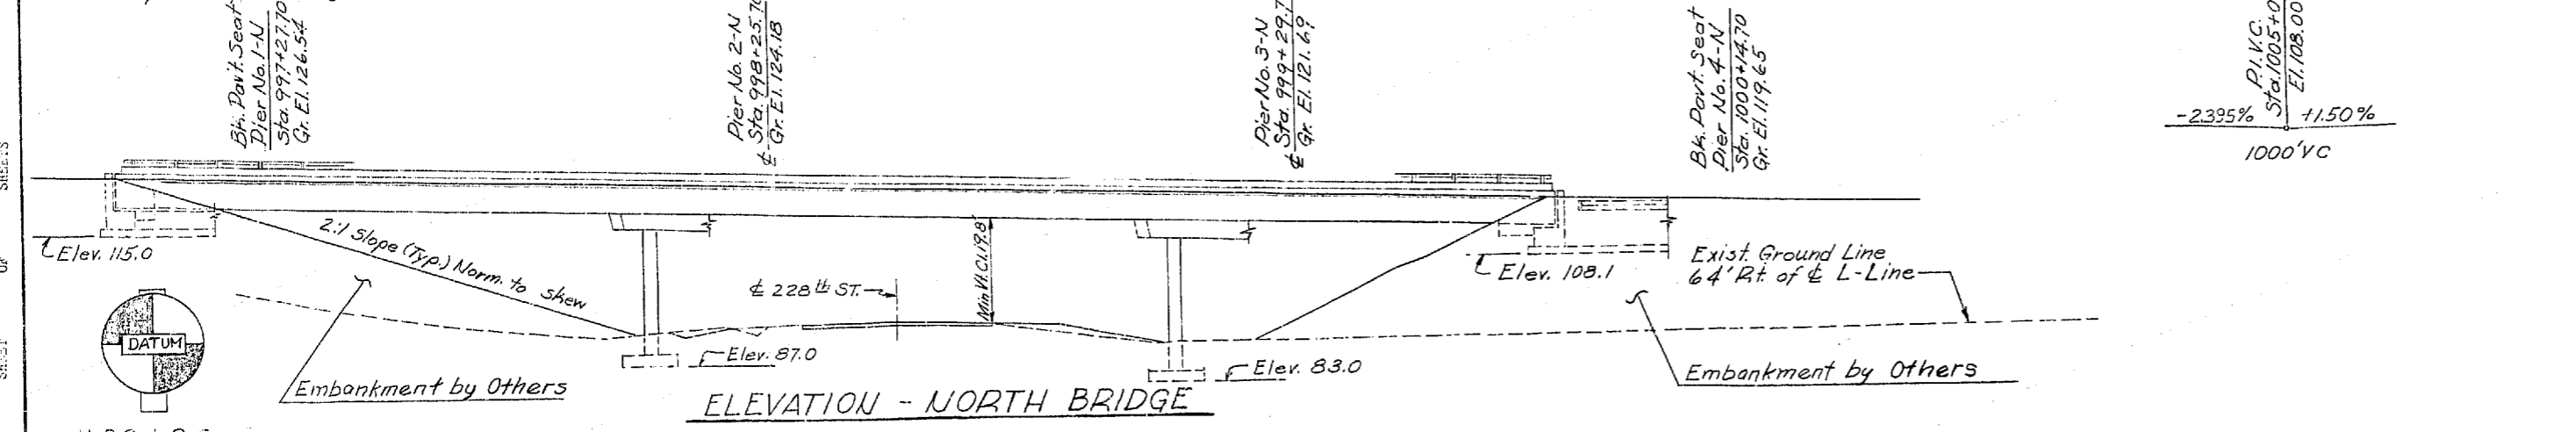




SR 405  
MP 24.28 TO MP 26.37  
NORTH CR. BR. AND 228TH ST. O'XING  
KING & SNOHOMISH COUNTIES  
228TH ST. OVERCROSSING

LAYOUT

WASHINGTON STATE HIGHWAY COMMISSION  
DEPARTMENT OF HIGHWAYS  
OLYMPIA, WASHINGTON


APPROVED Nov. 22, 1967  
SHEET 10 OF 26 SHEETS  
CONTRACT NUMBER 8376



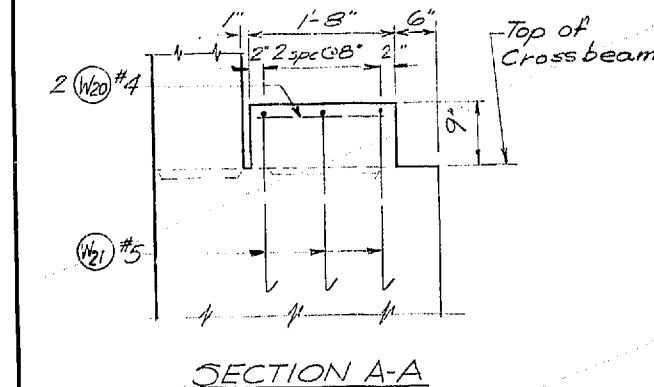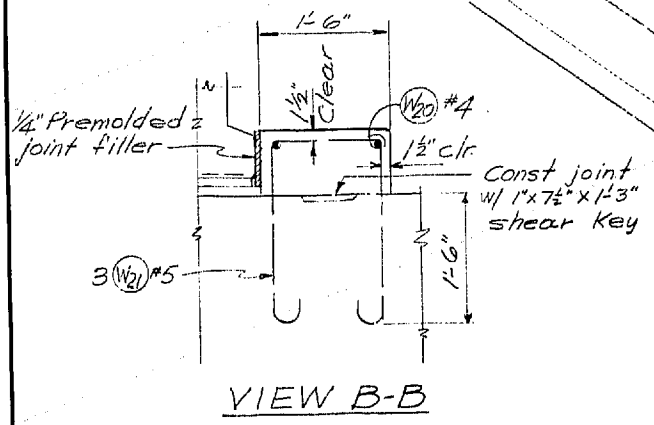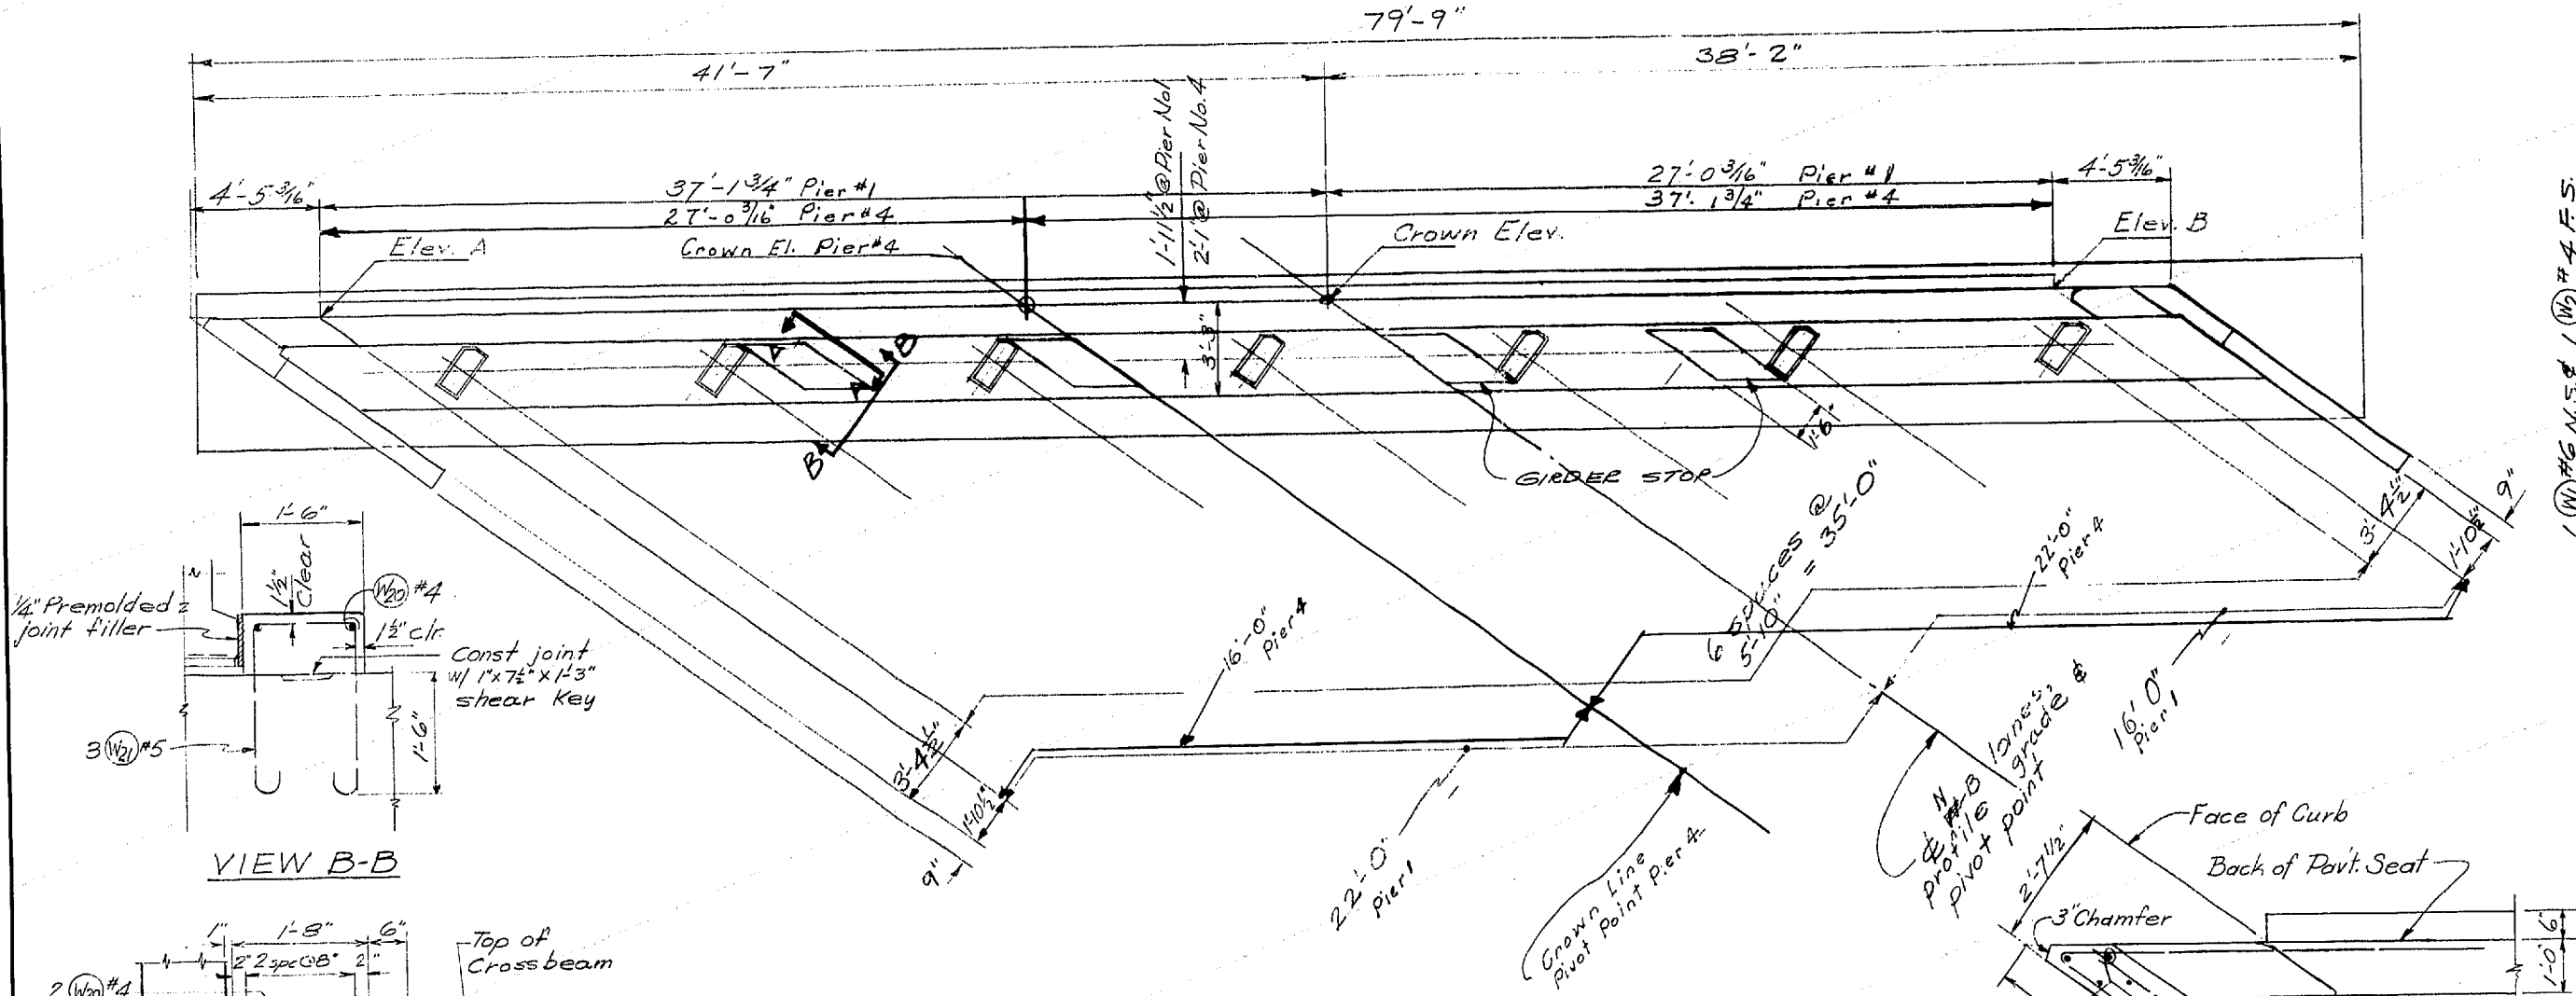


**PLAN OF PIER NO. 1**


Pier No. 4 opposite hand  
 At back of pavement seat & N-B lanes, profile grade & pivot point

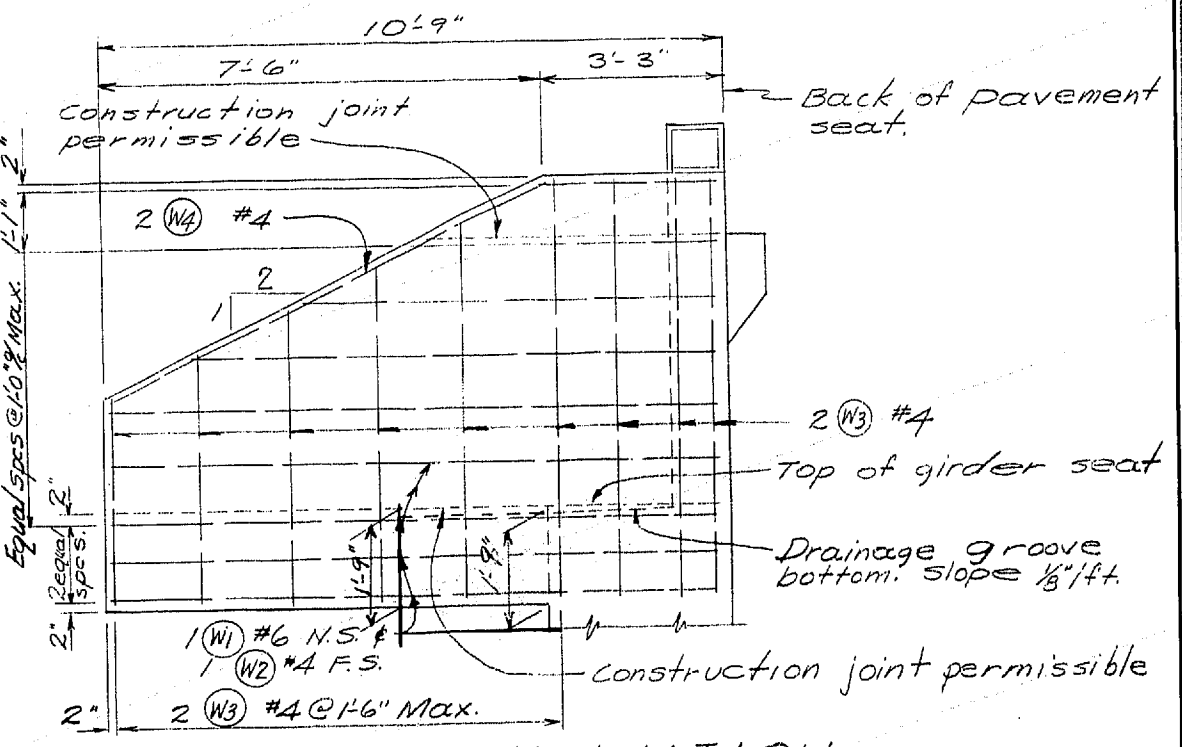

**WING WALL ELEVATION**

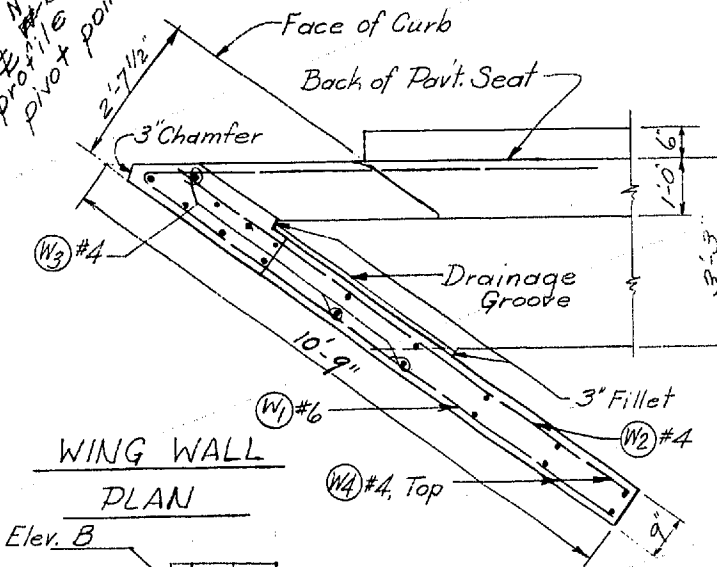


**WING WALL PLAN**

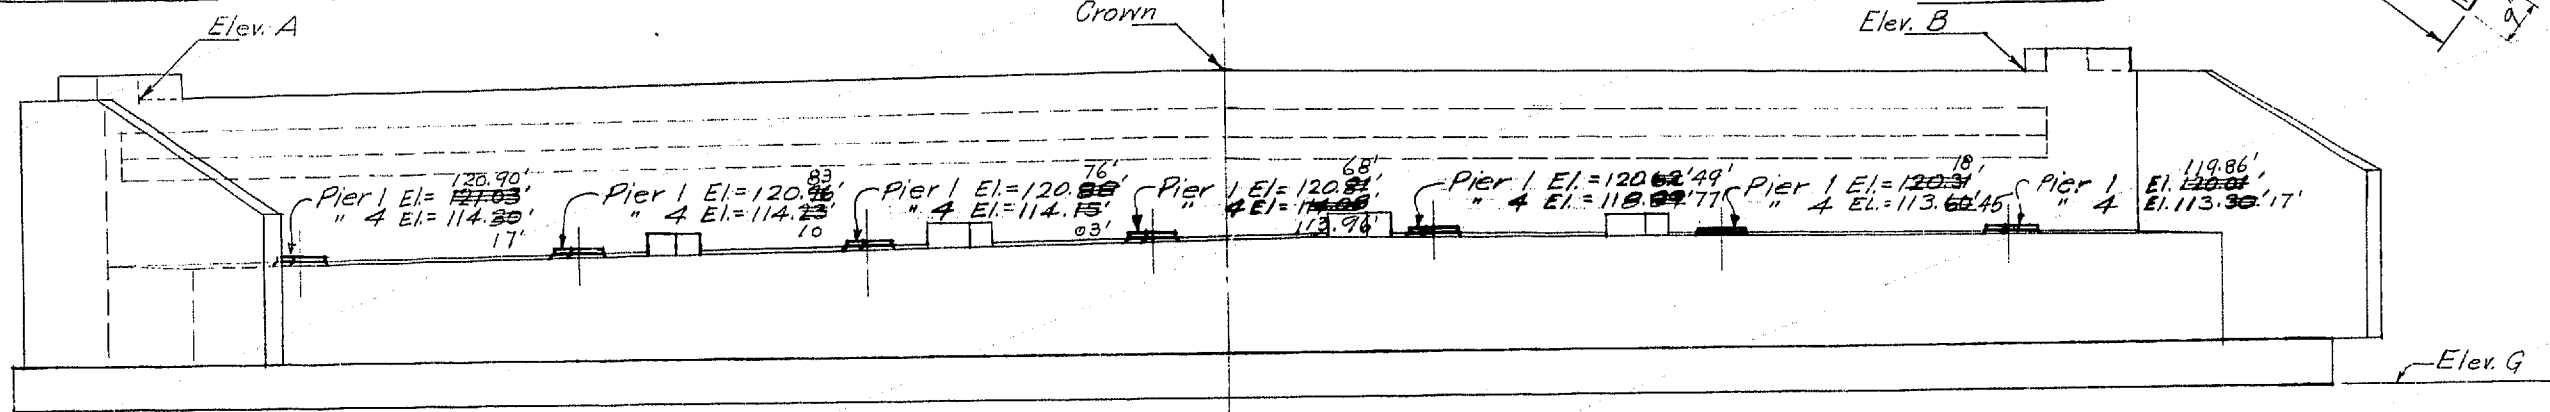

**ELEVATION OF PIERS NO. 1 & 4**

Location	At back of Pav't. Seat			Footing Elevation G
	Elev. A	Crown	Elev. B	
Pier No. 1	126.82'	126.54'	125.76'	115.00'
Pier No. 4	119.93'	119.65'	118.83'	108.10'

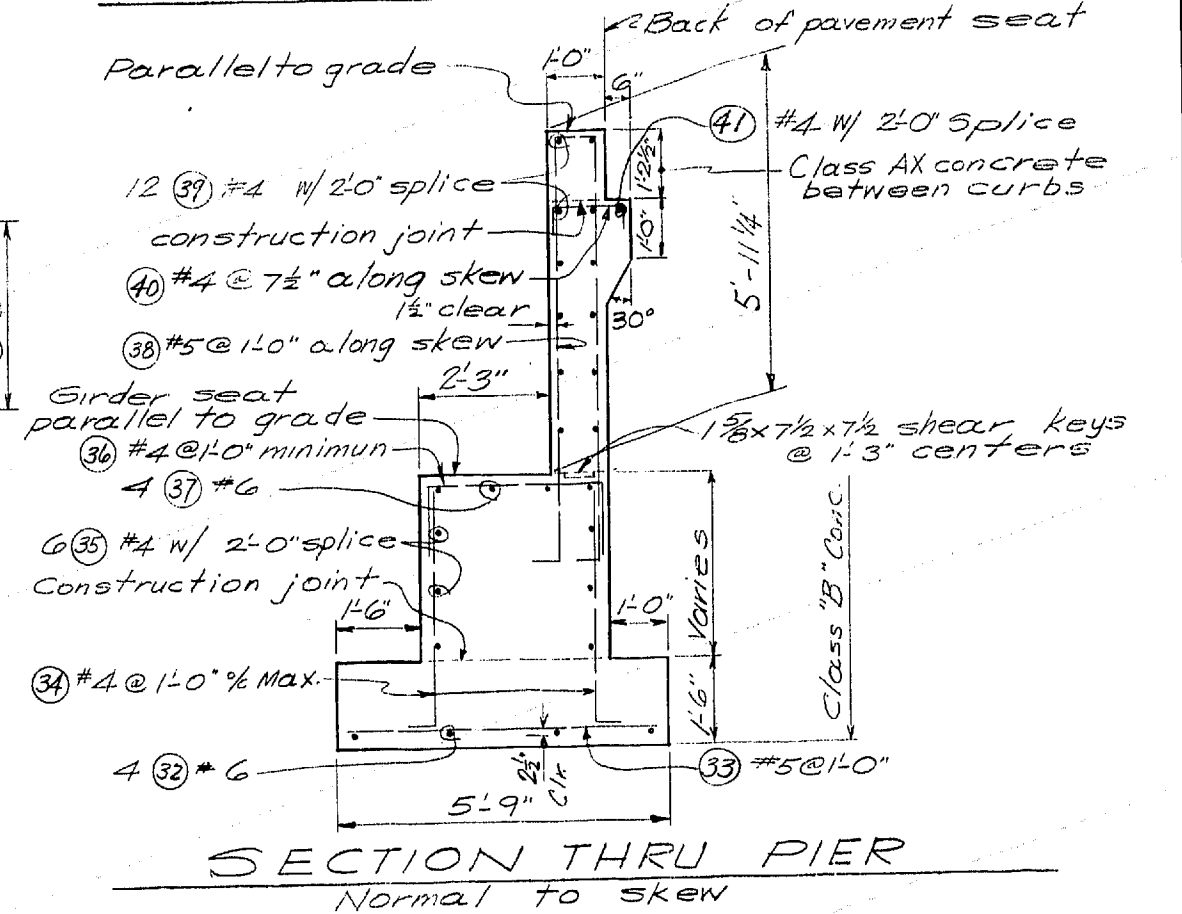

**SECTION THRU PIER**  
Normal to skew

SR 405  
 MP 24.28 TO MP 26.37  
 NORTH CR. BR. AND 228TH ST. O'XING  
 KING & SNOHOMISH COUNTIES  
 228TH ST. OVERCROSSING  
 PIERS 1 & 4 - NO. BR.

WASHINGTON STATE HIGHWAY COMMISSION  
 DEPARTMENT OF HIGHWAYS  
 OLYMPIA, WASHINGTON

GEOFF D. ZIMM, CHAIRMAN  
 E. I. MIKALSON  
 K. WALSH  
 ZAKER FERDUSON  
 JOHN H. RUFF

APPROVED: Nov. 22, 1967  
 CONT. No. 8376  
 SHEET 11 of 26 SHEETS




As Built Changes in Red 1-21-70

P/1992

6/34

SHEETS  
 1-1976 C.S. 17523 & 31110  
 KING & SNOHOMISH COUNTIES  
 4' SPACING TO DANGER ROAD




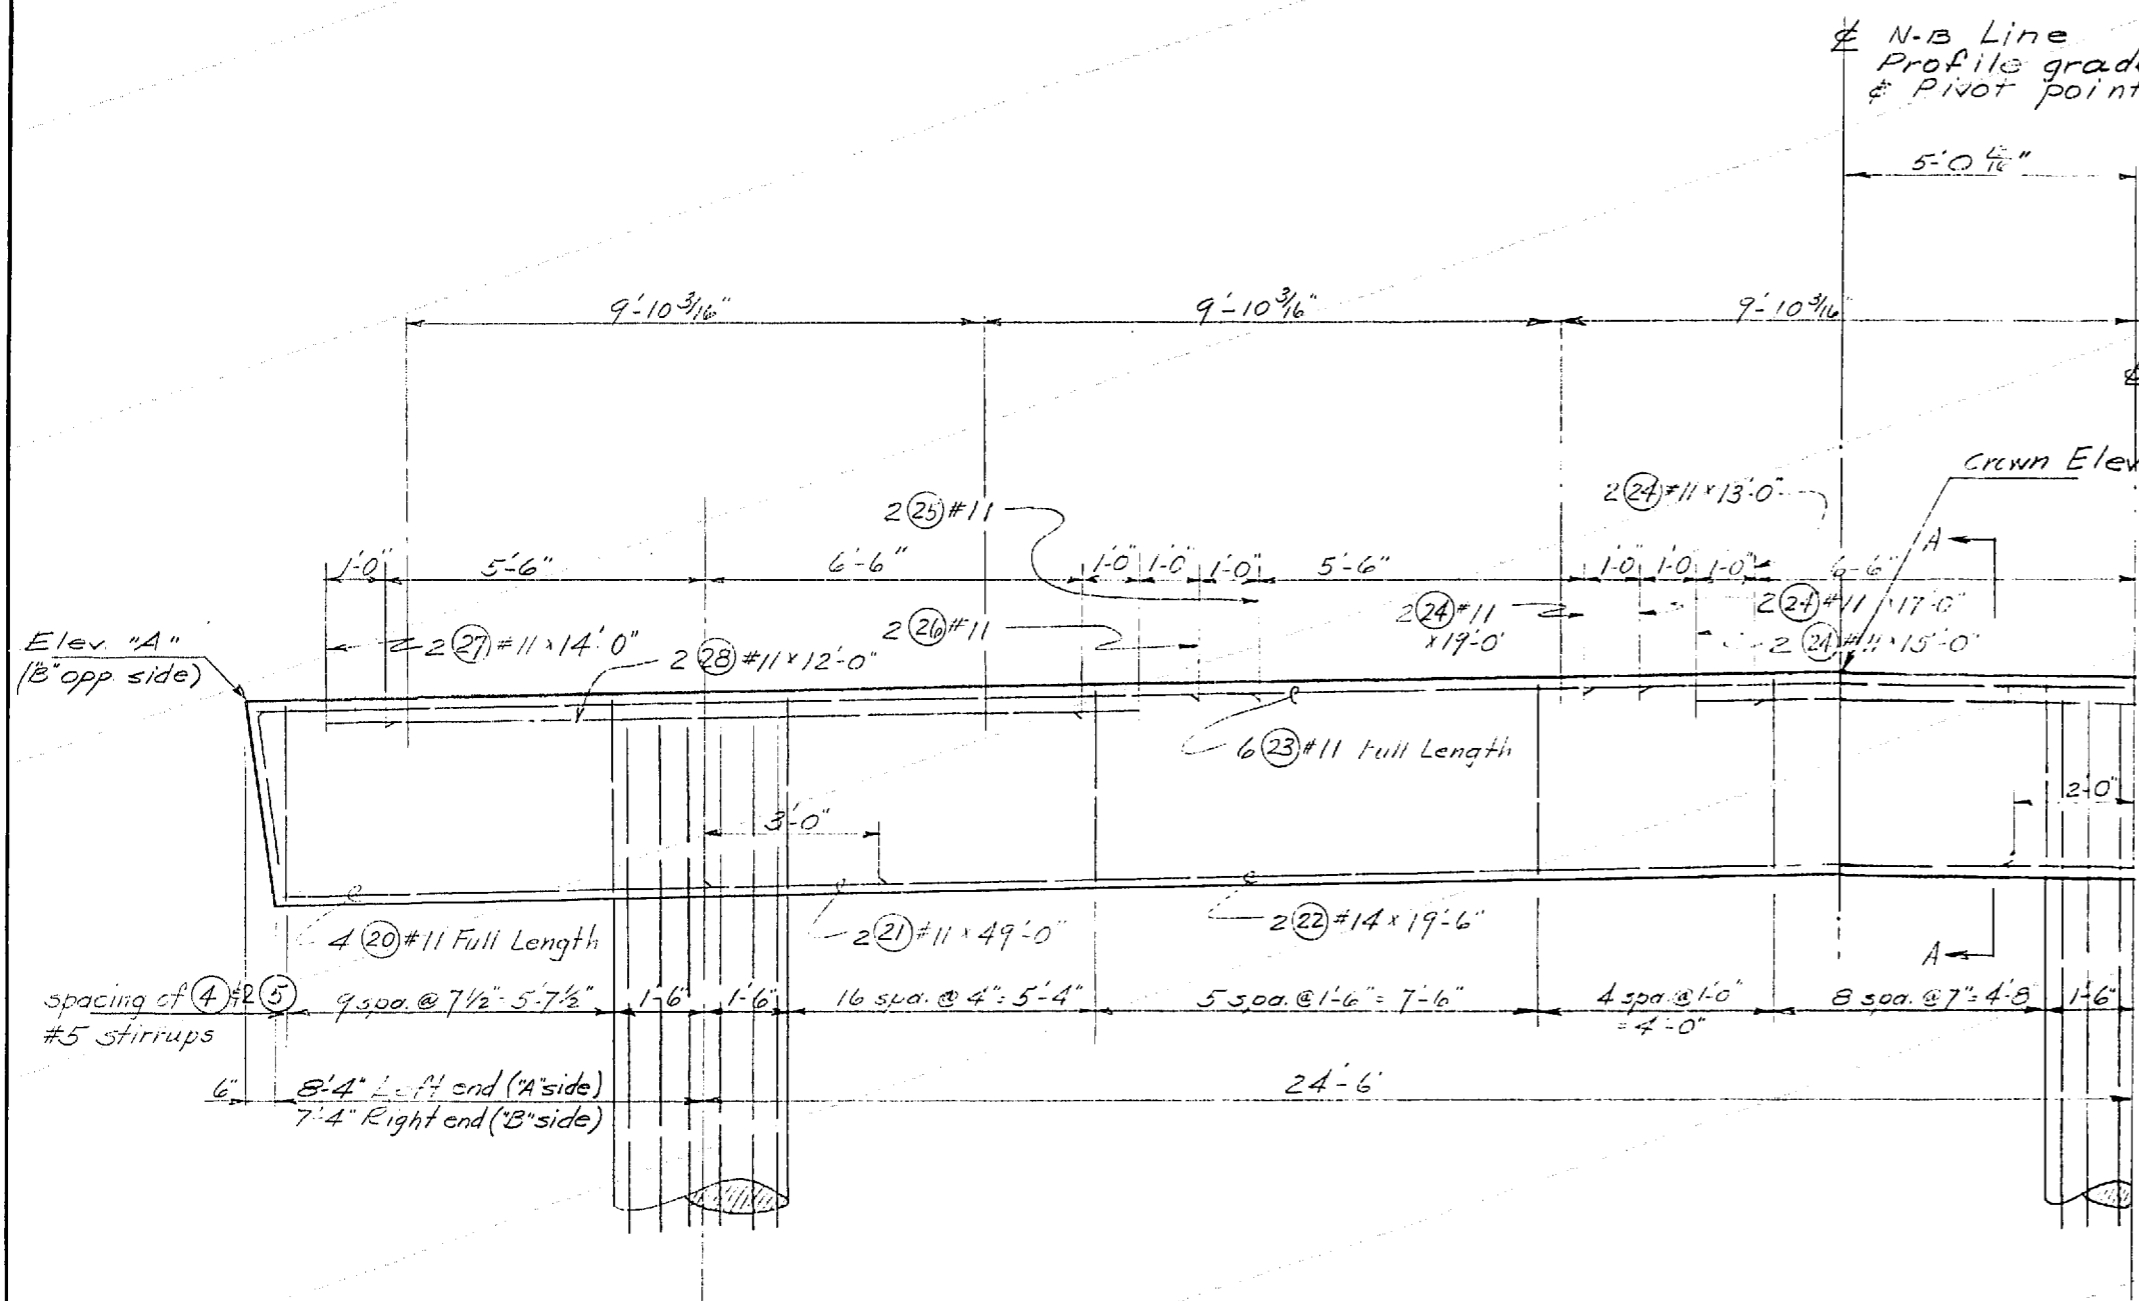


**HALF ELEVATION  
PIER NO. 3**

See detail of columns and footings on Pier No. 2.

X-BEAM ELEVATIONS				
Dier	Location	Elev. A'	Crown	Elev. 'B'
No. 3-N	at Pier	114.74'	115.63'	115.90'

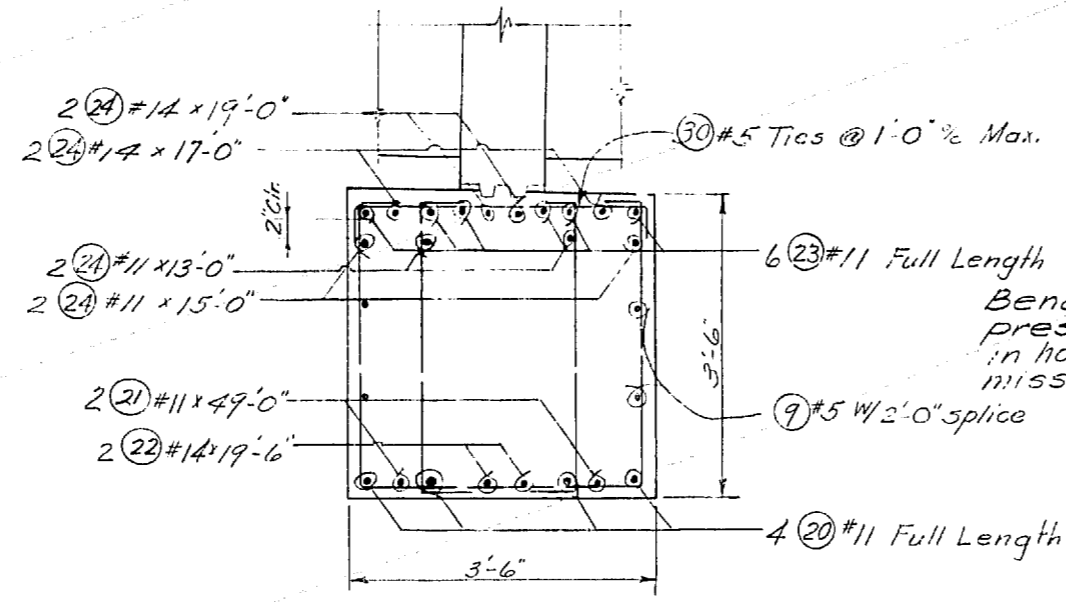


**SECTION A-A**  
Shown normal to skew

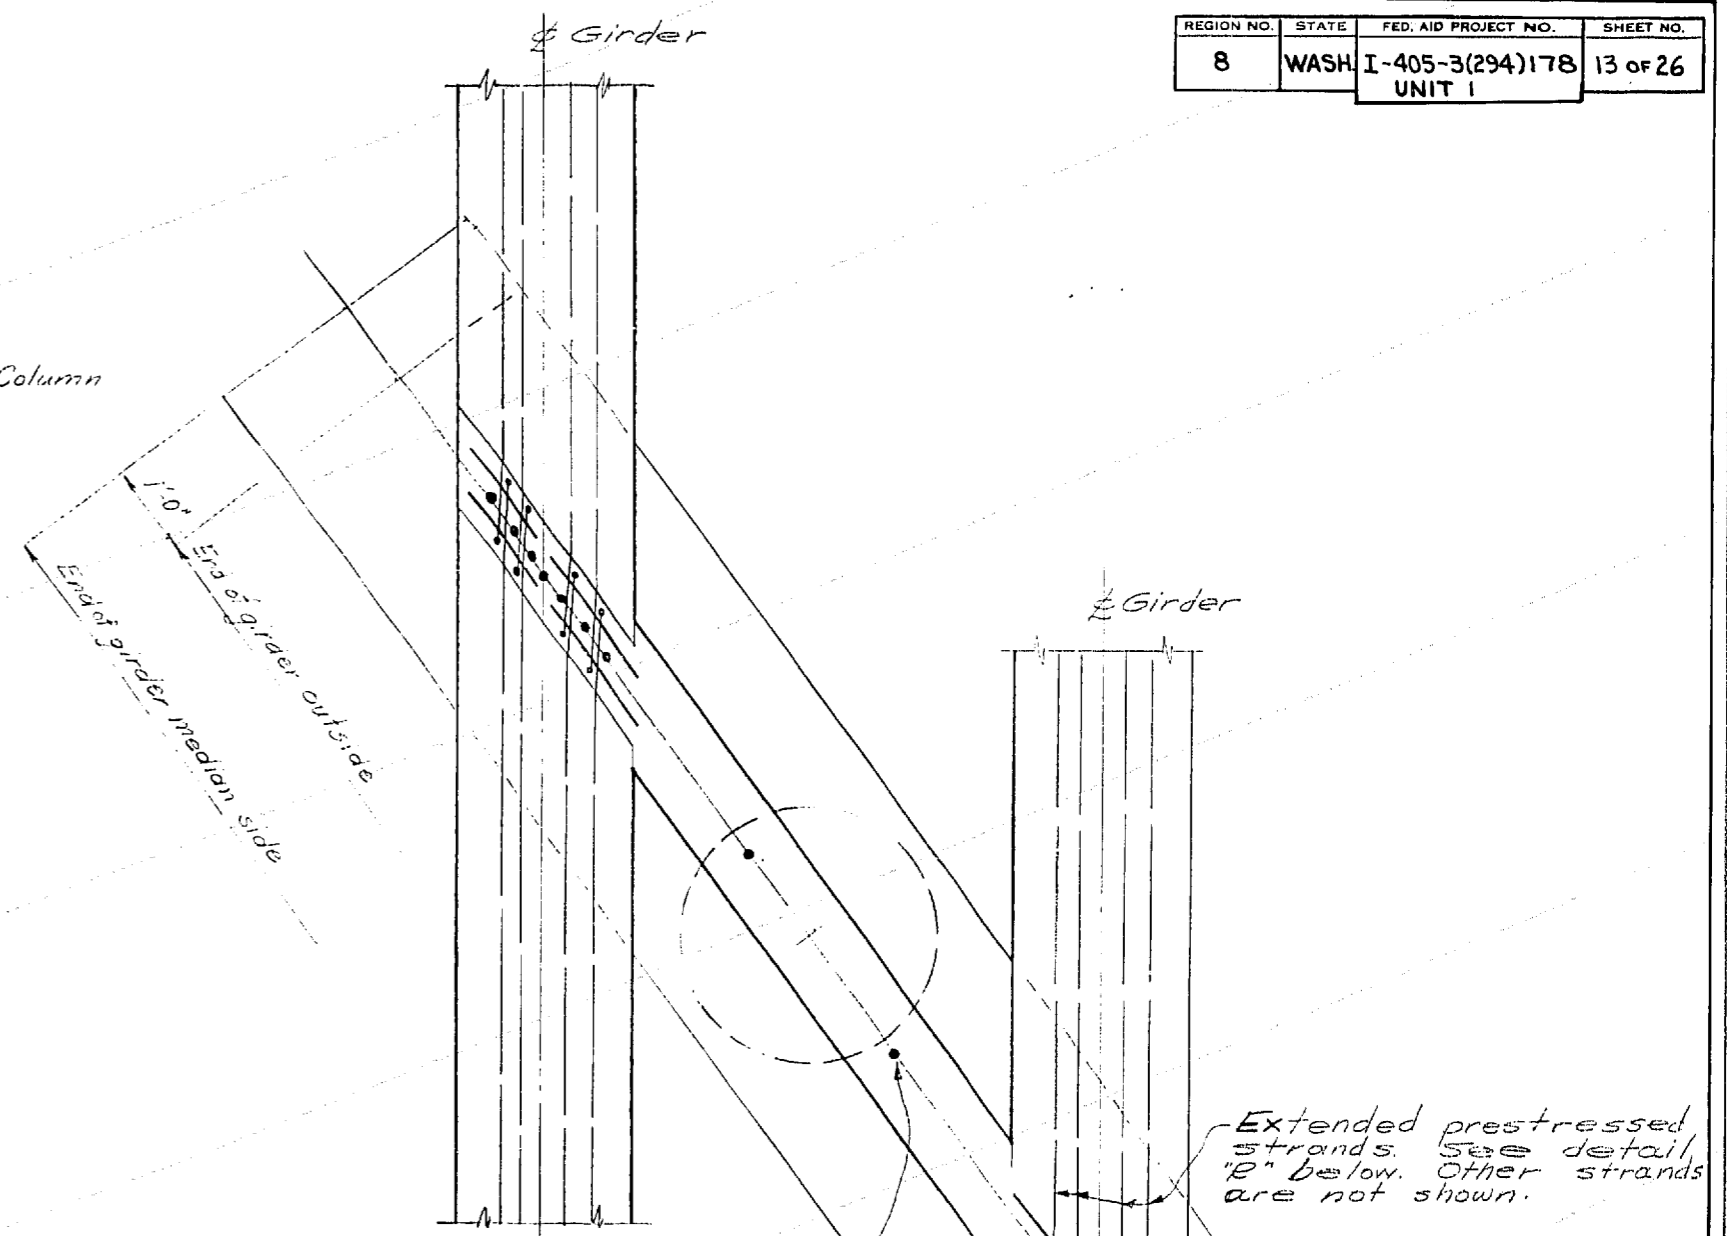

**GIRDER PLAN  
AT CROSS BEAM**

7(9)#11 Hinge bars each girder and 2(19)#11 at equal spaces between girders.

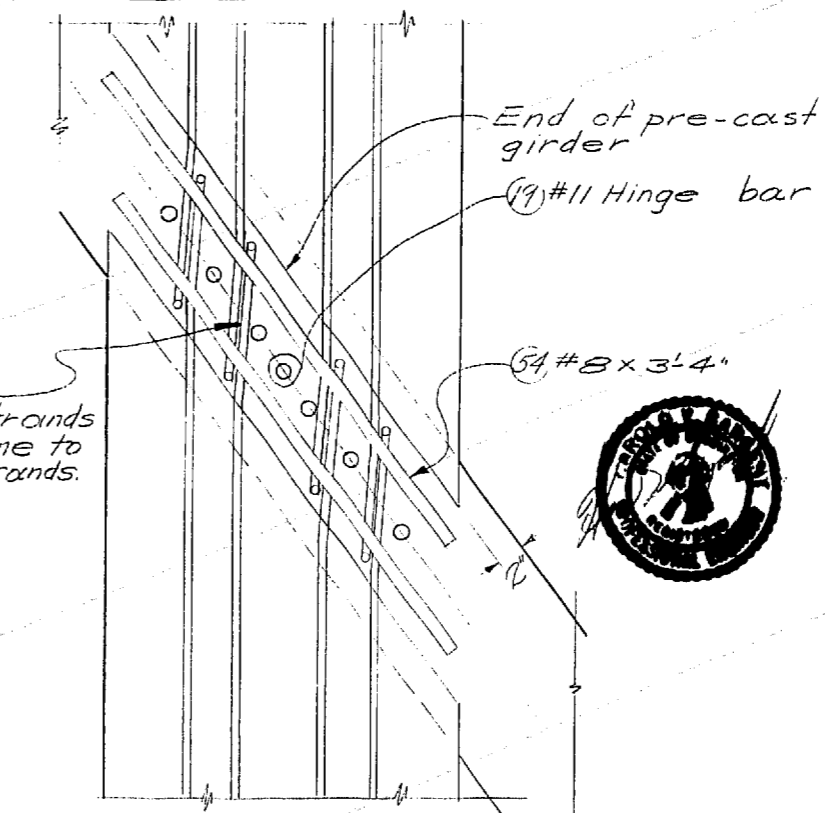

**DETAIL "R"**

**SR 405  
MP 24.28 TO MP 26.37  
NORTH CR. BR. AND 228TH ST. O'XING  
KING & SNOHOMISH COUNTIES  
228TH ST. OVERCROSSING**

PIER NO. 3 - NO. BR.

WASHINGTON STATE HIGHWAY COMMISSION  
DEPARTMENT OF HIGHWAYS  
OLYMPIA, WASHINGTON

R. L. WILSON  
H. WALSH



BAKER FERGUSON  
JOHN N. RUPP

APPROVED Nov. 22, 1967


SHEET 13 of 26 SHEETS

CONTRACT NUMBER 8375


P/1992

6/33


SR 405  
 100 FT. OVERPASS TO BRANCH ROAD  
 5 STRUCTURES  
 KING & SNOHOMISH COUNTIES  
 1-1976 C.E. 17220 & 21110  
 SHEET 13 OF 26 SHEETS

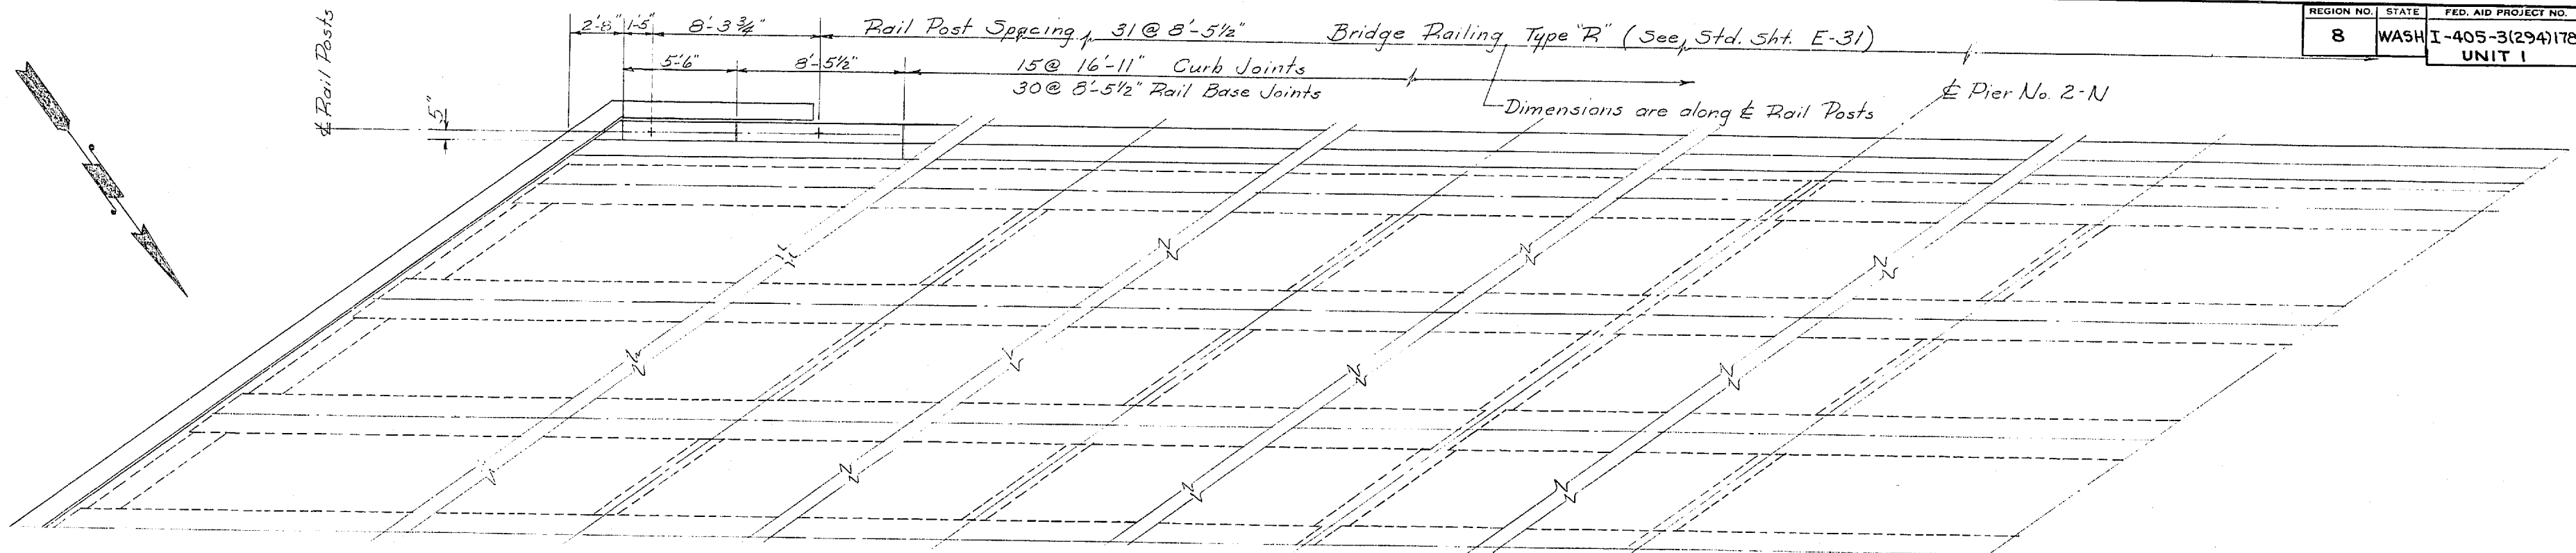


PART. FRAMING PLAN - NORTH BRIDGE

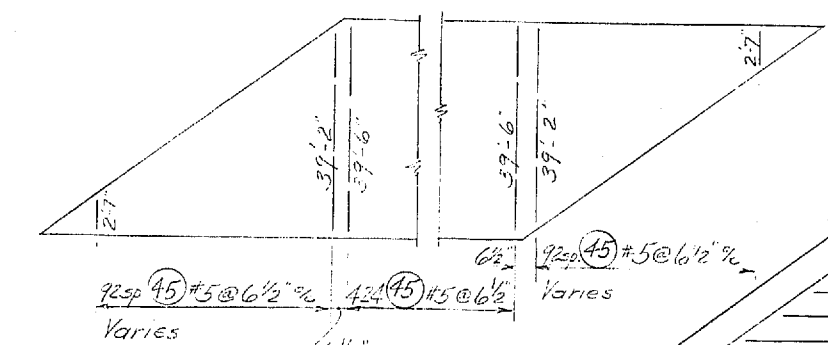


TRANSV REINF. - BOTTOM

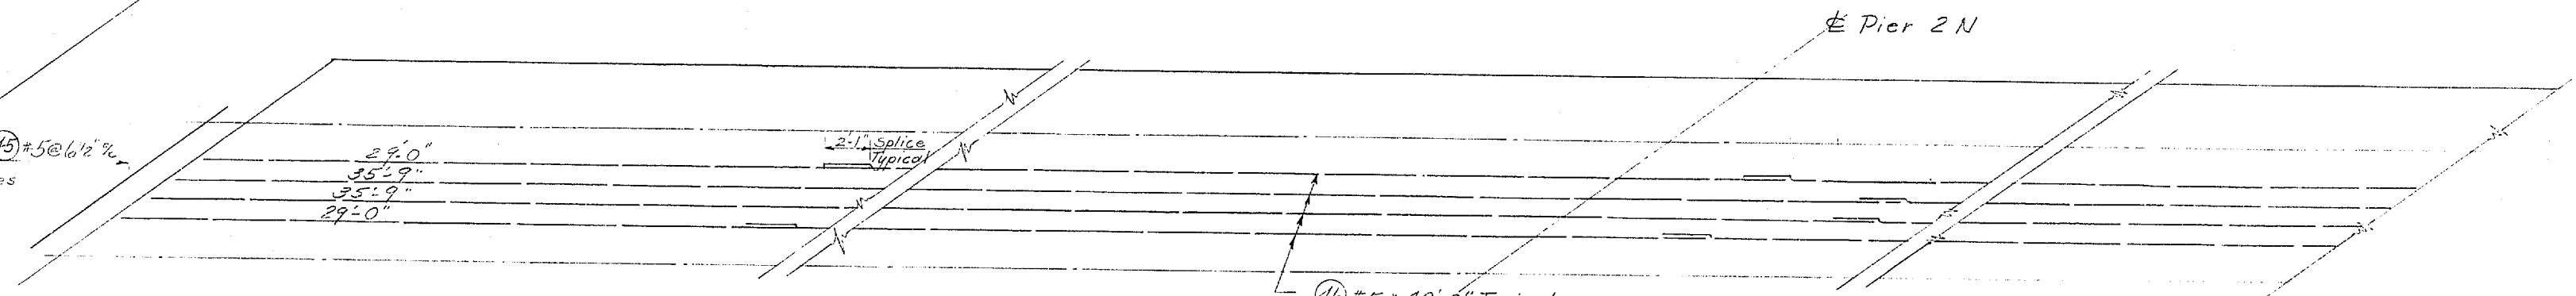

BOTTOM LONGIT. SLAB REINF. - SPANS 1 & 2 N

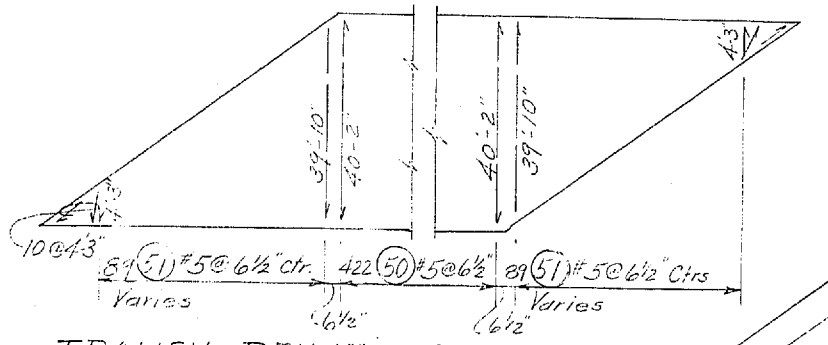

TRANSV. REINF. - TOP

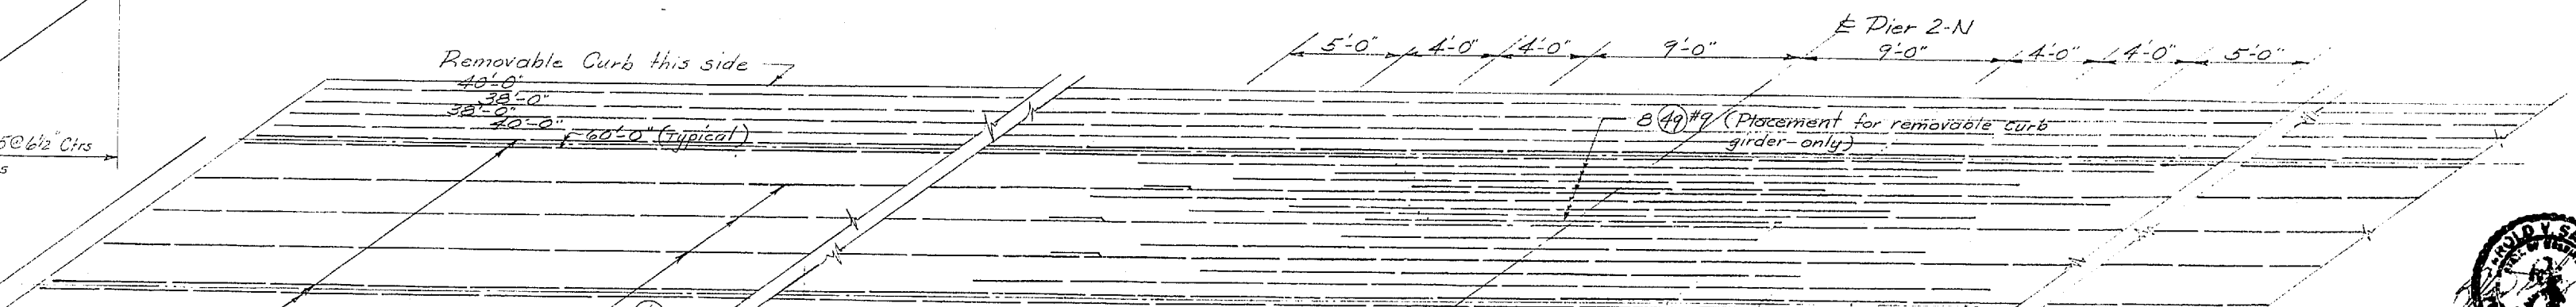

TOP LONGIT. SLAB REINF. - SPANS 1 & 2 N



SR 405  
MP 24.28 TO MP 26.37  
NORTH CR. BR. AND 228TH ST. O'XING  
KING & SNOHOMISH COUNTIES  
228TH ST. OVERCROSSING  
FRAMING PLAN & SLAB REINF. - NO. BR.

WASHINGTON STATE HIGHWAY COMMISSION  
DEPARTMENT OF HIGHWAYS  
OLYMPIA, WASHINGTON

R. L. MIKALSON  
H. WALSH



BAKER FERROUN  
JOHN H. RUFF

APPROVED: Nov. 22, 1967

SHEET 14 of 26 SHEETS


CONTRACT NUMBER 8376

P/1992


6/32

SHEET OF SHEETS  
 14 OF 26 SHEETS  
 8376


Rail Base Jts. midway btwn. Rail Posts Bridge Railing Type "R" (See Std. Sht. E-31) Rail Post Spacing 31 @ 8'-5 1/2" 1/2

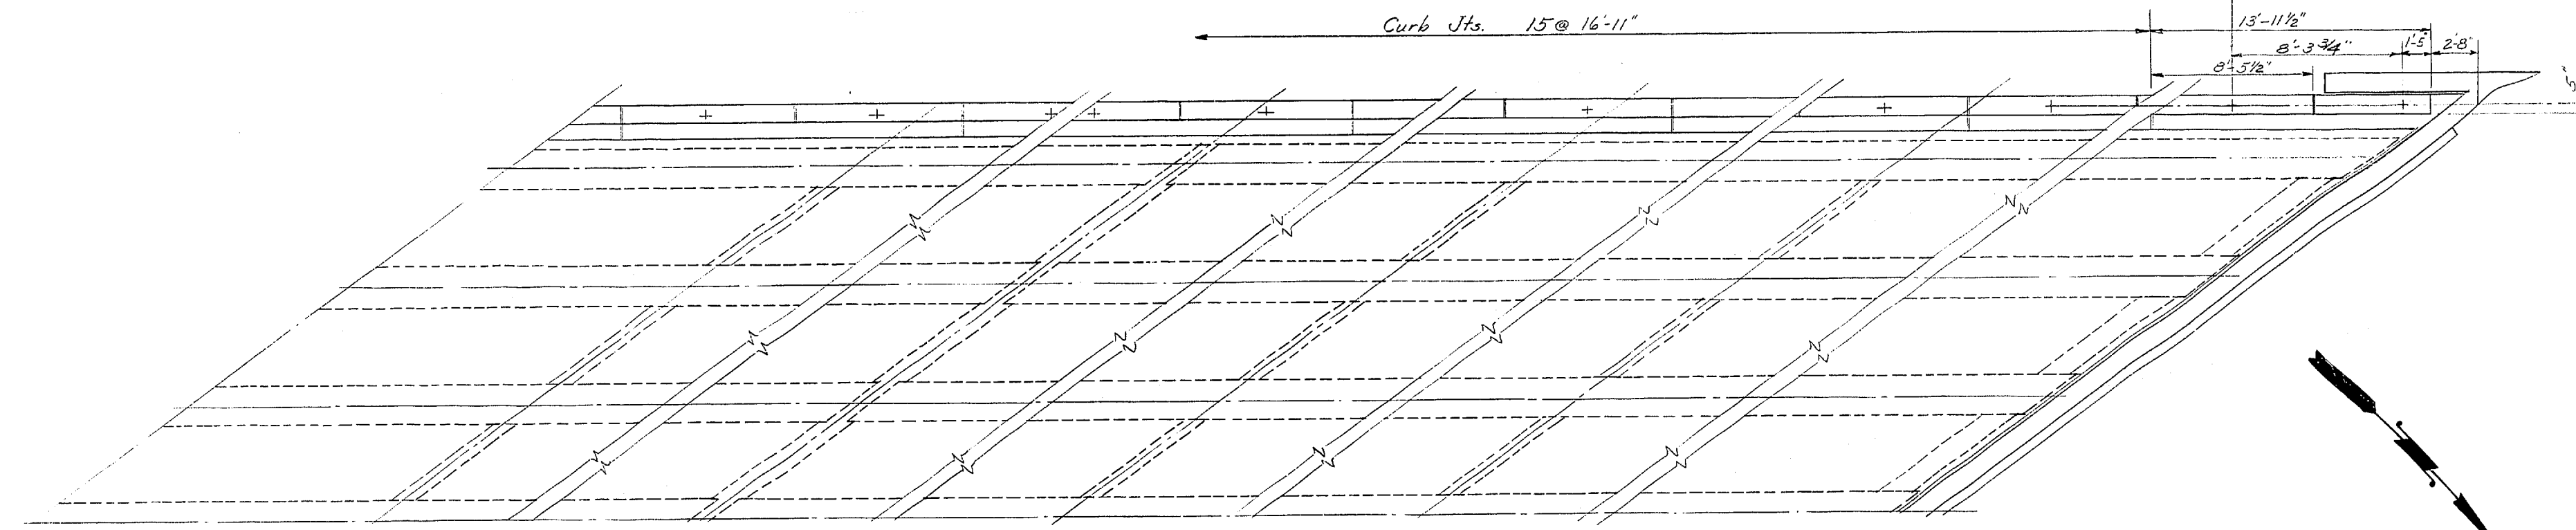

PART FRAMING PLAN - NORTH BRIDGE

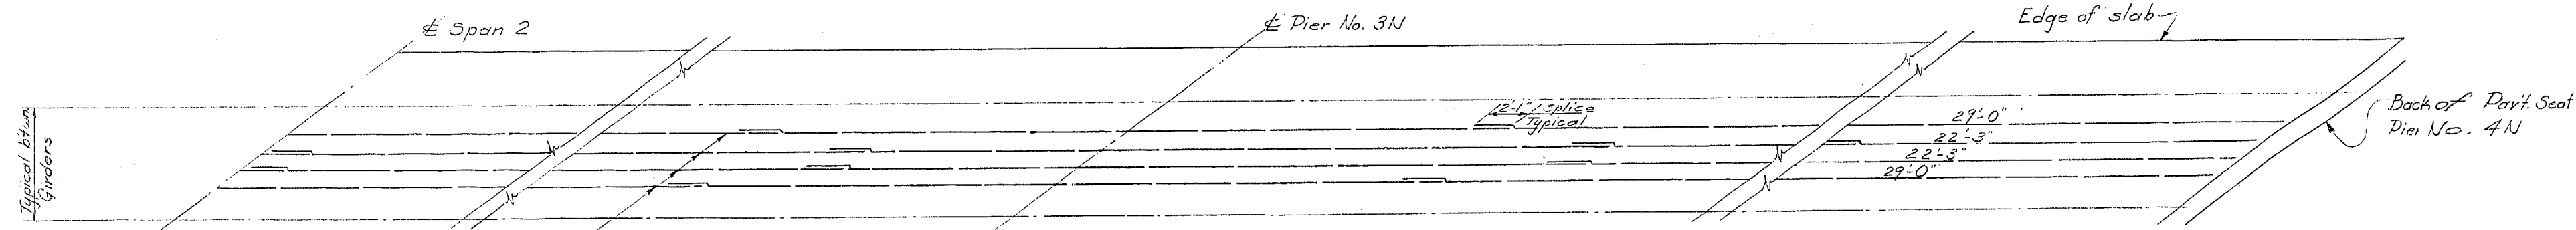

BOTTOM LONGIT. SLAB REINF. - SPANS 2 & 3N

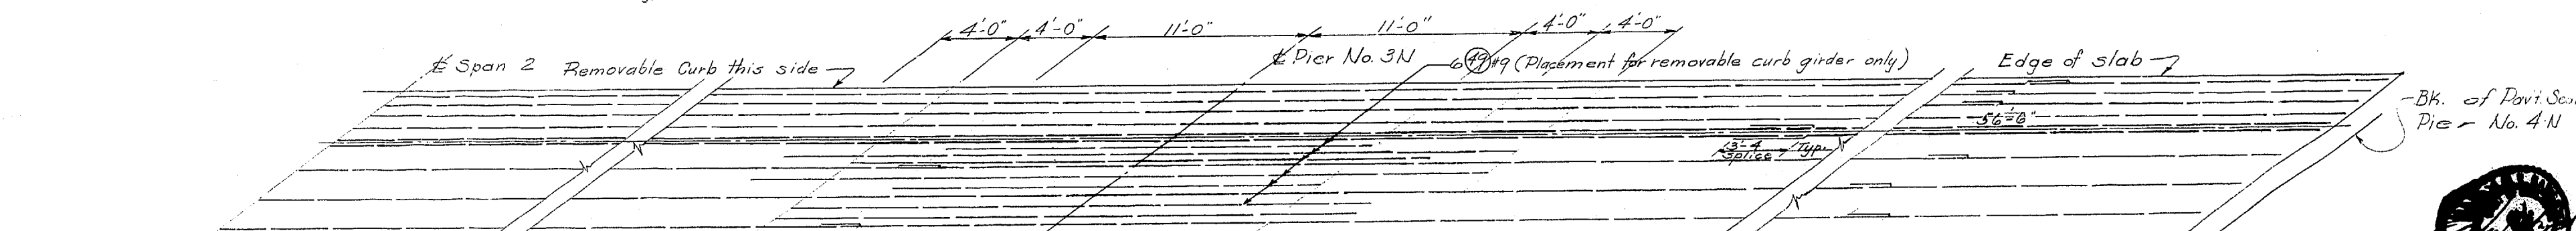

TOP LONGIT. SLAB REINF. - SPANS 2 & 3N

SR 405  
MP 24.28 TO MP 26.37  
NORTH CR. BR. AND 228TH ST. O'XING  
KING & SNOHOMISH COUNTIES  
228TH ST. OVERCROSSING

FRAMING & SLAB REINF. - NO. BRIDGE












WASHINGTON STATE HIGHWAY COMMISSION  
DEPARTMENT OF HIGHWAYS  
OLYMPIA, WASHINGTON

E. I. NIELSON  
H. WALSH  
GEORGE D. ZANK, CHAIRMAN  
SAFIR, PEROUSSON  
JOHN DE. BLIPP

APPROVED: Nov. 22, 1967  
SHEET 15 OF 26 SHEETS  
CONTRACT NUMBER 8375



SR 405  
NORTH CR. BR. TO DANFORD ROAD  
& 228TH ST.  
KING & SNOHOMISH COUNTIES  
E. I. NIELSON, ENGINEER & DRAFTER

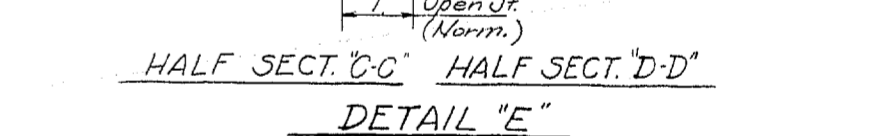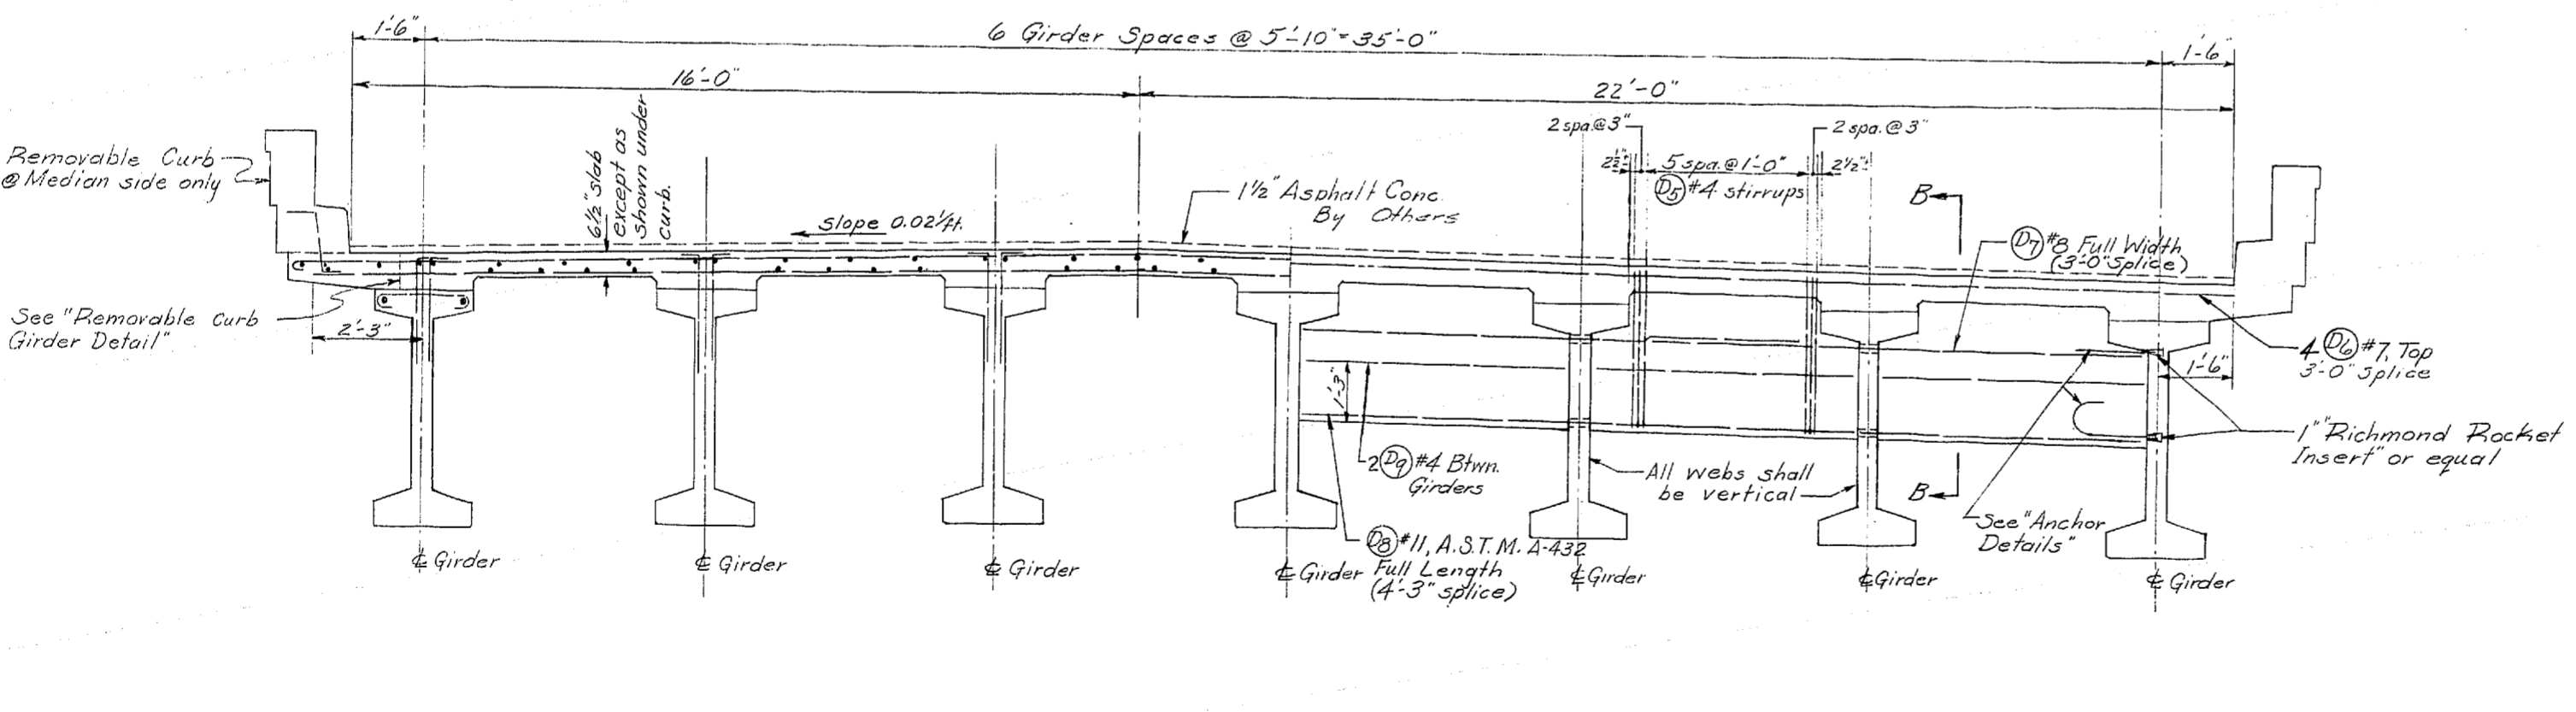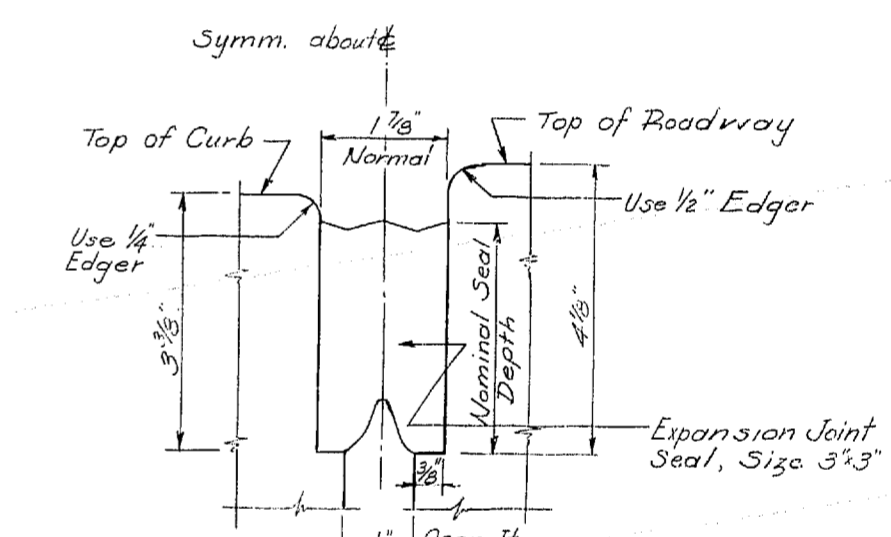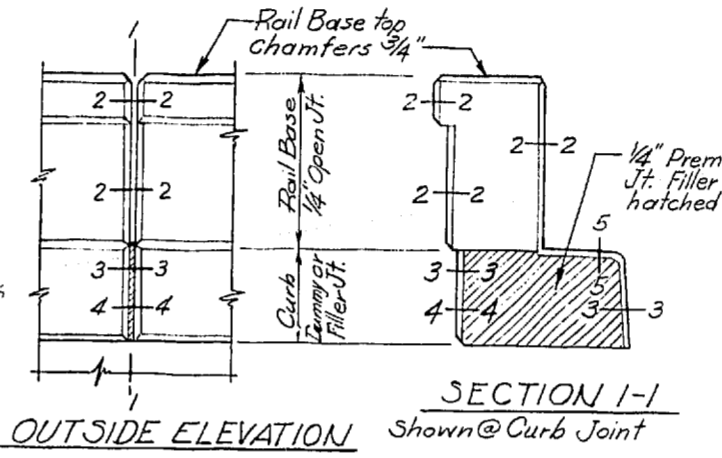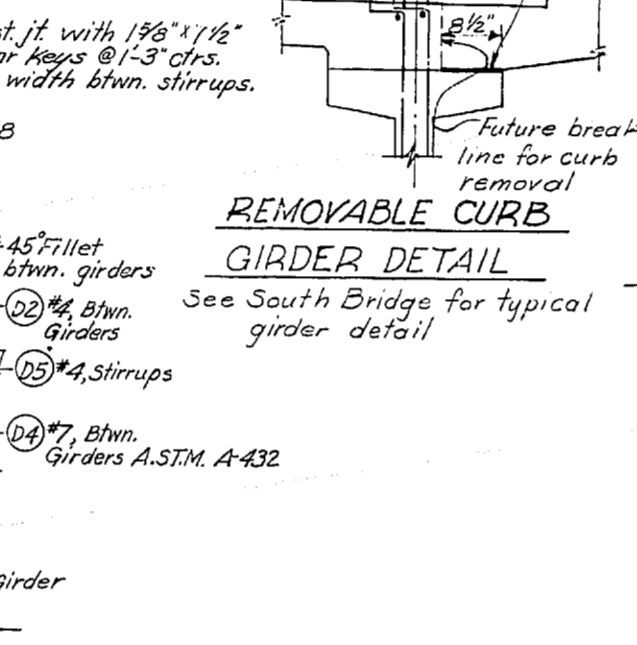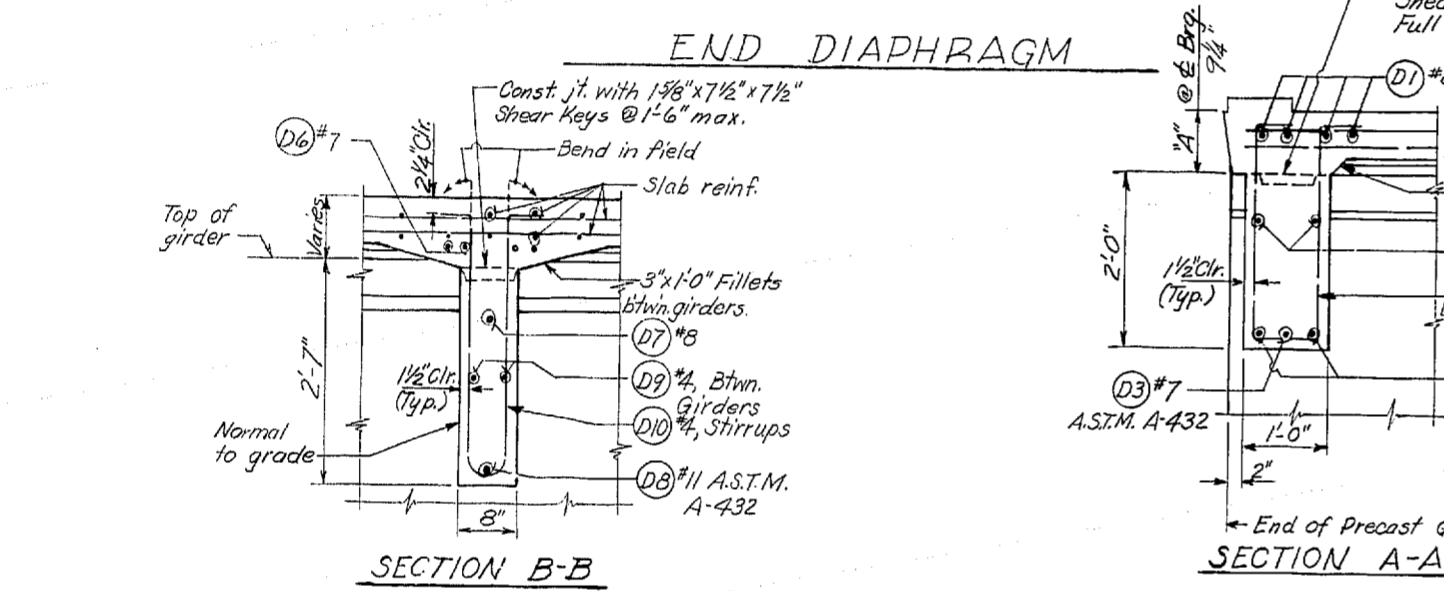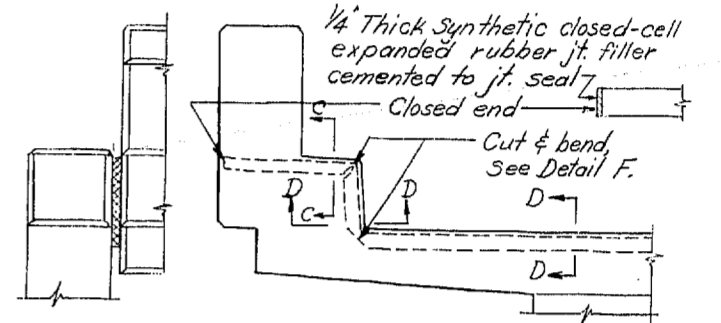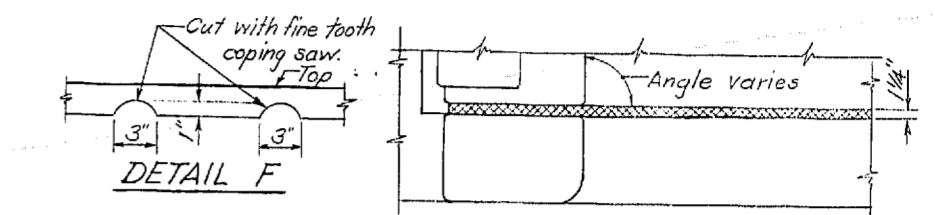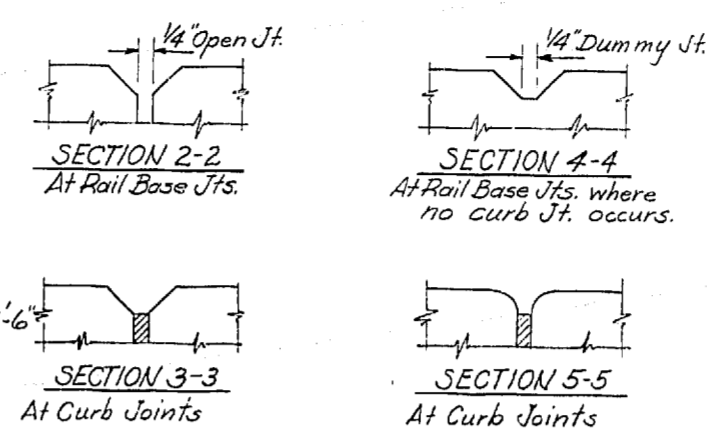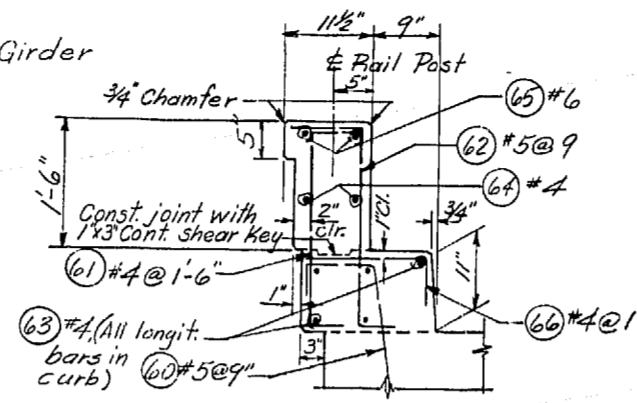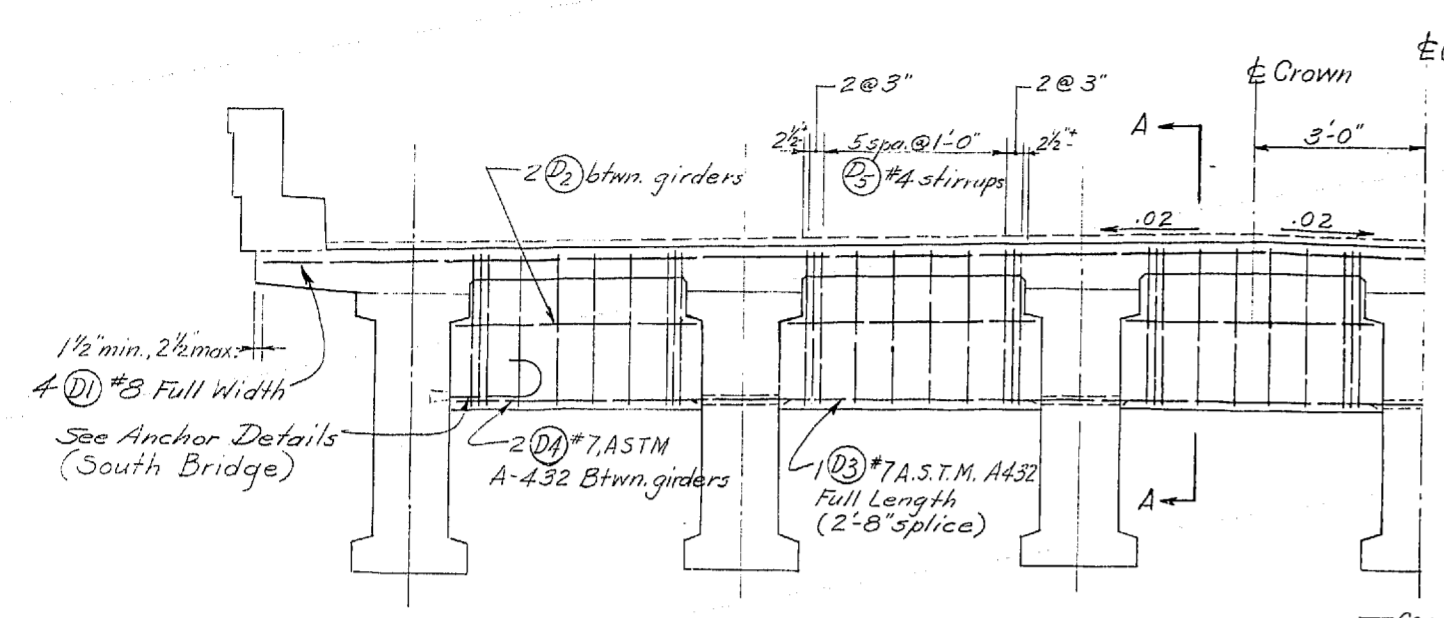



**SR 405**  
**MP 24.28 TO MP 26.37**  
**NORTH CR. BR. AND 228TH ST. O'XING**  
 KING & SNOHOMISH COUNTIES  
**228TH ST. OVERCROSSING**

DIAPH. & ROADWAY SECT. - NO. BR.


WASHINGTON STATE HIGHWAY COMMISSION  
 DEPARTMENT OF HIGHWAYS  
 OLYMPIA, WASHINGTON  
 GEORGE D. ZAHM, CHAIRMAN  
 E. L. MICALSON, H. WALSH, JOHN H. RUPP, BARRY PERGUSON

APPROVED NOV. 22, 1967  
 SHEET 16 OF 26 SHEETS  
 CONTRACT NUMBER 8376

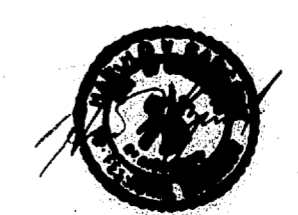


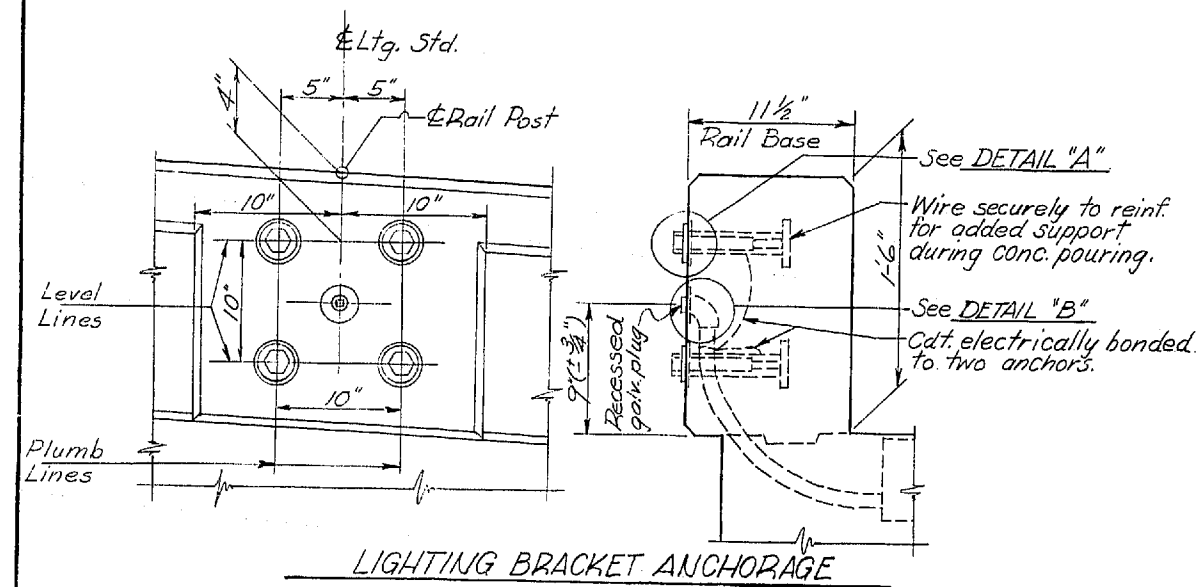


LIGHTING BRACKET ANCHORAGE

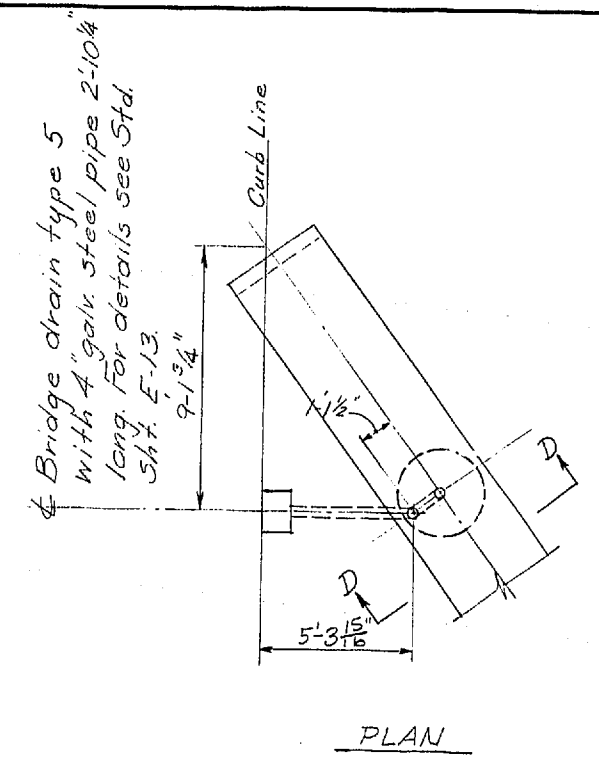


PLAN

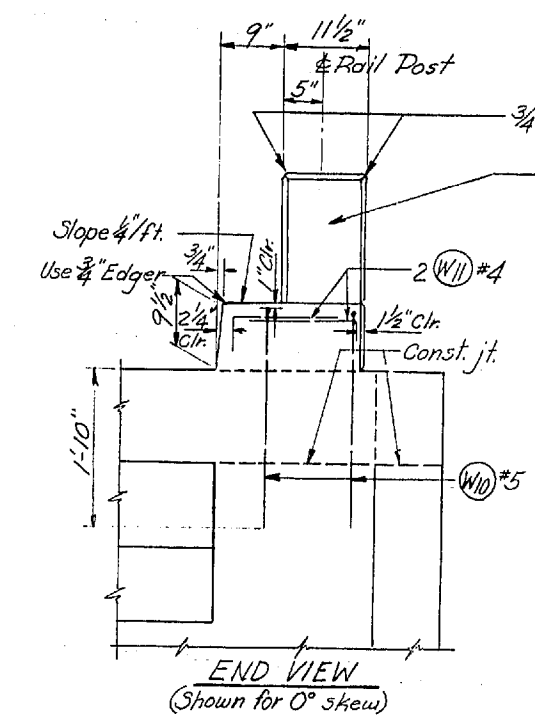


END VIEW (Shown for 0° skew)

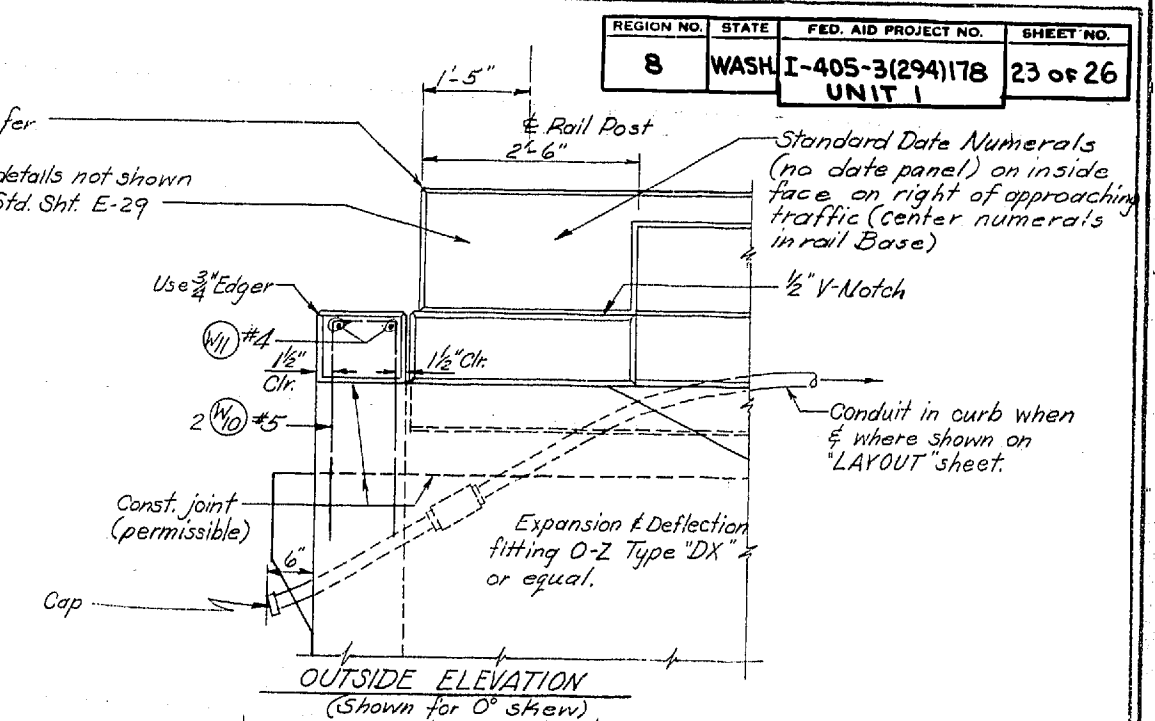


OUTSIDE ELEVATION (Shown for 0° skew)

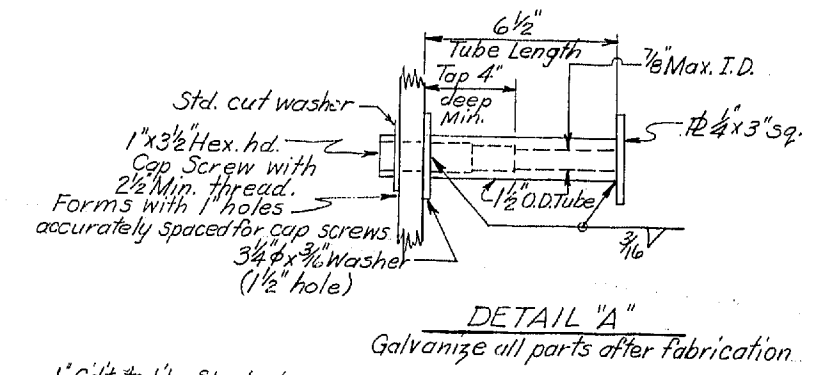

DETAIL "A" Galvanize all parts after fabrication.

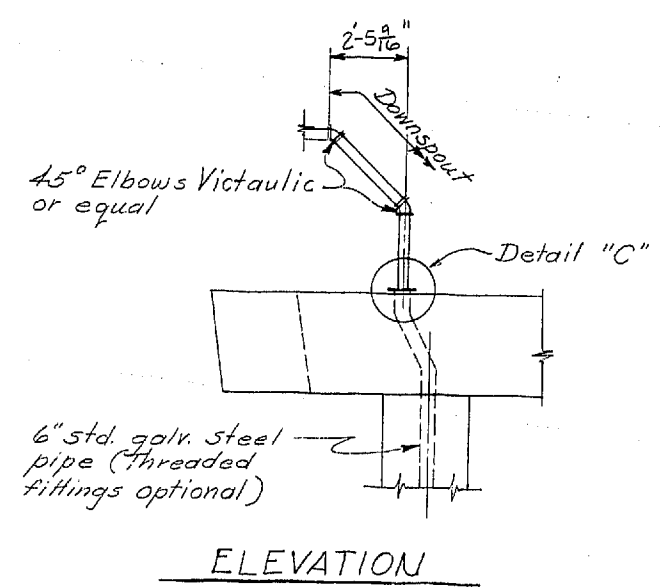


ELEVATION

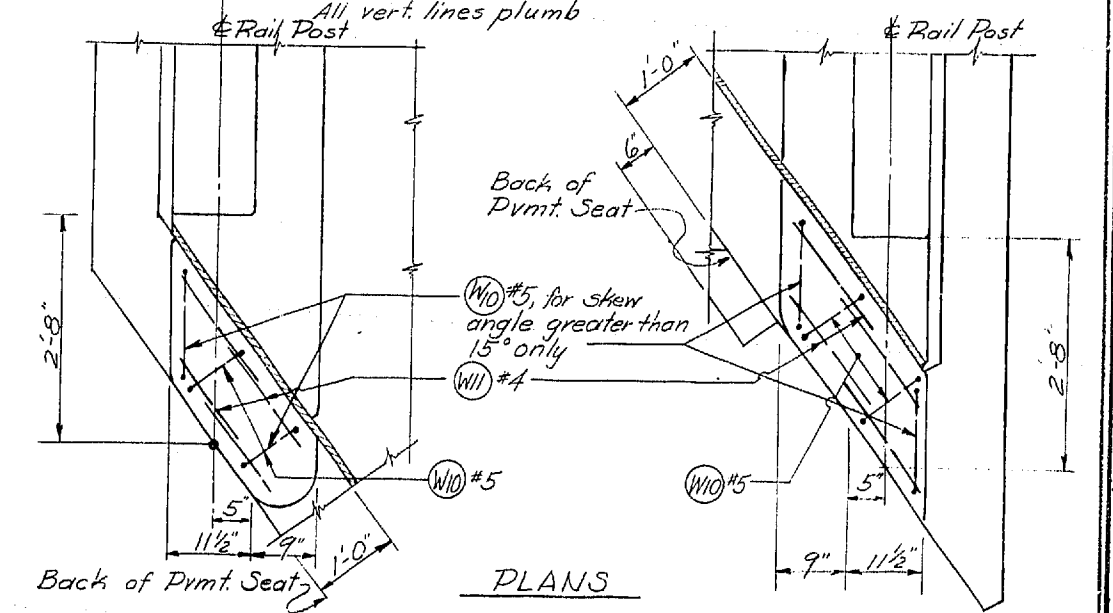


PLANS

9" CURB DETAILS AT END PIERS (All Curb & Rail Base Chamfers 1/2" except top of Rail Base as noted)

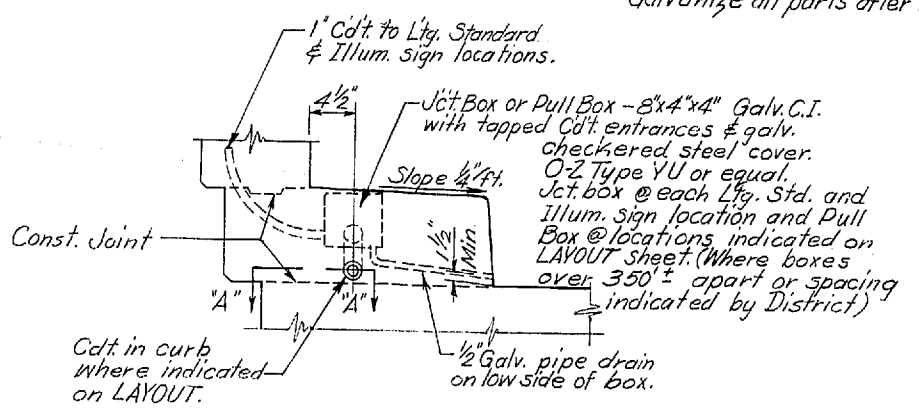

SECTION THRU CURB

Showing conduit and boxes in curb. Install #12 Galv. iron pull wire in all conduit runs in curbs. All conduit shall be galvanized rigid conduit of size indicated on LAYOUT. Install all conduit runs to drain to a box or bridge end or open conduit Exp. Jt.

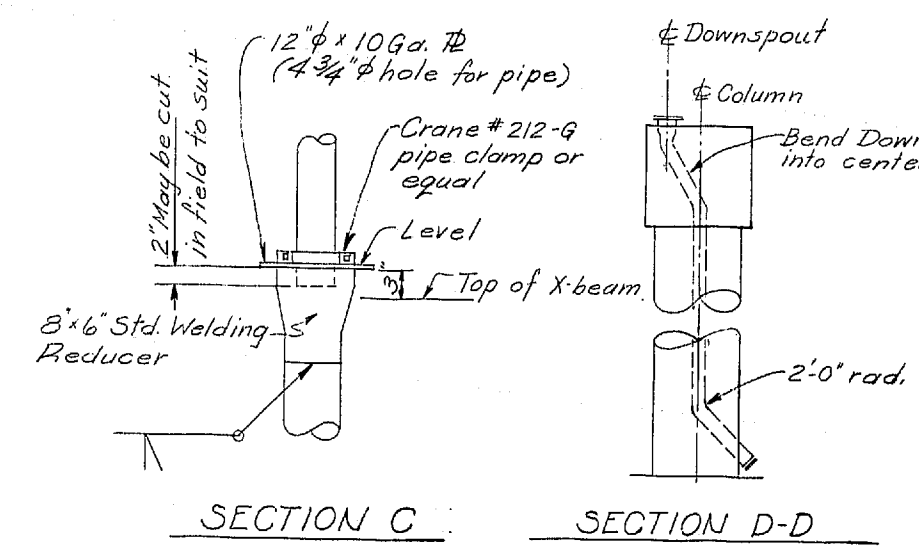


SECTION C


SECTION D-D

DOWNSPOUT DETAIL - PIER NO. 2-S

All pipes & fittings shall be galvanized after fabrication

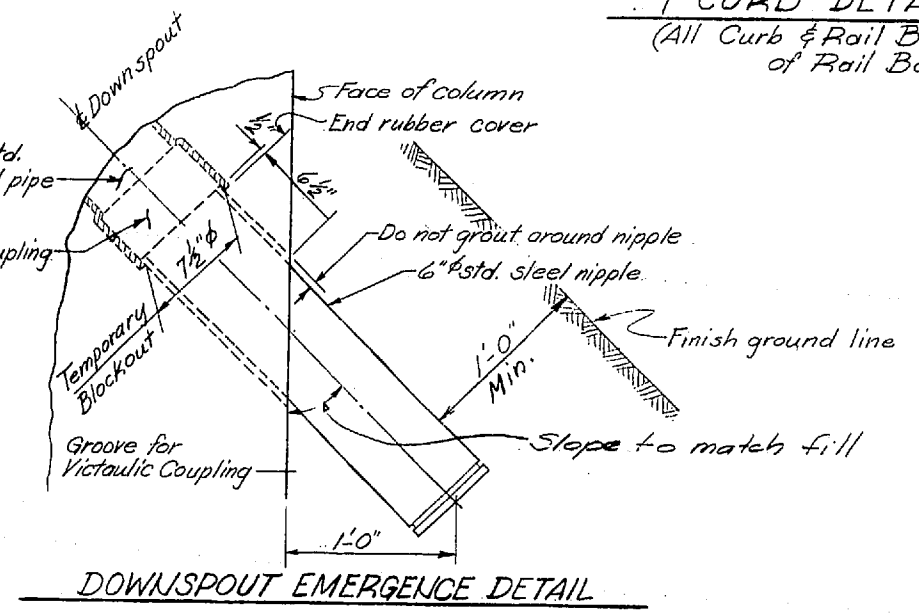

DOWNSPOUT EMERGENCE DETAIL

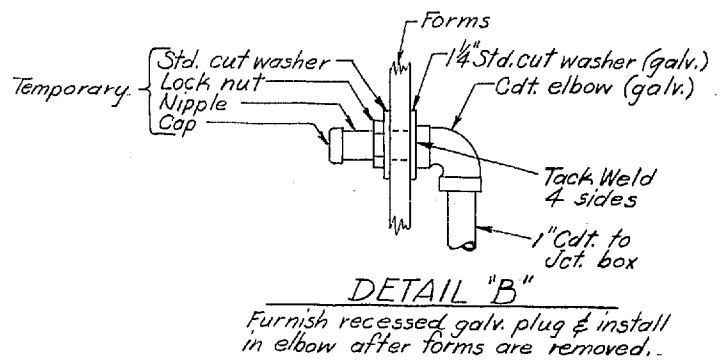

DETAIL "B"

Furnish recessed galv. plug & install in elbow after forms are removed.


LIGHTING BRACKET DETAILS

SR 405  
MP 24.28 TO MP 26.37  
NORTH CR. BR. AND 228TH ST. O'XING  
KING & SNOHOMISH COUNTIES  
228TH ST. OVERCROSSING

MISC. DETAILS

WASHINGTON STATE HIGHWAY COMMISSION  
DEPARTMENT OF HIGHWAYS  
OLYMPIA, WASHINGTON

GEOSE D. ZAHN, CHAIRMAN  
R. I. MITALSON  
H. WALSH  
BARRY FERGUSON  
JOHN H. RUPP

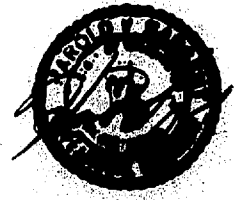

APPROVED Nov. 22, 1967


SHEET 23 of 26 SHEETS

CONTRACT NUMBER 8375

P/1992

6/23

**NOTE:**  
ALL DETAILS ON THIS SHEET ARE FOR  
**PRETENSIONED STRAND DESIGN ONLY**

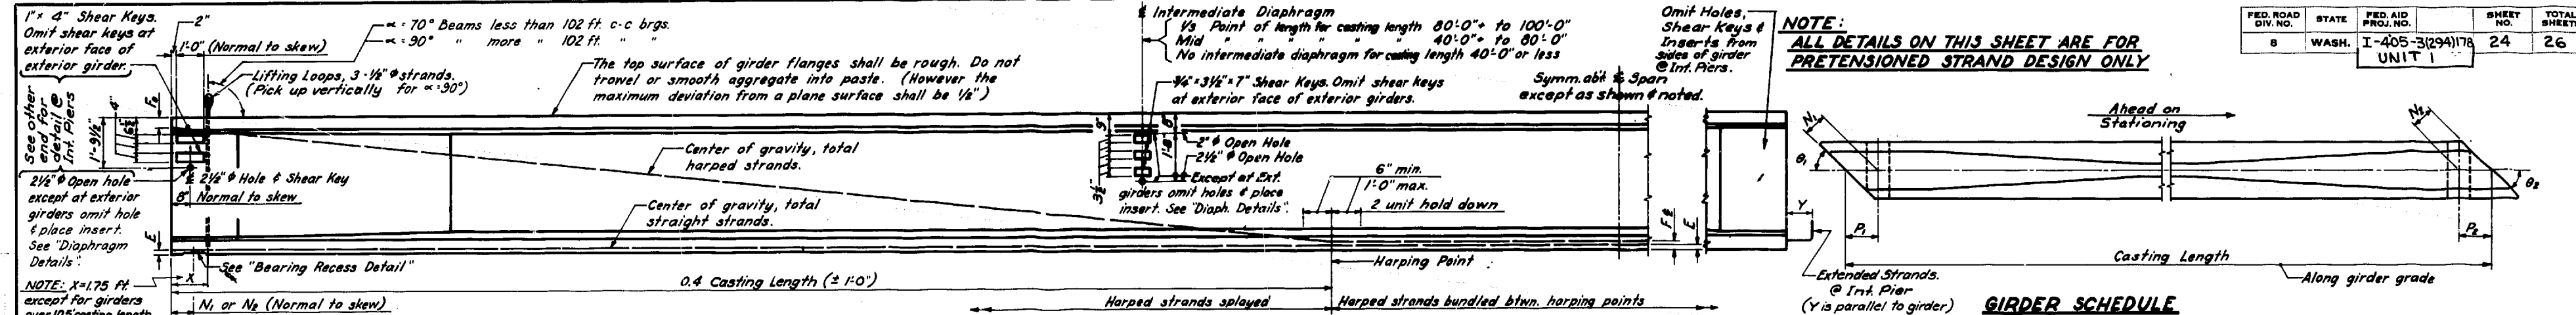


**GIRDER ELEVATION**


**GIRDER SCHEDULE**  
All strands shall be 1/2" x 270"

SPAN	GIRDER	DIMENSIONS							BUNDLED HARPED & STRAIGHT PRETENSIONED										
		θ <sub>1</sub>	θ <sub>2</sub>	N <sub>1</sub>	N <sub>2</sub>	P <sub>1</sub>	P <sub>2</sub>	Y	Casting Length	HARPED		STRAIGHT		Location of C.G. Steel Area (In.)	Camber (In.)				
										No. of Strands	Jacking Force (Kips)	No. of Strands	Jacking Force (Kips)						
NORTH BRIDGE																			
1	7*	143°41'	143°41'	9 1/2	-	15	-	11 3/4	95-5 1/2	14@16 1/2	8	232	20	580	28	2 3/8	3	4 5/8	1 1/2
2	7*	143°41'	143°41'	-	-	-	-	11 3/4	102-10 1/2	18@15	9	261	24	696	33	3 1/8	3	5 1/8	1 1/2
3	7*	143°41'	143°41'	-	9 1/2	-	15	11 3/4	85-3 1/2	1-6	8	232	14	406	22	2 1/4	3	4 3/8	1 1/4
SOUTH BRIDGE																			
1	8*	143°41'	143°41'	9 1/2	-	15	-	11 3/4	95-5 1/2	22@14 1/2	8	232	22	638	30	2 1/8	3	4 5/8	1 5/8
2	8*	143°41'	143°41'	-	-	-	-	11 3/4	102-10 1/2	20@14	11	319	24	676	35	3 1/8	3	6	2
3	8*	143°41'	143°41'	-	9 1/2	-	15	11 3/4	68-3 3/4	1-6	6	174	10	290	16	1 3/4	3	3 3/4	5/16


**SECTION THRU WEB AT INT. DIAPHRAGMS**

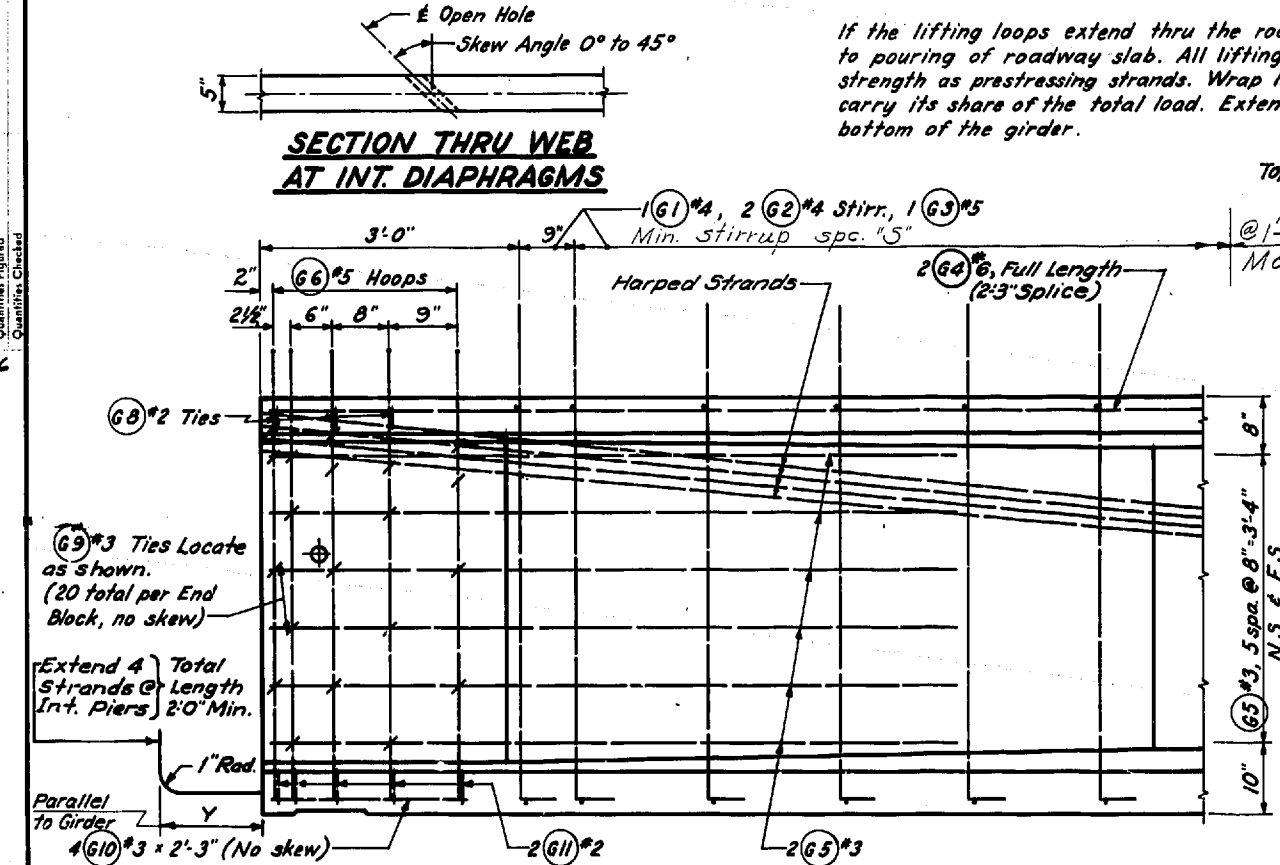

**STRAND PATTERN AT SPAN**

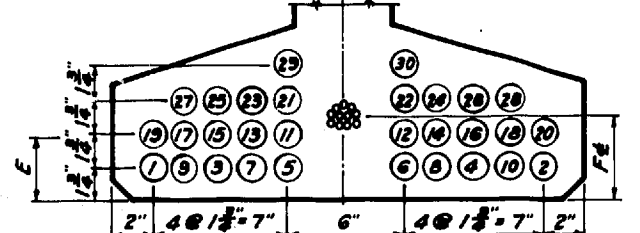


**STRAND PATTERN AT GIRDER END**

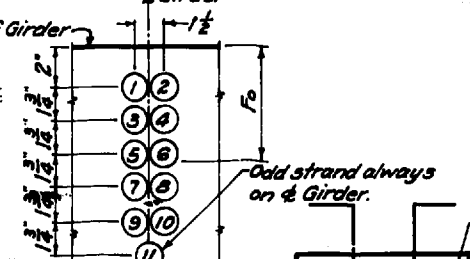


**END BLOCK ELEVATION**



**END VIEW OF GIRDER AT INTERMEDIATE PIERS**

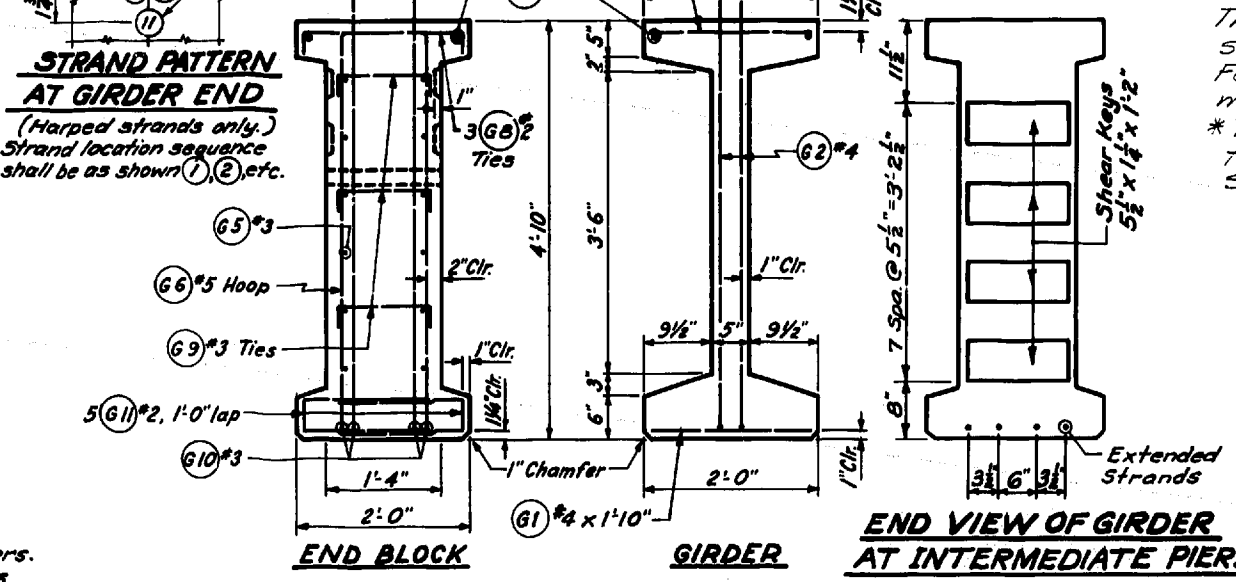

**TYPICAL CROSS SECTIONS**

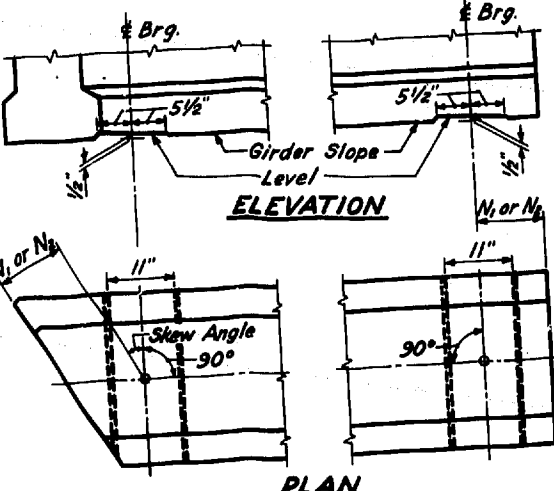

**GIRDER WEIGHTS**

SECTION	End Blk.	Girder
	lb./lin.ft.	lb./lin.ft.
1137	607	


**NOTE:**  
Extra caution must be exercised in handling and placing girders over 100' long. If necessary the girders shall be braced laterally to prevent tipping or buckling.

**BAR LIST**


All dimensions are out to out.

MARK	LOCATION	SIZE
G 1	Girder - Bot. Flange	4 Str.
G 2	" " Stirrups	4
G 3	" " Top Flange	5 Str.
G 4	" " Longit. - Top - full length	6 "
G 5	End Block - Longit.	3
G 6	" " Hoops	5
G 8	End Block - Ties - Top Flange	2
G 9	" " " " " "	3
G 10	" " Longit. - Bottom	3 Str.
G 11	" " Transv. " " "	2
G 12	Girder Top Flange	3

**NOTE:** For "A" dim. see "Girder Schedule".

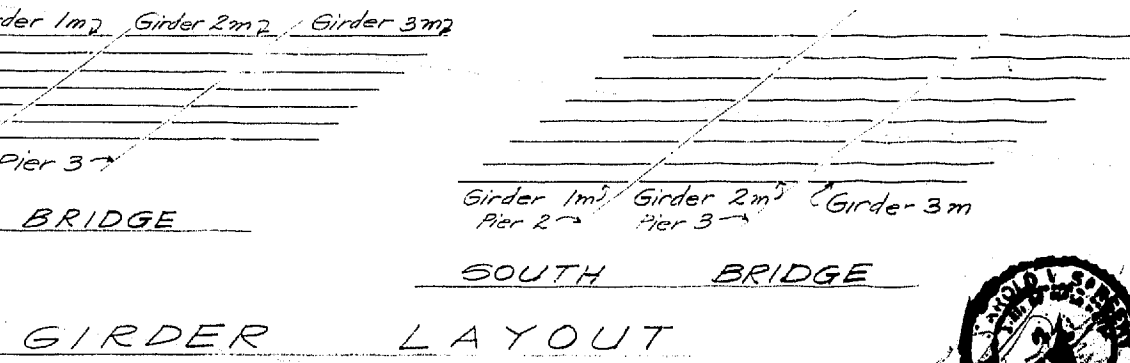

**SCREED CAMBER FOR GIRDER DEFLECTION**

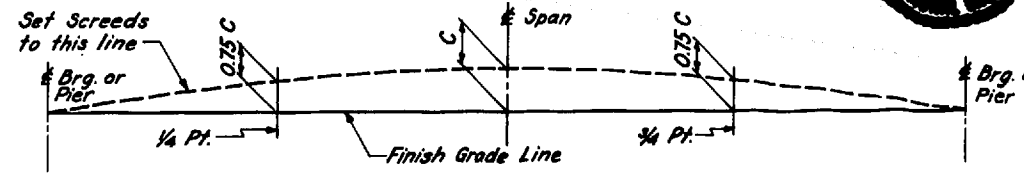

**SERIES 100 GIRDER**

SR 405  
MP 24.28 TO MP 26.37  
NORTH CR. BR. AND 228TH ST. O'XING  
KING & SNOHOMISH COUNTIES  
228TH ST. OVERCROSSING

**GIRDER DETAILS**

WASHINGTON STATE HIGHWAY COMMISSION  
DEPARTMENT OF HIGHWAYS  
OLYMPIA, WASHINGTON

Design Engineer: [Name]  
 Supervising Bridge Engr.: [Name]  
 Designer: [Name]  
 Checker: [Name]  
 Date: [Date]



S= Bar is included in substructure quantities.  
 F= Bar to be field welded.  
 T= Tie or Stirrup.  
 H= A.S.T.M. A-432.  
 V= Bar dimensions vary between dimensions shown on this line and the following line.

MARK NO.	LOCATION	SIZE	NO.	REQ'D.	BEND TYPE	TIE OR STIR	FIELD WELD	SUBSTR.	VARIES	NO. EACH	DIMENSIONS (Out to out)										LENGTH	WEIGHT		
											U		W		X		Y		Z				θ <sub>1</sub> θ <sub>2</sub>	
											Ft.	In.	Ft.	In.	Ft.	In.	Ft.	In.	Ft.	In.			Deg.	Deg.
101	PIER NO2 FTG	9	126	50	S						11	1.0						4748	4749					
102	PIER NO3 FTG	8	132	50	S						10	7.0						3730	3729					
103	PIERS NO 2+3 DOWELS	9	66	65	S						5	2.0	1	7.0	0.0			1449	1458					
104	PIER NO 2 COL VERTS	9	11	50	S						27	9.0						1038						
104	PIER NO 2 COL VERTS	9	11	50	S						27	3.0						979						
104	PIER NO 2 COL VERTS	9	11	50	S						26	2.0						944						
104	PIER NO 3 COL VERTS	9	11	50	S						25	3.0						926						
104	PIER NO 3 COL VERTS	9	11	50	S						24	9.0						888						
104	PIER NO 3 COL VERTS	9	11	50	S						23	9.0						491	489					
105	PIERS NO 2+3 COL HOOPS	3	137	66	S						11	10.0	1	0.0	4	0.5	6.0	2271	2270					
107	X-BEAM STIRRUPS PIERS 2+3	5	184	61	S						3	6.0	4	0.5	6.0	0.0		1839	1838					
108	X-BEAM STIRRUPS PIERS 2+3	14	4	50	S						81	0.0						2479						
109	X-BEAM PIER 2 BOT	14	4	50	S						30	0.0						918						
110	X-BEAM PIER 2 BOT	14	4	50	S						23	0.0						704						
111	X-BEAM PIER 2 BOT	14	4	50	S						20	0.0						692	692					
112	X-BEAM PIERS 2+3	5	16	50	S						41	6.0						107	106					
113	X-BEAM PIERS 2+3	4	4	50	S						40	0.0						6632						
114	HINGE BARS	11	140	65	S						2	2.0	7	2.0	0.0			3764						
115	X-BEAM TOP PIER 2	14	6	50	S						82	0.0						306						
116	X-BEAM TOP PIER 2	14	2	50	S						20	0.0						275						
117	X-BEAM TOP PIER 2	14	2	50	S						18	0.0						245						
118	X-BEAM TOP PIER 2	14	2	50	S						16	0.0						222						
119	X-BEAM TOP PIER 2	14	2	50	S						16	0.0						345	346					
119	X-BEAM TOP PIER 2	14	2	50	S						21	6.0	0.0	2	7.0	0.0	9.0	0	82	22	7.	360		
120	X-BEAM TOP PIER 2	14	2	50	S						20	6.0	0.0	2	7.0	0.0	9.0	0	82	21	7.	330		
120	X-BEAM TOP PIER 2	14	2	50	S						20	6.0	0.0	2	7.0	0.0	9.0	0	82	22	7.	345		
121	X-BEAM TOP PIER 2	14	2	50	S						16	0.0							245			245		
122	X-BEAM PIER 2	14	2	50	S						14	0.0							214			214		
123	X-BEAM PIERS 2+3	5	166	61	S						3	3.0		6.0	6.0	6.0	0.0		693			693		
124	X-BEAM PIER 3 BOT	14	4	50	S						81	0.0							2479			2479		
125	X-BEAM PIER 3 BOT	14	4	50	S						30	0.0							918			918		
126	X-BEAM PIER 3 BOT	14	4	50	S						23	0.0							489			489		
127	X-BEAM PIER 3 TOP	14	2	50	S						16	0.0							170			170		
128	X-BEAM PIER 3 TOP	14	6	50	S						82	0.0							3764			3764		
129	X-BEAM PIER 3 TOP	14	2	50	S						20	0.0							306			306		
130	X-BEAM PIER 3 TOP	14	2	50	S						18	0.0							191			191		
131	X-BEAM PIER 3 TOP	14	2	50	S						16	0.0							340			340		
132	X-BEAM PIER 3 TOP	14	4	80	S						21	6.0	0.0	2	7.0	0.0	9.0	0	82	23	7.	707		
132	X-BEAM PIER 3 TOP	14	4	80	S						19	6.0	0.0	2	7.0	0.0	9.0	0	82	21	7.	676		
135	PIERS NO 1+4 FTG	6	16	50	S						49	3.5							1078			1078		
136	PIERS NO 1+4 FTG	5	194	50	S						5	4.0							309			309		
137	PIERS NO 1+4	4	100	65	T						5	4.0							456			456		
137	PIERS NO 1+4	4	128	65	T						5	0.0							536			536		
137	PIERS NO 1+4	4	132	65	T						6	1.0							749			749		
138	PIERS NO 1+4 GIRDER SEAT	4	36	50	S						31	2.0							749			749		
139	PIERS NO 1+4 GIRDER SEAT	4	16	50	S						45	11.0							1103			1103		
140	PIERS NO 1+4 GIRDER SEAT	4	180	61	T						3	0.0	1	3.0	1	3.0	0.0	0.0	641			641		
141	PIERS NO 1+4 BK WALL	5	180	62	T						9.0		7	6.0	7	6.0	6.0	6.0	3066			3066		


S= Bar is included in substructure quantities.  
 F= Bar to be field welded.  
 T= Tie or Stirrup.  
 H= A.S.T.M. A-432.  
 V= Bar dimensions vary between dimensions shown on this line and the following line.

MARK NO.	LOCATION	SIZE	NO.	REQ'D.	BEND TYPE	TIE OR STIR	FIELD WELD	SUBSTR.	VARIES	NO. EACH	DIMENSIONS (Out to out)										LENGTH	WEIGHT		
											U		W		X		Y		Z				θ <sub>1</sub> θ <sub>2</sub>	
											Ft.	In.	Ft.	In.	Ft.	In.	Ft.	In.	Ft.	In.			Deg.	Deg.
142	PIERS NO 1+4 BK WALL	4	72	50	S						31	2.0							1499	1500				
143	PIERS 1+4 PAVT SEAT	4	260	64	T						1	11.0	1	3.0	5.0	0.0			333	332				
144	PIERS 1+4 PAVT SEAT	4	6	50	S						28	3.0							113	114				
W20	GIRDER STOP-LONGIT	4	24	50	S						2	5.0							39					
W21	GIRDER STOP-TRANSV	5	36	70	T						2	2.0	2	1.5	2	1.5			277	278				
W1	WING WALL	6	10	90	S						16	3.0	10	5.0	0	0.0			308	296				
W1	WING WALL	6	10	90	S						16	3.0	10	5.0	0	0.0			297	298				
W1	WING WALL	6	8	90	S						14	4.0	9	6.0	10	6	0.0		131	148				
W1	WING WALL	6	8	90	S						14	4.0	9	6.0	10	6	0.0		131	148				
W1	WING WALL	6	8	90	S						14	4.0	9	6.0	10	6	0.0		131	148				
W2	WING WALL	4	20	50	S						7	9.0							126					
W2	WING WALL	4	16	50	S						7	9.0							127					
W3	WING WALL	4	32	50	S						7	4.0							157					
W3	WING WALL	4	40	50	S						8	6.0	5	10.0					129					
W4	WING WALL	4	8	50	S						3	10.0							43					
150	SLAB BOT TRANSV	5	426	50	S						29	0.0							12885					
150	SLAB BOT TRANSV	5	442	50	S						22	7.0							10411					
150	SLAB BOT TRANSV	5	130	50	S						28	7.0							2124					
150	SLAB BOT TRANSV	5	98	50	S						22	2.0							9345					
151	SLAB BOT LONGIT	5	224	50	S						40	0.0							504					
151	SLAB BOT LONGIT	5	14	50	S						34	6.0							664					
151	SLAB BOT LONGIT	5	14	50	S						47	0.0							686					
151	SLAB BOT LONGIT	5	14	50	S						47	0.0							460					
151	SLAB BOT LONGIT	5	14	50	S						43	6.0							524					
152	SLAB TOP LONGIT	5	156	50	S						40	0.0							6399					
152	SLAB TOP LONGIT	5	18	50	S						46	10.0	6.0						480					
152	SLAB TOP LONGIT	5	18	50	S						41	10.0	6.0						480					
152	SLAB TOP LONGIT	5	18	50	S						35	0.0							657					
153	SLAB TOP GIRDER	8	64	50	S						60	0.0							10253					
153	SLAB TOP GIRDER	8	16	50	S						42	4.0							1808					
154	SLAB TOP PIER 2	9	16	50	S						20	0.0							1088					
154	SLAB TOP PIER 2	9	16	50	S						26	0.0							1414					
154	SLAB TOP PIER 2	9	16	50	S						26	0.0							1850					
154	SLAB TOP PIER 2	9	16	50	S						34	0.0							2285					
154	SLAB TOP PIER 2	9	16	50	S						42	0.0							979					
154	SLAB TOP PIER 3	9	16	50	S						18	0.0							1414					
154	SLAB TOP PIER 3	9	16	50	S						26	0.0							1958					
154	SLAB TOP PIER 3	9	16	50	S						36	0.0							24574					
155	SLAB TOP TRANSV	5																						

SR 405

SEC. 32.29 & 30 T.27N. R.5E. W.M.  
SNOHOMISH COUNTY

GENERAL NOTES

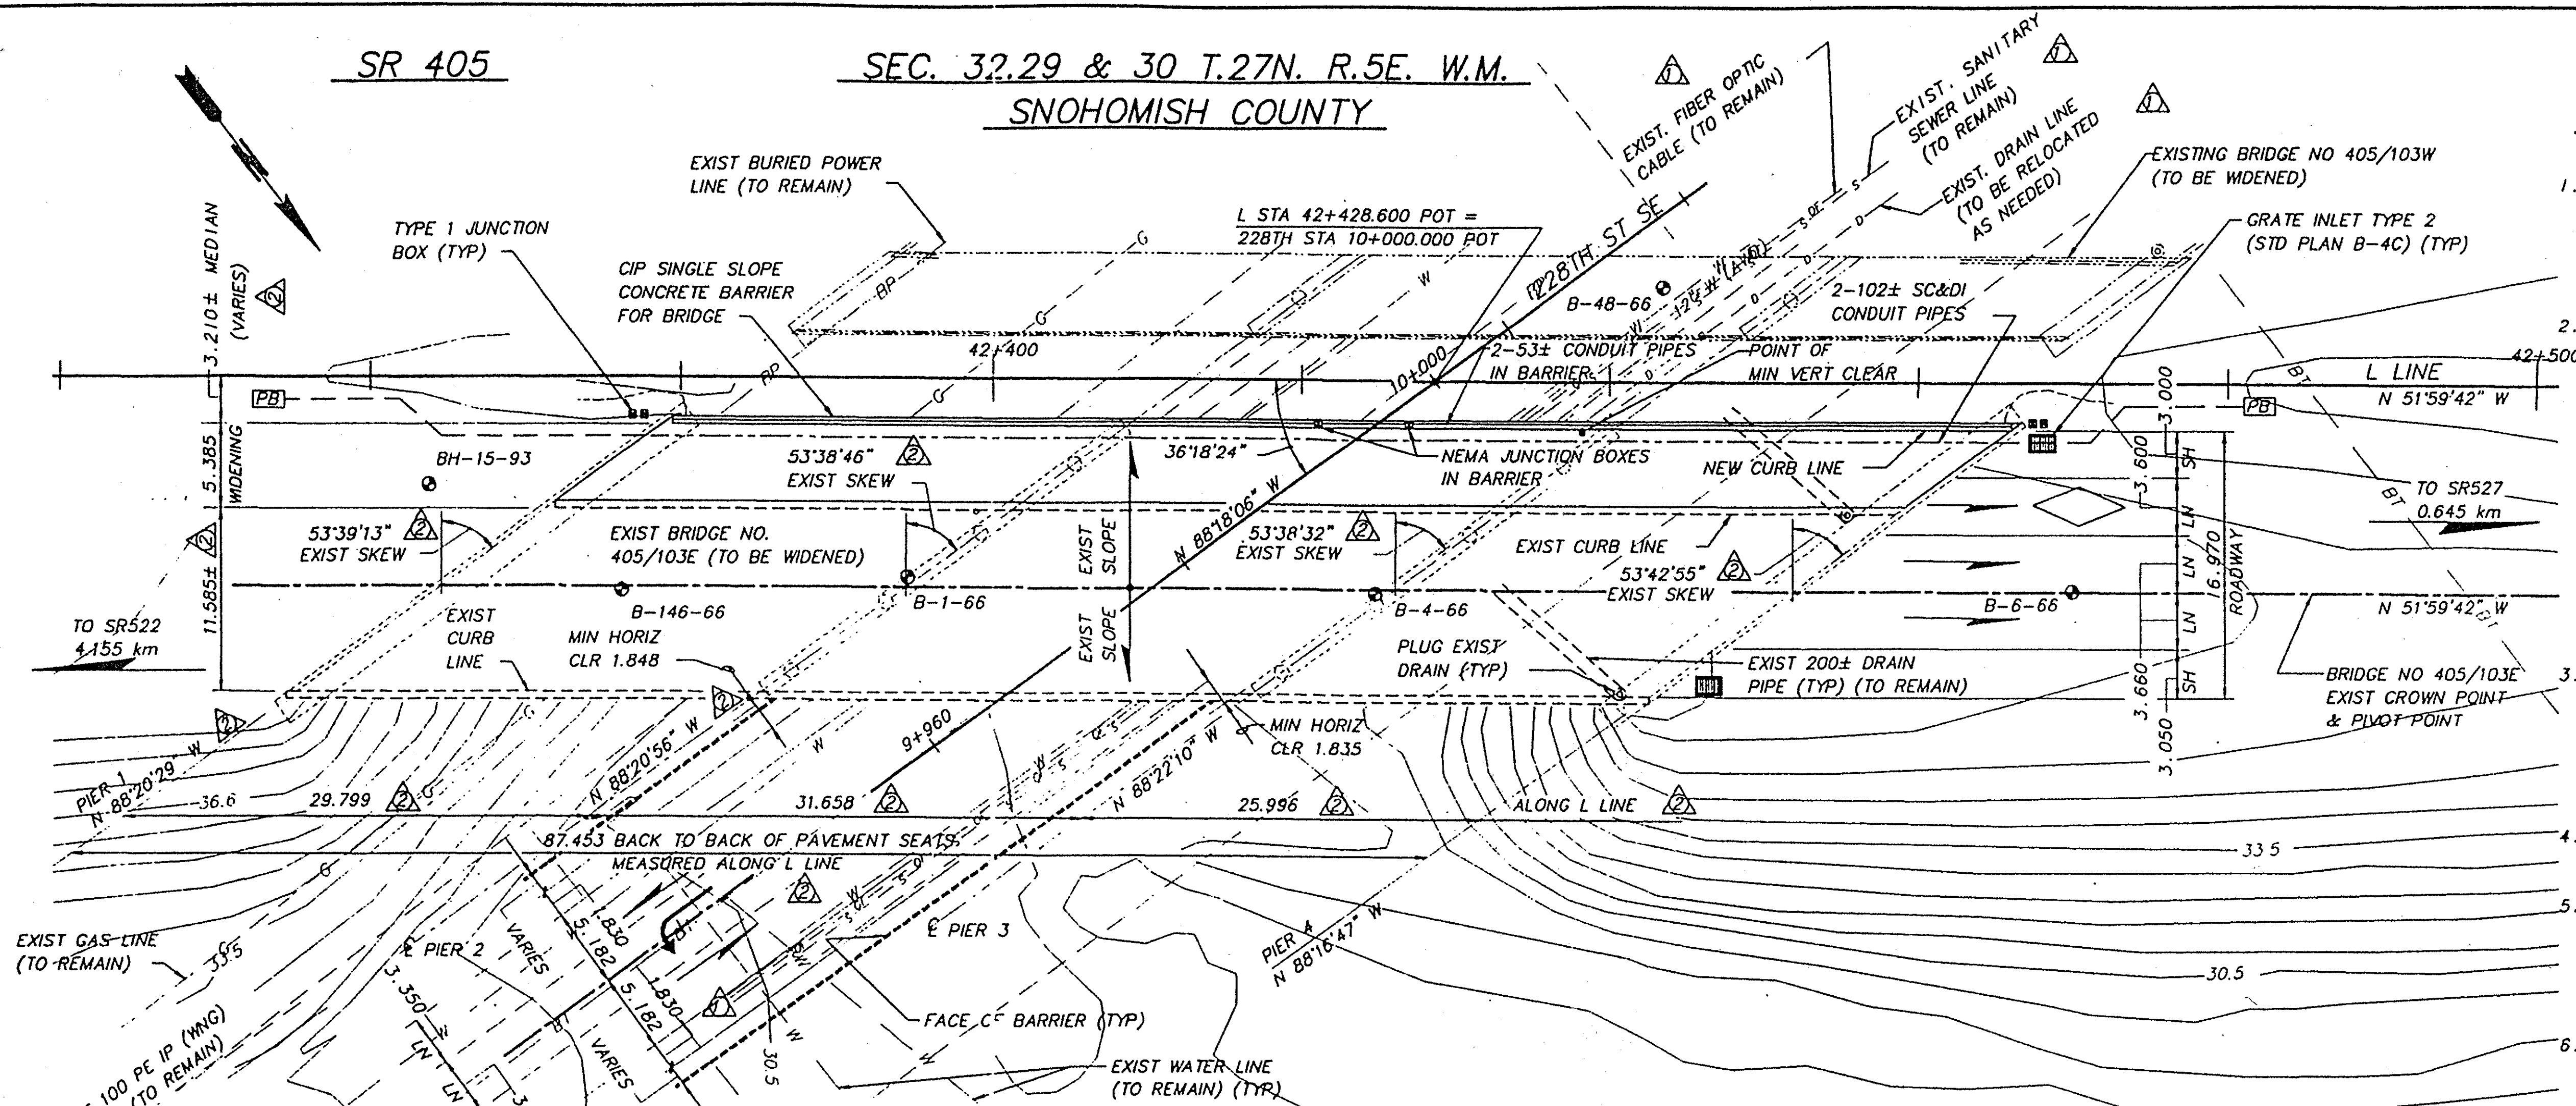


PLAN - EAST BRIDGE  
BEARINGS OF ALL PIER WIDENING TO MATCH EXISTING

METRIC LEGEND:

- 126.175 DENOTES METERS
- 175 DENOTES MILLIMETERS
- SOIL BORING TEST HOLE
- IDENTIFIES SECTION, VIEW OR DETAIL
- TAKEN OR SHOWN ON BRIDGE SHEET 12
- TAKEN OR SHOWN ON THE SAME SHEET

1. ALL MATERIAL AND WORKMANSHIP SHALL BE IN ACCORDANCE WITH THE REQUIREMENTS OF THE WASHINGTON STATE DEPARTMENT OF TRANSPORTATION STANDARD SPECIFICATIONS FOR ROAD, BRIDGE AND MUNICIPAL CONSTRUCTION METRIC DATED 1996, AND AMENDMENTS.
2. THE WIDENED PORTION OF THIS STRUCTURE HAS BEEN DESIGNED IN ACCORDANCE WITH THE REQUIREMENTS OF THE AASHTO STANDARD SPECIFICATIONS FOR HIGHWAY BRIDGES FIFTEENTH EDITION - 1992 AND INTERIMS THROUGH 1995. ALL PRESTRESSED CONCRETE ELEMENTS HAVE BEEN DESIGNED FOR SERVICE LOAD STRESS AND CHECKED FOR THE REQUIREMENTS OF LOAD FACTOR DESIGN. ALL NEW STRUCTURAL ELEMENTS ARE DESIGNED IN ACCORDANCE WITH THE REQUIREMENTS FOR LOAD FACTOR DESIGN. SEISMIC DESIGN OF THE WIDENED STRUCTURE HAS BEEN PERFORMED USING AN ACCELERATION COEFFICIENT OF 0.25 WITH A TYPE II SOIL PROFILE SPECTRUM. SUBSTRUCTURE DETAILS ARE SUBJECT TO CHANGE, DEPENDING UPON FOUNDATION MATERIAL ENCOUNTERED. REINFORCING STEEL FOR FOOTINGS, ABUTMENT WALLS AND COLUMNS SHALL NOT BE CUT UNTIL FINAL FOOTING ELEVATIONS HAVE BEEN DETERMINED AND SUBSTRUCTURE DETAILS HAVE BEEN MODIFIED IF NECESSARY. THE MAXIMUM DESIGN SOIL PRESSURE IS 290 kPa FOR PIERS 1 & 4 AND 770 kPa FOR PIERS 2 & 3.
3. THE CONCRETE IN THE ROADWAY DECK SHALL BE CLASS 28D. THE CONCRETE IN THE SEALS SHALL BE CLASS 28W. ALL OTHER CAST-IN-PLACE CONCRETE SHALL BE CLASS 28, EXCEPT WHERE SPECIFICALLY SHOWN OTHERWISE ON THE PLANS.
4. THE CONCRETE SEALS AT PIERS 2 & 3 ARE DESIGNED FOR A WATER SURFACE ELEVATION OF 28.000. AFTER SEALS ARE PLACED, COFFERDAMS SHALL NOT BE DEWATERED WHEN THE WATER LEVEL IS ABOVE ELEVATION OF 28.000. PROVISIONS SHALL BE PROVIDED TO FLOOD THE COFFERDAM IN THE EVENT THAT THE WATER SURFACE RISES ABOVE THE DESIGN ELEVATION.
5. FALSEWORK SHALL BE CAREFULLY RELEASED TO PREVENT IMPACT OR UNDUE STRESS IN THE STRUCTURE. THE TRAFFIC BARRIER SHALL NOT BE PLACED UNTIL THE FALSEWORK HAS BEEN RELEASED.
6. UNLESS OTHERWISE SHOWN ON THE PLANS, CONCRETE COVER MEASURED FROM THE FACE OF THE CONCRETE TO THE FACE OF ANY REINFORCEMENT STEEL SHALL BE 50 AT THE TOP OF THE ROADWAY SLAB, 25 AT THE BOTTOM OF THE ROADWAY SLAB, 50 AT THE TOP OF THE FOOTING, 75 AT THE BOTTOM OF THE FOOTINGS AND 40 AT ALL OTHER LOCATIONS.
7. THE BACKFILL BEHIND THE PIER ABUTMENTS MAY BE PLACED PRIOR TO PLACEMENT OF THE SUPERSTRUCTURE.
8. ALL EXISTING DIMENSIONS AND ELEVATIONS SHALL BE MEASURED & VERIFIED IN THE FIELD BY THE CONTRACTOR PRIOR TO ORDERING OR FABRICATING ANY MATERIAL (SEE SPECIAL PROVISIONS).

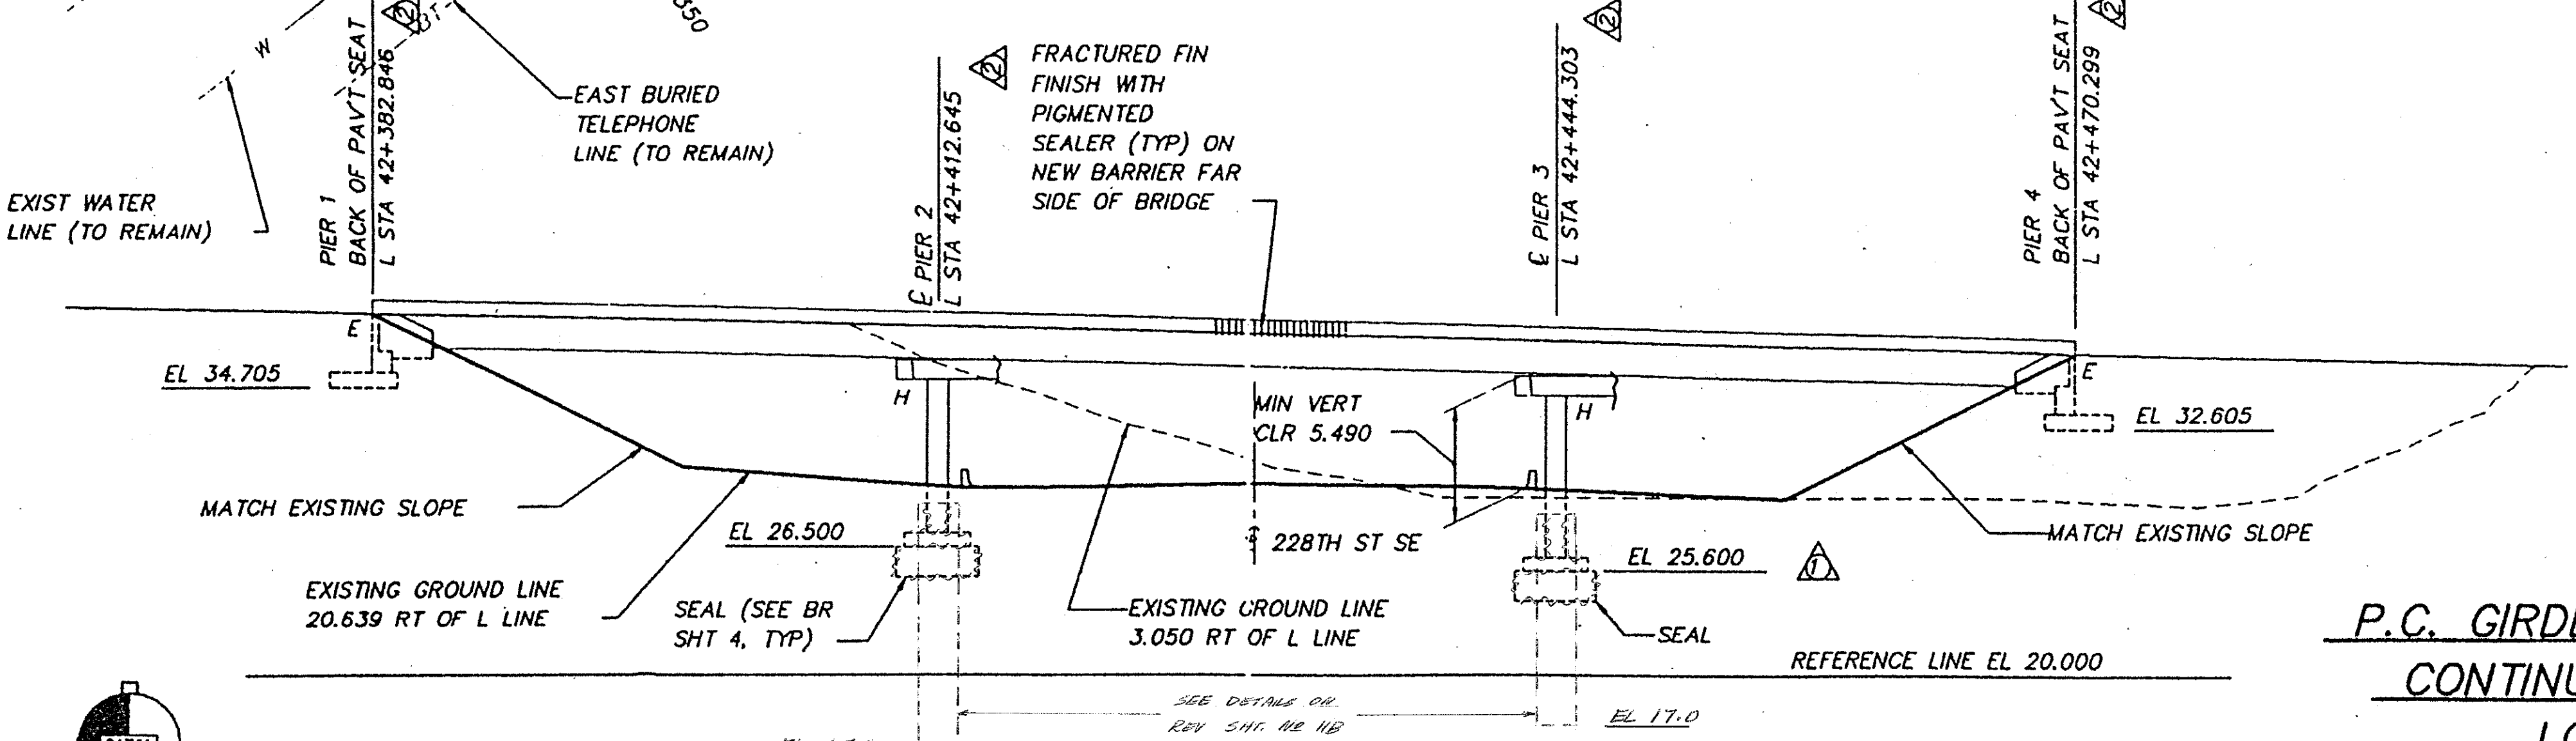

ELEVATION

SEE STANDARD PLAN H-9 FOR EMBANKMENT DETAILS AT BRIDGE ENDS  
SEE BRIDGE SHEET 4 FOR TEMPORARY CONSTRUCTION OPENING ALONG 228TH ST SE

**P.C. GIRDERS (W58MG) WIDENING  
CONTINUOUS FOR LIVE LOAD  
LOADING: HS-25  
OR  
TWO 107 KN AXLES @ 1.220 CTRS**

**FOR "AS CONSTRUCTED  
PLANS" ONLY**

SR 405 JOB NO. 7079 SHEET 1 OF 31

BRIDGE DESIGN ENGR	C.C. RUTH	4/96							
SUPERVISOR									
DESIGNED BY	M. TRAGESSER	6/96							
CHECKED BY	S. ANDERSON	6/96							
DATE									
BRIDGE PROJECTS ENGR	K.N. KIRKER	4/96	10/97	CHANGED ORDER 25	M2				
PRELIM PLAN BY	Y. TEO	3/96	9/97	REVISED AS-BUILT SURVEY DATA	M.T				
ARCHITECT/SPECIALIST	A. YOUNG	3/96		REVISED PIER 3 FOOTING-FIT UTILITIES	J2				
				DATE	REVISION	BY	APPR		


Washington State Department of Transportation  
 BERGER/ABAM ENGINEERS INC.  
 33301 8TH AVENUE SOUTH  
 FEDERAL WAY, WASHINGTON 98003-3330  
 (206)431-2300 FAX:(206)431-2320

Washington State Department of Transportation


SR 405  
 BOTHELL TO SWAMP CREEK I/C  
 HOV LANES - STAGE 1  
 228TH BRIDGE 405/103E  
 LAYOUT

BRIDGE SHEET NO. 1  
 SHEET 499 OF 663 SHEETS

LOT# 2, Mon Oct 13 1997 7:51am FILENAME: W:\496077\405-103E\1.dwg SCALE: 250

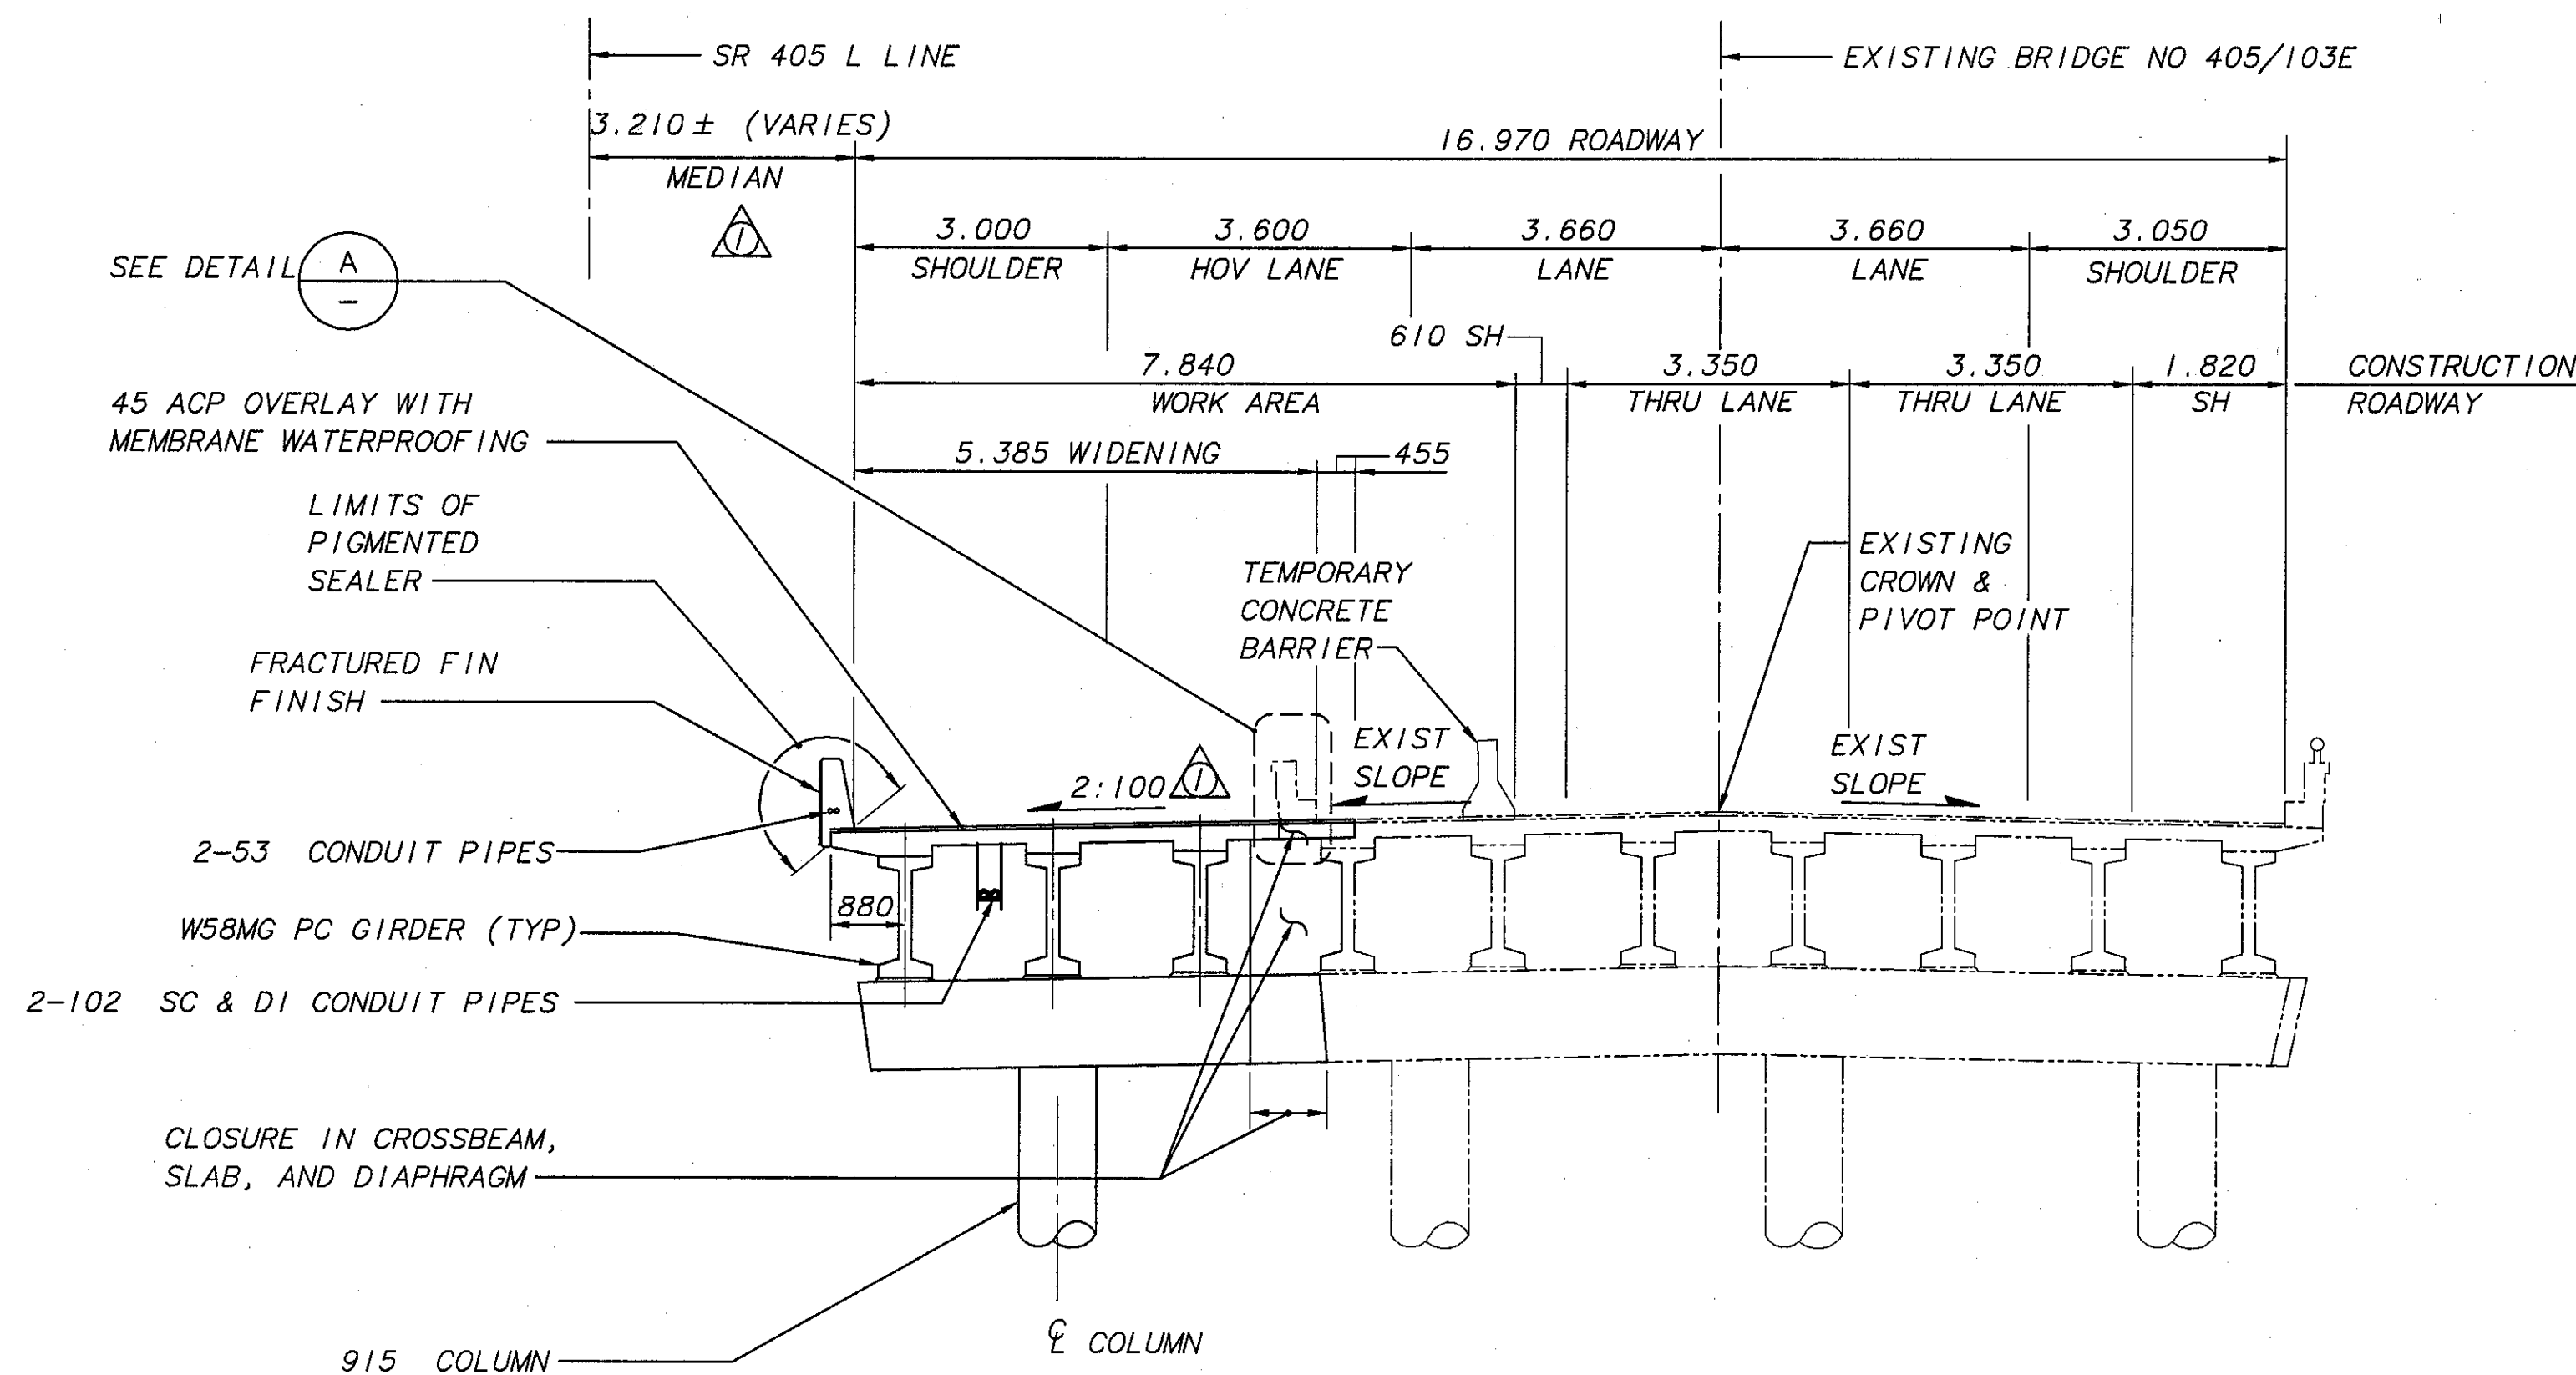

**TYPICAL SECTION**  
ALL DIMENSIONS NORMAL TO L LINE

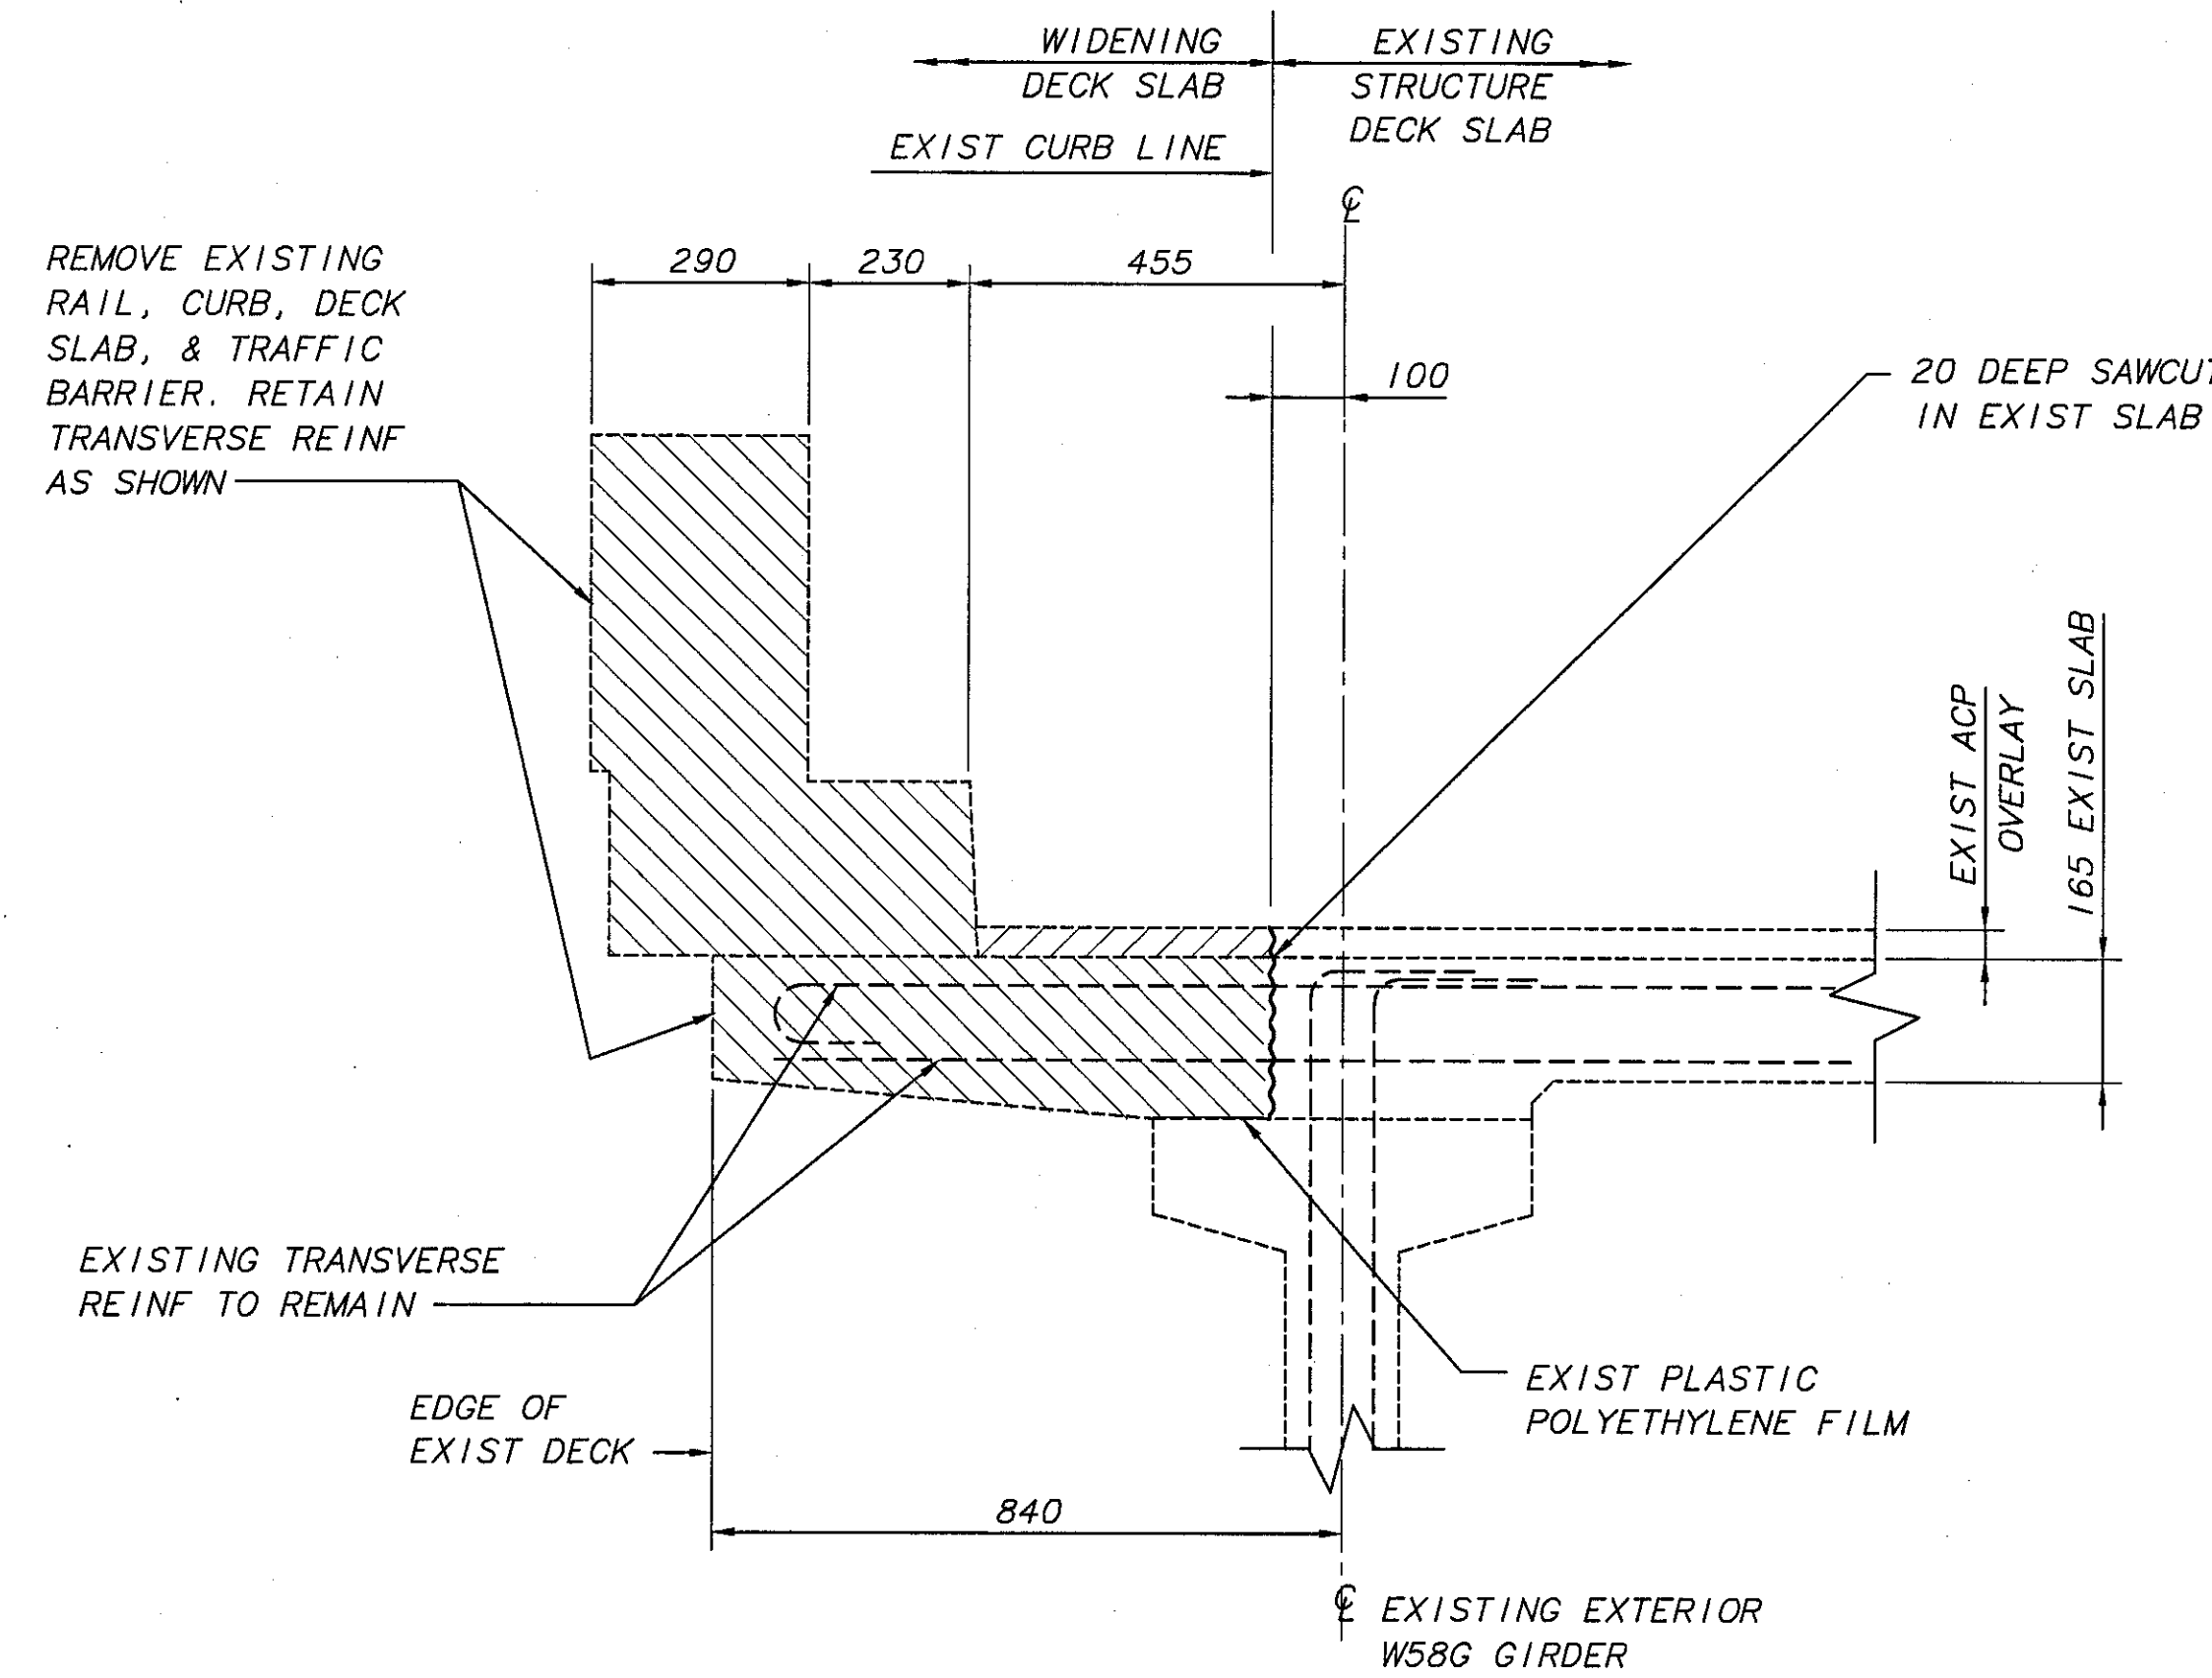

**DEMOLITION DETAIL**  
NOTE: FOR REMOVAL DETAILS @ PIER 1 & 4, SEE BRIDGE SHEET 6 & 7.


**NOTES:**

1. THE DIMENSIONS SHOWN ON THE PLANS ARE BASED ON ORIGINAL CONSTRUCTION RECORDS TOGETHER WITH FIELD SURVEY DATA. THE WIDENED PORTION OF THE STRUCTURE IS INTENDED TO MATCH THE EXISTING BRIDGE. THESE DIMENSIONS AND ELEVATIONS SHALL BE VERIFIED BY THE CONTRACTOR IN THE FIELD.

PLOTED: Mon Oct 13 1997 4:26pm FILENAME: V:\960771\405-103E\2.dwg SCALE: 7.5

SR 405 JOB NO. 7079 SHEET 2 OF 31

BRIDGE DESIGN ENGR		REGION NO.	STATE	FED AID PROJ NO	SHEET NO.	TOTAL SHEETS
SUPERVISOR		1	WASH			
DESIGNED BY	M. TRAGESSER 6/96	JOB NUMBER		96W035		
CHECKED BY	S. ANDERSON 6/96	CONTRACT NO.		5054		
DETAILED BY	R. MOHN 6/96	DATE	REVISION	BY	APPR	
BRIDGE PROJECTS ENGR		10/97	REVISED AS-BUILT SURVEY DATA	MLT		
PRELIM PLAN BY						
ARCHITECT/SPECIALIST						

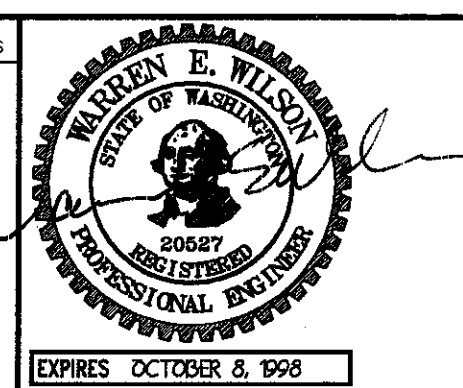

**BERGER/ABAM**  
ENGINEERS IN C.  
33301 9TH AVENUE SOUTH  
FEDERAL WAY, WASHINGTON 98003-4395  
(206)431-2300 FAX: (206)431-2260



SR 405  
BOTHELL TO SWAMP CREEK I/C  
HOV LANES - STAGE 1  
228TH BRIDGE 405/103E  
TYPICAL SECTION & DEMOLITION DETAILS

BRIDGE SHEET NO. 2  
SHEET 500 OF 663 SHEETS

BRIDGE NO. 405/103E  
EXISTING ELEVATIONS

L LINE STATION	ACP ELEVATION LEFT CURB LINE $\Delta$	ACP ELEVATION PROFILE GRADE LINE	ACP ELEVATION RIGHT CURB LINE	CCP ELEVATION SAW-CUT LINE $\Delta$
42+355.360	-	-	38.632	-
42+357.000	-	38.716	38.598	-
42+360.000	-	38.640	38.550	-
42+363.000	-	38.585	38.486	-
42+366.000	-	38.498	38.401	-
42+369.000	-	38.435	38.328	-
42+371.340	-	-	-	-
42+372.000	38.285	38.372	38.250	38.241
42+375.000	38.220	38.316	38.170	38.184
42+378.000	38.154	38.257	38.092	38.124
42+381.000	38.090	38.187	38.019	38.057
42+384.000	38.024	38.115	37.946	37.993
42+387.000	37.952	38.044	37.871	37.920
42+390.000	37.880	37.968	37.791	37.843
42+393.000	37.806	37.890	37.719	37.767
42+396.000	37.729	37.818	37.654	37.690
42+399.000	37.657	37.749	37.587	37.614
42+402.000	37.581	37.679	37.516	37.546
42+405.000	37.514	37.612	37.446	37.479
42+408.000	37.450	37.544	37.379	37.413
42+411.000	37.382	37.471	37.308	37.346
42+414.000	37.309	37.398	37.232	37.276
42+417.000	37.242	37.321	37.162	37.204
42+420.000	37.165	37.242	37.098	37.130
42+423.000	37.090	37.167	37.038	37.055
42+426.000	37.020	37.091	36.967	36.982
42+429.000	36.954	37.022	36.895	36.908
42+432.000	36.878	36.959	36.821	36.833
42+435.000	36.805	36.893	36.747	36.758
42+438.000	36.737	36.817	36.665	36.690
42+441.000	36.660	36.740	36.583	36.624
42+442.410	-	-	36.542	-
42+444.000	36.591	36.653	-	36.547
42+447.000	36.508	36.563	-	36.469
42+450.000	36.437	36.474	-	36.396
42+453.000	36.363	36.388	-	36.319
42+456.925	-	-	-	36.216
42+456.000	36.282	36.308	-	36.237
42+458.610	36.226	-	-	-


228TH ST SE  
EXISTING ELEVATIONS

228TH ST SE STATION	LEFT						228TH ST SE		RIGHT					
	BARRIER		FOG STRIPE		LANE EDGE		CENTERLINE	LANE EDGE		FOG STRIPE		BARRIER		
	OFFSET	ELEVATION	OFFSET	ELEVATION	OFFSET	ELEVATION	ELEVATION	OFFSET	ELEVATION	OFFSET	ELEVATION	OFFSET	ELEVATION	
9+960.376							29.858							
9+963.424							29.801							
9+966.472							29.745	5.182	29.663	7.010	29.595	9.309	29.519	
9+969.520	8.580	29.532	7.010	29.554	5.182	29.587	29.688	5.182	29.627	7.010	29.561	9.091	29.491	
9+972.568	8.549	29.504	7.010	29.525	5.182	29.556	29.831	5.182	29.591	7.010	29.527	8.843	29.463	
9+975.616	8.529	29.476	7.010	29.495	5.182	29.526	29.600	5.182	29.554	7.010	29.493	8.623	29.435	
9+978.664	8.510	29.448	7.010	29.466	5.182	29.495	29.574	5.182	29.518	7.010	29.459	8.402	29.407	
9+981.712	8.491	29.420	7.010	29.437	5.182	29.464	29.548	5.182	29.482	7.010	29.425	8.362	29.384	
9+984.760	8.471	29.392	7.010	29.407	5.182	29.434	29.521	5.182	29.446	7.010	29.391	8.379	29.364	
9+987.808	8.454	29.364	7.010	29.378	5.182	29.403	29.495	5.182	29.421	7.010	29.367	8.396	29.344	
9+990.856	8.494	29.345	7.010	29.360	5.182	29.384	29.482	5.182	29.408	7.010	29.353	8.371	29.324	
9+993.904	8.503	29.332	7.010	29.349	5.182	29.374	29.470	5.182	29.396	7.010	29.340	8.347	29.303	
9+996.952	8.512	29.318	7.010	29.338	5.182	29.364	29.457	5.182	29.382	7.010	29.326	8.322	29.283	
10+000.000	8.521	29.305	7.010	29.327	5.182	29.353	29.445	5.182	29.370	7.010	29.312	8.298	29.263	
10+003.048	8.503	29.302	7.010	29.325	5.182	29.351	29.442	5.182	29.380	7.010	29.321	8.304	29.274	
10+006.096	8.445	29.314	7.010	29.334	5.182	29.358	29.453	5.182	29.393	7.010	29.335	8.347	29.290	
10+009.144	8.388	29.326	7.010	29.343	5.182	29.365	29.463	5.182	29.406	7.010	29.348	8.391	29.307	
10+012.192	8.331	29.339	7.010	29.353	5.182	29.372	29.474	5.182	29.420	7.010	29.362	8.434	29.323	
10+015.240	8.315	29.353	7.010	29.362	5.182	29.379	29.499	5.182	29.440	7.010	29.382	8.440	29.344	
10+018.288	8.373	29.384	7.010	29.387	5.182	29.405	29.540	5.182	29.478	7.010	29.420	8.400	29.380	
10+021.336	8.431	29.414	7.010	29.434	5.182	29.453	29.581	5.182	29.516	7.010	29.458	8.361	29.416	
10+024.384	8.522	29.450	7.010	29.481	5.182	29.502	29.623	5.182	29.554	7.010	29.496	8.322	29.452	
10+027.432	8.782	29.509	7.010	29.528	5.182	29.550	29.664	5.182	29.592	7.010	29.534	8.283	29.488	
10+030.480	9.101	29.524	7.010	29.574	5.182	29.599	29.719	5.182	29.630	7.010	29.572	8.286	29.526	
10+033.528	9.443	29.535	7.010	29.621	5.182	29.647	29.775	5.182	29.666	7.010	29.609	8.295	29.566	
10+036.576	9.784	29.546	7.010	29.679	5.182	29.726	29.831	5.182	29.702	7.010	29.647	8.304	29.606	
10+039.624			7.010	29.758	5.182	29.805	29.887	5.182	29.738	7.010	29.684	8.312	29.645	
10+042.672			7.010	29.837	5.182	29.885	29.950	5.182	29.801	7.010	29.750	8.338	29.713	
10+045.720			7.010	29.917	5.182	29.964	30.052	5.182	29.896	7.010	29.849	8.385	29.806	
10+048.768			7.010	29.996	5.182	30.043	30.154	5.182	29.991	7.010	29.948	8.432	29.900	
10+051.816			7.010	30.076	5.182	30.122	30.256	5.182	30.087	7.010	30.047	8.480	29.993	
10+054.864							30.357							
10+057.912							30.460							
10+060.960							30.561							

PLOTTED: Mon Oct 13 1997 8:07am FILENAME: v:\a96077\405-103E\3.dwg SCALE: 1

SR 405 JOB NO. 7079 SHEET 3 OF 31

BRIDGE DESIGN ENGR				REGION	STATE	FED AID PROJ NO	SHEET	TOTAL SHEETS
SUPERVISOR				I	WASH			
DESIGNED BY	M. TRAGESSER	6/96						
CHECKED BY	S. ANDERSON	6/96						
DETAILED BY	R. MOHN	6/96						
BRIDGE PROJECTS ENGR								
PRELIM PLAN BY	10/97	REVISED AS-BUILT SURVEY DATA	MLT					
ARCHITECT/SPECIALIST	DATE	REVISION	BY	APPR				
					5054			

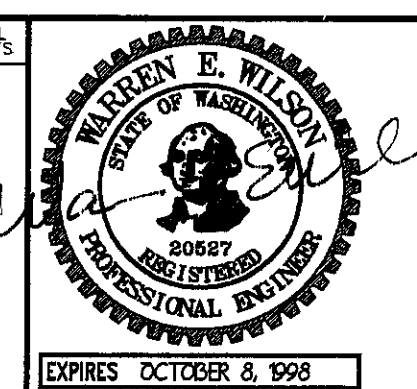

**BERGER/ABAM**  
ENGINEERS INC.  
33301 9TH AVENUE SOUTH  
FEDERAL WAY, WASHINGTON 98003-8380  
(206) 431-8300 FAX: (206) 431-2280




SR 405 BOTHELL TO SWAMP CREEK 1/C HOV LANES - STAGE 1 228TH BRIDGE 405/103E GEOMETRIC DATA	BRIDGE SHEET NO. 3 SHEET 501 OF 663 SHEETS
--	---



LOTTEC: Mon Oct 13 1997 8:34am FILENAME: K:\AS6077\405-103E\15.dwg SCALE: 250

SR 405 JOB NO. 7079 SHEET 5 OF 31

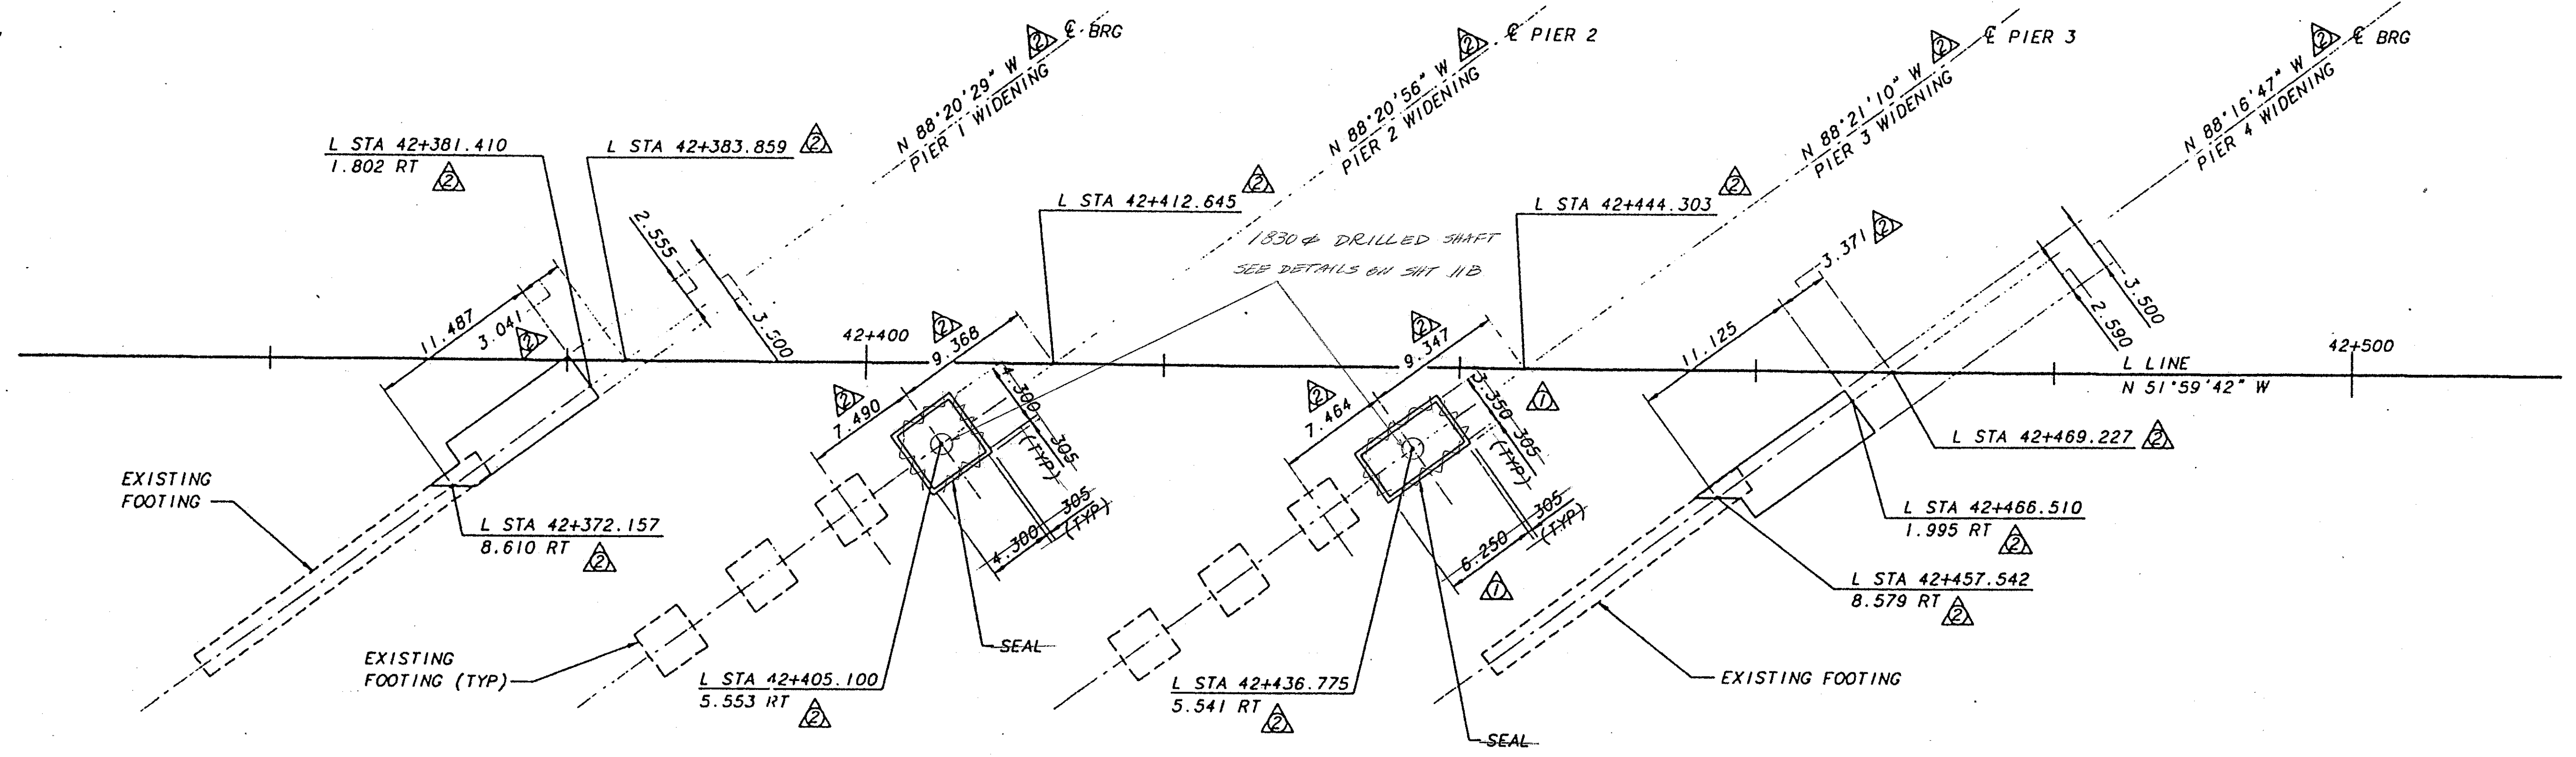


**FOOTING PLAN**


**NOTE:**  
 1. CONTRACTOR SHALL MEASURE & VERIFY EXISTING FOOTING LOCATION, SIZE AND ELEVATIONS PRIOR TO CONSTRUCTION OF NEW FOUNDATIONS.

**FOR "AS CONSTRUCTED PLANS" ONLY**

BRIDGE DESIGN ENGR		REGION NO.	STATE	FED AID PROJ NO.	SHEET NO.	TOTAL SHEETS
SUPERVISOR		1	WASH			
DESIGNED BY	M. TRAGESSER 6/96			JOB NUMBER	96W035	
CHECKED BY	S. ANDERSON 6/96			CONTRACT NO.		
DETAILED BY	R. MOHN 6/96	10/97	REVISOR	M.T	REVISOR	
BRIDGE PROJECTS ENGR		9/97	REVISOR	JZ	REVISOR	
PRELIM PLAN BY			REVISION			
ARCHITECT/SPECIALIST			DATE			

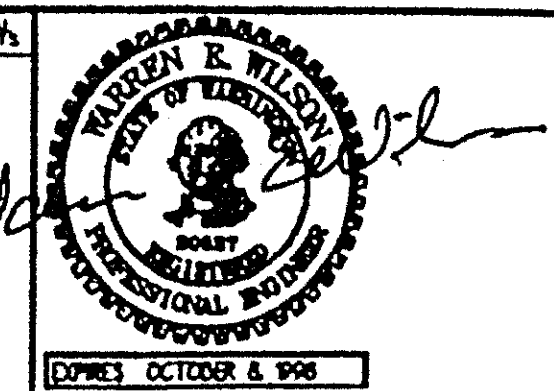


**BERGER/ABAM ENGINEERS INC.**  
 33301 9TH AVENUE, SOUTH  
 FEDERAL WAY, WASHINGTON 98003-4398  
 (206) 431-2300 FAX: (206) 431-2200

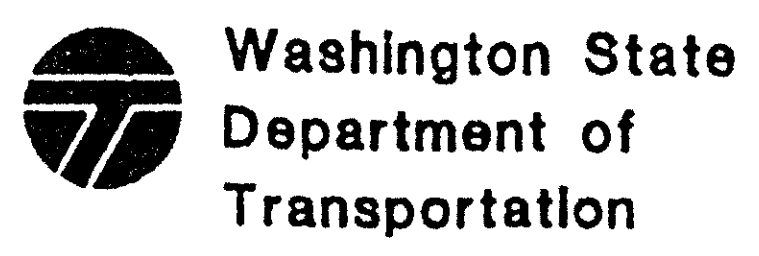


SR 405  
 BOTHELL TO SWAMP CREEK I/C  
 HOV LANES - STAGE 1  
 228TH BRIDGE 405/103E  
**FOOTING PLAN**


BRIDGE SHEET NO. **6**  
 SHEET 503 OF 663 SHEETS

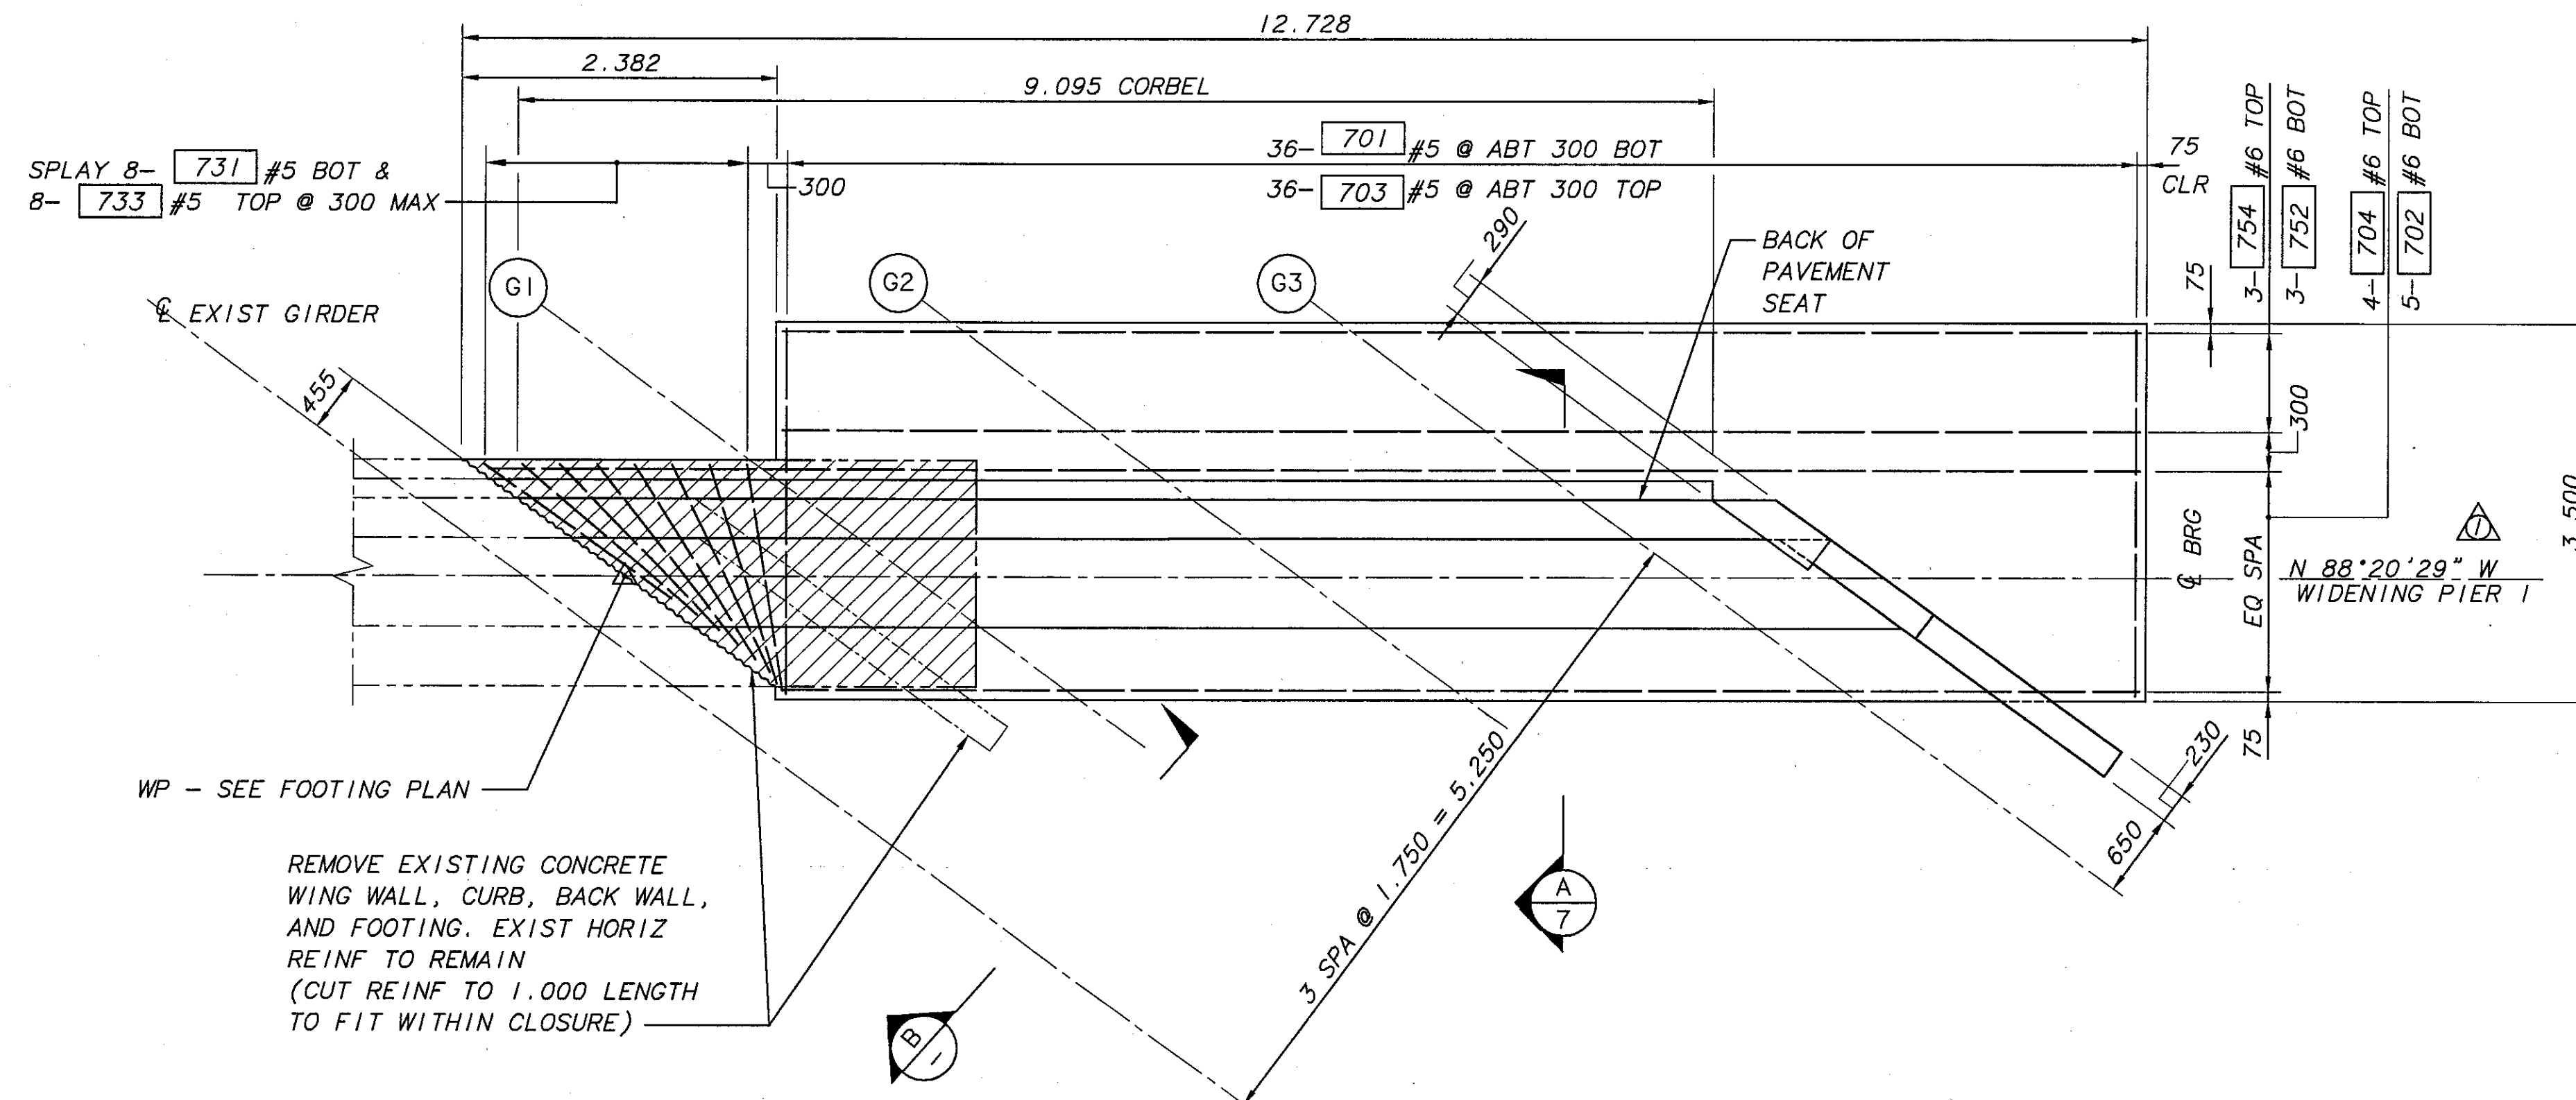

PLAN - PIER 1 FOOTING  
(LOOKING BACK ON STATION)

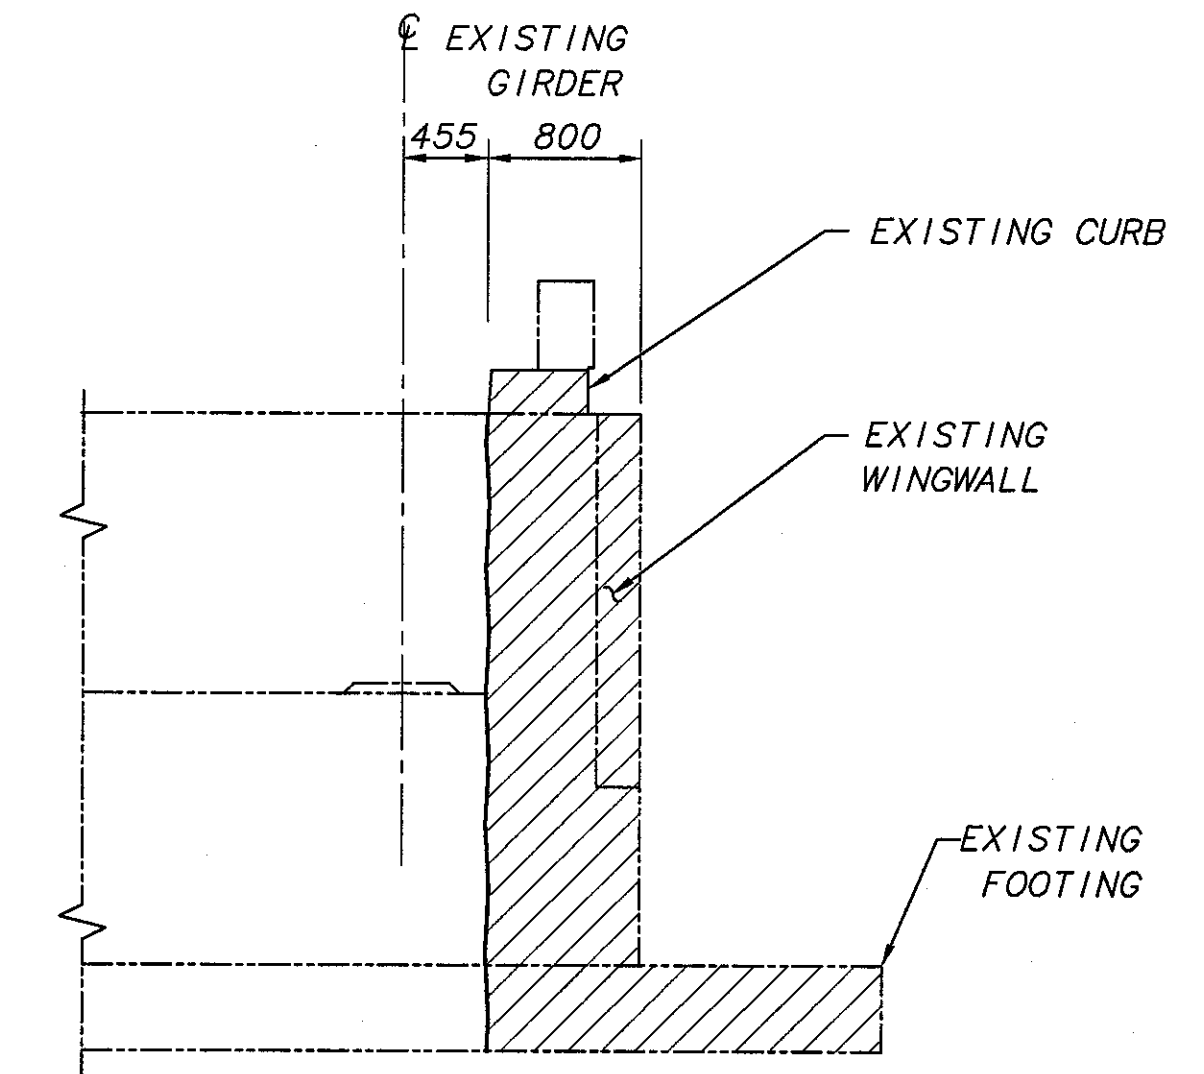

DEMOLITION DETAIL - PIER 1  
(LOOKING ALONG L LINE)

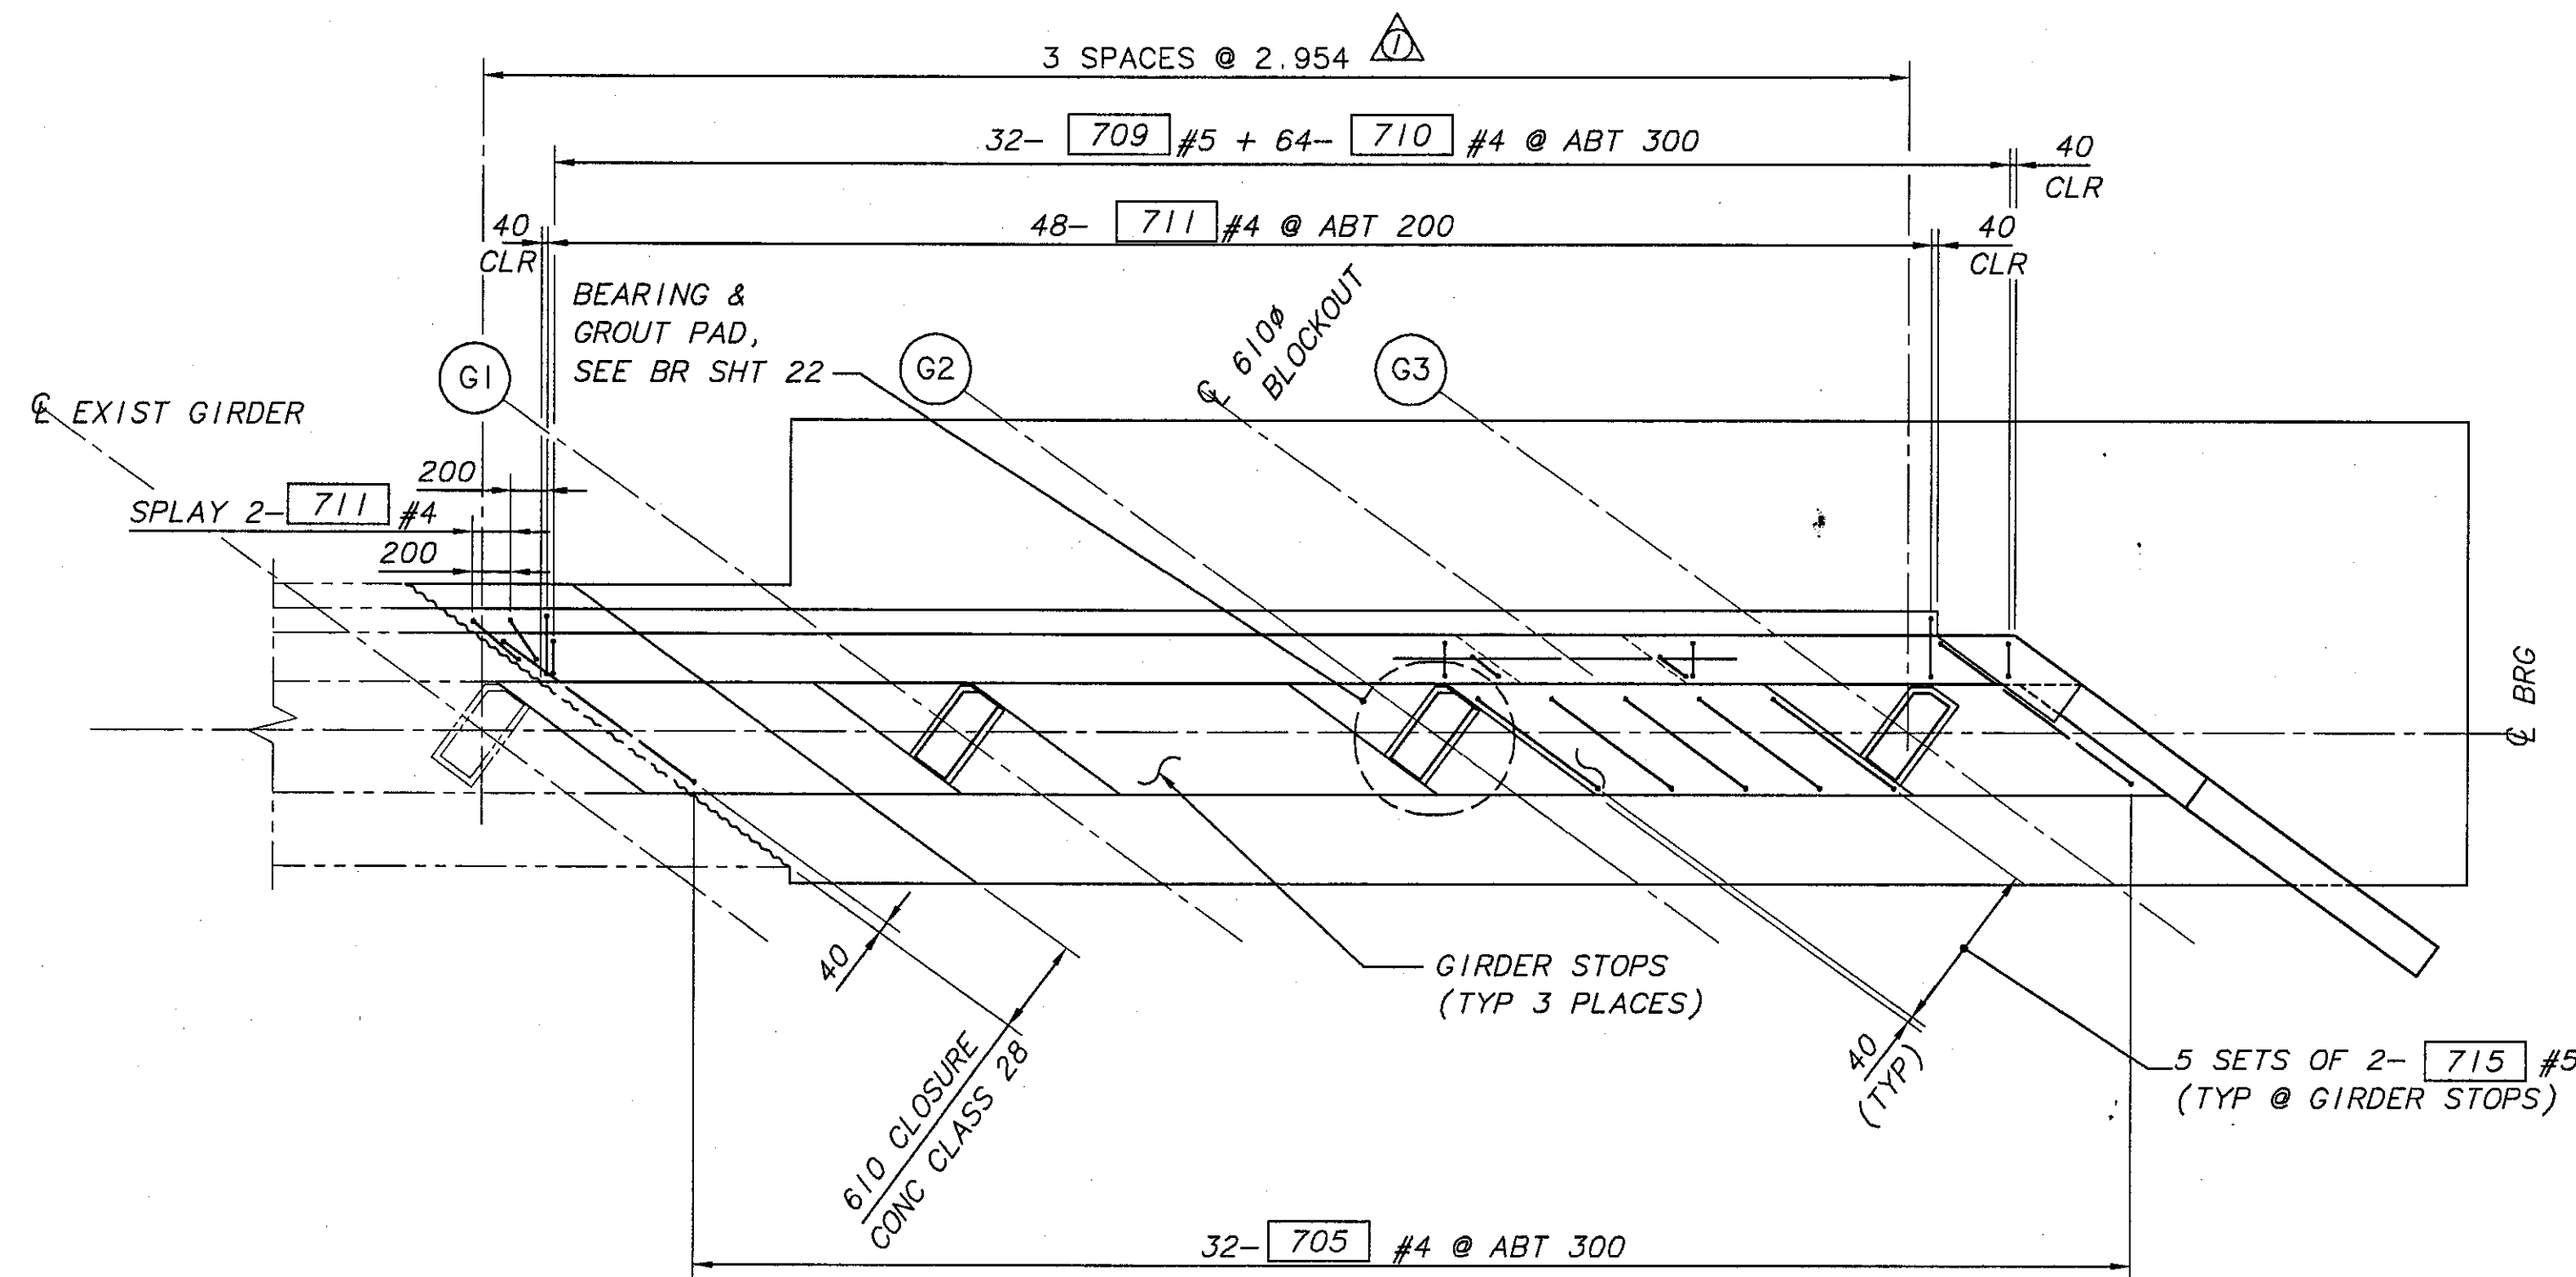


PLAN - PIER 1  
(LOOKING BACK ON STATION)


SR 405 JOB NO. 1079 SHEET 6 OF 31

PLOTTED: Mon Oct 13 1997 4:50pm FILENAME: V:\96077\405-103E\6.dwg SCALE: 40

BRIDGE DESIGN ENGR		REGION NO.	STATE	FED AID PROJ NO.	SHEET NO.	TOTAL SHEETS
SUPERVISOR			1 WASH			
DESIGNED BY	M. TRAGESSER 6/96					
CHECKED BY	S. ANDERSON 6/96					
DETAILED BY	R. MOHN 6/96					
BRIDGE PROJECTS ENGR						
PRELIM PLAN BY	10/97	REVISED AS-BUILT SURVEY DATA	MLT	JOB NUMBER	96W035	
ARCHITECT/SPECIALIST	DATE	REVISION	BY	APPR	5054	CONTRACT NO.

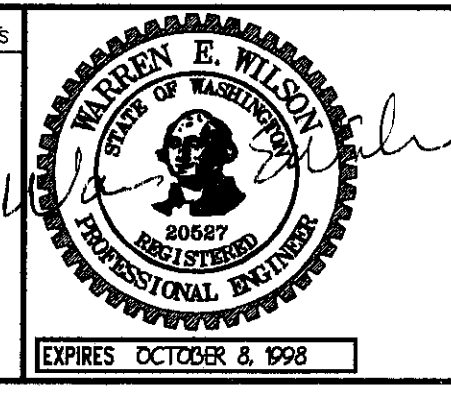

**BERGER/ABAM**  
ENGINEERS INC.  
33301 9TH AVENUE SOUTH  
FEDERAL WAY, WASHINGTON 98003-8385  
(206)431-2300 FAX: (206)431-2250

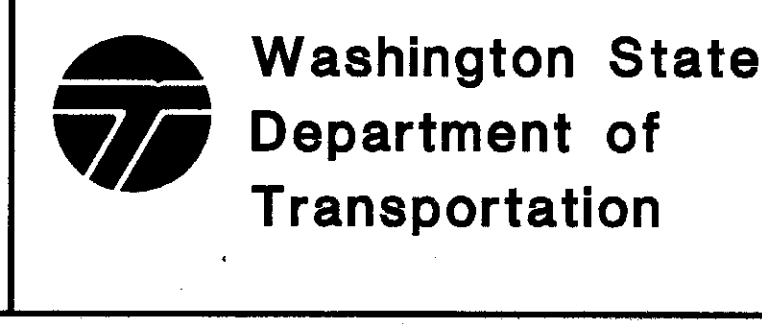


SR 405  
BOTHELL TO SWAMP CREEK I/C  
HOV LANES - STAGE 1  
228TH BRIDGE 405/103E  
PIER 1 PLAN & DETAILS


BRIDGE SHEET NO. 6  
SHEET 504 OF 663 SHEETS

PLOTTED: Mon Oct 13 1997 4:53pm FILENAME: V:\A96077\405-103E\7.dwg SCALE: 40

SR 405 JOB NO. 7079 SHEET 7 OF 31

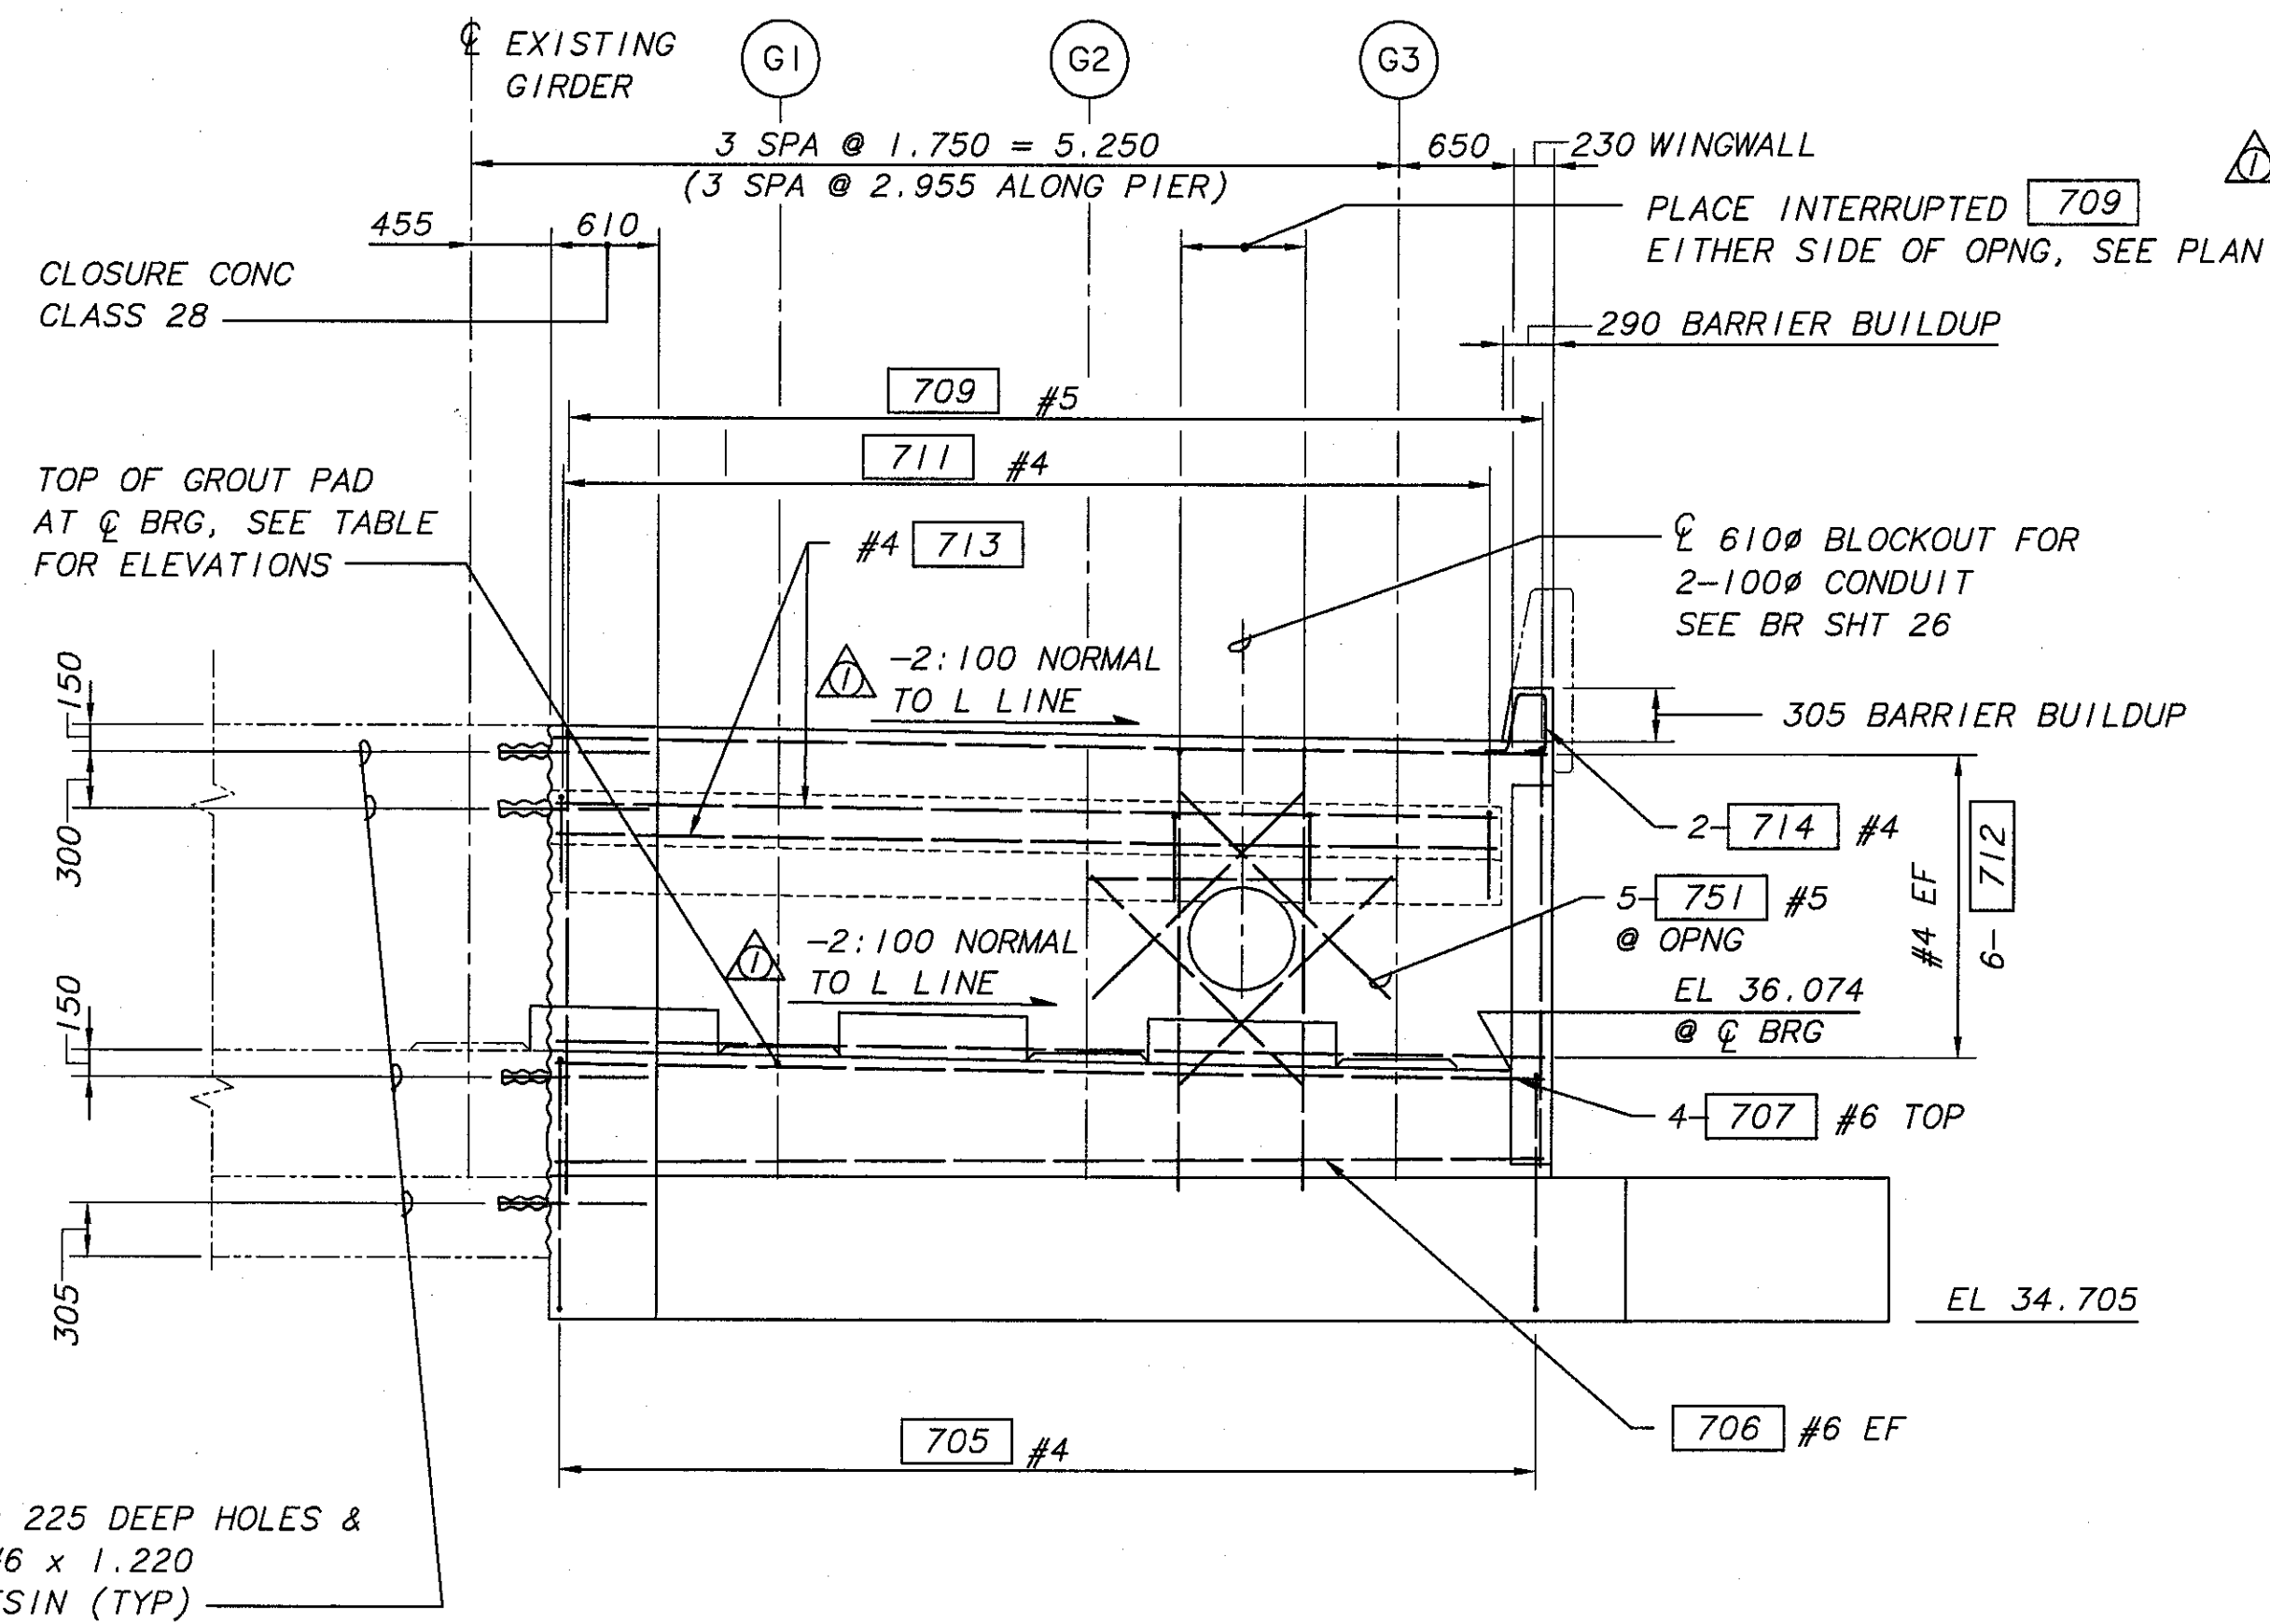


**ELEVATION - PIER 1**  
(DIMENSIONS NORMAL TO L LINE)  
(LOOKING BACK ON STATION)

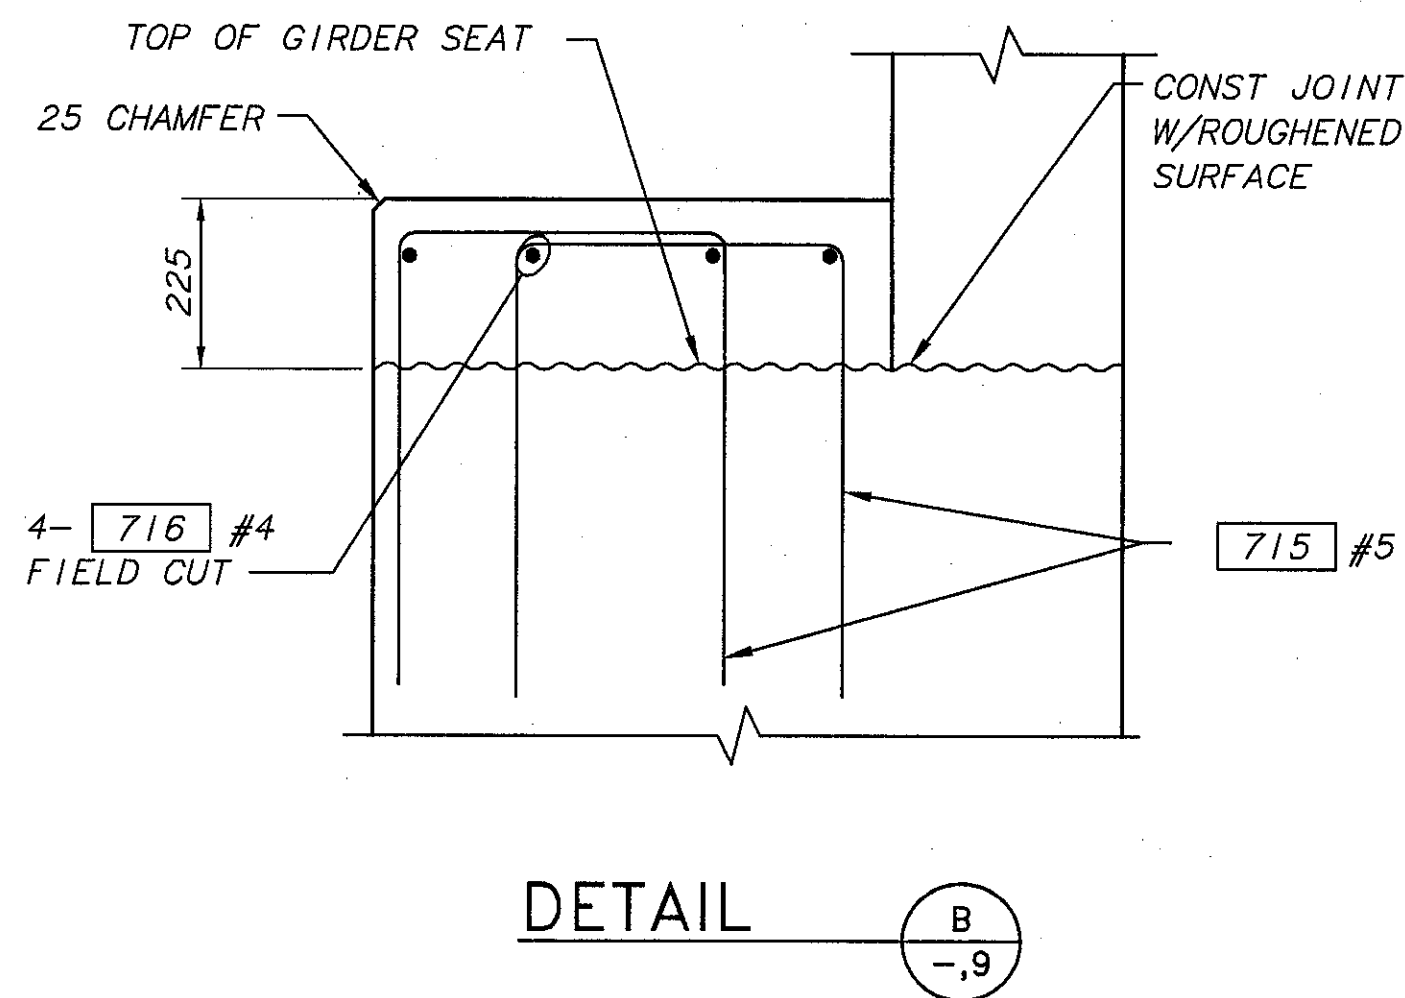


**DETAIL** B  
-9

TOP OF GROUT PAD ELEVATIONS			
GIRDER	G1	G2	G3
ELEVATION	36.334	36.252	36.168

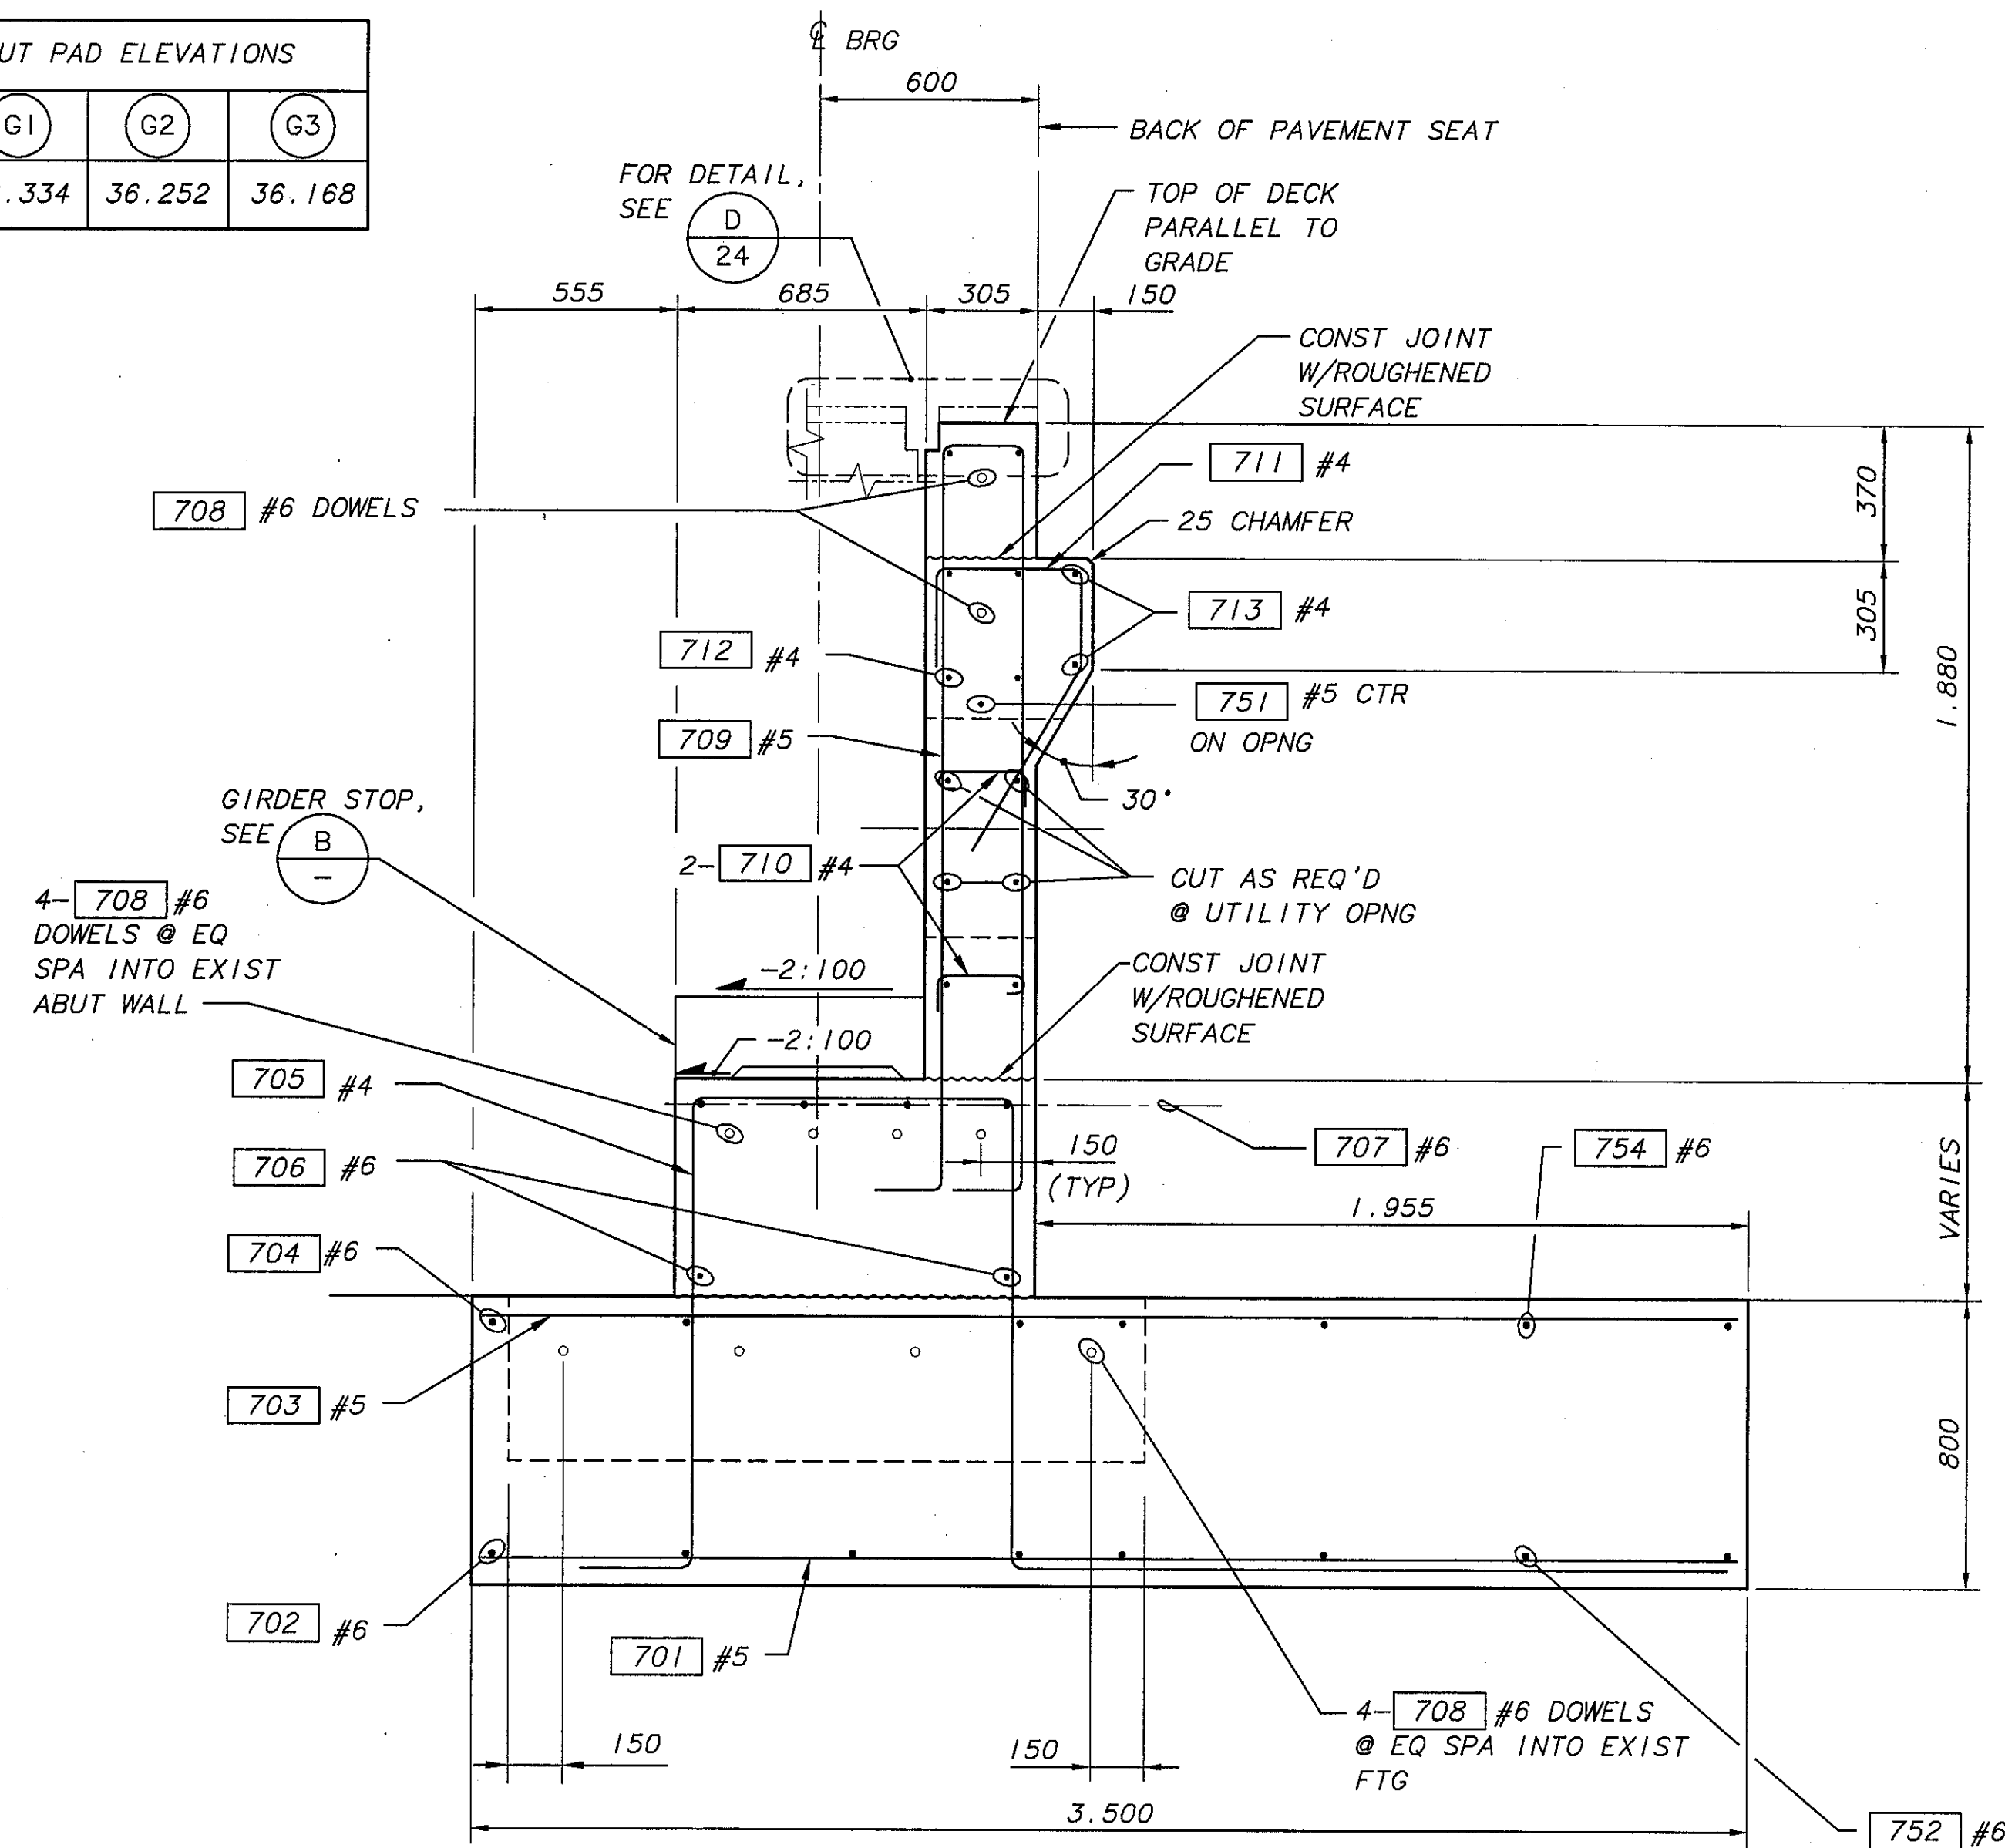

**SECTION** A  
6

BRIDGE DESIGN ENGR		REGION	STATE	FED AID PROJ NO	SHEET	TOTAL SHEETS
SUPERVISOR		1	WASH			
DESIGNED BY	M. TRAGESSER 6/96	JOB NUMBER				
CHECKED BY	S. ANDERSON 6/96	96W035				
DETAILED BY	R. MOHN 6/96	CONTRACT NO.				
BRIDGE PROJECTS ENGR		DATE				
PRELIM PLAN BY	10/97	REVISED AS-BUILT SURVEY DATA				
ARCHITECT/SPECIALIST		MLT	BY	APPR		
					5054	

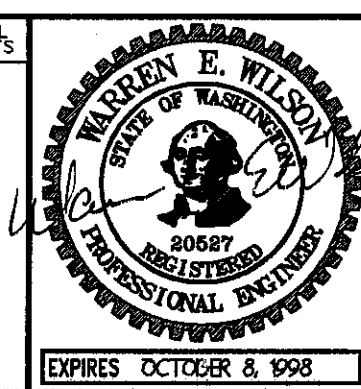

**BERGER/ABAM**  
ENGINEERS INC.  
33301 9TH AVENUE SOUTH  
FEDERAL WAY, WASHINGTON 98003-4386  
(206)431-2300 FAX: (206)431-2280


**Washington State**  
Department of  
Transportation

SR 405  
BOTHELL TO SWAMP CREEK I/C  
HOV LANES - STAGE 1  
228TH BRIDGE 405/103E  
PIER 1 ELEVATION & SECTIONS


BRIDGE SHEET NO. 7  
SHEET 505 OF 663 SHEETS

PLOTTED: Mon Oct 13 1997 4:55pm FILENAME: V:\96077\405-103E\8.dwg SCALE: 40


SR 405 JOB NO. 7079 SHEET 8 OF 31

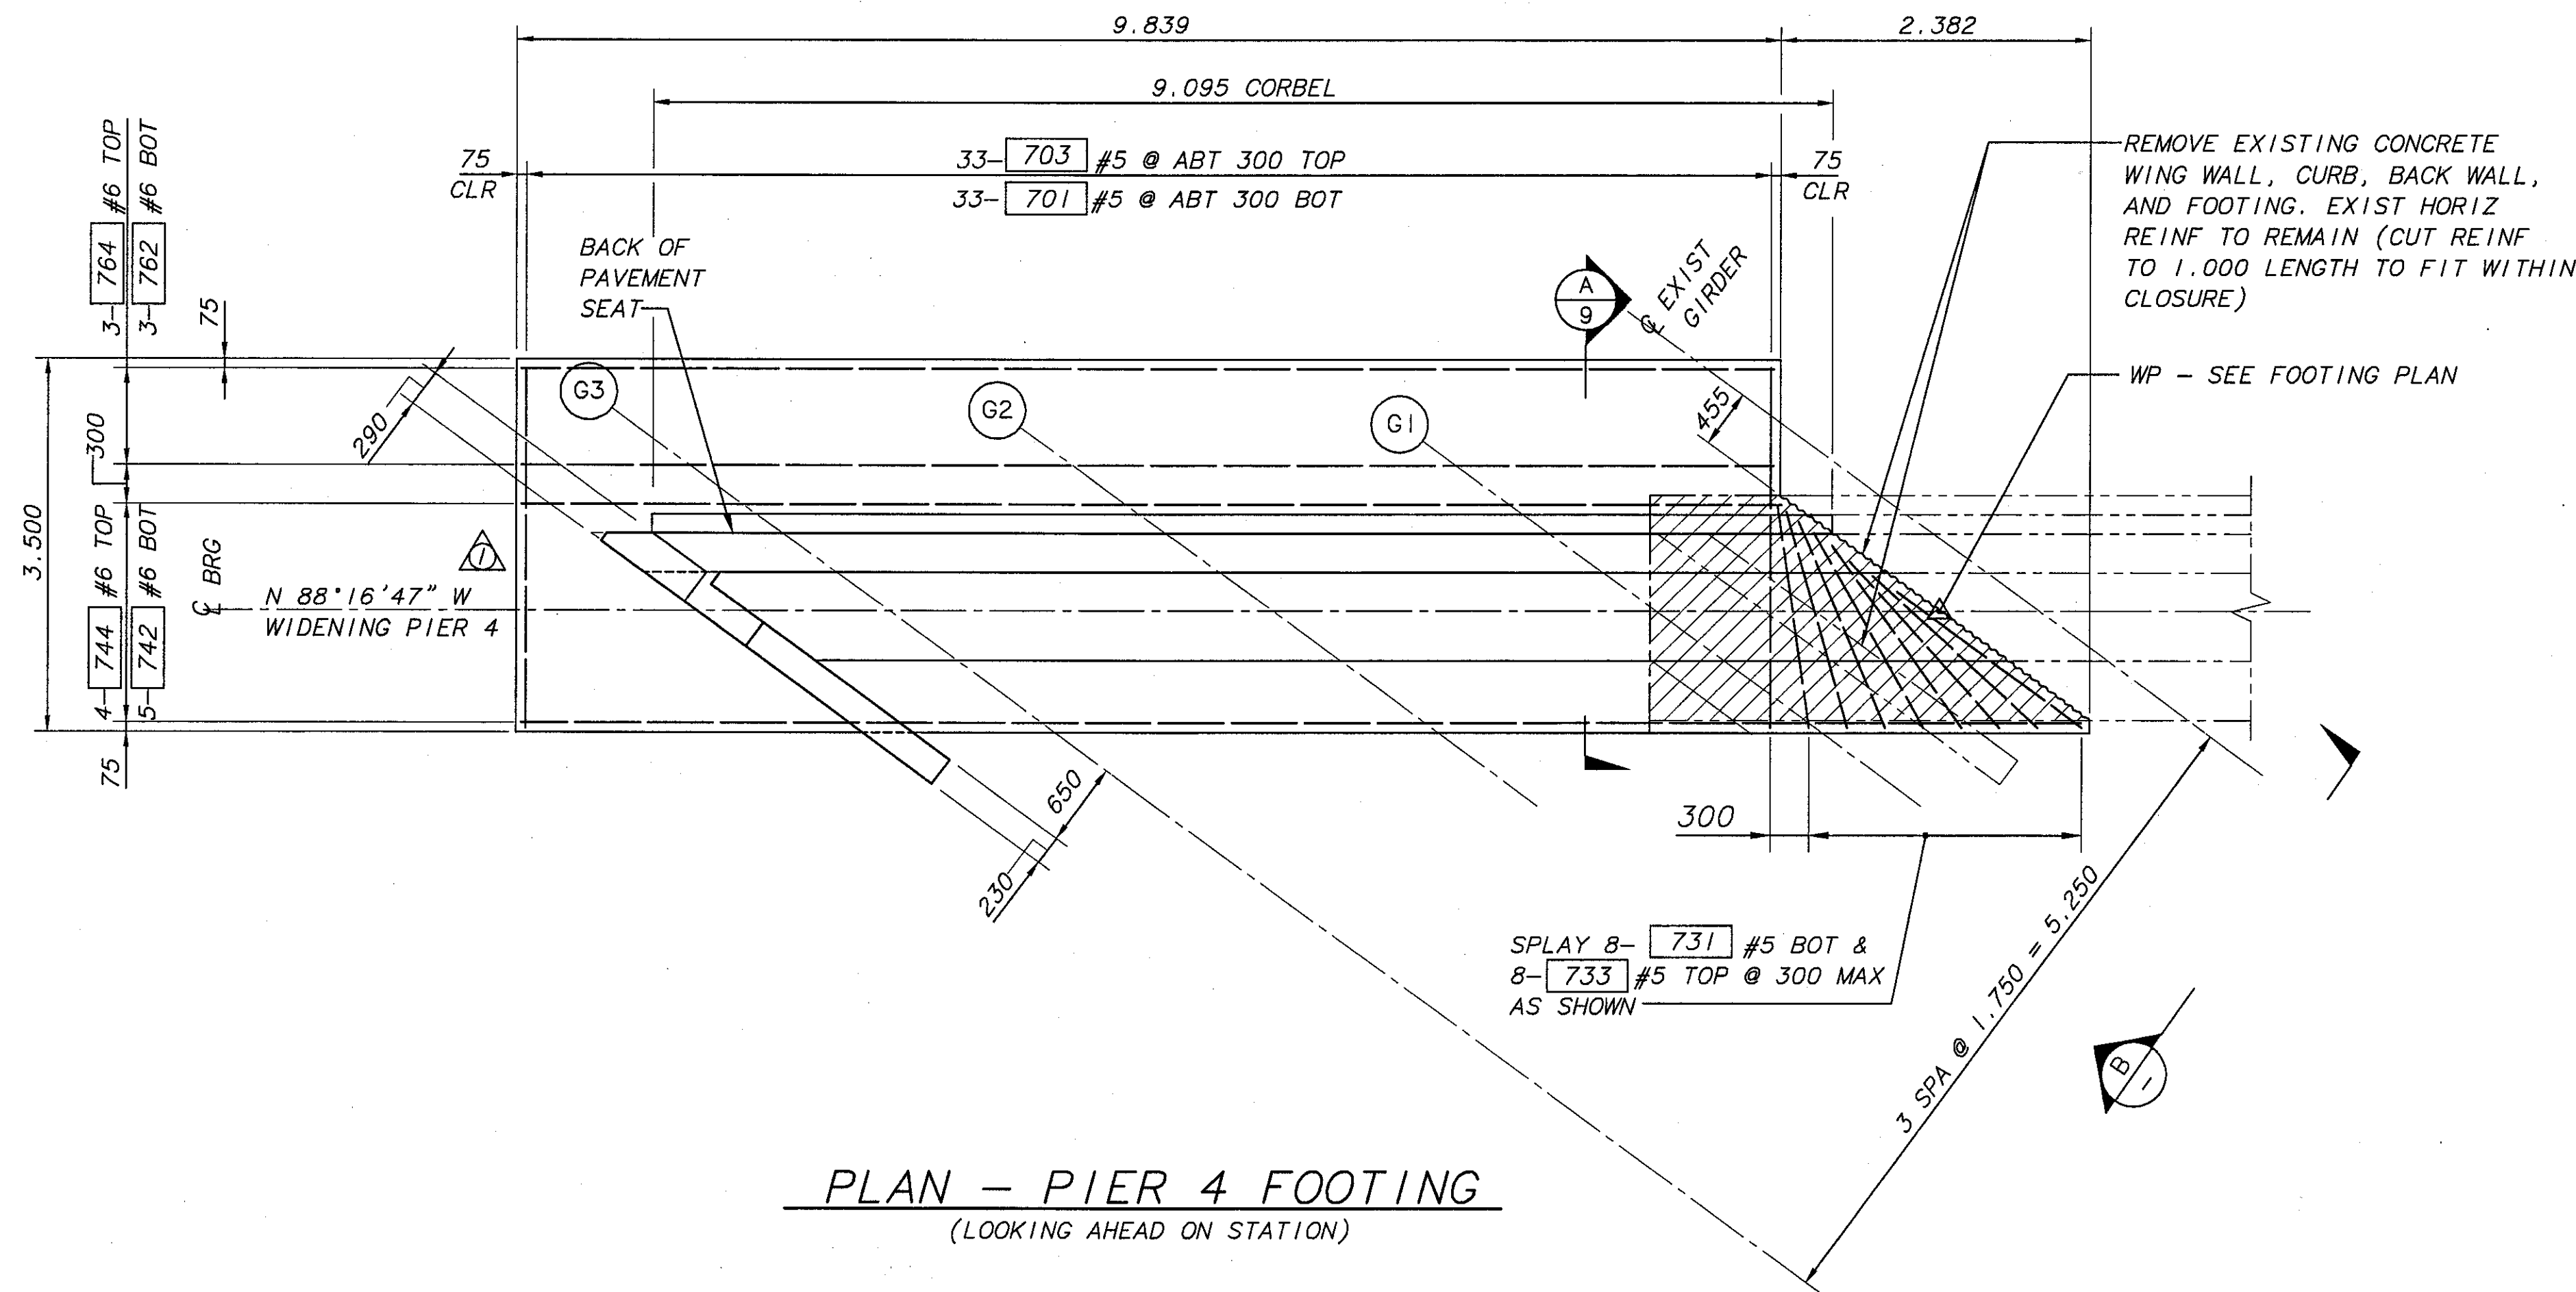

PLAN - PIER 4 FOOTING  
(LOOKING AHEAD ON STATION)

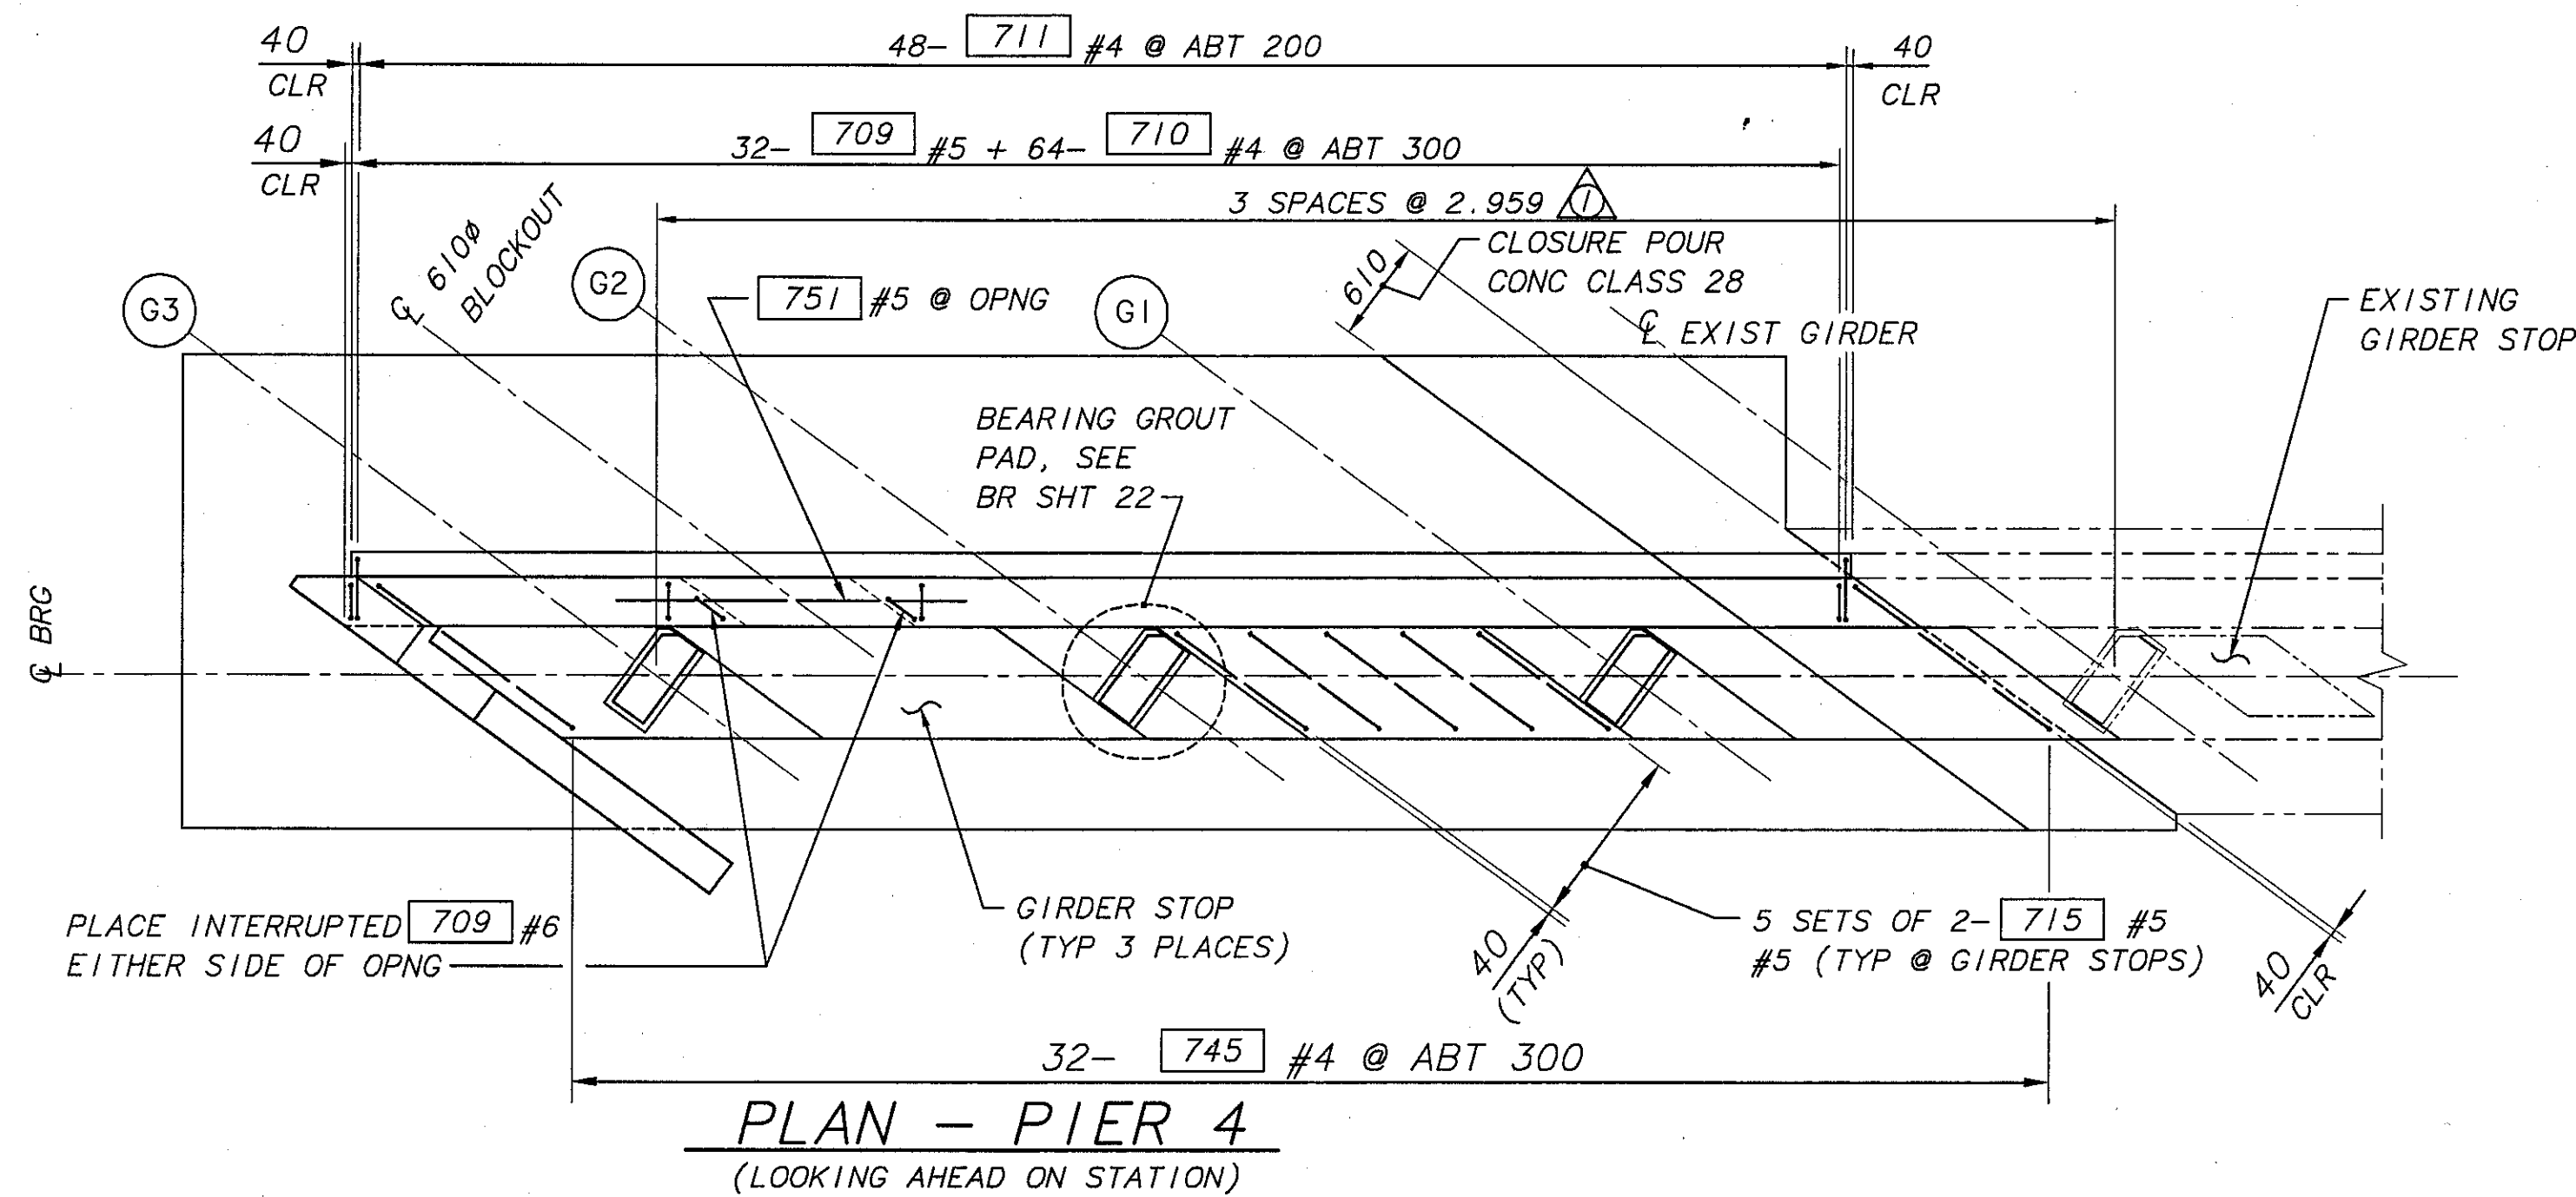


PLAN - PIER 4  
(LOOKING AHEAD ON STATION)

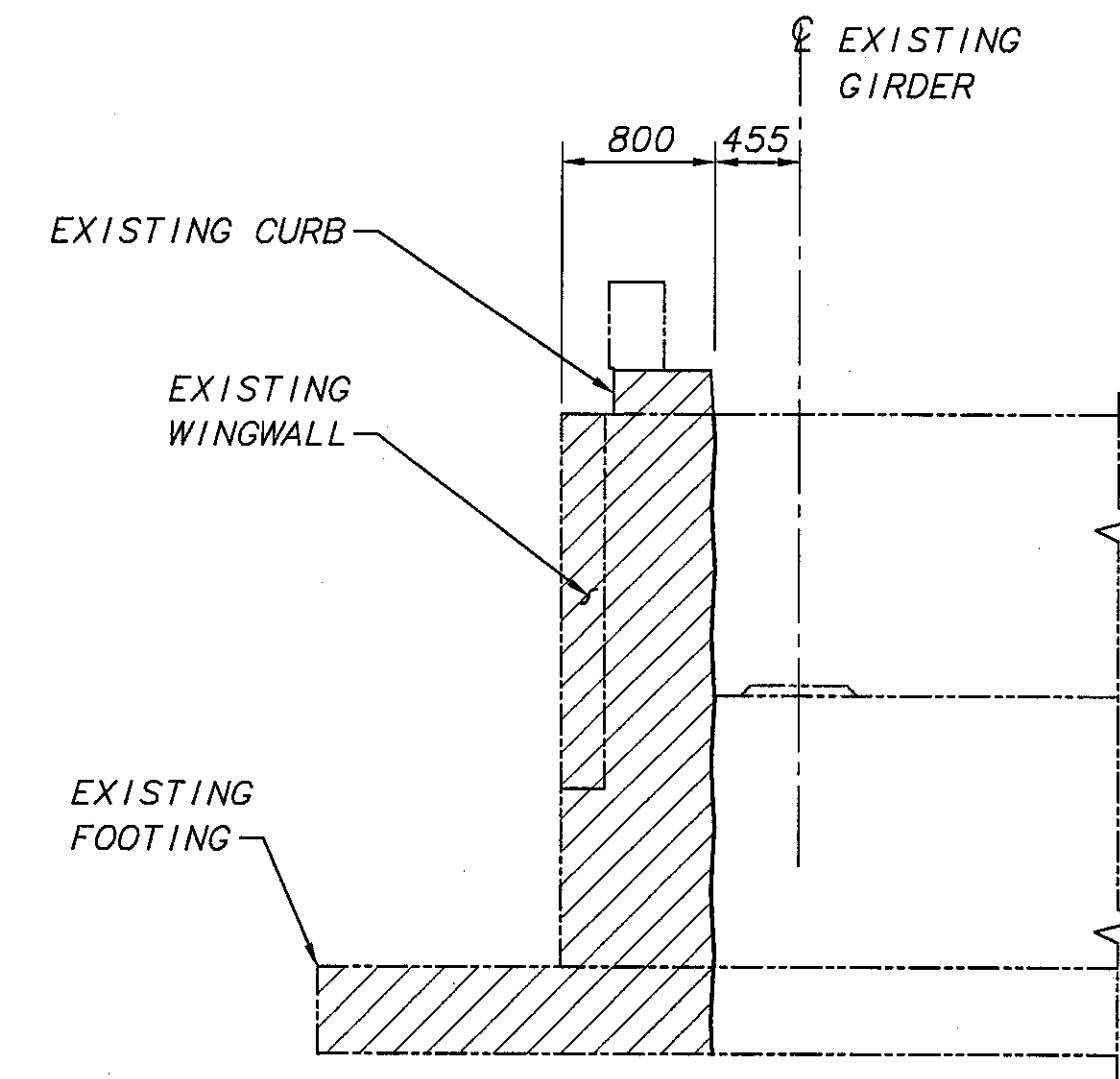

DEMOLITION DETAIL - PIER 4  
(LOOKING ALONG L LINE)

BRIDGE DESIGN ENGR		REGION NO.	STATE	FED AID PROJ NO.	SHEET NO.	TOTAL SHEETS
SUPERVISOR		1	WASH			
DESIGNED BY	M. TRAGESSER 6/96	JOB NUMBER				
CHECKED BY	S. ANDERSON 6/96	96W035				
DETAILED BY	R. MOHN 6/96	CONTRACT NO.				
BRIDGE PROJECTS ENGR		5054				
PRELIM PLAN BY	10/97	REVISED AS-BUILT SURVEY DATA	MLT			
ARCHITECT/SPECIALIST	DATE	REVISION	BY	APPR		

REGION NO.	STATE	FED AID PROJ NO.	SHEET NO.	TOTAL SHEETS
1	WASH			

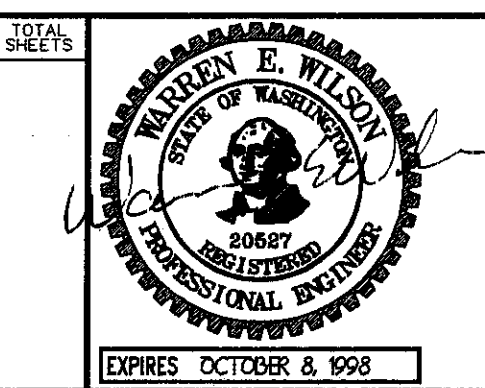

**BERGER/ABAM**  
ENGINEERS INC.  
33301 9TH AVENUE SOUTH  
FEDERAL WAY, WASHINGTON 98003-2305  
(206)431-2300 FAX: (206)431-2200


**Washington State**  
Department of  
Transportation

SR 405  
BOTHELL TO SWAMP CREEK I/C  
HOV LANES - STAGE 1  
228TH BRIDGE 405/103E  
PIER 4 PLAN & DETAILS

BRIDGE SHEET NO.	8
SHEET OF	663
SHEETS	663


PLOTTED: Mon Oct 13 1997 4:58pm FILENAME: v:\a96077\405-103E\9.dwg SCALE: 40

SR 405 JOB NO. 7079 SHEET 9 OF 31

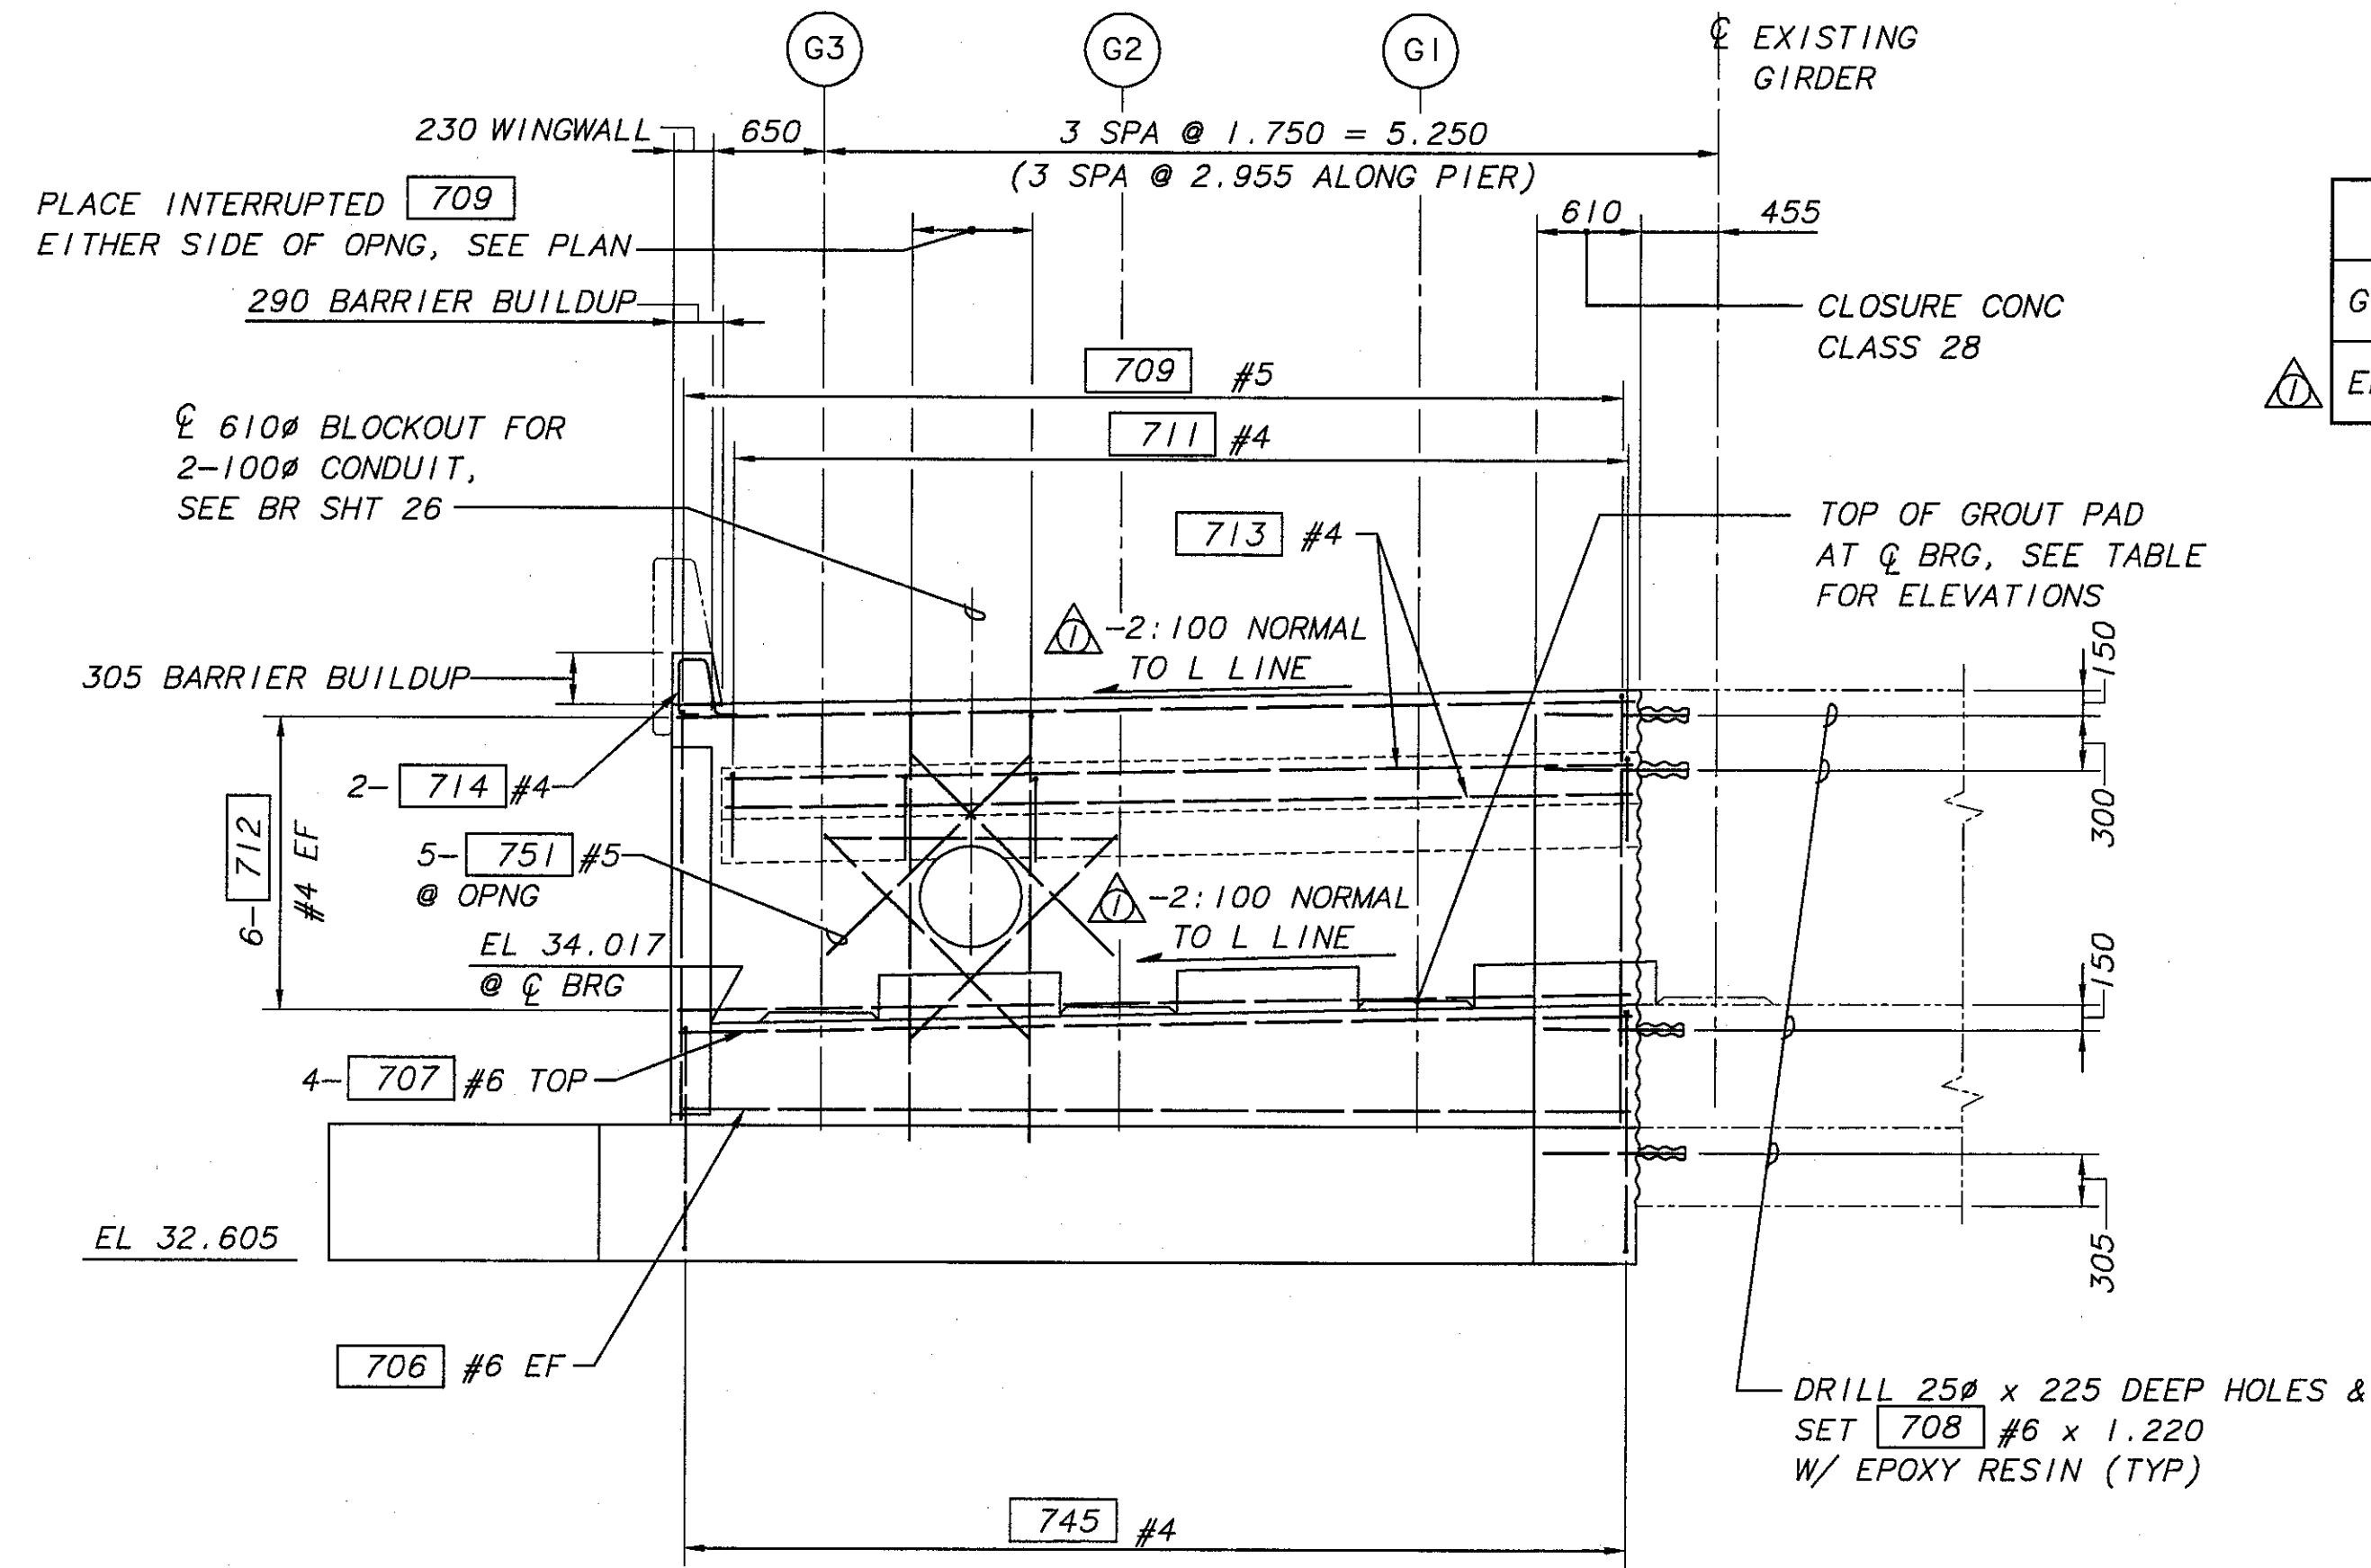

**ELEVATION - PIER 4**  
(DIMENSIONS NORMAL TO L LINE)  
(LOOKING AHEAD ON STATION)


TOP OF GROUT PAD ELEVATIONS			
GIRDER	G1	G2	G3
ELEVATION	34.284	34.188	34.093

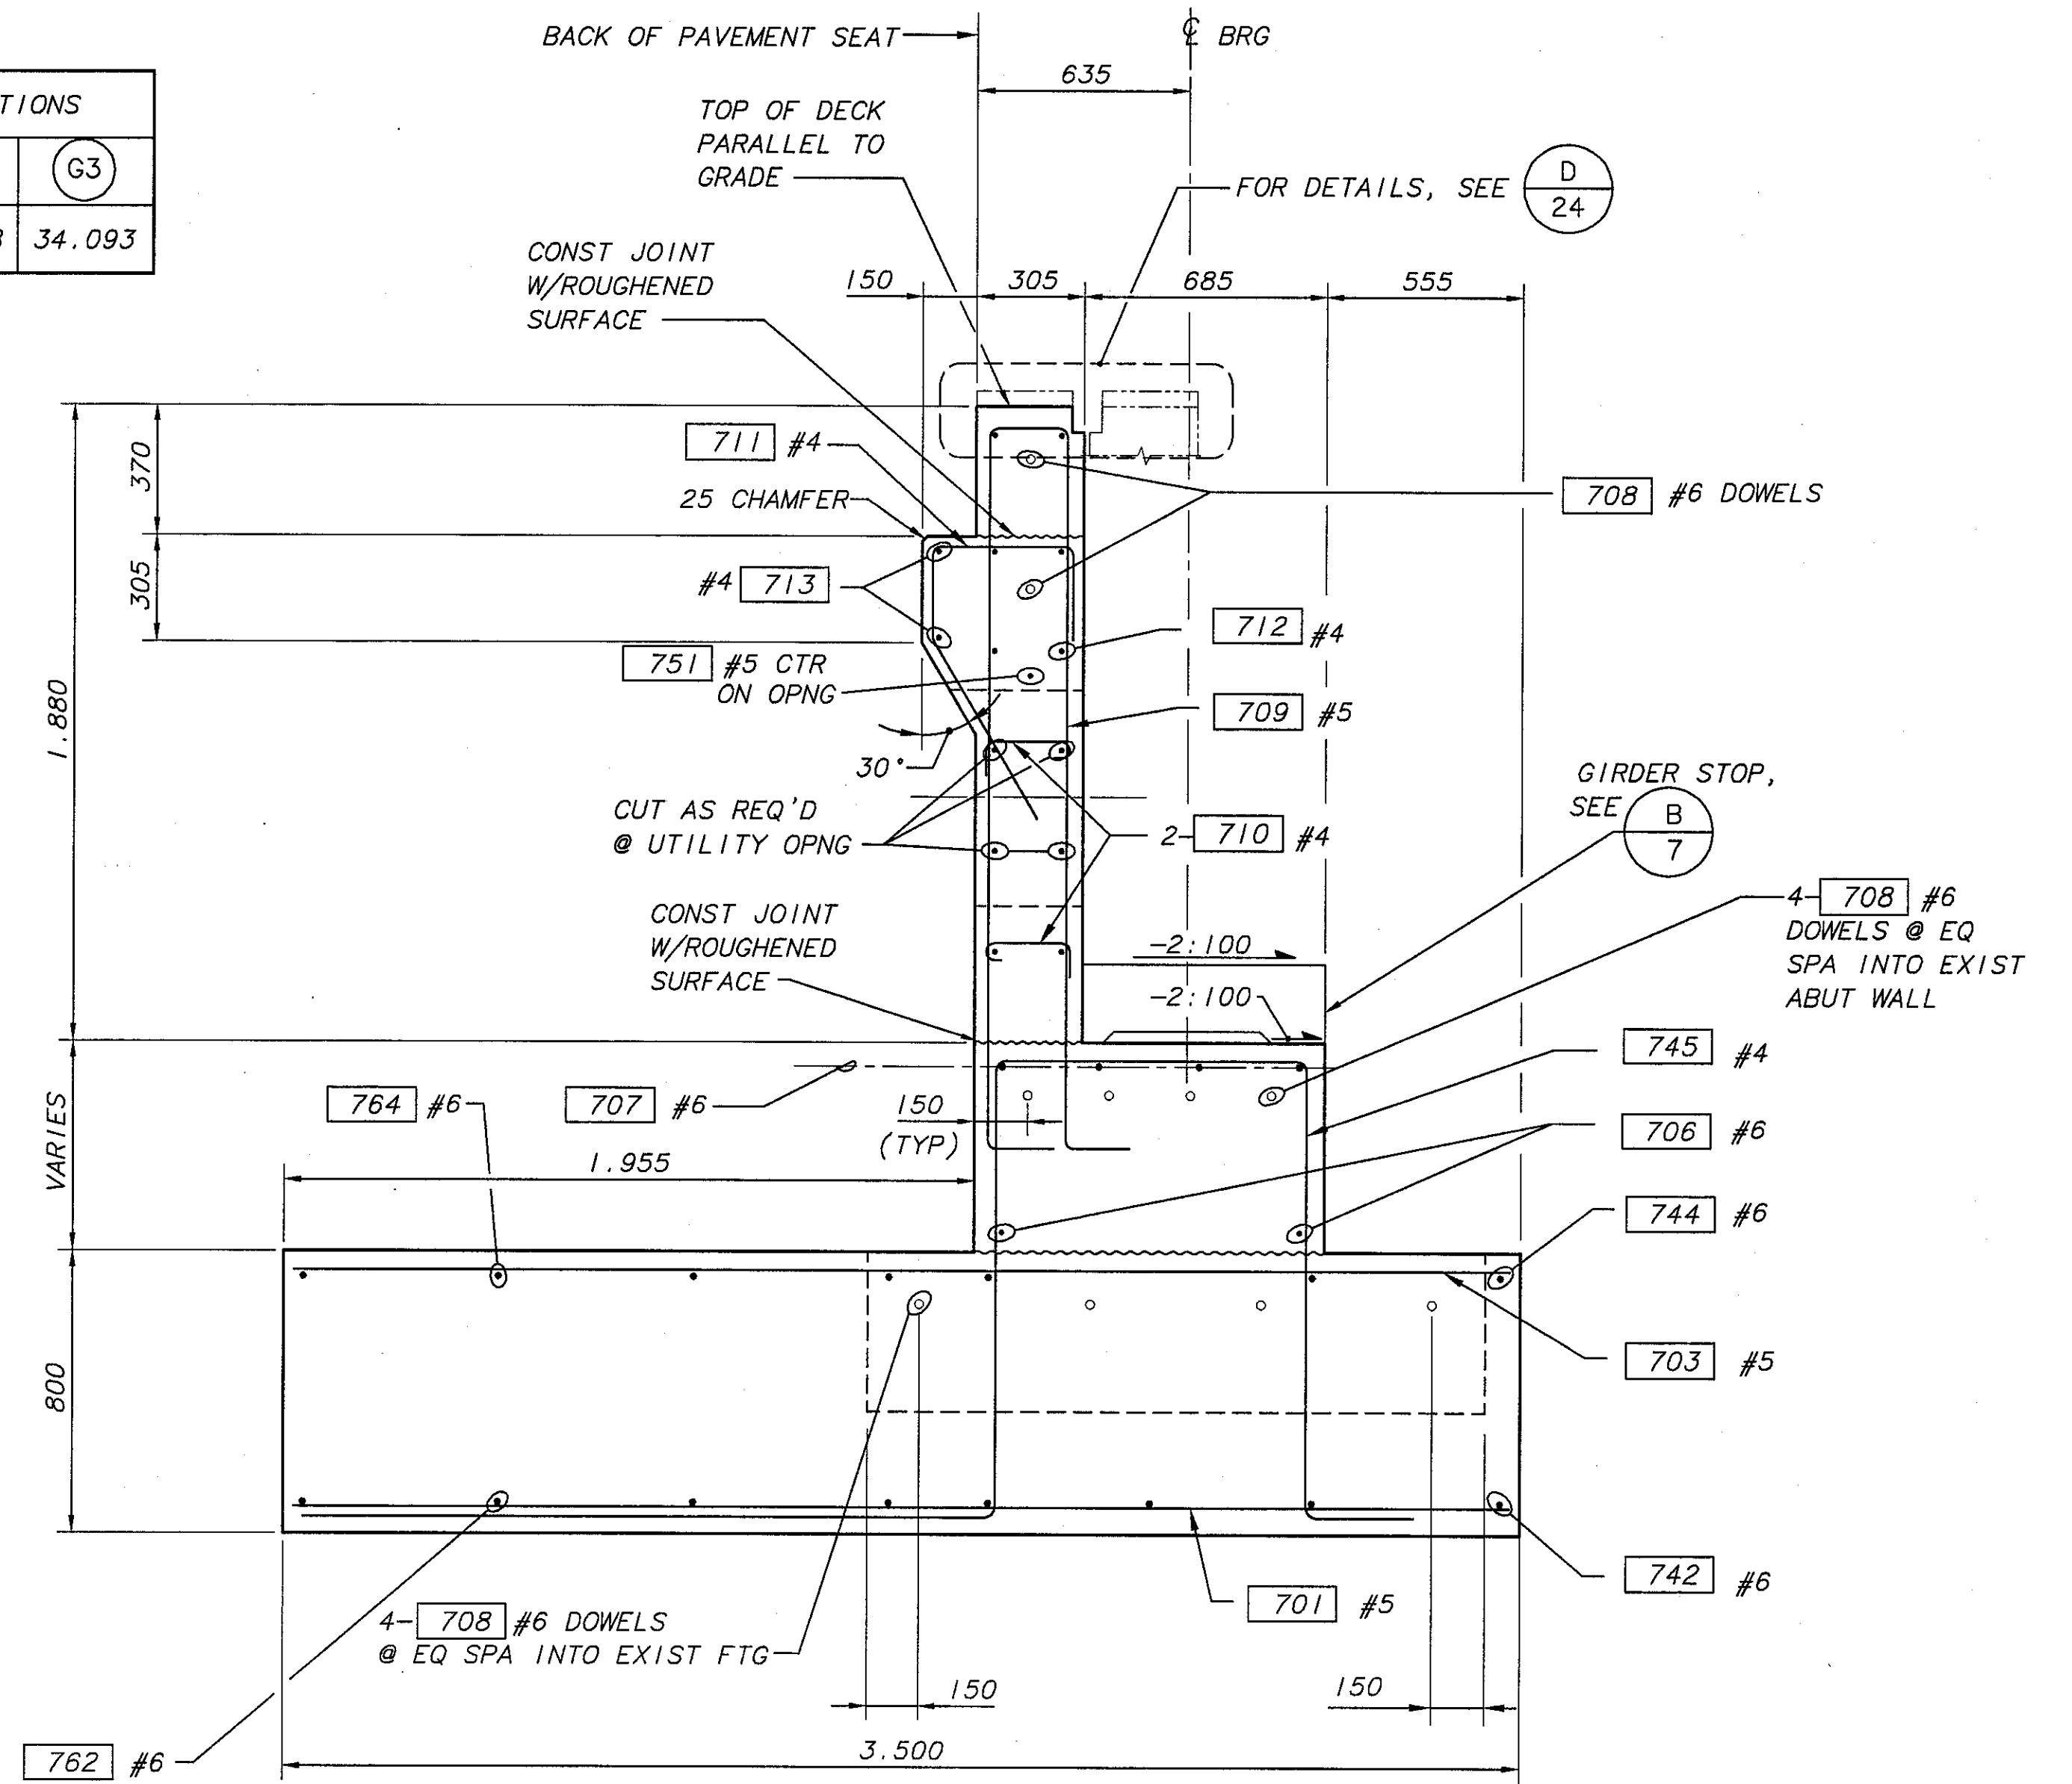

NOTE: FOR DRAINAGE & BACKFILL, SEE DETAIL A 10

**SECTION A-A**

BRIDGE DESIGN ENGR		REGION	STATE	FED AID PROJ NO	SHEET	TOTAL SHEETS
SUPERVISOR		I	WASH			
DESIGNED BY	M. TRAGESSER 6/96					
CHECKED BY	S. ANDERSON 6/96					
DETAILED BY	R. MOHN 6/96					
BRIDGE PROJECTS ENGR				JOB NUMBER		
PRELIM PLAN BY	10/97	REVISED AS-BUILT SURVEY DATA	MLT	96W035		
ARCHITECT/SPECIALIST	DATE	REVISION	BY	CONTRACT NO.		
				5054		

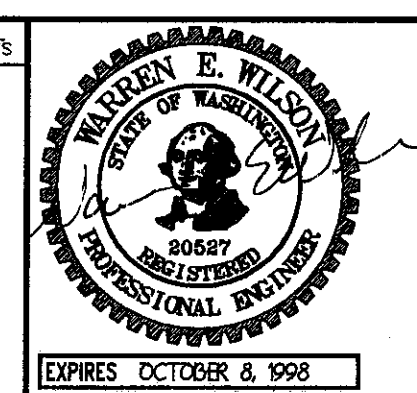

**BERGER/ABAM**  
ENGINEERS INC.  
33301 9TH AVENUE SOUTH  
FEDERAL WAY, WASHINGTON 98003-8386  
(206) 451-6300 FAX: (206) 451-8250

**Washington State**  
Department of  
Transportation


SR 405  
BOTHELL TO SWAMP CREEK 1/C  
HOV LANES - STAGE 1  
228TH BRIDGE 405/103E  
PIER 4 ELEVATION AND SECTIONS

BRIDGE SHEET NO. 9  
SHEET 507 OF 663 SHEETS




PLotted: Tue Oct 14 1997 10:21am FILENAME: V:\466077\405-103E\11.dwg SCALE: 40

SR 405 JOB NO. 7029 SHEET 11 OF 31

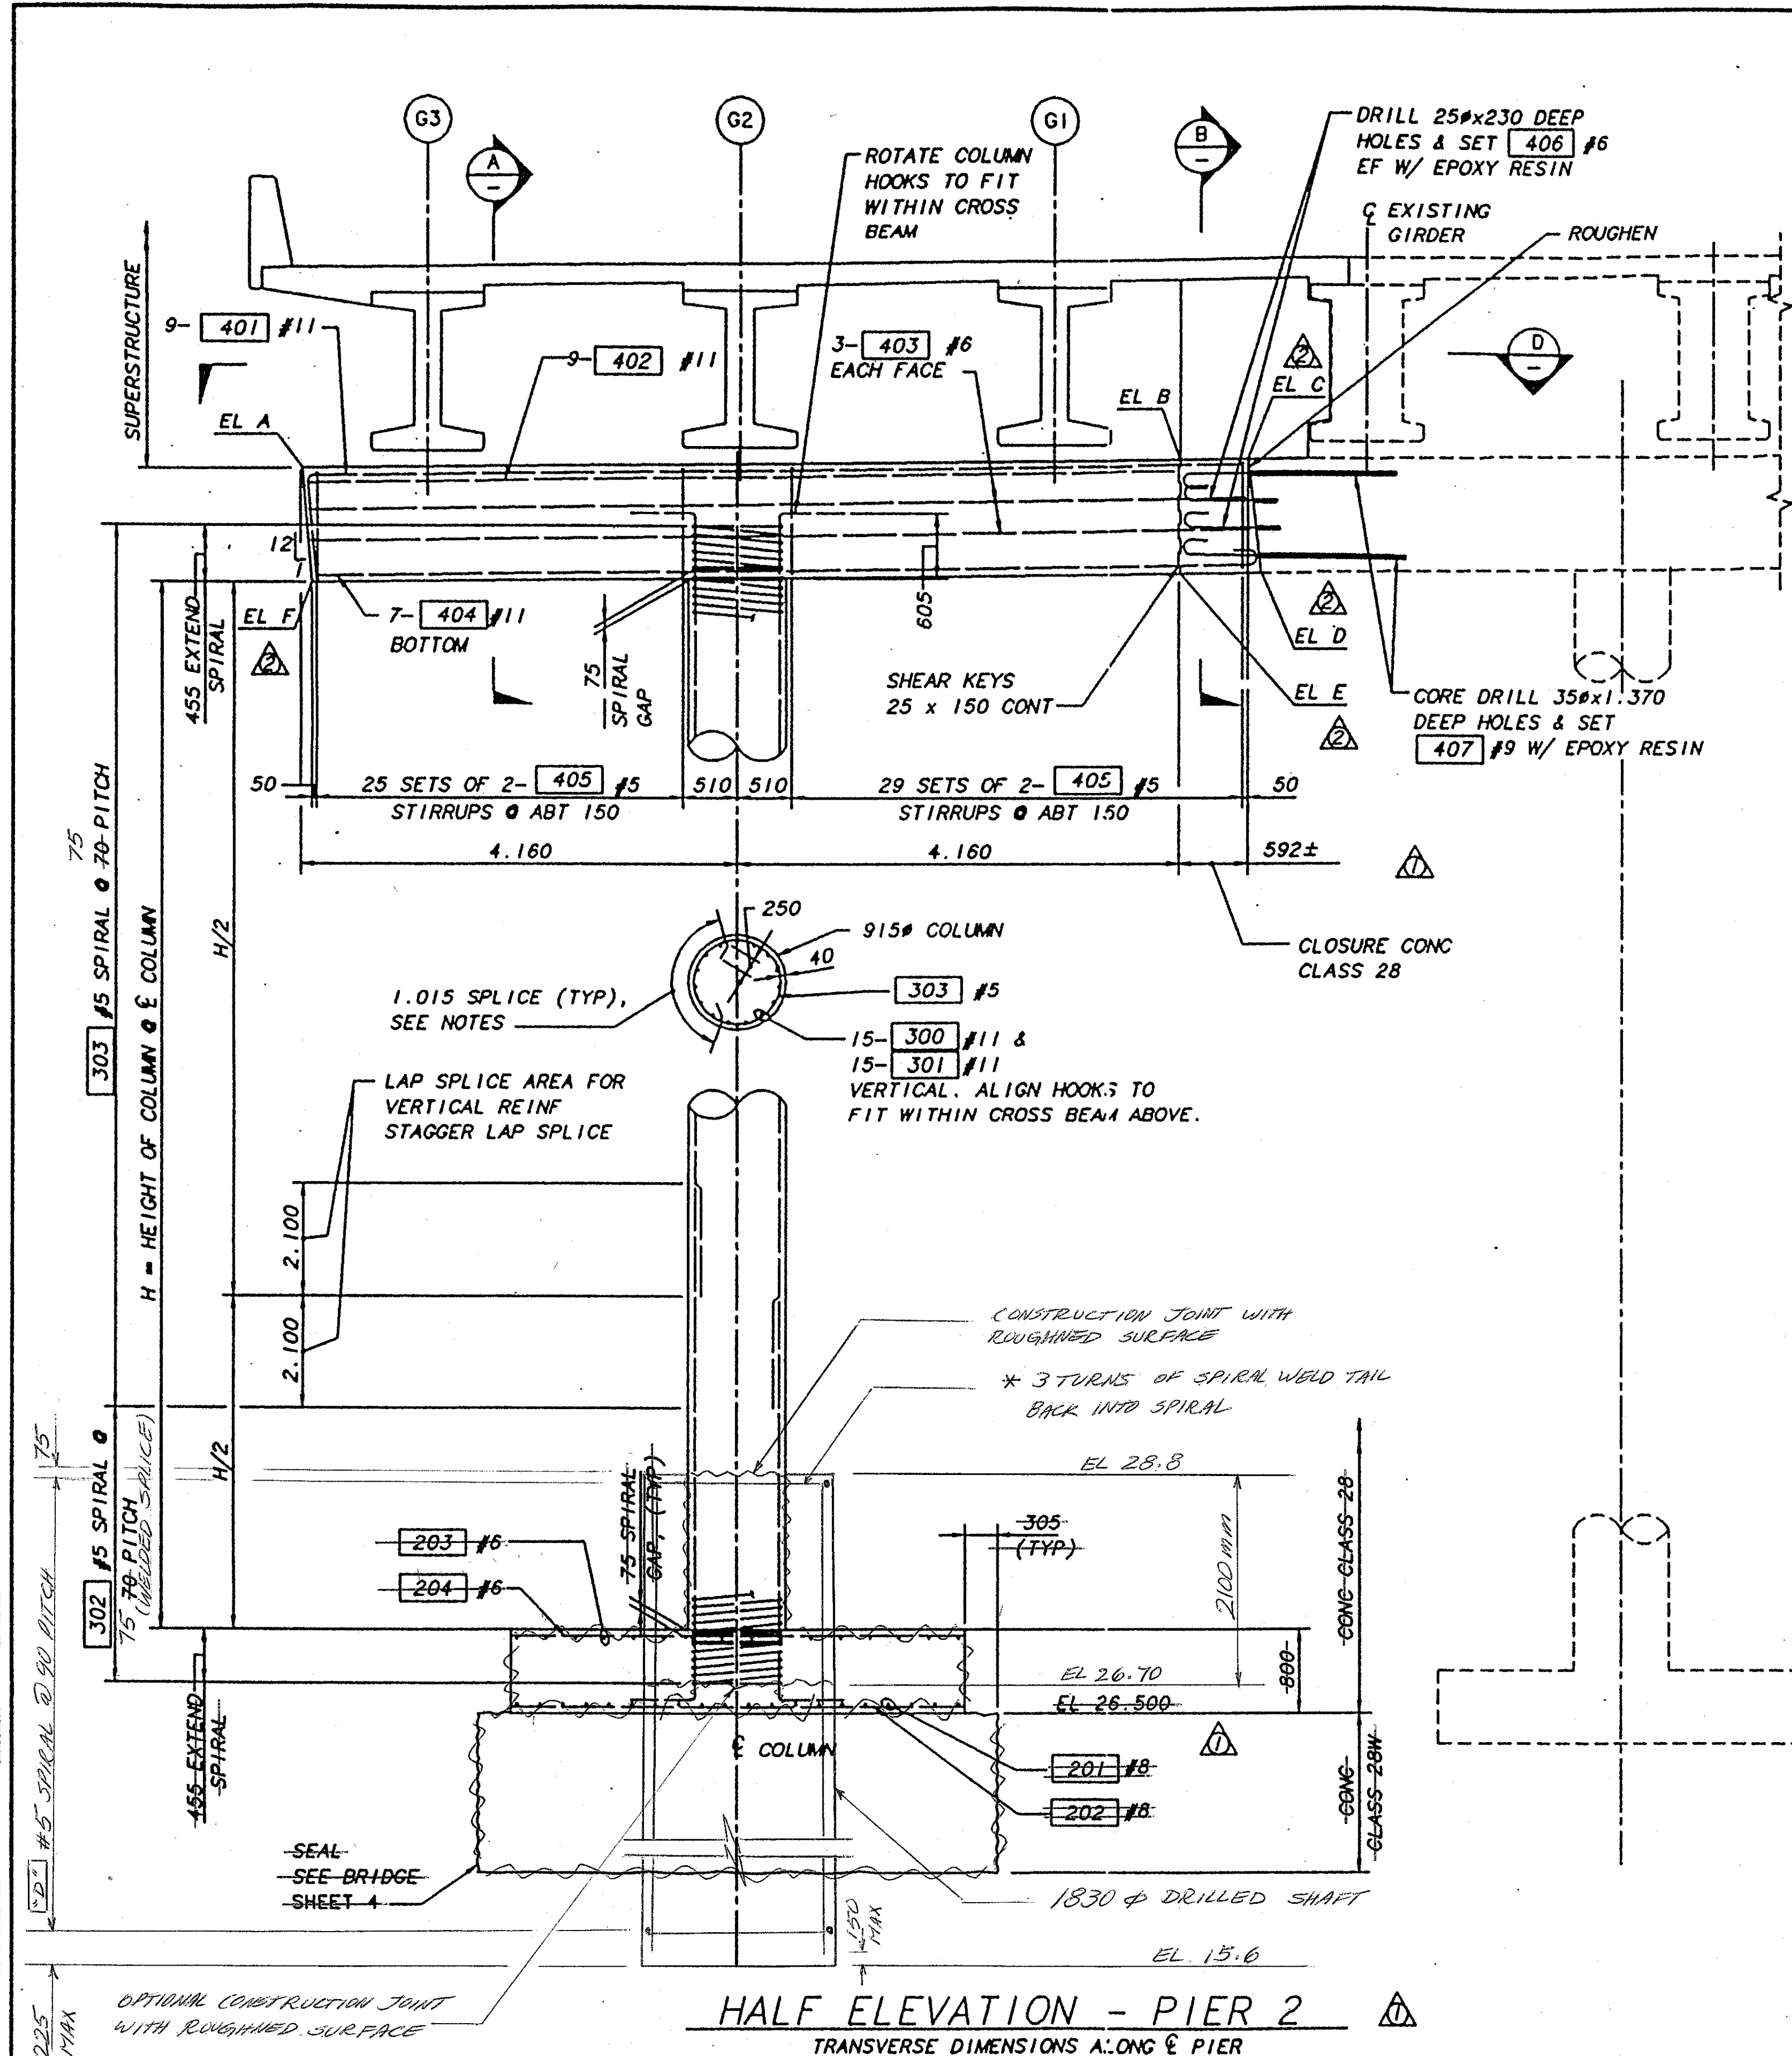

HALF ELEVATION - PIER 2  
TRANSVERSE DIMENSIONS ALONG PIER

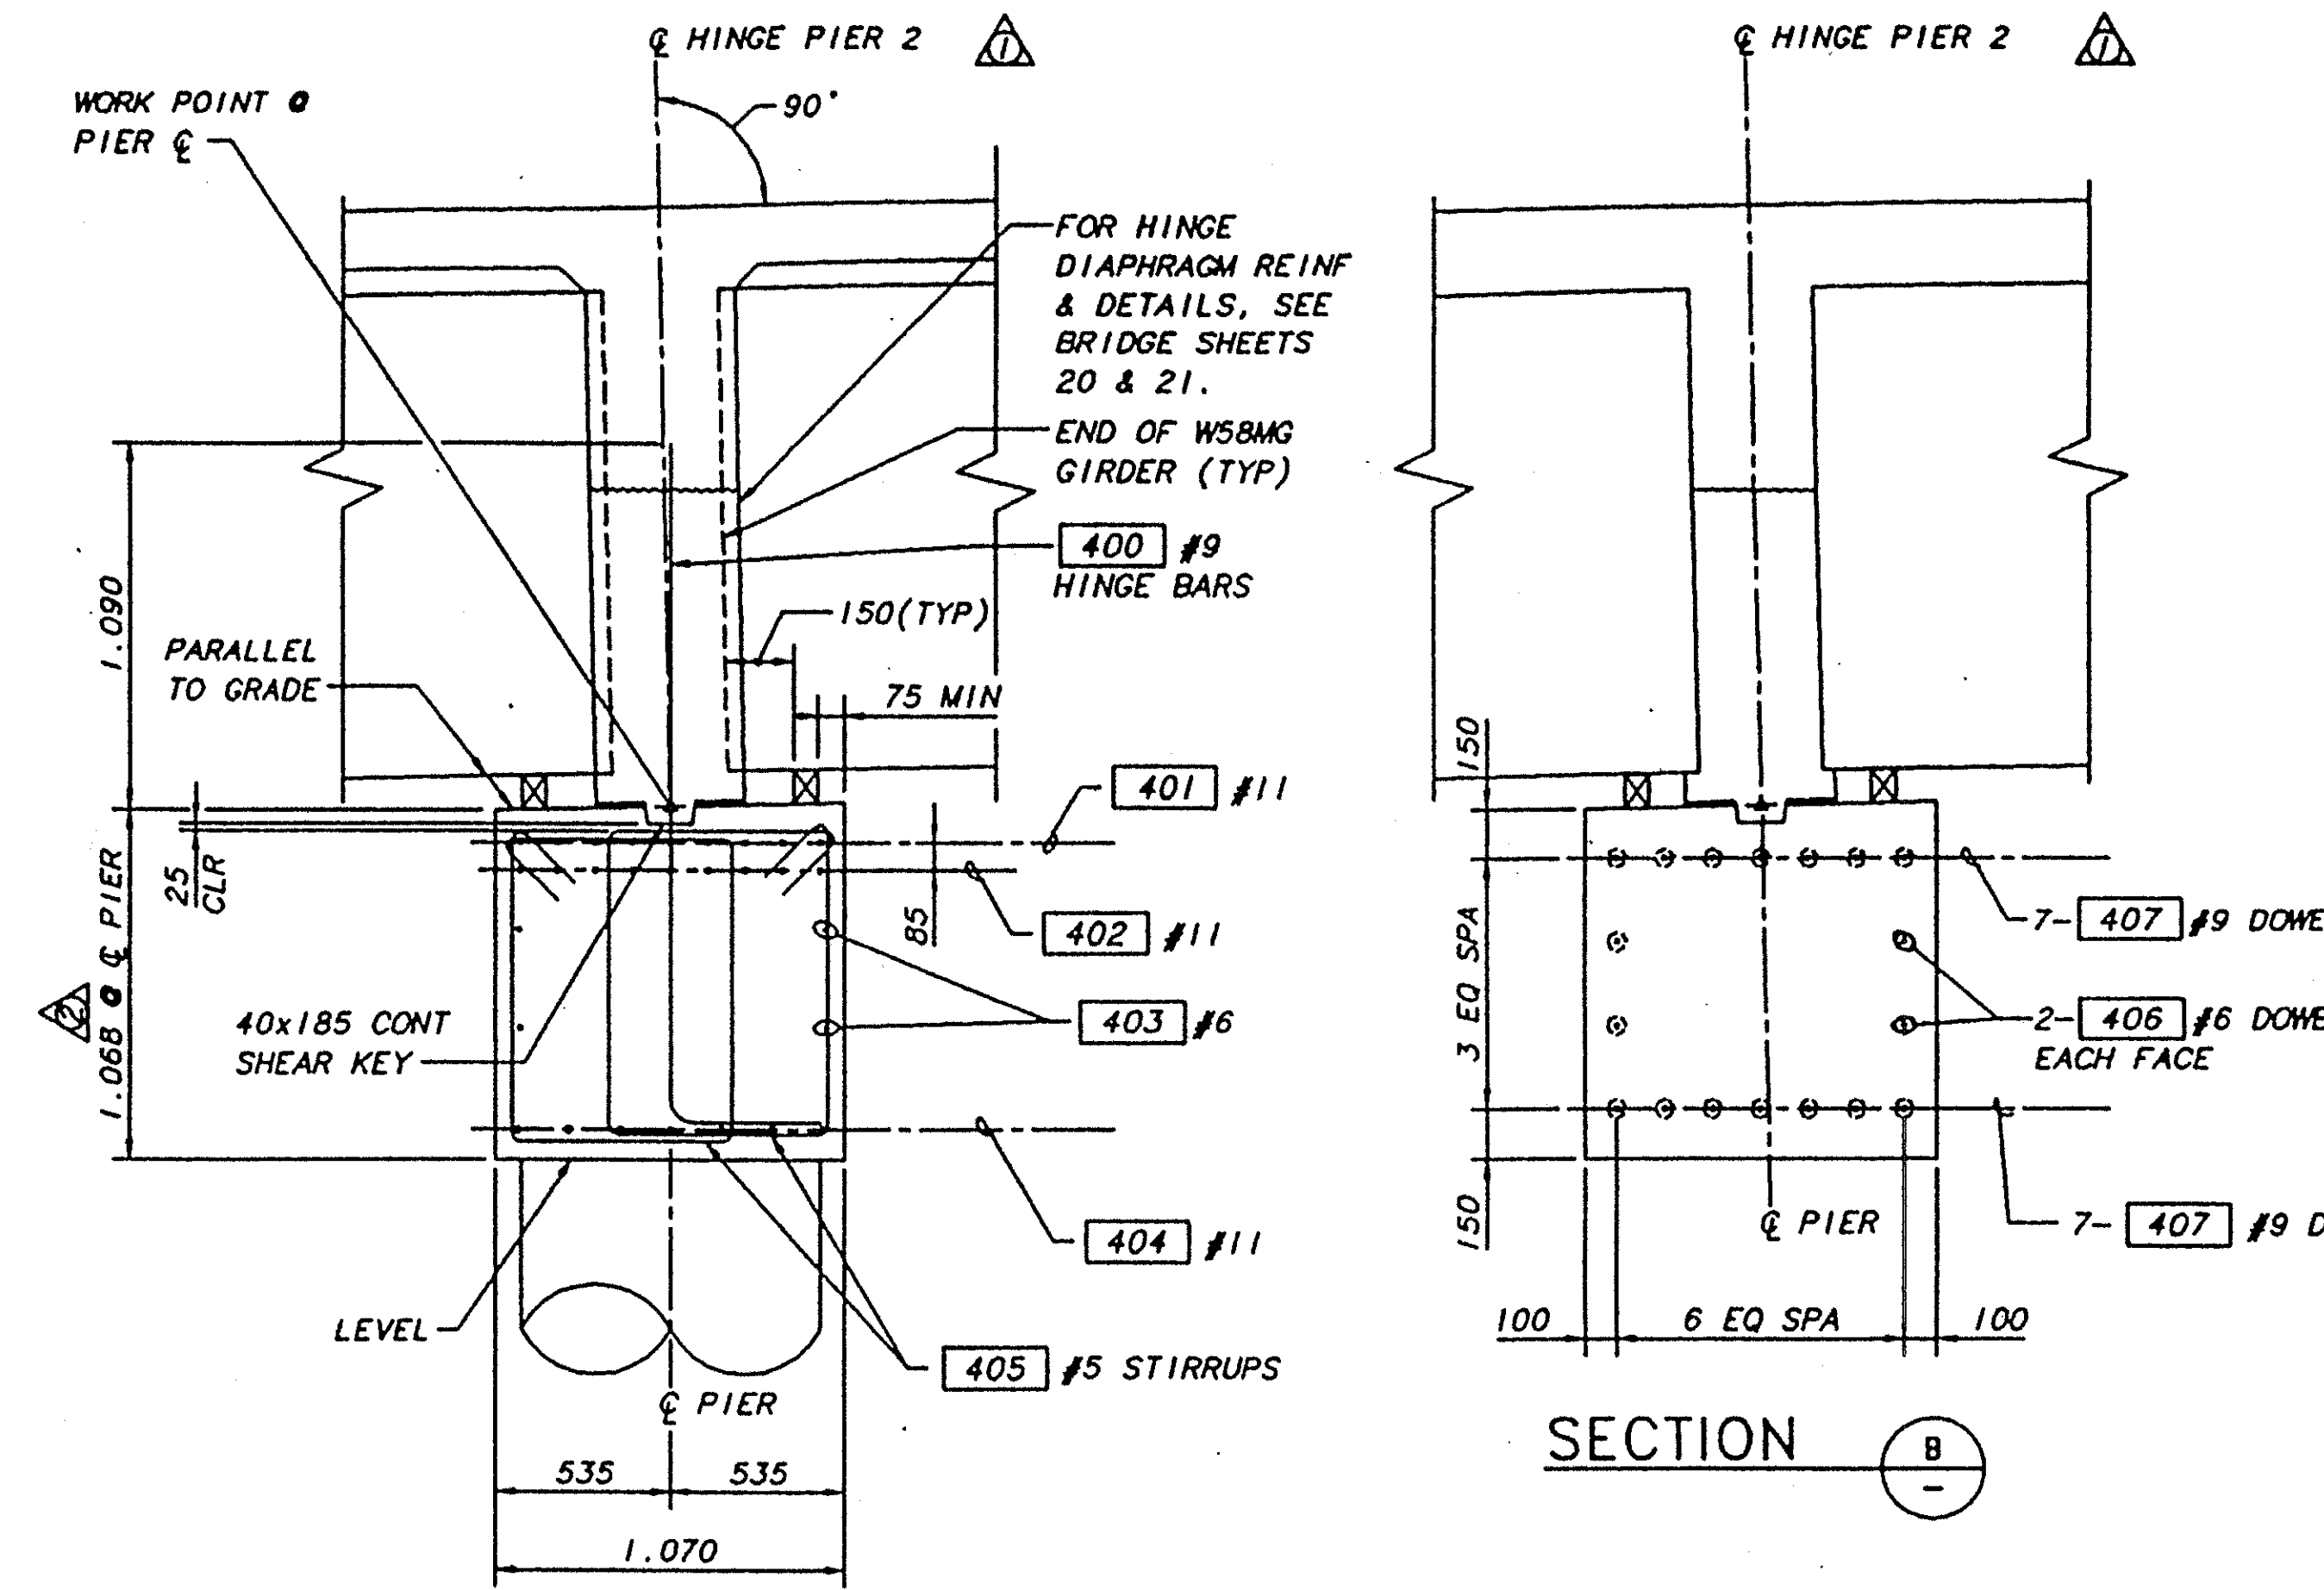


SECTION A

SECTION B

PIER E ELEVATIONS	
EL A	35.446
EL B	35.694
EL C	35.714
EL D	34.649
EL E	34.626
EL F	34.381

COLUMN NOTES:

1. COLUMN SPIRAL BARS SHALL BE #5 DEFORMED BARS, 16 PLAIN STEEL BAR, W31 COLD DRAWN WIRE, OR D31 DEFORMED WIRE.
2. SEE DETAIL ON BR SHT 12 FOR SPIRAL WELD SPLICE ALTERNATE.
3. SPIRAL LAP SPLICE MAY BE USED ONLY WITHIN THE CENTER HALF OF COLUMN HEIGHT. WELD SPLICE SHALL BE USED EXCEPT AS NOTED.
4. TERMINATE SPIRAL WITH 1/2 TURNS OF SPIRAL. WELD TAIL BACK ONTO SPIRAL (SEE WELDED LAP SPLICE DETAIL) \* OR OTHERWISE AS NOTED
5. SEE DRILLED SHAFT DETAILS ON SHT NO 11B

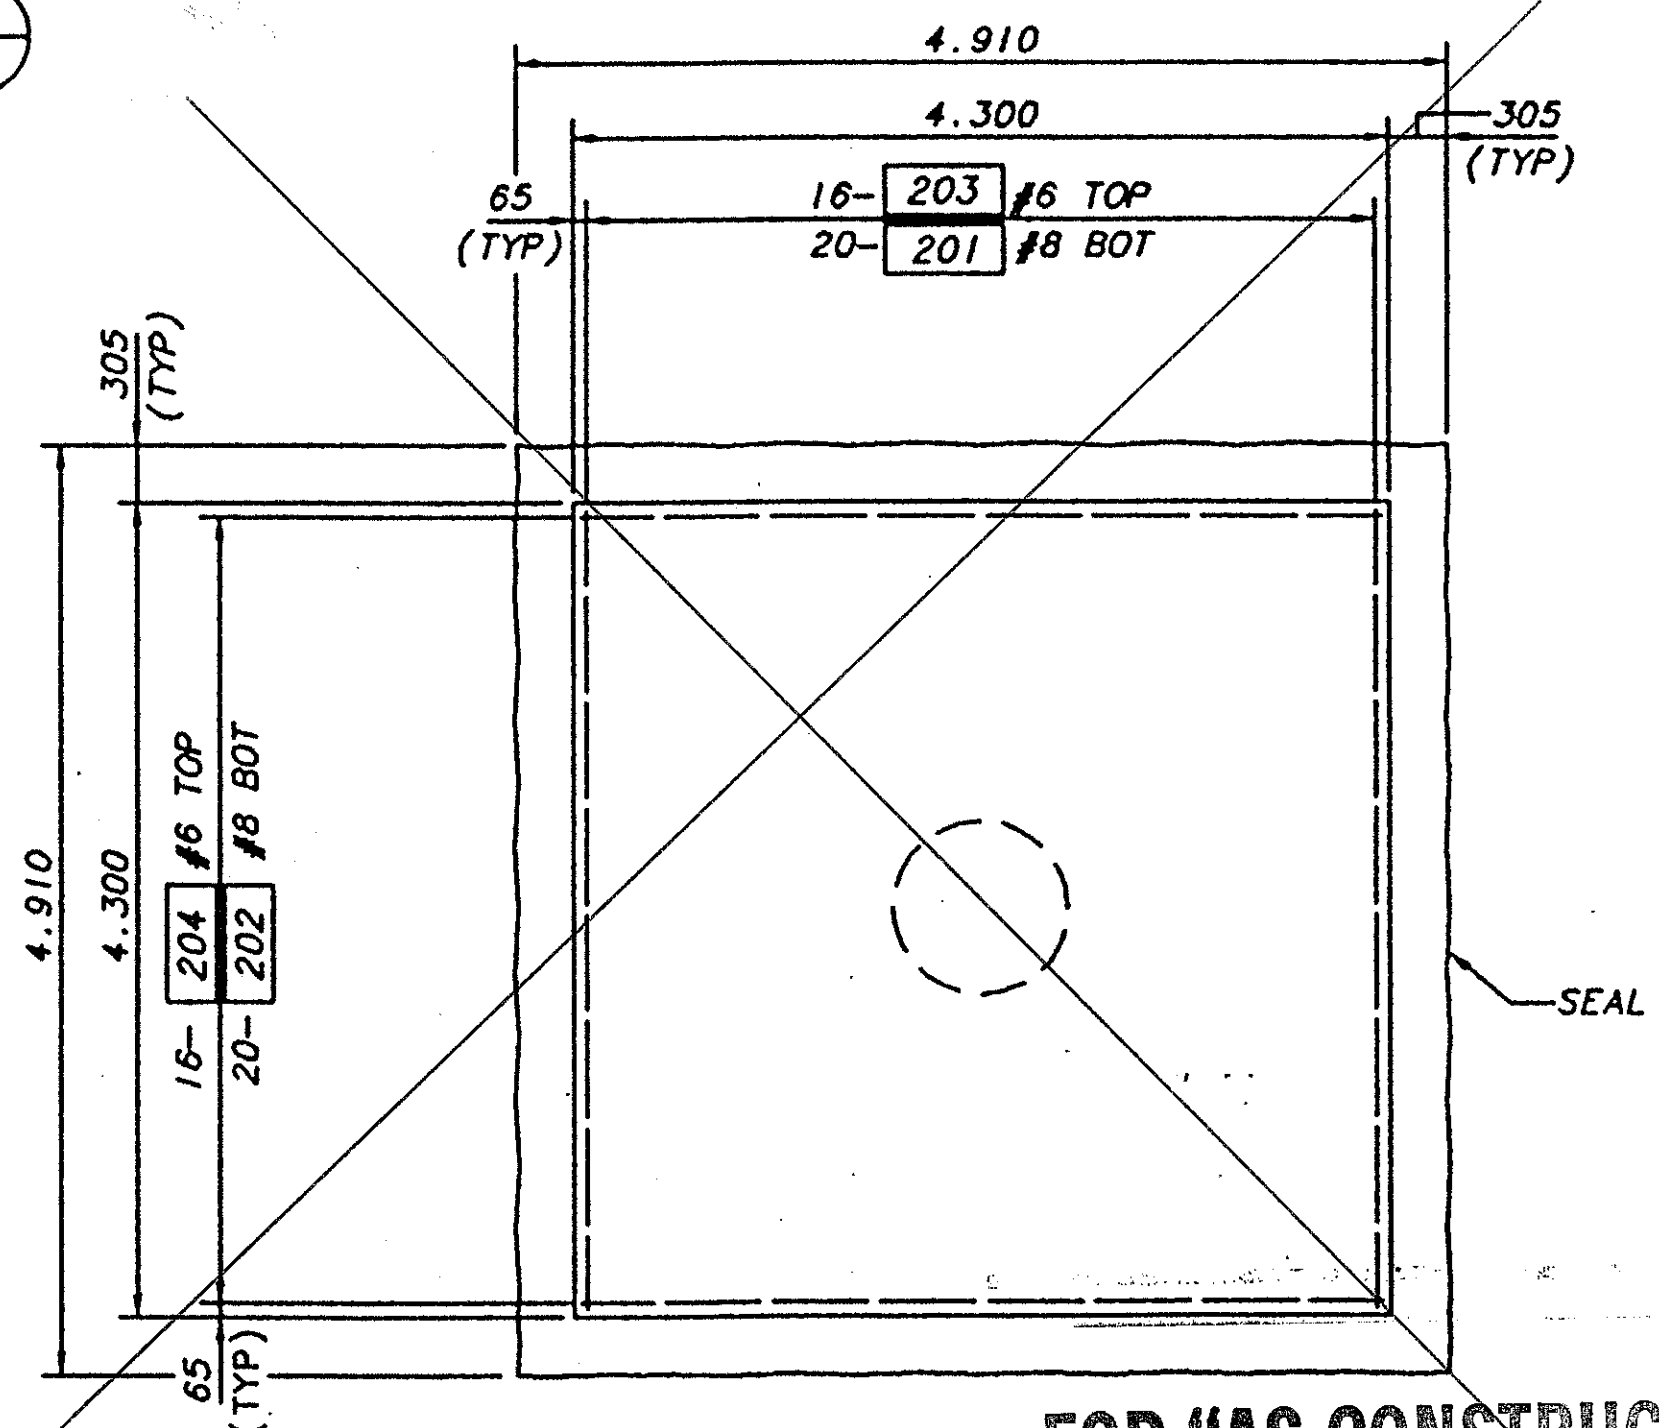

PLAN - FOOTING PIER 2

FOR "AS CONSTRUCTED PLANS" ONLY



BRIDGE DESIGN ENGR		NO. 20	STA. E	FED AID PROJ NO.	ST	DATE
SUPERVISOR						
DESIGNED BY	M. TRAGESSER	6/98				
CHECKED BY	S. ANDERSON	6/98				
DETAILED BY	R. MOHN	6/98	4/13/98	CHANGE ORDER # 25	HZ	
BRIDGE PROJECTS ENGR			10/2/98	REVISED AS-BUILT SURVEY DATA	JM	
PRELIM PLAN BY			9/27/98	REVISED PIER 3 FOOTING-FIT UTILITIES	JZ	
ARCHITECT/SPECIALIST			DATE	REVISION	BY	APPR

Washington State Department of Transportation  
 BERGER/ABAM ENGINEERS P.C.  
 2201 9TH AVENUE SOUTH  
 FEDERAL WAY, WASHINGTON 98003-8398  
 (206) 431-8200 FAX: (206) 431-2280

Washington State Department of Transportation  
 SR 405  
 BOTHELL TO SWAMP CREEK I/C  
 HOV LANES - STAGE 1  
 228TH BRIDGE 405/103E  
 PIER 2 PLAN, ELEVATION & SECTIONS


NOTED: Thu Oct 14 1997 10:22am FILENAME: V:\66077\405-103E\171A.dwg SCALE: 40

SR 405 JOB NO. 2079 SHEET 11 OF 31

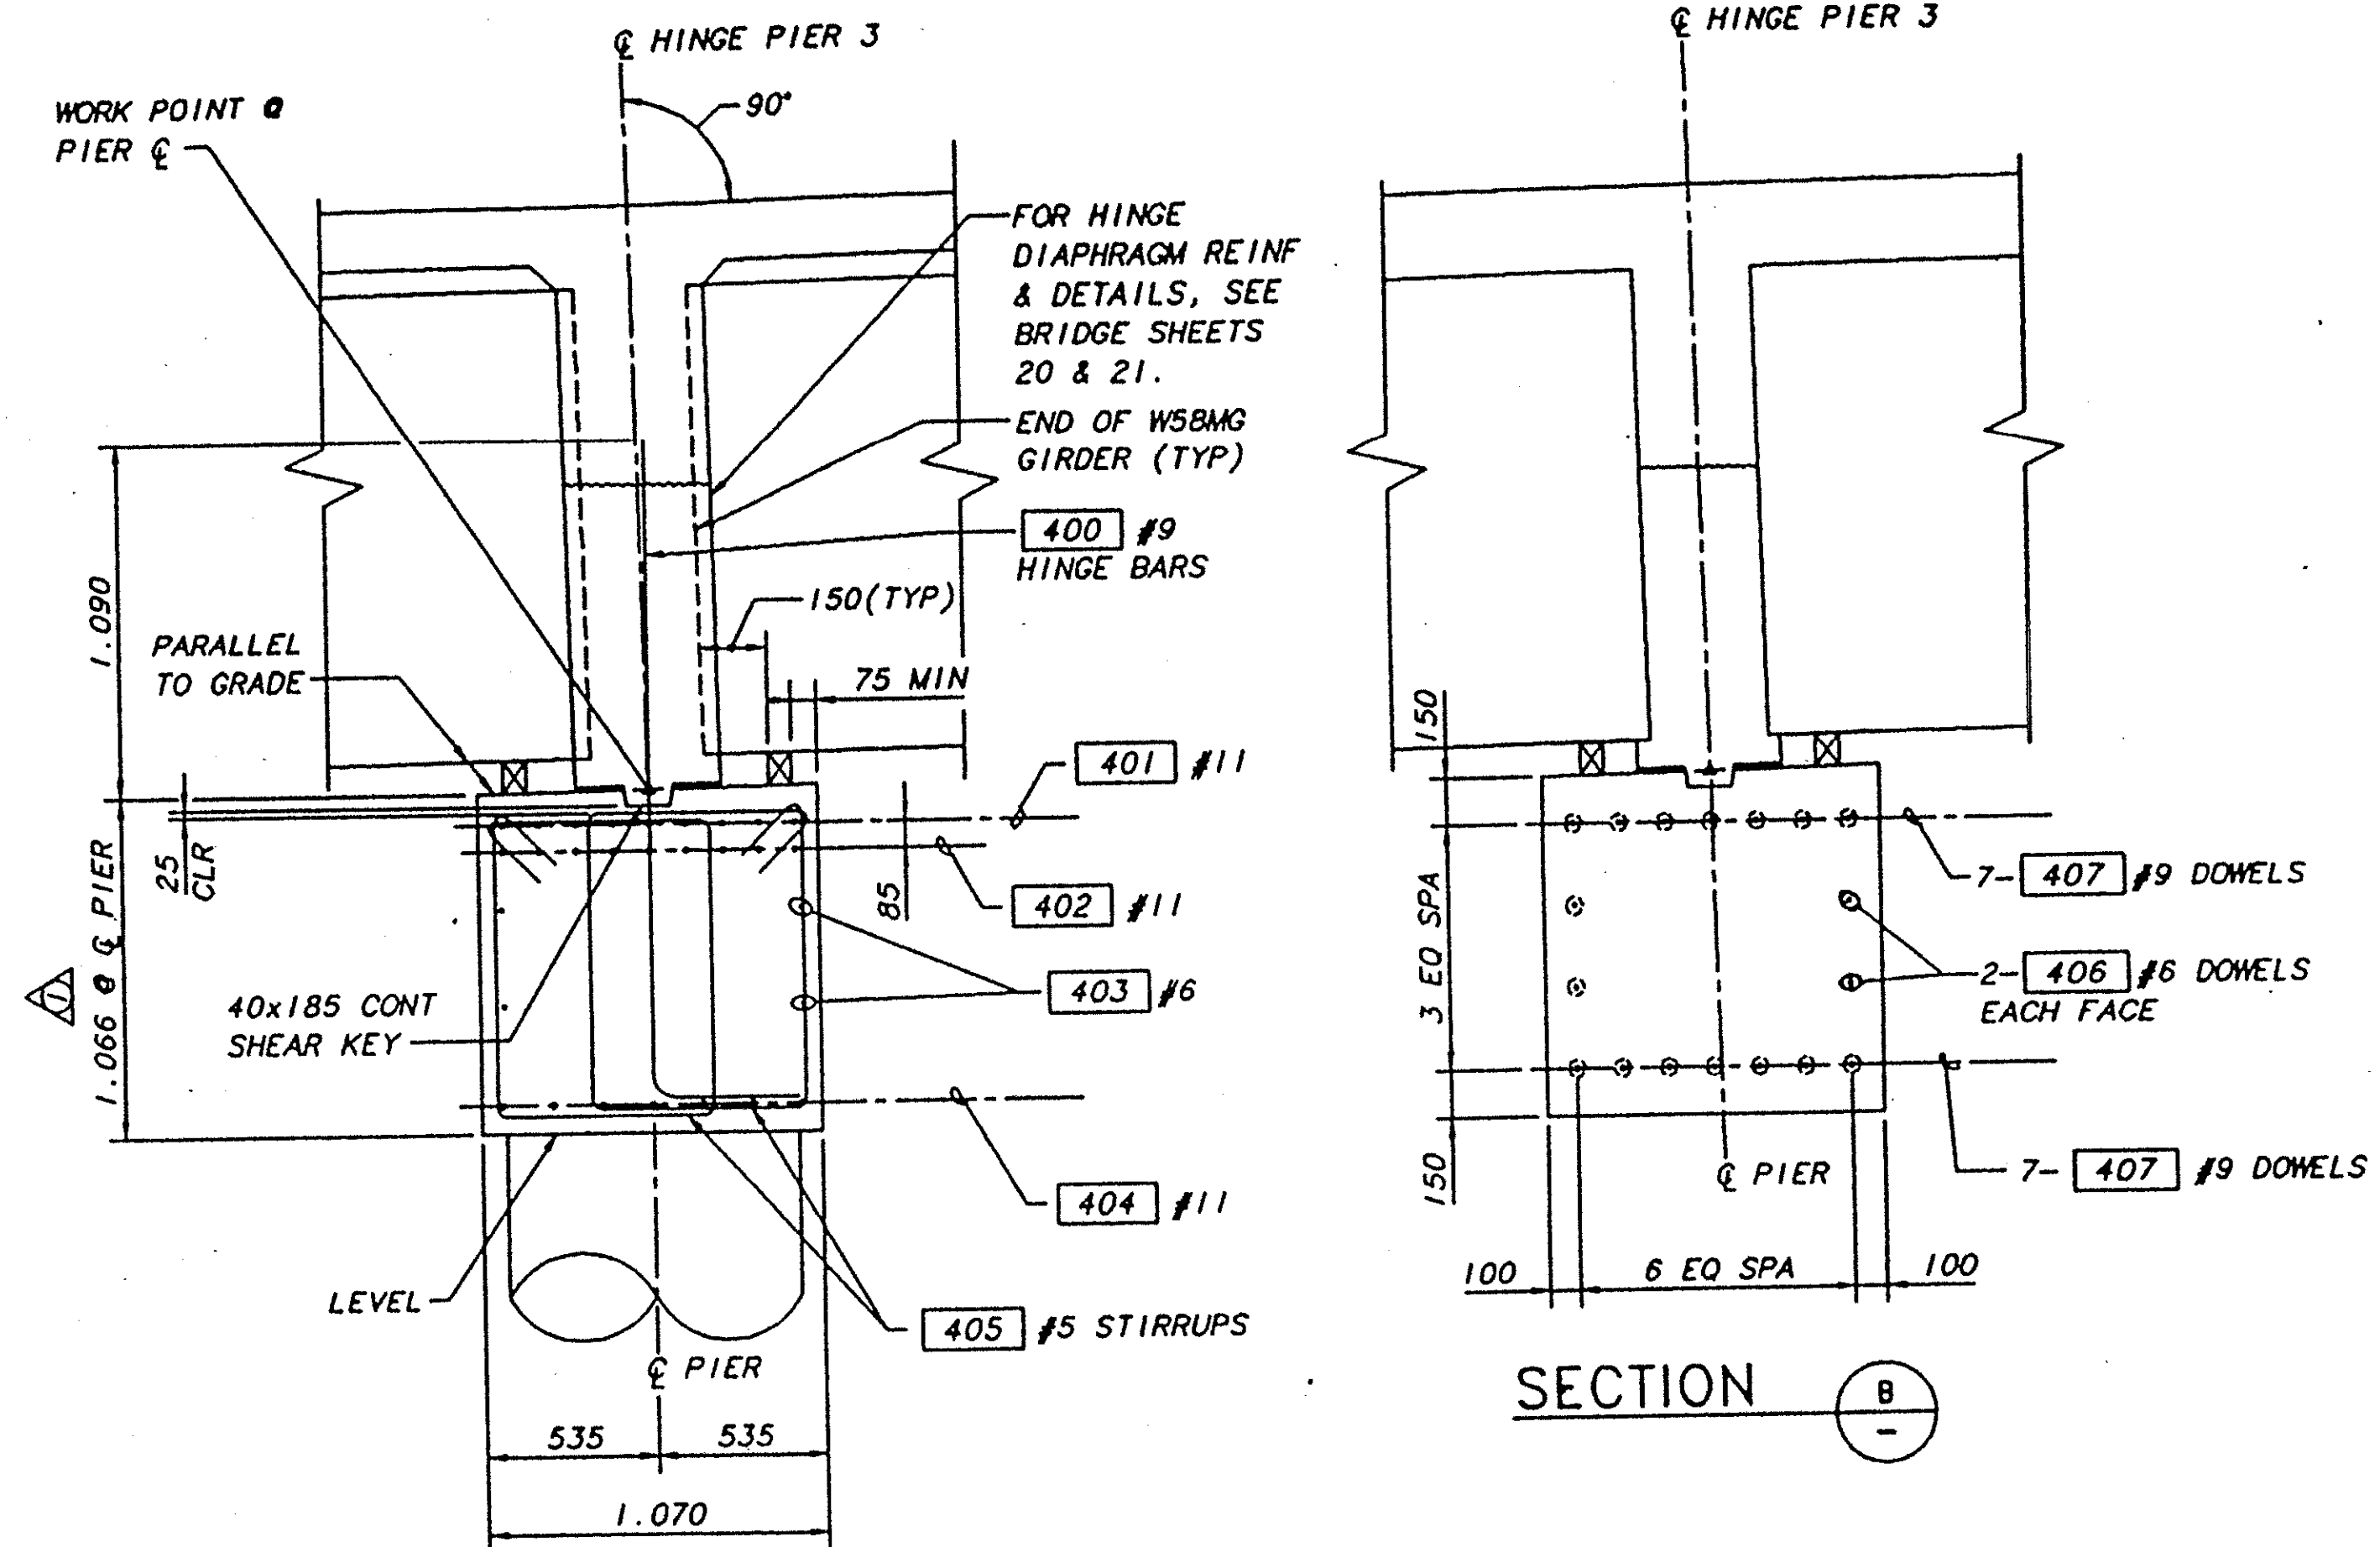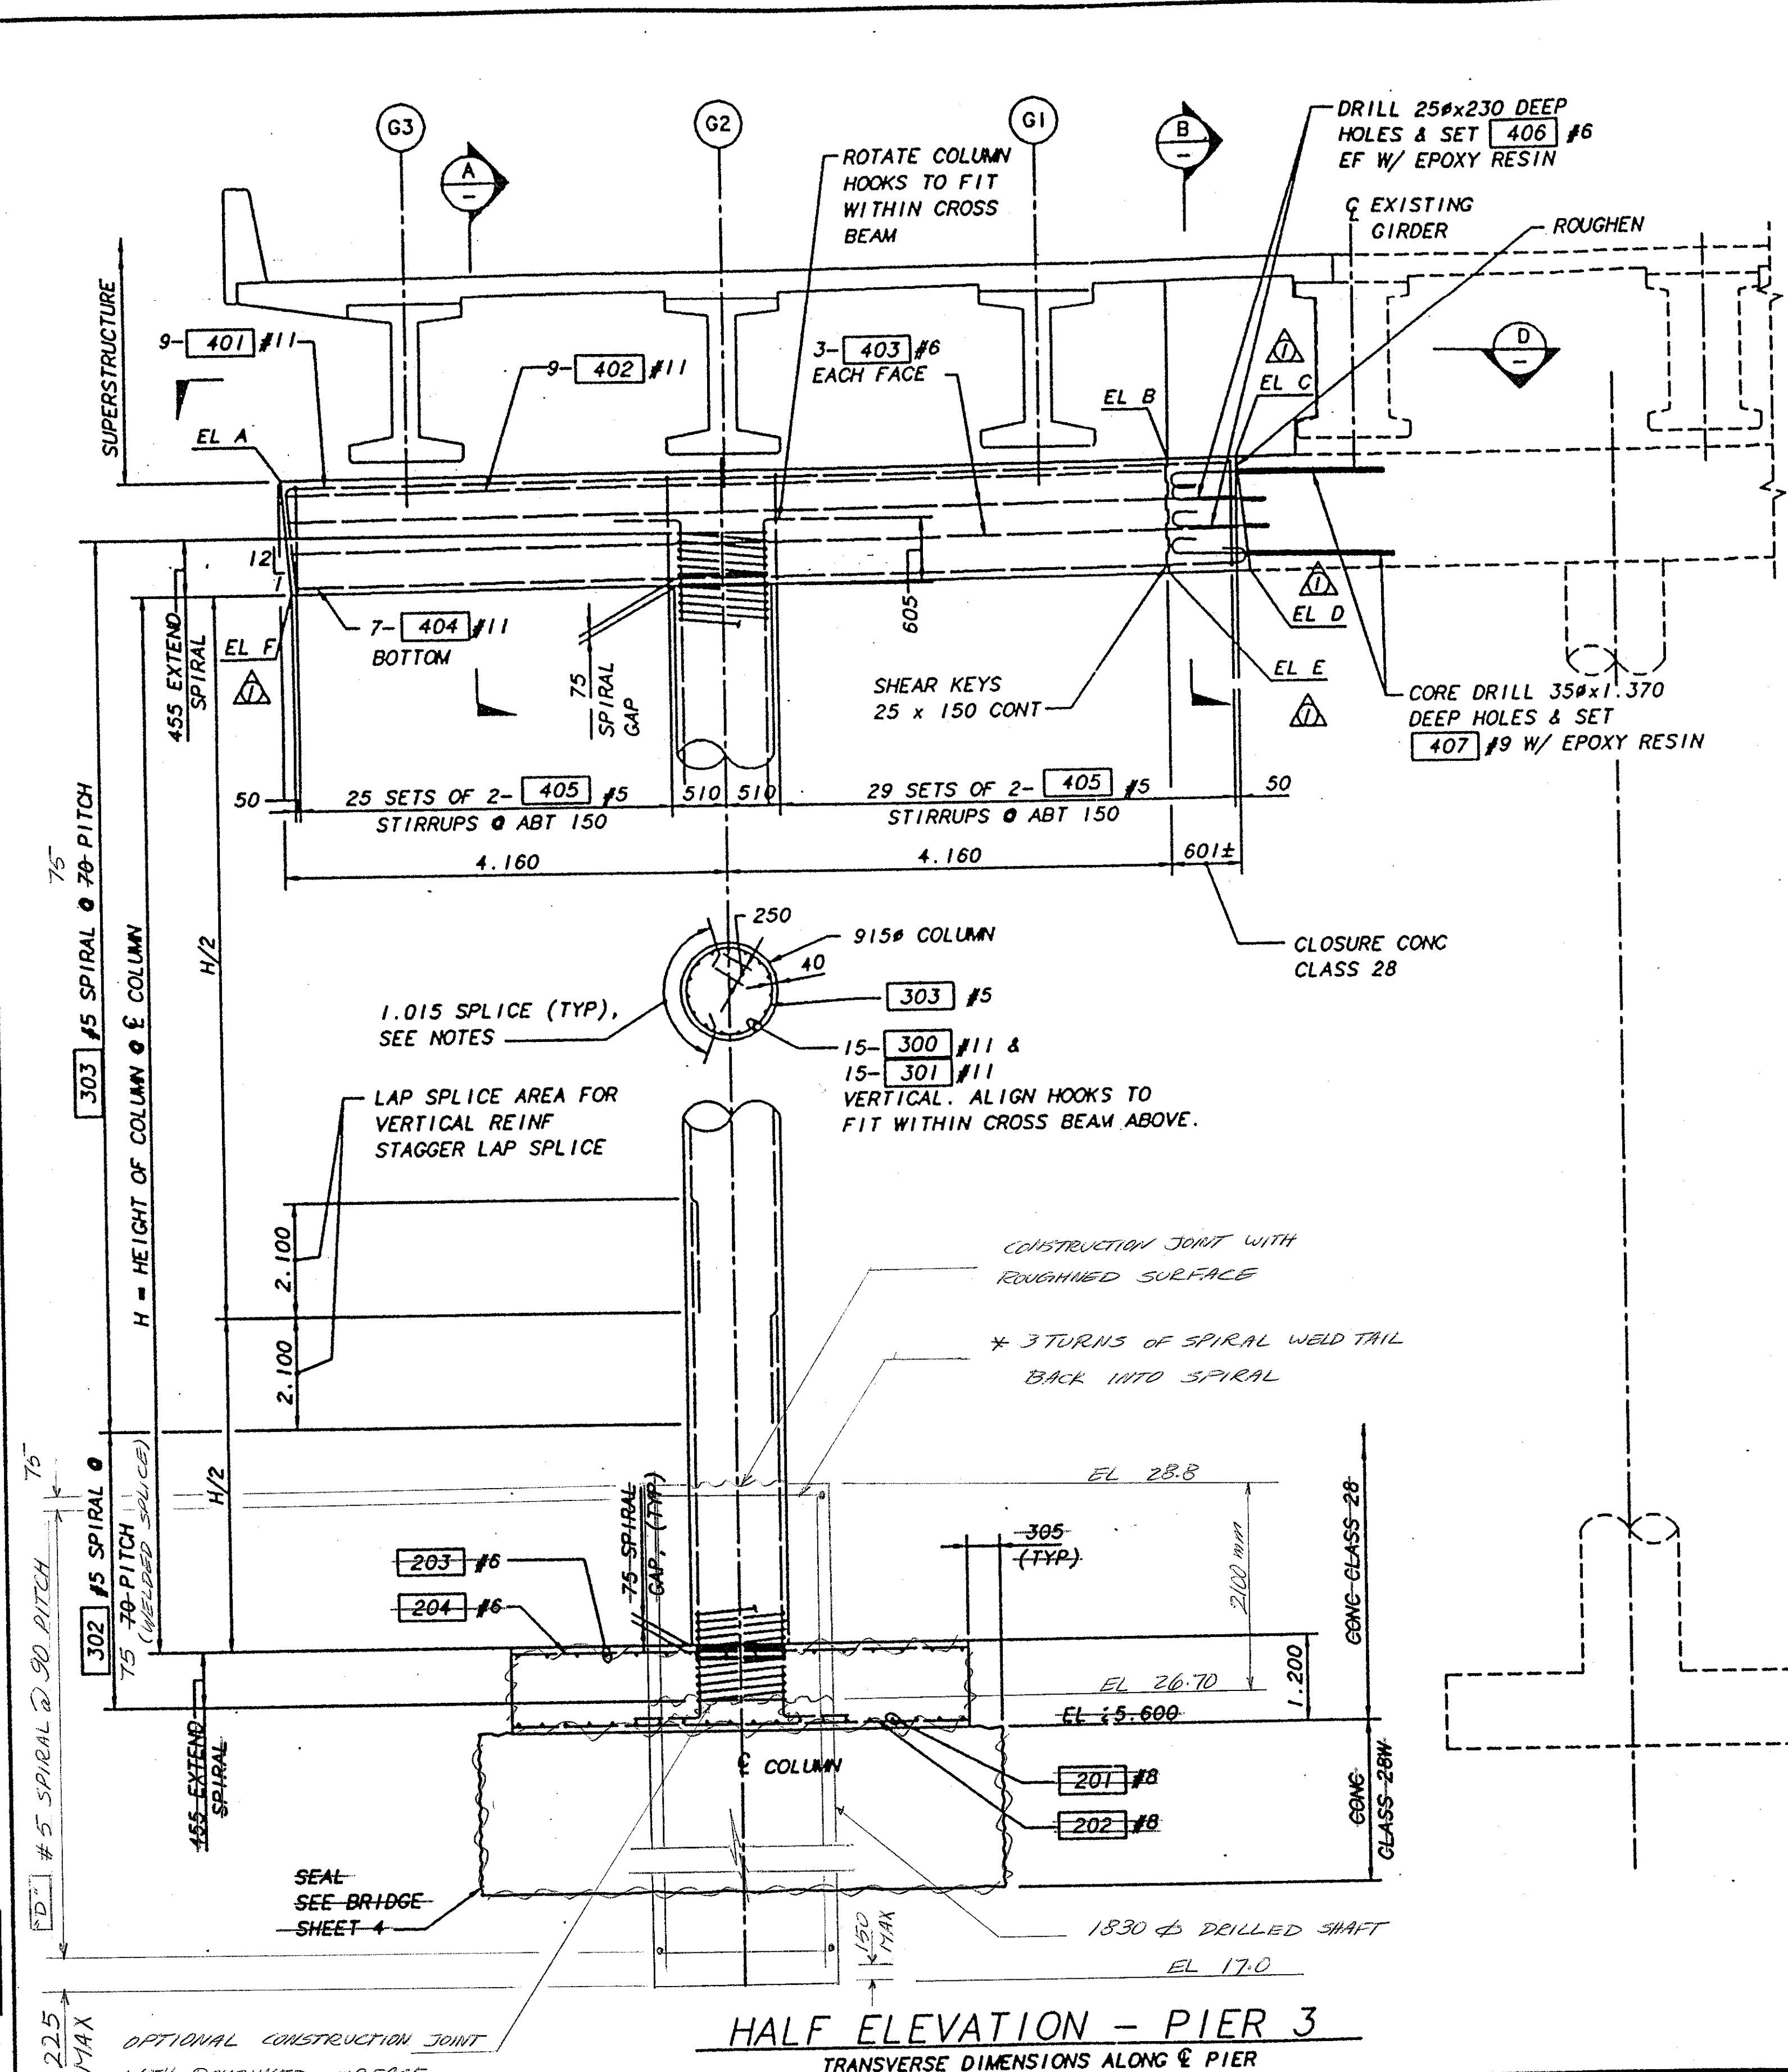

PIER & ELEVATIONS	
EL A	34.683
EL B	34.940
EL C	34.972
EL D	33.899
EL E	33.874
EL F	33.620


- COLUMN NOTES:**
- COLUMN SPIRAL BARS SHALL BE #5 DEFORMED BARS, 16 PLAIN STEEL BAR, W31 COLD DRAWN WIRE, OR D31 DEFORMED WIRE.
  - SEE DETAIL ON BR SHT 12 FOR SPIRAL WELD SPLICE ALTERNATE.
  - SPIRAL LAP SPLICE MAY BE USED ONLY WITHIN THE CENTER HALF OF COLUMN HEIGHT. WELD SPLICE SHALL BE USED EXCEPT AS NOTED.
  - TERMINATE SPIRAL WITH 1 1/2 TURNS OF SPIRAL. WELD TAIL BACK ONTO SPIRAL (SEE WELDED LAP SPLICE DETAIL)
  - SEE DRILLED SHAFT DETAILS ON SHT 11B

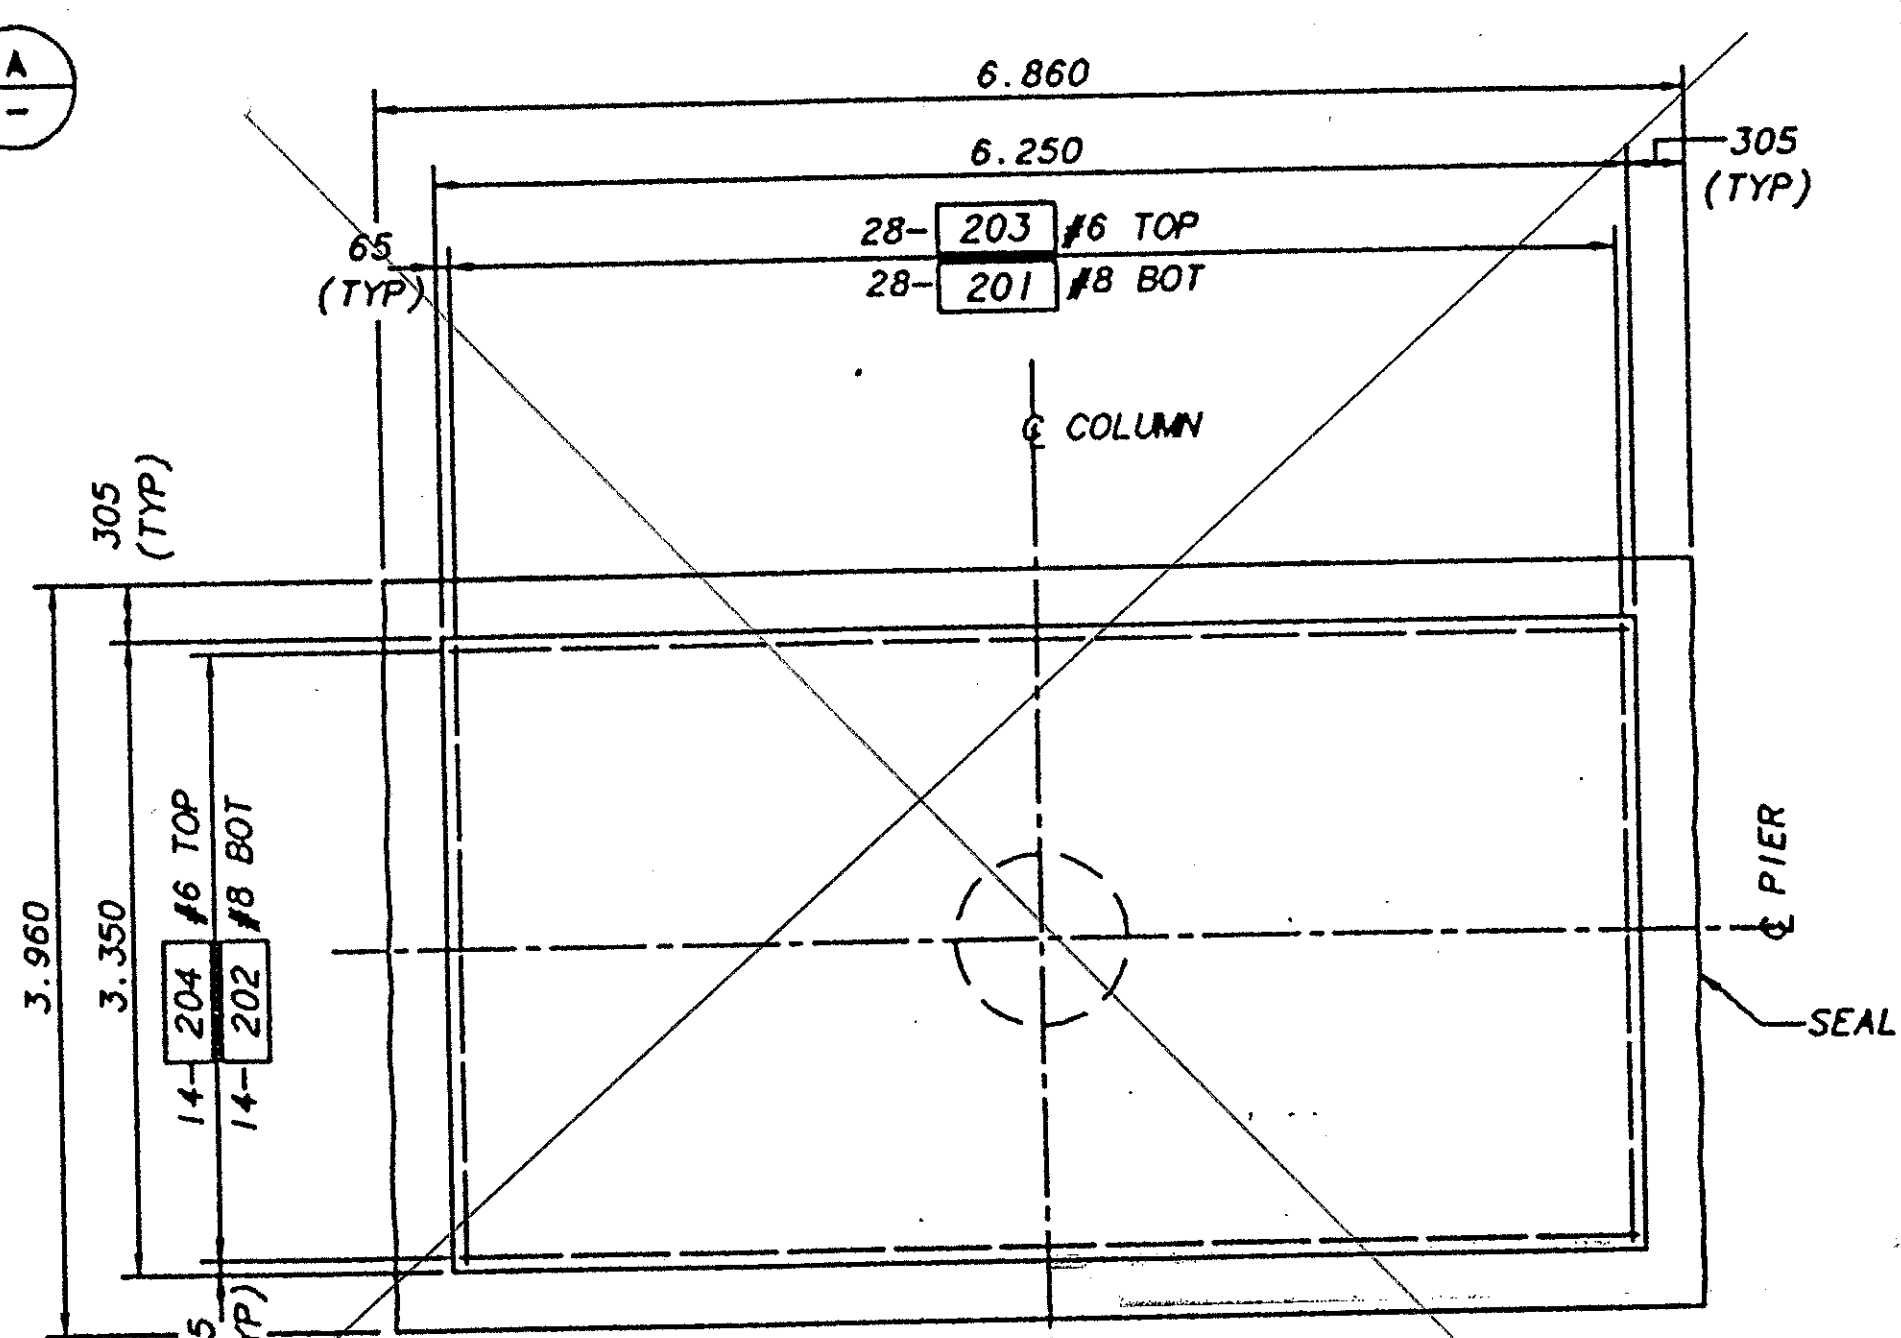

FOR "AS CONSTRUCTED PLANS" ONLY

PLAN - FOOTING PIER 3

BRIDGE DESIGN ENGR	DATE	REVISION	BY	APPR	STATE	FED AID PROJ NO	POST	DATE
DESIGNED BY	M. TRAGESSER	6/96			1	WASH		
CHECKED BY	S. ANDERSON	6/96						
DETAILED BY	R. MOHN	6/96						
BRIDGE PROJECTS ENGR	4/13/97	CHANGE ORDER #25						
PRELIM PLAN BY	10/2/96	REVISED AS-BUILT SURVEY DATA	JM					
ARCHITECT/SPECIALIST								

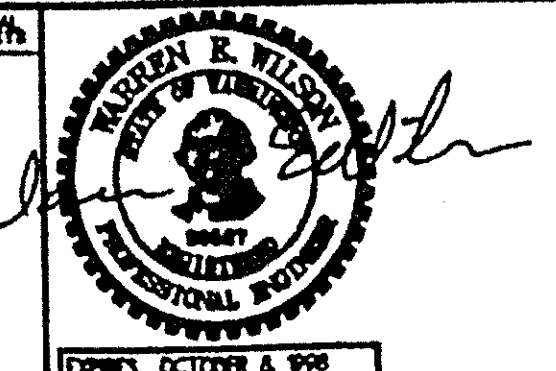


**BERGER/ABAM ENGINEERING INC.**  
3300 7TH AVENUE SOUTH  
FEDERAL WAY, WASHINGTON 98003-6396  
(206) 431-2300 FAX: (206) 431-2390


**Washington State Department of Transportation**

SR 405  
BOTHELL TO SWAMP CREEK I/C  
HOV LANES - STAGE 1  
228TH BRIDGE 405/103E  
PIER 3 PLAN, ELEVATION & SECTIONS

BRIDGE SHEET NO. 11A  
SHEET 509A OF 663 SHEETS

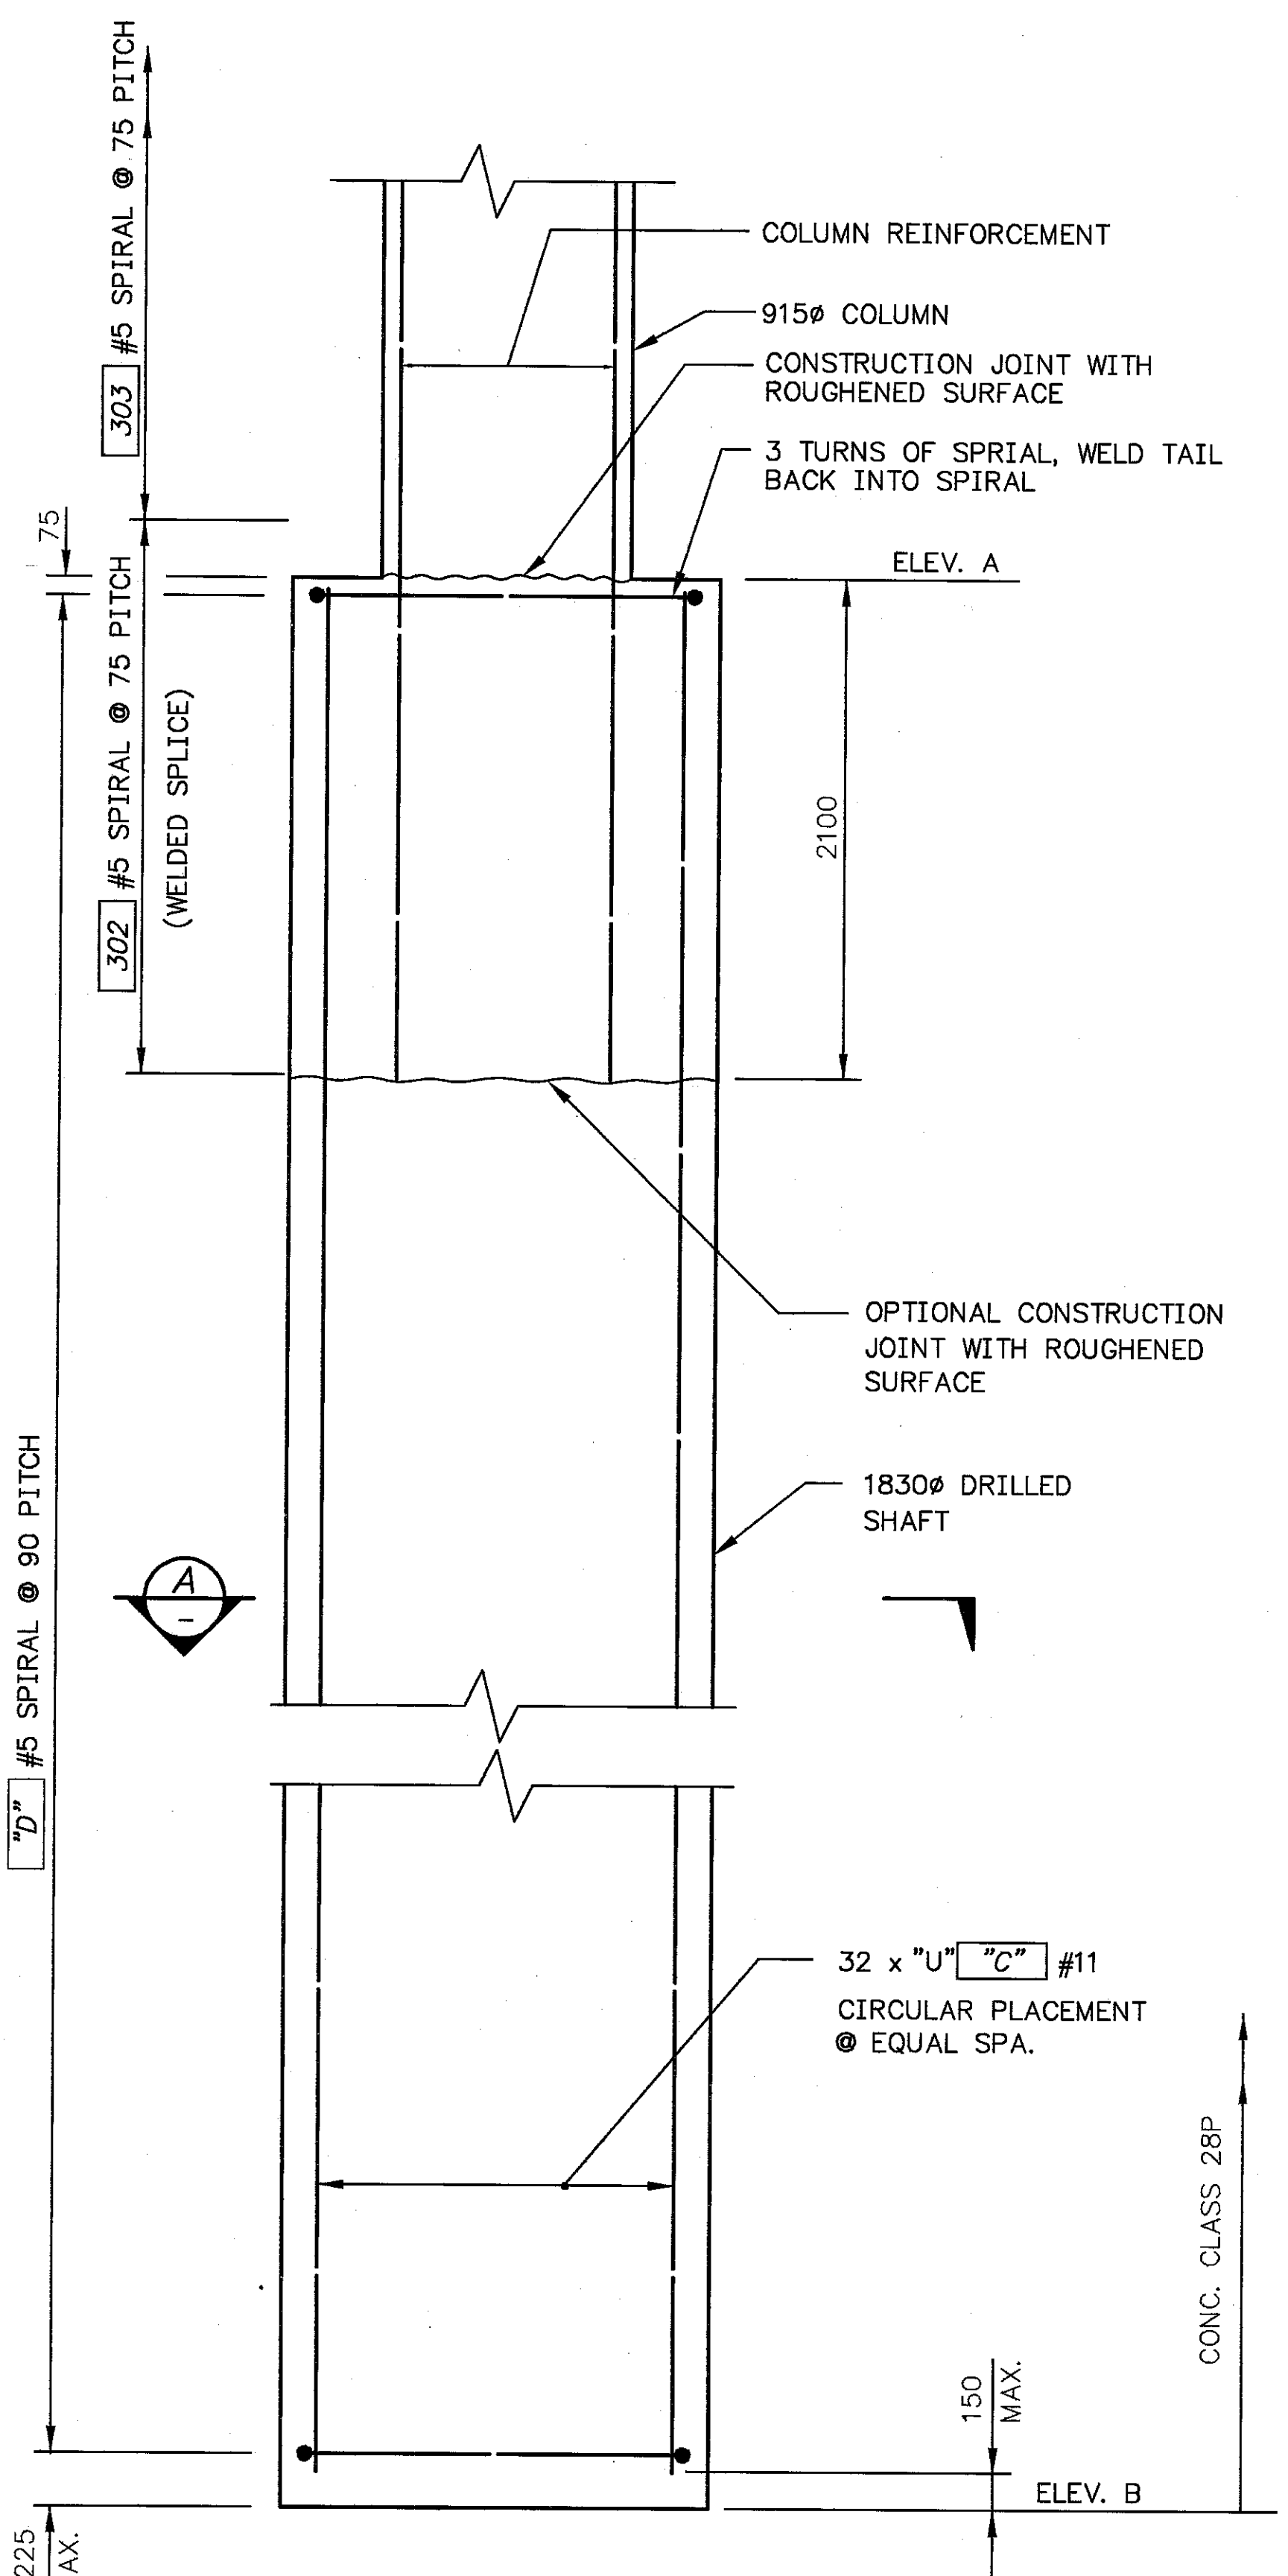


PIERS 2 & 3

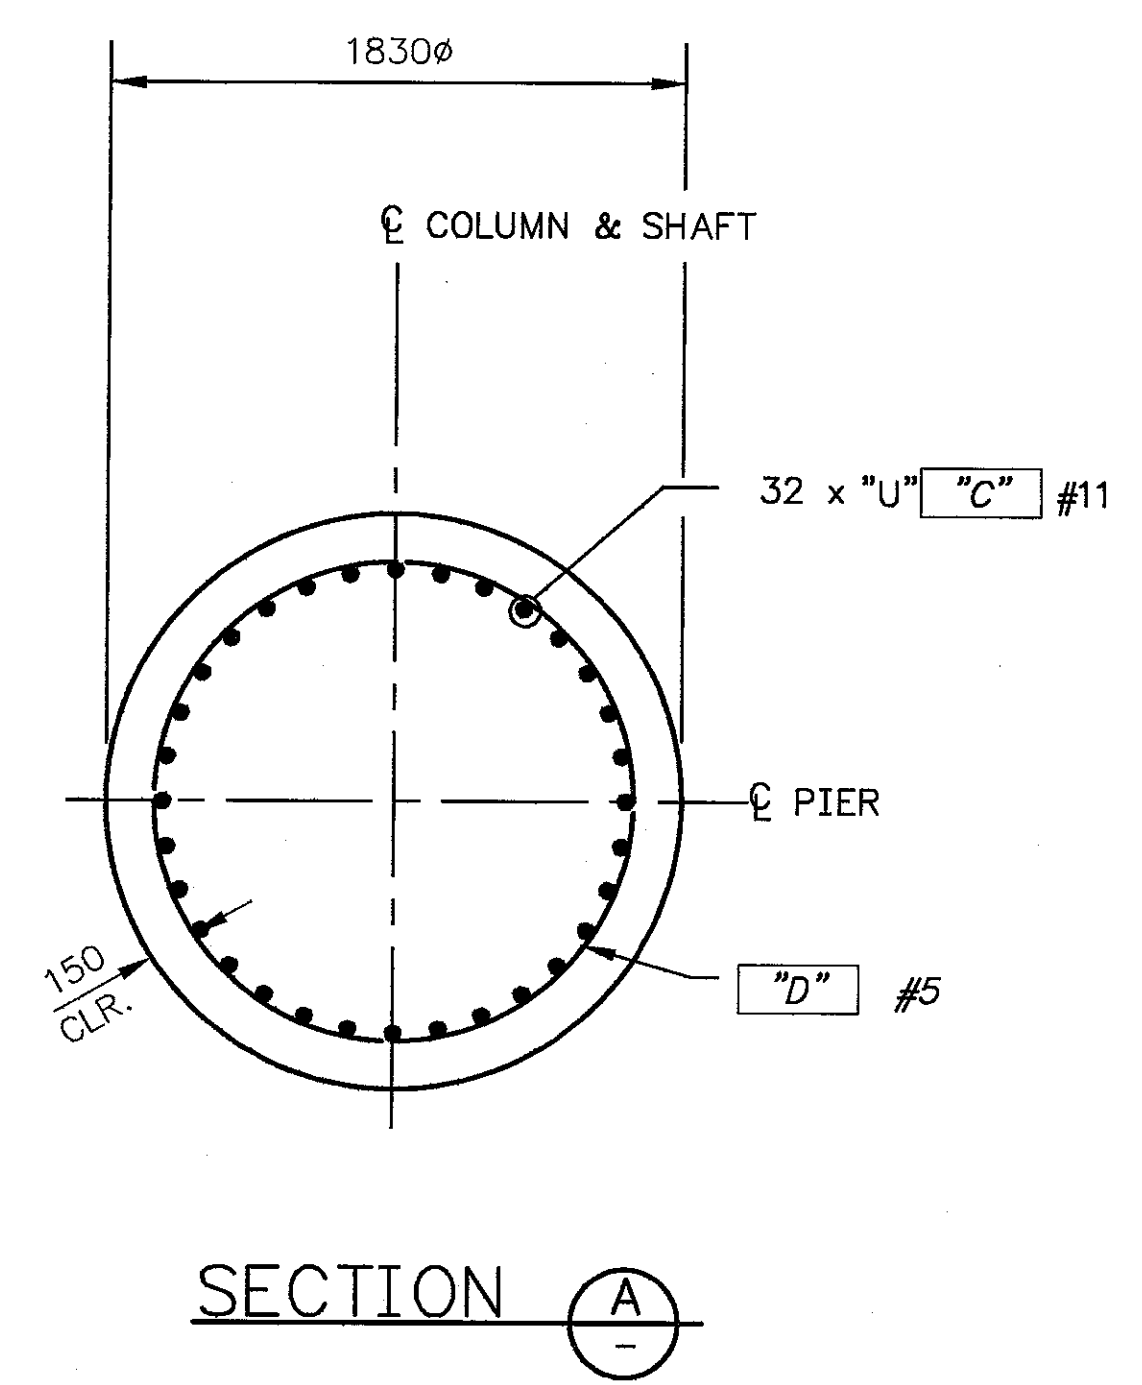

SECTION A

PIERS 2 & 3 DRILLED SHAFT TABLE *					
EAST BRIDGE					
SHAFT AT PIER	ELEV. A**	ELEV. B	MARK "C"	MARK "D"	"U" (M)
2	28.8	15.6	900	902	13.025
3	28.8	17.0	901	903	11.625

\* ELEV. GIVEN IN METERS  
 \*\* BASED ON GROUND SURFACE ELEVATION OF 29.4 (VERIFY IN THE FIELD.)

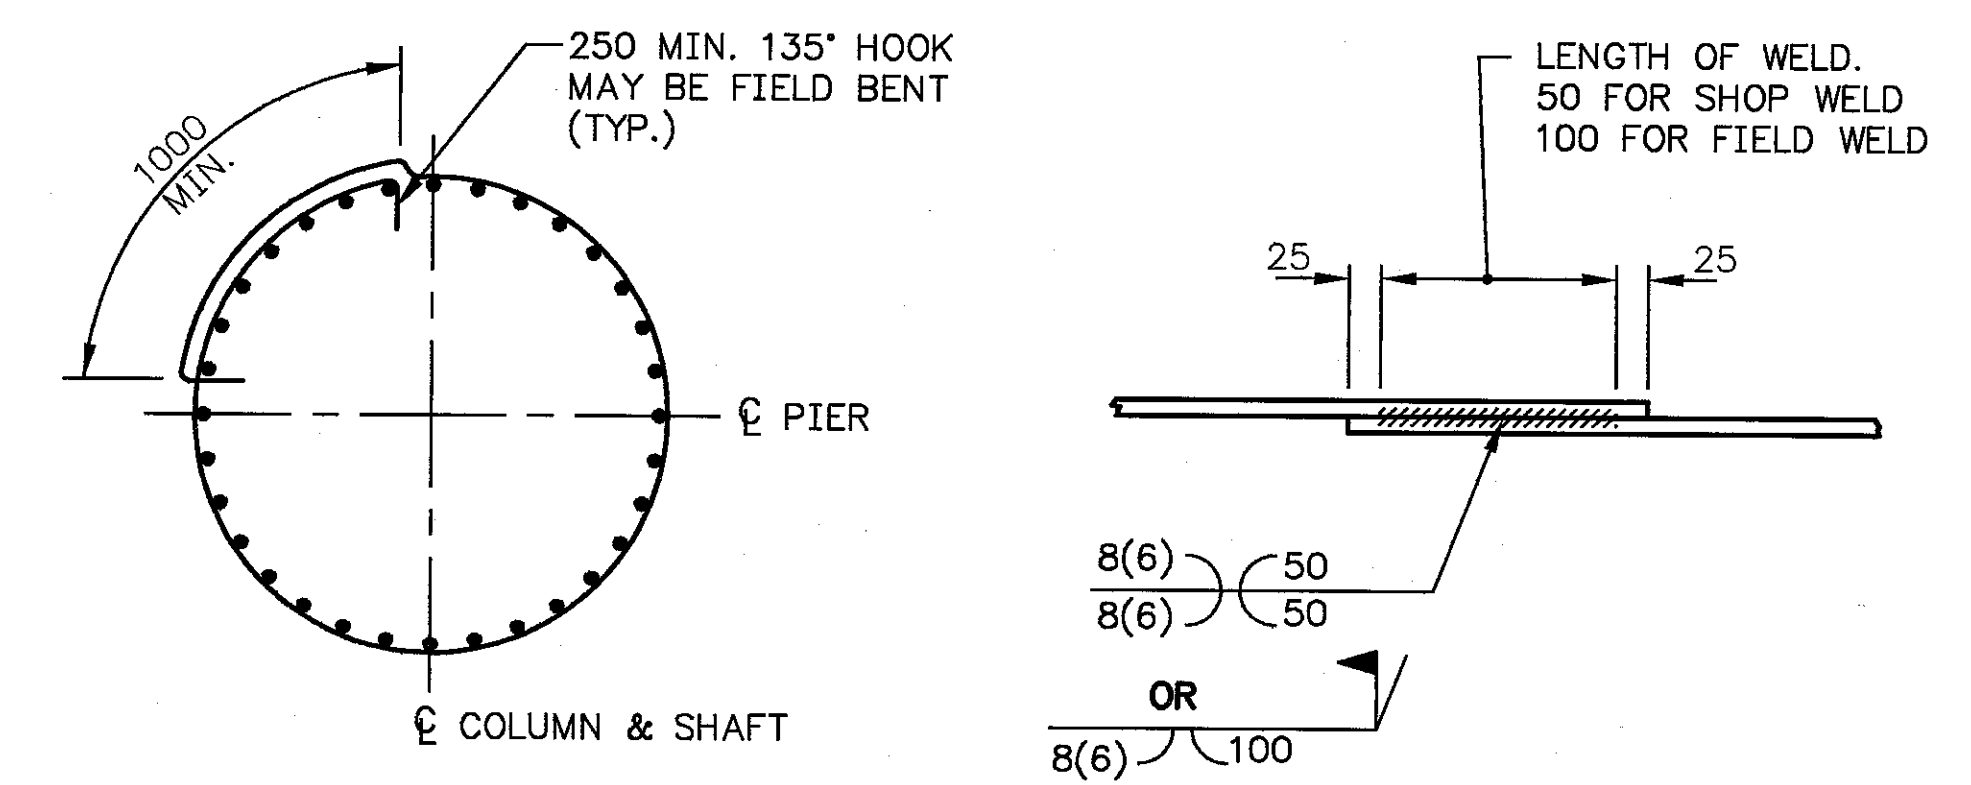

ALTERNATE 1  
LAP SPLICE  
 ALTERNATE 2  
WELDED SPLICE  
 TYPICAL SPIRAL AND HOOP TIE SPLICE DETAILS

NOTES:  
 1. END OF SPIRAL SHALL BE SPLICED BACK ONTO ITSELF WHERE SPIRAL IS DISCONTINUOUS.

- NOTES:
1. THE CONTRACTOR SHALL PROVIDE ADQUATE REINFORCING TIES AND BRACING FOR CONSTRUCTION AND PLACEMENT OF REINFORCING CAGE. THE CAGE LIFTING POINTS SHALL BE DETERMINED BY THE CONTRACTOR.
  2. THE CONTRACTOR SHALL PROVIDE CASING AS REQUIRED TO MAINTAIN ALL DRILLED HOLES AND SHAFTS FREE FROM SLOUGHING AND CAVING OF SURROUNDING SOIL.
  3. FOR #5 SPIRAL, 16Ø PLAIN STEEL BAR, D31 DEFORMED WIRE OR W31 COLD DRAWN WIRE MAY BE USED AS ALTERNATIVES.
  4. THE CONCRETE IN THE SHAFTS SHALL BE CLASS 28P.
  5. THE MAXIMUM DESIGN LOAD OF EACH SHAFT IS 4000 KN DEVELOPED THROUGH A COMBINATION OF POINT BEARING AND SKIN FRICTION.




4/7/1998 2:54 P.M. H:\JOB85\7088\CADD\STRUCT\02-STP23.DWG INCA\_F.PCP OIF 1.0


DRAWN V.P.		DESIGNED BY S.H.		CHECKED BY B.R.		PROJ. ENGR. A.A.		DIST. ADM.		3/98 DATE		NEW DRILL SHAFT SHEET REVISION		MV BY APP'D		5054		REGION STATE FED. AID PROJ. NO. SHEET TOTAL 1 WASH JOB NUMBER 96W035 CONTRACT NO. 5054		INCA ENGINEERS INC. 400 112th Avenue NE Bellevue, WA 98004 (425) 635-1000		Washington State Department of Transportation		SR 405 BOTHELL TO SWAMP CREEK I/C HOV LANES - STAGE 1 228th BRIDGE 405/103 E		BRIDGE SHEET #11B SHEET 509B OF 663 SHEETS		PIER 2 & 3 DRILLED SHAFTS	
------------	--	------------------	--	-----------------	--	------------------	--	------------	--	-----------	--	--------------------------------	--	-------------	--	------	--	---	--	--	--	--	--	---	--	---	--	---------------------------	--

PLOTTED: Mon Oct 13 1997 9:20am FILENAME: V:\96077\405-103E\12.dwg SCALE: 30

SR 405 JOB NO. 7079 SHEET 12 OF 31

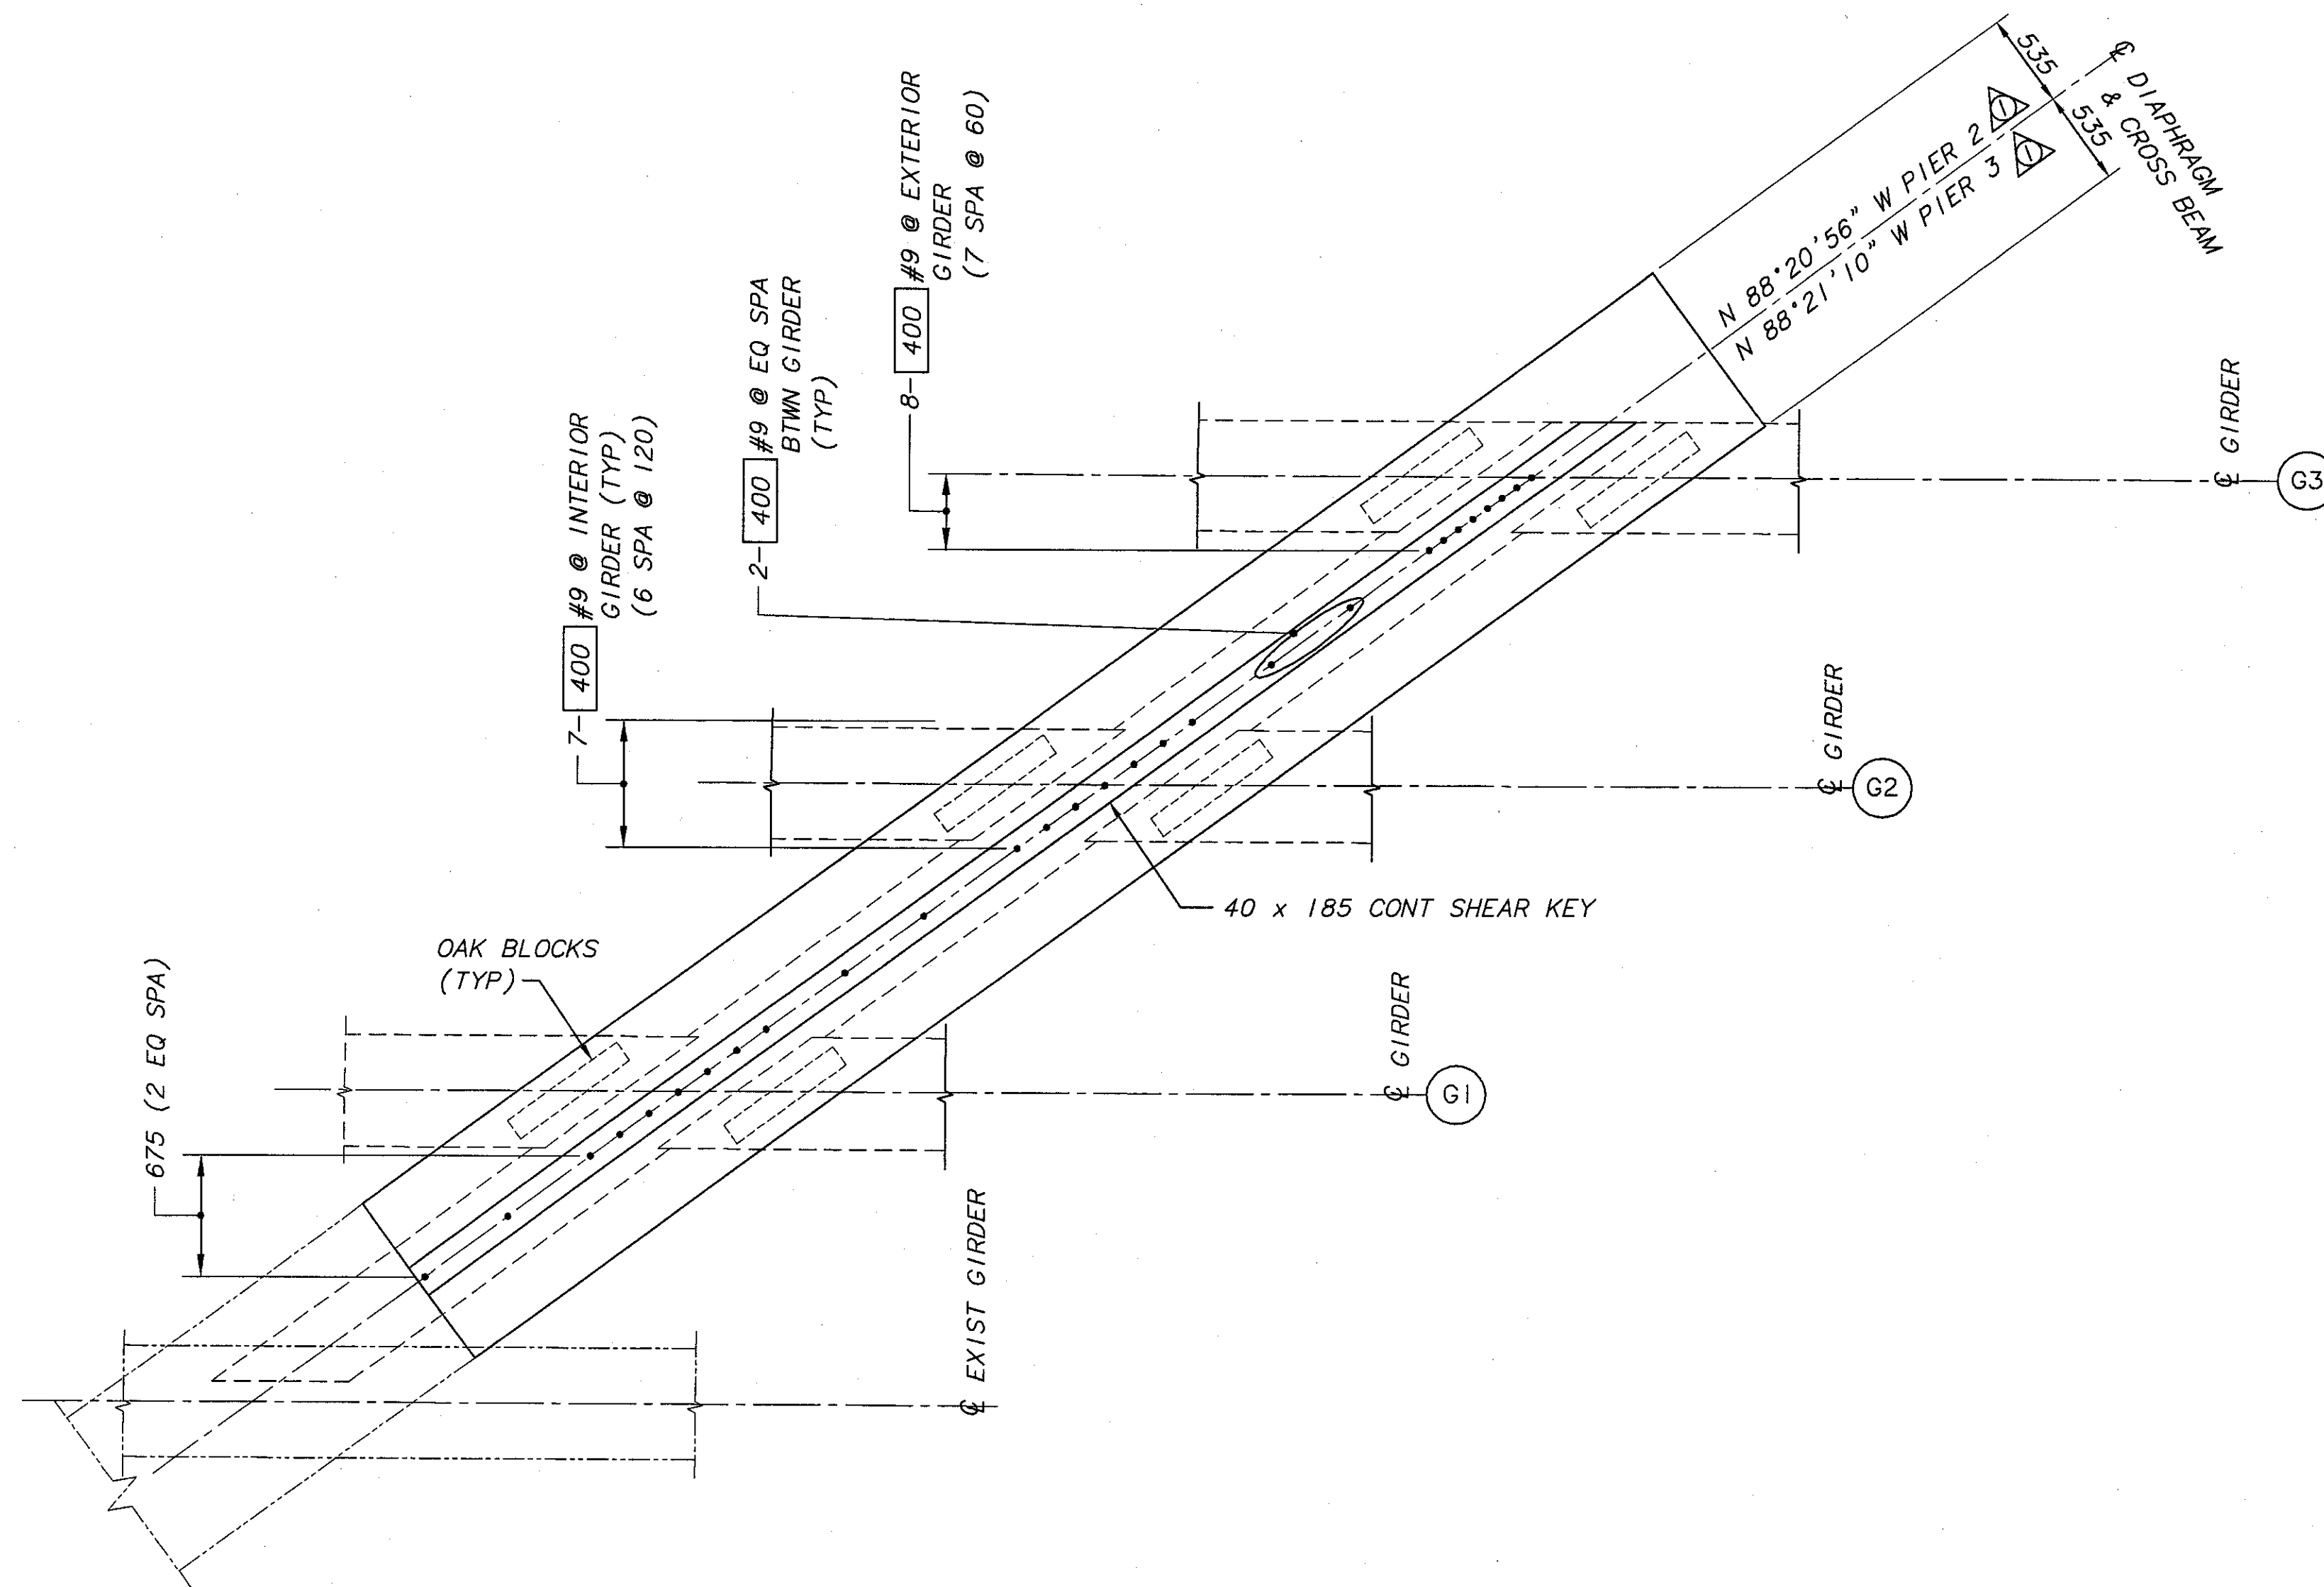


PLAN - HINGE BARS

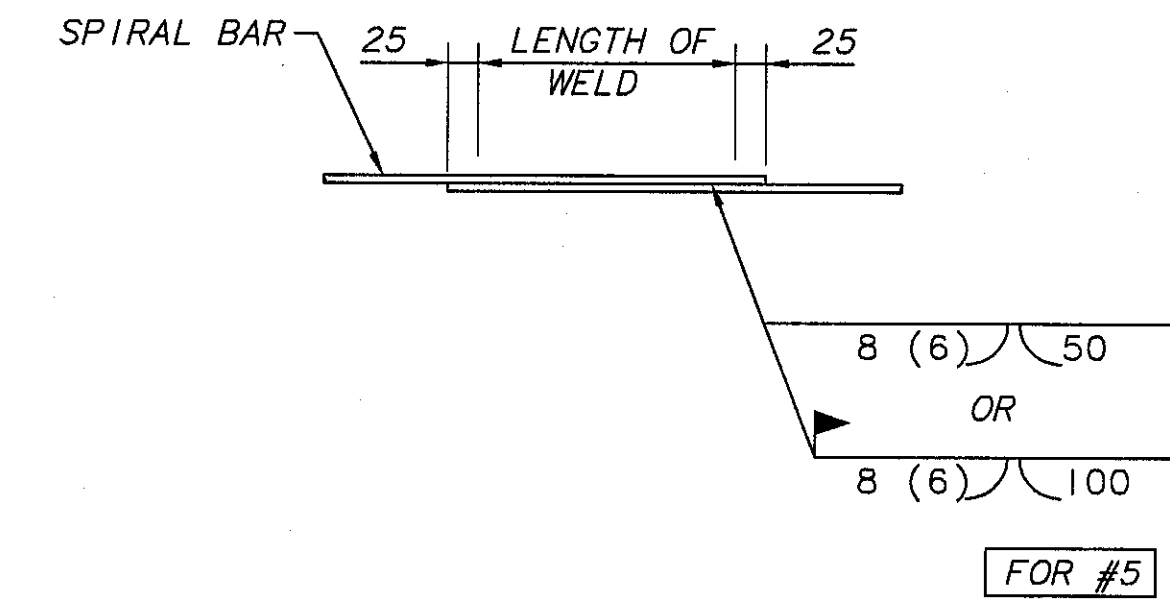

WELDED LAP SPLICE DETAIL


BRIDGE DESIGN ENGR				REGION NO.	STATE	FED AID PROJ NO.	SHEET NO.	TOTAL SHEETS			SR 405 BOTHELL TO SWAMP CREEK I/C HOV LANES - STAGE 1 228TH BRIDGE 405/103E PIER 2 & 3 DETAILS	BRIDGE SHEET NO. 12 SHEET 510 OF 663 SHEETS
SUPERVISOR			I	WASH								
DESIGNED BY	M. TRAGESSER	6/96			JOB NUMBER	96WQ35						
CHECKED BY	S. ANDERSON	6/96			CONTRACT NO.	5054						
BRIDGE PROJECTS ENGR												
PRELIM PLAN BY			10/97	REVISED AS-BUILT SURVEY DATA	MLT							
ARCHITECT/SPECIALIST			DATE	REVISION	BY	APPR						

**BERGER/ABAM**  
ENGINEERS INC.  
33301 9TH AVENUE SOUTH  
FEDERAL WAY, WASHINGTON, WASH. 98003-3389  
(206)431-2500 FAX: (206)431-2280

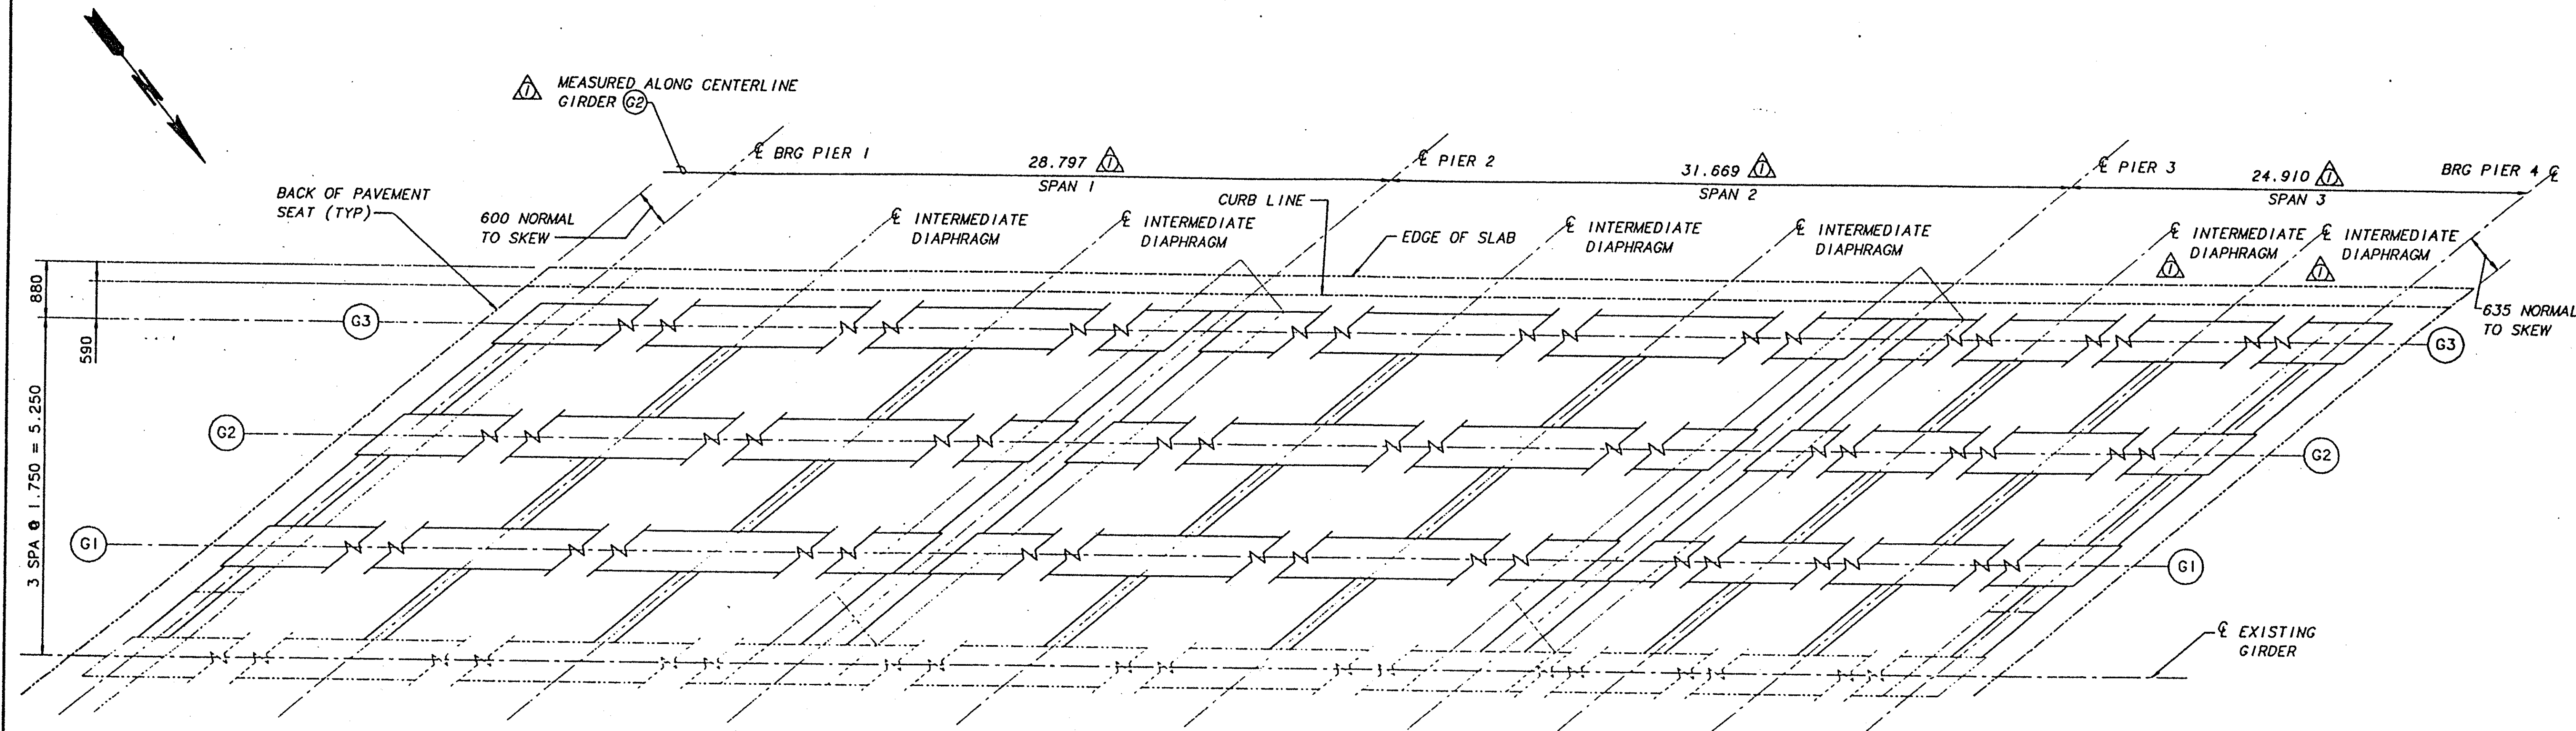


**FRAMING PLAN**

BEARINGS OF ALL PIER WIDENING TO MATCH EXISTING  
 INTERMEDIATE DIAPHRAGM LOCATIONS TO MATCH EXISTING - SEE BRIDGE SHEET 16

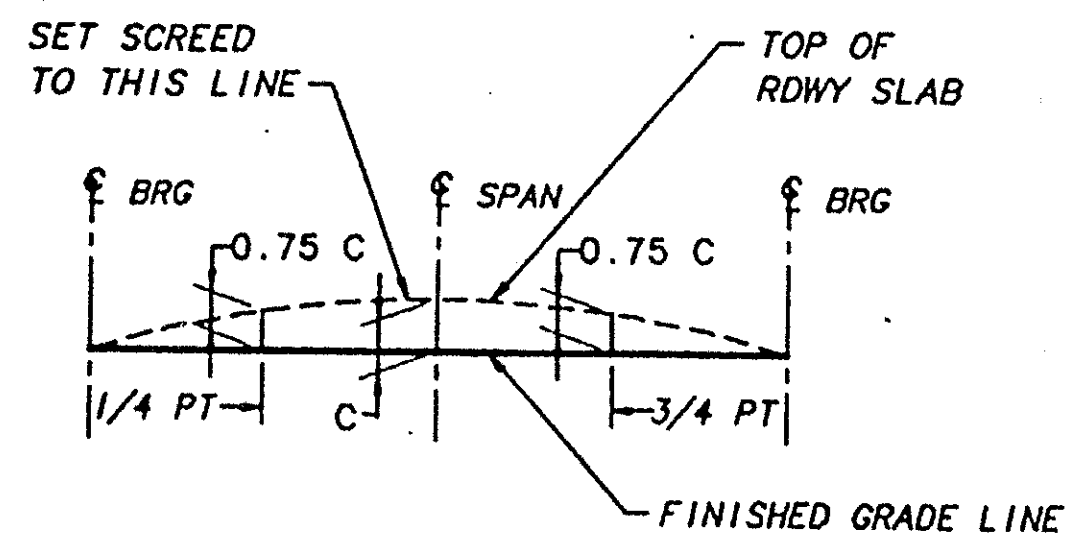

**SCREED SETTING DIMENSIONS**  
 FOR DIMENSION 'C', SEE GIRDER SCHEDULE BR SHT 16

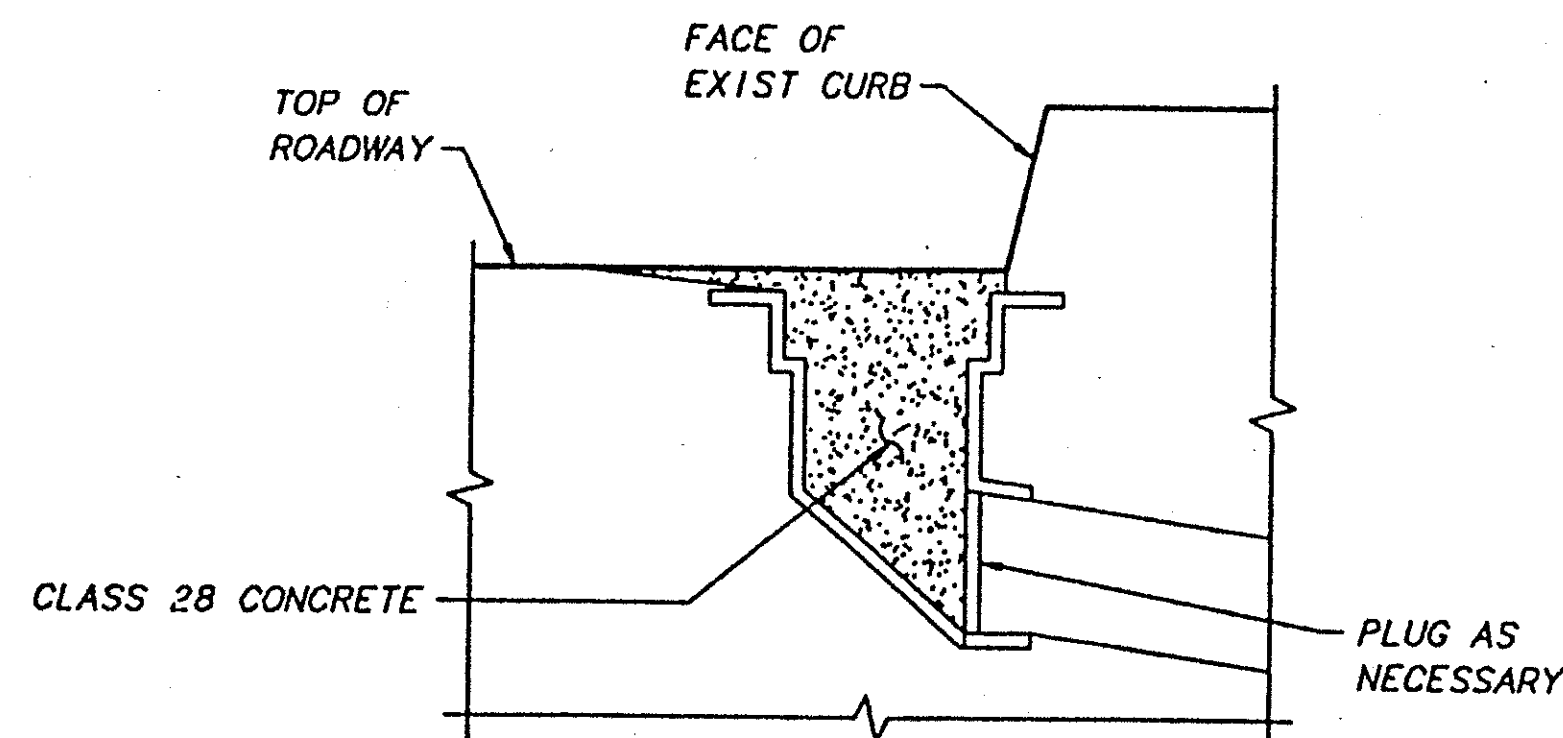

**BRIDGE DRAIN PLUG DETAIL**

REMOVE DRAIN GRATING & GALV STEEL CHAIN  
 FILL DRAIN W/CLASS 28 CONCRETE AFTER PLUGGING (2 REQ'D)


**FOR "AS CONSTRUCTED PLANS" ONLY**

LOTTED: Mon Oct 13 1997 9:27am FILENAME: X:\96077\405-103E\13.dwg SCALE: 50


SR 405 JOB NO. 7079 SHEET 13 OF 31

BRIDGE DESIGN ENGR					
SUPERVISOR					
DESIGNED BY	M. TRAGESSER	6/96			
CHECKED BY	S. ANDERSON	6/96			
DETAILED BY	R. MOHN	6/96			
BRIDGE PROJECTS ENGR					
PRELIM PLAN BY		10/97	REVISED AS-BUILT SURVEY DATA	M.T.	
ARCHITECT/SPECIALIST		DATE	REVISION	BY	APPR

REGION	STA	FED AID PROJ NO	SHEET	TOTAL SHEETS
1	WASH			
JOB NUMBER	96W035			
CONTRACT NO.				

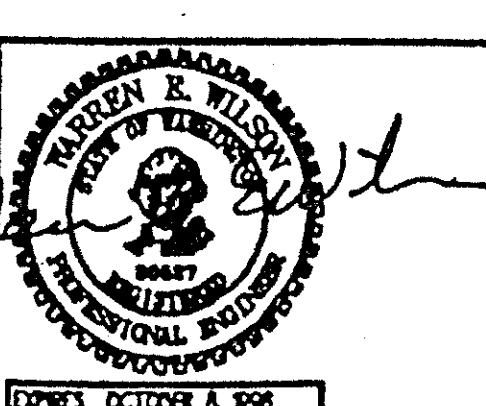

**BERGER/ABAM**  
 ENGINEERS INC.  
 3320 8TH AVENUE SOUTH  
 FEDERAL WAY, WASHINGTON 98003-6348  
 (206)431-2200 FAX: (206)431-2200

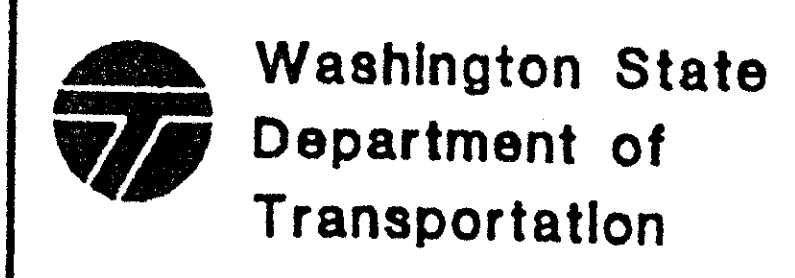

SR 405  
 BOTHELL TO SWAMP CREEK 1/C  
 HOV LANES - STAGE 1  
 228TH BRIDGE 405/103E  
 FRAMING PLAN

BRIDGE SHEET NO. 13  
 SHEET 511 OF 663 SHEETS

**NOTES**

ALL DETAILS ON THIS SHEET ARE FOR PRETENSIONED DESIGN ONLY.  
 PLAN LENGTH SHALL BE INCREASED AS NECESSARY TO COMPENSATE FOR SHORTENING DUE TO PRESTRESS AND SHRINKAGE.  
 EXTRA CAUTION MUST BE EXERCISED IN HANDLING AND PLACING ALL GIRDERS.  
 ALL GIRDERS OVER 32,000 LONG SHALL BE BRACED Laterally TO PREVENT TIPPING OR BUCKLING.  
 THE TOP SURFACE OF THE GIRDER FLANGE SHALL BE ROUGHENED IN ACCORDANCE WITH SECTION 6-02.3(25)H OF THE STANDARD SPECIFICATIONS.

IF THE LIFTING LOOPS EXTEND WITHIN 75 OF THE TOP OF THE ROADWAY SLAB THEY SHALL BE CUT OFF PRIOR TO PLACING THE ROADWAY SLAB. ALL LIFTING STRANDS SHALL BE OF THE SAME MATERIAL AND STRENGTH AS THE PRESTRESSING STRANDS. WRAP THE LIFTING LOOPS SO THAT EACH STRAND WILL CARRY ITS SHARE OF THE TOTAL LOAD. EXTEND LIFTING LOOPS ENDING WITH A 230 LONG 90° HOOK TO WITHIN 75 CLEAR OF THE BOTTOM OF THE GIRDER.


CUT ALL STRANDS FLUSH WITH THE GIRDER ENDS AND PAINT WITH AN APPROVED EPOXY RESIN EXCEPT FOR EXTENDED STRANDS AS SHOWN.

FORMS FOR BEARING PAD RECESSES SHALL BE CONSTRUCTED AND FASTENED IN SUCH A MANNER AS NOT TO CAUSE DAMAGE TO THE GIRDER DURING THE STRAND RELEASE OPERATION.


ALL STRANDS ARE 13φ LOW RELAXATION STRANDS (AASHTO M203 GRADE 1860).

EXTENDED STRANDS AND BARS ARE PARALLEL TO GIRDER.


FOR SAWTEETH DETAILS SEE W58MG GIRDER DETAILS 2 OF 2.

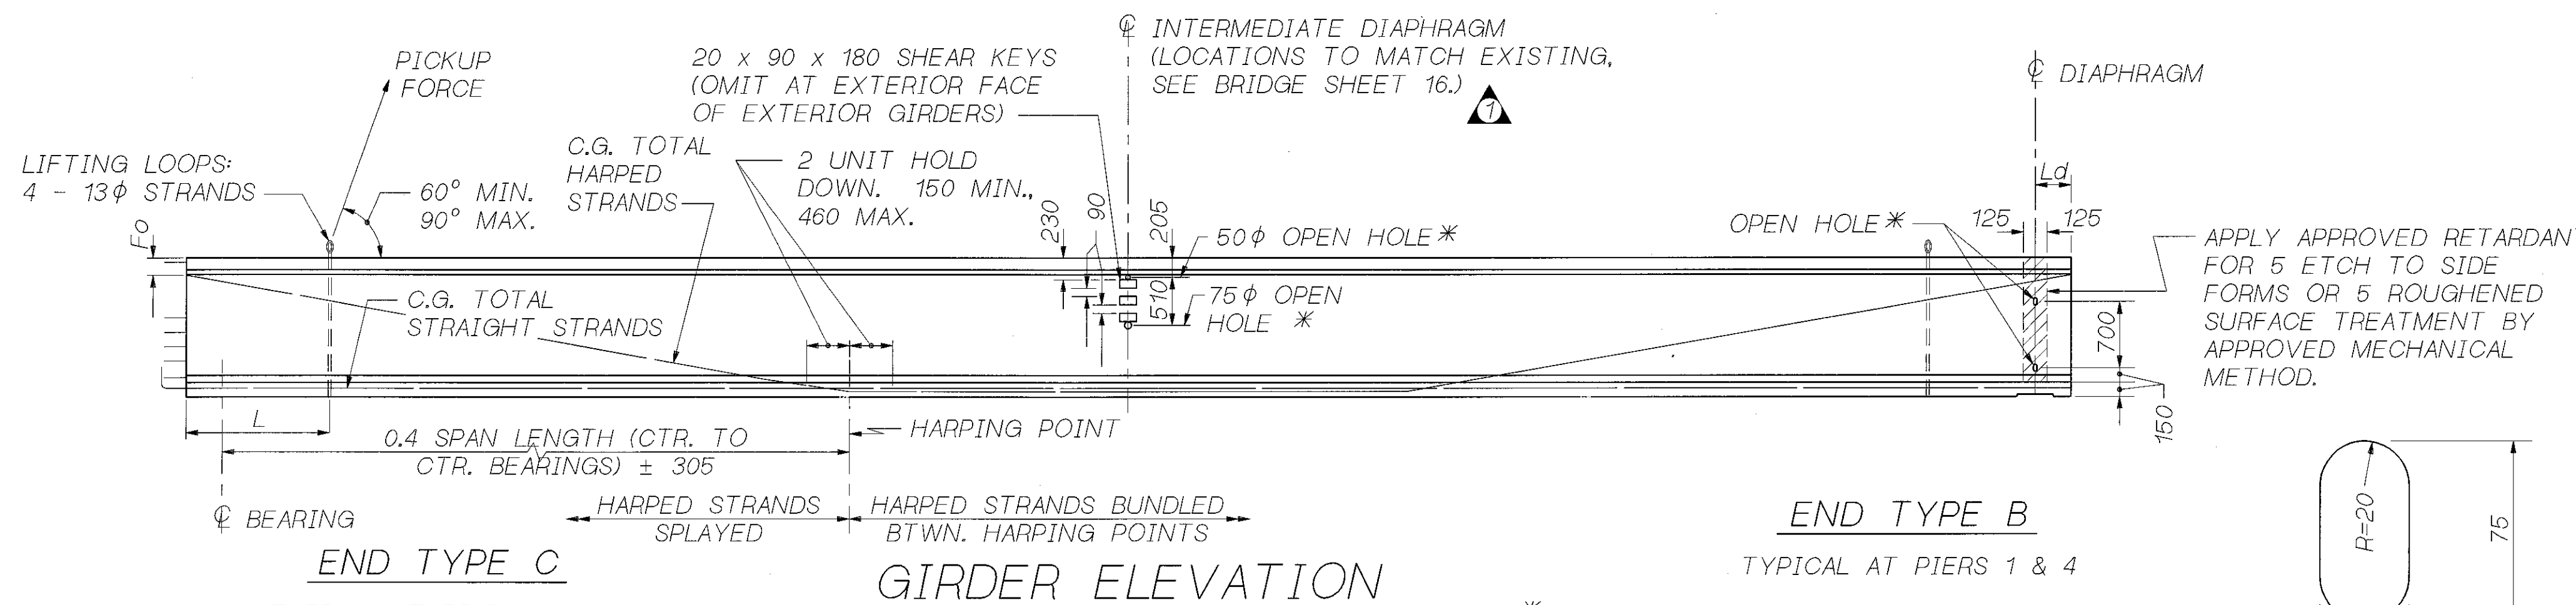


\* OMIT HOLES AND PLACE INSERTS ON THE INTERIOR FACE OF EXTERIOR GIRDERS. PLACE HOLES AND INSERTS PARALLEL TO SKEW. INSERTS SHALL BE 25 RICHMOND ROCKET, BURKE HI-TENSILE, LANCASTER MALLEABLE OR APPROVED EQUAL.

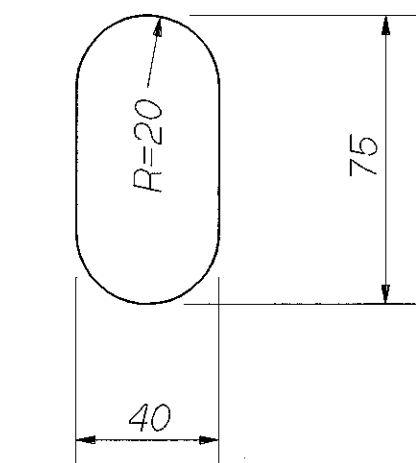


**OPEN HOLE**  
AT END TYPE B ONLY

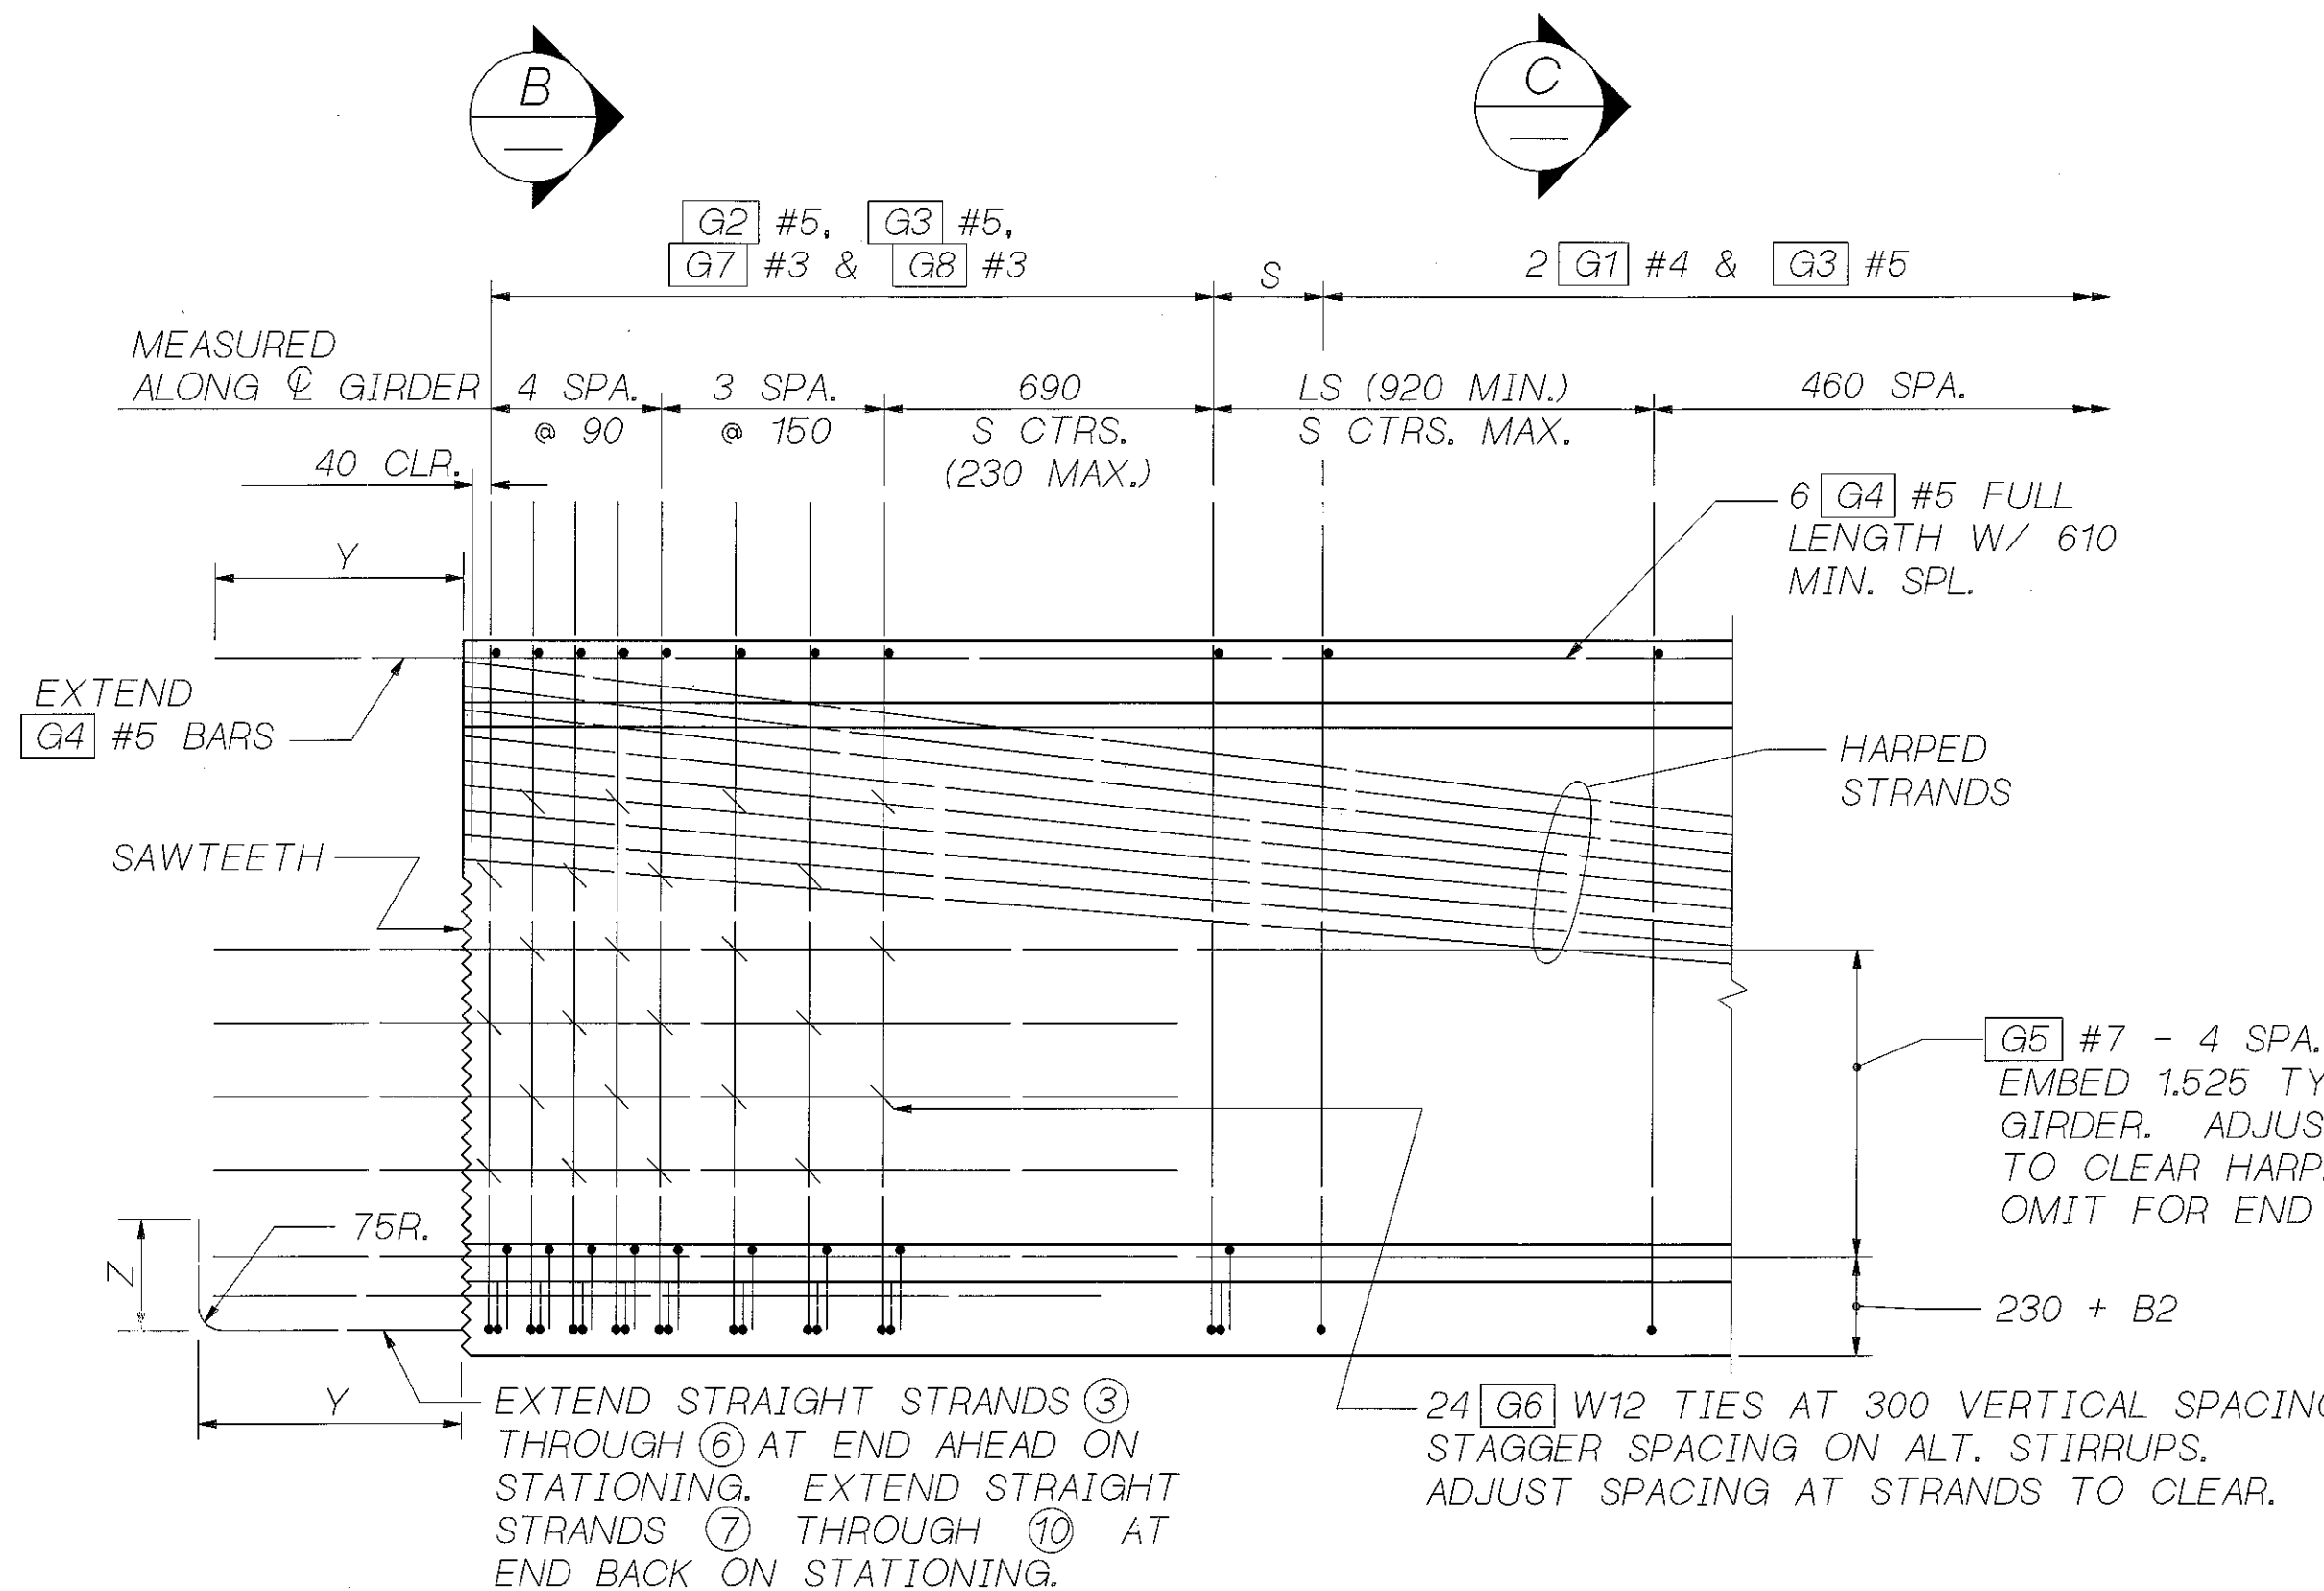

**TYPICAL END ELEVATION**  
END TYPE C SHOWN.  
OTHER ENDS SIMILAR.

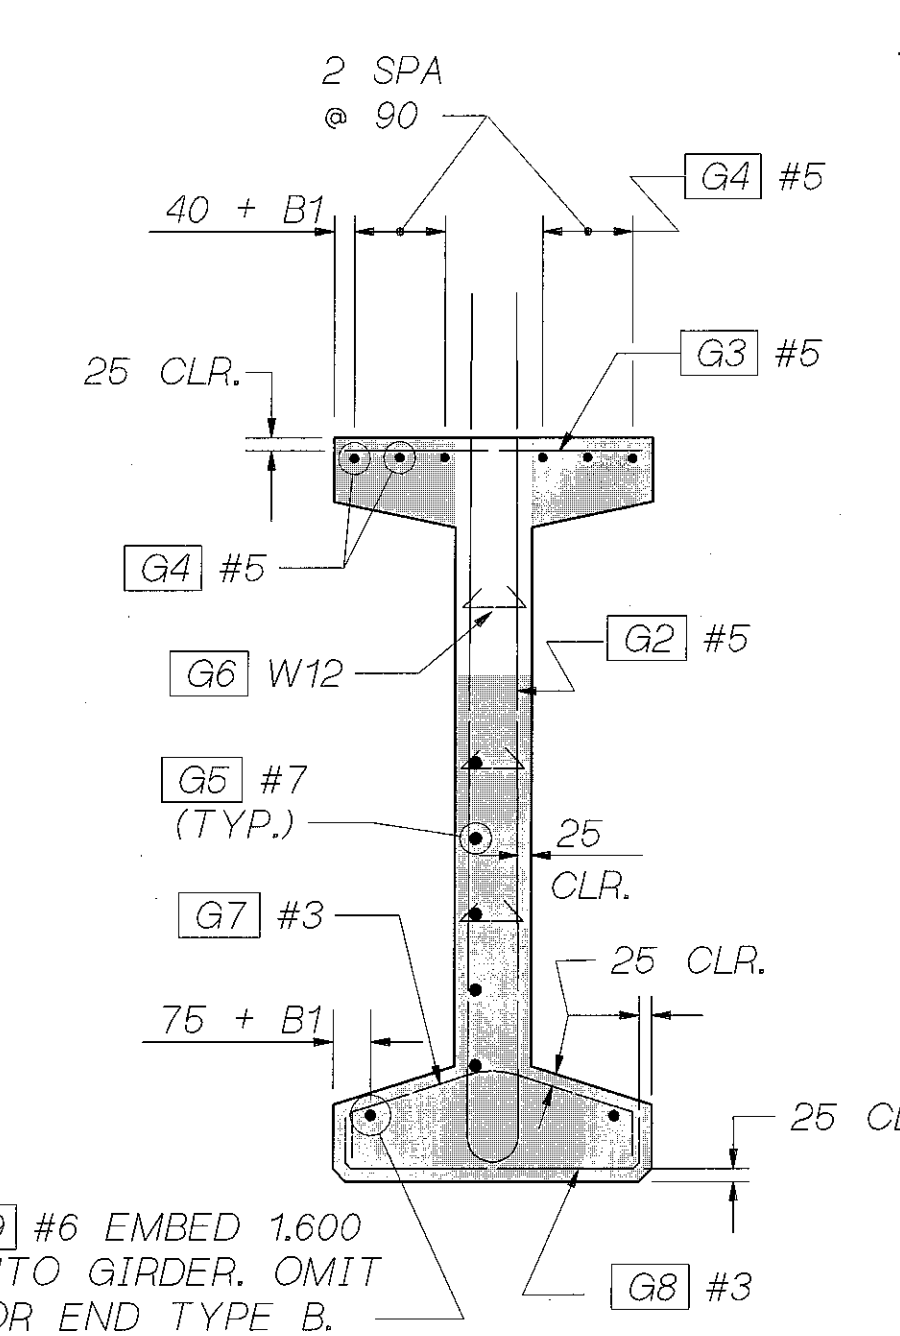

**SECTION B**  
SAWTEETH SHOWN BY SHADED AREA.

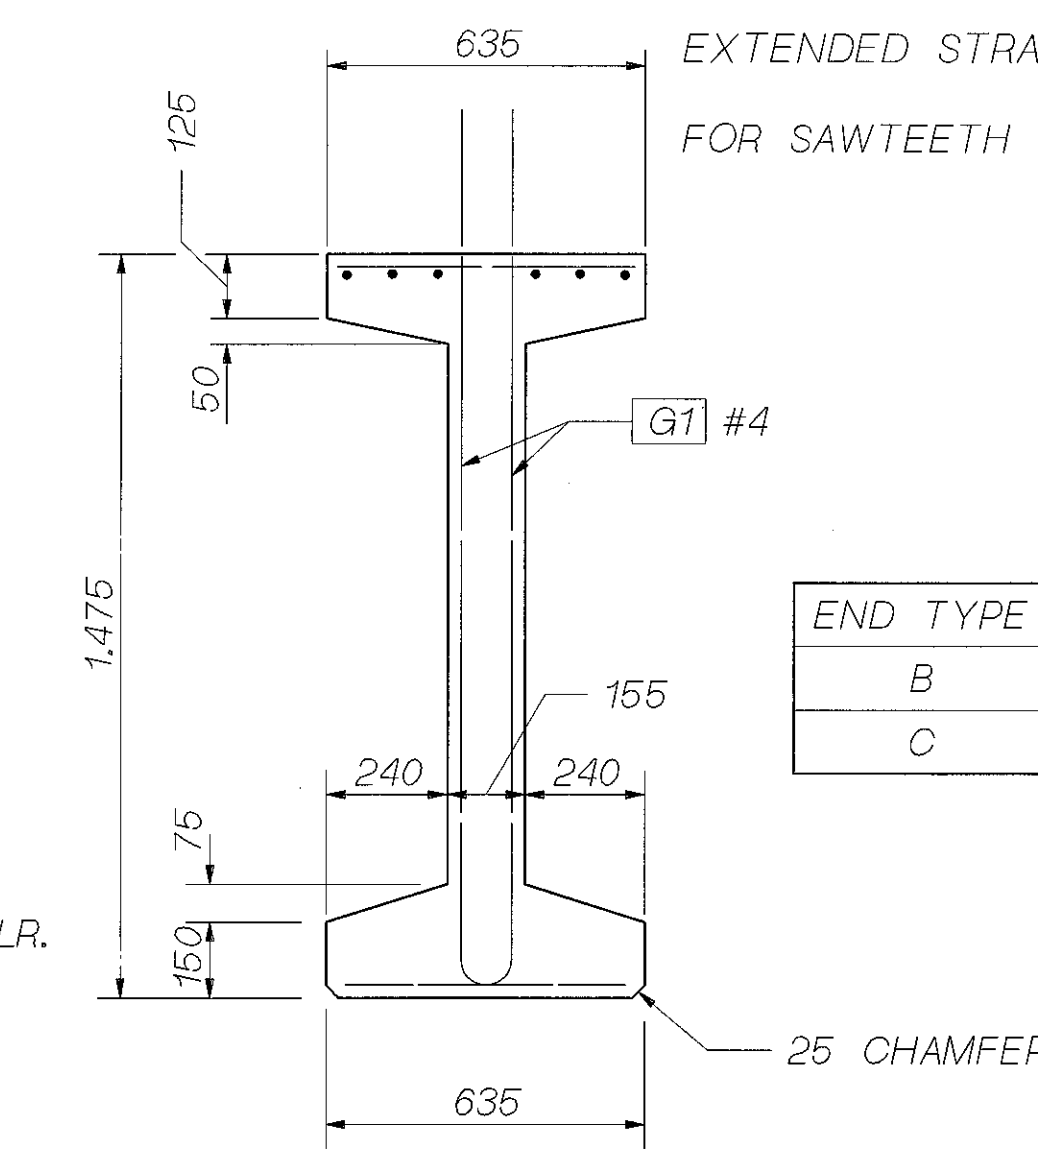

**SECTION C**

END TYPE	BEARING RECESS	Y	Z	SAWTEETH
B	YES	0	0	NO
C	NO	325	465	YES


ENDS AHEAD ON STATION	
G5 BARS LEFT OF C	
B1 = 0 (G4, G9)	
B2 = 0 (G5)	
ENDS BACK ON STATION	
G5 BARS RIGHT OF C	
B1 = 40 (G4, G9)	
B2 = 75 (G5)	

MARK	LOCATION	SIZE	BENDING DIAGRAM (ALL DIMENSIONS ARE OUT TO OUT)
G1	GIRDER STIRRUPS	4	NOTE: FOR DIMENSION A, SEE "GIRDER SCHEDULE" * = VARIES FOR SKEWED SPANS 
G2	GIRDER END STIRRUPS	5	
G3	GIRDER TOP FLANGE	5 STR.	
G4	GIRDER LONGIT. FULL LENGTH	5 STR.	
G5	GIRDER END LONGIT.	7 STR.	
G6	GIRDER END TIES	W12 #	
G7	GIRDER END TIES	3	
G8	GIRDER END TIES	3	
G9	GIRDER LONGIT.	6 STR.	

# 3 OR # 4 MAY BE SUBSTITUTED. FIELD BENDING IS OPTIONAL.


SR 405 JOB NO. 7079 SHEET 15

Bridge Design Engr.	S405D103ROOT:(L.FGB)W58MG_1.FGB:1	REGION NO.	STATE	FED. AID PROJ. NO.	SHEET NO.	TOTAL SHEETS
Supervisor	W. WILSON		10 WASH.			
Designed By	M. TRAGESSER					
Checked By	S. ANDERSON					
Detailed By	D.W. PULSE JR.					
Bridge Projects Engr.				JOB NUMBER		
Prelim. Plan By	10/97	REVISOR	REVISION	BY	APPD.	5054
Architect/Specialist	DATE	REVISION	BY	APPD.		

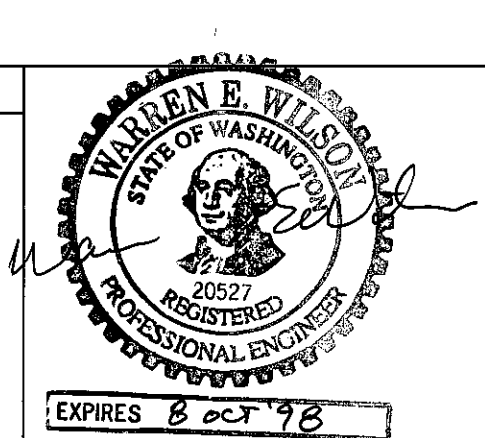


SR 405  
 BOTHELL TO SWAMP CREEK 1/C  
 HOV LANES - STAGE 1  
 228TH BRIDGE 405/103E  
 W58MG GIRDER 1 OF 2

BRIDGE SHEET NO. 15  
 SHEET 518 OF 663 SHEETS

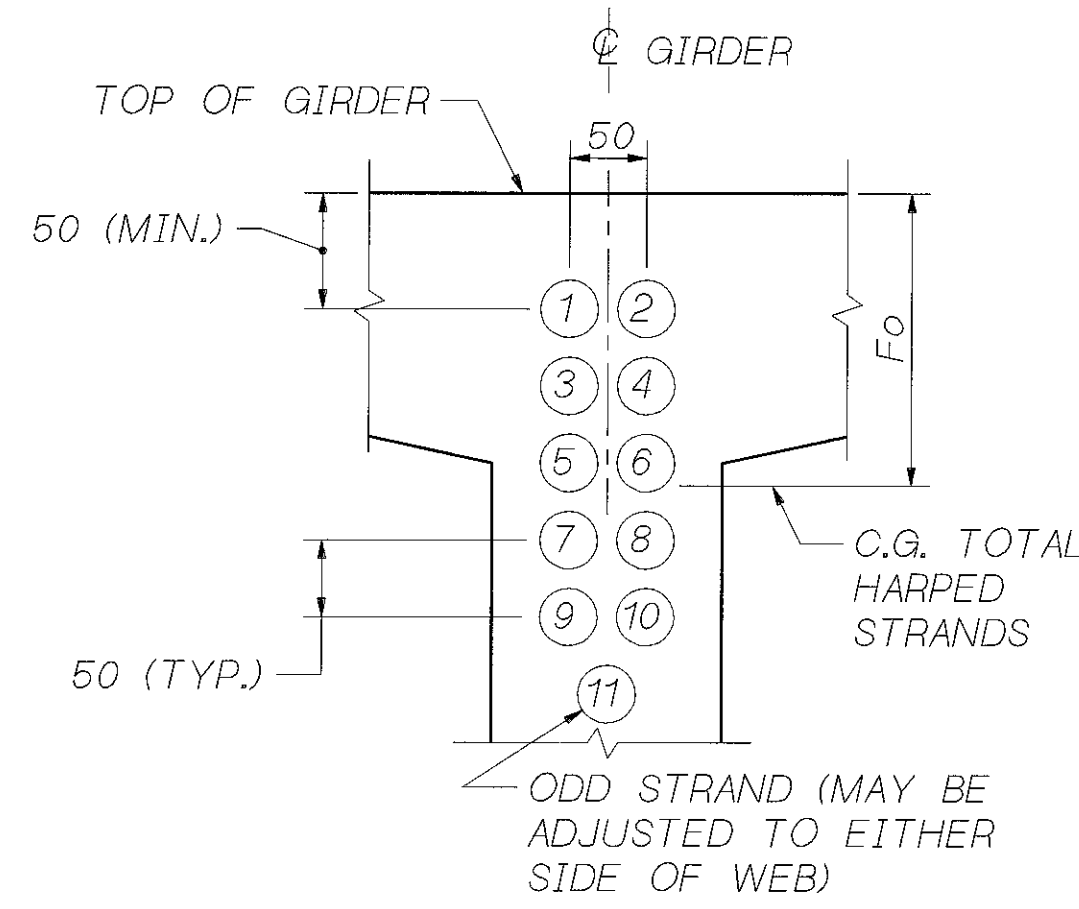


**STRAND PATTERN AT GIRDER END**

HARPED STRAND LOCATION SEQUENCE SHALL BE AS SHOWN ①, ② ETC.

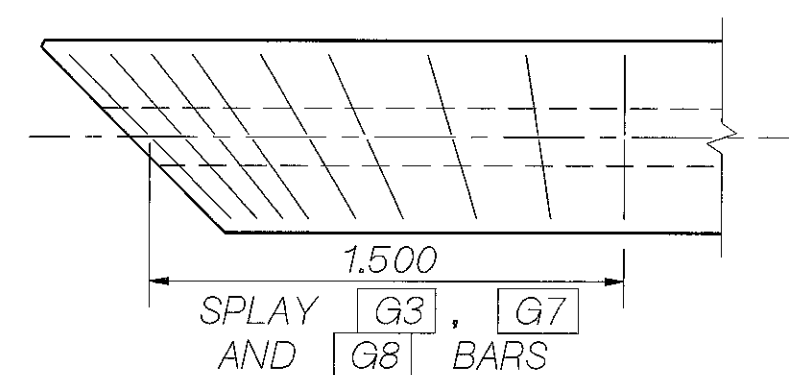



**TRANSVERSE REINFORCING SKEWED ENDS**

ONLY TRANSVERSE REINF. SHOWN

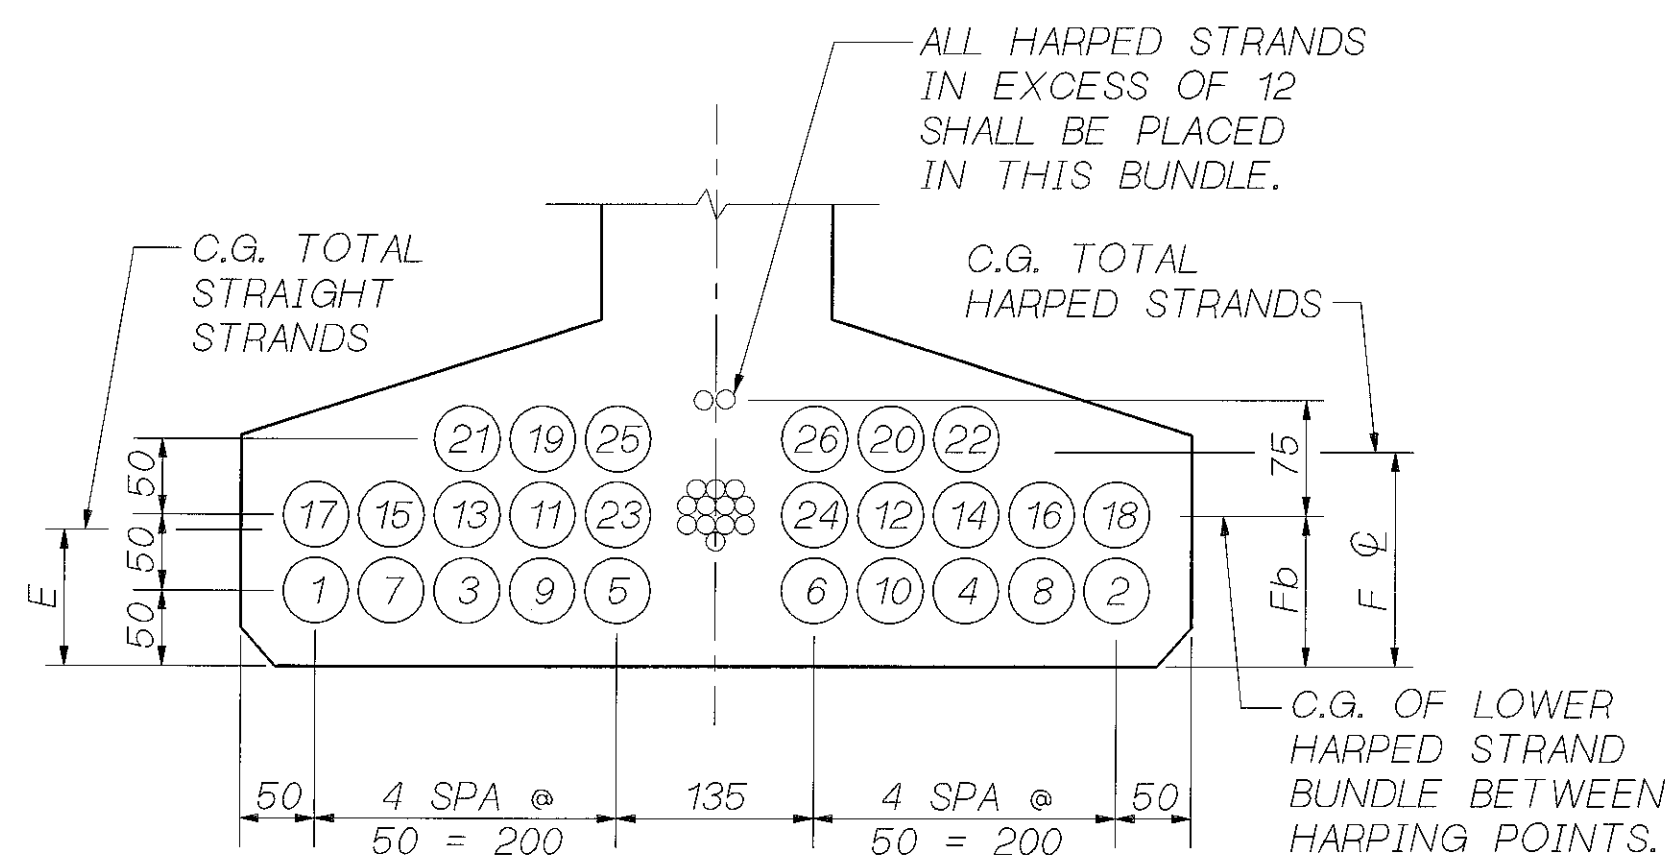

**STRAND PATTERN AT SPAN**

STRAND LOCATION SEQUENCE SHALL BE AS SHOWN ①, ② ETC.

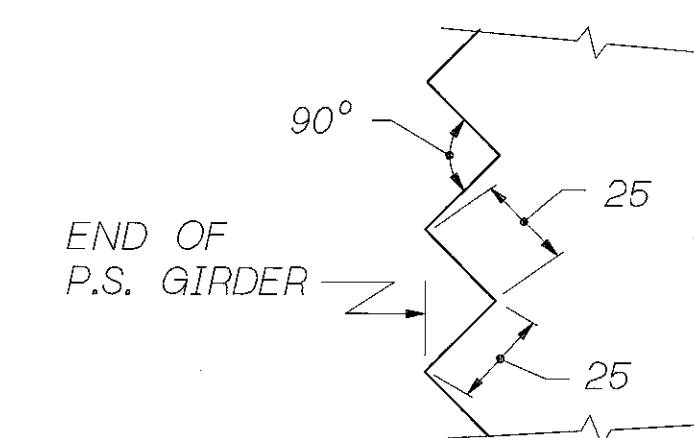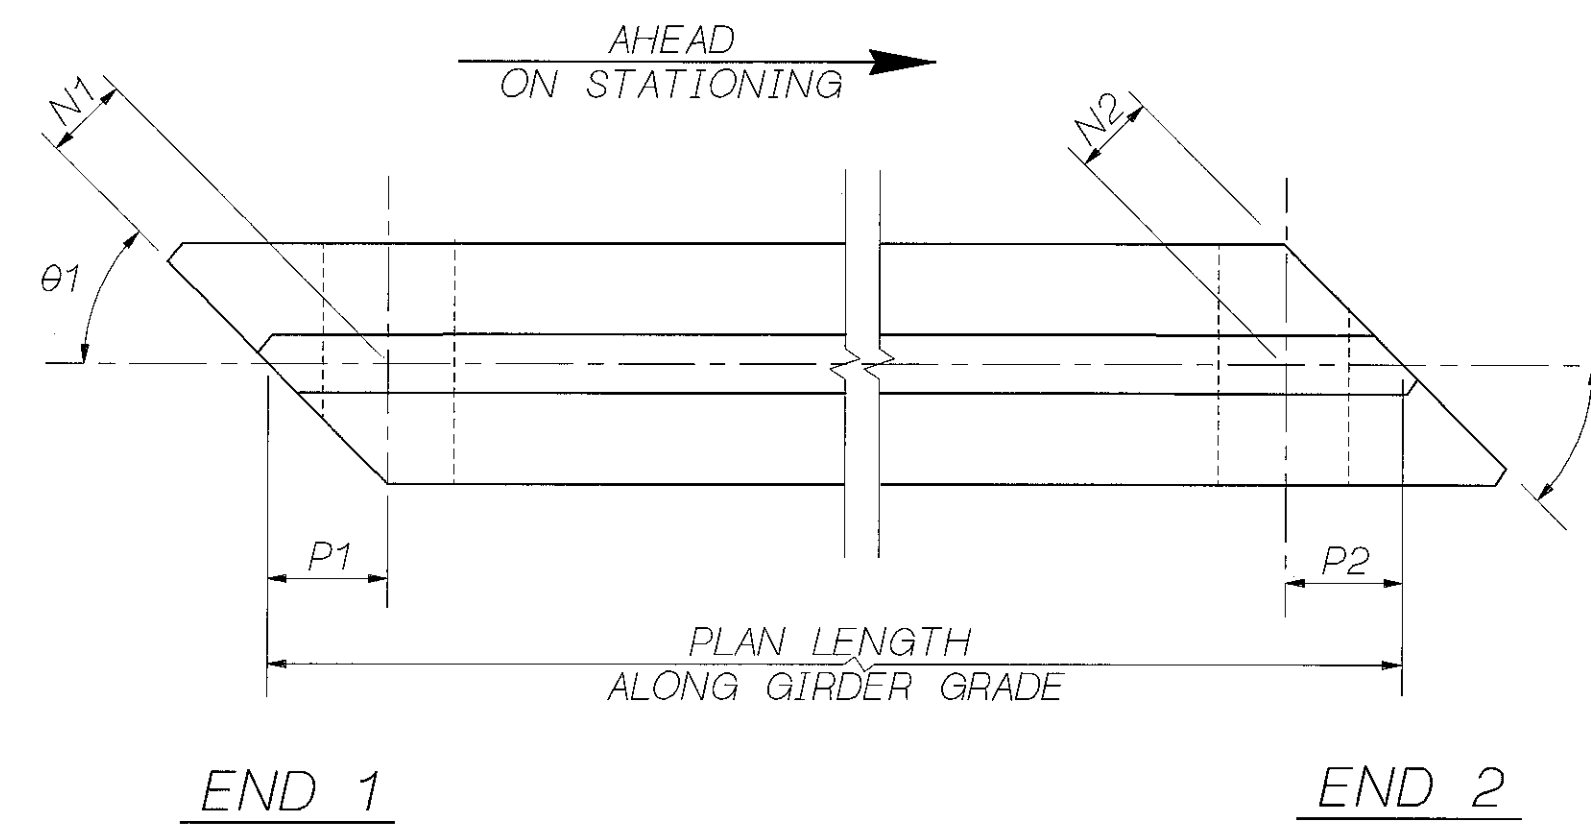

**SAWTEETH DETAILS**


SAWTEETH ARE FULL WIDTH - USE SAWTEETH KEYS FROM BOTTOM OF BOTTOM FLANGE TO BOTTOM OF LOWEST HARPED STRAND AS WELL AS TOP FLANGE ADJACENT TO HARPED STRANDS AS SHOWN IN SECTION B - W58MG GIRDER DETAILS 1 OF 2.

DIMENSION A AT BRG. = 305


BASED ON GIRDER DEFLECTION = D AT TIME OF SLAB POUR (120 DAYS)

SPAN	GIRDER	END 1 TYPE	END 2 TYPE	L* (mm)	θ1	θ2	N1 (mm)	N2 (mm)	P1 (mm)	P2 (mm)	PLAN LENGTH ALONG GIRDER GRADE (m)	MIN. CONCR. COMPR. STRENGTH		S (mm)	LS (mm)	HARPED		STRAIGHT		LOCATION OF C.G. STRANDS				C (mm)	D (mm)	Ld (mm)
												28 DAYS F'c (MPa)	RELEASE F'c (MPa)			NO. OF STRANDS	JACKING FORCE (kN)	NO. OF STRANDS	JACKING FORCE (kN)	E (mm)	F <sub>Q</sub> (mm)	F <sub>b</sub> (mm)	F <sub>o</sub> (mm)			
1	ALL	B	C	900	143°41'	143°41'	240	-	405	-	28.920	48	35	400	5600	8	1100	22	3030	85	75	75	125	25	60	340
2	ALL	C	C	900	143°41'	143°41'	-	-	-	-	31.093	48	38	400	6400	9	1240	26	3580	95	75	75	140	35	85	-
3	ALL	C	B	900	143°41'	143°41'	-	240	-	405	25.034	48	35	400	4800	7	965	16	2205	70	75	75	115	15	35	340

\* FINAL LOCATION TO BE DETERMINED BY GIRDER MANUFACTURER.

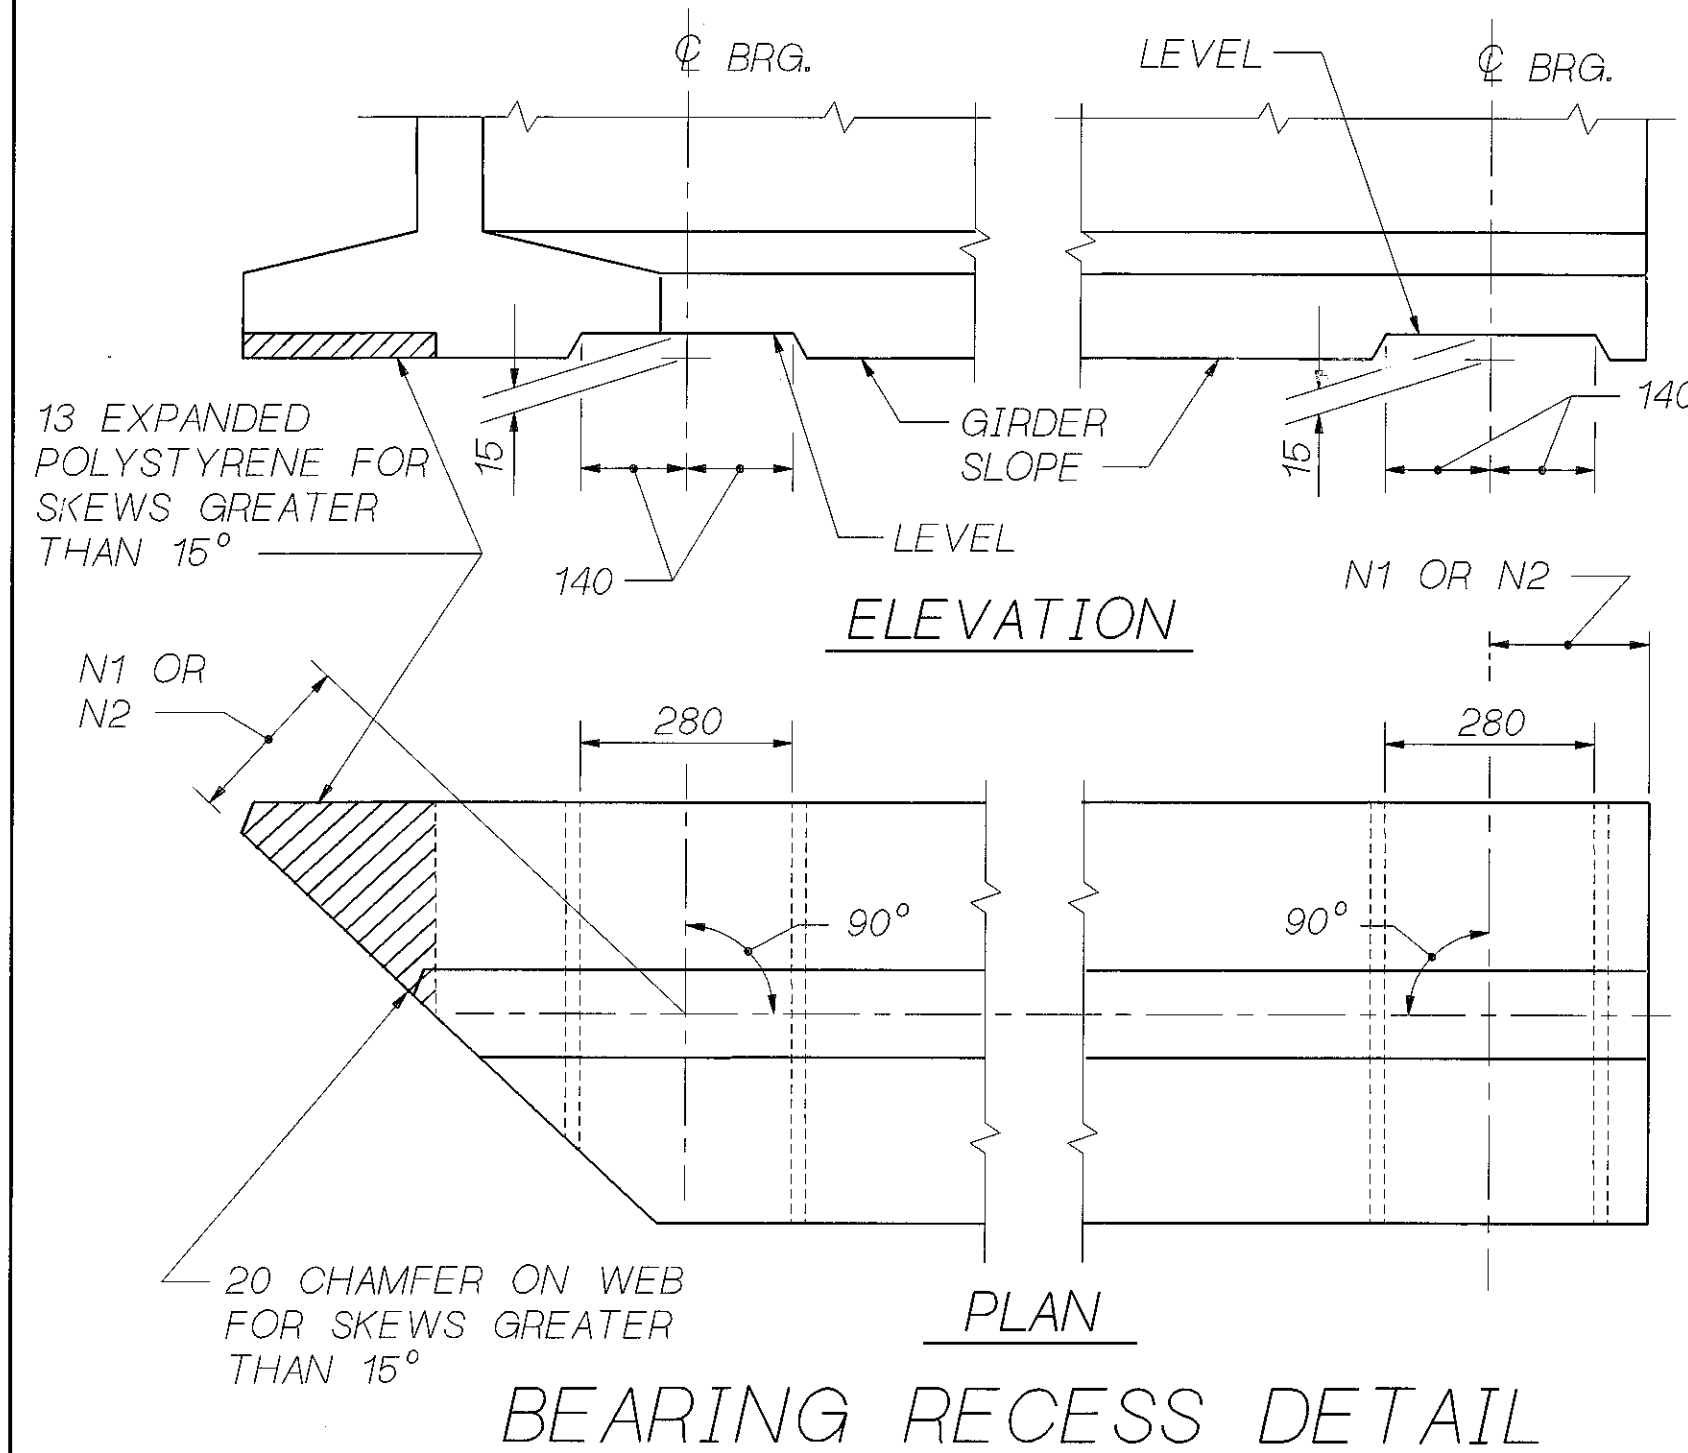

**BEARING RECESS DETAIL**

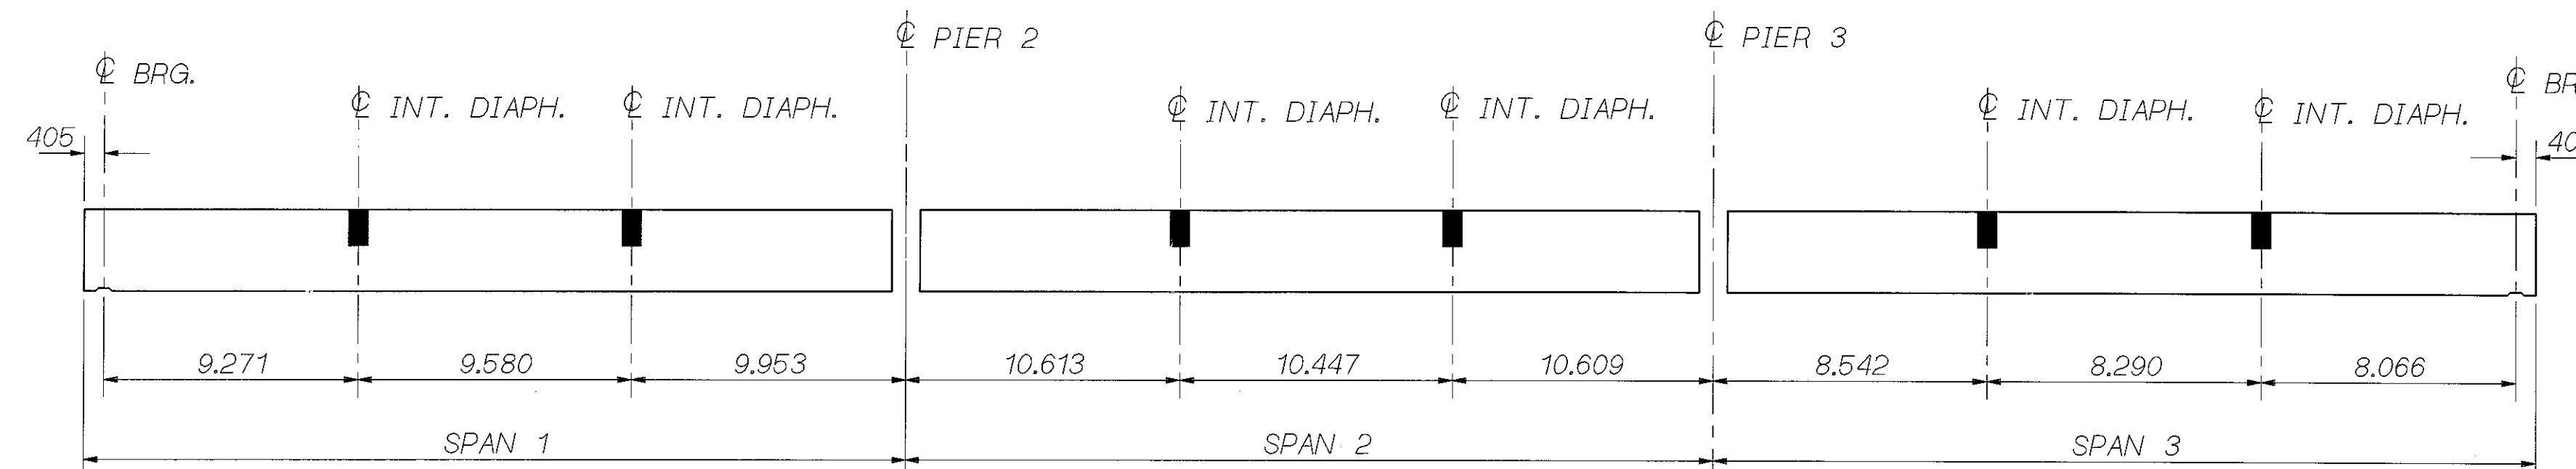


**INTERMEDIATE DIAPHRAGMS**

(BEARINGS SHOWN ON BRIDGE SHEET 13)

AS-BUILT SURVEY DIMENSIONS SHOWN AT EXISTING MEDIAN GIRDER CENTERLINE

SR 405 JOB NO. 7079 SHEET 16

Bridge Design Engr.	S405D103R001: L.FGB\W58MG_2.FGB: 1	REGION NO.	STATE	FED. AID PROJ. NO.	SHEET NO.	TOTAL SHEETS
Supervisor	W. WILSON		10 WASH.			
Designed By	M. TRAGESSER 6/96					
Checked By	S. ANDERSON 6/96					
Detailed By	D.W. PULSE JR. 6/96					
Bridge Projects Engr.						
Prelim. Plan By	10/97	1	REVISED AS-BUILT SURVEY DATA	MLT		
Architect/Specialist	DATE	REVISION	BY	APP'D	5054	

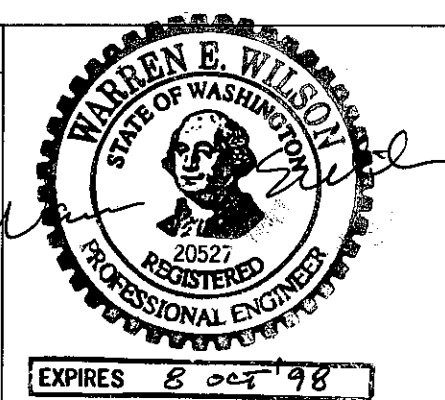


SR 405  
BOTHELL TO SWAMP CREEK 1/C  
HOV LANES - STAGE 1  
228TH BRIDGE 405/103E

W58MG GIRDER 2 OF 2



BRIDGE SHEET NO. 16  
SHEET 514 OF 663 SHEETS

16-OCT-97

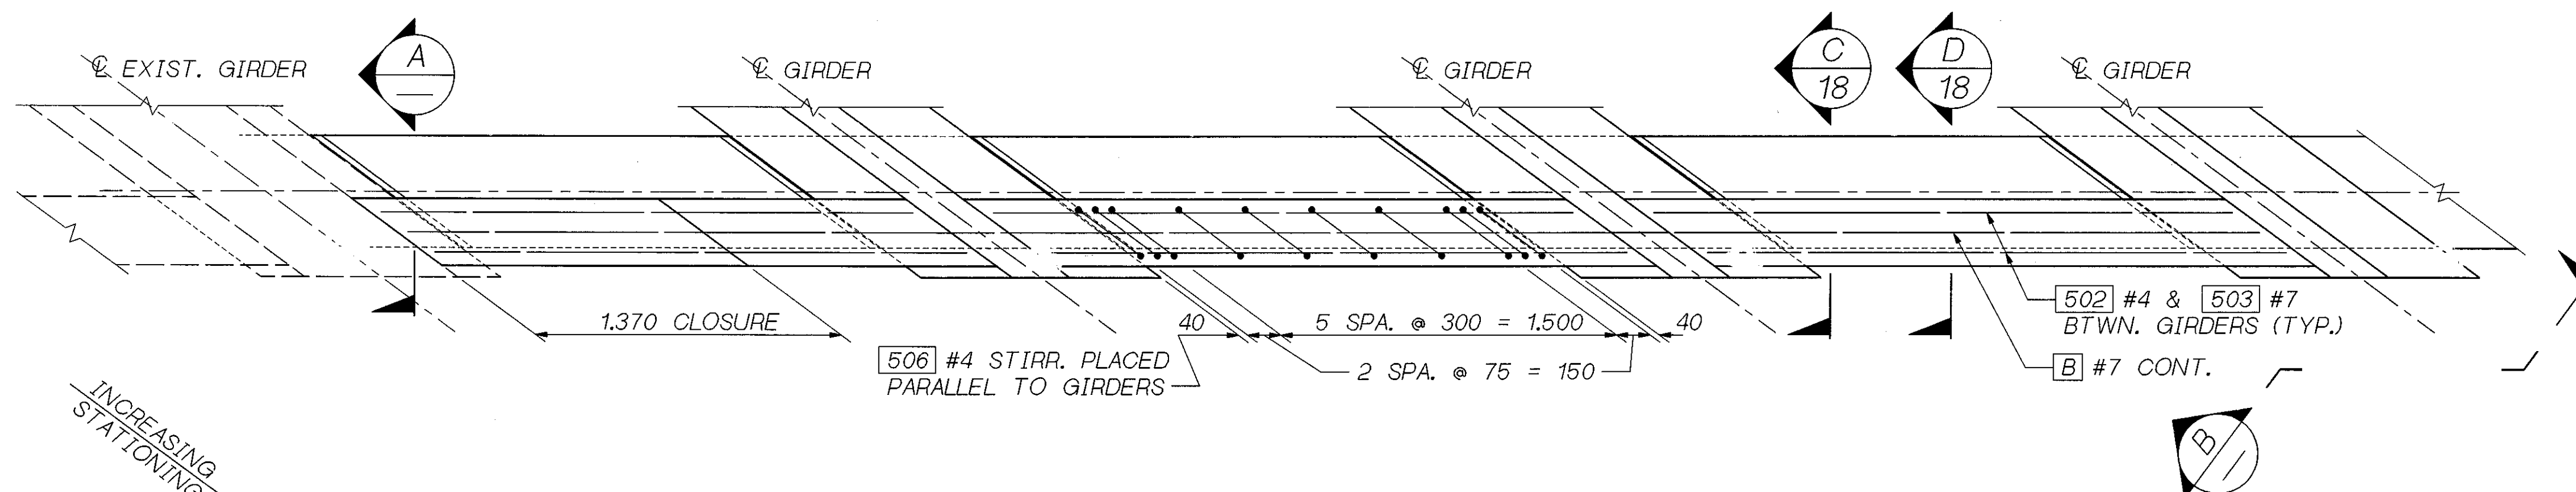


PLAN

SLAB NOT SHOWN FOR CLARITY.  
PIER 1 SHOWN, PIER 4 SIMILAR

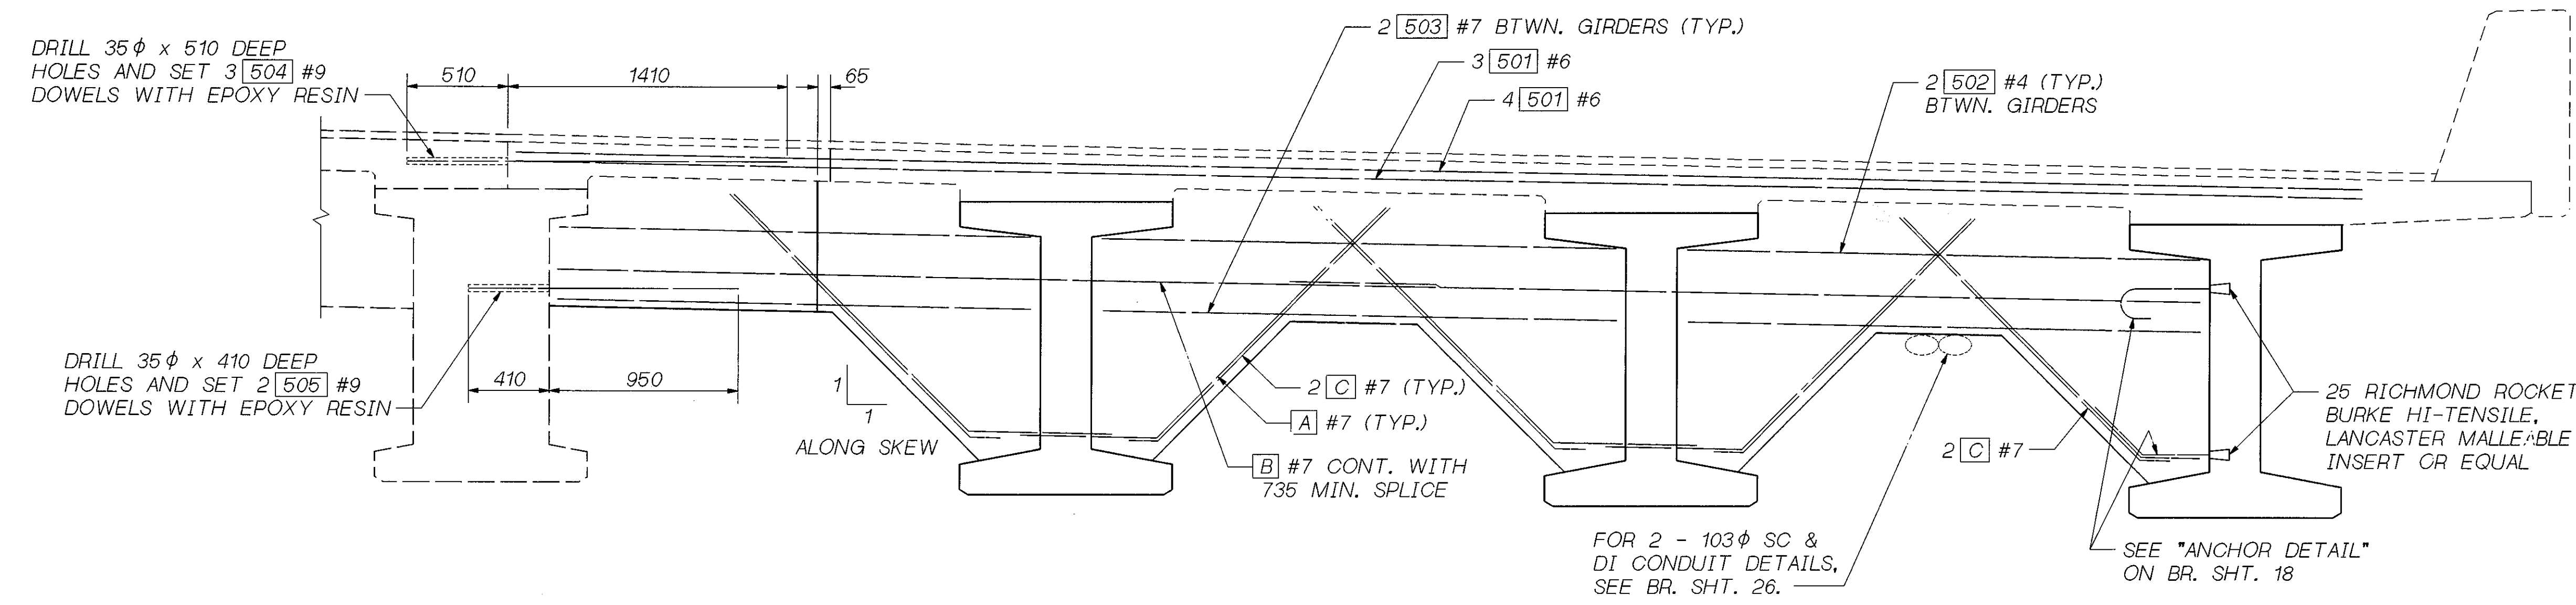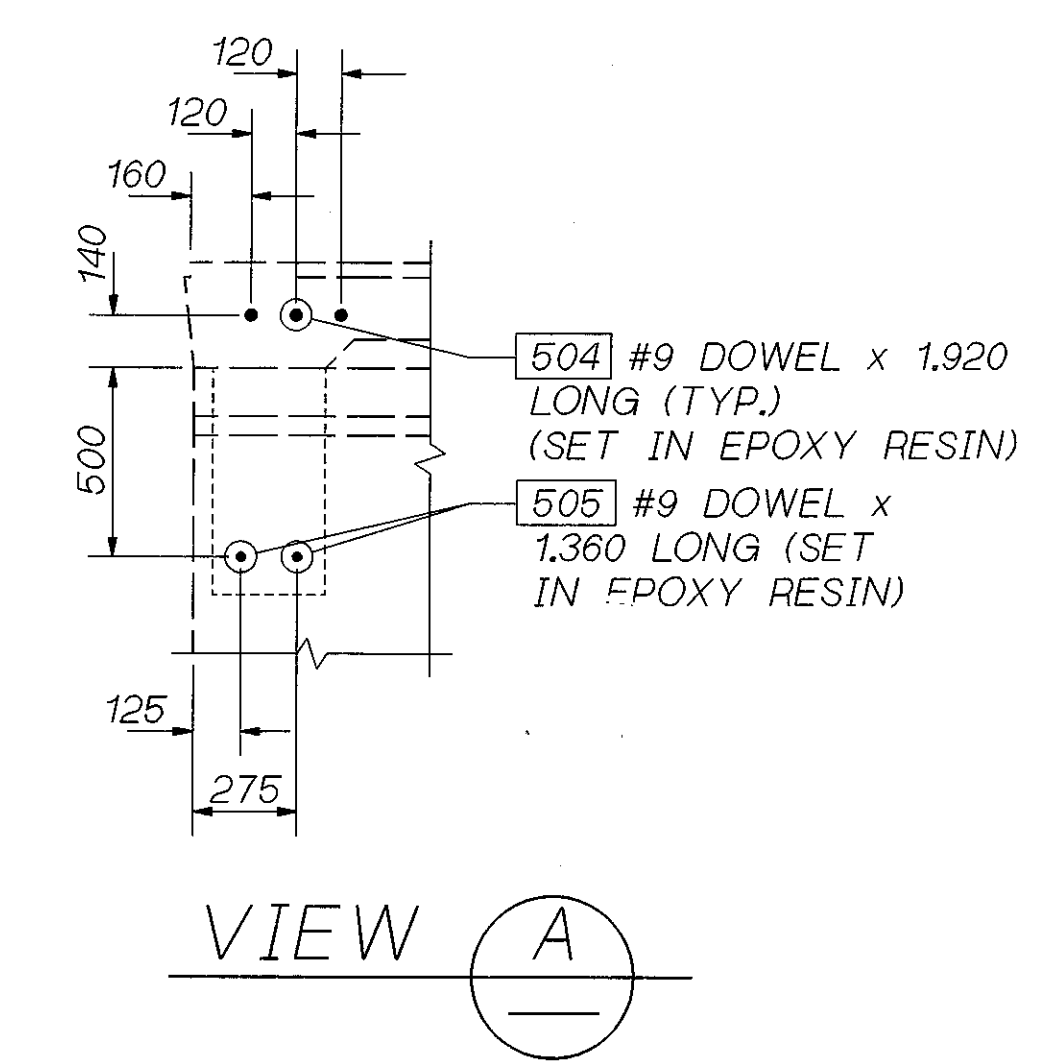


ELEVATION

506 #4 STIRR. NOT SHOWN FOR CLARITY.

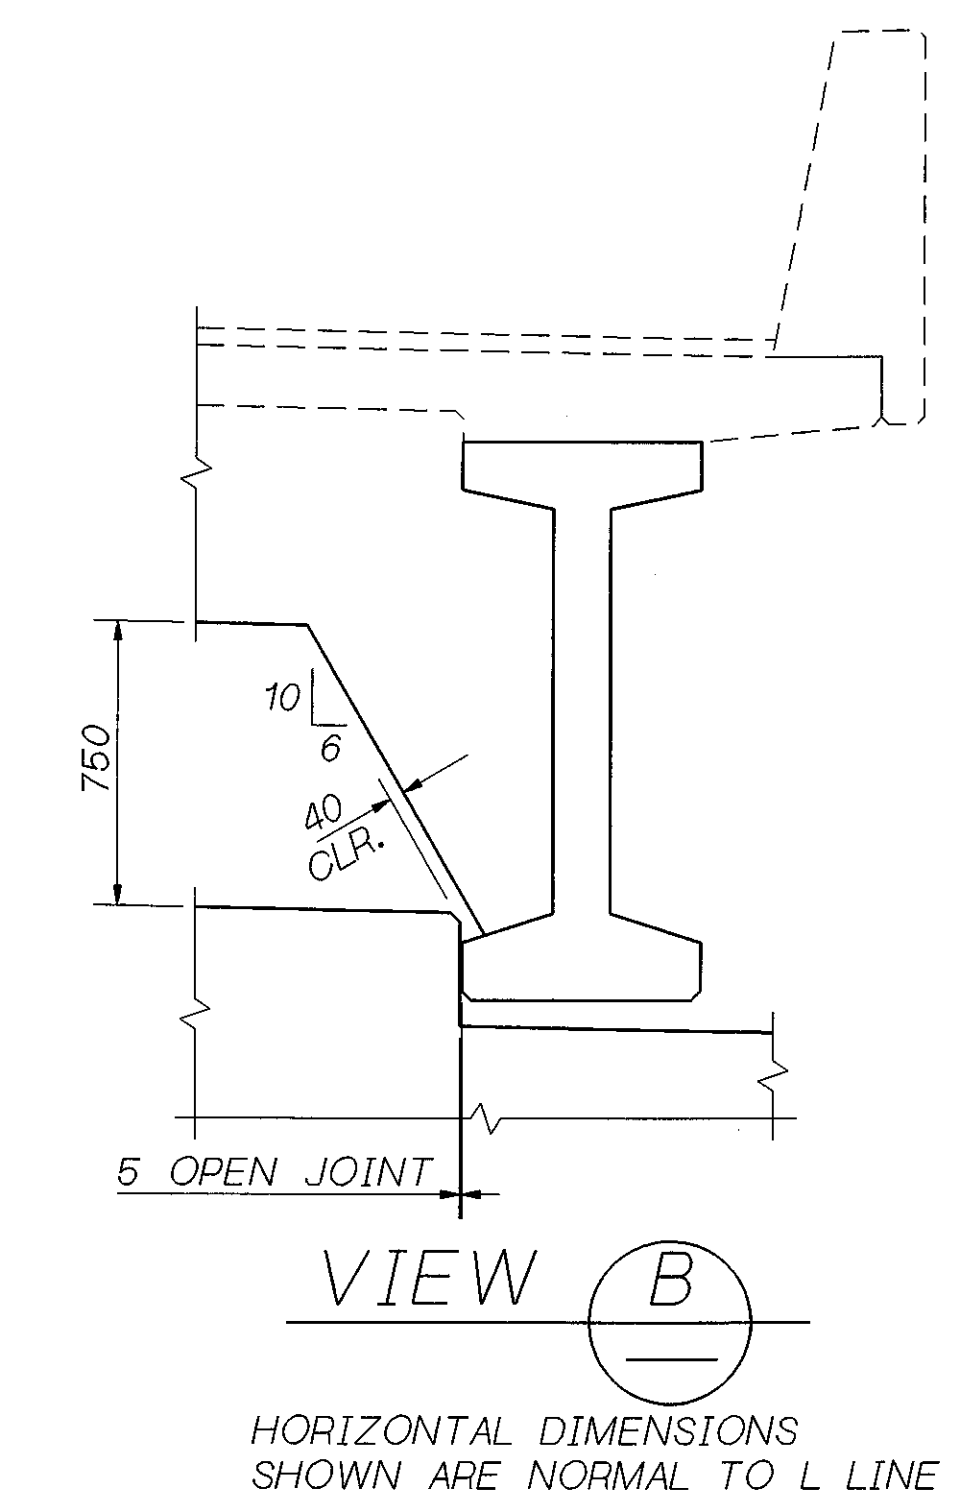

SR 405 JOB NO. 7079 SHEET 17

Bridge Design Engr.	S405D103R00T: (000000.FGB1D1A. ENDE.FGB: 1	REGION NO.	STATE	FED. AID PROJ. NO.	SHEET NO.	TOTAL SHEETS
Supervisor	W. WILSON		10 WASH.			
Designed By	M. TRAGESSER					
Checked By	S. ANDERSON					
Detailed By	D.W. PULSE JR.					
Bridge Projects Engr.			JOB NUMBER			
Prelim. Plan By			96W035			
Architect/Specialist		DATE	REVISION	BY	APP'D	5054

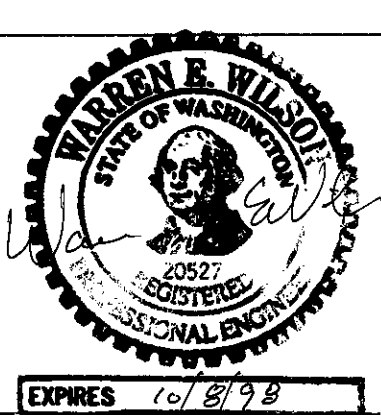


SR 405  
BOTHELL TO SWAMP CREEK 1/C  
HOV LANES - STAGE 1  
228TH BRIDGE 405/103E

END DIAPHRAGM - 1 OF 2


BRIDGE SHEET NO. 17  
SHEET 515 OF 663 SHEETS

24/112

SR 405 JOB NO. 7079 SHEET 18

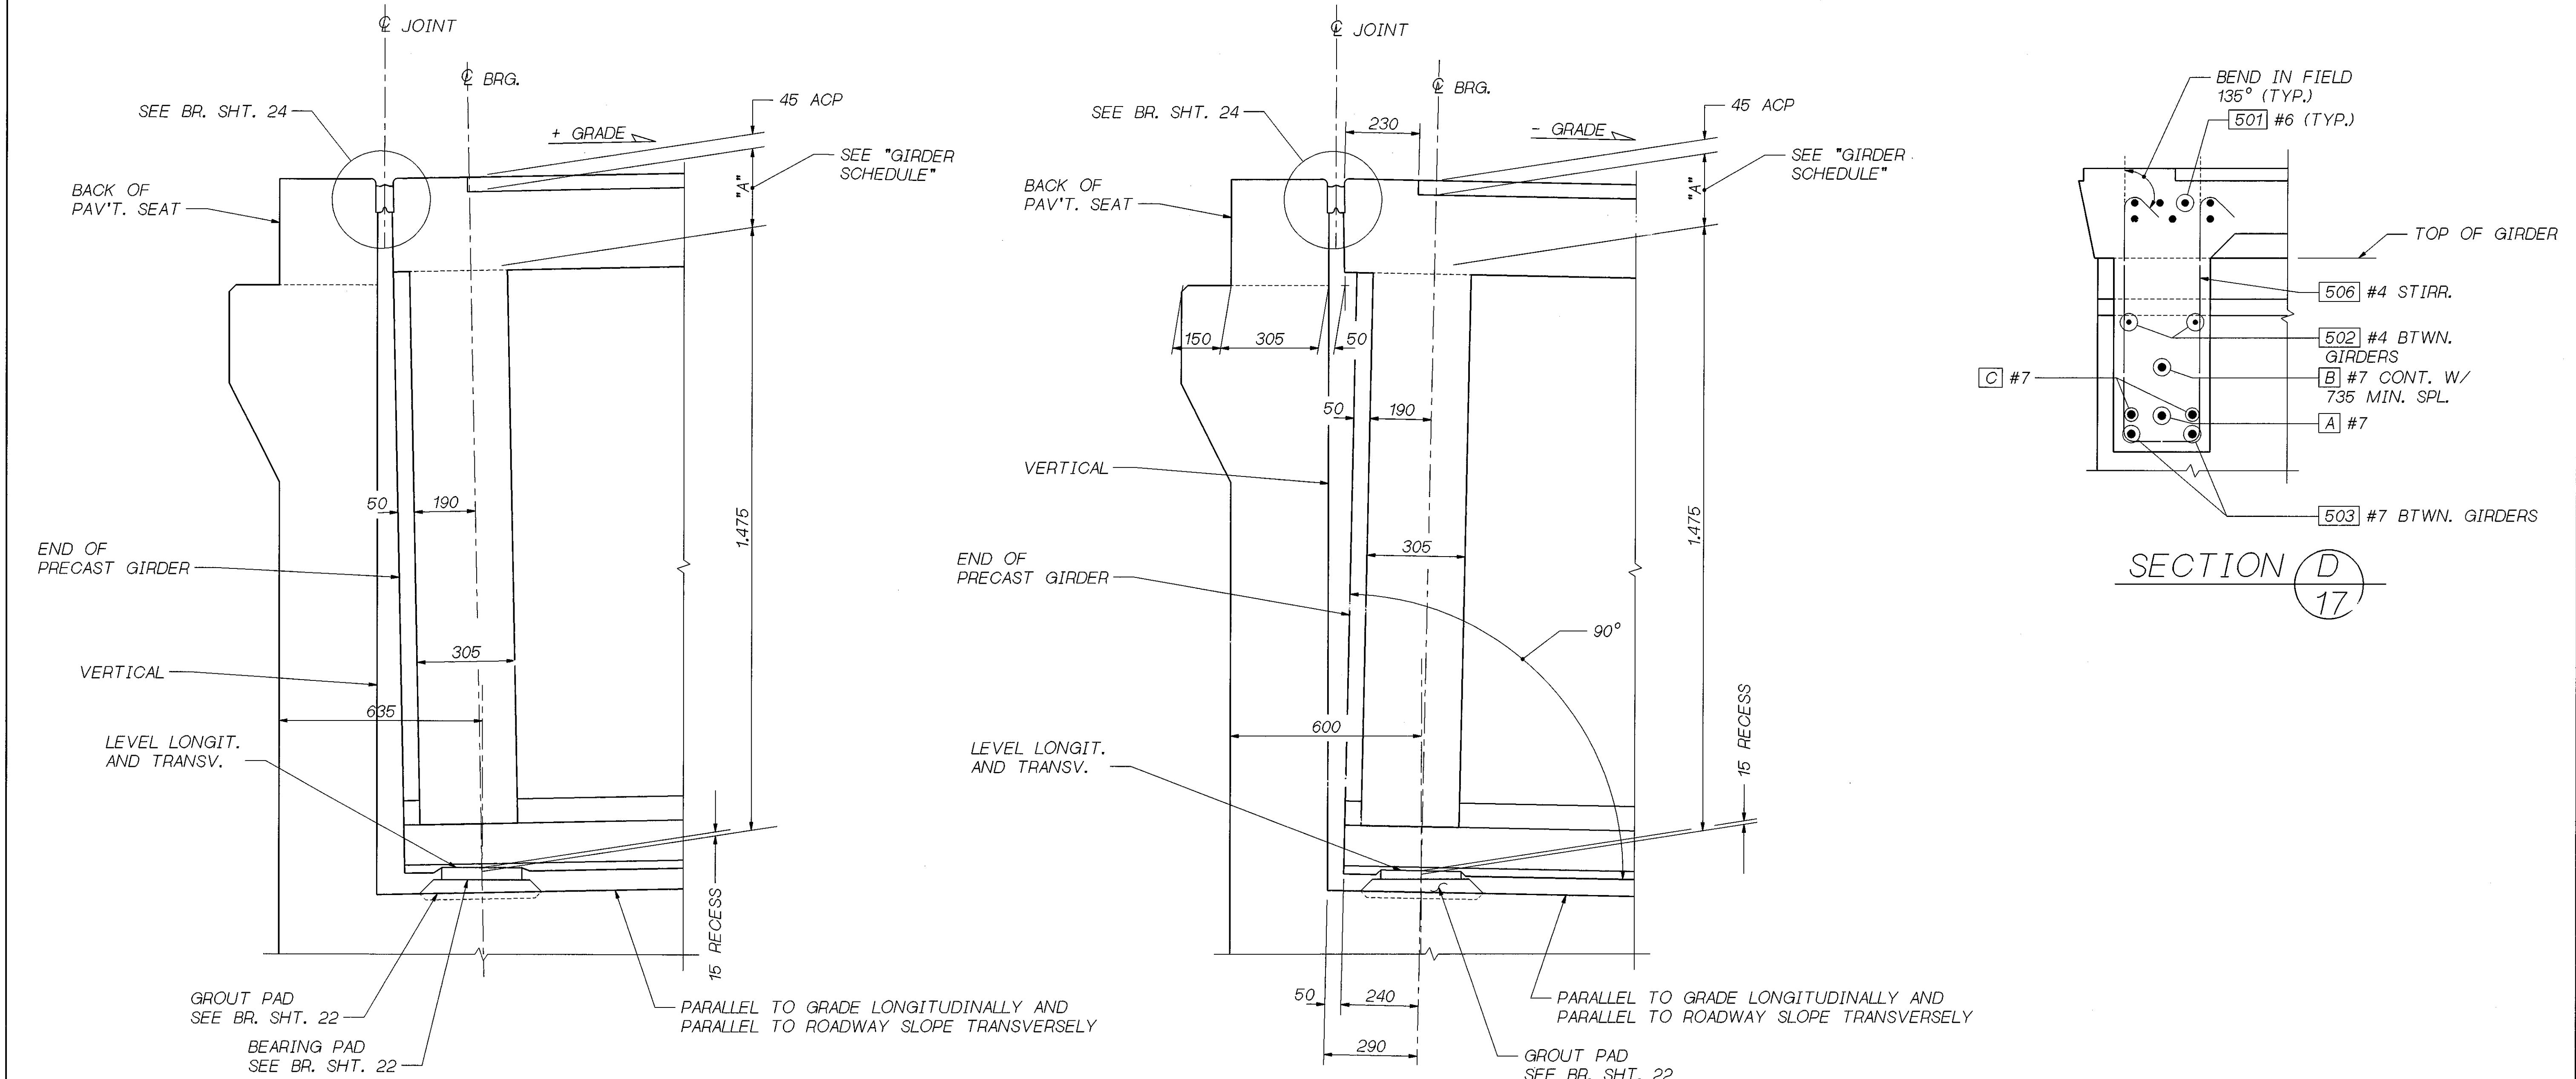


SECTION C  
17  
**ROADWAY EXPANSION JOINT AT END PIERS**  
LONGITUDINAL DIMENSIONS ARE NORMAL TO SKEW.

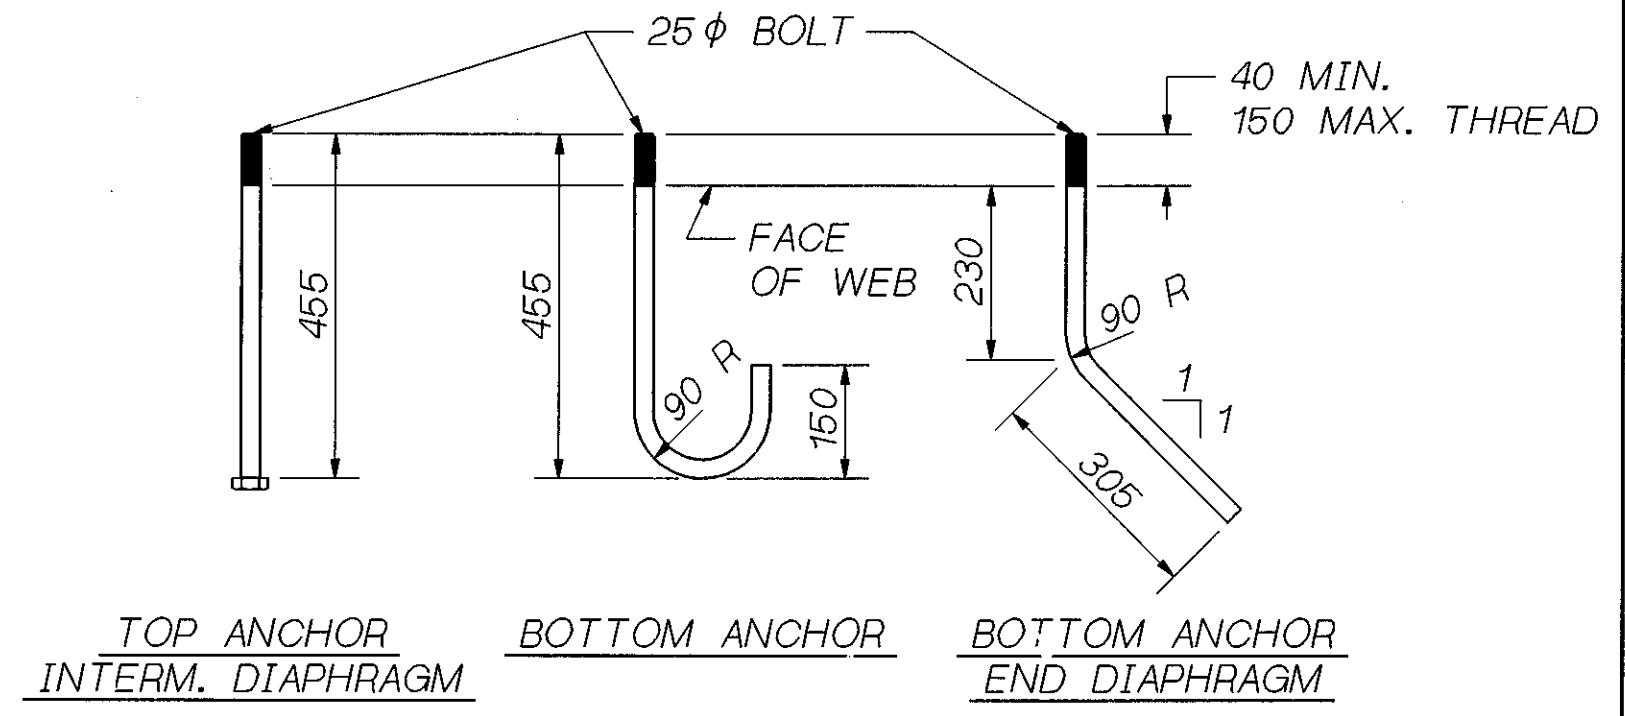

**ANCHOR DETAILS**  
A.S.T.M. A-307



Bridge Design Engr.	S405D103ROOT:1.000000.FGB1/DIAEND2.FGB:1			REGION NO.	STATE	FED. AID PROJ. NO.	SHEET NO.	TOTAL SHEETS
Supervisor	W. WILSON			10	WASH.			
Designed By	M. TRAGESSER							
Checked By	S. ANDERSON							
Detailed By	D.W. PULSE JR.							
Bridge Projects Engr.				JOB NUMBER	96W035			
Prelim. Plan By				DATE	REVISION	BY	APP'D	5054
Architect/Specialist								

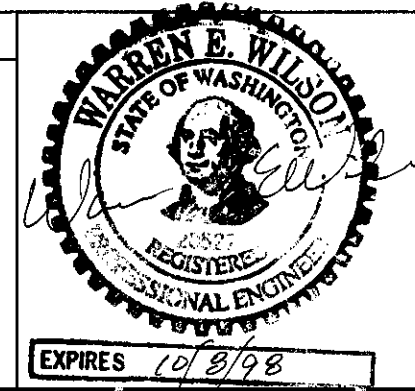

SR 405  
BOTHELL TO SWAMP CREEK 1/C  
HOV LANES - STAGE 1  
228TH BRIDGE 405/103E  
**END DIAPHRAGM - 2 OF 2**

BRIDGE SHEET NO.	18
SHEET OF	516 OF 663
SHEETS	

2A/11

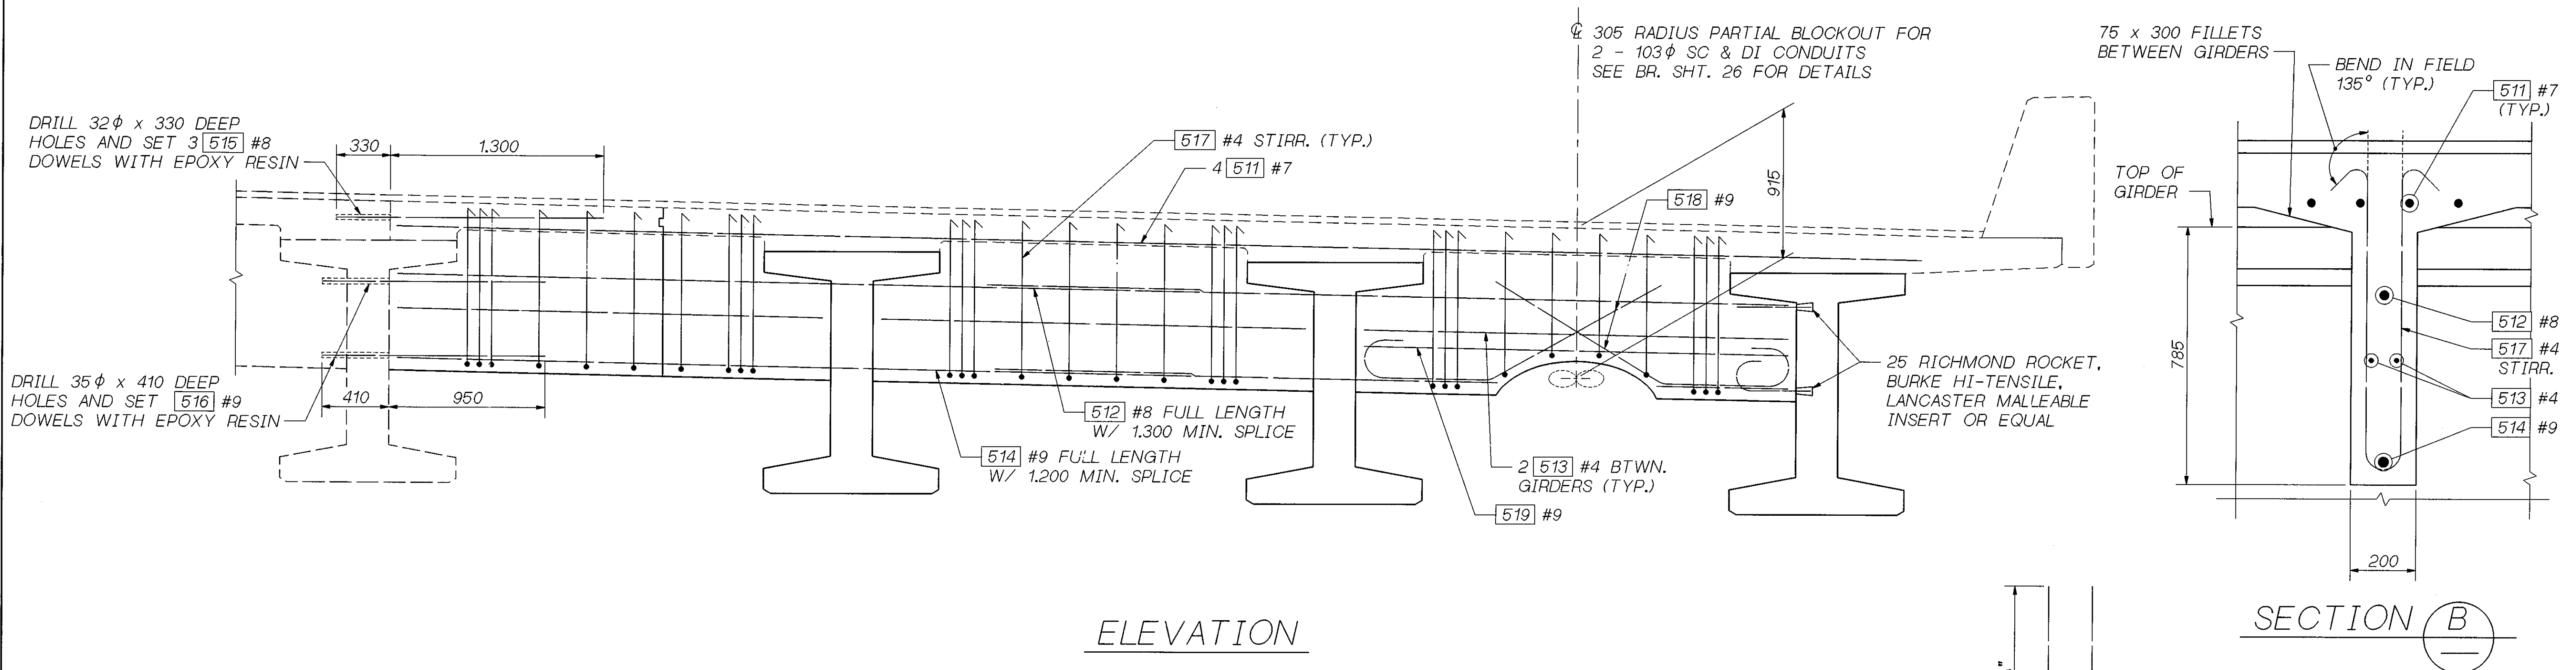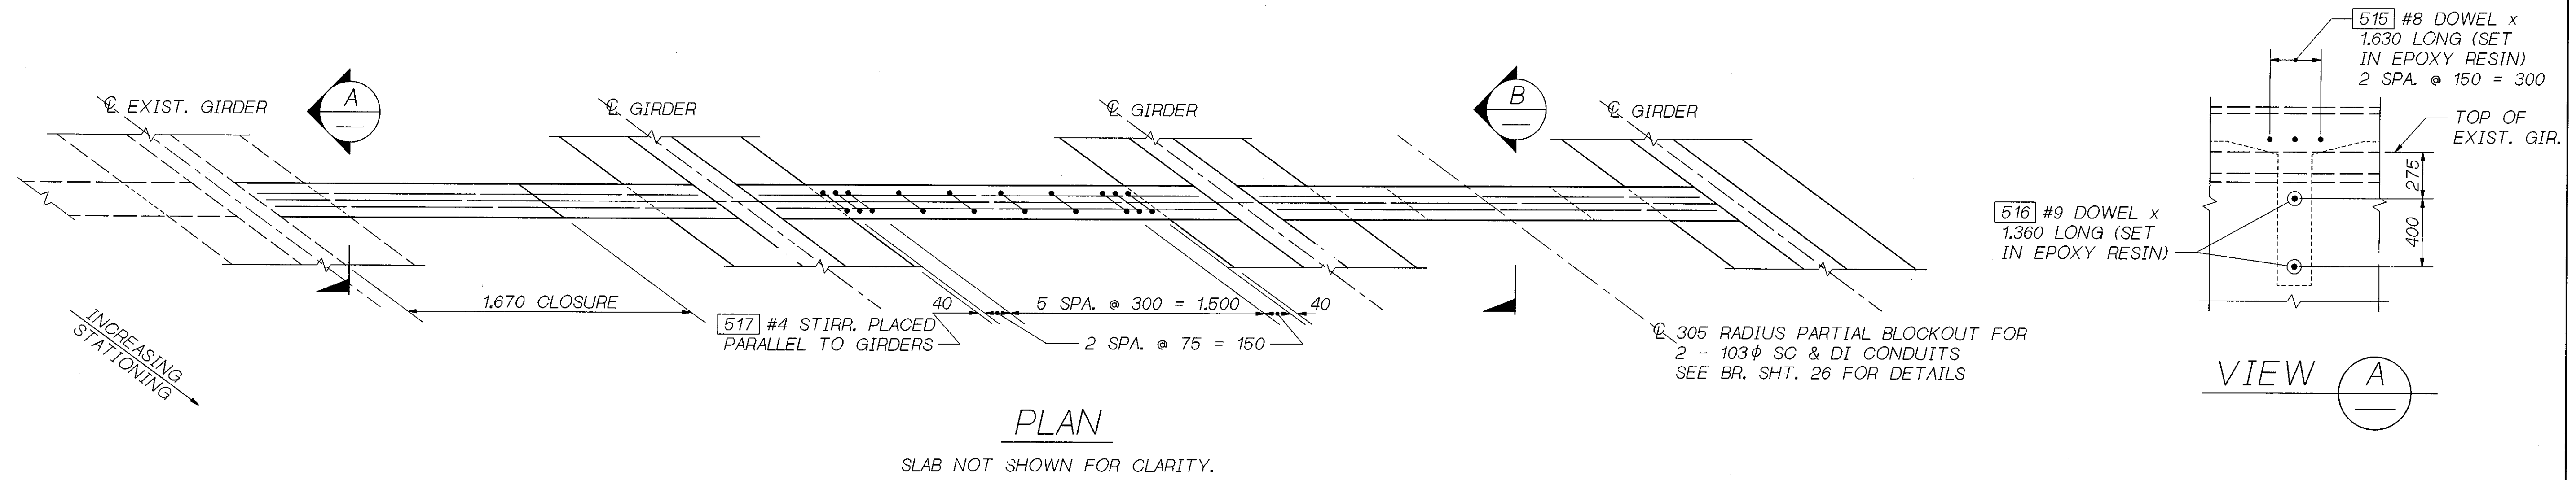


**NOTE:**

GIRDERS SHALL BE HELD RIGIDLY IN PLACE WHEN DIAPHRAGMS ARE PLACED. REINFORCING BARS SHALL BE THREADED THROUGH HOLES IN GIRDERS PRIOR TO PLACING OF EXTERIOR GIRDERS. SEE "GIRDER DETAILS" SHEET FOR DIMENSION "A".


SR 405 JOB NO. 7079 SHEET 19

Bridge Design Engr.	S405D103R007-(000000.FGB)DIA_INTE.FGB:1	REGION NO.	STATE	FED. AID PROJ. NO.	SHEET NO.	TOTAL SHEETS
Supervisor	W. WILSON		TO WASH.			
Designed By	M. TRAGESSER					
Checked By	S. ANDERSON					
Detailed By	D.W. PULSE JR.					
Bridge Projects Engr.						
Prelim. Plan By						
Architect/Specialist		DATE	REVISION	BY	APP'D	5054

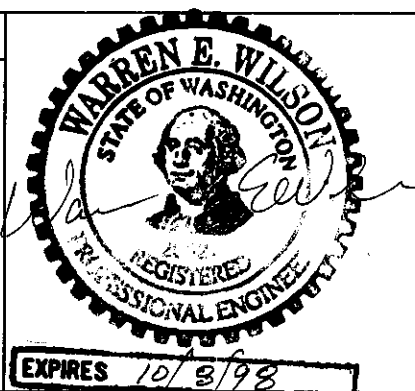


SR 405 BOTHELL TO SWAMP CREEK 1/C HOV LANES - STAGE 1 228TH BRIDGE 405/103E	BRIDGE SHEET NO. 19 SHEET OF 517 OF 663 SHEETS
INTERMEDIATE DIAPHRAGMS	


24/116

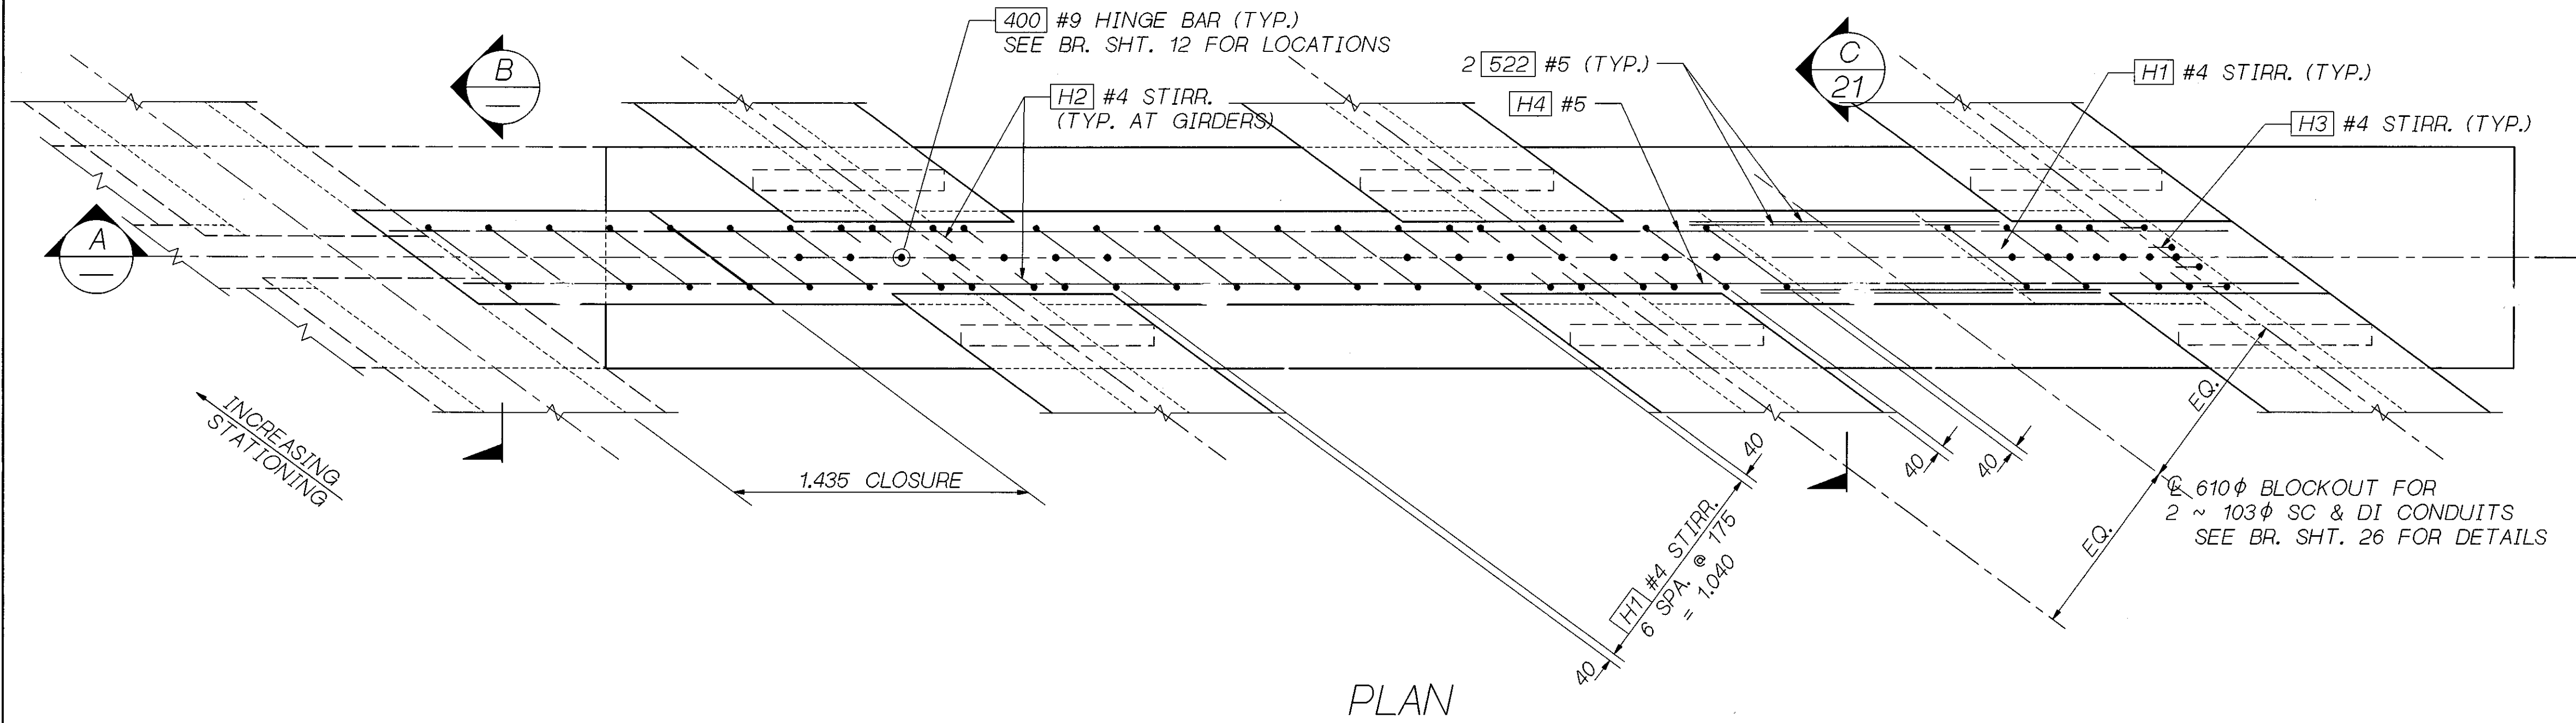

PLAN

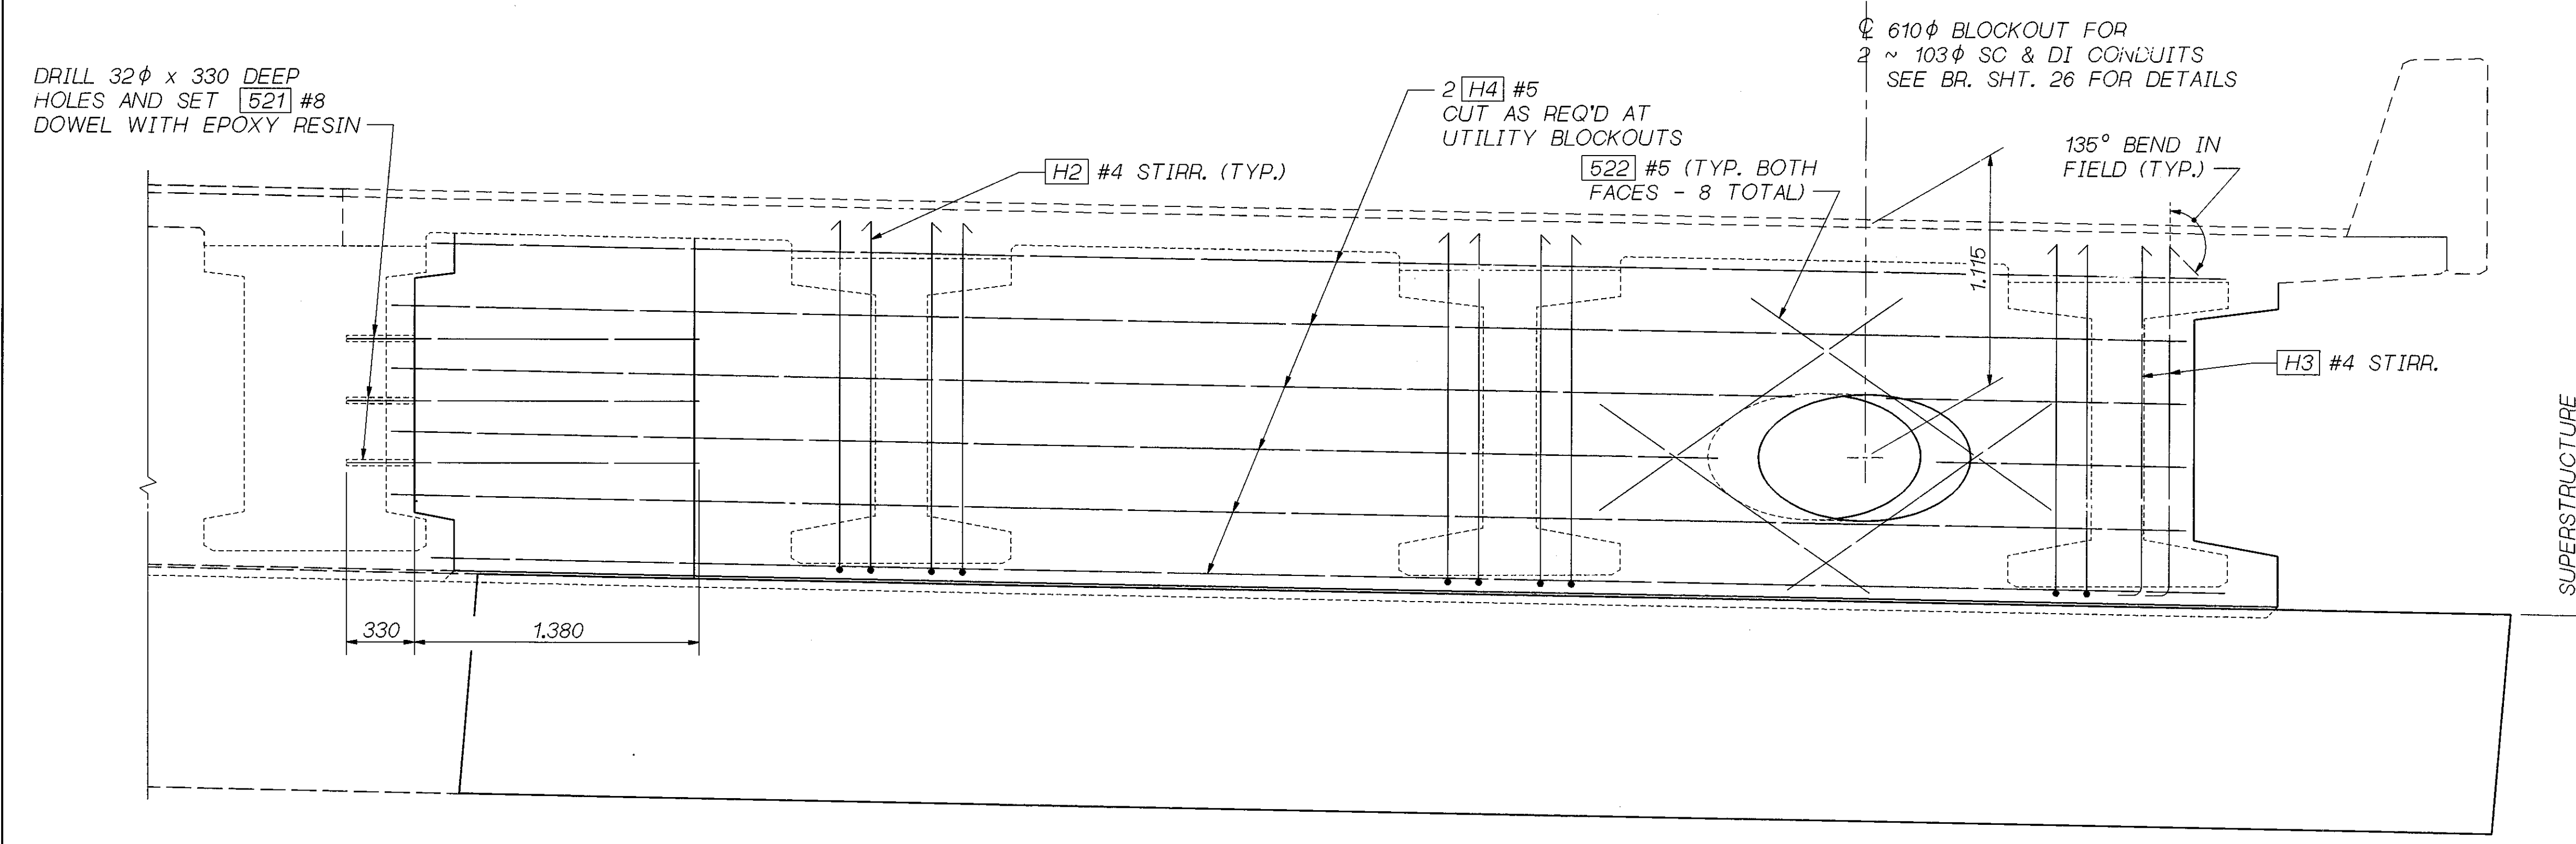

SECTION A

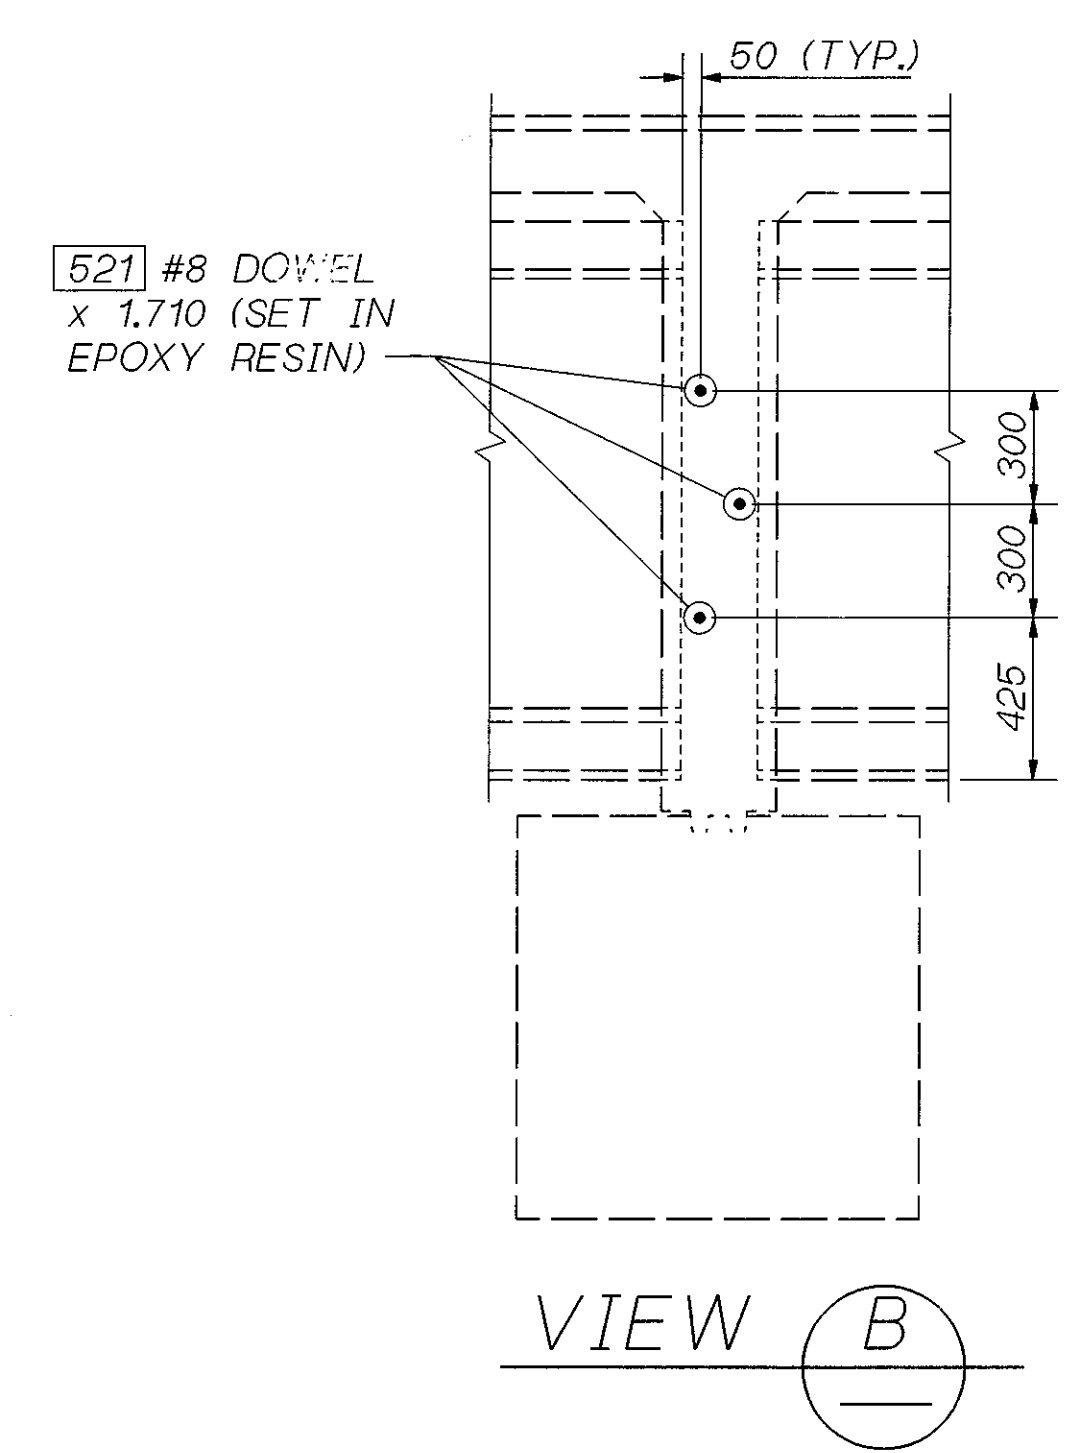


VIEW B

DRILL 32 φ x 330 DEEP HOLES AND SET #8 DOWEL WITH EPOXY RESIN

SR 405 JOB NO. 7079 SHEET 20

Bridge Design Engr.	S405D103ROOT-1.000000.FGB\HINGEE.FGB:1	REGION NO.	STATE	FED. AID PROJ. NO.	SHEET NO.	TOTAL SHEETS
Supervisor	W. WILSON	10	WASH.			
Designed By	M. TRAGESER 6/96					
Checked By	S. ANDERSON 6/96					
Detailed By	D.W. PULSE JR. 6/96					
Bridge Projects Engr.		JOB NUMBER	96W035			
Prelim. Plan By		DATE	REVISION	BY	APP'D	5054
Architect/Specialist						

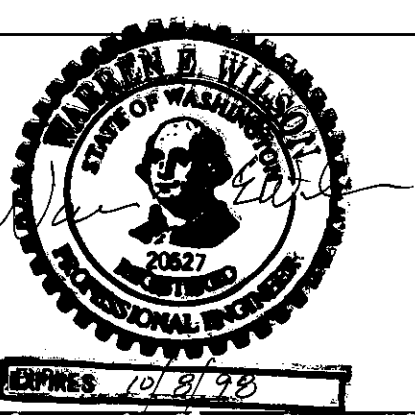


SR 405  
BOTHELL TO SWAMP CREEK 1/C  
HOV LANES - STAGE 1  
228TH BRIDGE 405/103E  
HINGE DIAPHRAGMS - 1 OF 2

BRIDGE SHEET NO. 20  
SHEET 518 OF 663 SHEETS

12-NOV-96


24/109

SR 405 JOB NO. 7079 SHEET 21

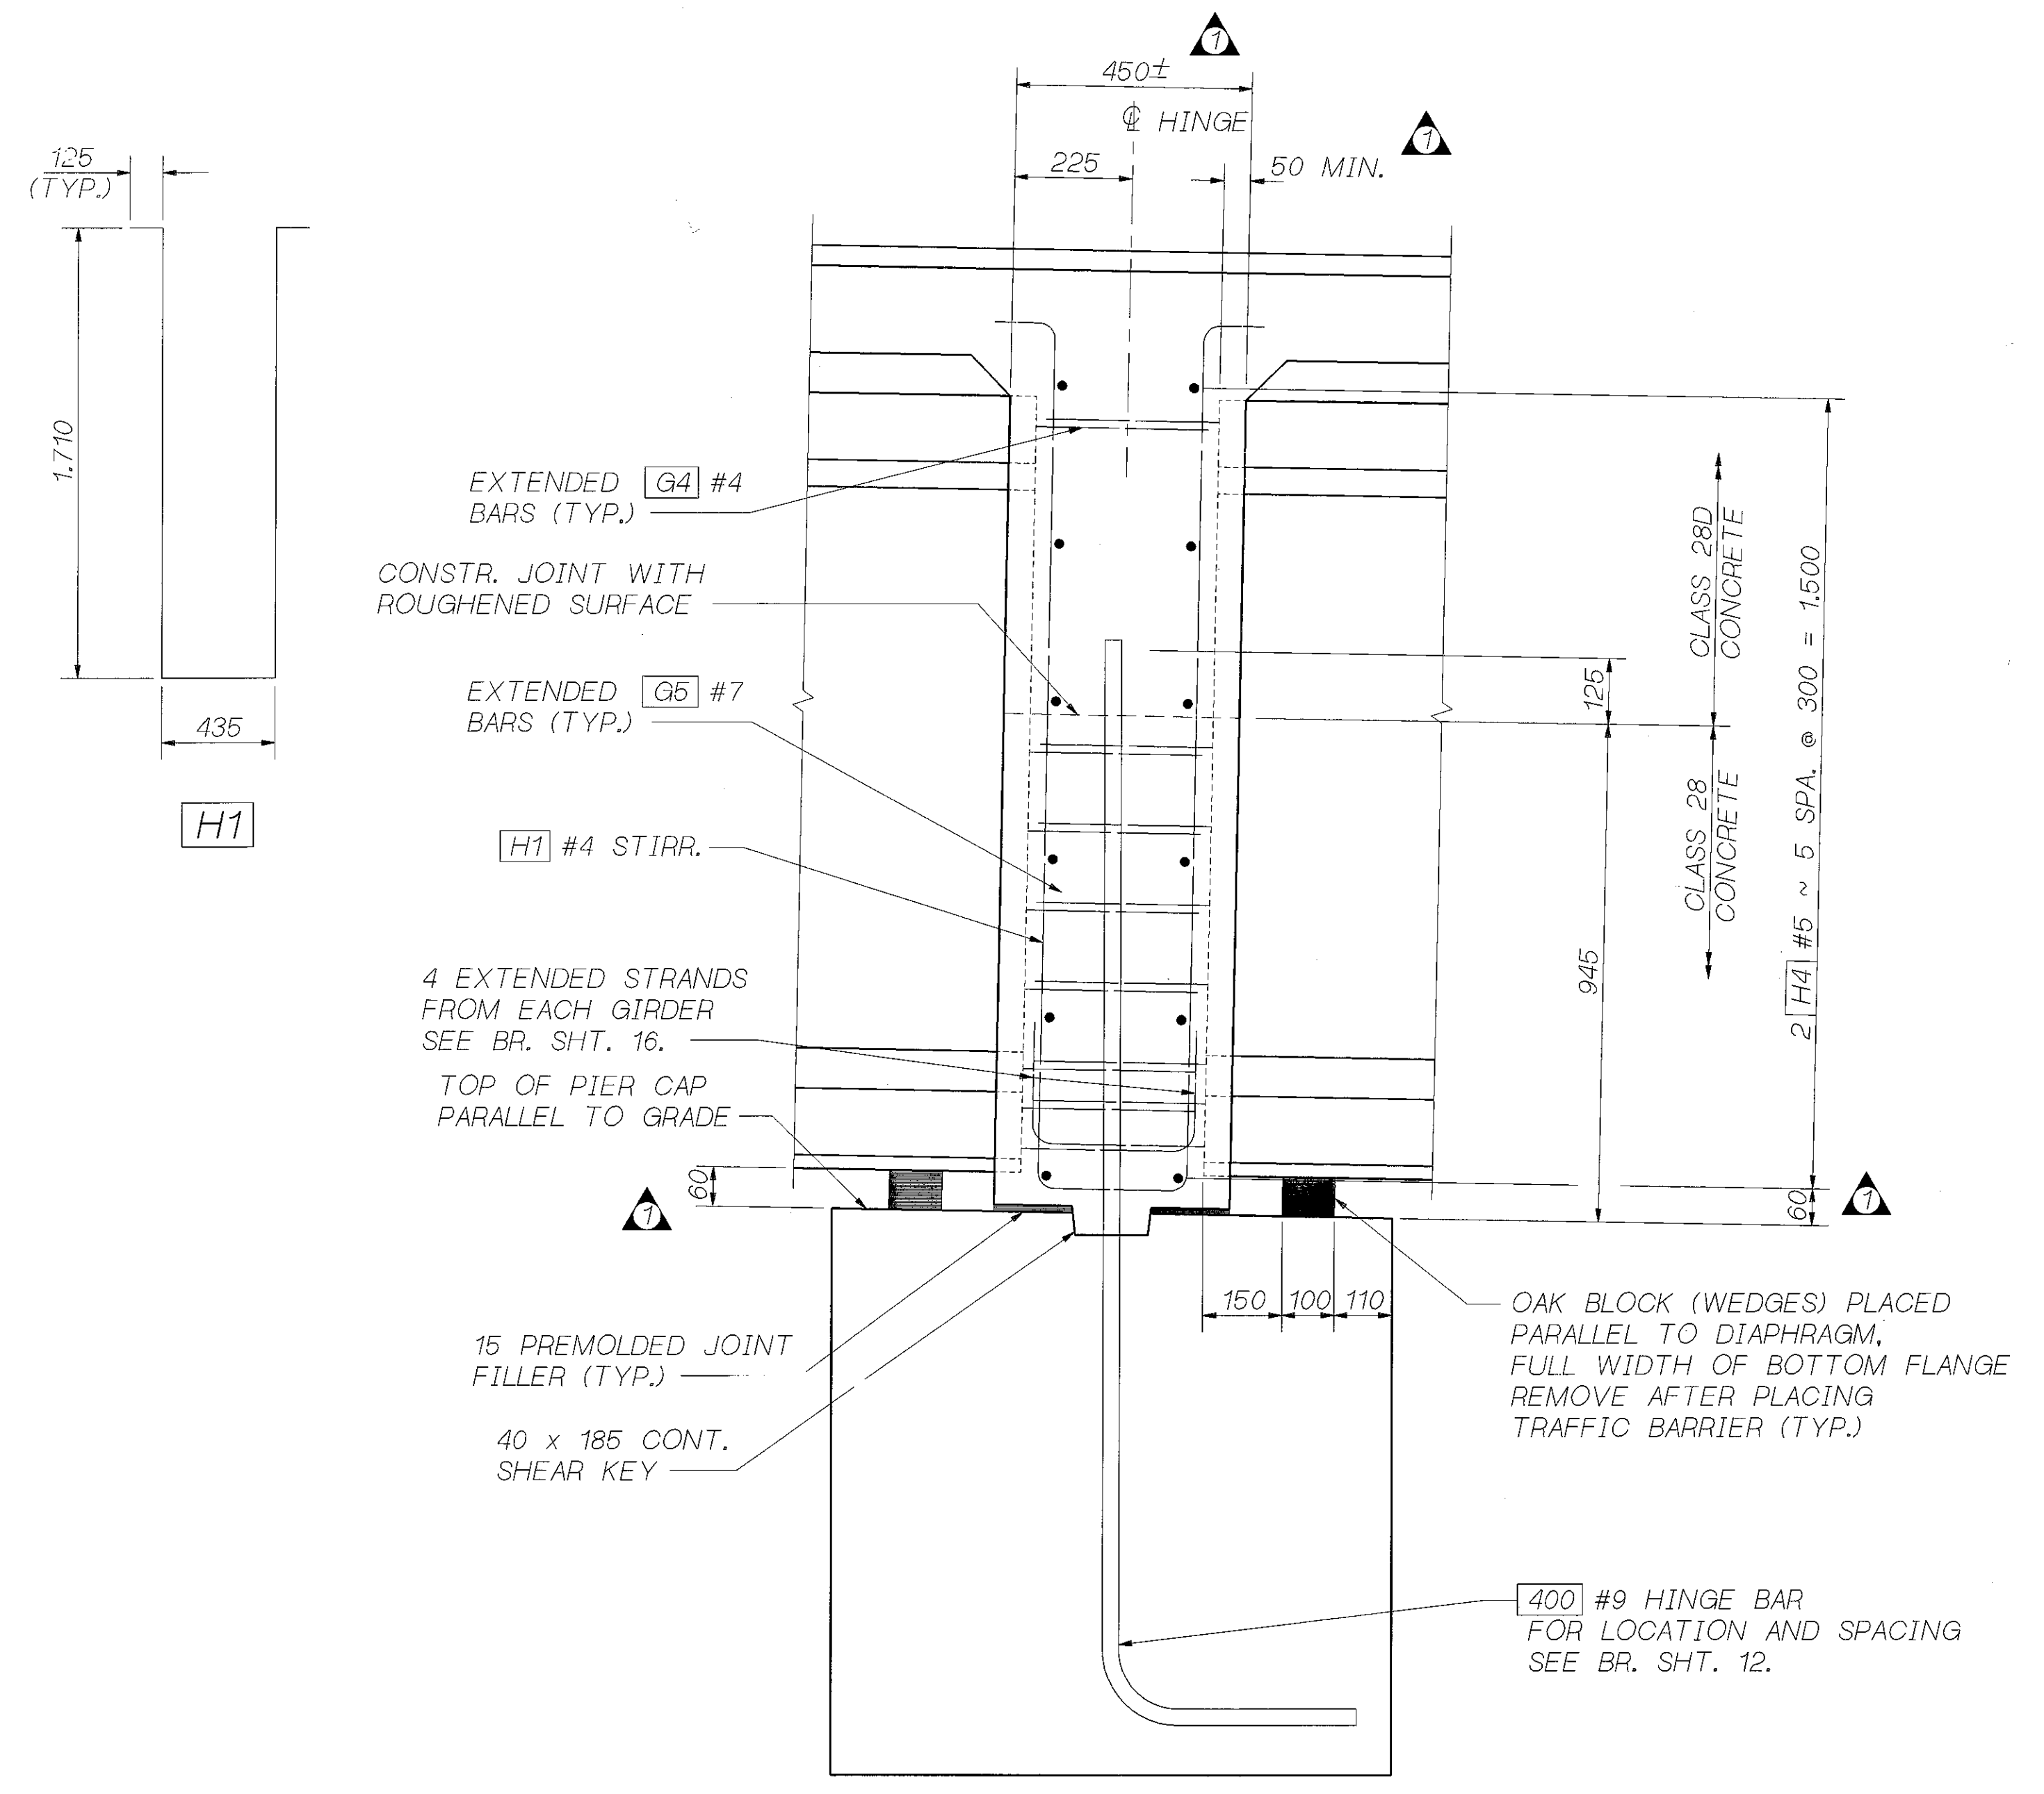

SECTION C  
20

Bridge Design Engr.	S:\05D\103\ROOT:\FGB\103\DET.FGB:1	REGION NO.	STATE	FED. AID PROJ. NO.	SHEET NO.	TOTAL SHEETS
Supervisor	W. WILSON					
Designed By	M. TRAGESSE	10	WASH.			
Checked By	S. ANDERSON					
Detailled By	D.W. PULSE JR.					
Bridge Projects Engr.				JOB NUMBER		
Prelim. Plan By	10/97			96W035		
Architect/Specialist	DATE	REVISION	BY	APP'D		
				5054		

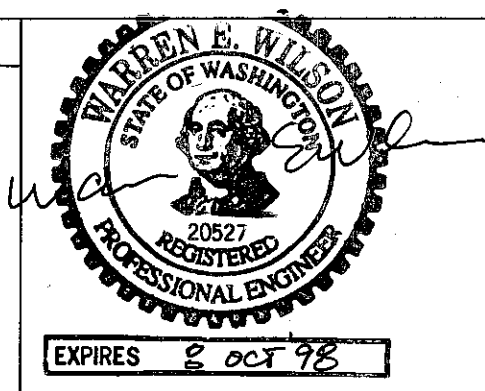


SR 405  
BOTHELL TO SWAMP CREEK I/C  
HOV LANES - STAGE 1  
228TH BRIDGE 405/103E

HINGE DIAPHRAGMS - 2 OF 2





BRIDGE SHEET NO.  
**21**  
SHEET OF SHEETS  
519 OF 663

16-OCT-97

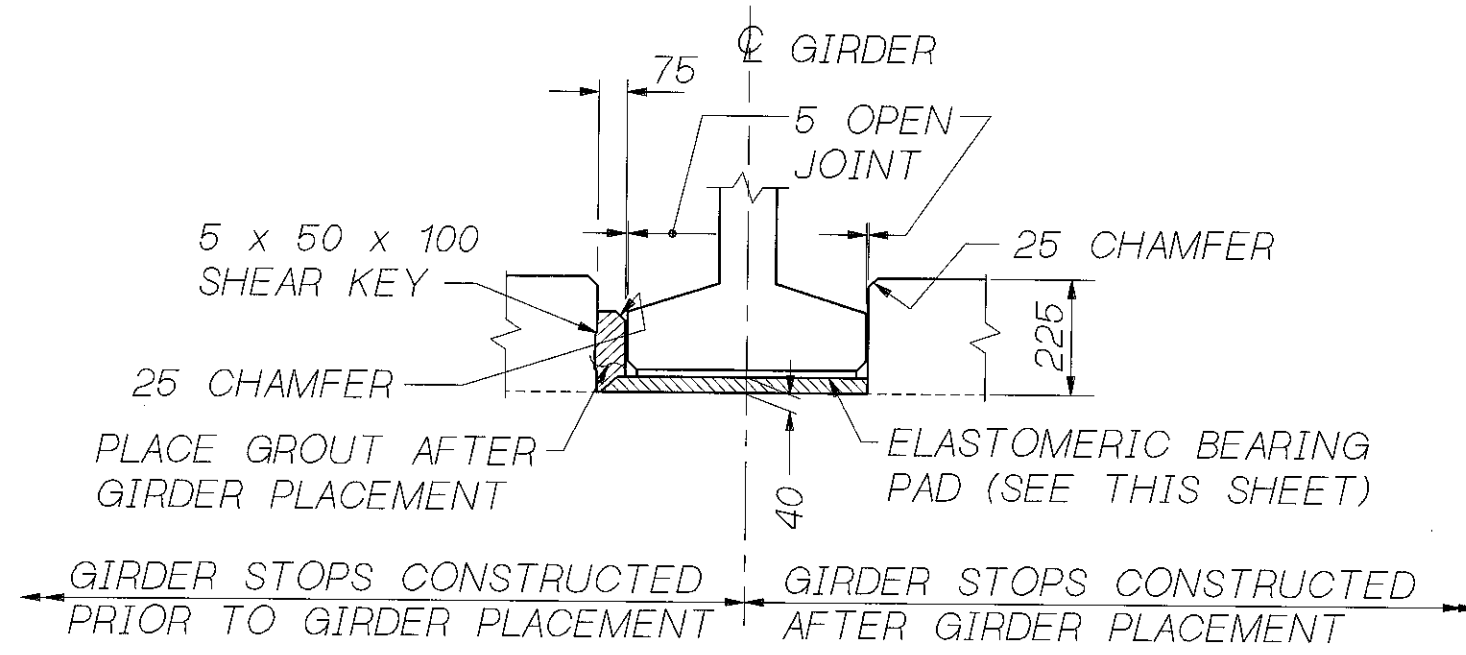

### GIRDER SEAT GROUTING DETAIL


GIRDER STOPS MAY BE CONSTRUCTED EITHER PRIOR TO GIRDER PLACEMENT OR AFTER GIRDER PLACEMENT. THE SAME METHOD SHALL BE USED FOR EACH PIER.

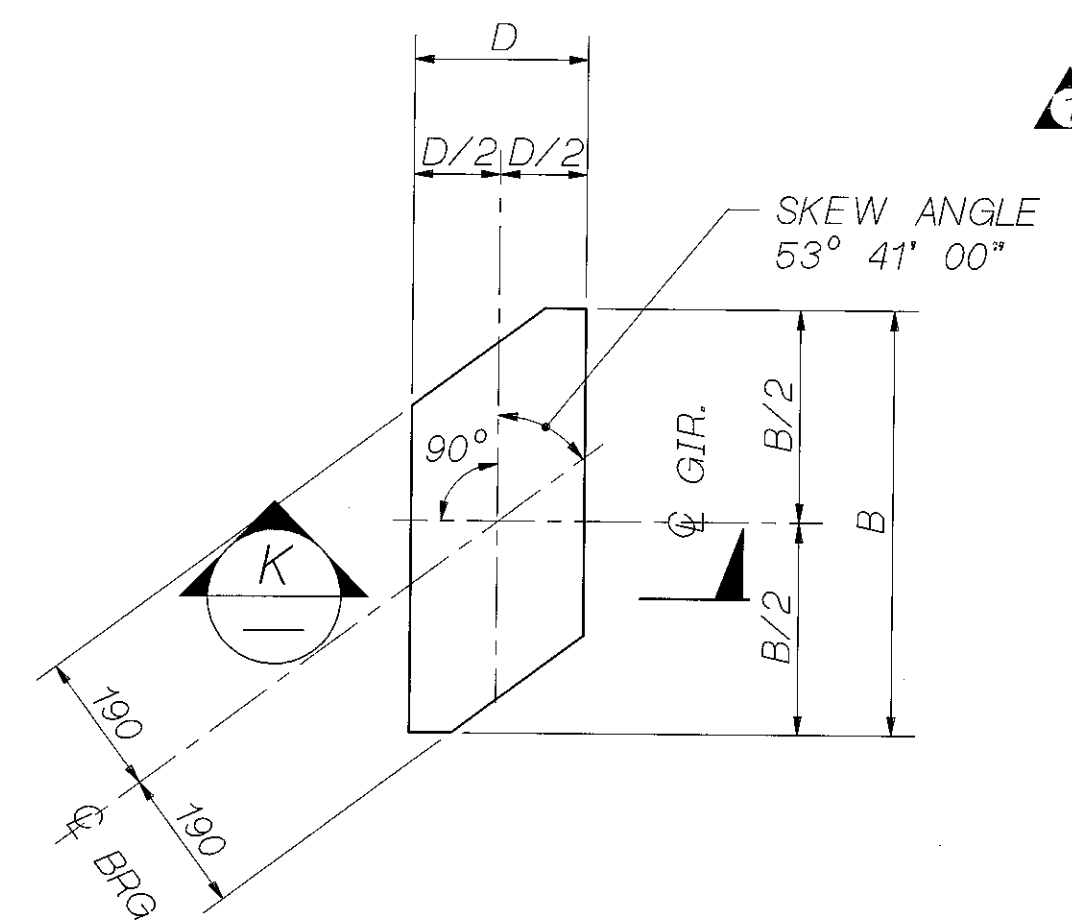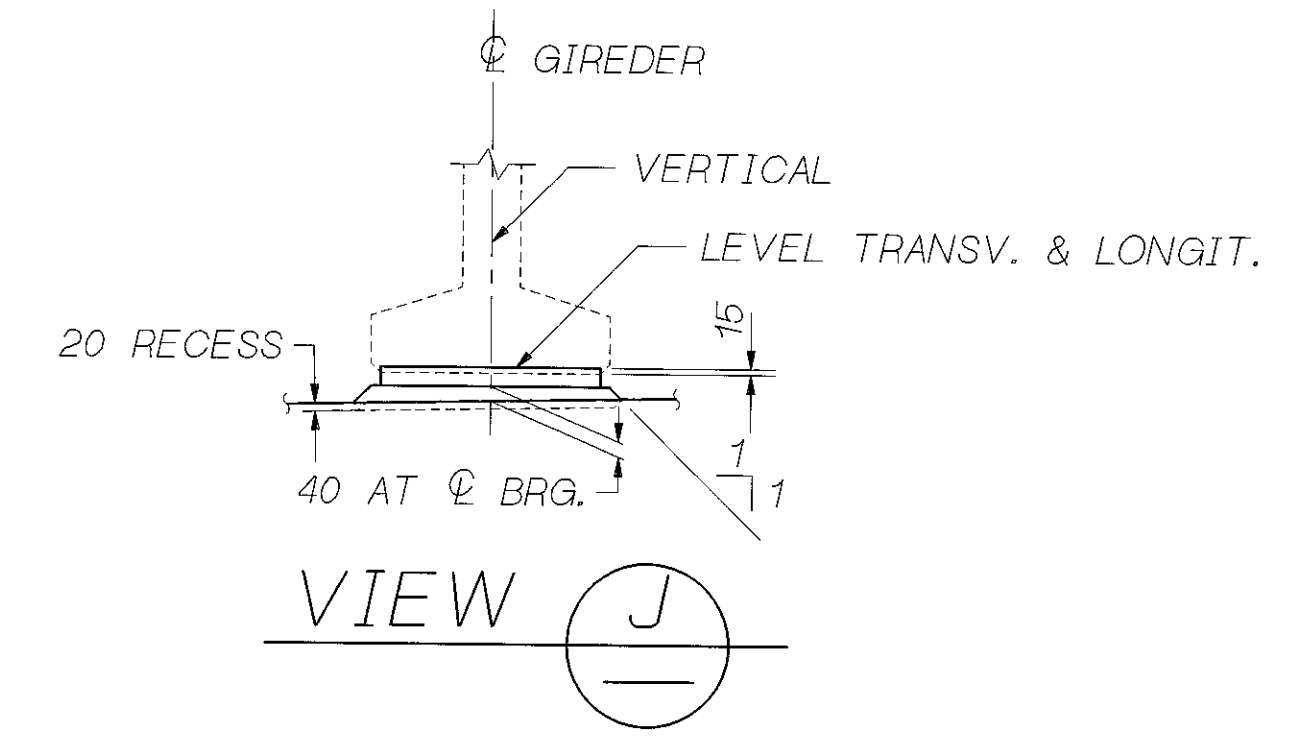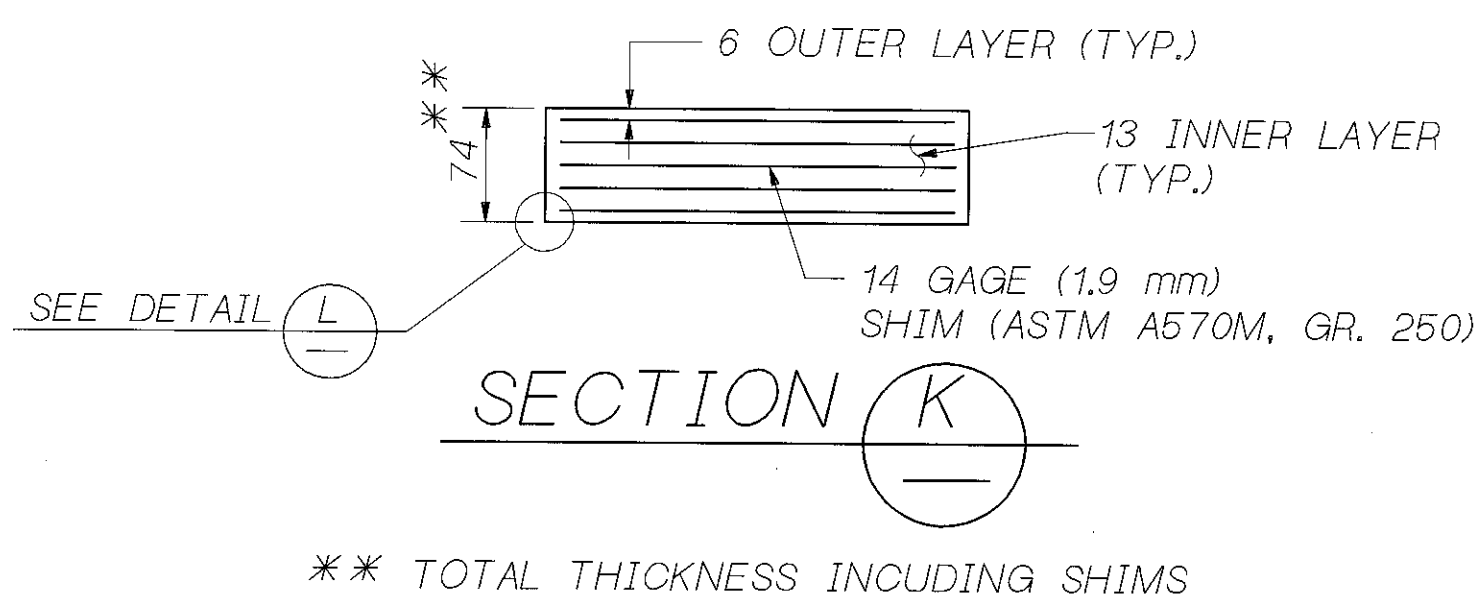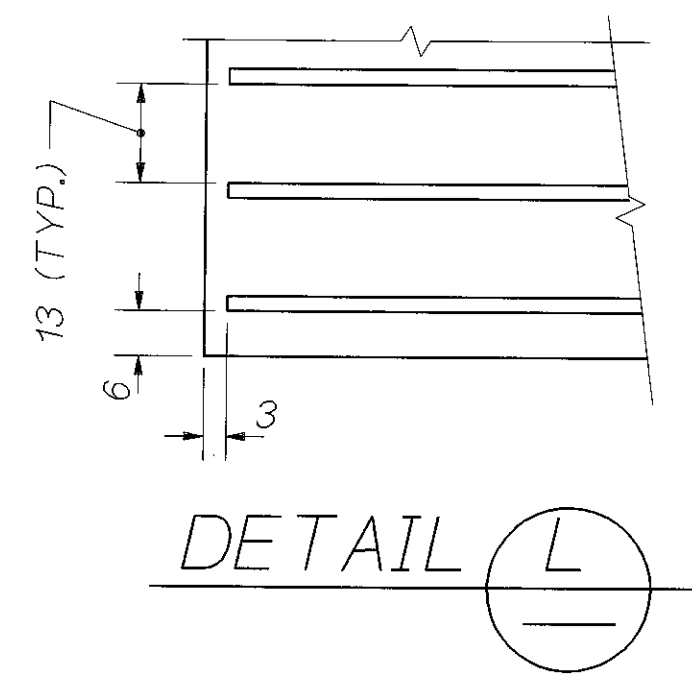

GIRDER SERIES	B	D
W58MG	560	230

### BEARING PAD

LAMINATED ELASTOMERIC BRG. PAD 74 THICK (5 SHIMS) DUROMETER HARDNESS = 60.

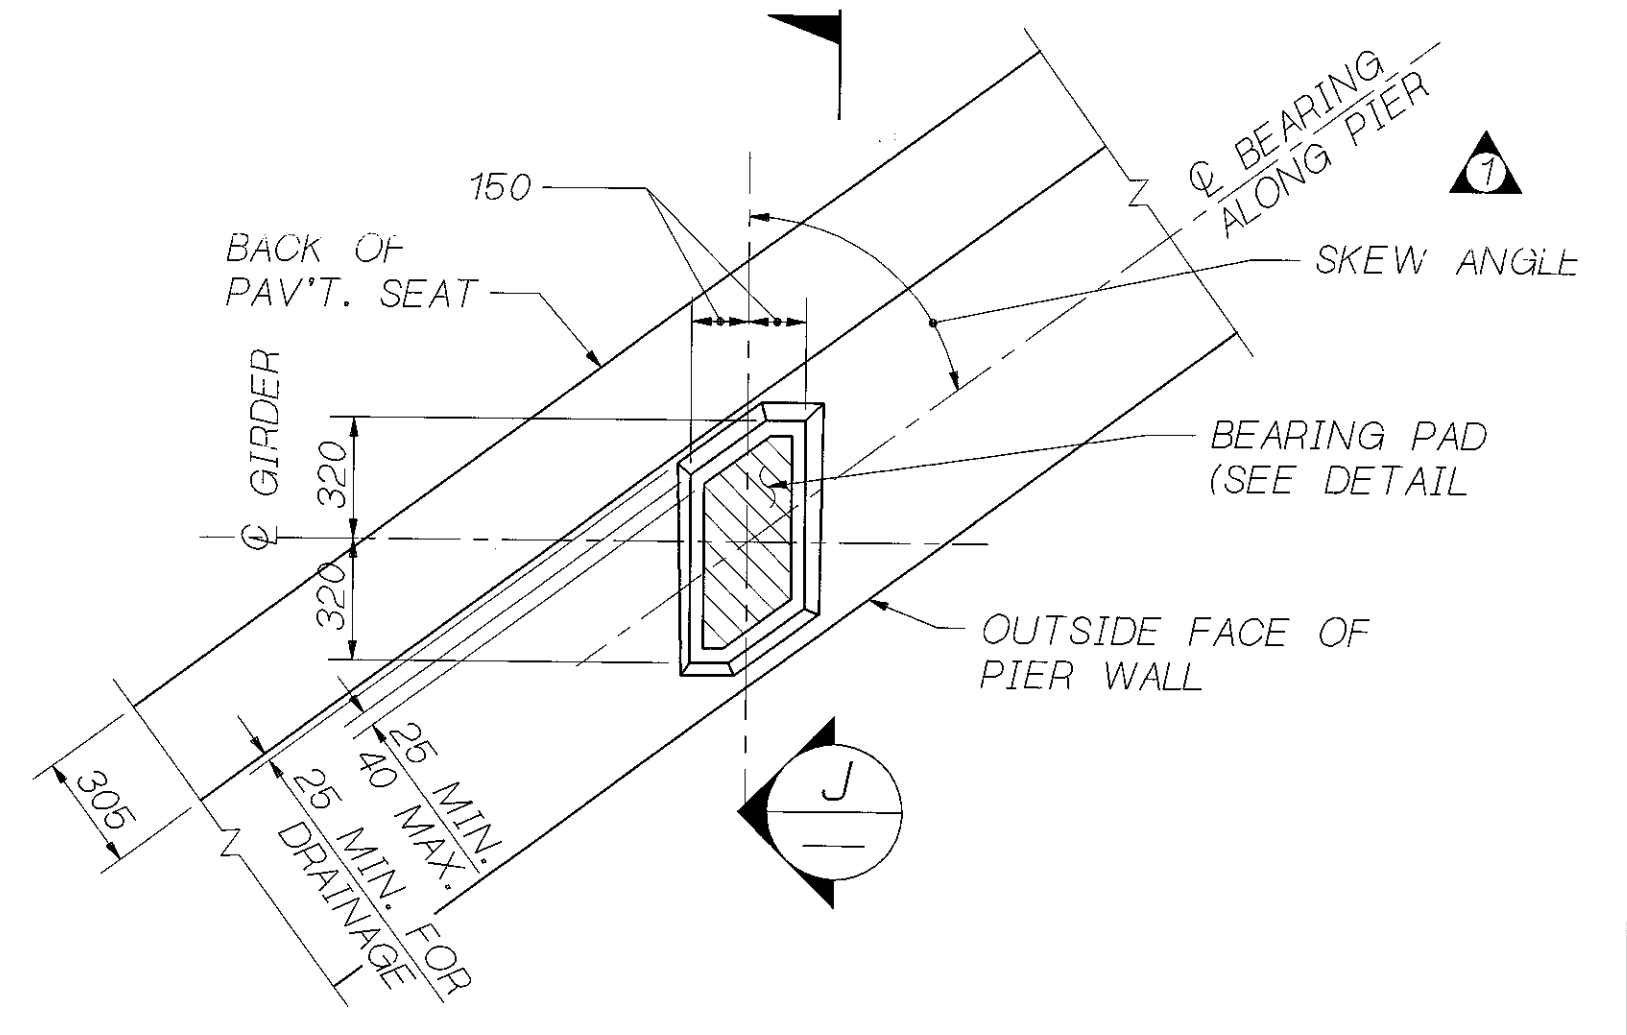


AT END PIER WITH "L" ABUTMENTS

### GROUT PAD

SR 405 JOB NO. 7079 SHEET 22

Bridge Design Engr.	S405D103ROOT (FGB)MISC.FGB:1	REGION NO.	STATE	FED. AID PROJ. NO.	SHEET NO.	TOTAL SHEETS
Supervisor	W. WILSON		10 WASH.			
Designed By	M. TRAGESER 6/96					
Checked By	S. ANDERSON 6/96					
Detailed By	D.W. PULSE JR. 6/96					
Bridge Projects Engr.				JOB NUMBER 96W035		
Prelim. Plan By	10/97	7	REVISED AS-BUILT SURVEY DATA	JZ		
Architect/Specialist	DATE	REVISION	BY	APP'D	5054	

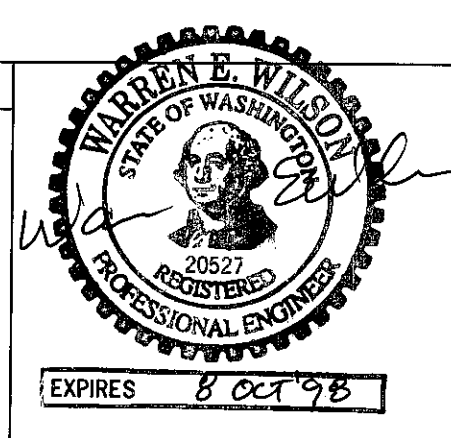


SR 405  
BOTHELL TO SWAMP CREEK 1/2  
HOV LANES - STAGE 1  
228TH BRIDGE 405/103E


MISCELLANEOUS DETAILS

BRIDGE SHEET NO. 22  
SHEET 520 OF 663 SHEETS

16-OCT-97

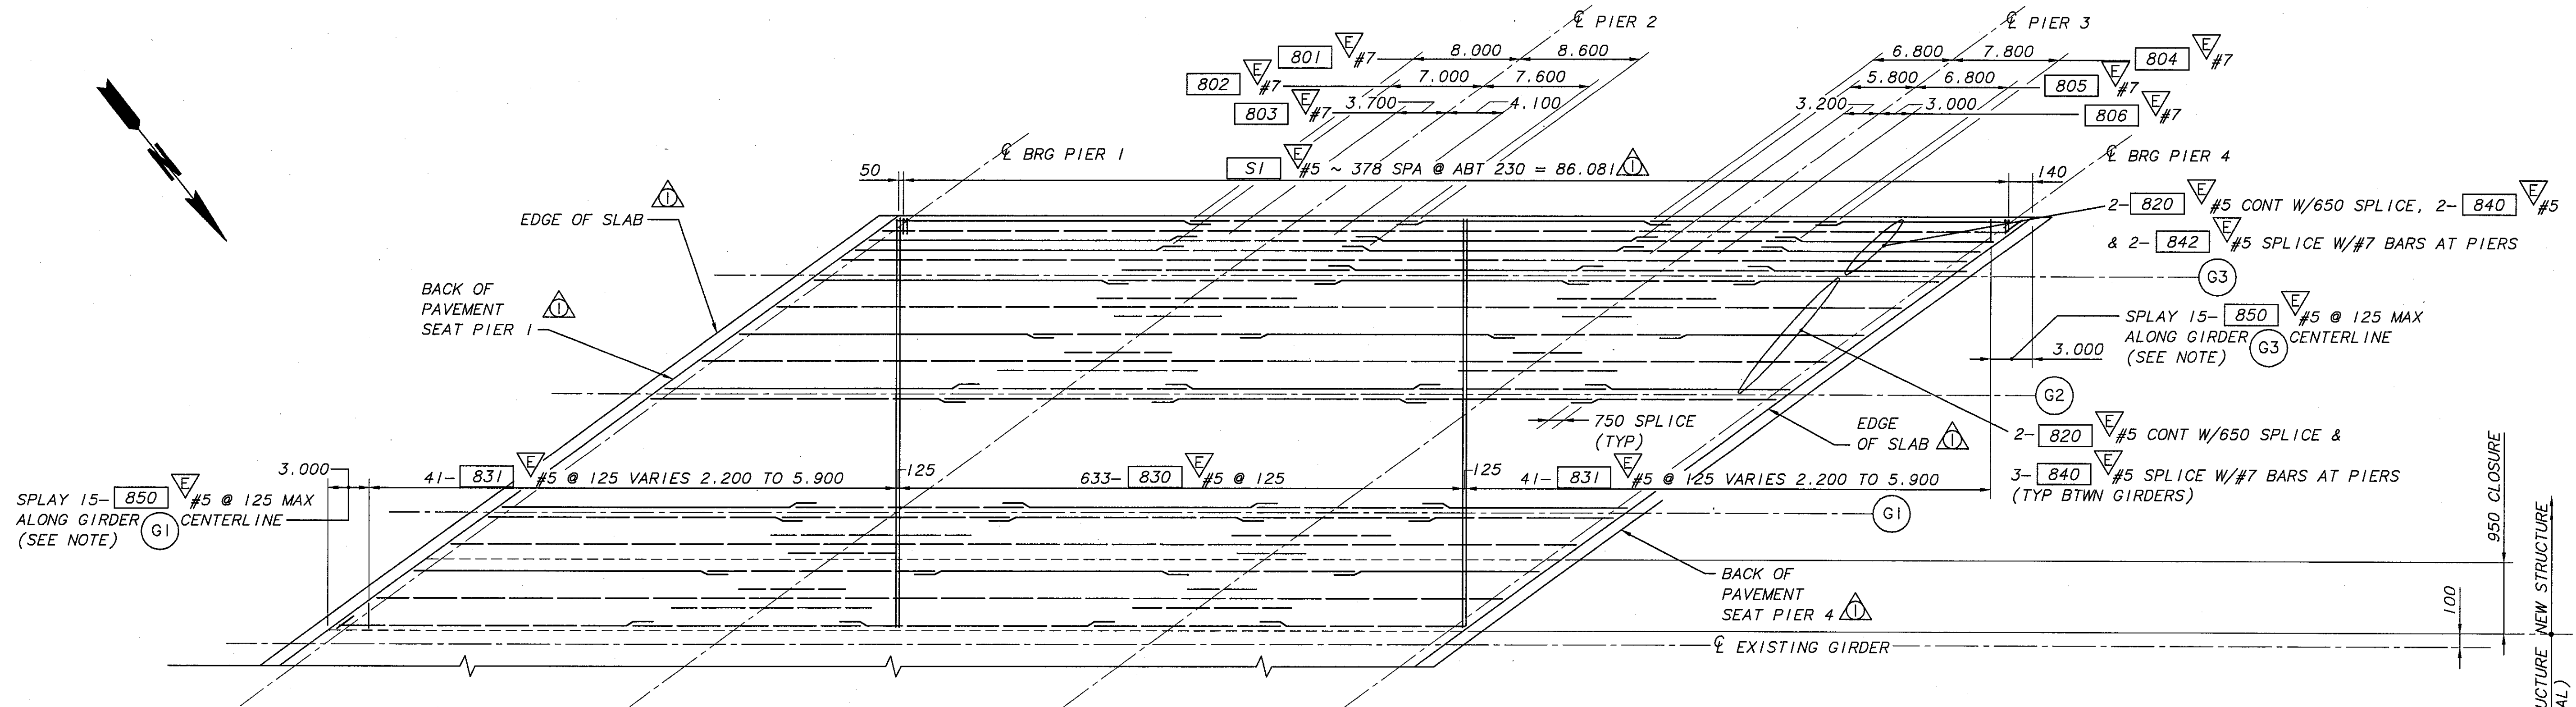

**ROADWAY SLAB PLAN - TOP MAT**  
 ▽ DENOTES EPOXY COATED BARS

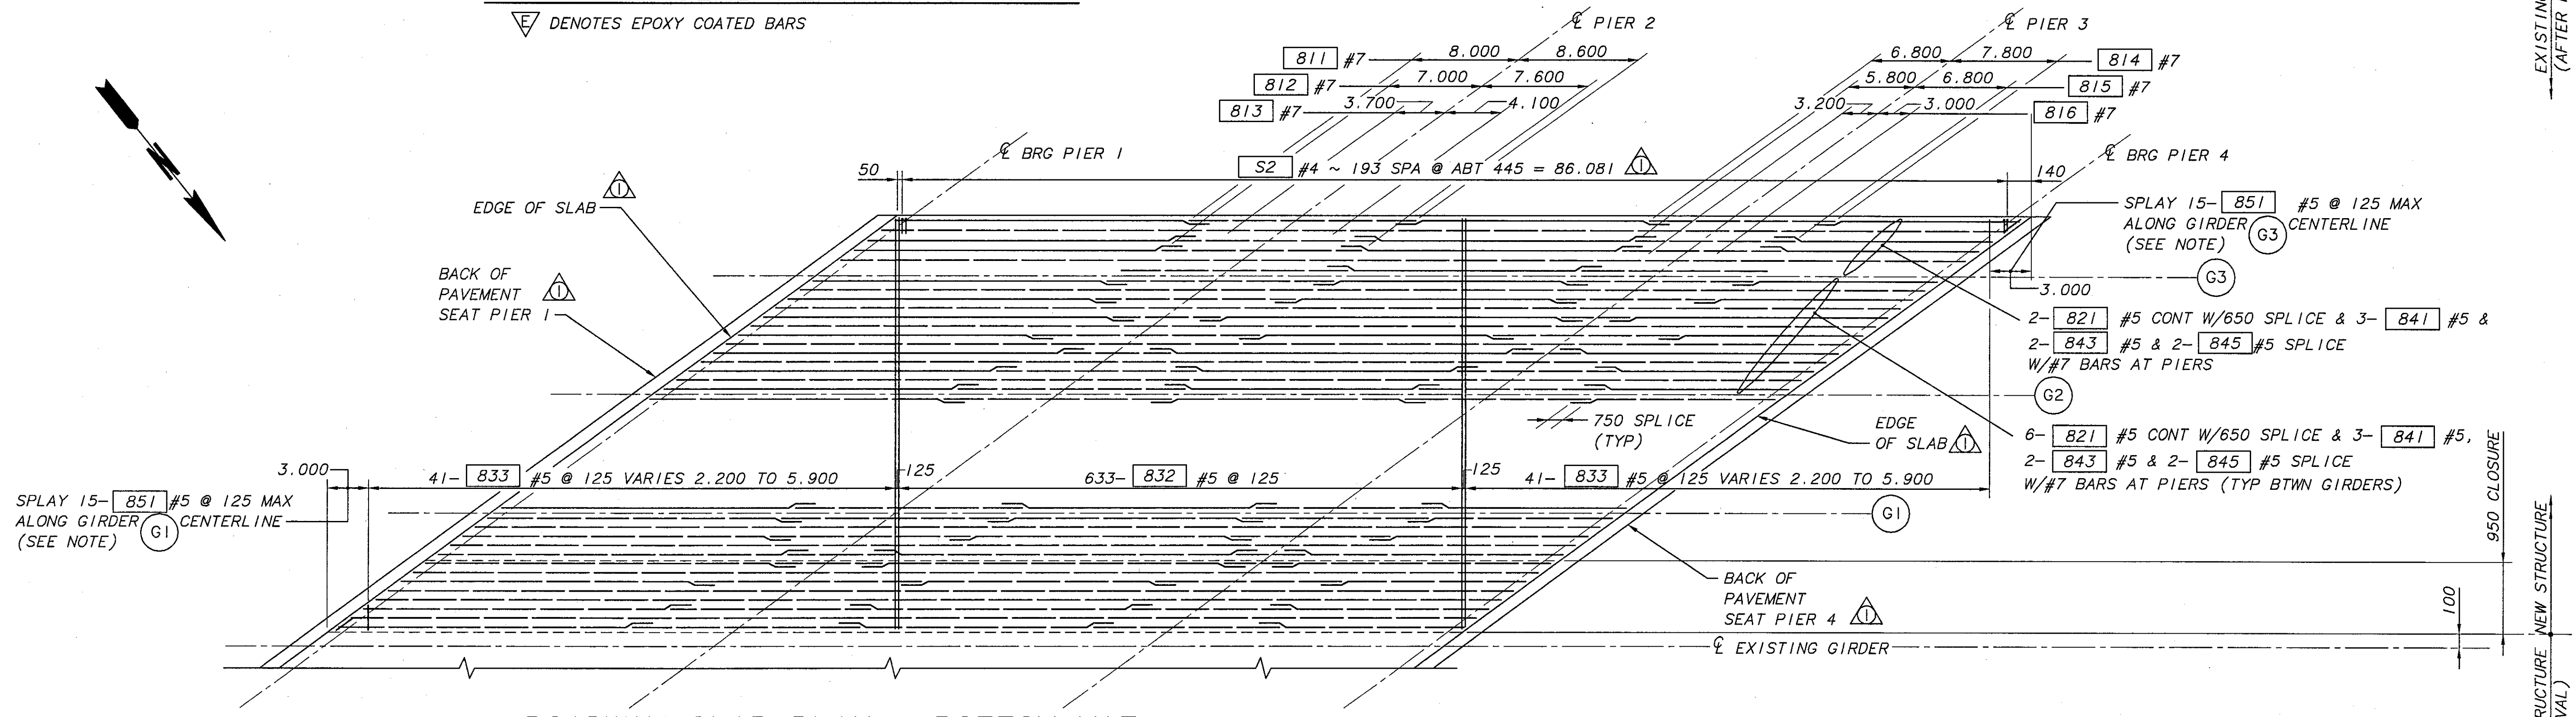


**ROADWAY SLAB PLAN - BOTTOM MAT**  
 ▽ DENOTES EPOXY COATED BARS

NOTE: HORIZONTAL & VERTICAL SCALES ARE DIFFERENT. SPLAYED BARS ARE NOT SHOWN PROPORTIONALLY.

SR 405 JOB NO. 7079 SHEET 23 OF 31

BRIDGE DESIGN ENGR		REGION	STATE	FED AID PROJ NO	SHEET NO	TOTAL SHEETS
SUPERVISOR		I	WASH			
DESIGNED BY	M. TRAGESSER 6/96	JOB NUMBER	96W035			
CHECKED BY	S. ANDERSON 6/96	CONTRACT NO.	5054			
DETAILED BY	R. MOHN 6/96					
BRIDGE PROJECTS ENGR						
PRELIM PLAN BY	10/97	REVISED AS-BUILT SURVEY DATA	JM			
ARCHITECT/SPECIALIST	DATE	REVISION	BY	APPR		

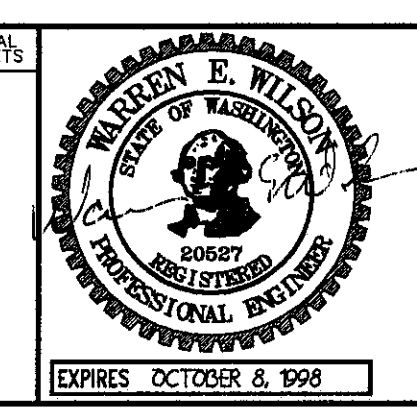


**BERGER/ABAM**  
 ENGINEERS INC.  
 33301 9TH AVENUE SOUTH  
 FEDERAL WAY, WASHINGTON 98003-8328  
 (206)431-9300 FAX: (206)431-2250



SR 405  
 BOTHELL TO SWAMP CREEK I/C  
 HOV LANES - STAGE 1  
 228TH BRIDGE 405/103E  
 ROADWAY SLAB PLAN


BRIDGE SHEET NO. **23**  
 SHEET 521 OF 663 SHEETS

PLOTTED: Wed Oct 22 1997 11:37am FILENAME: V:\96077\405-103E\23.dwg SCALE: 25

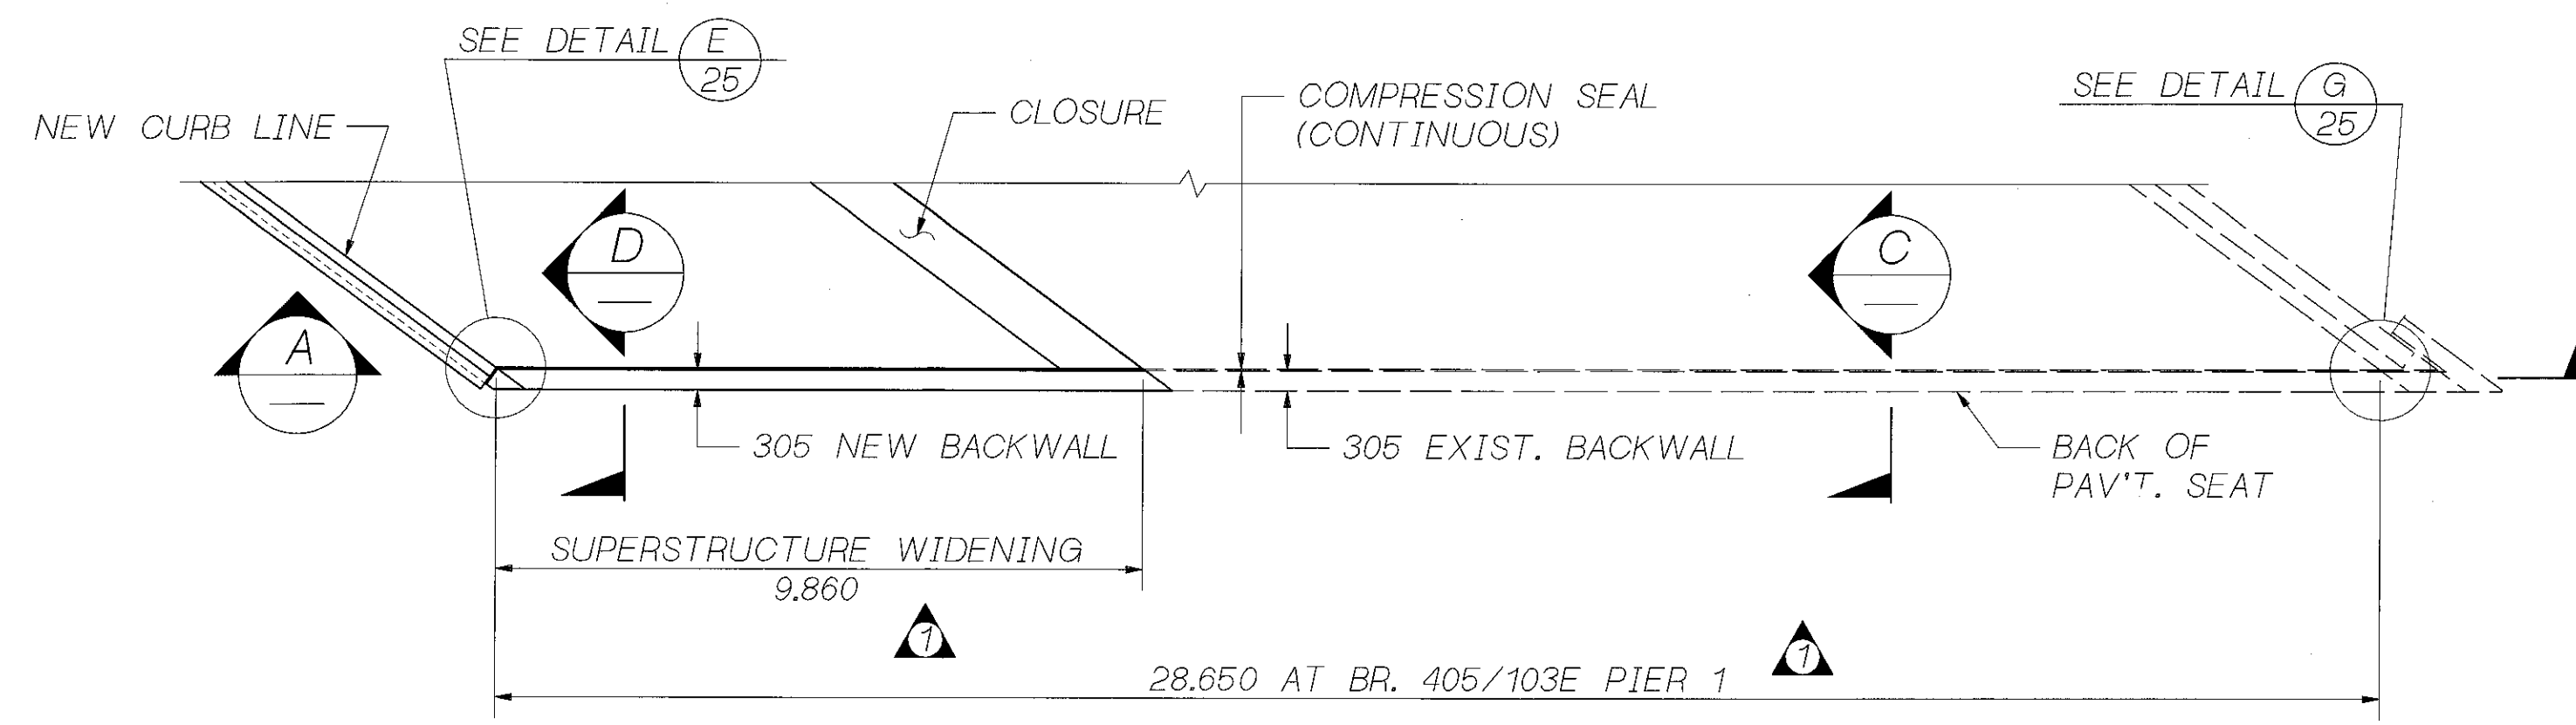


PLAN

BR. 405/103E PIER 1 SHOWN  
LOOKING AHEAD ON STATIONING.  
BR. 405/103W PIER 4 SIMILAR.

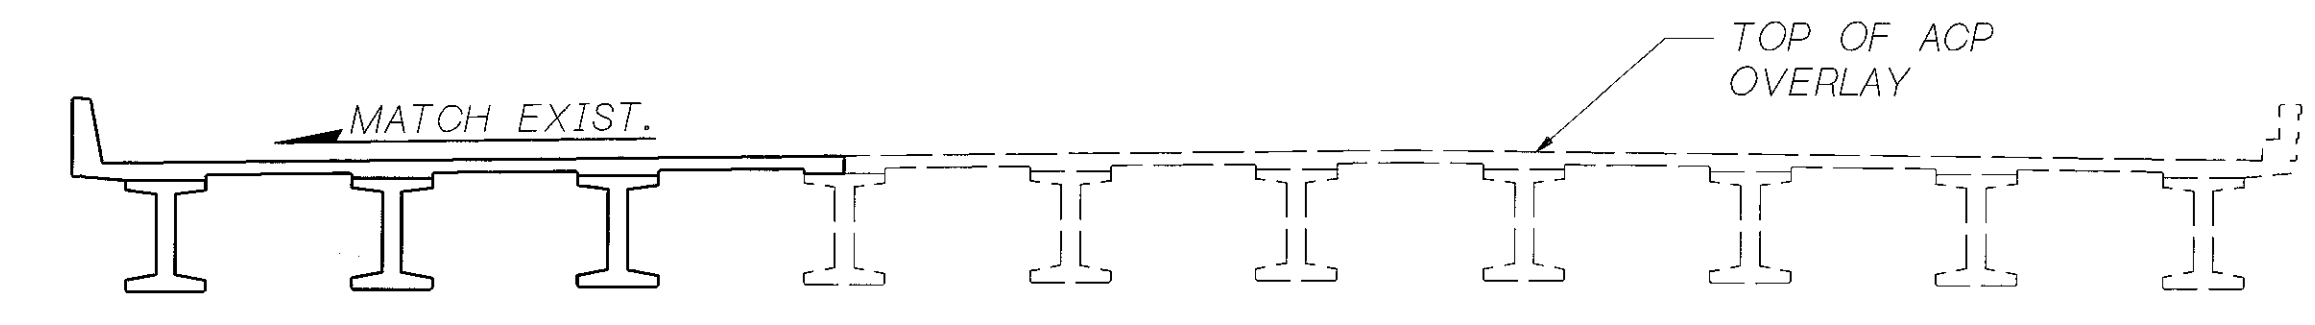


SECTION A

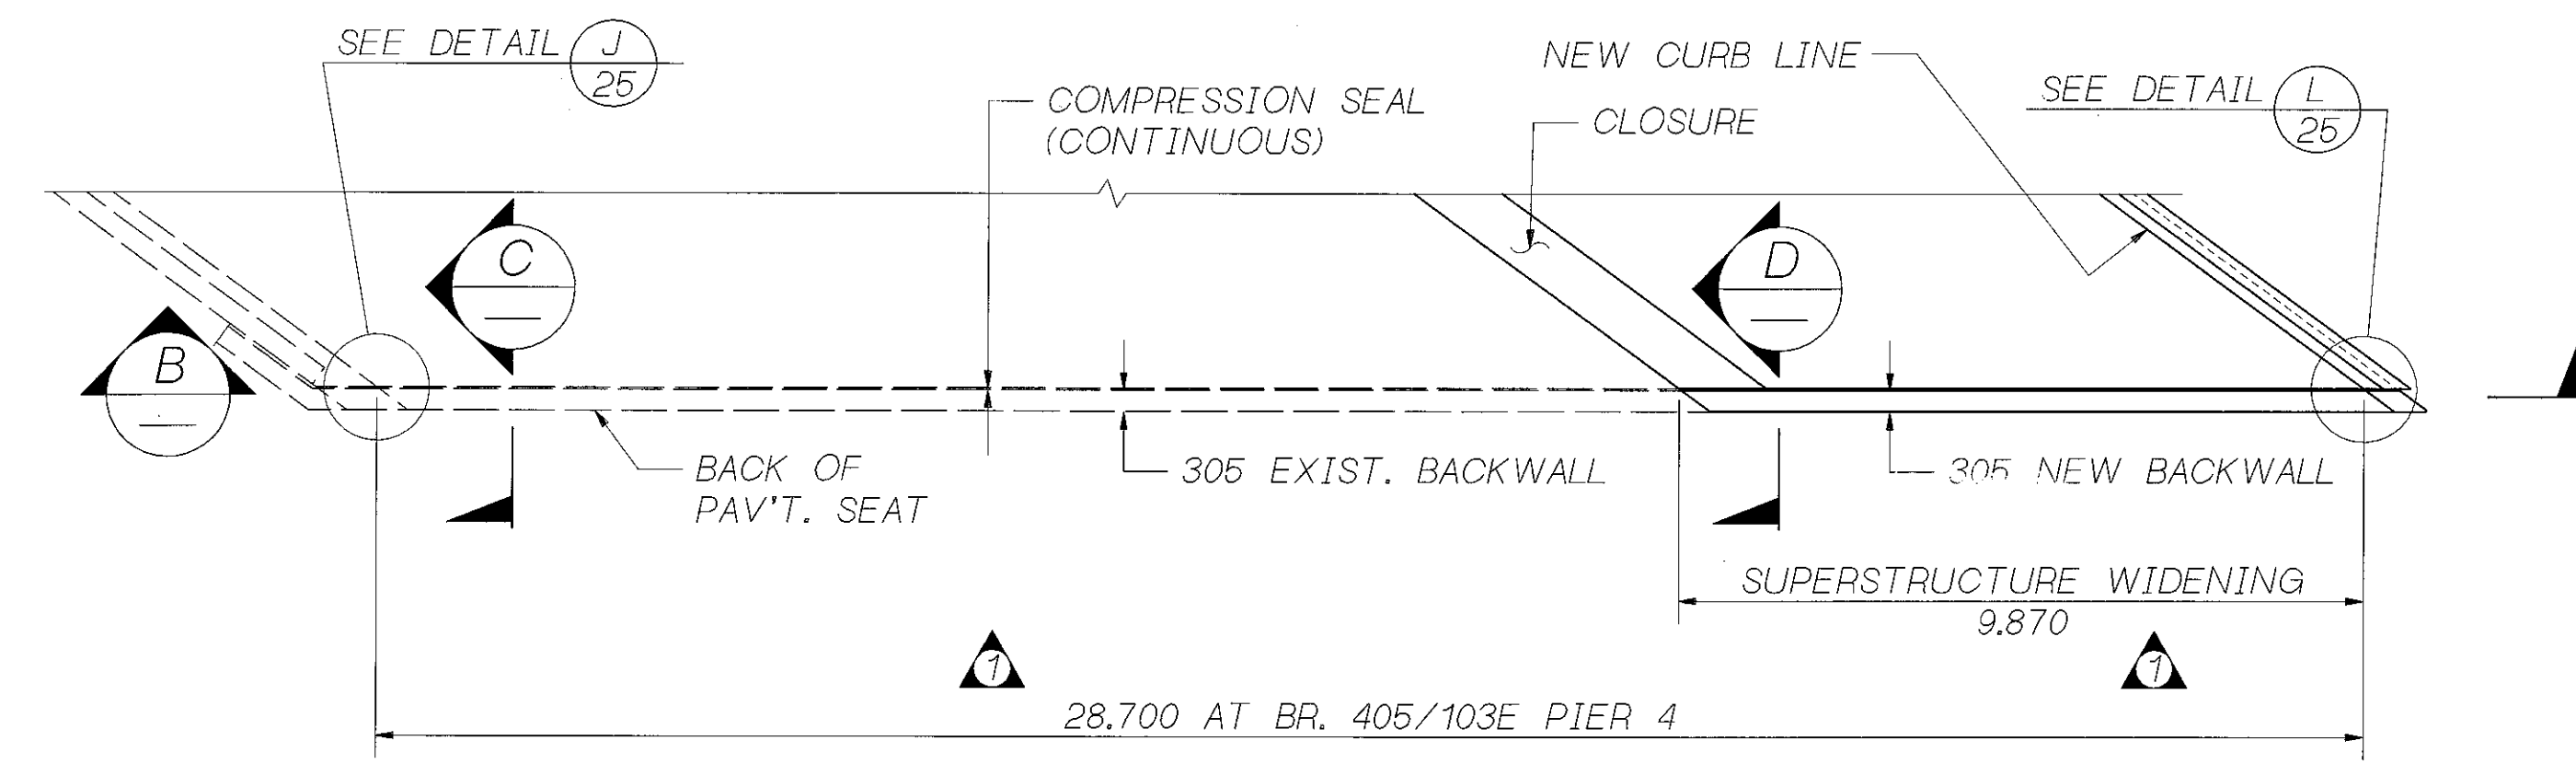


PLAN

BR. 405/103E PIER 4 SHOWN  
LOOKING BACK ON STATIONING.  
BR. 405/103W PIER 1 SIMILAR.

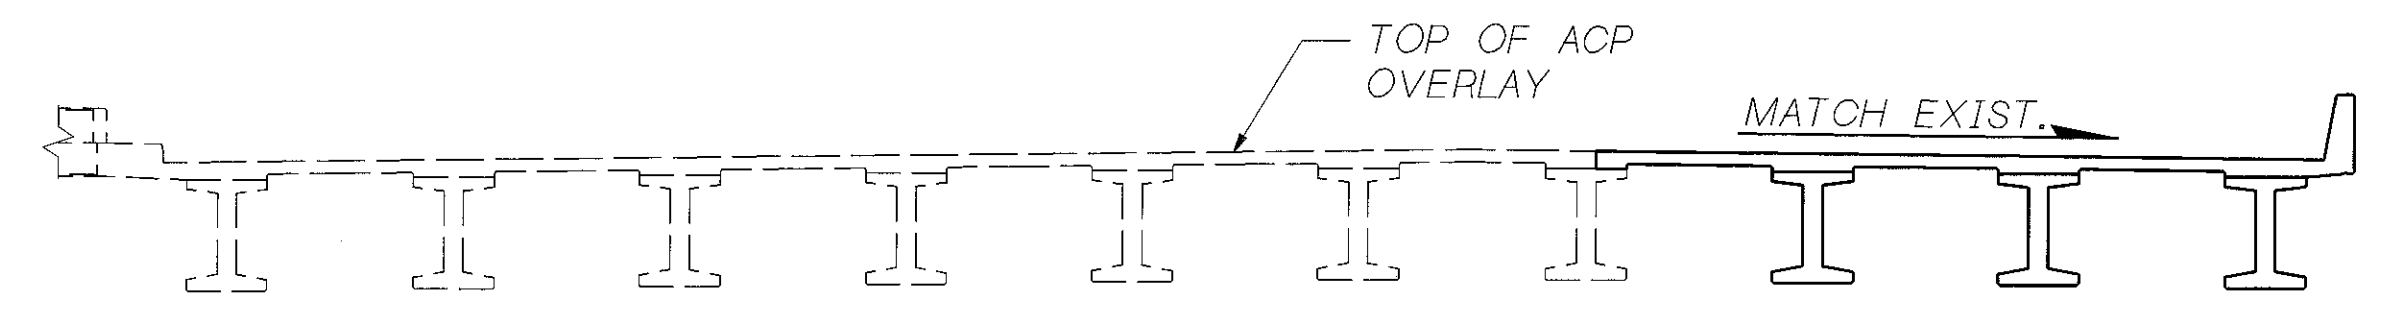

SECTION B

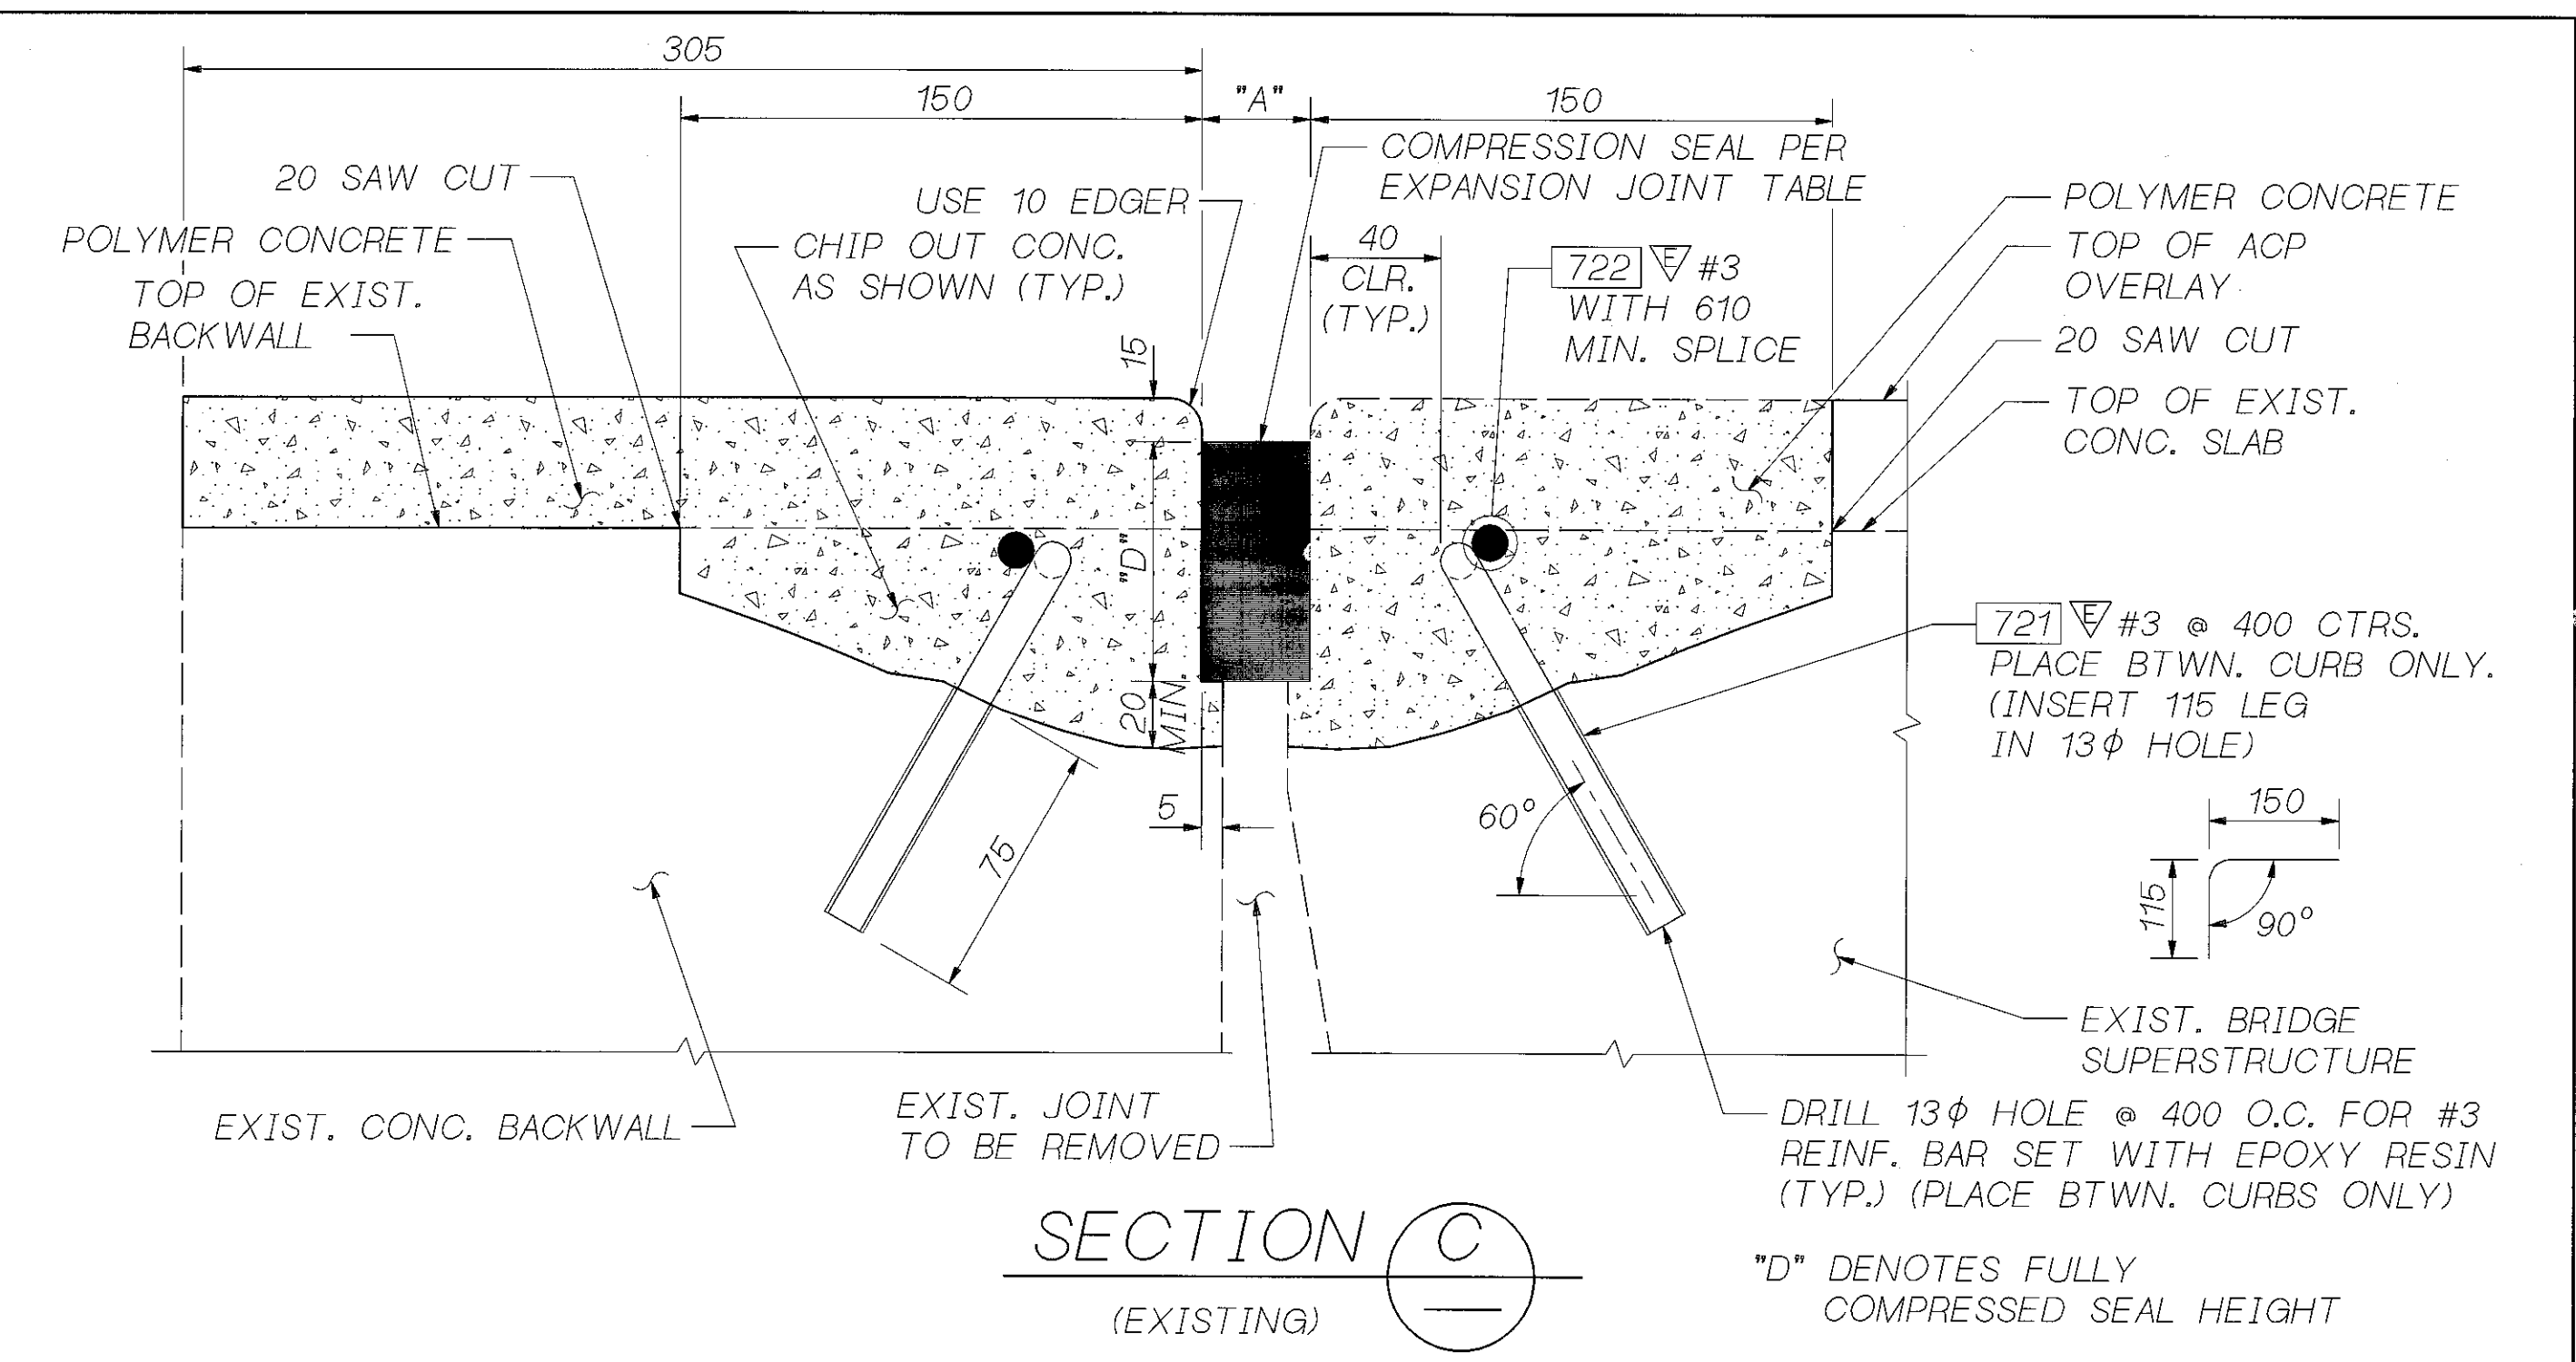


SECTION C  
(EXISTING)

"D" DENOTES FULLY COMPRESSED SEAL HEIGHT

COMPRESSION SEAL TABLE*				
LOCATION	OPENING "A" (NORMAL TO JOINT)			EXPANSION JOINT TYPE
	@ 5°C	@ 20°C	@ 25°C	
PIERS (1 AND 4) (2 LOCATIONS)	64	60	59	D.S. BROWN CV-4000 WATSON BOWMAN ACME WA-400 ELASTOMER SEALS X-4000 STRUCTURAL ACCESSORIES SA 4000

\* TESTING SHALL BE PER AASHTO M-220 PRIOR TO USE.

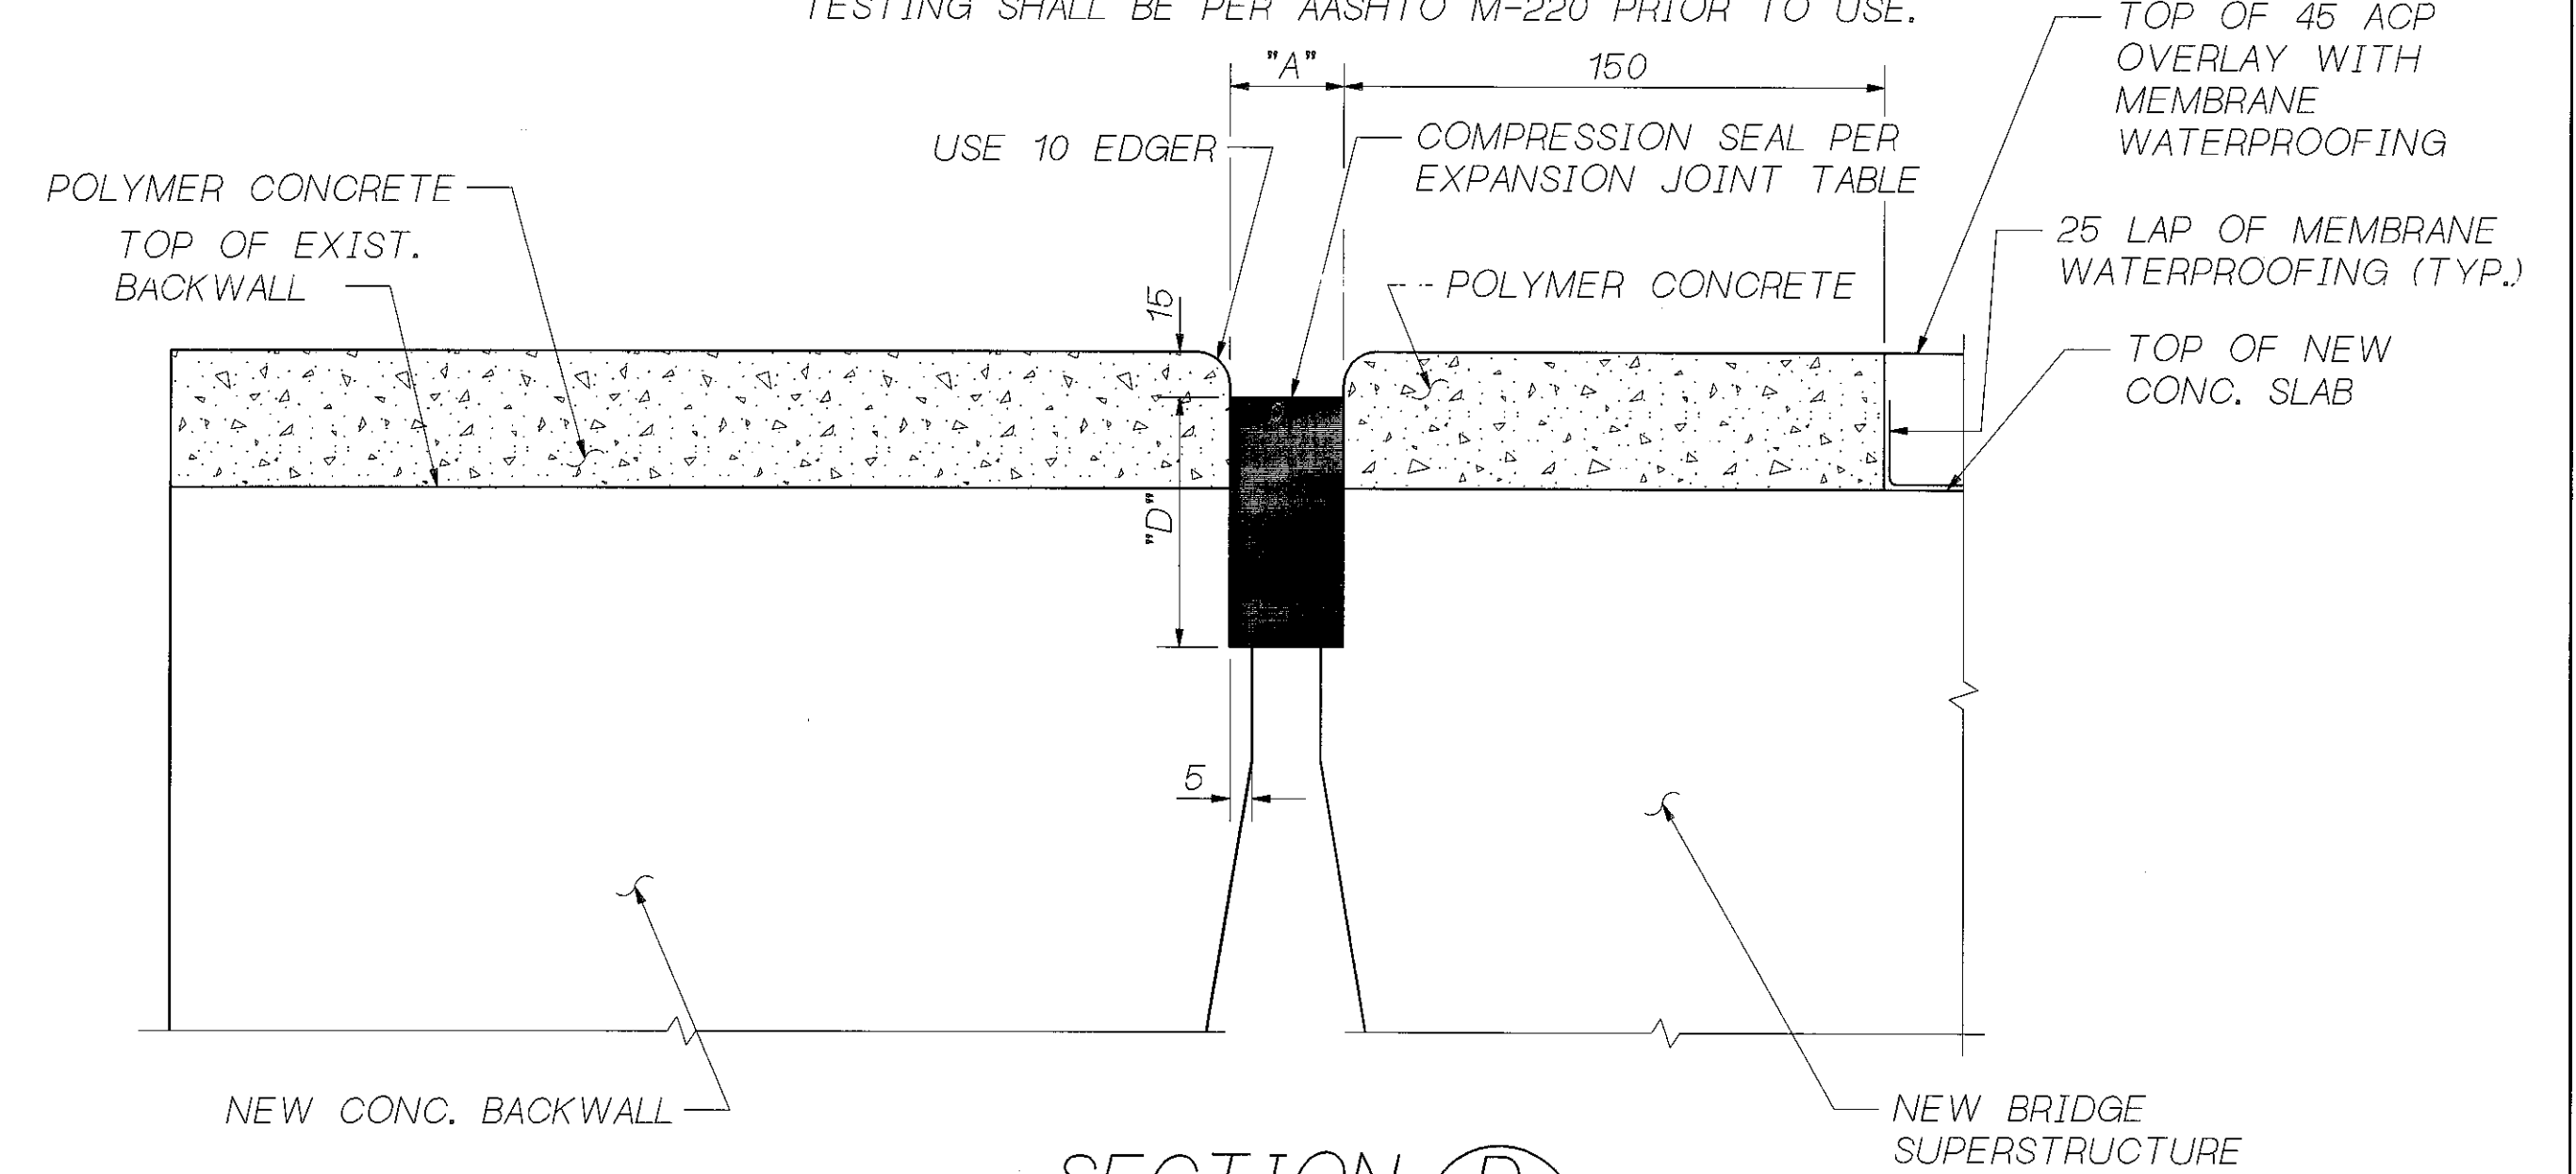


SECTION D  
(WIDENING)

FOR DETAILS NOT SHOWN SEE "SECTION C", THIS SHEET.

"D" DENOTES FULLY COMPRESSED SEAL HEIGHT

SR 405 JOB NO. 7079 SHEET 24


Bridge Design Engr.	S405D103R001-(FGB)EXP1.FGB;1	REGION NO.	STATE	FED. AID PROJ. NO.	SHEET NO.	TOTAL SHEETS
Supervisor	W. WILSON		10 WASH.			
Designed By	M. TRAGESSER					
Checked By	S. ANDERSON					
Detailed By	D.W. PULSE JR.					
Bridge Projects Engr.		JOB NUMBER	96W035			
Prelim. Plan By	10/97	REVISION	1 REVISED AS-BUILT SURVEY DATA	JZ		
Architect/Specialist	DATE	BY	APP'D	5054		

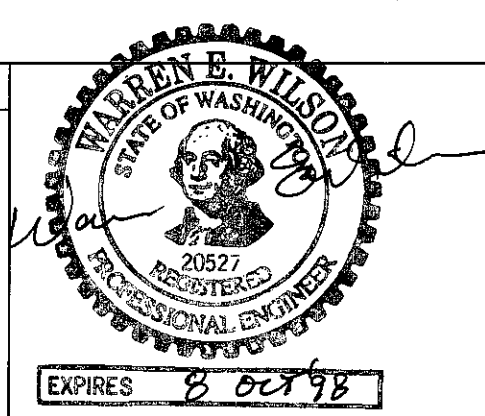

SR 405  
BOTHELL TO SWAMP CREEK I/C  
HOV LANES - STAGE 1  
228TH BRIDGE 405/103E  
EXPANSION JOINT DETAILS  
1 OF 2


BRIDGE SHEET NO.  
24  
SHEET 522 OF 663 SHEETS

16-OCT-97

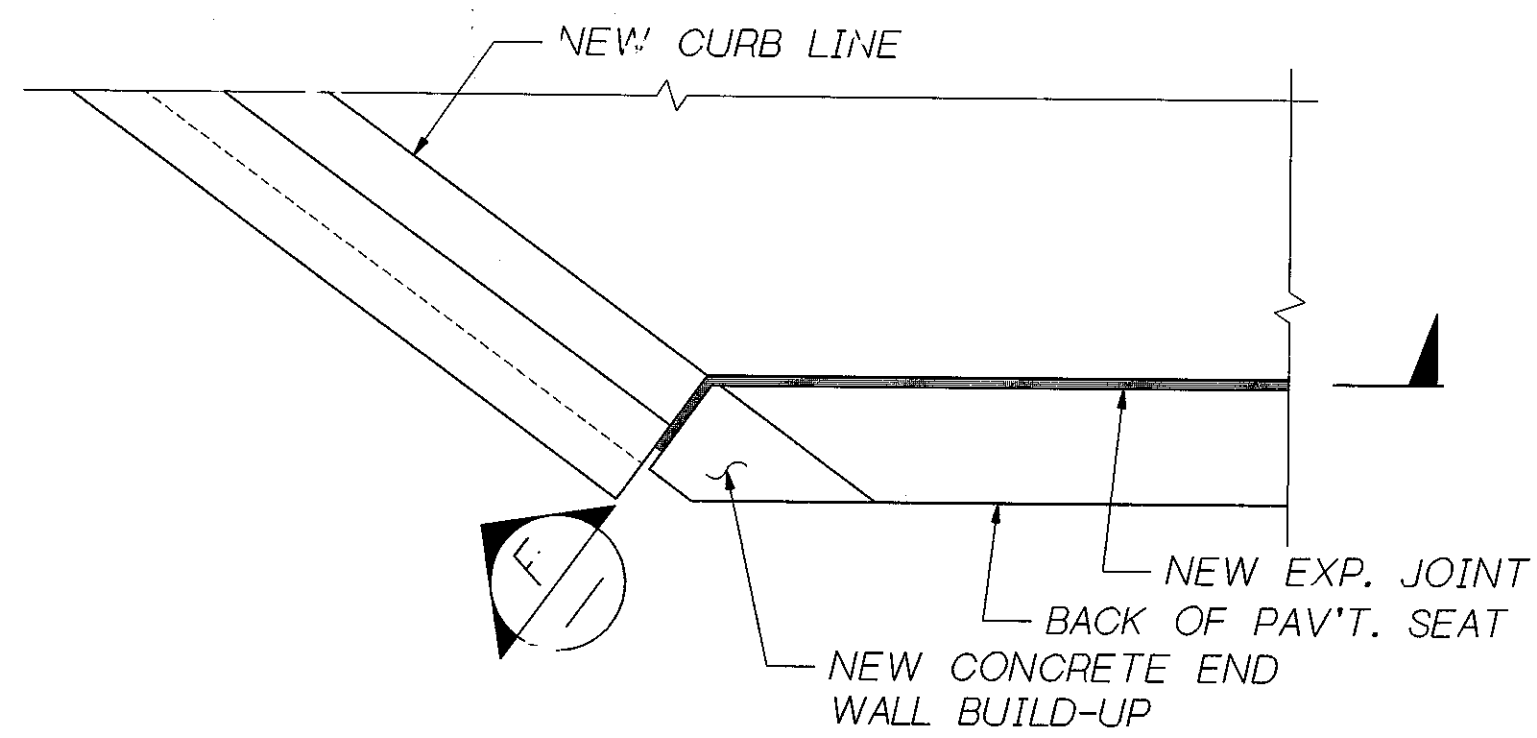


DETAIL E  
24


5 THICK SYNTHETIC CLOSED CELL EXPANDED RUBBER JOINT FILLER CEMENTED TO JOINT SEAL AT END

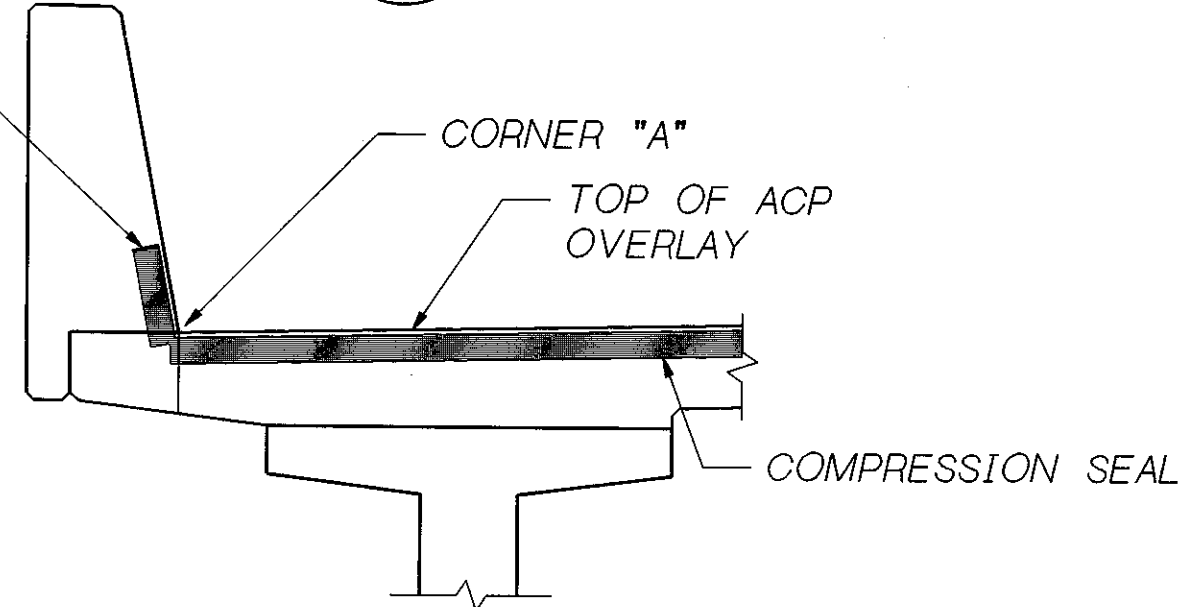


SECTION F

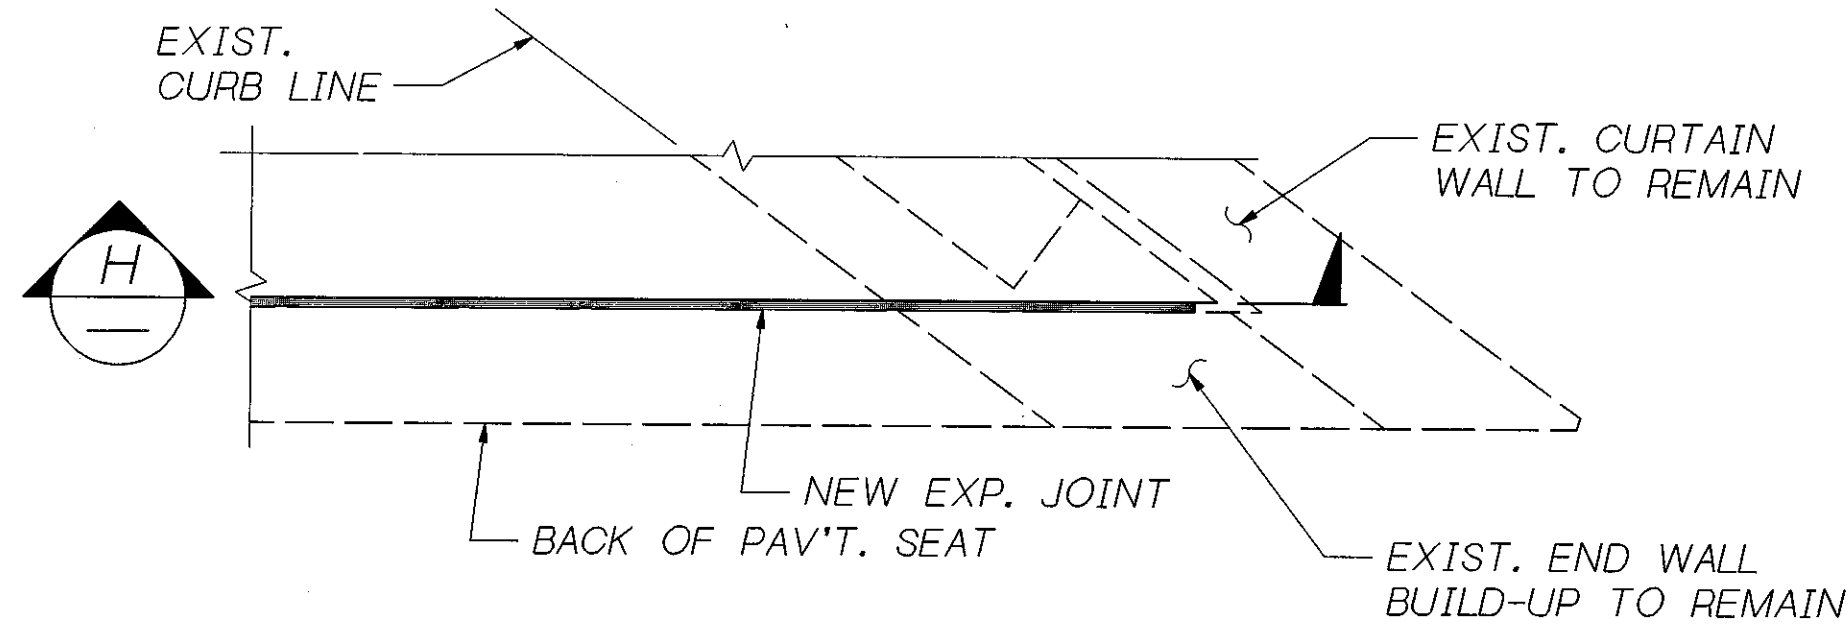


DETAIL G  
24

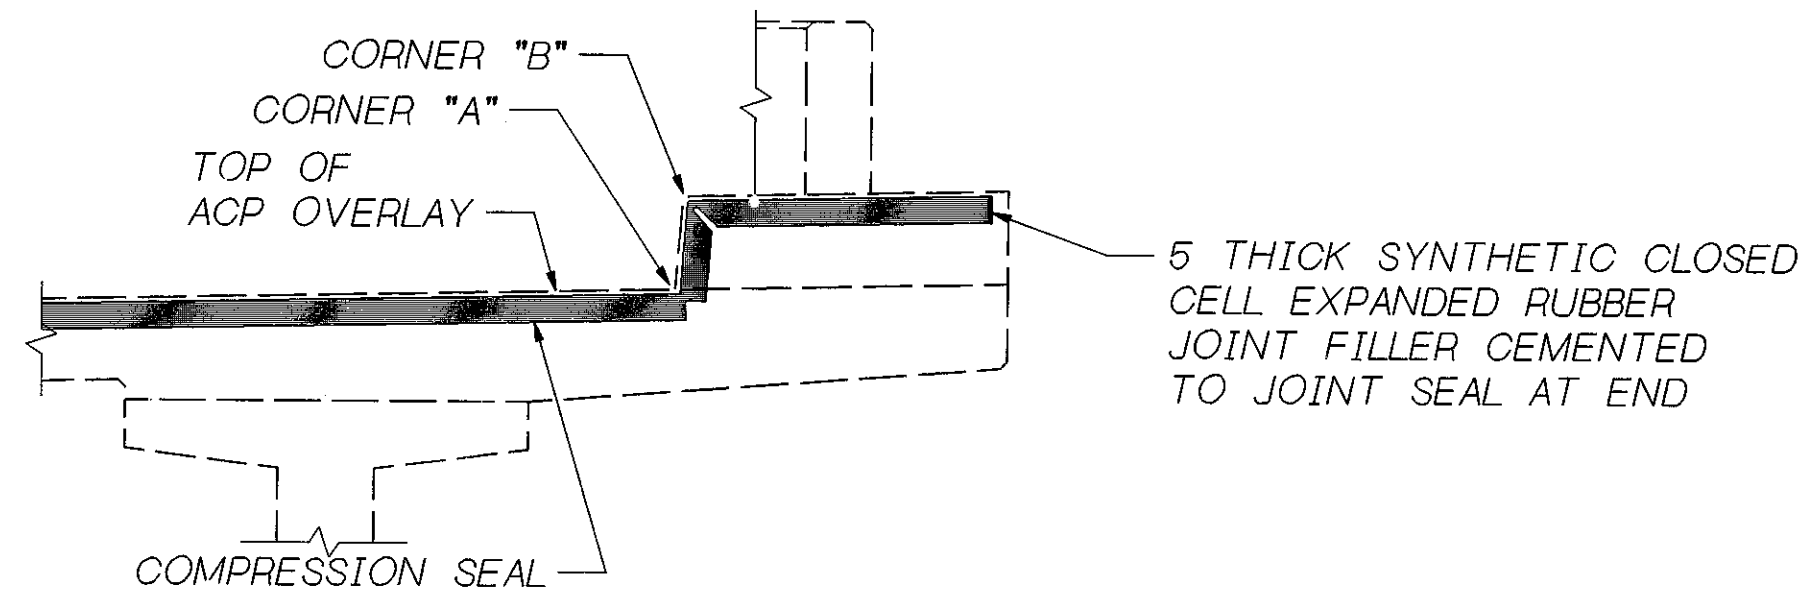


SECTION H

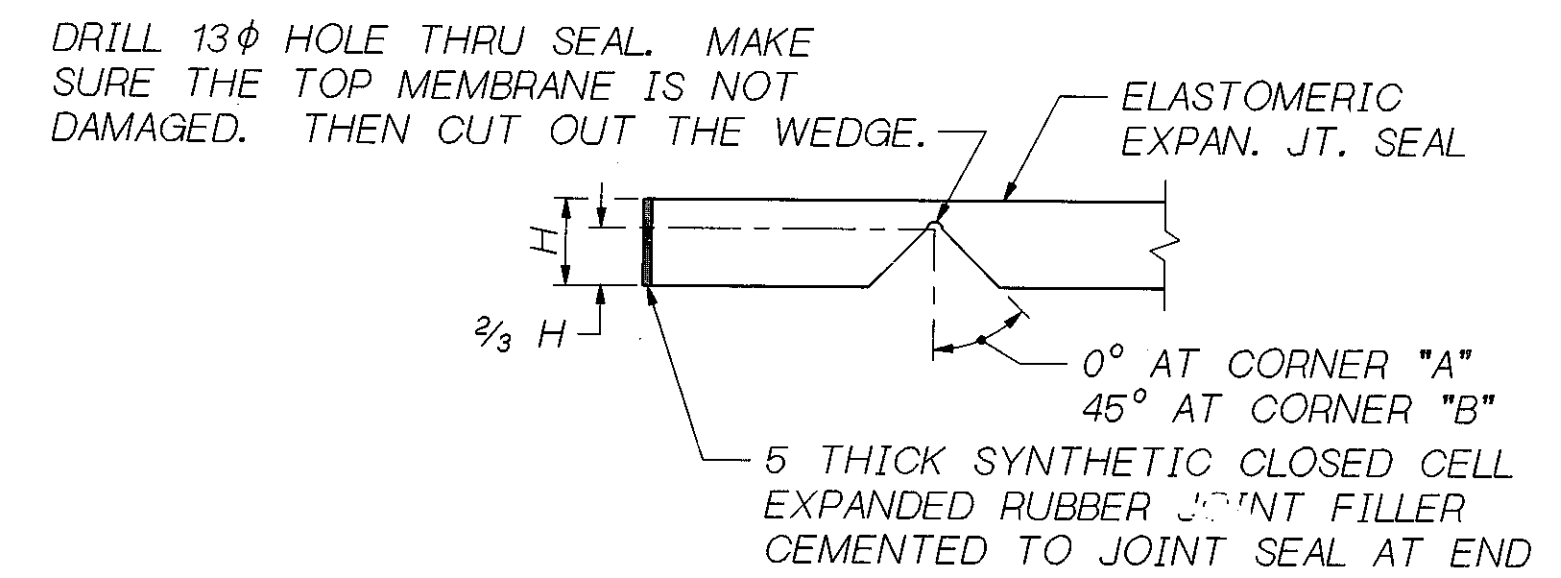


SEAL CUTTING DETAIL

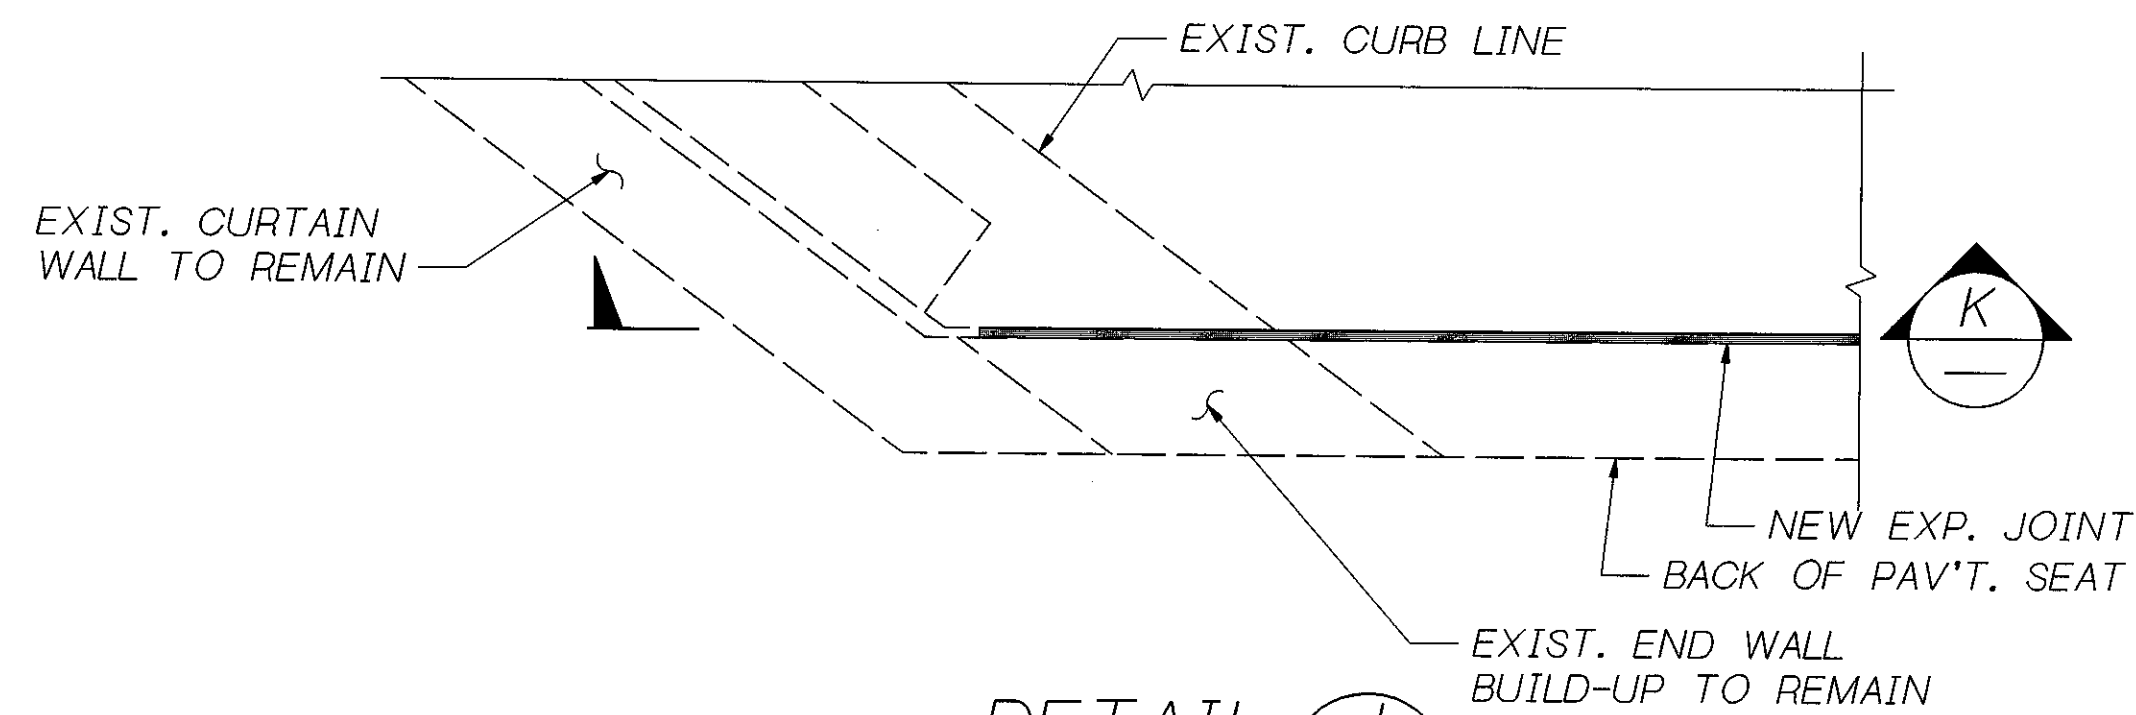


DETAIL J  
24

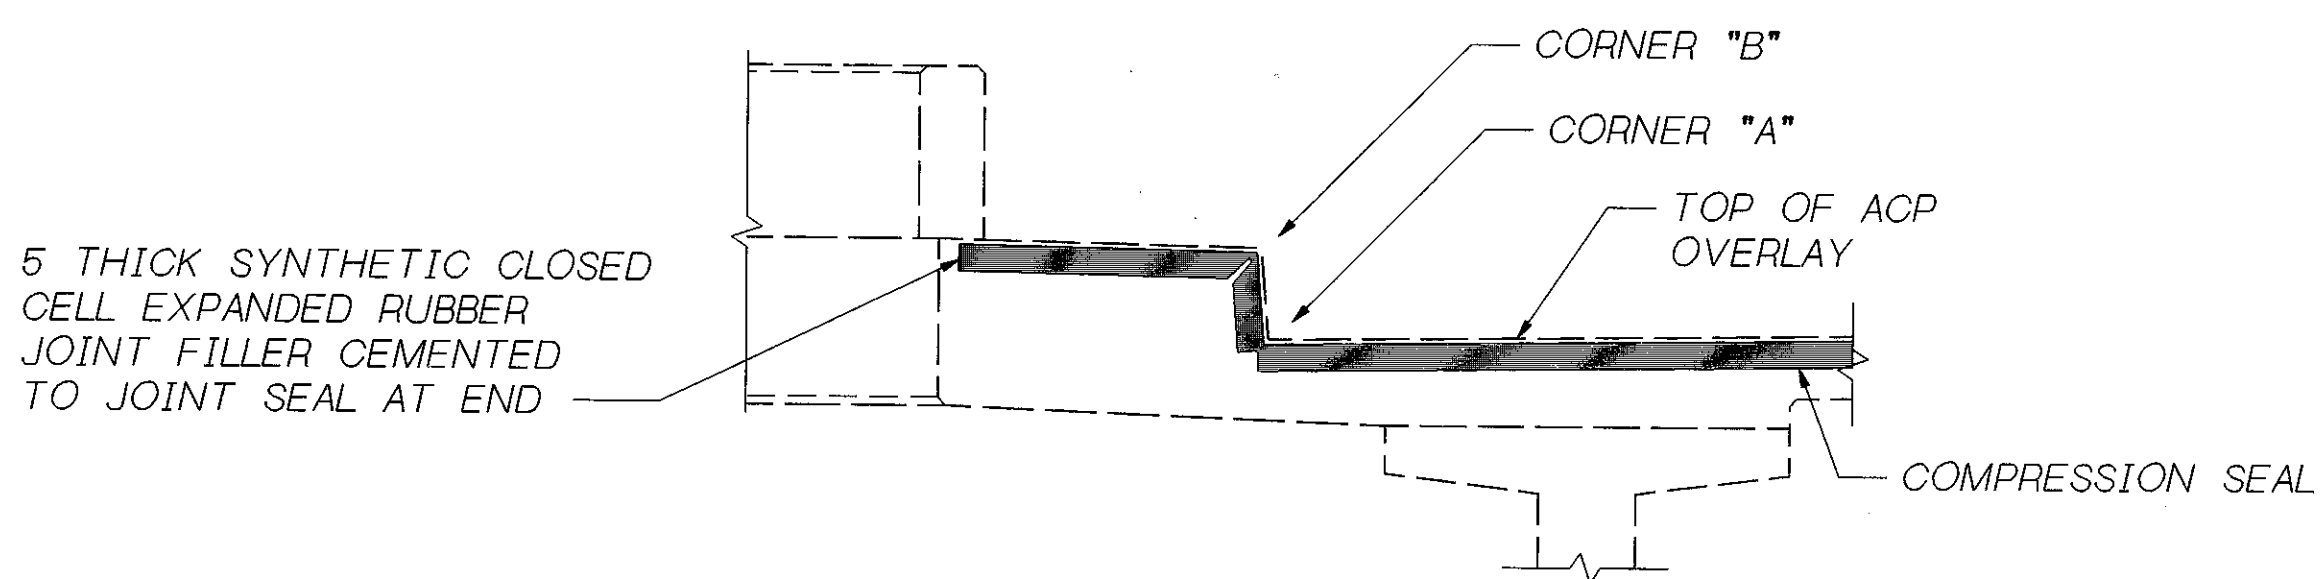

SECTION K

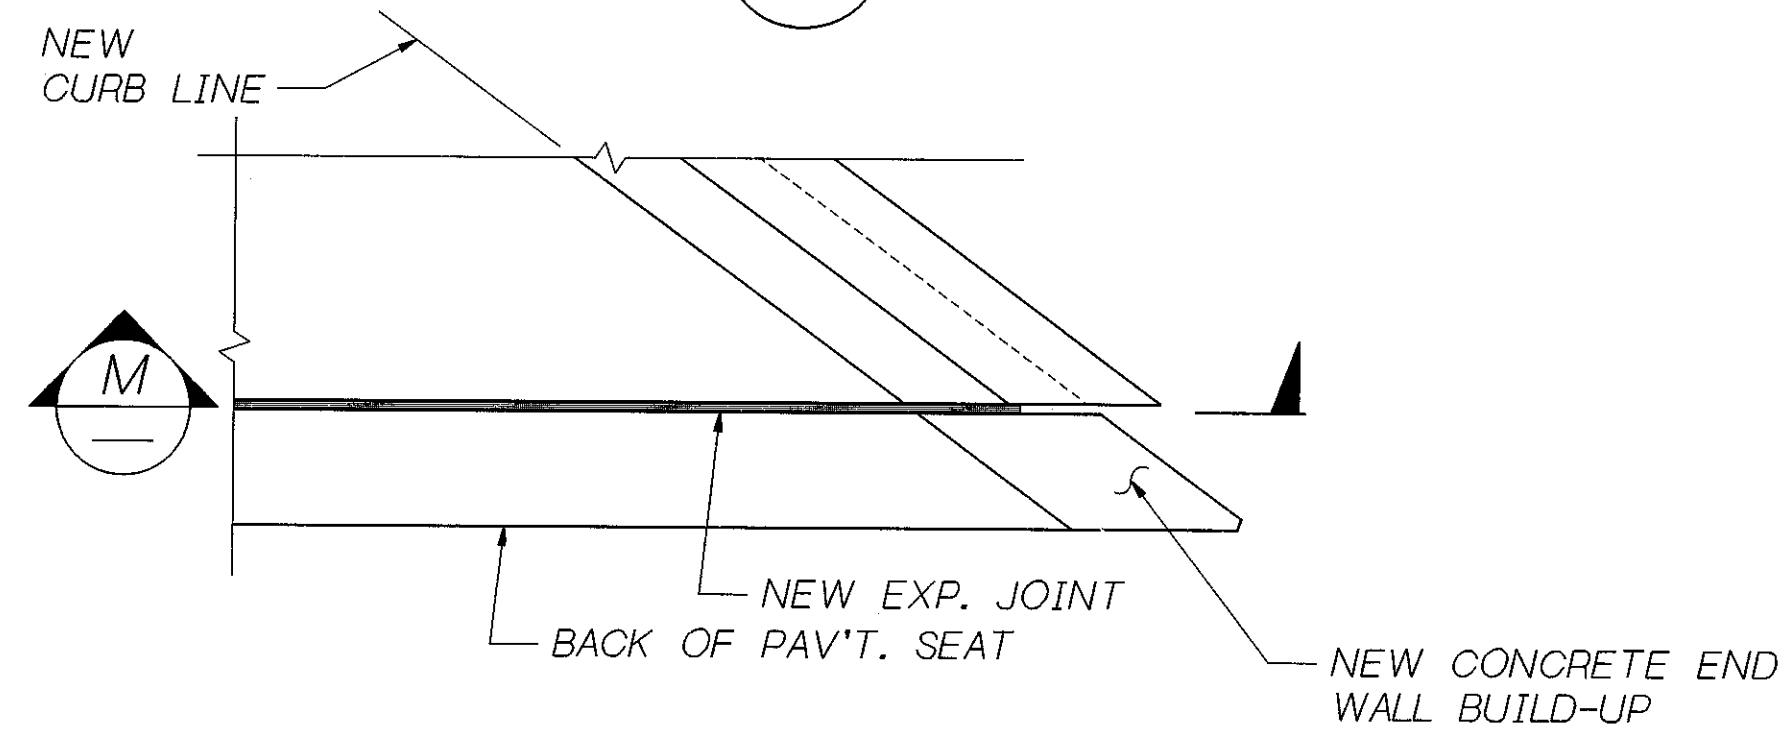


DETAIL L  
24

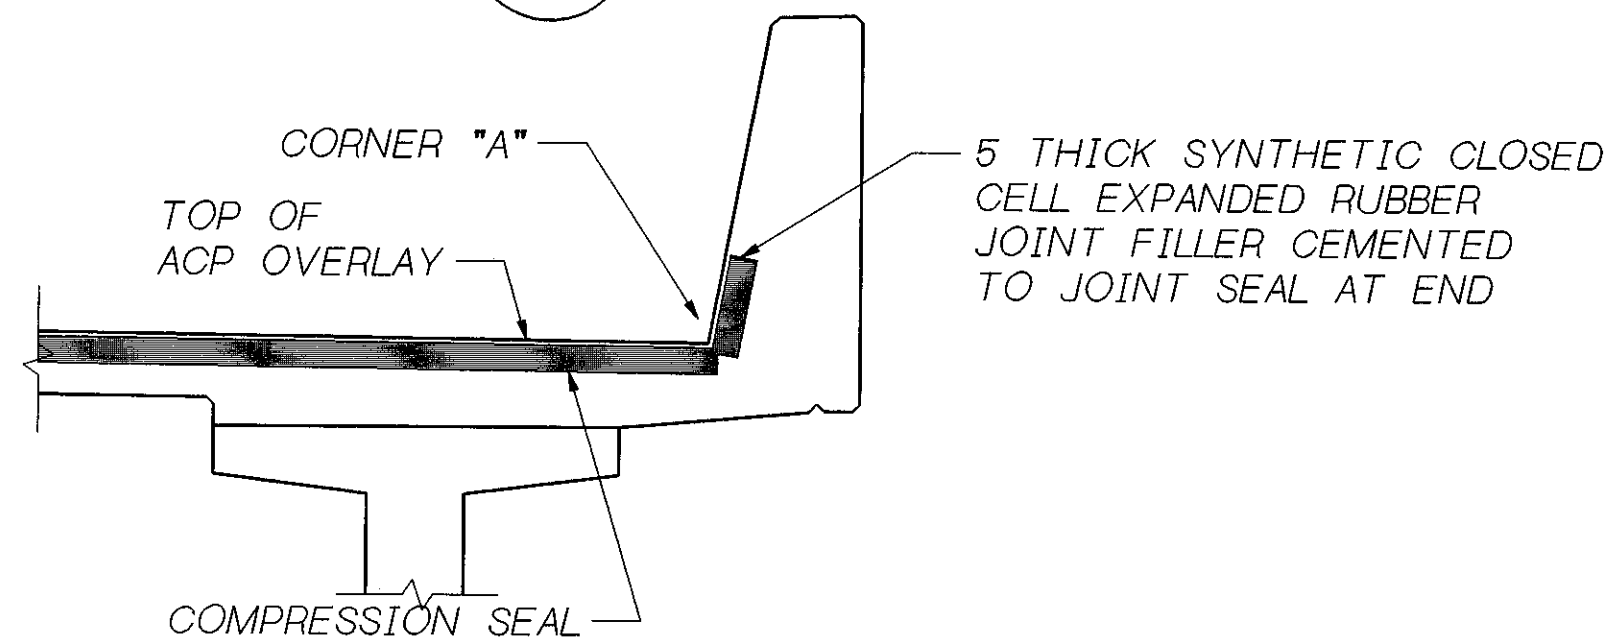

SECTION M

SR 405 JOB NO. 7079 SHEET 25

Bridge Design Engr.	S405D103R00T-C000000.FGB1EXP.FGB:1			REGION NO.	STATE	FED. AID PROJ. NO.	SHEET NO.	TOTAL SHEETS
Supervisor	W. WILSON			10	WASH.			
Designed By	M. TRAGESSER	6/96						
Checked By	S. ANDERSON	6/96						
Detailed By	D.W. PULSE JR.	6/96						
Bridge Projects Engr.				JOB NUMBER	96W035			
Prelim. Plan By				DATE	REVISION	BY	APP'D	5054
Architect/Specialist								

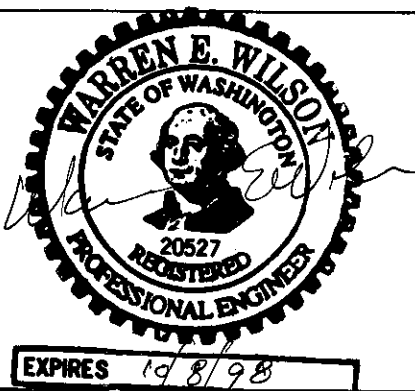


**Washington State Department of Transportation**


SR 405  
BOTHELL TO SWAMP CREEK 1/0  
HOV LANES - STAGE 1  
228TH BRIDGE 405/103E  
EXPANSION JOINT DETAILS  
SHEET 2

BRIDGE SHEET NO. 25  
SHEET 523 OF 663 SHEETS


2.11/04

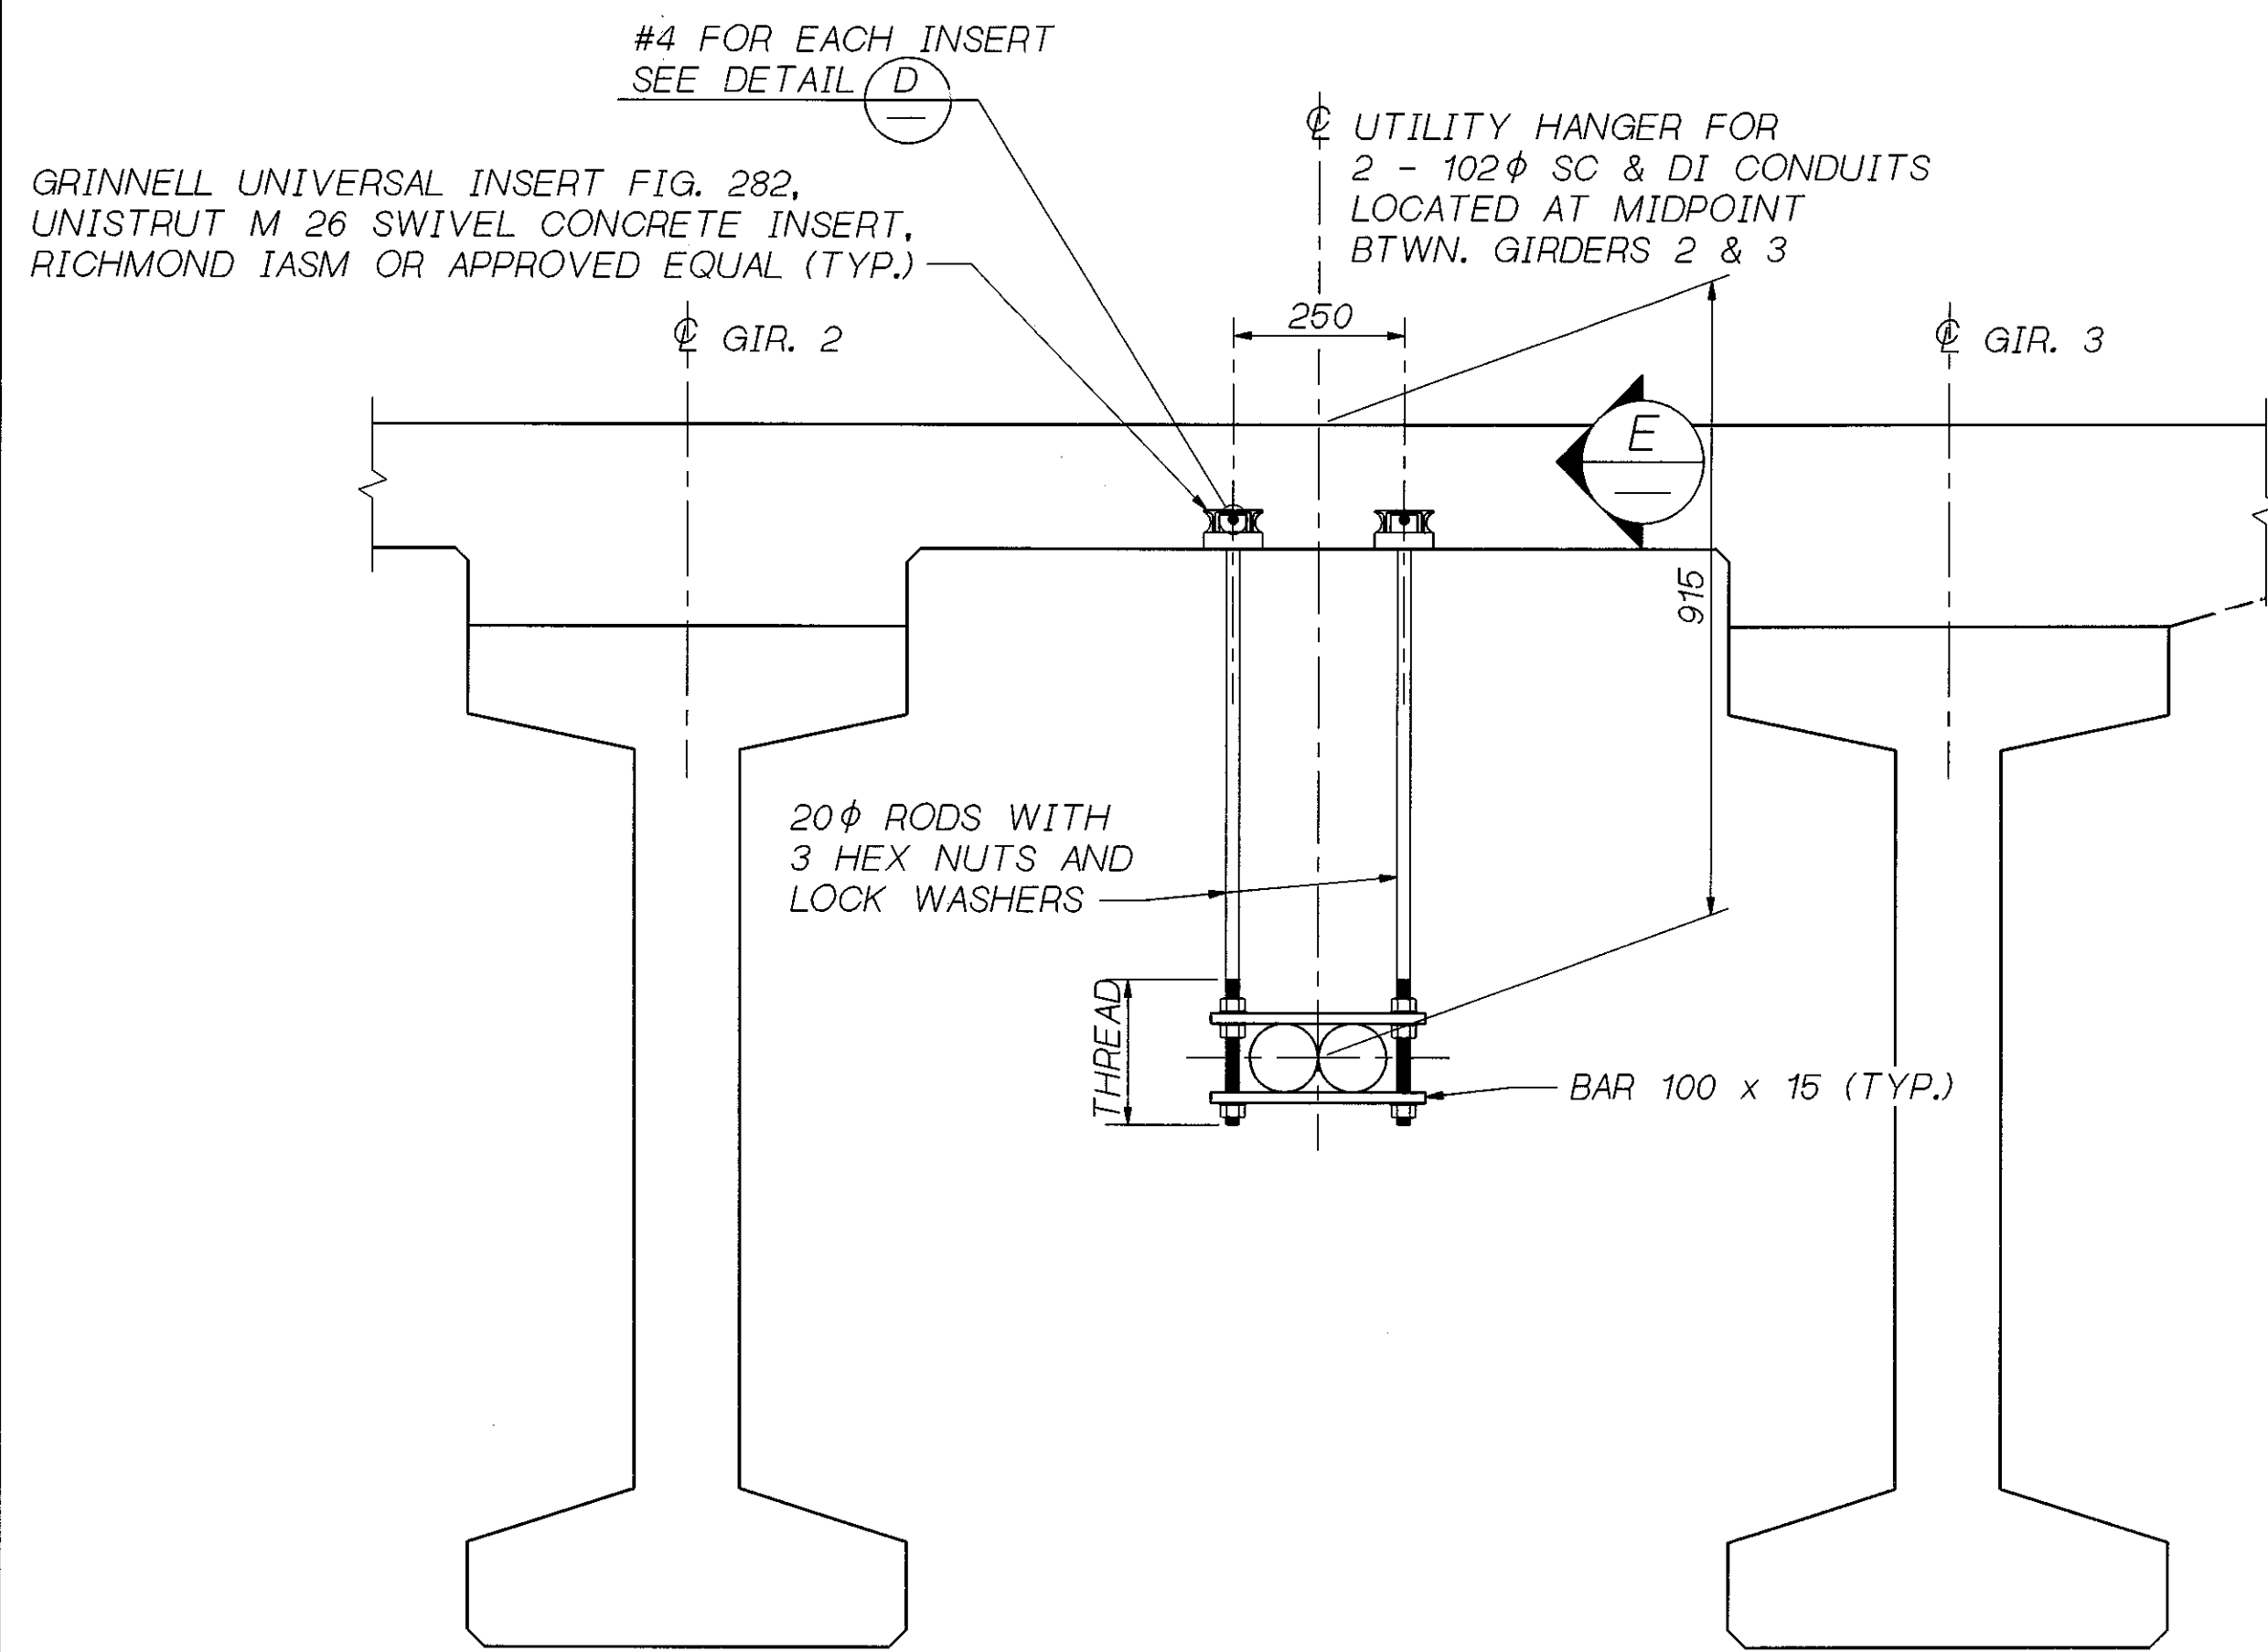


HANGER UTILITY SUPPORT  
SC & DI

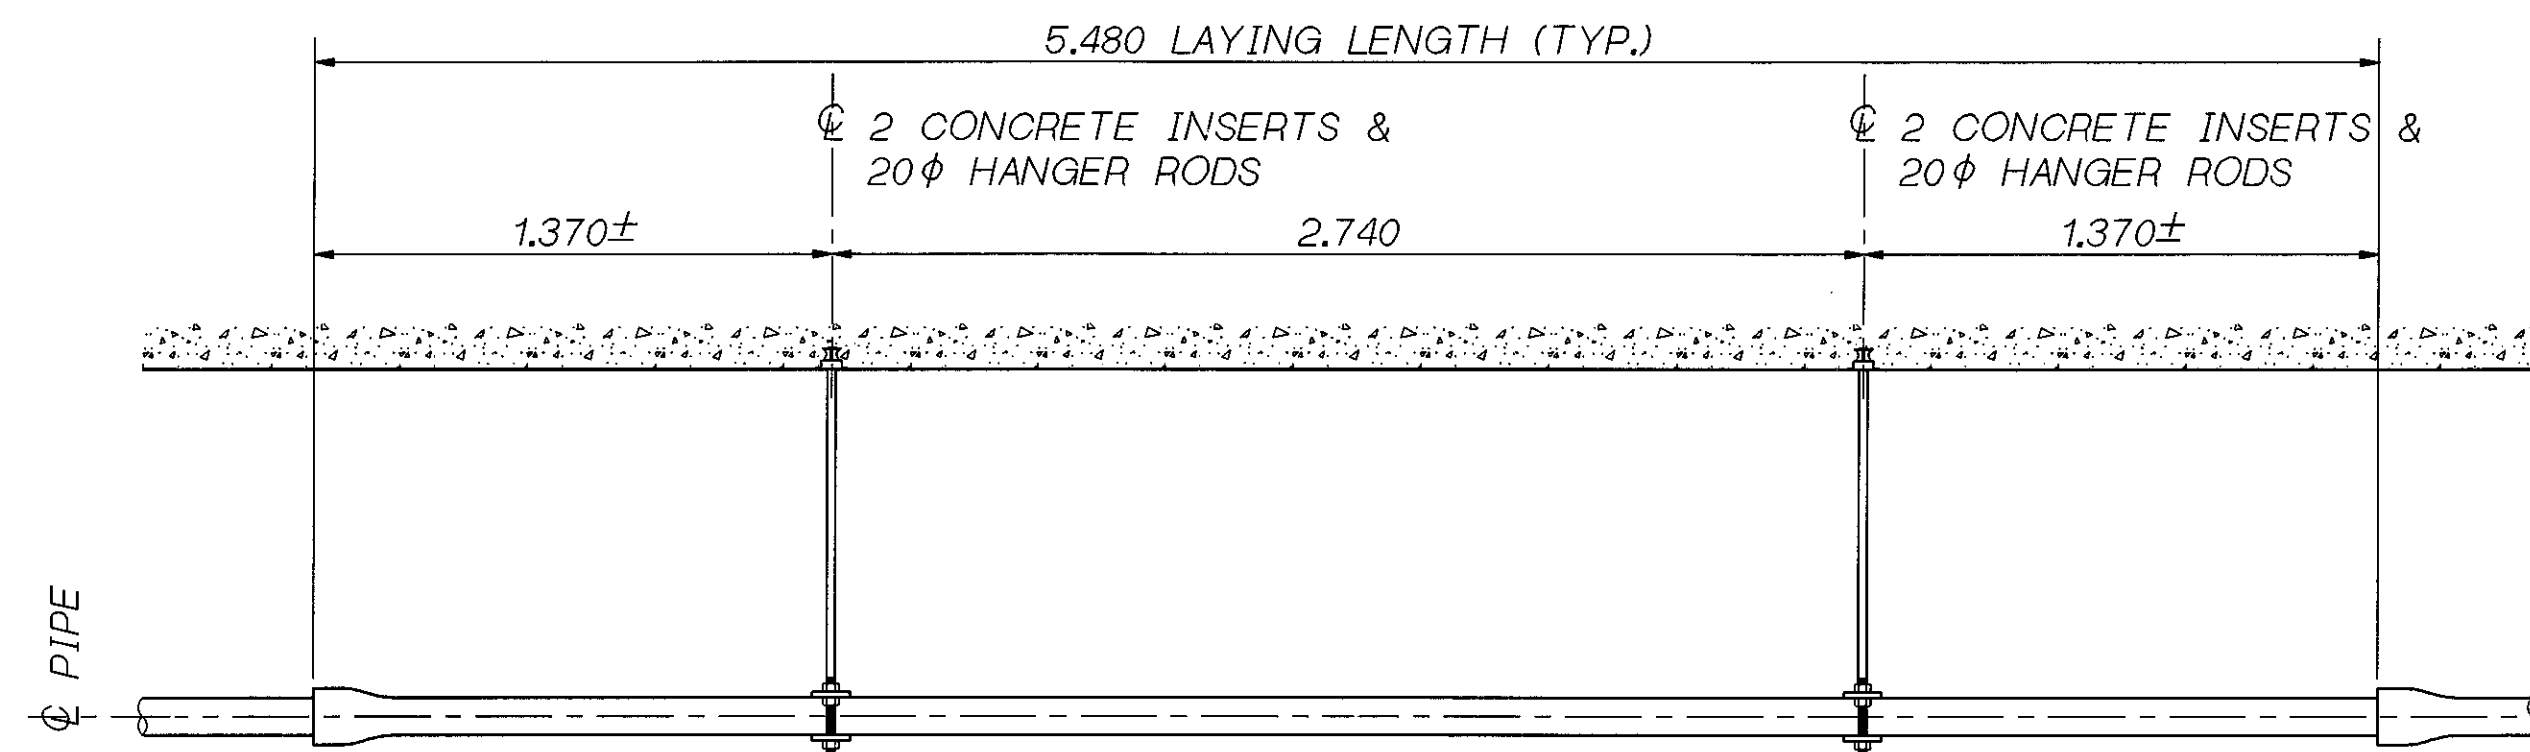

SECTION E

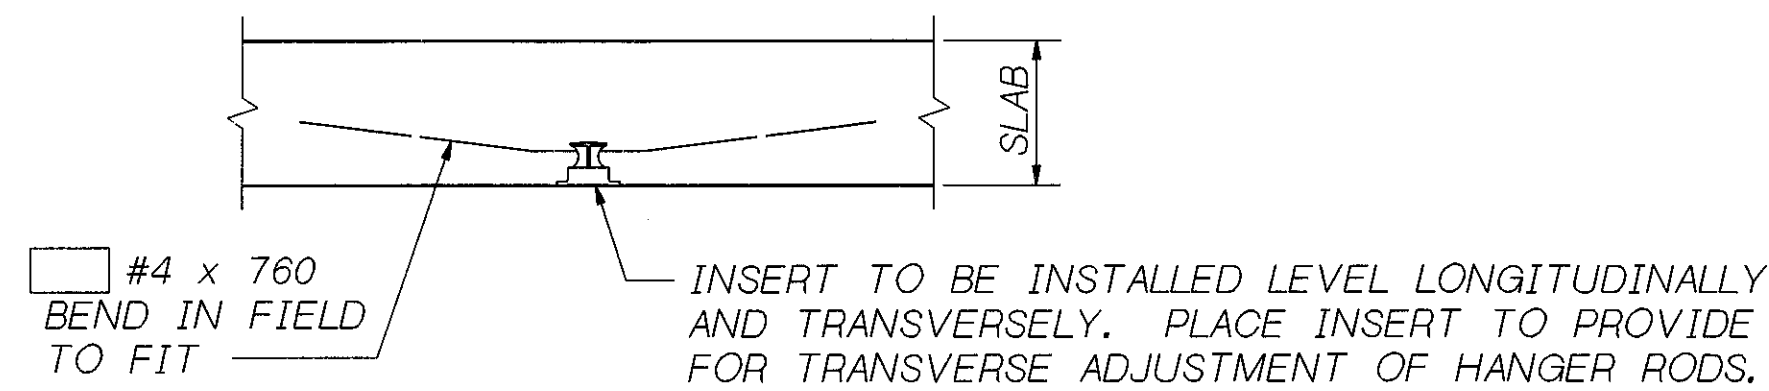


DETAIL D

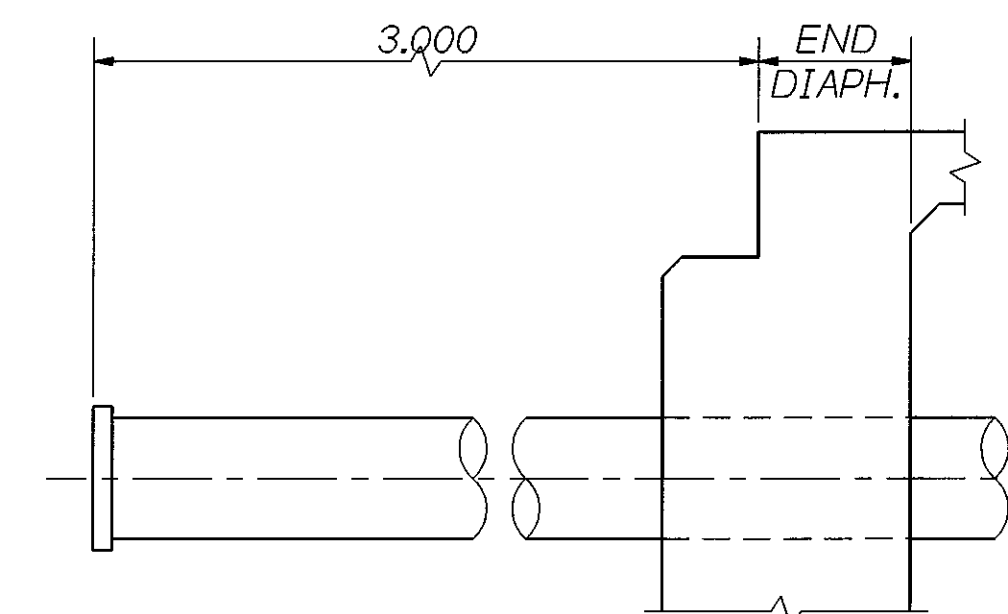

UTILITY CONDUIT  
PLACEMENT DETAIL

SR 405 JOB NO. 7079 SHEET 26

Bridge Design Engr.	S405D103ROOT:1.000000.FGB1UTILITY.FGB:1			REGION NO.	STATE	FED. AID PROJ. NO.	SHEET NO.	TOTAL SHEETS
Supervisor	W. WILSON			10	WASH.			
Designed By	M. TRAGESSER							
Checked By	S. ANDERSON							
Detailed By	D.W. PULSE JR.							
Bridge Projects Engr.				JOB NUMBER	96W035			
Prelim. Plan By				DATE	REVISION	BY	APP'D	5054
Architect/Specialist								

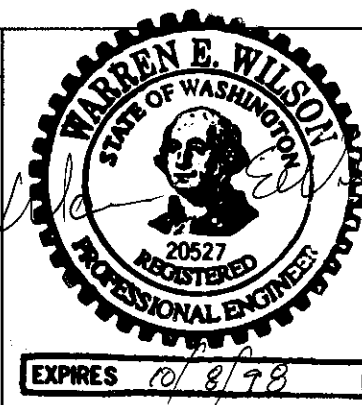


SR 405  
BOTHELL TO SWAMP CREEK I/C  
HOV LANES - STAGE 1  
228TH BRIDGE 405/103E

HANGER UTILITY DETAILS

BRIDGE SHEET NO. 26  
SHEET 524 OF 663 SHEETS


241/103

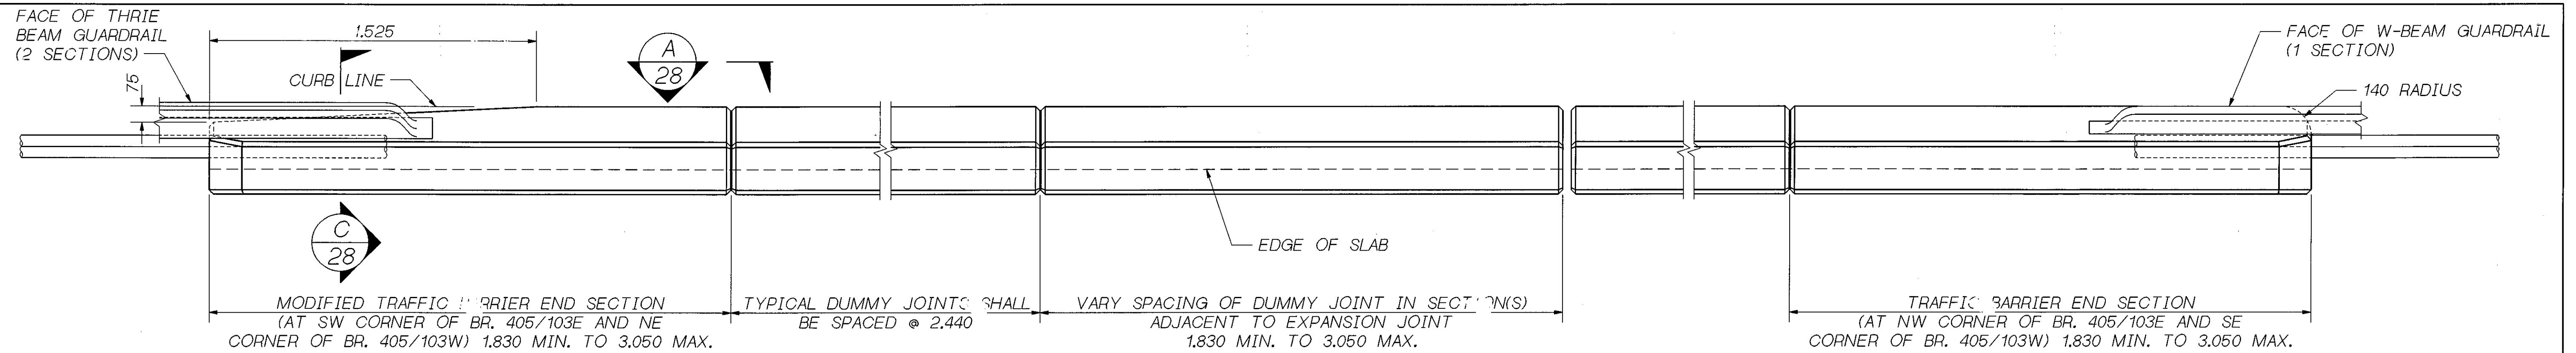



PLAN TRAFFIC BARRIER

TYPE 1 GUARDRAIL TRANSITION WITH D CONNECTION, FAR SIDE (SEE STD. PLANS C-3 & C-5) (WHERE SHOWN ON LAYOUT) PROVIDE 5 - 22φ GALV. RICHMOND ROCKET, BURKE HI-TENSILE, LANCASTER MALLEABLE INSERTS OR APPROVED EQUAL


BARRIER CONTINUOUS BETWEEN ROADWAY EXPANSION JOINTS. CONSTRUCTION JOINTS WITH SHEAR KEYS ARE PERMISSIBLE AT DUMMY JOINT LOCATIONS. FORM JOINTS BETWEEN DUMMY JOINTS SHALL NOT BE PERMITTED.

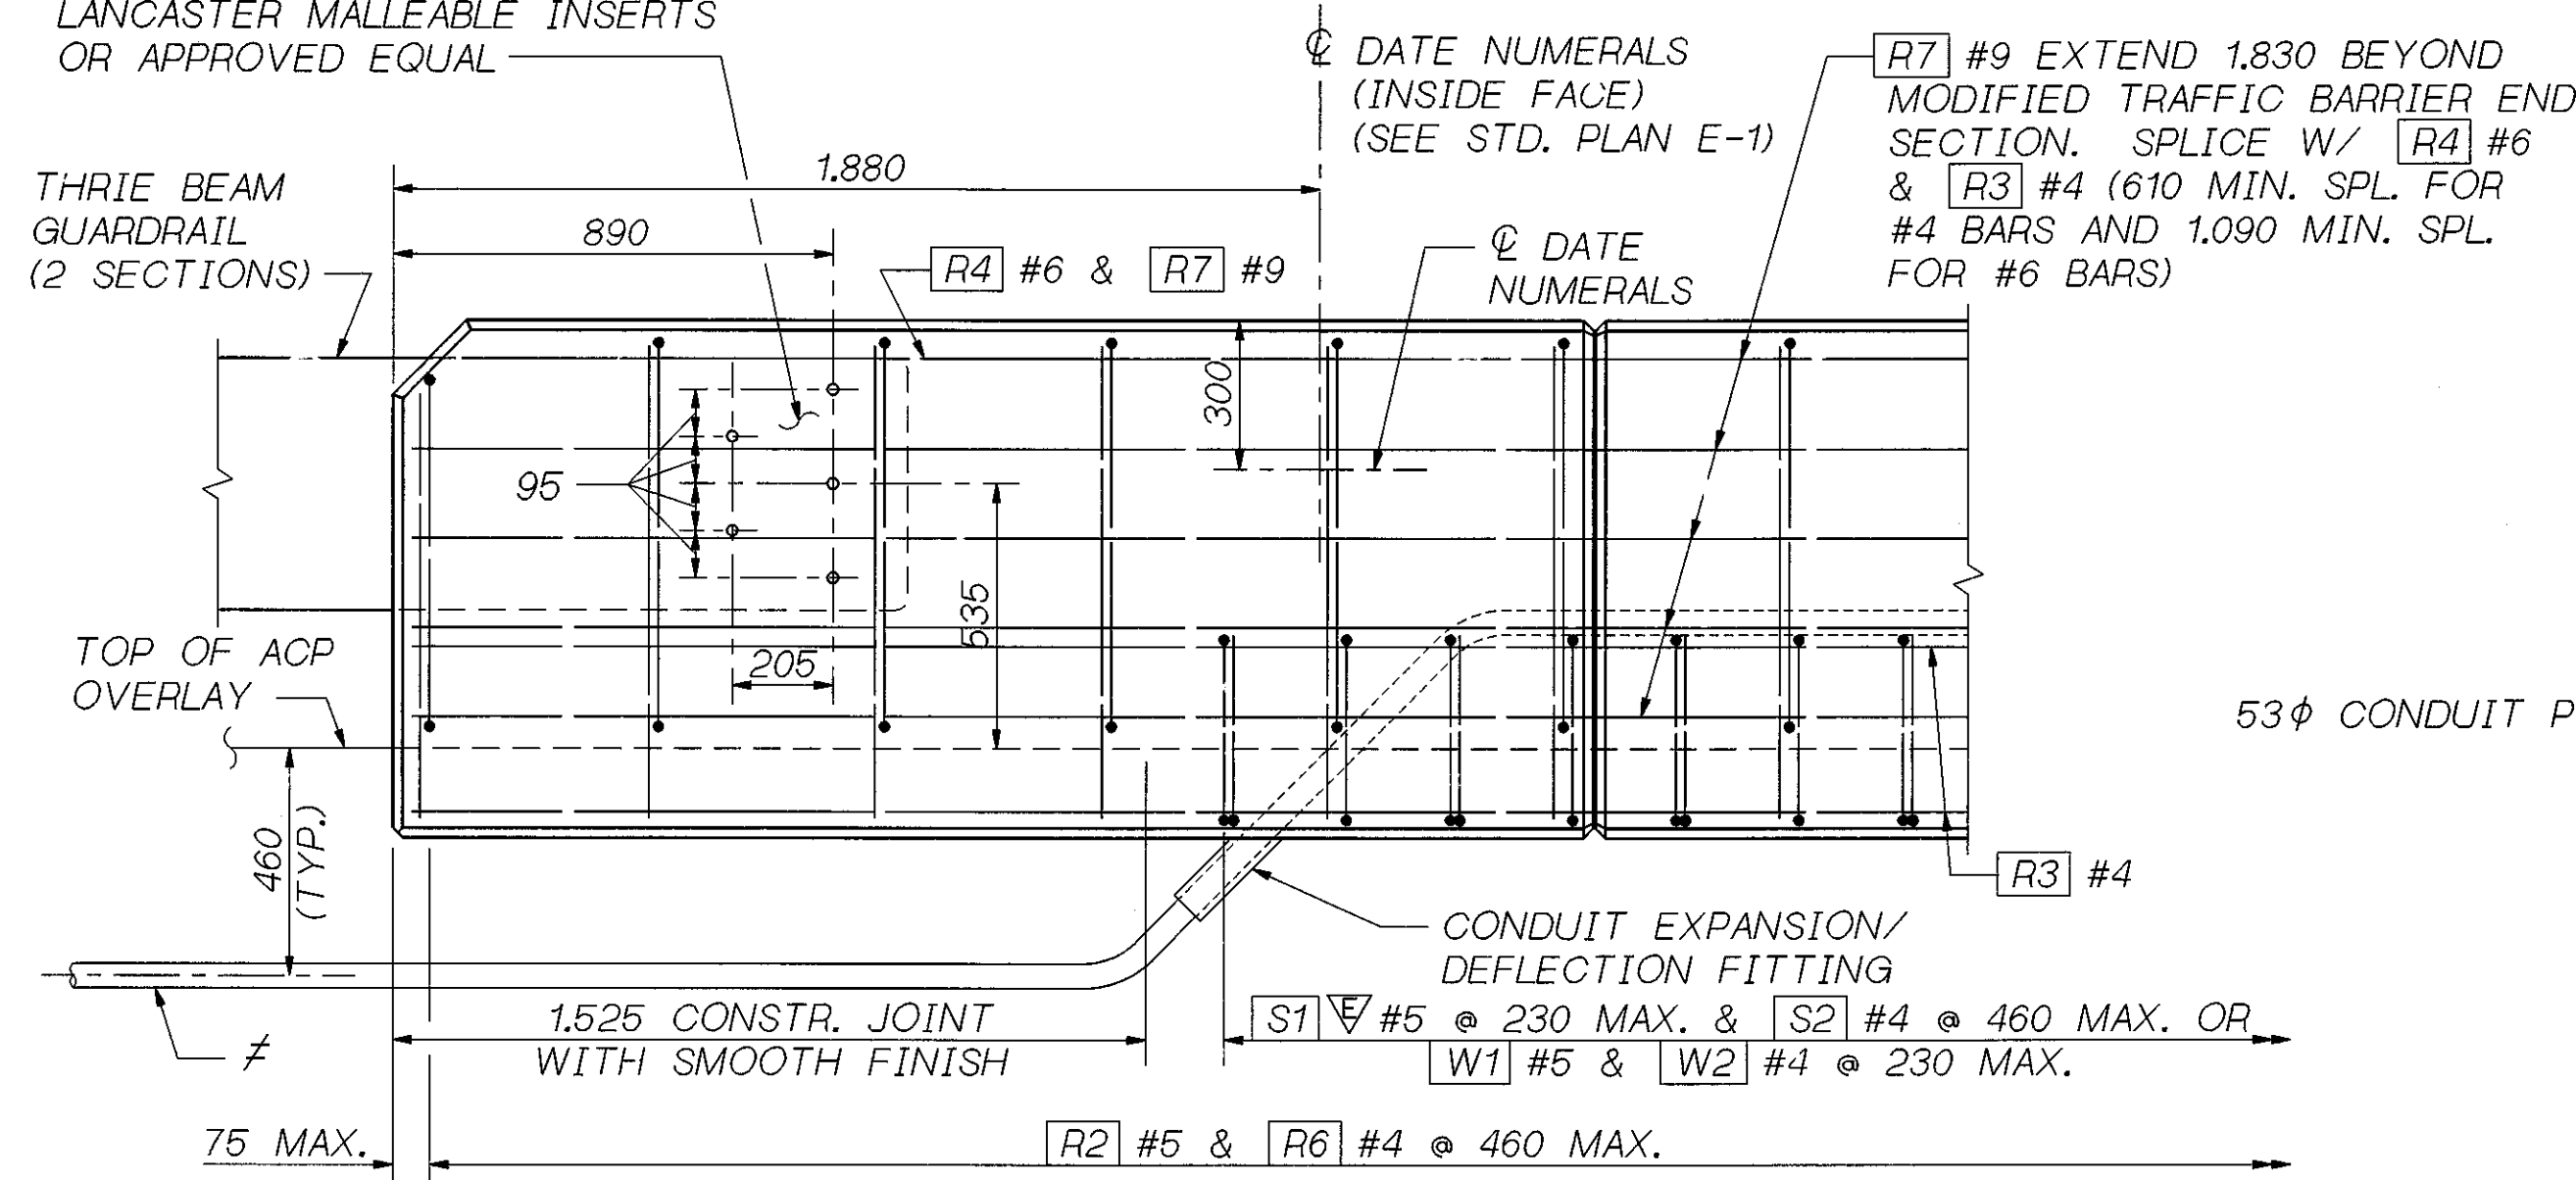

OUTSIDE ELEVATION END OF MODIFIED TRAFFIC BARRIER FOR D CONNECTION GUARDRAIL ANCHORAGE

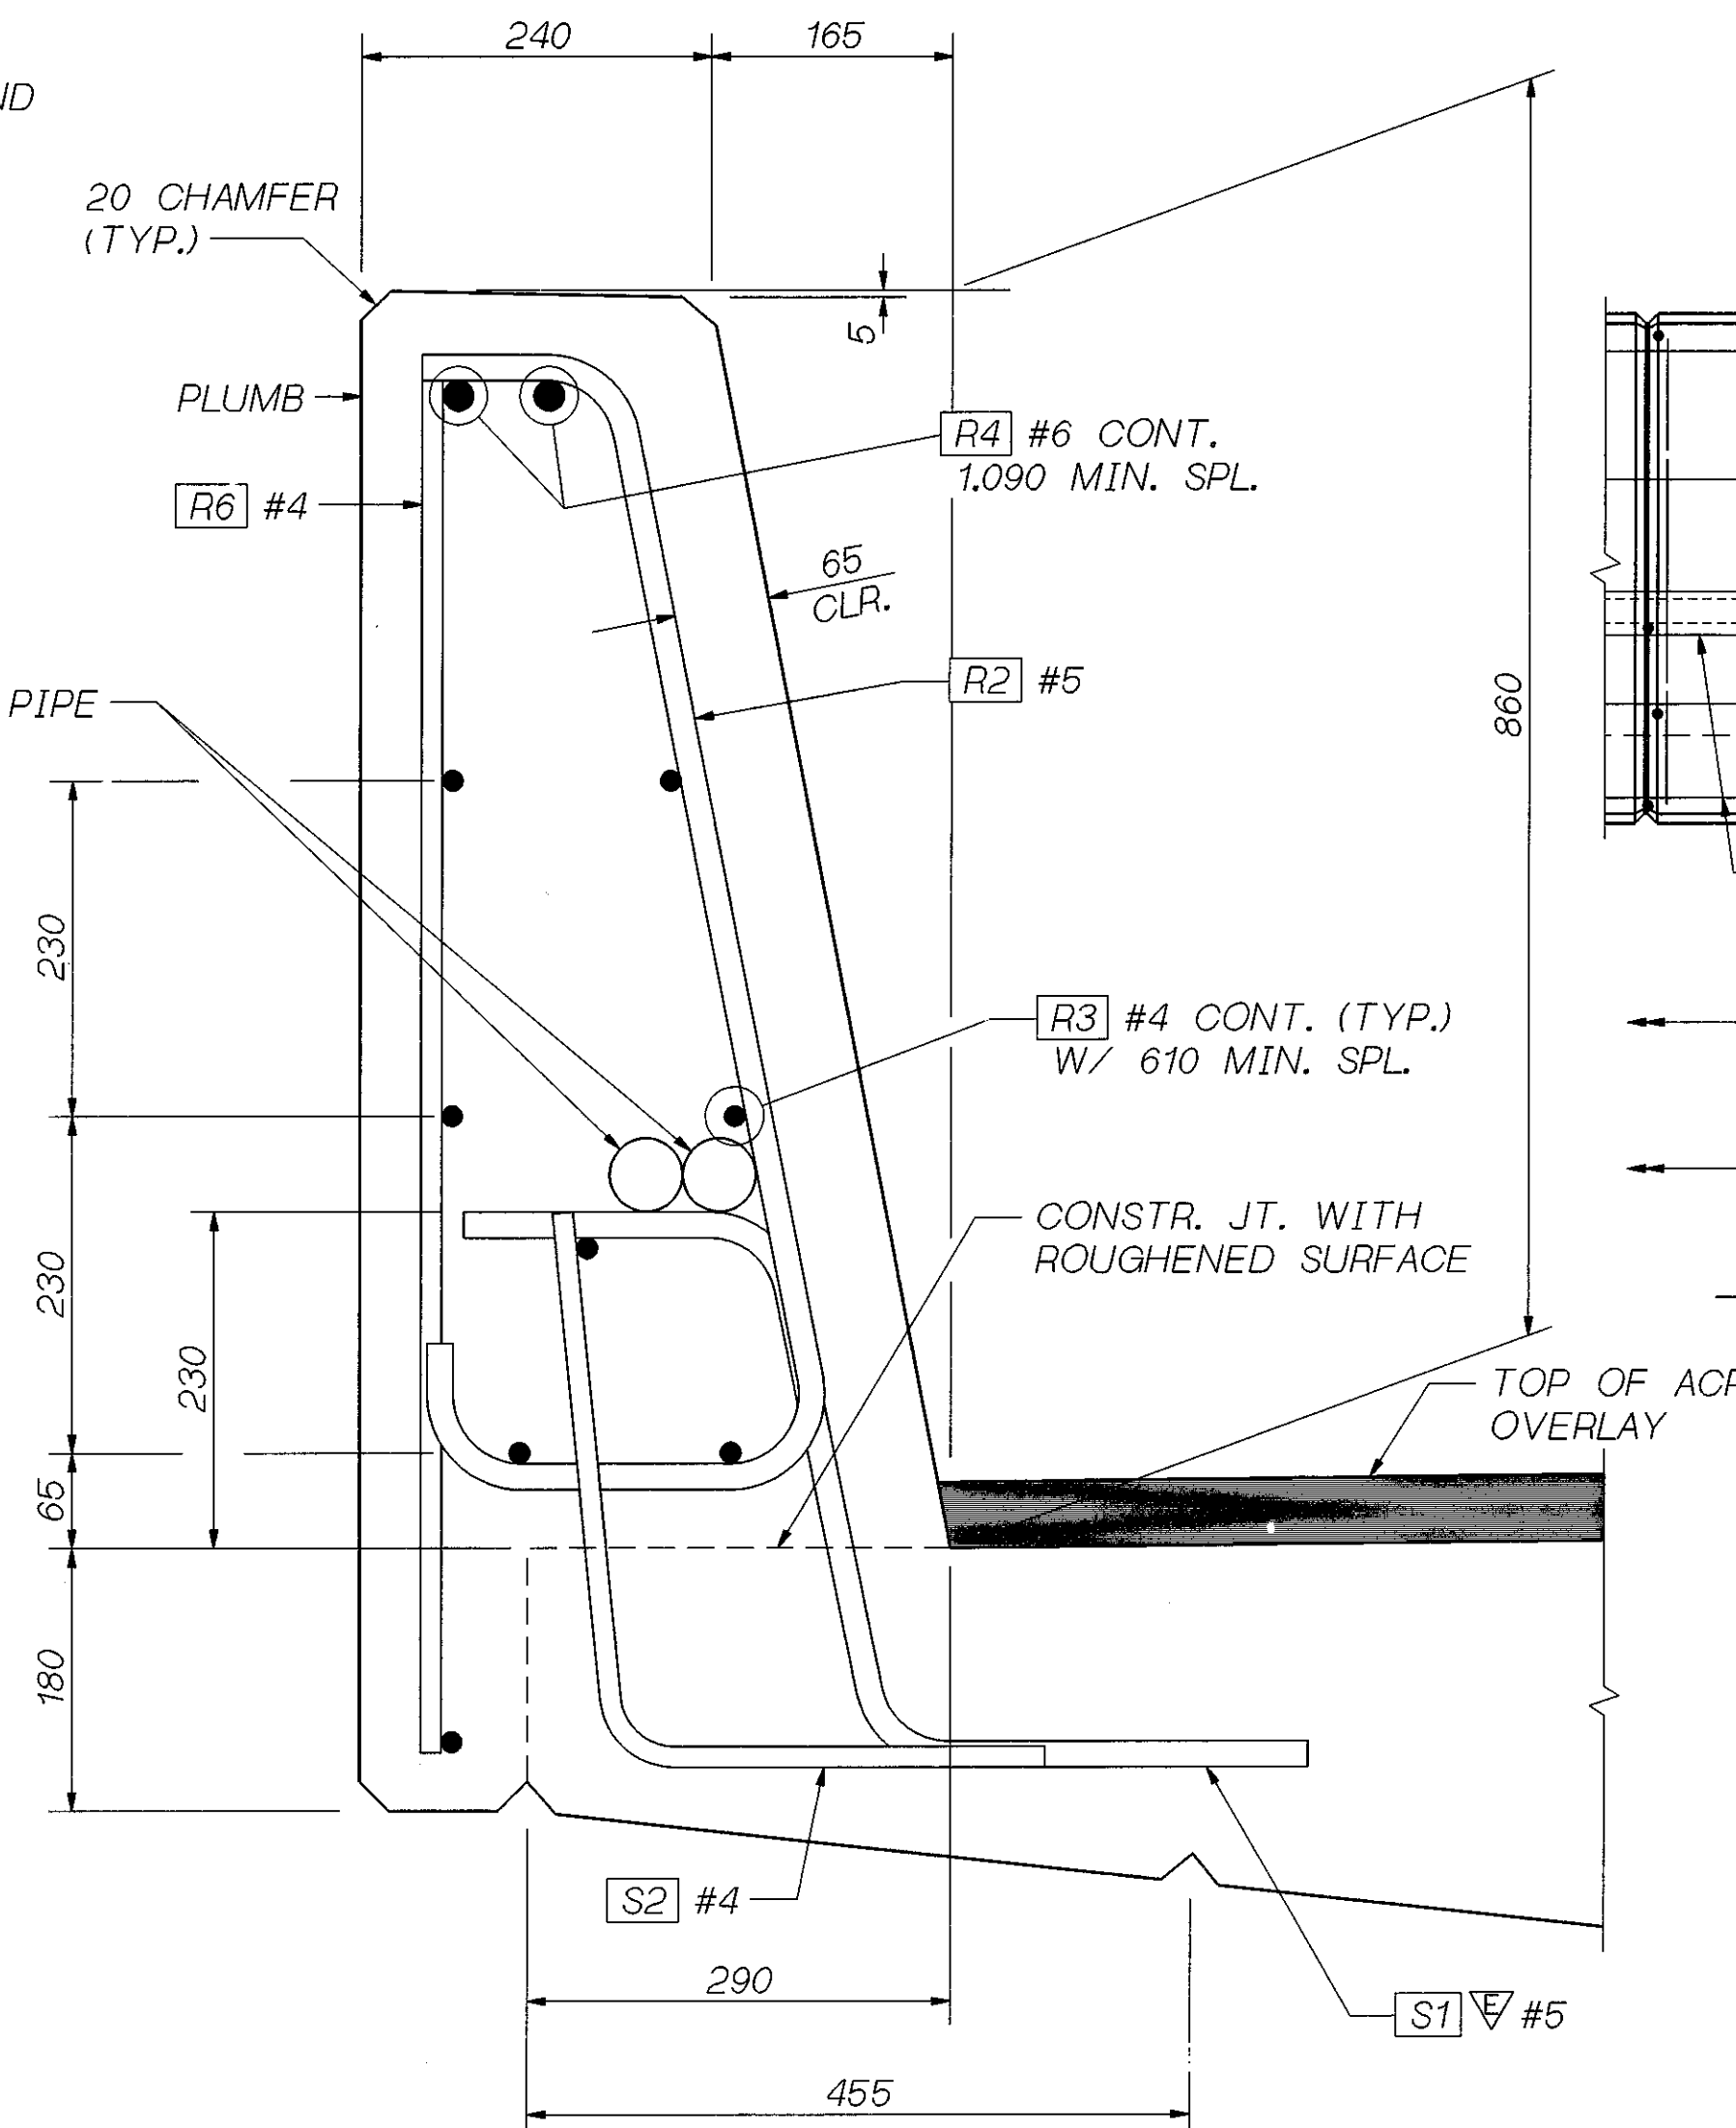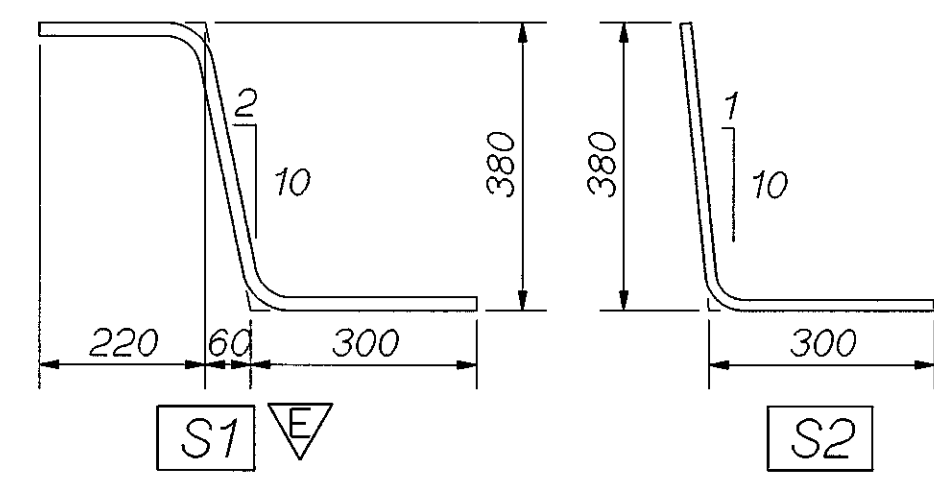

TYPICAL SECTION - TRAFFIC BARRIER

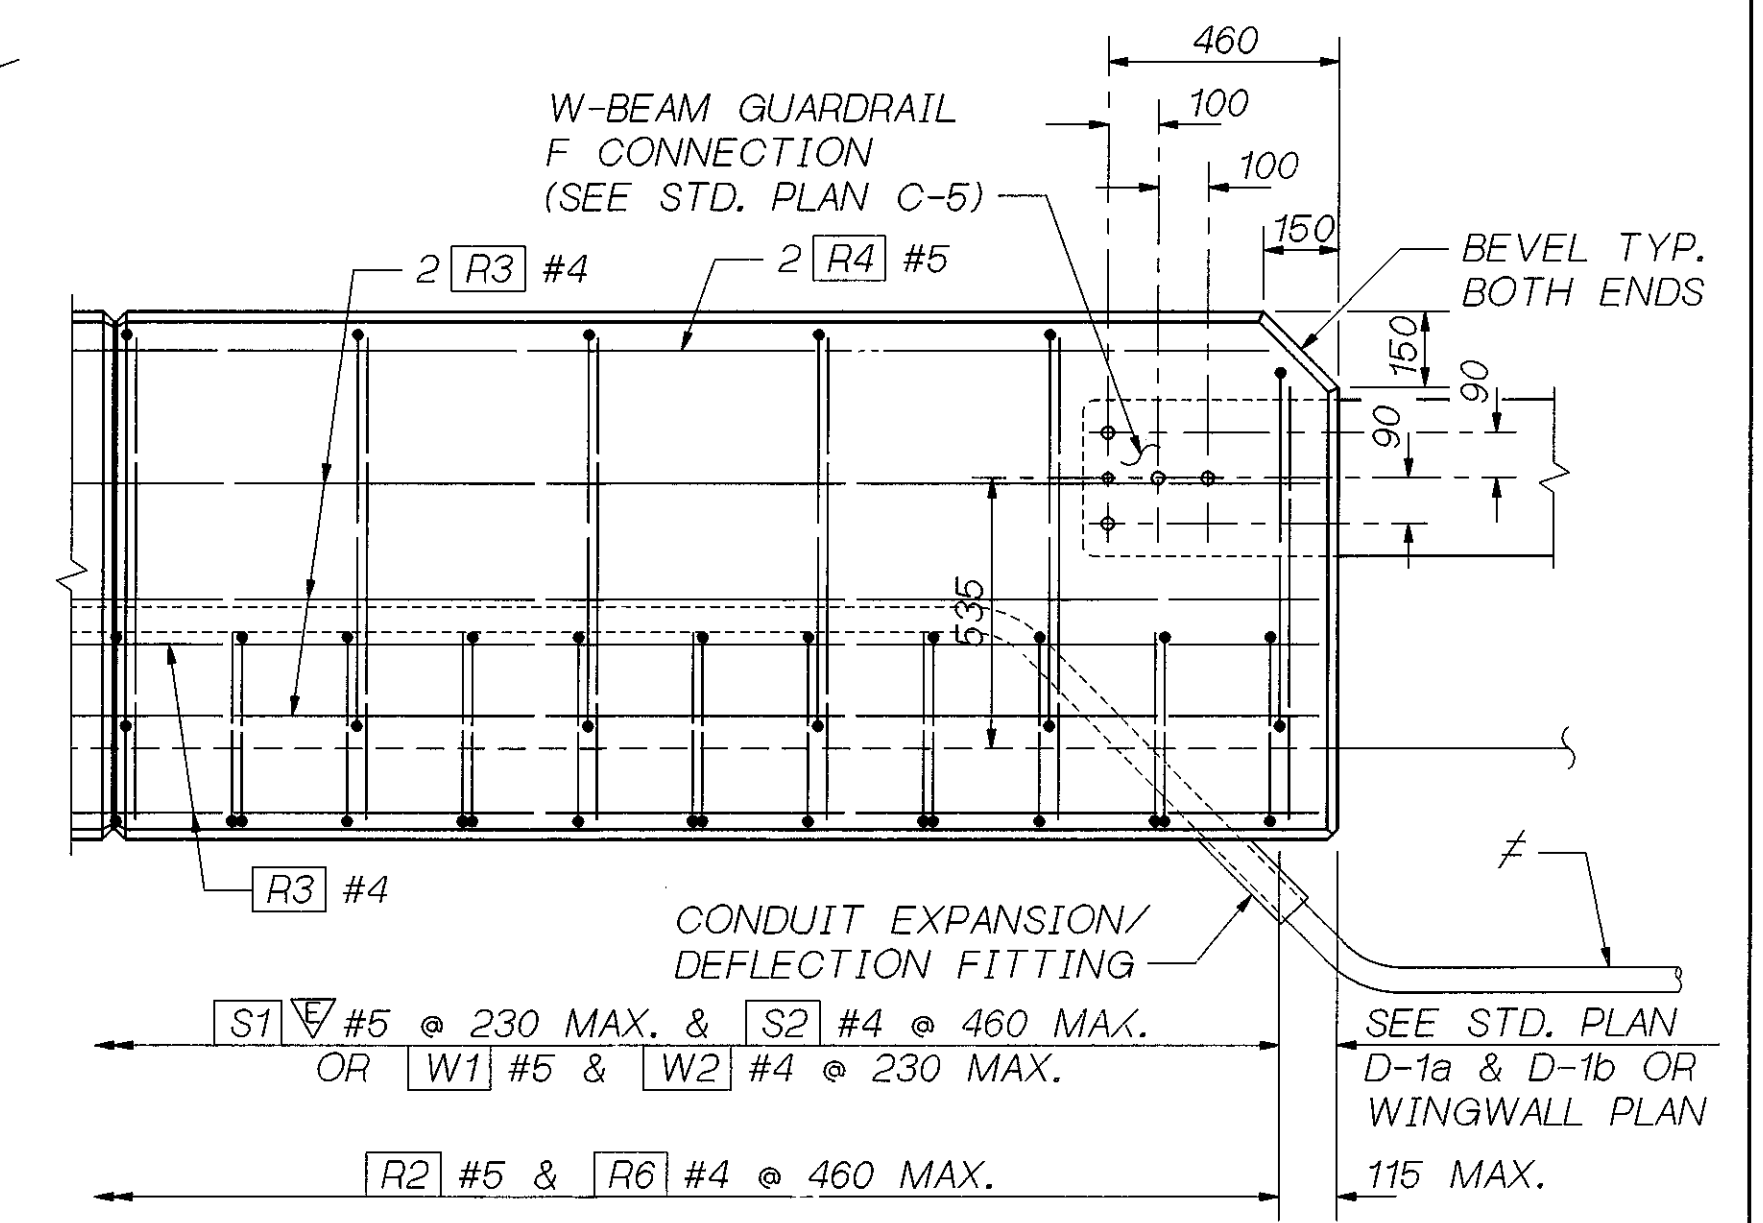


OUTSIDE ELEVATION TRAFFIC BARRIER AT TRAILING END OF BRIDGE

TERMINATE EACH CONDUIT PIPE AT SEPARATE TYPE 1 JUNCTION BOX OFF END OF BRIDGE.

SR 405 JOB NO. 7079 SHEET 27


Bridge Design Engr.	S405D103R00T-1.000000.FGB1MSS.1.FGB.1	REGION NO.	STATE	FED. AID PROJ. NO.	SHEET NO.	TOTAL SHEETS
Supervisor	W. WILSON		10 WASH.			
Designed By	M. TRAGESSER					
Checked By	S. ANDERSON					
Detailed By	D.W. PULSE JR.					
Bridge Projects Engr.		JOB NUMBER	96W035			
Prelim. Plan By		DATE	5054	BY	APP'D	
Architect/Specialist		REVISION				

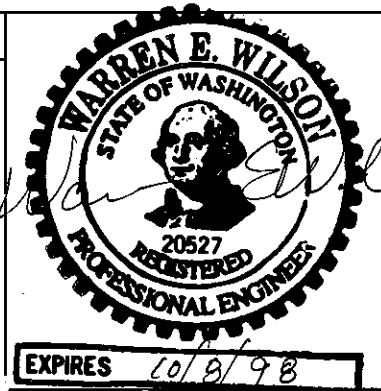


SR 405  
BOTHELL TO SWAMP CREEK 1/C  
HOV LANES - STAGE 1  
228TH BRIDGE 405/103E  
TRAFFIC BARRIER 1 OF 3

BRIDGE SHEET NO. 27  
SHEET 525 OF 663 SHEETS


21/102

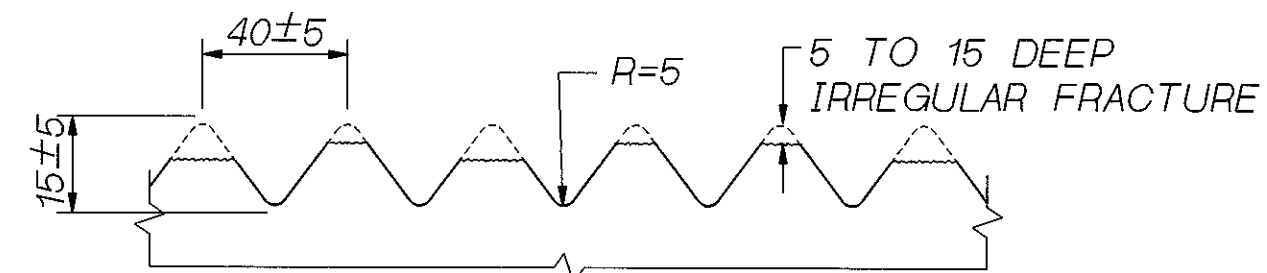


FRACTURED FIN FINISH

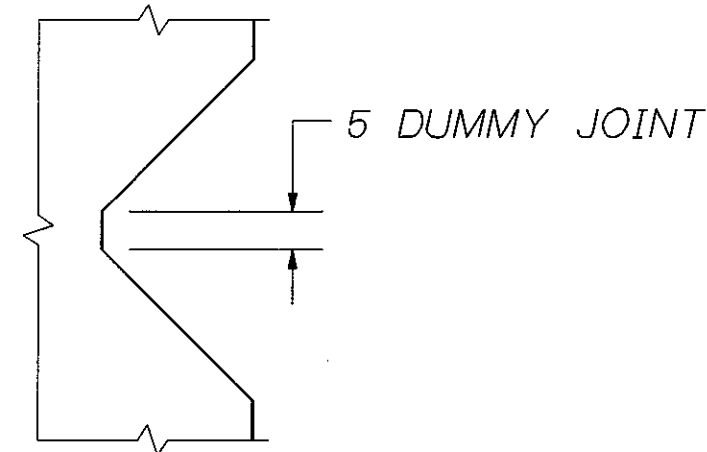

DUMMY JOINT  
DETAIL

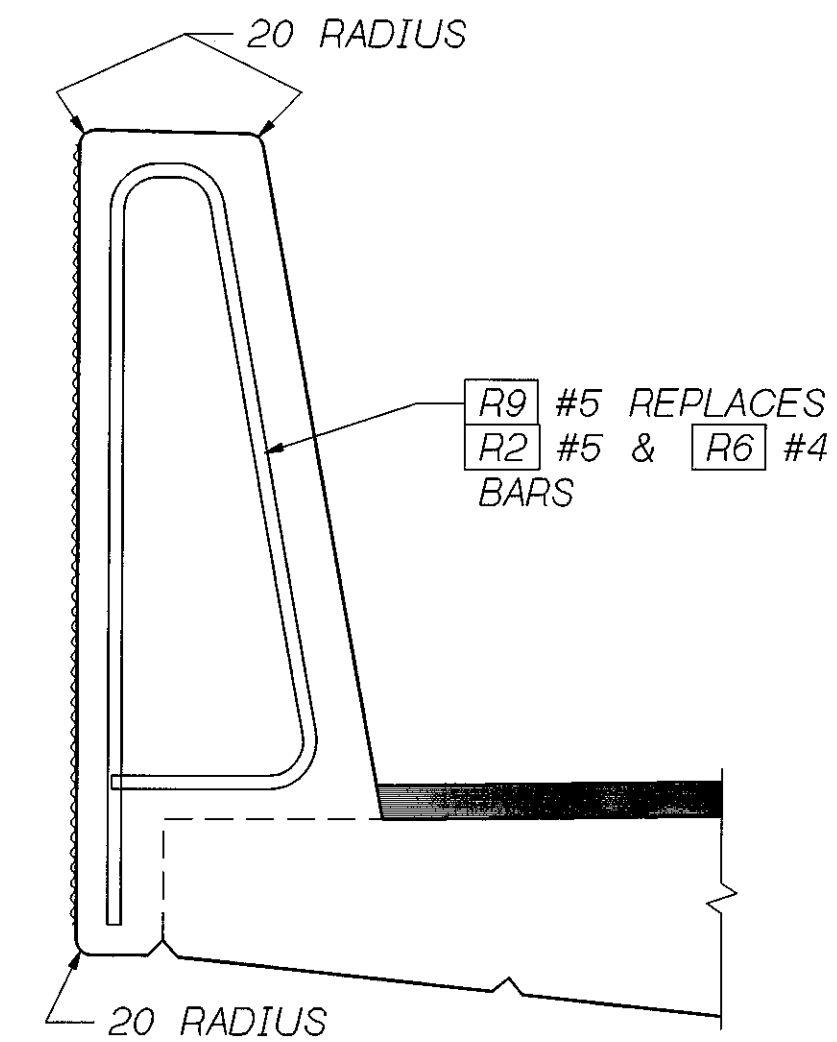


SLIPFORM  
ALTERNATE  
SEE TYPICAL SECTION - TRAFFIC  
BARRIER FOR ADDITIONAL DETAILS.

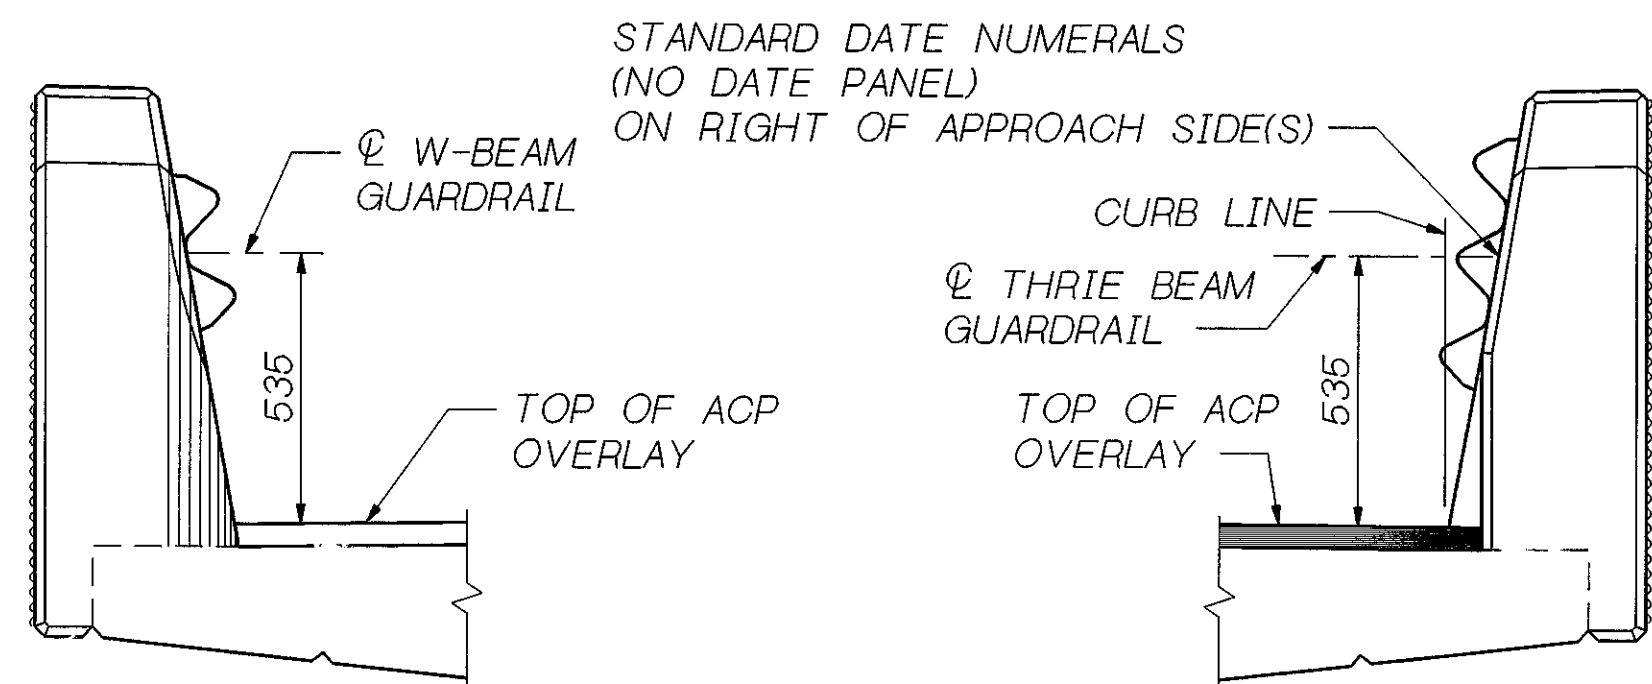


END VIEW  
WITH F CONNECTION

END VIEW  
WITH D CONNECTION

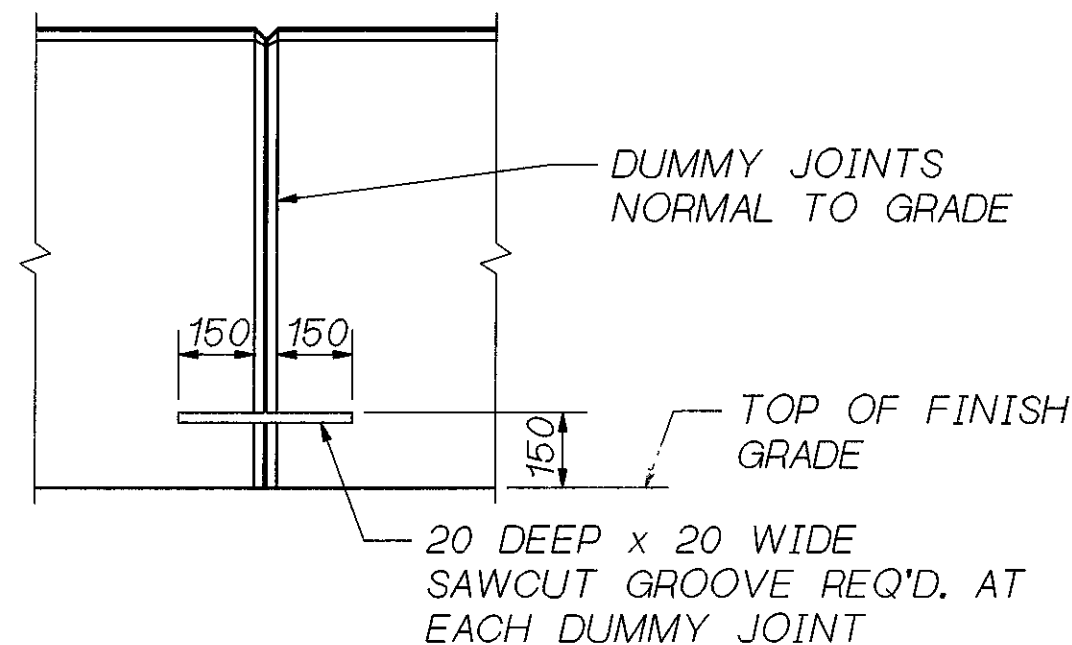

VIEW A  
27

NOTE: CONCRETE SURFACE CONSTRUCTION TOLERANCE OF 3 IN 3,000 (MAX.) IS REQ'D. FOR TRAFFIC SIDE OF BARRIER.

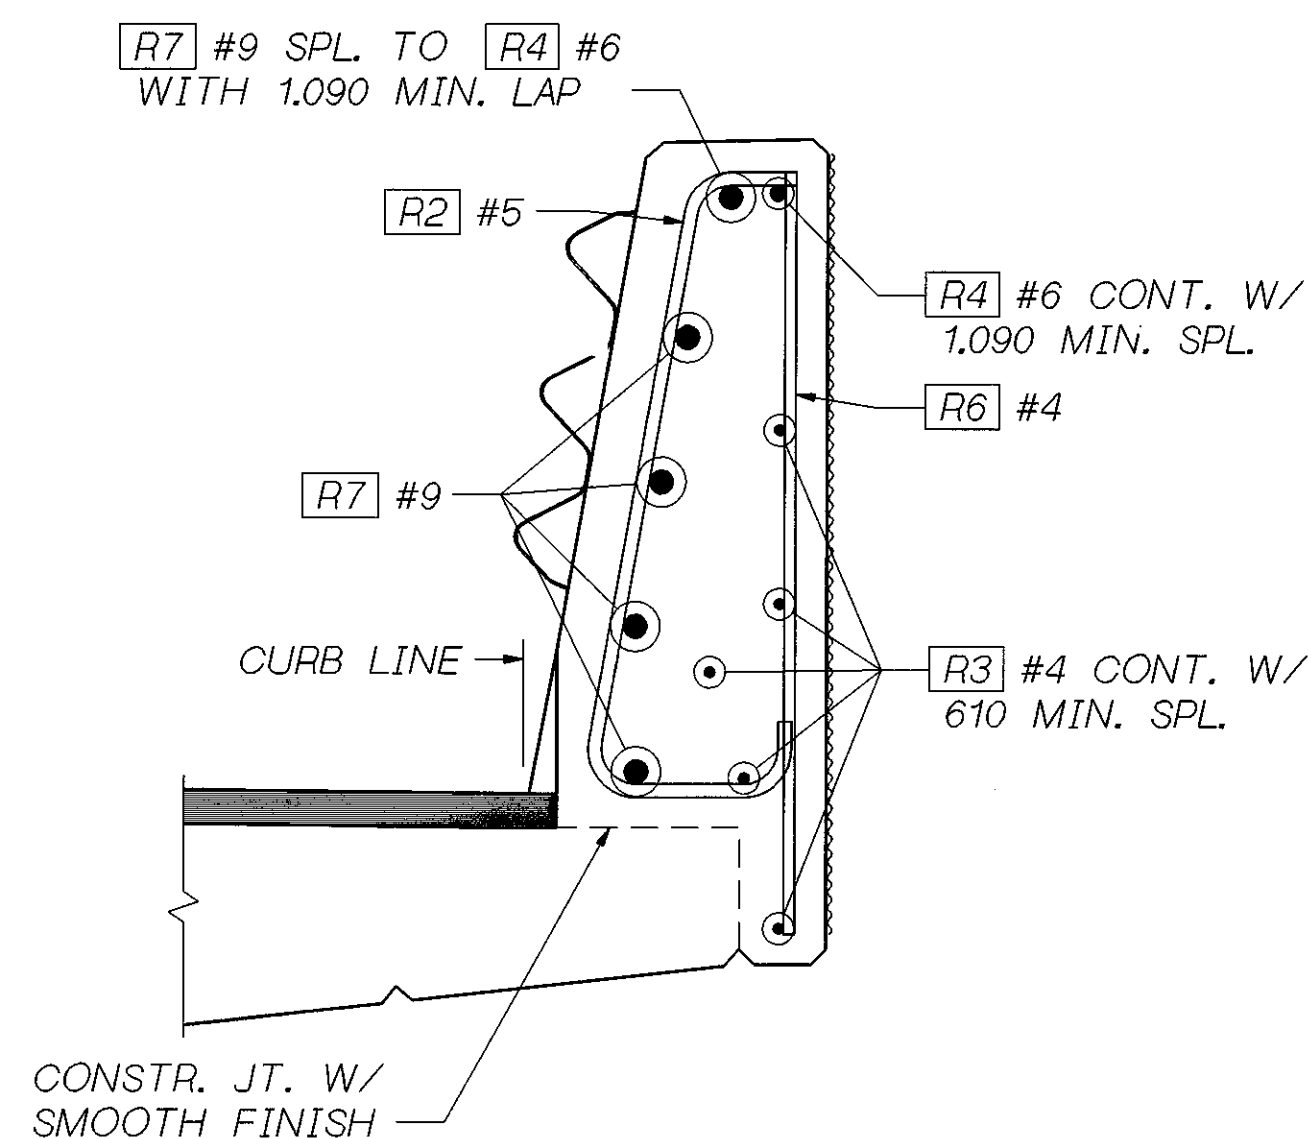

SECTION C BRIDGE  
27


DETAIL FOR BRIDGE  
FOR DETAILS NOT SHOWN SEE "OUTSIDE  
ELEVATION" AND "TYPICAL SECTION"

∇ : EPOXY COATED ≠ DIMENSIONS TO POINTS OF INTERSECTION.

TRAFFIC BARRIER BAR LIST  
ALL REINFORCING SHALL BE AASHTO M31, GR. 60.

MARK SIZE LENGTH BENDING DIAGRAM (ALL DIMENSIONS ARE OUT TO OUT)

MARK	SIZE	LENGTH	
R2	5	1,320	
R3	4	(A)	STR.
R4	6	(A)	STR.
R6	4	960	STR.
R7	9	4,265	STR.
R9	5	2,180	

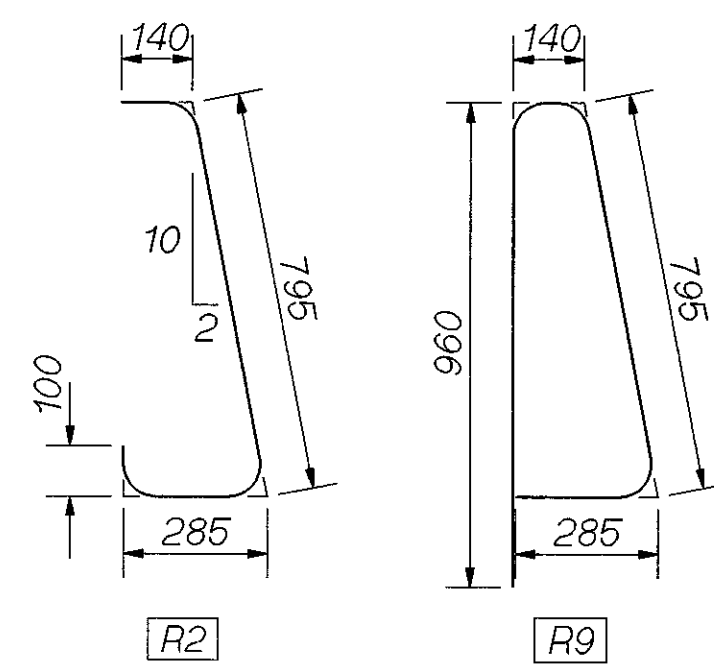


(A) DETERMINE FROM PLANS

FOR [W1] & [W2] BARS SEE WINGWALL OR RETAINING WALL PLANS. FOR [S1] & [S2] BARS SEE BARLIST.

SR 405 JOB NO. 7079 SHEET 28


Bridge Design Engr.	S405D103ROOT:\000000.FGB\MSS_2.FGB:1			REGION NO.	STATE	FED. AID PROJ. NO.	SHEET NO.	TOTAL SHEETS
Supervisor	W. WILSON			10	WASH.			
Designed By	M. TRAGESSER							
Checked By	S. ANDERSON							
Detailed By	D.W. PULSE JR.							
Bridge Projects Engr.				JOB NUMBER	96W035			
Prelim. Plan by				DATE	REVISION	BY	APP'D	5054
Architect/Specialist								

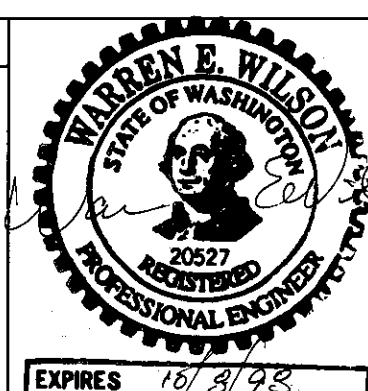

SR 405  
BOTHELL TO SWAMP CREEK 1/C  
HOV LANES - STAGE 1  
228TH BRIDGE 405/103E  
TRAFFIC BARRIER 2 OF 3


BRIDGE SHEET NO. 28  
SHEET 526 OF 663 SHEETS

2/11/01

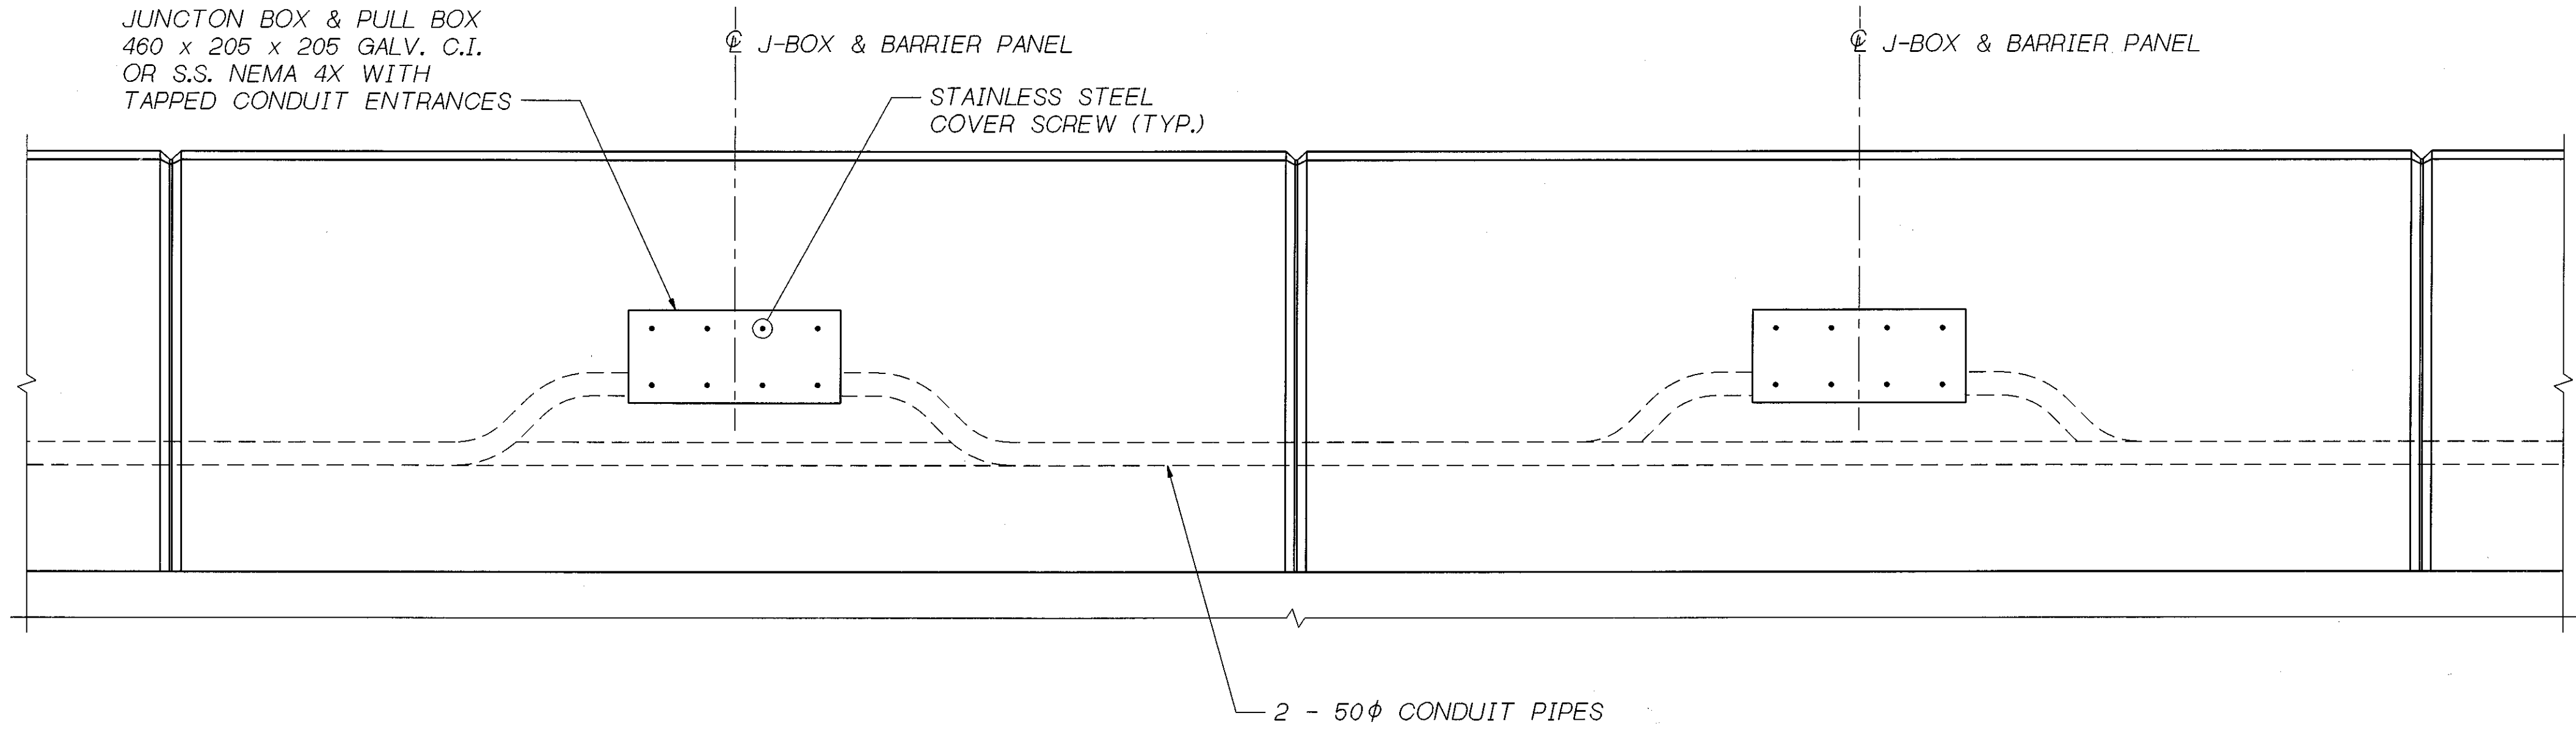


**ELEVATION - CONDUIT & J-BOX IN TRAFFIC BARRIER**

LABEL JUNCTION BOX COVER IN ACCORDANCE WITH STANDARD PLAN J-11a AND SPECIAL PROVISIONS.

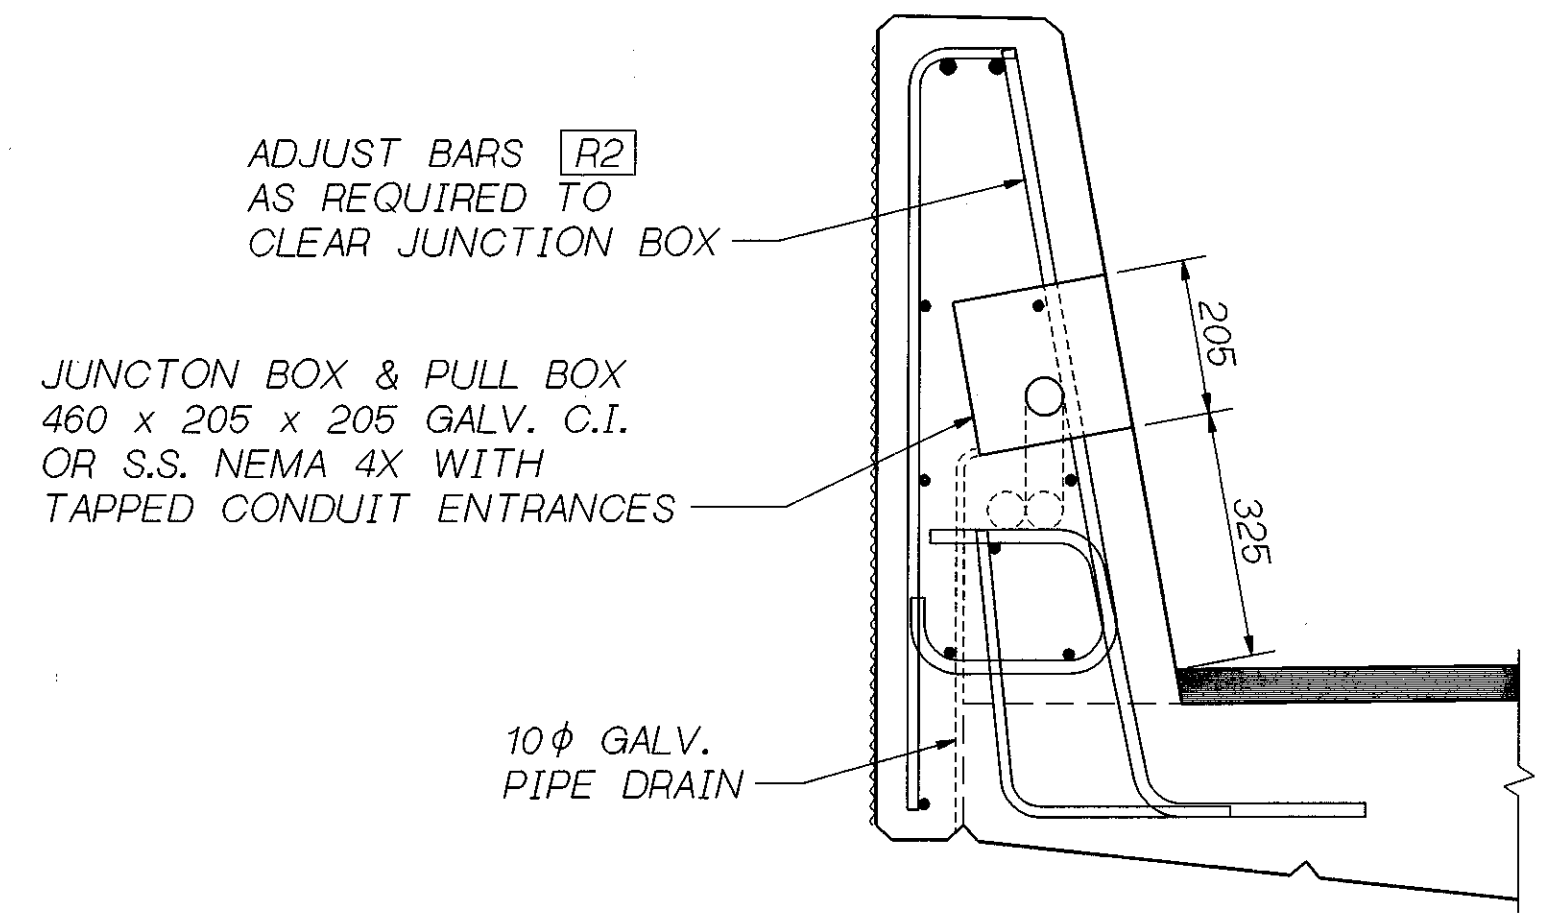

**TYPICAL SECTION TRAFFIC BARRIER**

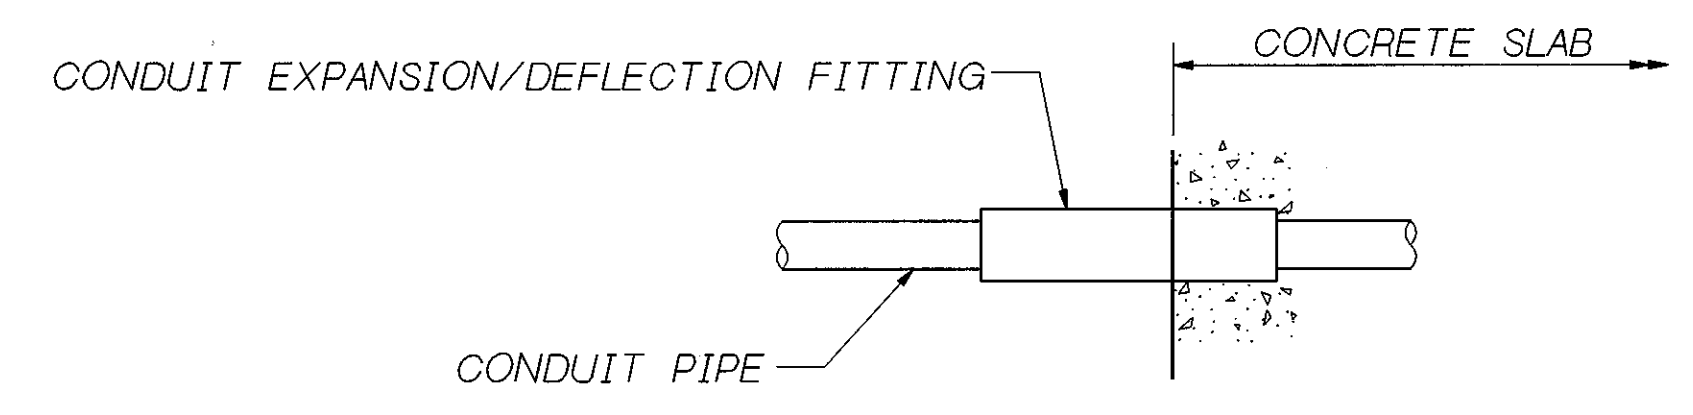


**CONDUIT EXPANSION/DEFLECTION FITTING**

TYPE AX/DX CONDUIT FITTING  
FOR DEFLECTION OF 30° AND 50 MOVEMENT  
PLACE AT CONDUIT PIPE EXIT FROM STRUCTURE.

JUNCTION BOX LOCATIONS	
L STA. 42+423.090 RT.	
L STA. 42+425.530 RT.	

SR 405 JOB NO. 1079 SHEET 29

Bridge Design Engr.	S405D103ROOT:1.000000.FGB1MSS.3.FGB:1	REGION NO.	STATE	FED. AID PROJ. NO.	SHEET NO.	TOTAL SHEETS
Supervisor	W. WILSON	10	WASH.			
Designed By	M. TRAGESSER					
Checked By	S. ANDERSON					
Detailed By	D.W. PULSE JR.					
Bridge Projects Engr.				JOB NUMBER		
Prelim. Plan By				96W035		
Architect/Specialist		DATE	REVISION	BY	APP'D	5054

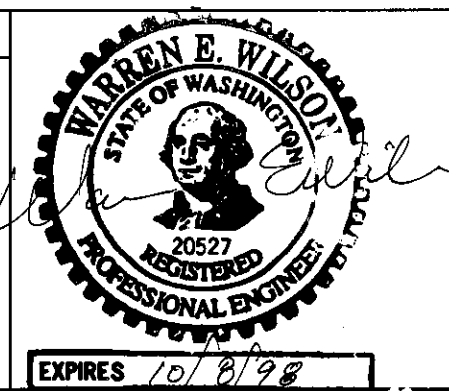

SR 405  
BOTHELL TO SWAMP CREEK 1/2  
HOV LANES - STAGE 1  
228TH BRIDGE 405/103E  
TRAFFIC BARRIER 3 OF 3

BRIDGE SHEET NO. 29  
SHEET 527 OF 663 SHEETS

24/100

S-BAR IS INCLUDED IN SUBSTRUCTURE QUANTITIES - LUMP SUM QUANTITY  
 T OR S-TIE OR STIRRUP RADIUS  
 E-EARTHQUAKE TAIL W/ TIE OR STIRRUP RADIUS  
 E-BAR IS EPOXY COATED  
 V-BAR DIMENSIONS VARY BETWEEN DIMENSIONS SHOWN ON THIS LINE AND THE FOLLOWING LINE

MARK NO.	LOCATION	SIZE	NO.	RED 'D'	BEND TYPE	BEND RADIUS	SUBSTRUCT	EPOXY COATED	VARIES	DIMENSIONS								LENGTH (EACH)	TOTAL WEIGHT
										U	W	X	Y	Z	θ <sub>1</sub>	θ <sub>2</sub>			
										M	M	M	M	M	DEG	DEG	M		
PIERS 1 & 4																			
501	PIER 1 & 4 END DIAPHRAGM	8	14	50						9.400						9.400	293		
502	PIER 1 & 4 END DIAPHRAGM	4	12	50						2.700						2.700	32		
503	PIER 1 & 4 END DIAPHRAGM	7	12	50						2.700						2.700	98		
504	PIER 1 & 4 END DIAPHRAGM	9	3	50						1.920						1.920	29		
505	PIER 1 & 4 END DIAPHRAGM	9	2	50						1.360						1.360	13		
D	PIER 1 & 4 END DIAPHRAGM	7	2	64						0.720	0.840	1.205							
A	PIER 1 & 4 END DIAPHRAGM	7	8	69						0.720	1.310	1.310				2.565	62		
B	PIER 1 & 4 END DIAPHRAGM	7	2	50						9.130						9.130	55		
C	PIER 1 & 4 END DIAPHRAGM	7	28	69						0.305	1.310	1.310				2.160	143		
CT	PIER 1 & 4 END DIAPHRAGM	7	10	69						0.300	0.840	1.205							
601	PIER 1 & 4 CURTAIN WALL	4	20	50						2.050						2.050			
										1.158						1.158	31		
602	PIER 1 & 4 CURTAIN WALL	4	16	50						2.050						2.050	32		
603	PIER 1 & 4 CURTAIN WALL	6	10	50						2.812						2.812	62		
604	PIER 1 & 4 CURTAIN WALL	4	10	50						2.812						2.812	28		
605	PIER 1 & 4 CURTAIN WALL	6	6	50						2.812						2.812			
	PIER 1 & 4 CURTAIN WALL									2.040						2.040	32		
606	PIER 1 & 4 CURTAIN WALL	4	6	50						2.812						2.812			
	PIER 1 & 4 CURTAIN WALL									2.040						2.040	14		
607	PIER 1 & 4 CURTAIN WALL	4	4	80						1.390	1.940	0.038	153			3.325	13		
608	PIER 1 & 4 CURTAIN WALL	6	6	80						1.145	1.145	0.055	144			2.285	40		
609	PIER 1 & 4 CURTAIN WALL	6	6	80						1.145	1.145	0.055	36			2.080	37		
701	PIER 1 & 4 FOOTING	5	68	50						3.350						3.350	359		
702	PIER 1 FOOTING	6	5	50						12.578						12.578			
	PIER 1 FOOTING									10.196						10.196	127		
703	PIER 1 & 4 FOOTING	5	68	50						3.350						3.350	359		
704	PIER 1 FOOTING	6	4	50						12.578						12.578			
	PIER 1 FOOTING									10.196						10.196	101		
705	PIER 1 & 4 FOOTING	4	32	63						1.104	1.219	1.219	0.205	0.205		3.835			
	PIER 1 & 4 FOOTING									1.104	1.510	1.510	0.205	0.205		4.420	131		
706	PIER 1 & 4 ABUTMENT	6	24	50						9.485						9.485	508		
707	PIER 1 & 4 ABUTMENT	6	6	50						9.485						9.485	169		
708	PIER 1 & 4 ABUTMENT	6	32	50						1.220						1.220	87		
709	PIER 1 & 4 ABUTMENT	5	64	62						0.205	2.420	2.420	0.255	0.255		5.410	537		
710	PIER 1 & 4 ABUTMENT	4	128	70						0.205	0.150					0.480	60		
711	PIER 1 & 4 ABUTMENT	4	96	50						1.515						1.515	144		
712	PIER 1 & 4 ABUTMENT	4	24	50						9.485						9.485	226		
713	PIER 1 & 4 ABUTMENT	4	4	50						9.485						9.485	37		
714	PIER 1 & 4 ABUTMENT	4	4	62						0.140	0.405	0.405	0.205	0.205		1.245	4		
715	PIER 1 & 4 ABUTMENT	5	60	62						0.585	0.575	0.575				1.650	153		
731	PIER 1 & 4 FOOTING	5	16	50						1.700						1.700	42		
733	PIER 1 & 4 FOOTING	5	16	50						1.700						1.700	42		
742	PIER 4 FOOTING	6	5	50						12.071						12.071			
	PIER 4 FOOTING									9.689						9.689	121		
744	PIER 4 FOOTING	6	4	50						12.071						12.071			
	PIER 4 FOOTING									9.689						9.689	97		
745	PIER 4 FOOTING	4	32	63						1.104	1.262	1.262	0.205	0.205		3.910			
	PIER 4 FOOTING									1.104	1.580	1.580	0.205	0.205		4.545	134		
751	PIER 1 & 4 ABUTMENT	5	10	50						2.000						2.000	30		
752	PIER 1 FOOTING	6	3	50						10.196						10.196	68		
754	PIER 1 FOOTING	6	3	50						10.196						10.196	68		

S-BAR IS INCLUDED IN SUBSTRUCTURE QUANTITIES - LUMP SUM QUANTITY  
 T OR S-TIE OR STIRRUP RADIUS  
 E-EARTHQUAKE TAIL W/ TIE OR STIRRUP RADIUS  
 E-BAR IS EPOXY COATED  
 V-BAR DIMENSIONS VARY BETWEEN DIMENSIONS SHOWN ON THIS LINE AND THE FOLLOWING LINE

MARK NO.	LOCATION	SIZE	NO.	RED 'D'	BEND TYPE	BEND RADIUS	LUMP SUM	SUBSTRUCT	EPOXY COATED	VARIES	DIMENSIONS								LENGTH (EACH)	TOTAL WEIGHT
											U	W	X	Y	Z	θ <sub>1</sub>	θ <sub>2</sub>			
											M	M	M	M	M	DEG	DEG	M		
PIER 2																				
201	FOOTING-BOTTOM-MAT	8	20	50							4.220					4.220	335			
202	FOOTING-BOTTOM-MAT	8	20	50							4.220					4.220	335			
203	FOOTING-TOP-MAT	6	16	50							4.220					4.220	150			
204	FOOTING-TOP-MAT	6	16	50							4.220					4.220	150			
300	COLUMN-VERTICAL	11	15	54							4.255					4.255	576			
301	COLUMN-VERTICAL	11	15	54							6.351					6.351	824			
302	COLUMN-SPRAL (X-BEAM & FTG)	5	2	67							0.835	33	0.070			85.295	264			
303	COLUMN-SPRAL	5	1	67							0.835	59	0.070			152.475	236			
400	HINGE BAR	9	28	54							2.060					2.465	348			
401	CROSSBEAM HORIZONTAL TOP	11	9	80							8.840		0.985	0.185	85	9.830	699			
402	CROSSBEAM HORIZONTAL SIDES	11	9	50							8.840					8.840	629			
403	CROSSBEAM HORIZONTAL SIDES	6	4	50							8.840					8.840	78			
404	CROSSBEAM HORIZONTAL BOTTOM	11	7	51							8.840					9.320	515			
405	CROSSBEAM STIRRUPS	5	108	72							0.650	0.960	0.960			2.795	468			
406	CROSSBEAM DOWELS	6	4	51							0.800					1.015	9			
407	CROSSBEAM DOWELS	9	14	51							1.900					2.285	161			
PIER 3																				
201	FOOTING-BOTTOM-MAT	8	20	50							4.220					4.220	335			
202	FOOTING-BOTTOM-MAT	8	20	50							4.220					4.220	335			
203	FOOTING-TOP-MAT	6	16	50							4.220					4.220	150			
204	FOOTING-TOP-MAT	6	16	50							4.220					4.220	150			
301	COLUMN-VERTICAL	11	15	80							8.202	0.610	0.610	0.185	90	9.174	1089			
302	COLUMN-SPRAL (X-BEAM & FTG)	5	2	67							0.835	33	0.070			85.295	264			
303	COLUMN-SPRAL	5	1	67							0.835	55	0.070			142.140	220			
400	HINGE BAR	9	28	54							2.060					2.465	348			
401	CROSSBEAM HORIZONTAL TOP	11	9	80							8.840		0.985	0.185	85	9.830	699			
402	CROSSBEAM HORIZONTAL SIDES	11	9	50							8.840					8.840	629			
403	CROSSBEAM HORIZONTAL SIDES	6	4	50							8.840					8.840	78			
404	CROSSBEAM HORIZONTAL BOTTOM	11	7	51							8.840					9.320	515			
405	CROSSBEAM STIRRUPS	5	108	72							0.650	0.960	0.960			2.795	468			
406	CROSSBEAM DOWELS	6	4	51							0.800					1.015	9			
407	CROSSBEAM DOWELS	9	14	51							1.900					2.285	161			
ROADWAY SLAB																				
801	LONGITUDINAL TOP	7	11	50							16.600									

S=BAR IS INCLUDED IN SUBSTRUCTURE QUANTITIES  
LUMP SUM QUANTITY  
T OR S-TIE OR STIRRUP RADIUS  
E=EARTHQUAKE TAIL W/ TIE  
OR STIRRUP RADIUS

E=BAR IS EPOXY COATED  
V=BAR DIMENSIONS VARY BETWEEN DIMENSIONS SHOWN  
ON THIS LINE AND THE FOLLOWING LINE


MARK NO.	LOCATION	SIZE	NO. REQ'D	BEND TYPE	BEND RADIUS	SUBSTRUCTURE	EPOXY COATED	DIMENSIONS							LENGTH (EACH)	TOTAL WEIGHT
								U	W	X	Y	Z	θ <sub>1</sub>	θ <sub>2</sub>		
								M	M	M	M	M	DEG	DEG		
814	LONGITUDINAL BOTTOM	7	11.50					14.600					14.600	488		
815	LONGITUDINAL BOTTOM	7	8.50					12.600					12.600	306		
816	LONGITUDINAL BOTTOM	7	6.50					6.200					6.200	112		
820	LONGITUDINAL TOP (CONT)	5	64.50				E	11.470					11.470	1139		
821	LONGITUDINAL BOTTOM (CONT)	5	160.50					11.470					11.470	2848		
840	LONGITUDINAL TOP (CONT W/7)	5	66.50				E	9.660					9.660	990		
841	LONGITUDINAL BOT (CONT W/7)	5	66.50					9.660					9.660	990		
842	LONGITUDINAL TOP (CONT W/7)	5	12.50					10.660					10.660	198		
843	LONGITUDINAL BOT (CONT W/7)	5	48.50					10.660					10.660	793		
845	LONGITUDINAL BOT (CONT W/7)	5	48.50					9.930					9.930	739		
830	TRANSVERSE TOP	5	633.51				E	5.980					6.145	6048		
831	TRANSVERSE TOP	5	41.51				E V	2.200					2.360			
								5.900					6.070	268		
832	TRANSVERSE BOTTOM	5	633.51					5.980					6.145	6048		
833	TRANSVERSE BOTTOM	5	41.51				V	2.200					2.360			
								5.900					6.070	268		
850	SPLAYED TOP	5	30.51				E	2.100					2.260	105		
851	SPLAYED BOT	5	30.51					2.100					2.260	105		
S1	TRAFFIC BARRIER TIE	4	379.69				E	0.300	0.060	0.380	0.220		0.885	329		
S2	TRAFFIC BARRIER TIE	4	194.69					0.300	0.030	0.380			0.660	127		
HINGE DIAPHRAGMS																
521	HORIZONTAL BAR	8	6.50					1.710					1.710	40		
522	HORIZONTAL BAR	5	16.50					3.800					3.800	94		
H1	STIRRUP	4	36.63					0.435	1.710	1.710	2.050	2.050	7.825	279		
H2	VERTICAL TIES	4	40.68					1.835	0.150				1.930	76		
H3	VERTICAL TIES	4	8.68					1.835	0.150				1.930	15		
H4	HORIZONTAL BAR	5	24.50					9.400					9.400	350		
INTERMEDIATE DIAPHRAGMS																
511	HORIZONTAL BAR	7	24.50					9.400					9.400	686		
512	HORIZONTAL BAR	8	6.50					9.817					9.817	234		
513	HORIZONTAL BAR BTWN GIRDERS	4	36.50					2.700					2.700	96		
514	HORIZONTAL BAR	9	12.50					8.980					8.980	545		
515	DOWEL	9	18.50					1.630					1.630	147		
516	DOWEL	9	12.50					1.360					1.360	82		
517	STIRRUP	4	180.71					0.200	1.090	1.090			2.285	408		
518	BLOCKOUT BAR	9	12.81					1.030	0.785		0.153	225	2.565	155		
519	HORIZONTAL BAR	9	6.50					2.700					2.700	82		

S=BAR IS INCLUDED IN SUBSTRUCTURE QUANTITIES  
LUMP SUM QUANTITY  
T OR S-TIE OR STIRRUP RADIUS  
E=EARTHQUAKE TAIL W/ TIE  
OR STIRRUP RADIUS

E=BAR IS EPOXY COATED  
V=BAR DIMENSIONS VARY BETWEEN DIMENSIONS SHOWN  
ON THIS LINE AND THE FOLLOWING LINE

MARK NO.	LOCATION	SIZE	NO. REQ'D	BEND TYPE	BEND RADIUS	SUBSTRUCTURE	EPOXY COATED	DIMENSIONS							LENGTH (EACH)	TOTAL WEIGHT
								U	W	X	Y	Z	θ <sub>1</sub>	θ <sub>2</sub>		
								M	M	M	M	M	DEG	DEG		
PIER 2																
300	COLUMN VERTICAL	11	8.54	S				4.26					4.87	307		
301	COLUMN VERTICAL	11	7.54	S				6.35					6.96	385		
300A	COLUMN VERTICAL	11	8.50	S				6.23					6.84	439		
301A	COLUMN VERTICAL	11	7.50	S				4.14					4.75	269		
302	COLUMN SPIRAL	5	1.67	S				0.84	36	0.07			93.05	144		
303	COLUMN SPIRAL	5	1.67	S				0.84	84	0.07			217.10	336		
900	DRILLED SHAFT VERT	11	32.50	S				12.97					13.0	3283		
902	DRILLED SHAFT SPIRAL	5	1.67	S				1.53	145	0.09			68.7	1067		
PIER 3																
301	COLUMN VERTICAL	11	15.54	S				7.58					8.19	972		
302	COLUMN SPIRAL	5	1.67	S				0.84	36	0.07			93.05	144		
303	COLUMN SPIRAL	5	1.67	S				0.84	73	0.07			188.60	292		
901	DRILLED SHAFT VERT	11	32.50	S				11.57					11.60	2928		
903	DRILLED SHAFT SPIRAL	5	1.67	S				11.53	129	0.09			612	949		

BENDING DIAGRAMS

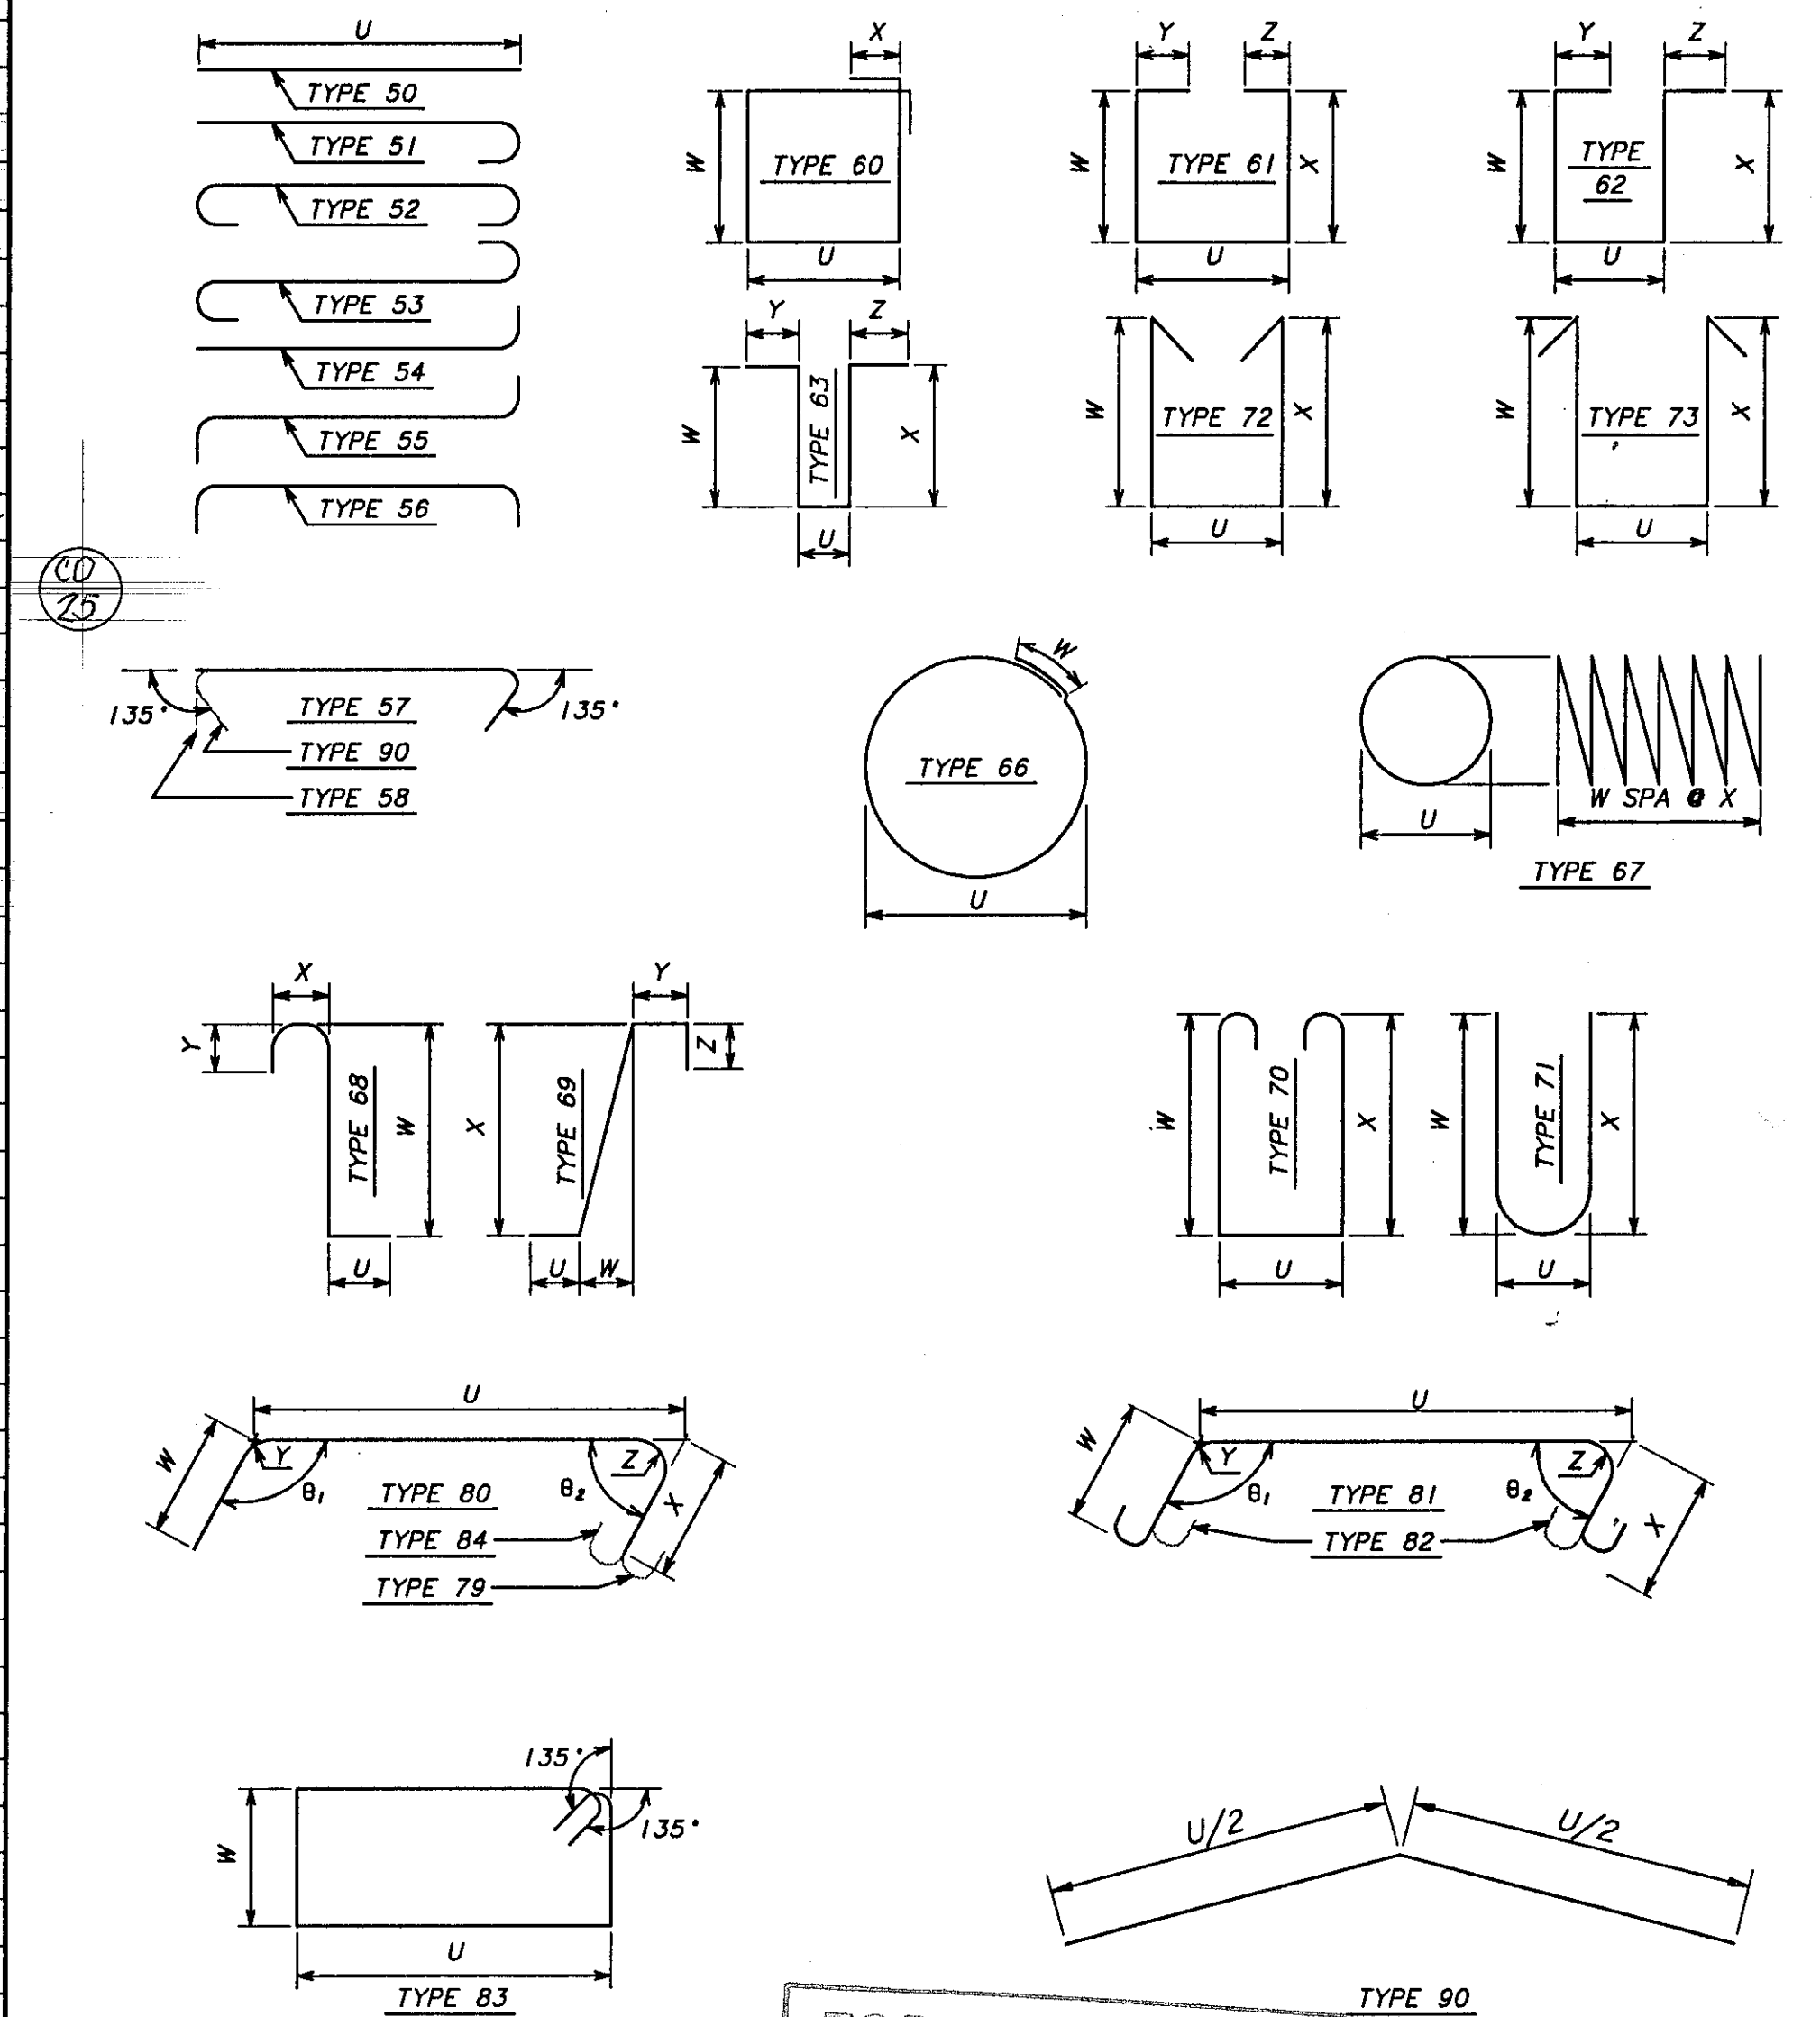


FOR "AS CONSTRUCTED PLANS" ONLY

- NOTES:
- ALL REINFORCING BARS ON THIS SHEET SHALL BE AASHTO-M31-GRADE 60 UNLESS SHOWN OTHERWISE.
  - REINFORCING FOR TRAFFIC BARRIER IS NOT SHOWN IN THIS BAR LIST EXCEPT FOR BARS S1 & S2. SEE TRAFFIC BARRIER, SHEETS 27, 28 & 29.
  - BEND FOR TRANSVERSE BARS DUE TO ROADWAY CROWN CONDITIONS HAVE NOT BEEN SHOWN. THESE BARS SHALL BE BENT AS REQUIRED TO CONFORM TO THE CONFIGURATION OF THE STRUCTURE.
  - § NUMBER AND LENGTH OF BARS TO BE DETERMINED BY THE CONTRACTOR FROM THE PLANS.
  - LENGTHS OF SPIRAL SHOWN IN BAR LIST DOES NOT INCLUDE LENGTH OF SPLICES.
  - DIMENSIONS FOR BENT REINFORCING BARS (INCLUDING LENGTH) ARE POINTS OF INTERSECTION (OUT TO OUT).
  - BEND FOR TRANSVERSE BARS DUE TO ROADWAY CROWN CONDITIONS HAVE NOT BEEN SHOWN. THESE BARS SHALL BE BENT AS REQUIRED TO CONFORM TO THE CONFIGURATION OF THE STRUCTURE.

PLOTTED: Tue Nov 12 1996 2:04pm FILENAME: X:\A98077\405-103E\31.DWG SCALE: 1  
SR 405 JOB NO. 7079 SHEET 31 OF 31

BRIDGE DESIGN ENGR		REGION NO.	STATE	FED AID PROJ NO.	SHEET	TOTAL SHEETS
SUPERVISOR		I	WASH			
DESIGNED BY	M. TRAGESSER 6/96	JOB NUMBER	96W035			
CHECKED BY	S. ANDERSON 6/96	CONTRACT NO.	5054			
DETAILED BY	R. MOHN 6/96	DATE	REVISION	BY	APPR	
BRIDGE PROJECTS ENGR						
PRELIM PLAN BY	A13-98	CHANGE ORDER #25	ALM			
ARCHITECT/SPECIALIST						

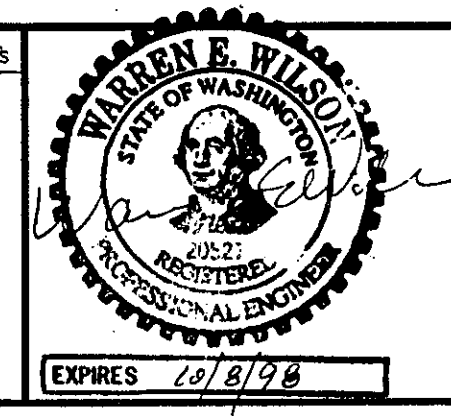

BERGER/ABAM ENGINEERS INC.  
33301 9TH AVENUE SOUTH  
FEDERAL WAY, WASHINGTON 98003-6395  
(206)431-2300 FAX:(206)431-2250



SR 405  
BOTHELL TO SWAMP CREEK 1/C  
HOV LANES - STAGE 1  
228TH BRIDGE 405/103E  
BAR LIST

BRIDGE SHEET NO. 31  
SHEET 529 OF 663 SHEETS