


TYPICAL SECTION PHASE 2 - STAGE 1

SHOWN NEAR AN INTERMEDIATE PIER
ALL DIMENSIONS ARE PERPENDICULAR TO \perp NBCD LINE.

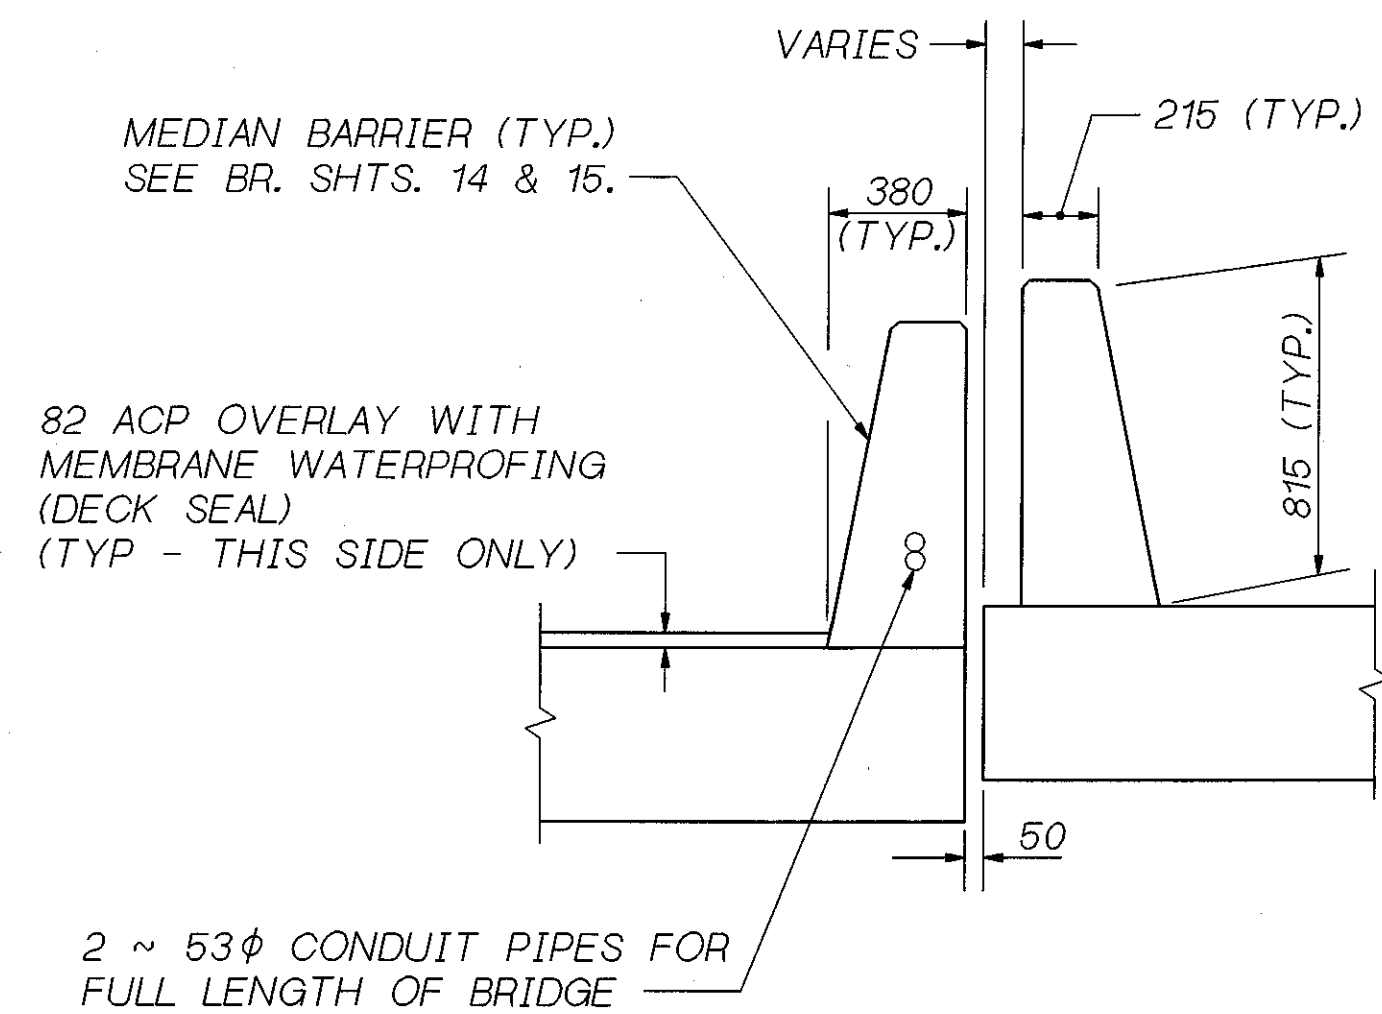

DETAIL A

CONSTRUCTION SEQUENCE

(BEGINS AFTER COMPLETION OF PHASES 1 & 2, L LINE)


PHASE 2 - STAGE 1:

1. SET TEMPORARY BARRIER. CONSTRUCT EAST PORTIONS OF PIERS 1 THRU 4 (NBCD LINE)
2. CONSTRUCT EAST PORTIONS OF DECK SLAB (NBCD LINE)
3. PLACE TRAFFIC BARRIER.

PHASE 2 - STAGE 2:

1. SET TEMPORARY BARRIER. REMOVE PORTIONS OF EXISTING STRUCTURE TO LIMITS AS SHOWN ON BRIDGE SHEET 1 AND AS SHOWN ON TYPICAL SECTION - THIS SHEET.
2. CONSTRUCT WEST PORTIONS OF PIERS 1 THRU 4 EXCEPT AT CLOSURE (NBCD LINE)
3. CONSTRUCT WEST PORTIONS OF DECK SLAB EXCEPT AT CLOSURE (NBCD LINE)
4. ALLOW 30 CALENDAR DAYS PRIOR TO SUBSTRUCTURE AND DECK SLAB CLOSURE (NBCD LINE)
5. PLACE SUBSTRUCTURE AND DECK SLAB CLOSURE (NBCD LINE)
6. PLACE TRAFFIC BARRIERS.

* EXISTING CURB AND RAIL BASE TO BE REMOVED.
EXISTING RAILS TO BE SALVAGED (SEE SPECIAL PROVISIONS).


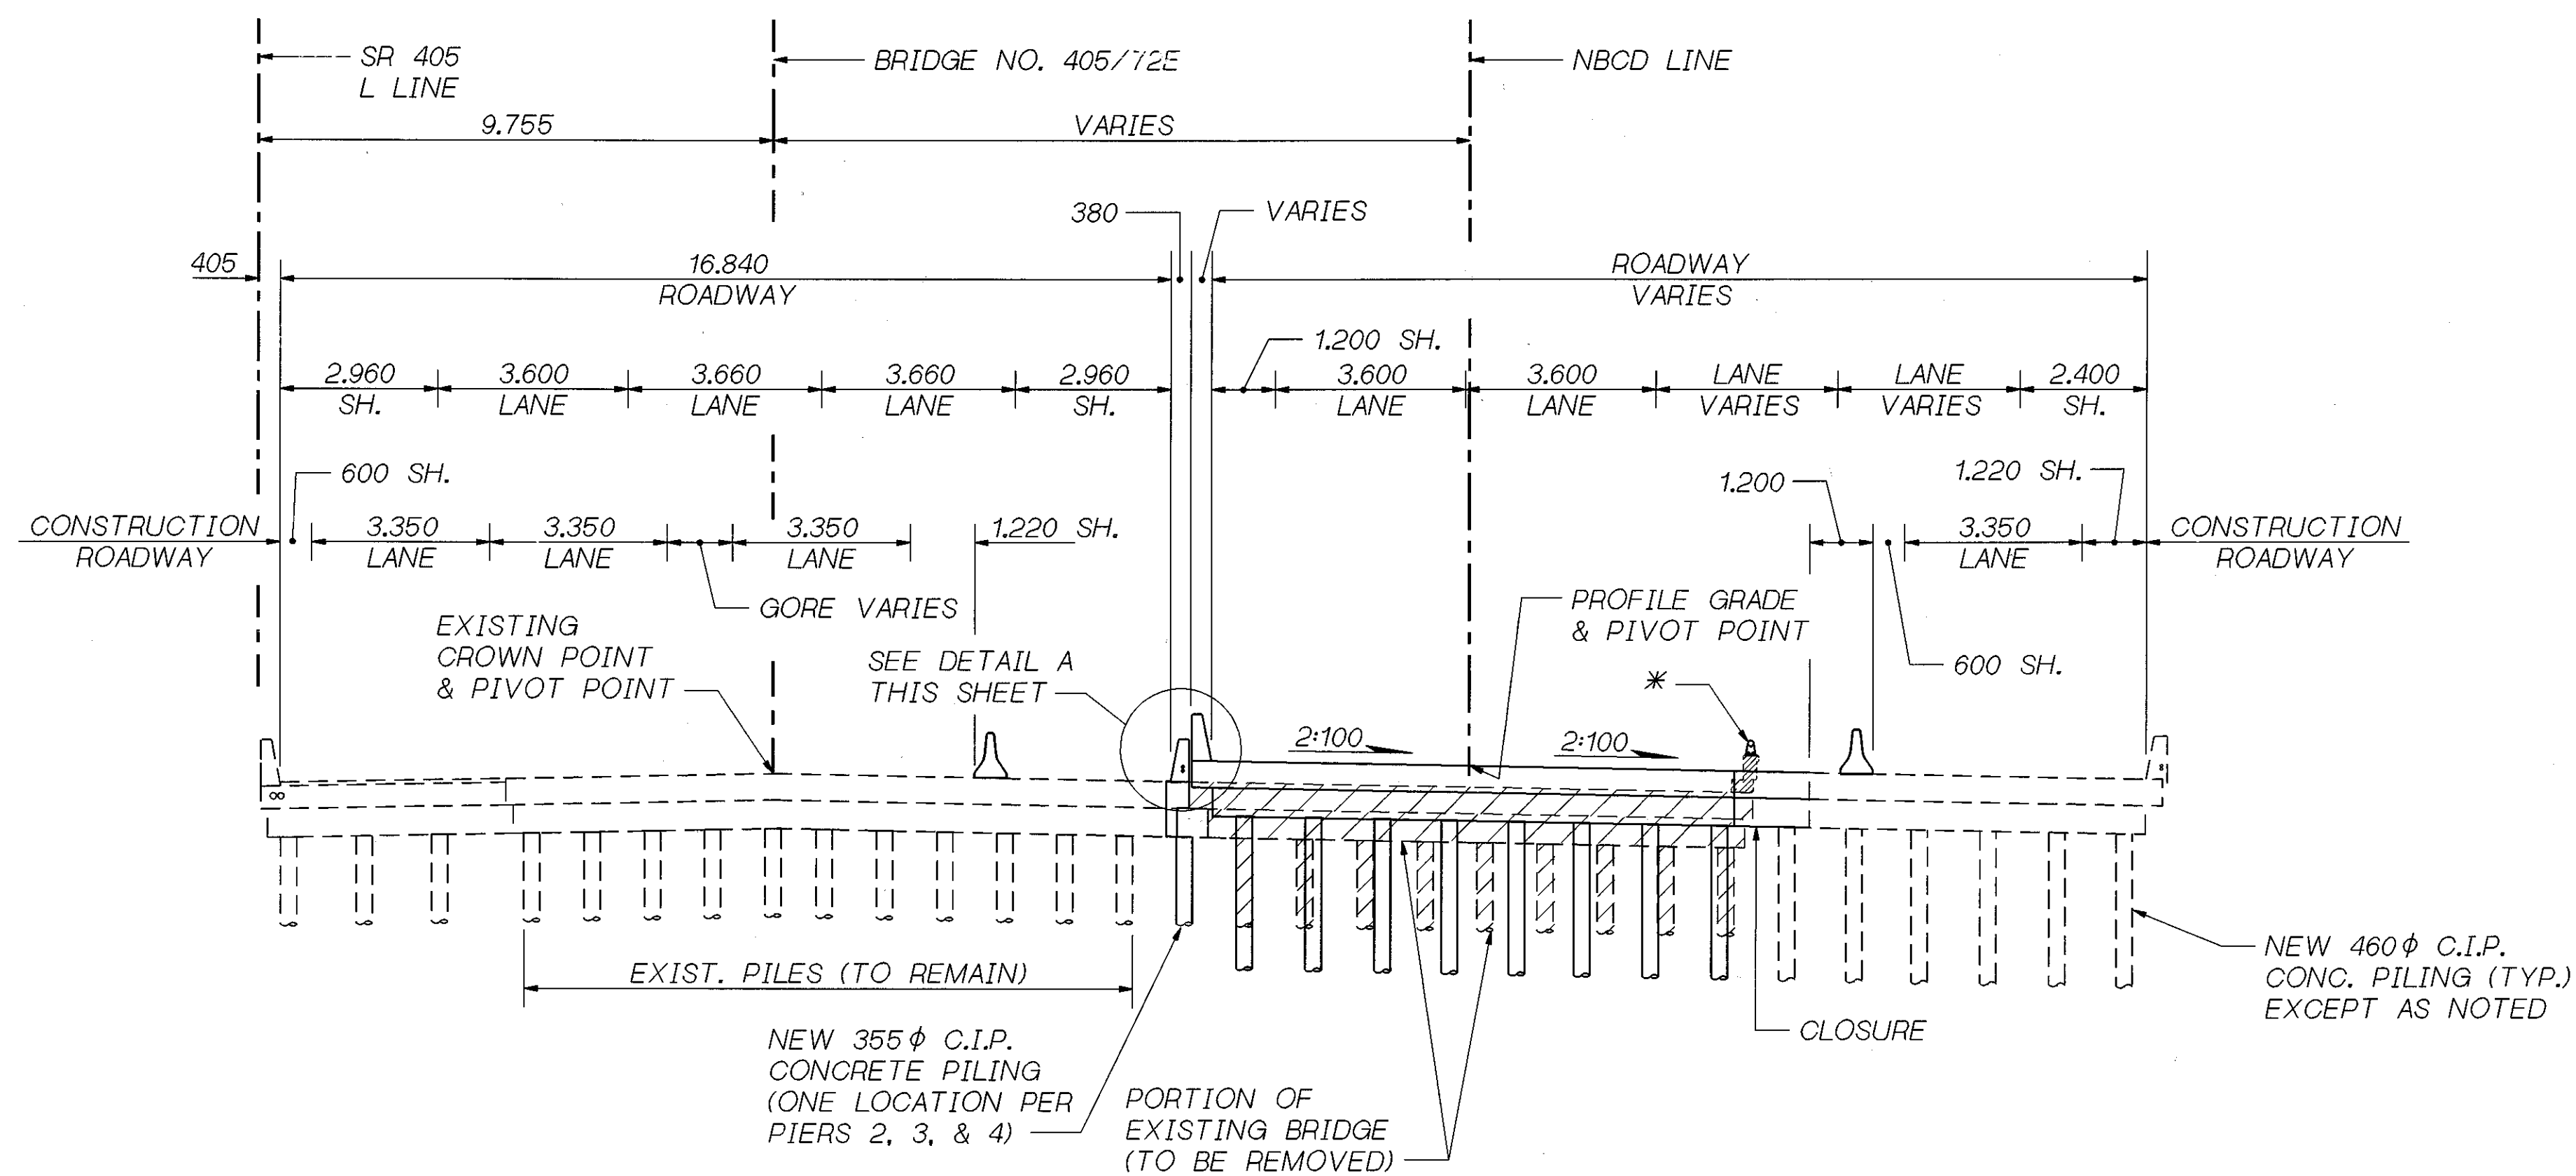


TYPICAL SECTION PHASE 2 - STAGE 2

SHOWN NEAR AN INTERMEDIATE PIER
ALL DIMENSIONS ARE PERPENDICULAR TO \perp NBCD LINE.

SR 405 JOB NO. 7071 SHEET 2

Bridge Design Engr. C. C. RUTH	4/96	NBCDROOT: [000000.FGB] STAGING.FGB: 1	REGION NO.	STATE	FED. AID PROJ. NO.	SHEET NO.	TOTAL SHEETS
Supervisor R.T. SHAEFER/W. WILSON	6/96		10	WASH.			
Designed By K. HINKLEY	6/96						
Checked By C. CORNELL	6/96						
Detailed By A. CHU	3/96						
Bridge Projects Engr. K. N. KIRKER	3/96						
Prelim. Plan By A. CHU	3/96						
Architect/Specialist A. YOUNG	3/96	DATE	REVISION	BY	APP'D	5054	

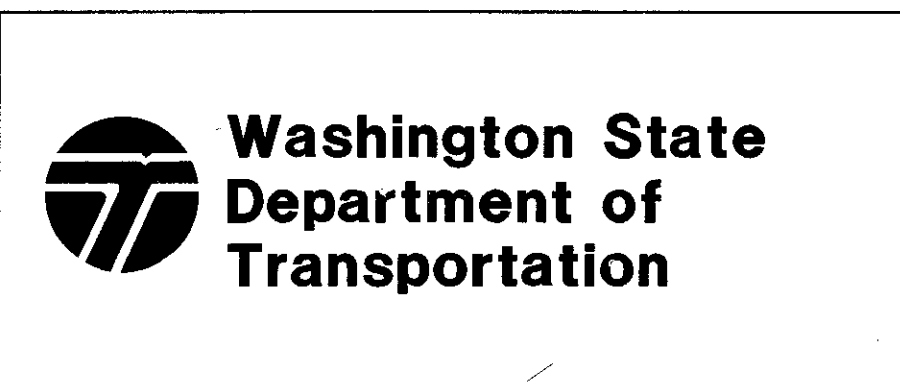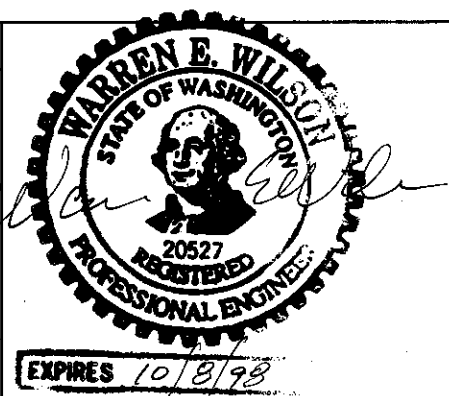

SR 405
BOTHELL TO SWAMP CREEK 1/C
HOV LANES - STAGE 1
NORTH CREEK BRIDGE 405/72 NBCD
CONSTRUCTION STAGING


BRIDGE SHEET NO. 2
SHEET 481 OF 663 SHEETS

24/145


REMOVAL OF PILES				
	PIER 1-E	PIER 2-E	PIER 3-E	PIER 4-E
'A'	6	10	11	9

GENERAL NOTES


- ALL MATERIAL AND WORKMANSHIP SHALL BE IN ACCORDANCE WITH THE REQUIREMENTS OF THE STATE OF WASHINGTON, DEPARTMENT OF TRANSPORTATION, STANDARD SPECIFICATIONS FOR ROAD, BRIDGE AND MUNICIPAL CONSTRUCTION METRIC DATED 1996, AND AMENDMENTS.
- THE REPLACEMENT AND WIDENED PORTION HAVE BEEN DESIGNED IN ACCORDANCE WITH THE REQUIREMENTS OF THE AASHTO STANDARD SPECIFICATIONS FOR HIGHWAY BRIDGES FIFTEENTH EDITION-1992 AND INTERIM SPECIFICATIONS THROUGH 1995. ALL STRUCTURAL ELEMENTS HAVE BEEN DESIGNED IN ACCORDANCE WITH LOAD FACTOR DESIGN. SEISMIC DESIGN OF THE REPLACEMENT AND WIDENED PORTION OF THIS STRUCTURE HAS BEEN DONE USING AN ACCELERATION COEFFICIENT OF 0.25 WITH A TYPE III SOIL PROFILE SPECTRUM.
- SUBSTRUCTURE DETAILS ARE SUBJECT TO CHANGE DEPENDING UPON FOUNDATION MATERIAL ENCOUNTERED. REINFORCING STEEL FOR PILES SHALL NOT BE CUT UNTIL FINAL ELEVATIONS HAVE BEEN DETERMINED AND SUBSTRUCTURE DETAILS HAVE BEEN MODIFIED, IF NECESSARY.
- CONCRETE IN THE PILES SHALL BE CLASS 28P, ALL OTHER CONCRETE EXCEPT WHERE SPECIFICALLY SHOWN ON THE PLAN, SHALL BE CLASS 28D.
- THE ULTIMATE CAPACITY FOR THE PILES FOR PIER 4-E IS 1320 kN AND 1590 kN FOR PIERS 2-E AND 3-E ON BRIDGE NO. 405/72E. THE ULTIMATE CAPACITY FOR THE PILES FOR PIERS 1 AND 4 IS 1420 kN AND THE ULTIMATE CAPACITY FOR PILES FOR PIERS 2 AND 3 IS 1900 kN ON BRIDGE NO. 405/72 NBCD. A DOWDRAG FORCE OF 230 kN FOR THE 355Ø CIP CONCRETE PILES AND 300 kN FOR THE 460Ø CIP CONCRETE PILES WAS INCLUDED IN THE ULTIMATE CAPACITY. A FACTOR OF SAFETY OF 2.5 WAS USED IN THE DETERMINATION OF THE ULTIMATE CAPACITY.
- FALSEWORK SHALL BE CAREFULLY RELEASED TO PREVENT IMPACT OR UNDUE STRESS IN THE STRUCTURE. THE TRAFFIC BARRIER SHALL NOT BE PLACED UNTIL THE FALSEWORK HAS BEEN RELEASED.
- ALL EXISTING DIMENSIONS AND ELEVATIONS SHALL BE MEASURED IN THE FIELD BY THE CONTRACTOR PRIOR TO ORDERING OR FABRICATING ANY MATERIAL. (SEE SPECIAL PROVISIONS.)
- UNLESS OTHERWISE SHOWN ON THE PLANS, CLEAR CONCRETE COVER FROM THE TOP OF THE ROADWAY SLAB TO ANY REINFORCEMENT SHALL BE 65, 25 FROM THE BOTTOM OF THE ROADWAY SLAB, 75 FROM THE BOTTOM OF THE PILES, 190 FROM BOTTOM OF FOOTINGS WITH PILES, AND 40 FROM ALL OTHER CONCRETE SURFACES.

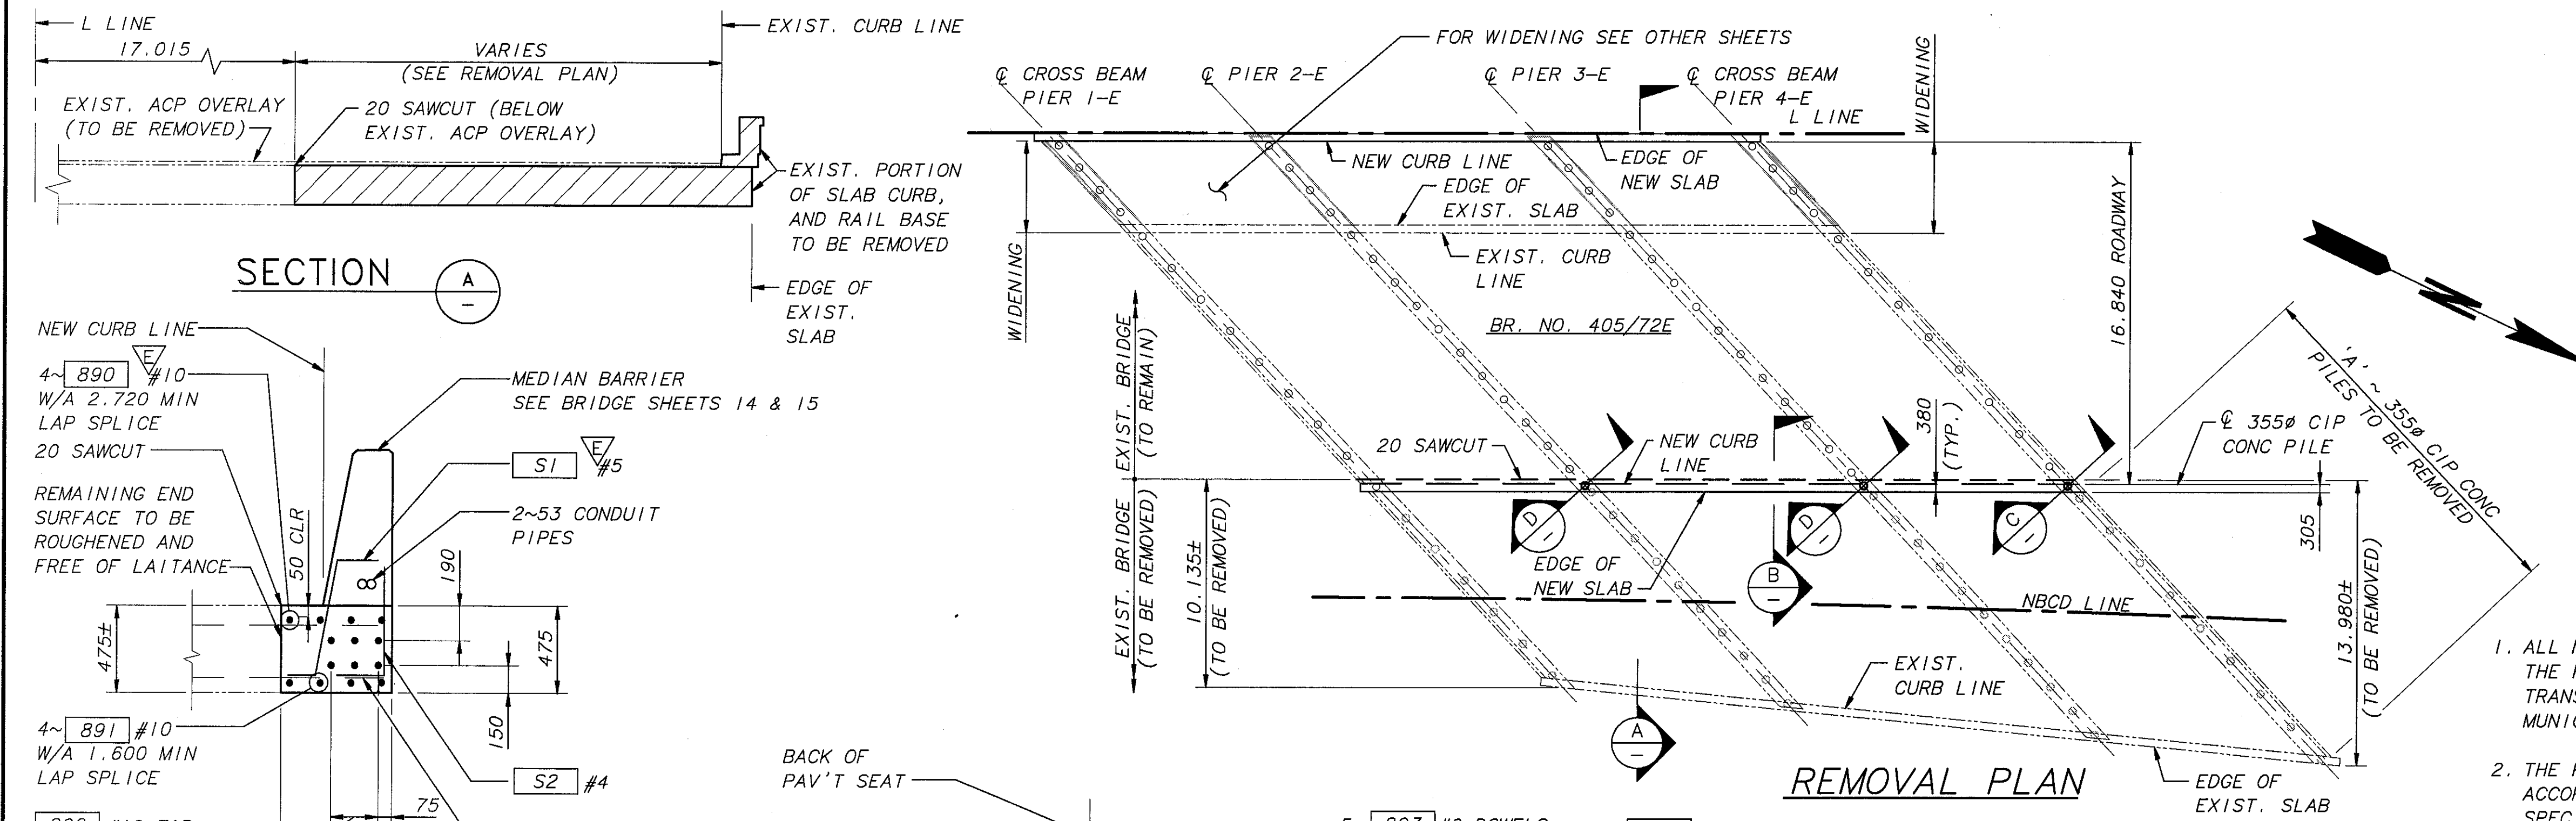


SECTION A

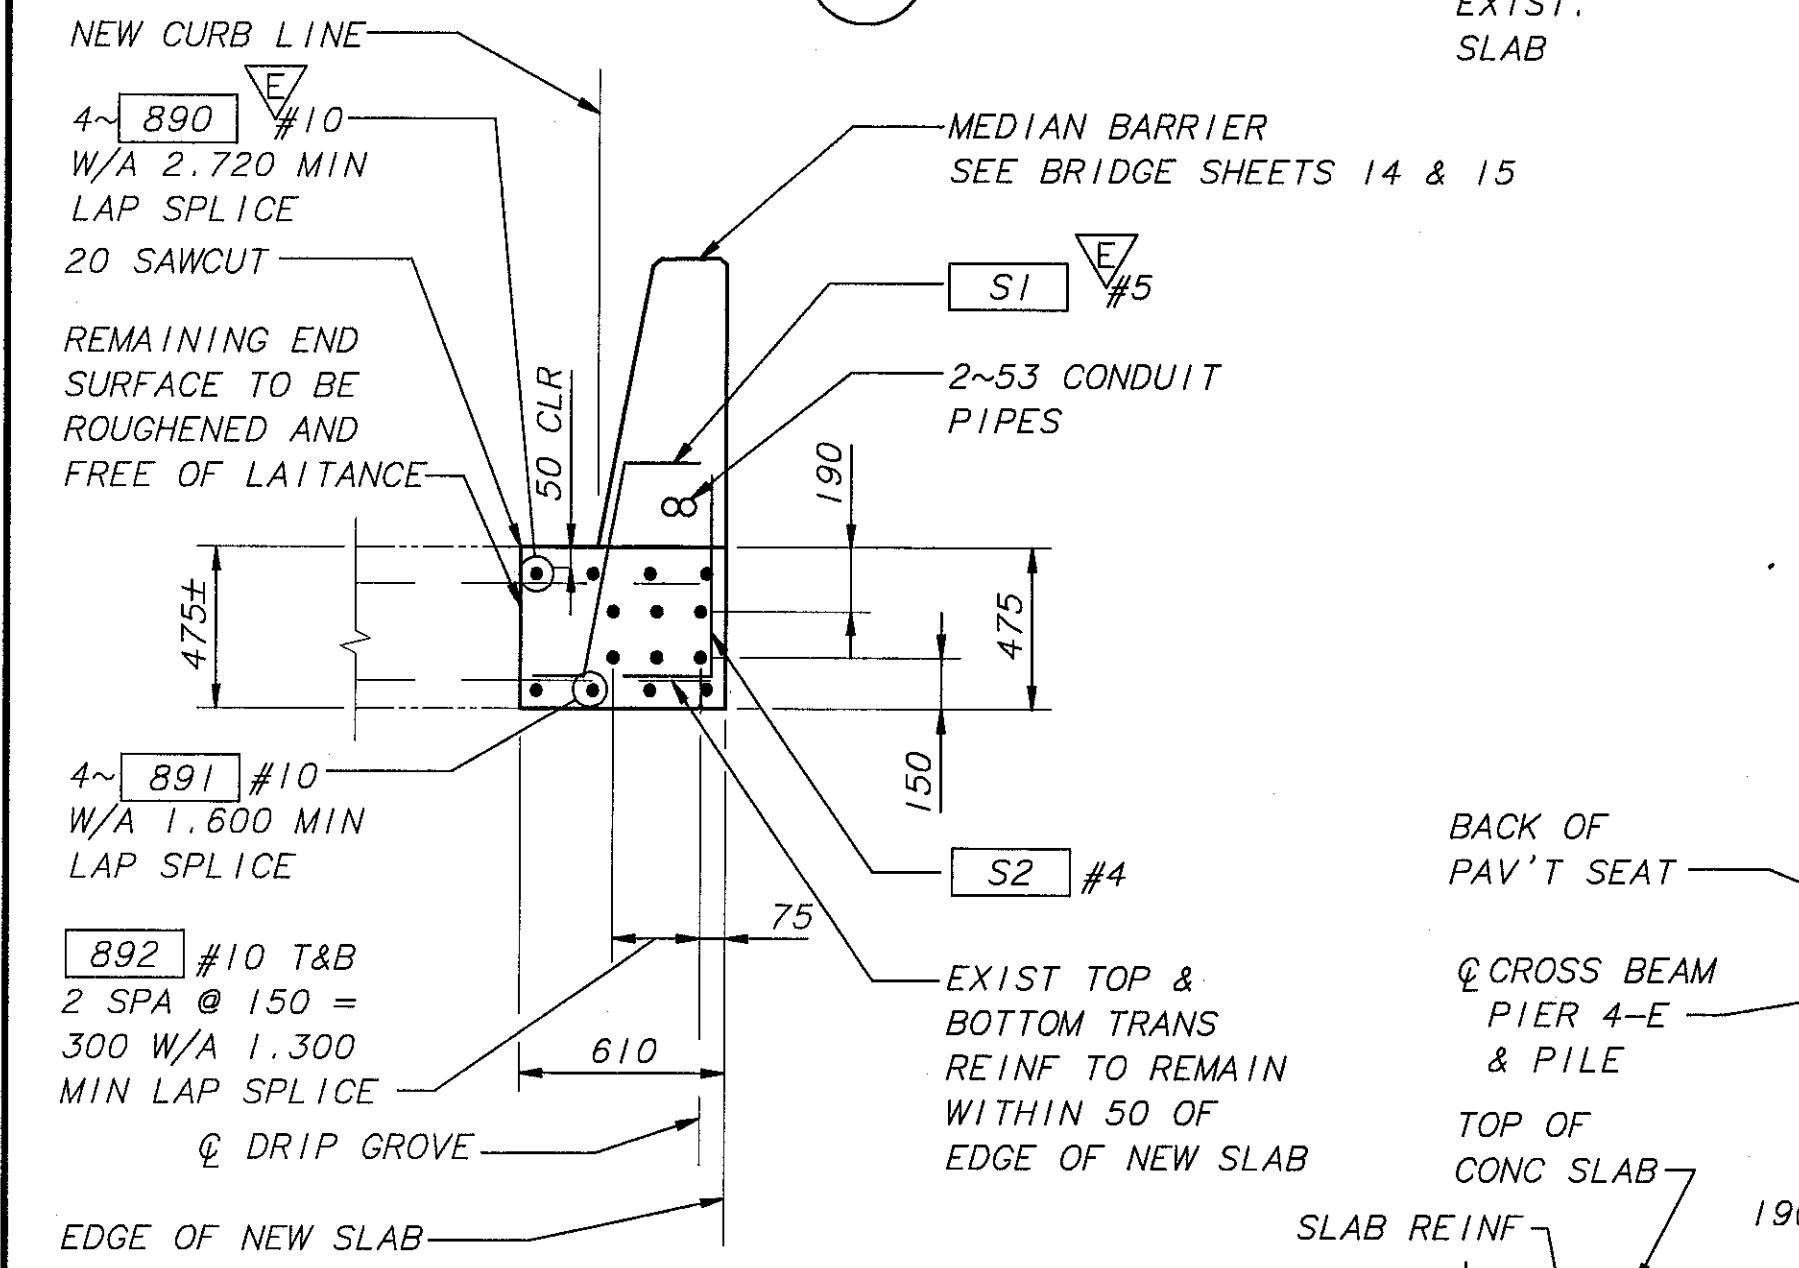

SECTION B

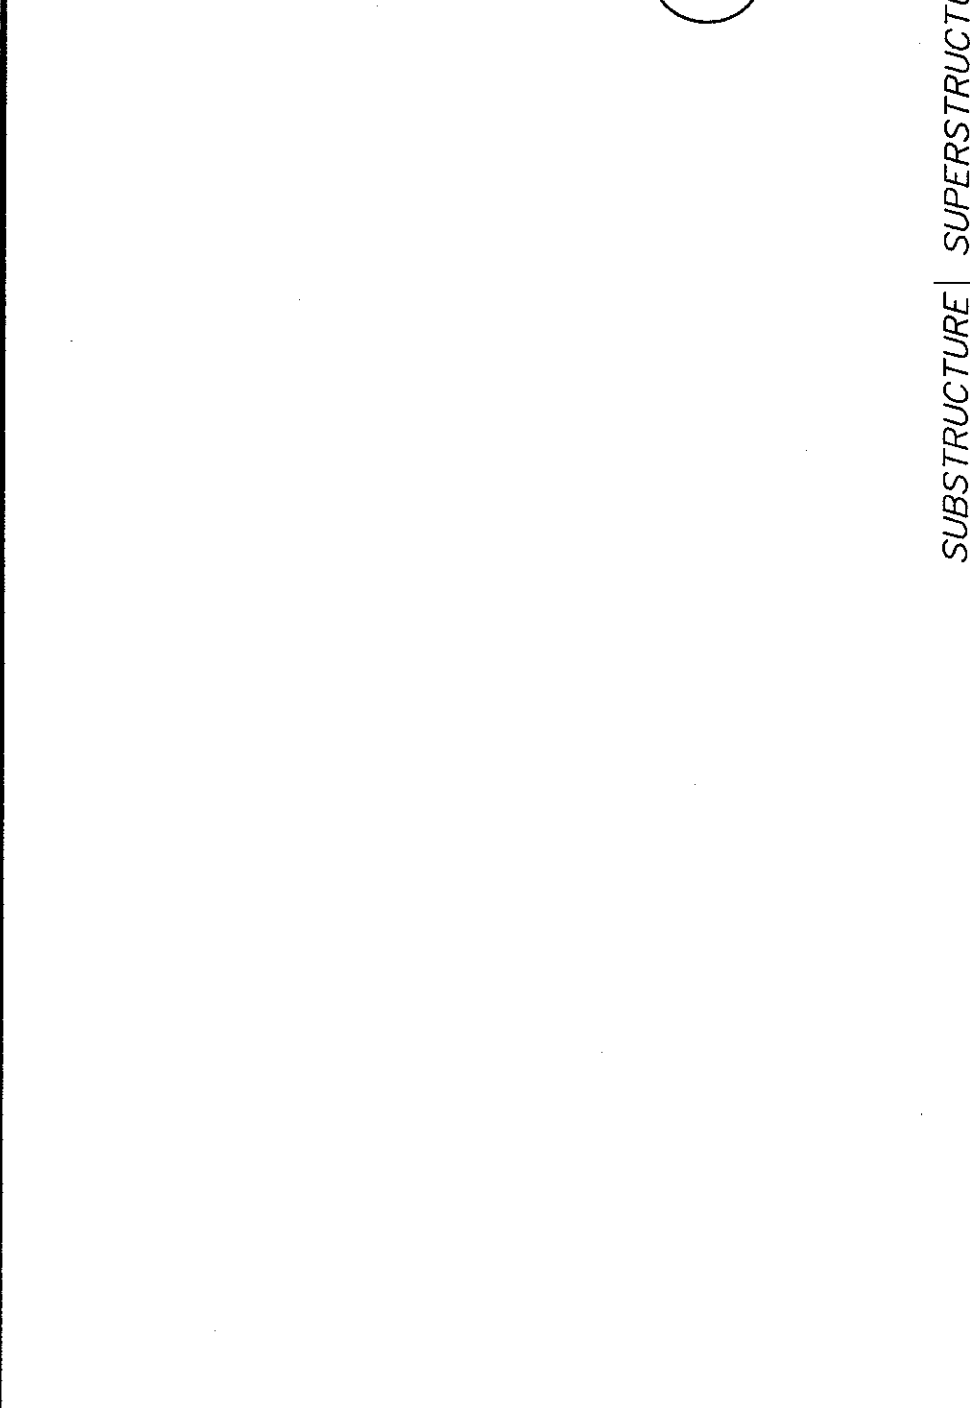


REMOVAL PLAN

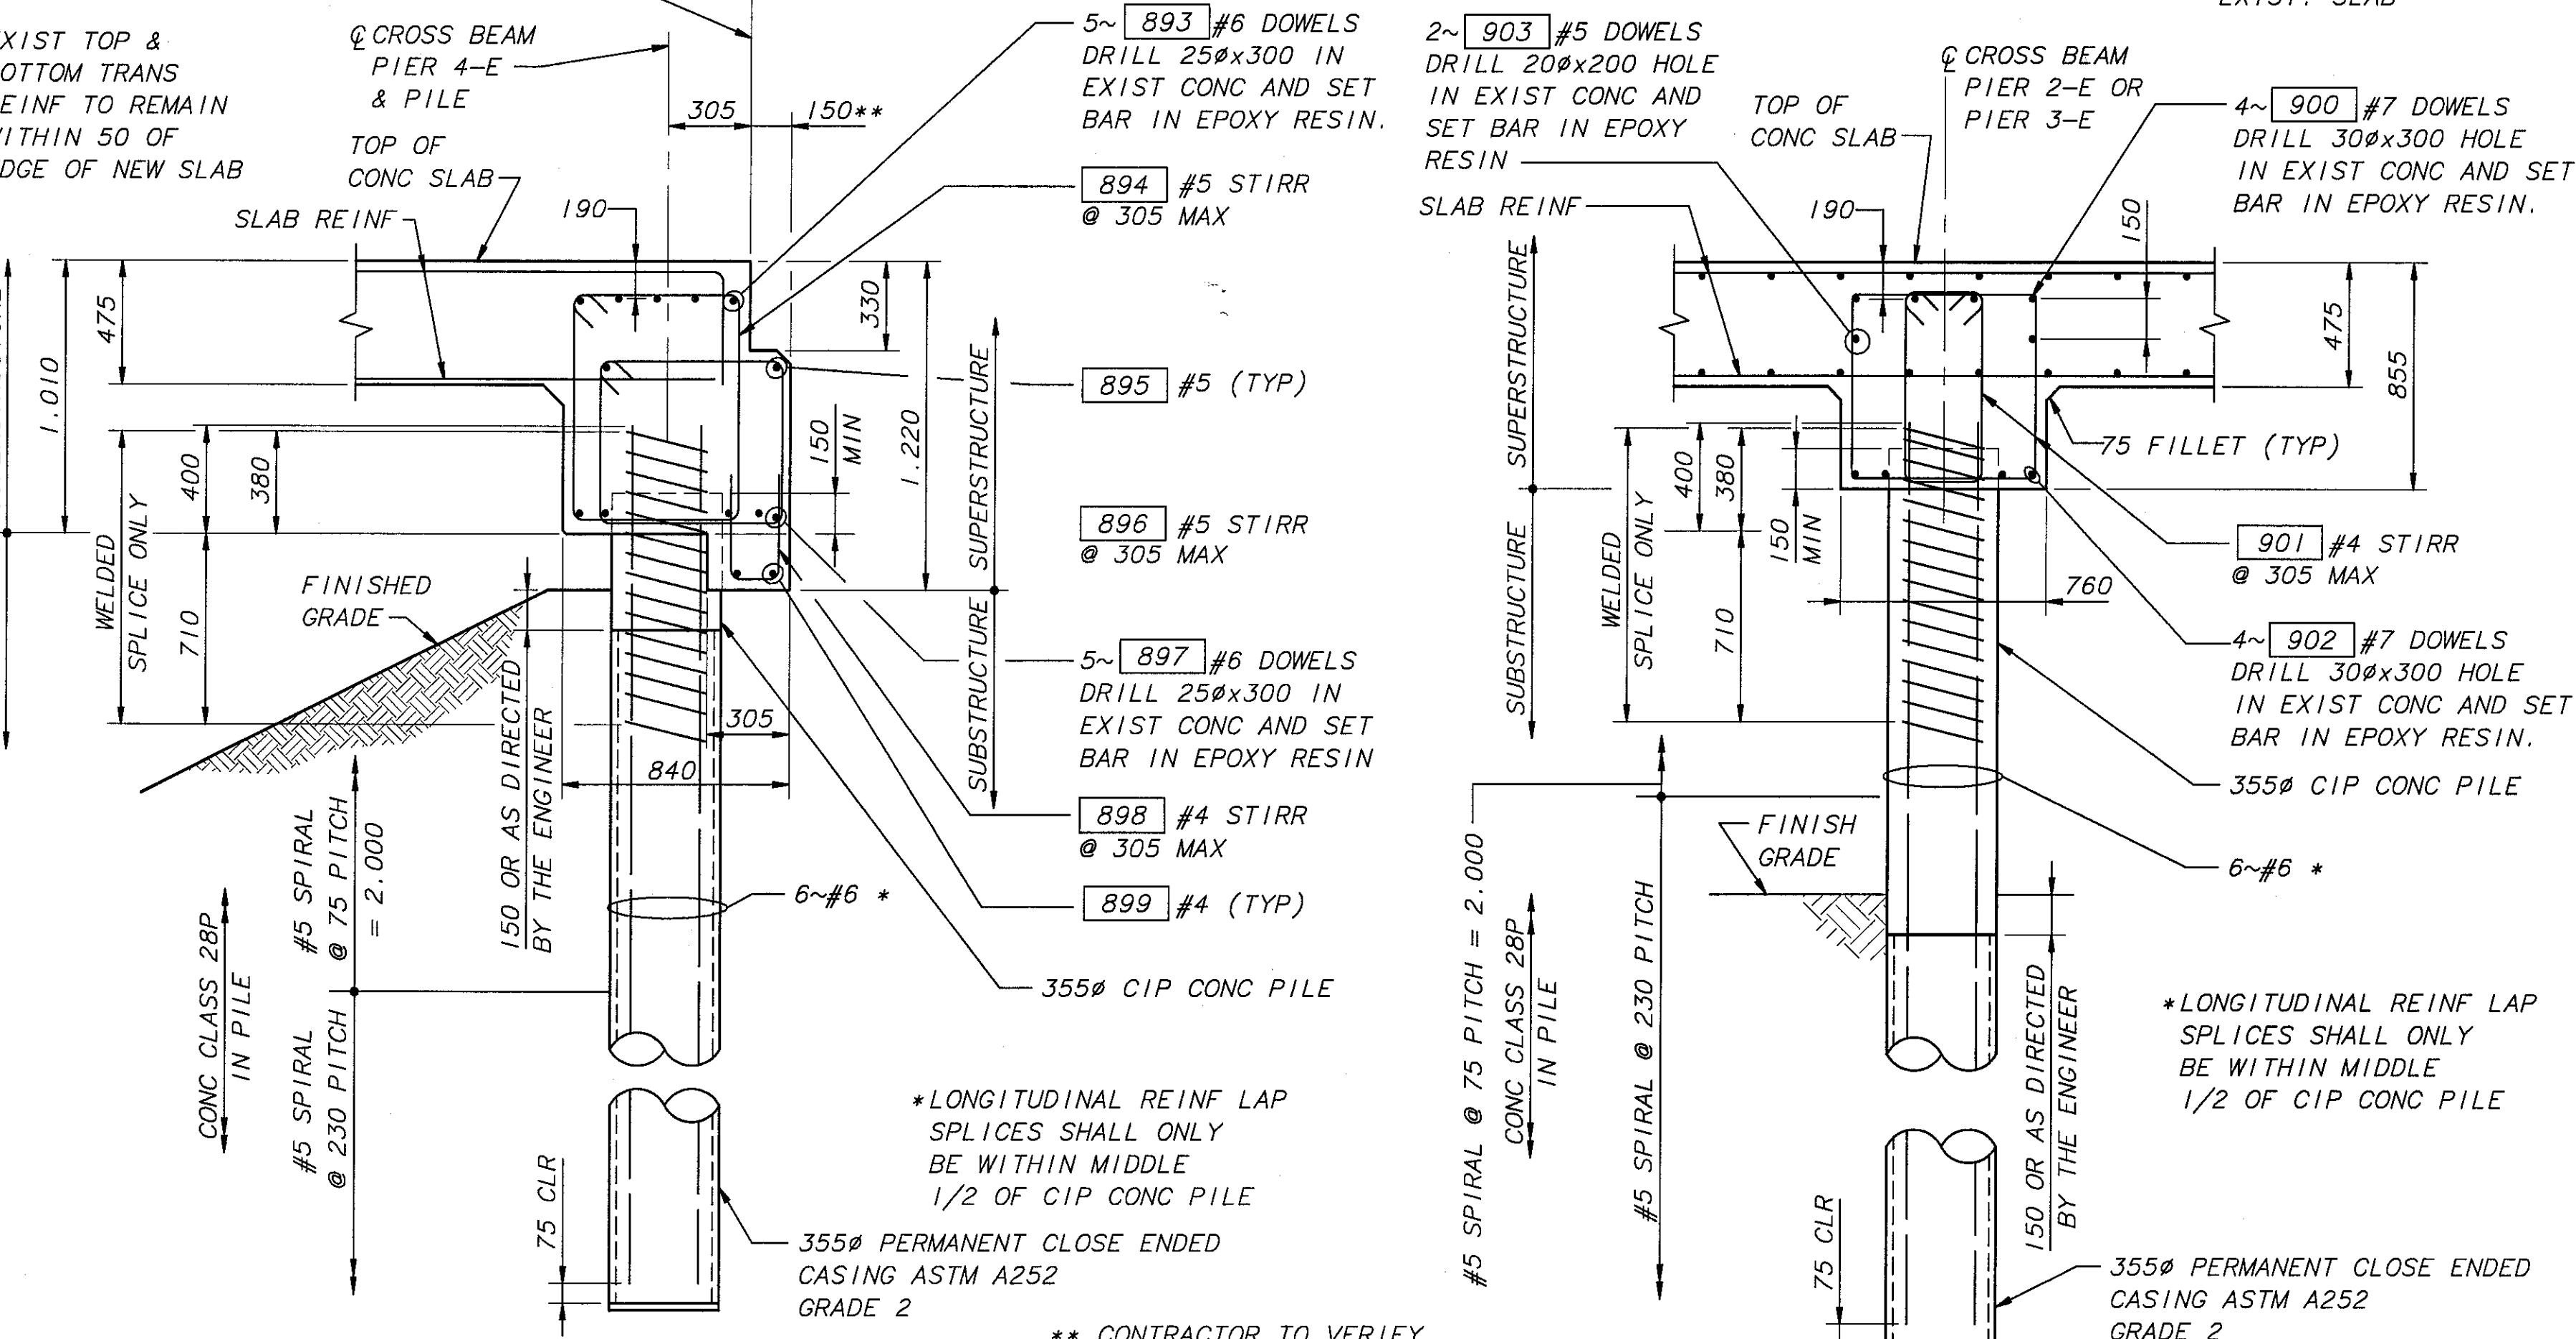


SECTION C

NOTE: SEE BRIDGE SHEET 14 FOR PLACEMENT OF 2-53 DIAMETER CONDUITS AT END PIER.

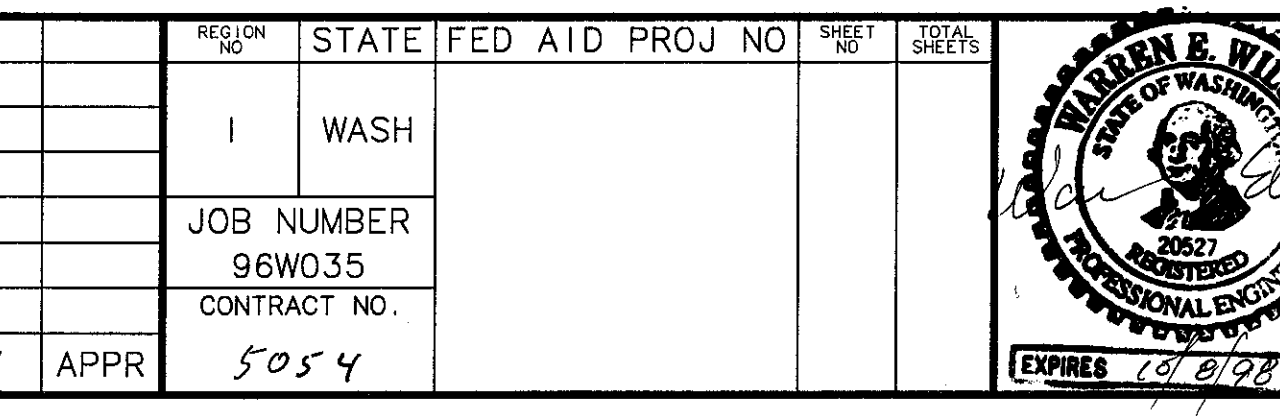

SECTION D

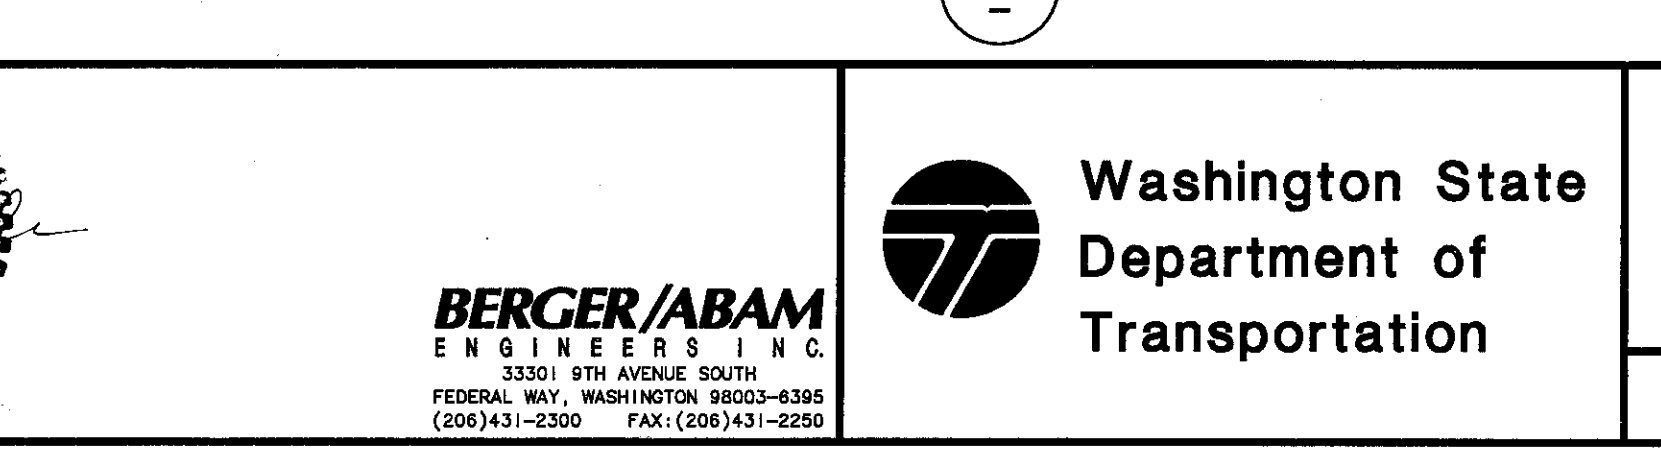


** CONTRACTOR TO VERIFY THAT DIMENSIONS MATCH EXISTING MEMBER SIZES

* LONGITUDINAL REINF LAP SPLICES SHALL ONLY BE WITHIN MIDDLE 1/2 OF CIP CONC PILE

* LONGITUDINAL REINF LAP SPLICES SHALL ONLY BE WITHIN MIDDLE 1/2 OF CIP CONC PILE

PLOTTED: Tue Nov 12 1996 11:36am FILENAME: X:\196077\BR72\NBCD\3.DWG SCALE: 100
 SR 405 JOB NO. 7071 SHEET 3 OF 19

BRIDGE DESIGN ENGR		REGION NO.	STATE	FED AID PROJ NO.	SHEET NO.	TOTAL SHEETS
SUPERVISOR		1	WASH			
DESIGNED BY	K. HINKLEY	6/96		JOB NUMBER	96W035	
CHECKED BY	C. CORNELL	6/96		CONTRACT NO.	5054	
DETAILED BY	T. BRENNAN	6/96				
BRIDGE PROJECTS ENGR						
PRELIM PLAN BY						
ARCHITECT/SPECIALIST						
DATE		REVISION		BY	APPR	

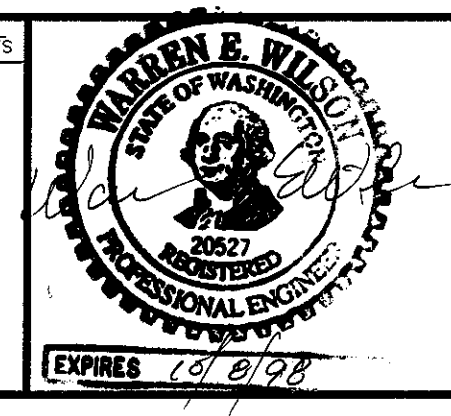


BERGER/ABAM
 ENGINEERS INC.
 3330 9TH AVENUE SOUTH
 FEDERAL WAY, WASHINGTON 98003-6395
 (206)431-2300 FAX: (206)431-2250




SR 405
 BOTHELL TO SWAMP CREEK I/C
 HOV LANES - STAGE 1
 NORTH CREEK BRIDGE 405/72 NBCD
 REMOVAL PLAN & DETAILS

BRIDGE SHEET NO.	3
SHEET	482
OF	663
SHEETS	

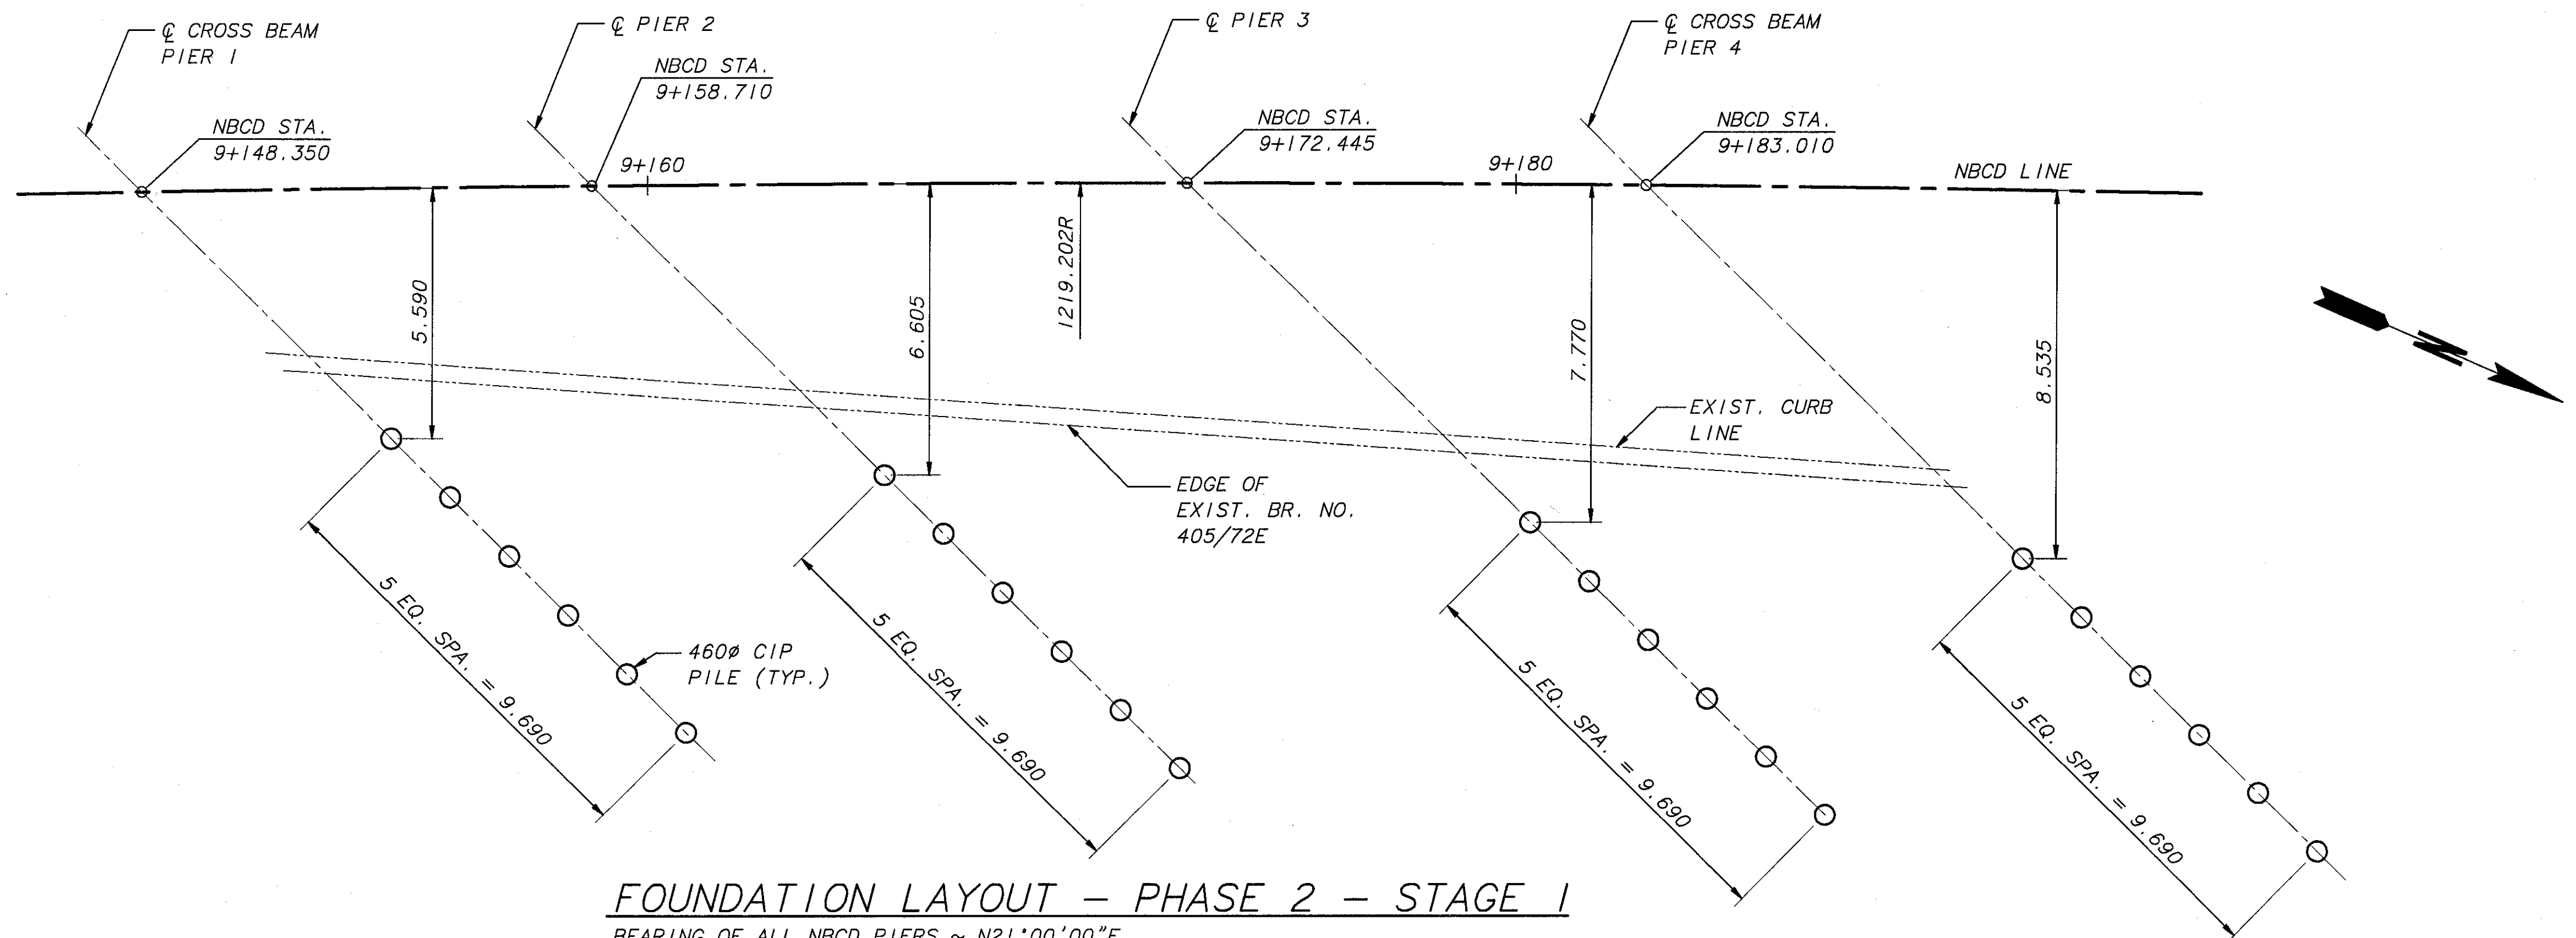

FOUNDATION LAYOUT - PHASE 2 - STAGE 1

BEARING OF ALL NB CD PIERS ~ N21°00'00"E

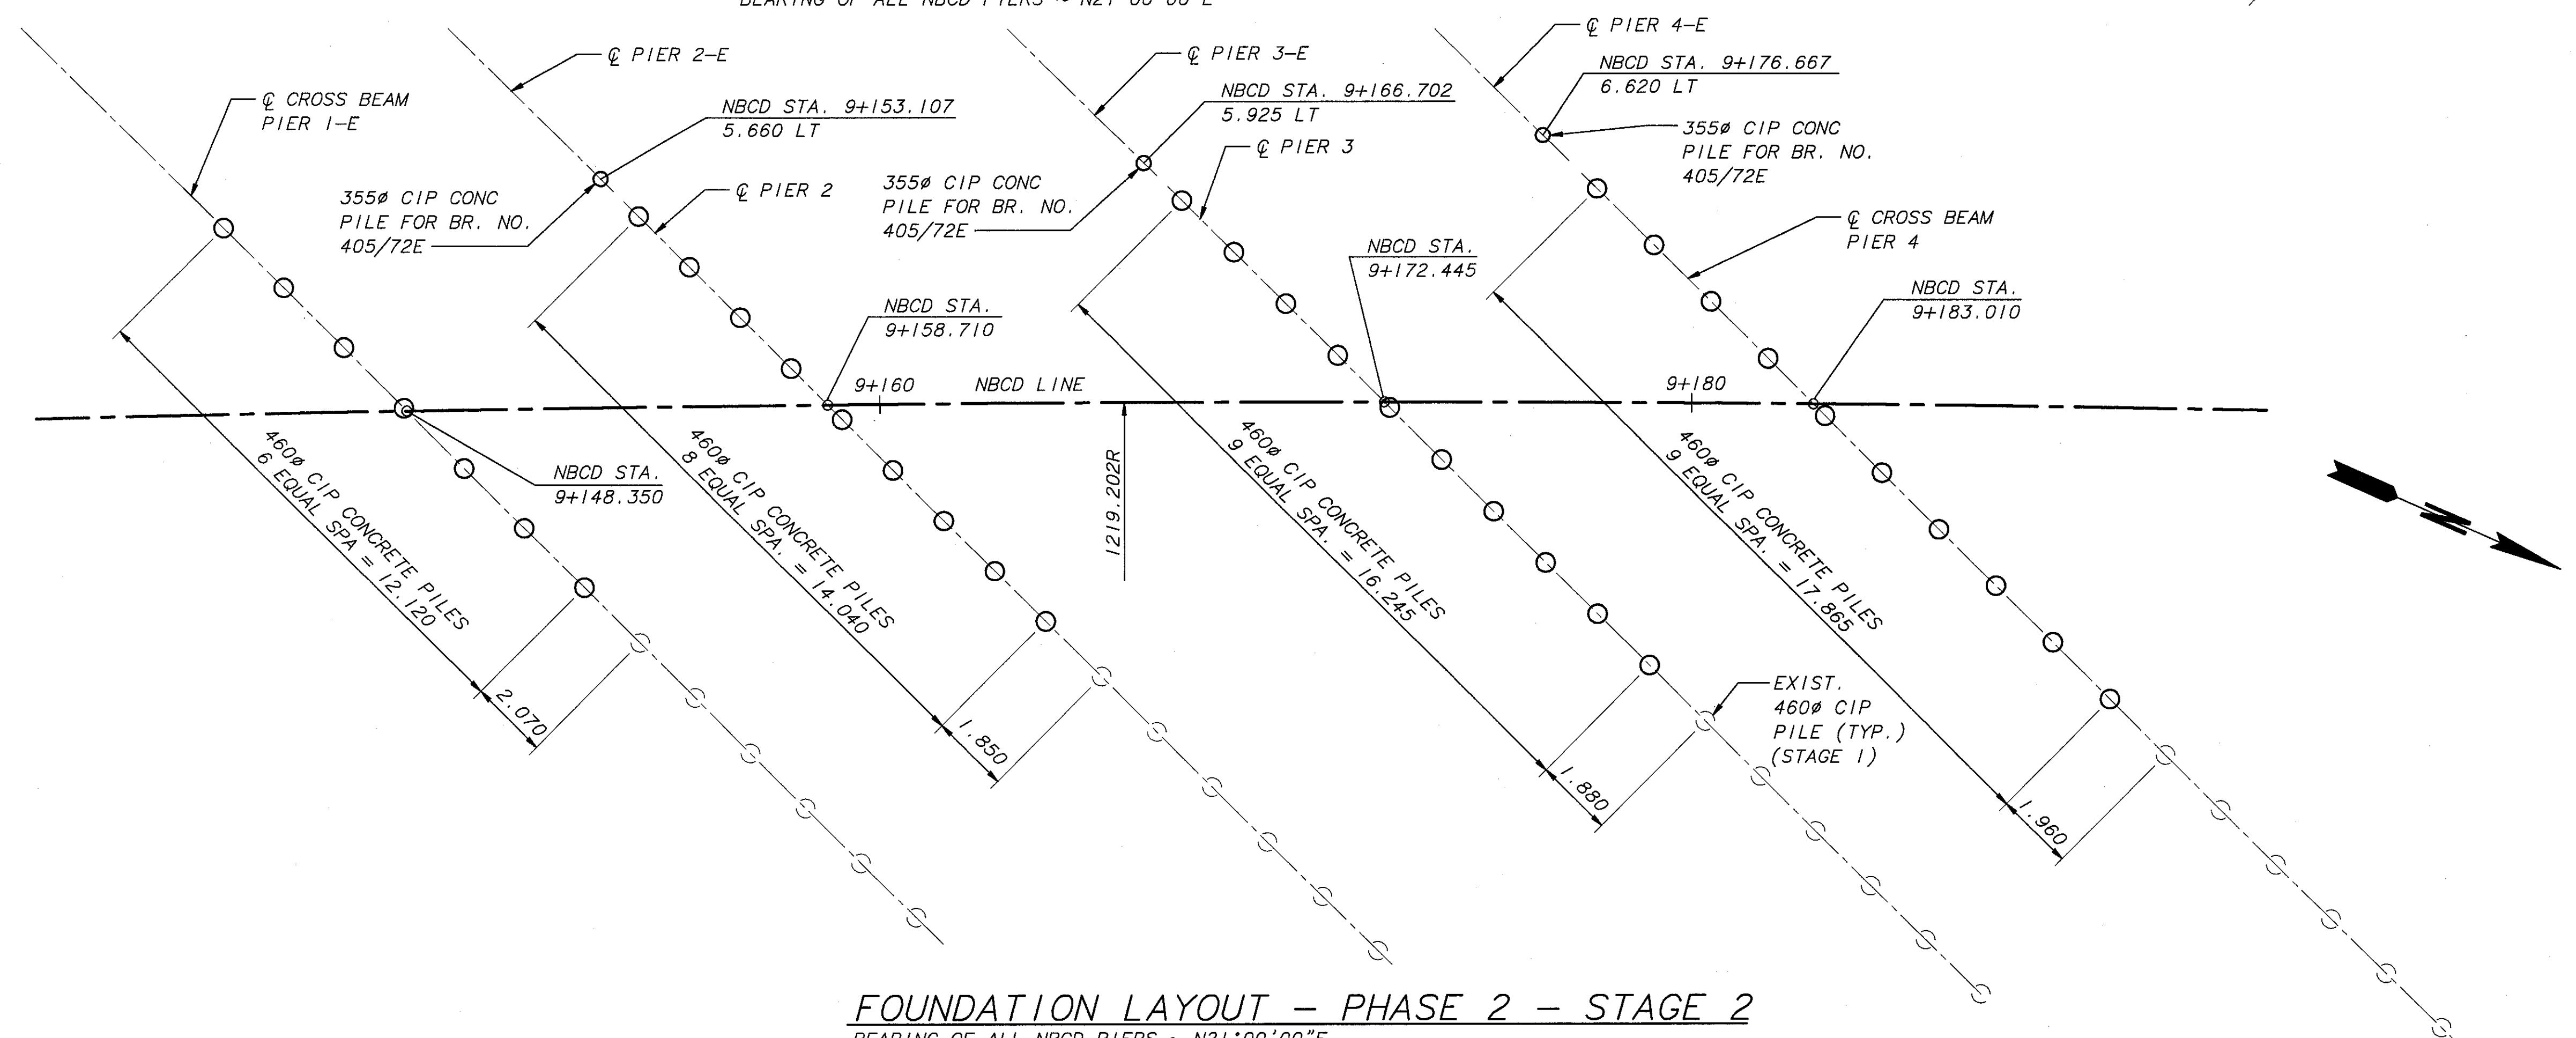


FOUNDATION LAYOUT - PHASE 2 - STAGE 2

BEARING OF ALL NB CD PIERS ~ N21°00'00"E

PLOTTED: Tue Nov 12 1996 11:37am FILENAME: X:\496077\BR72\NB CD\4-DWG SCALE: 100 SR 405 JOB NO. 7071 SHEET 4 OF 19

BRIDGE DESIGN ENGR					
SUPERVISOR					
DESIGNED BY	K. HINKLEY	6/96			
CHECKED BY	C. CORNELL	6/96			
DETAILED BY	T. BRENNAN	6/96			
BRIDGE PROJECTS ENGR					
PRELIM PLAN BY					
ARCHITECT/SPECIALIST					
DATE	REVISION	BY	APPR		




REGION NO.	STATE	FED AID PROJ NO.	SHEET NO.	TOTAL SHEETS
1	WASH			
JOB NUMBER		96W035		
CONTRACT NO.		5054		

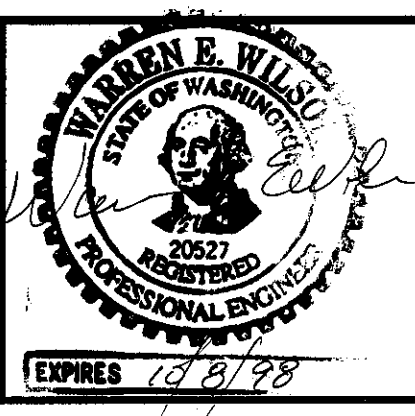



BERGER/ABAM
ENGINEERS INC.
33301 9TH AVENUE SOUTH
FEDERAL WAY, WASHINGTON 98003-4395
(206)431-2300 FAX: (206)431-2250



SR 405	BRIDGE SHEET NO. 4
BOTHELL TO SWAMP CREEK I/C	SHEET 483 OF 663 SHEETS
HOV LANES - STAGE 1	
NORTH CREEK BRIDGE 405/72 NB CD	
FOUNDATION LAYOUT	

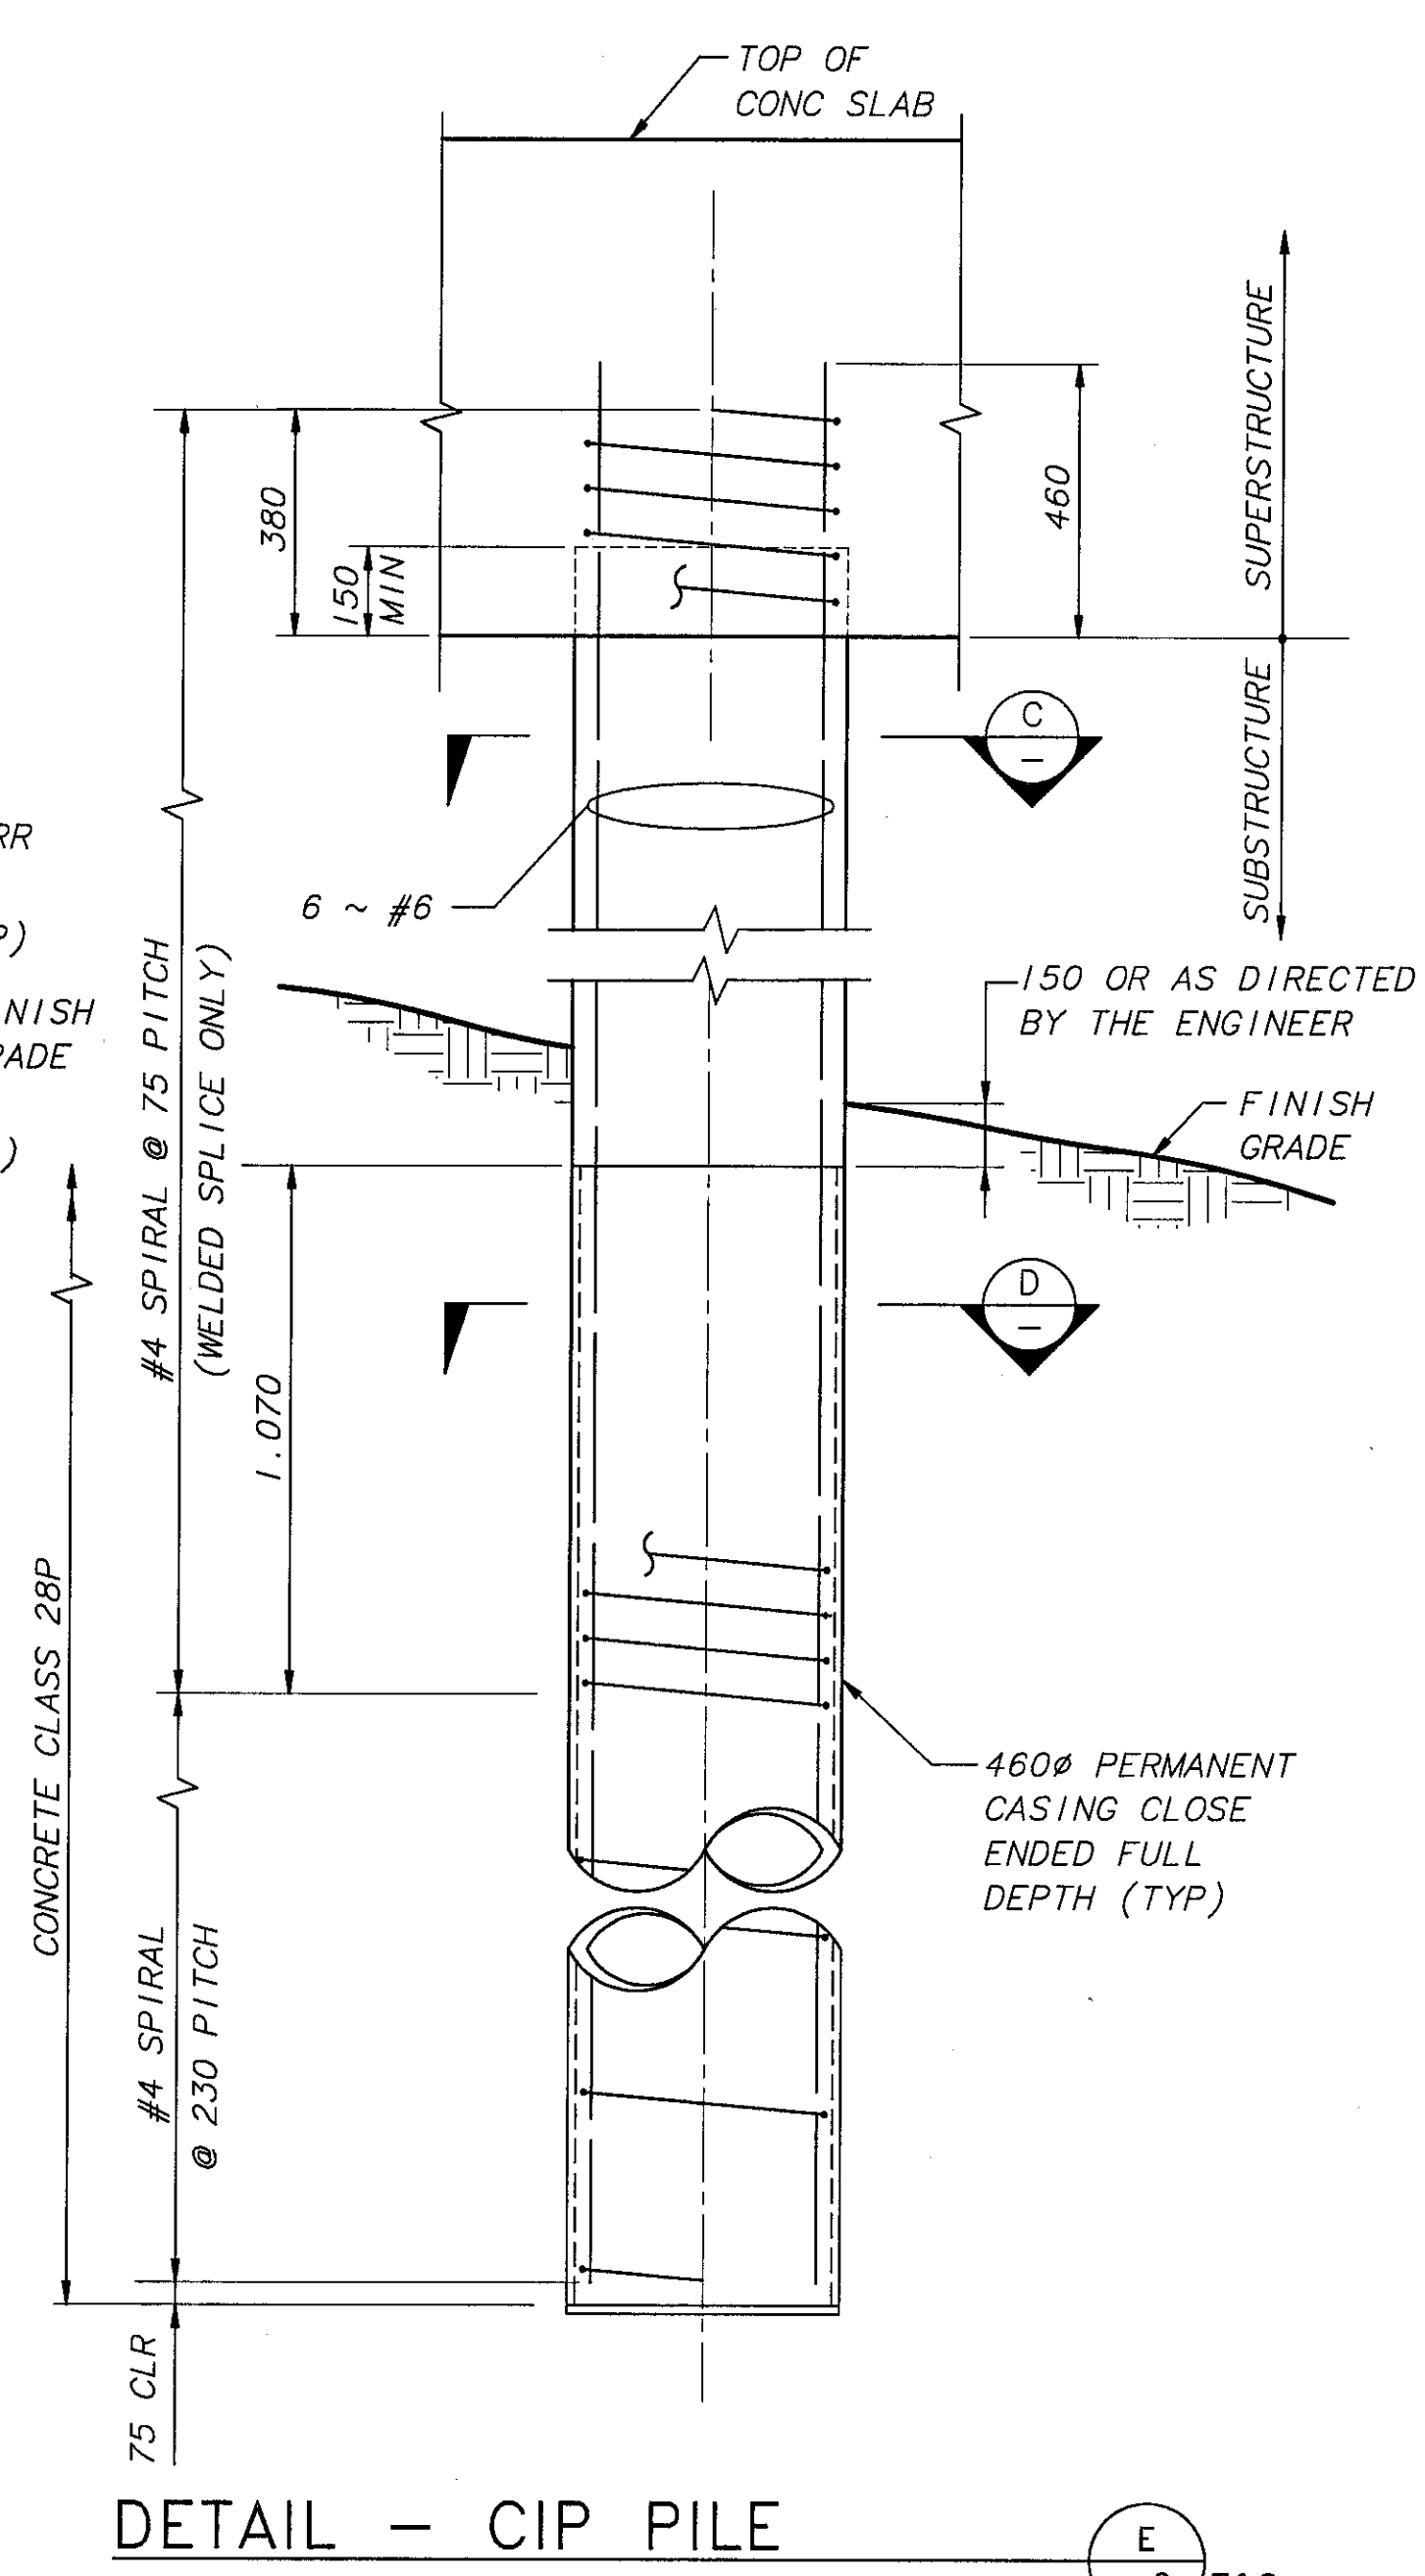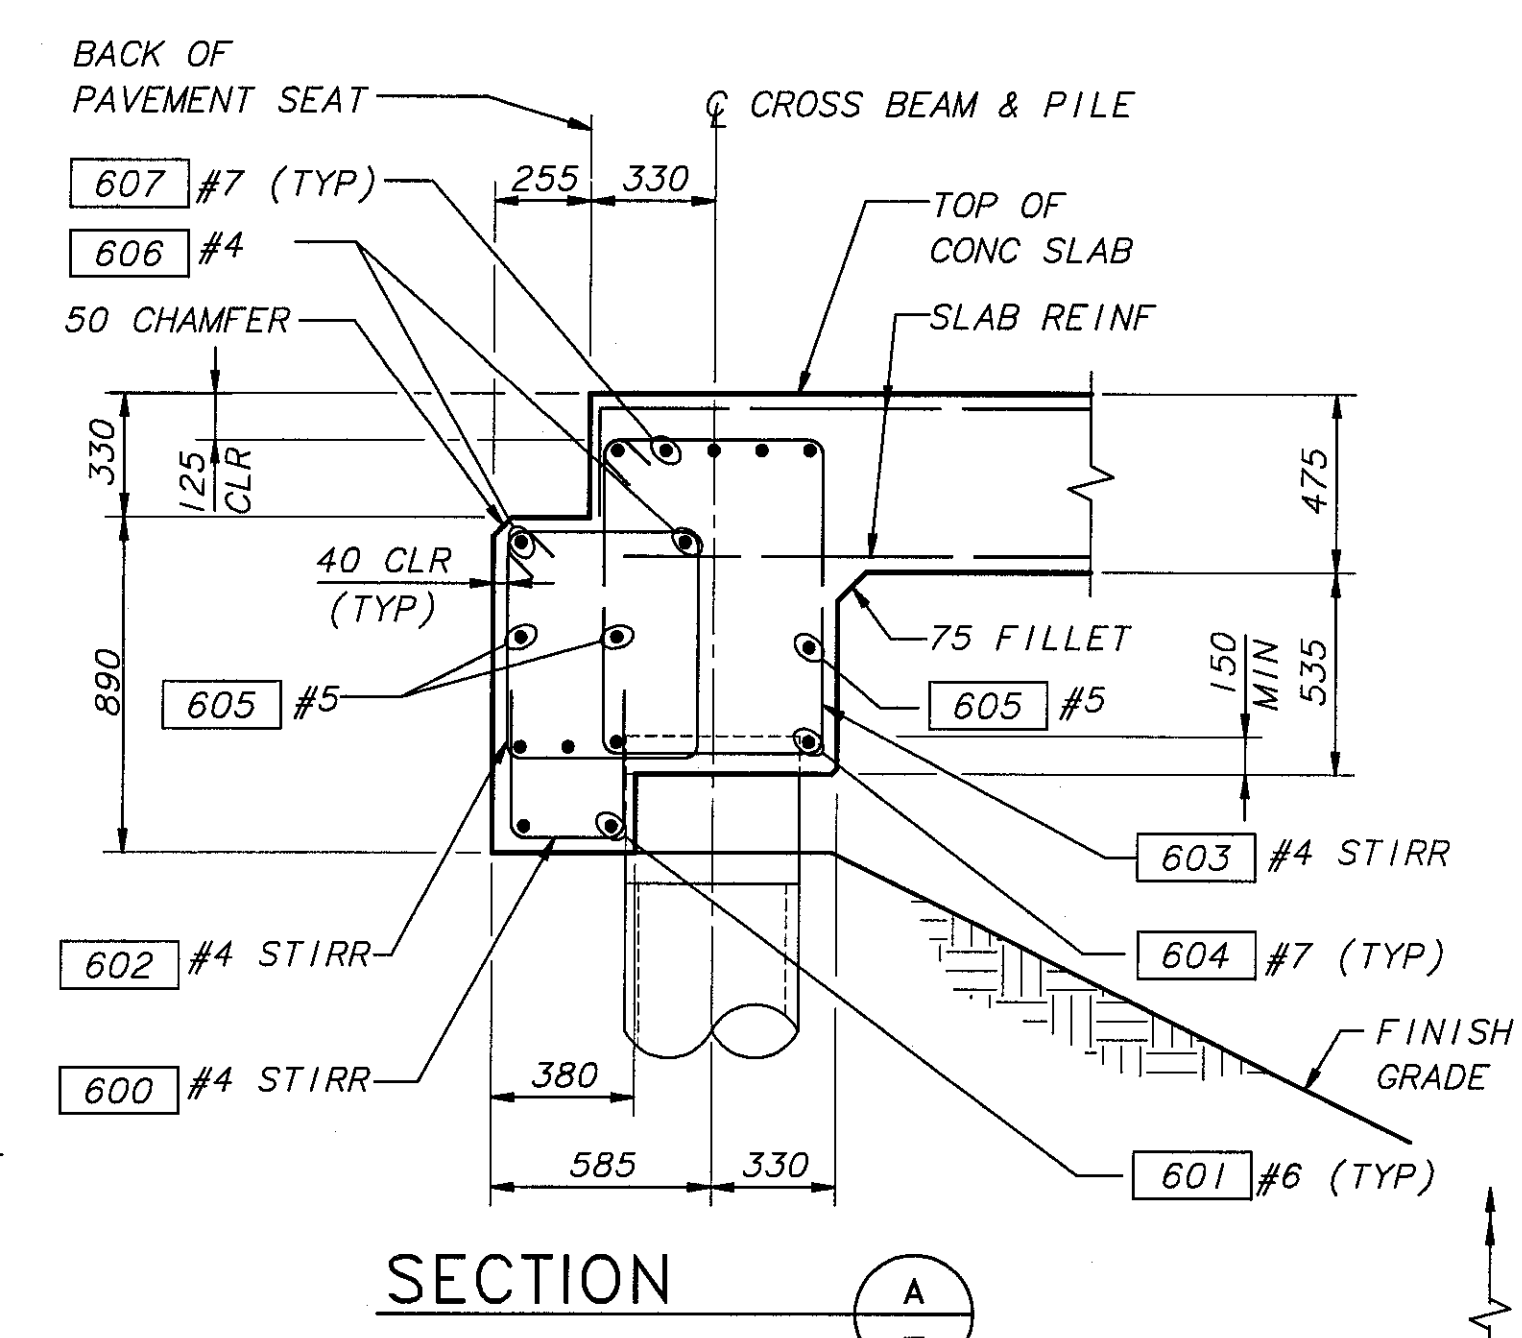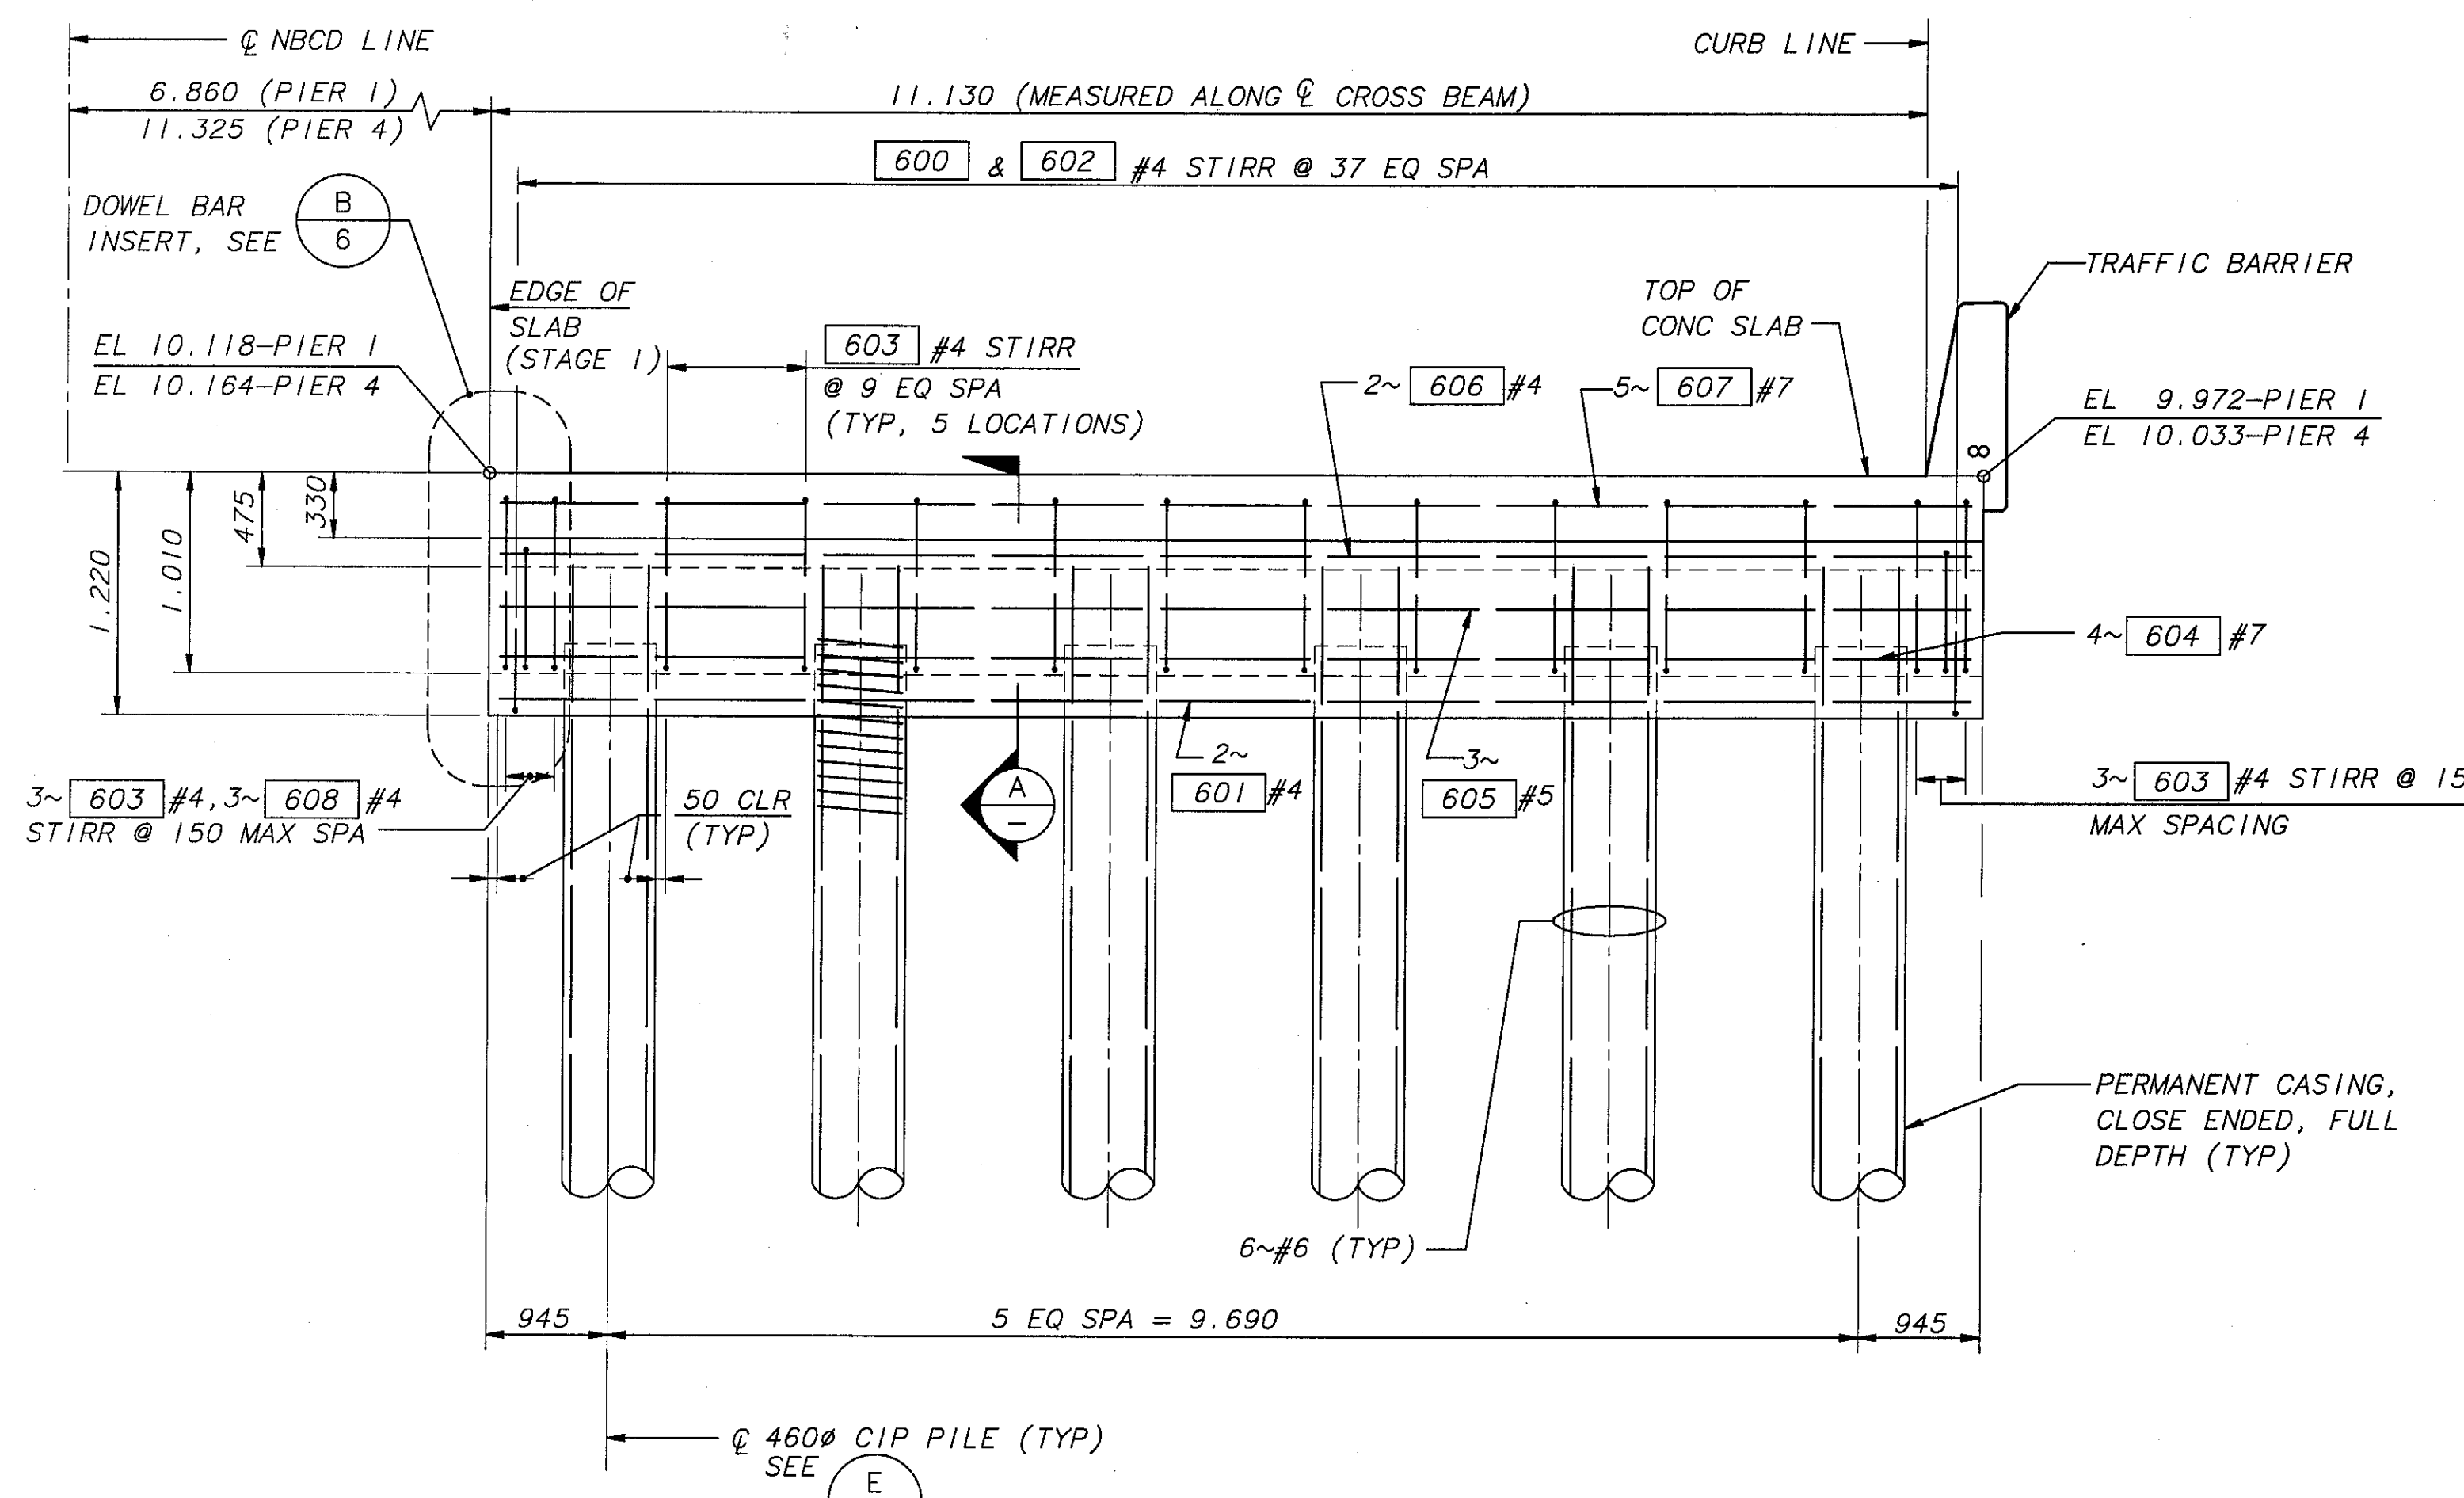


SPIRAL ALTERNATIVES			
DEFORMED BARS	PLAIN SMOOTH BARS	COLD DRAWN WIRE	DEFORMED WIRE
#4	13 ϕ	W20	D20

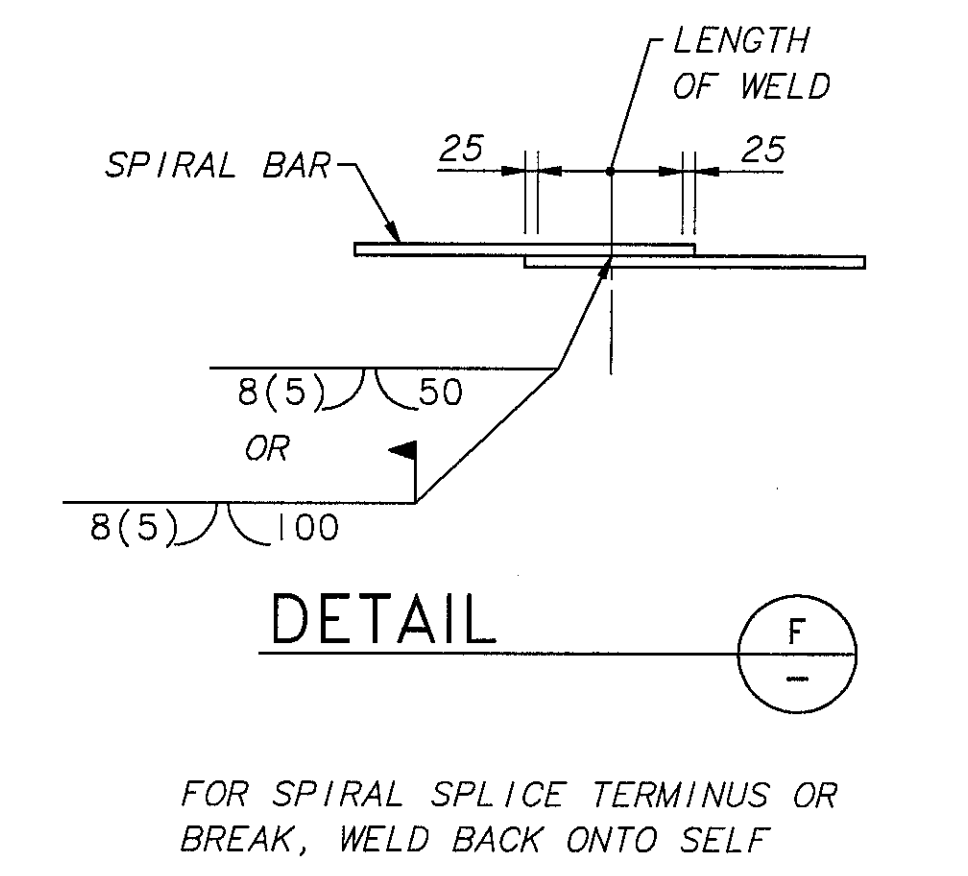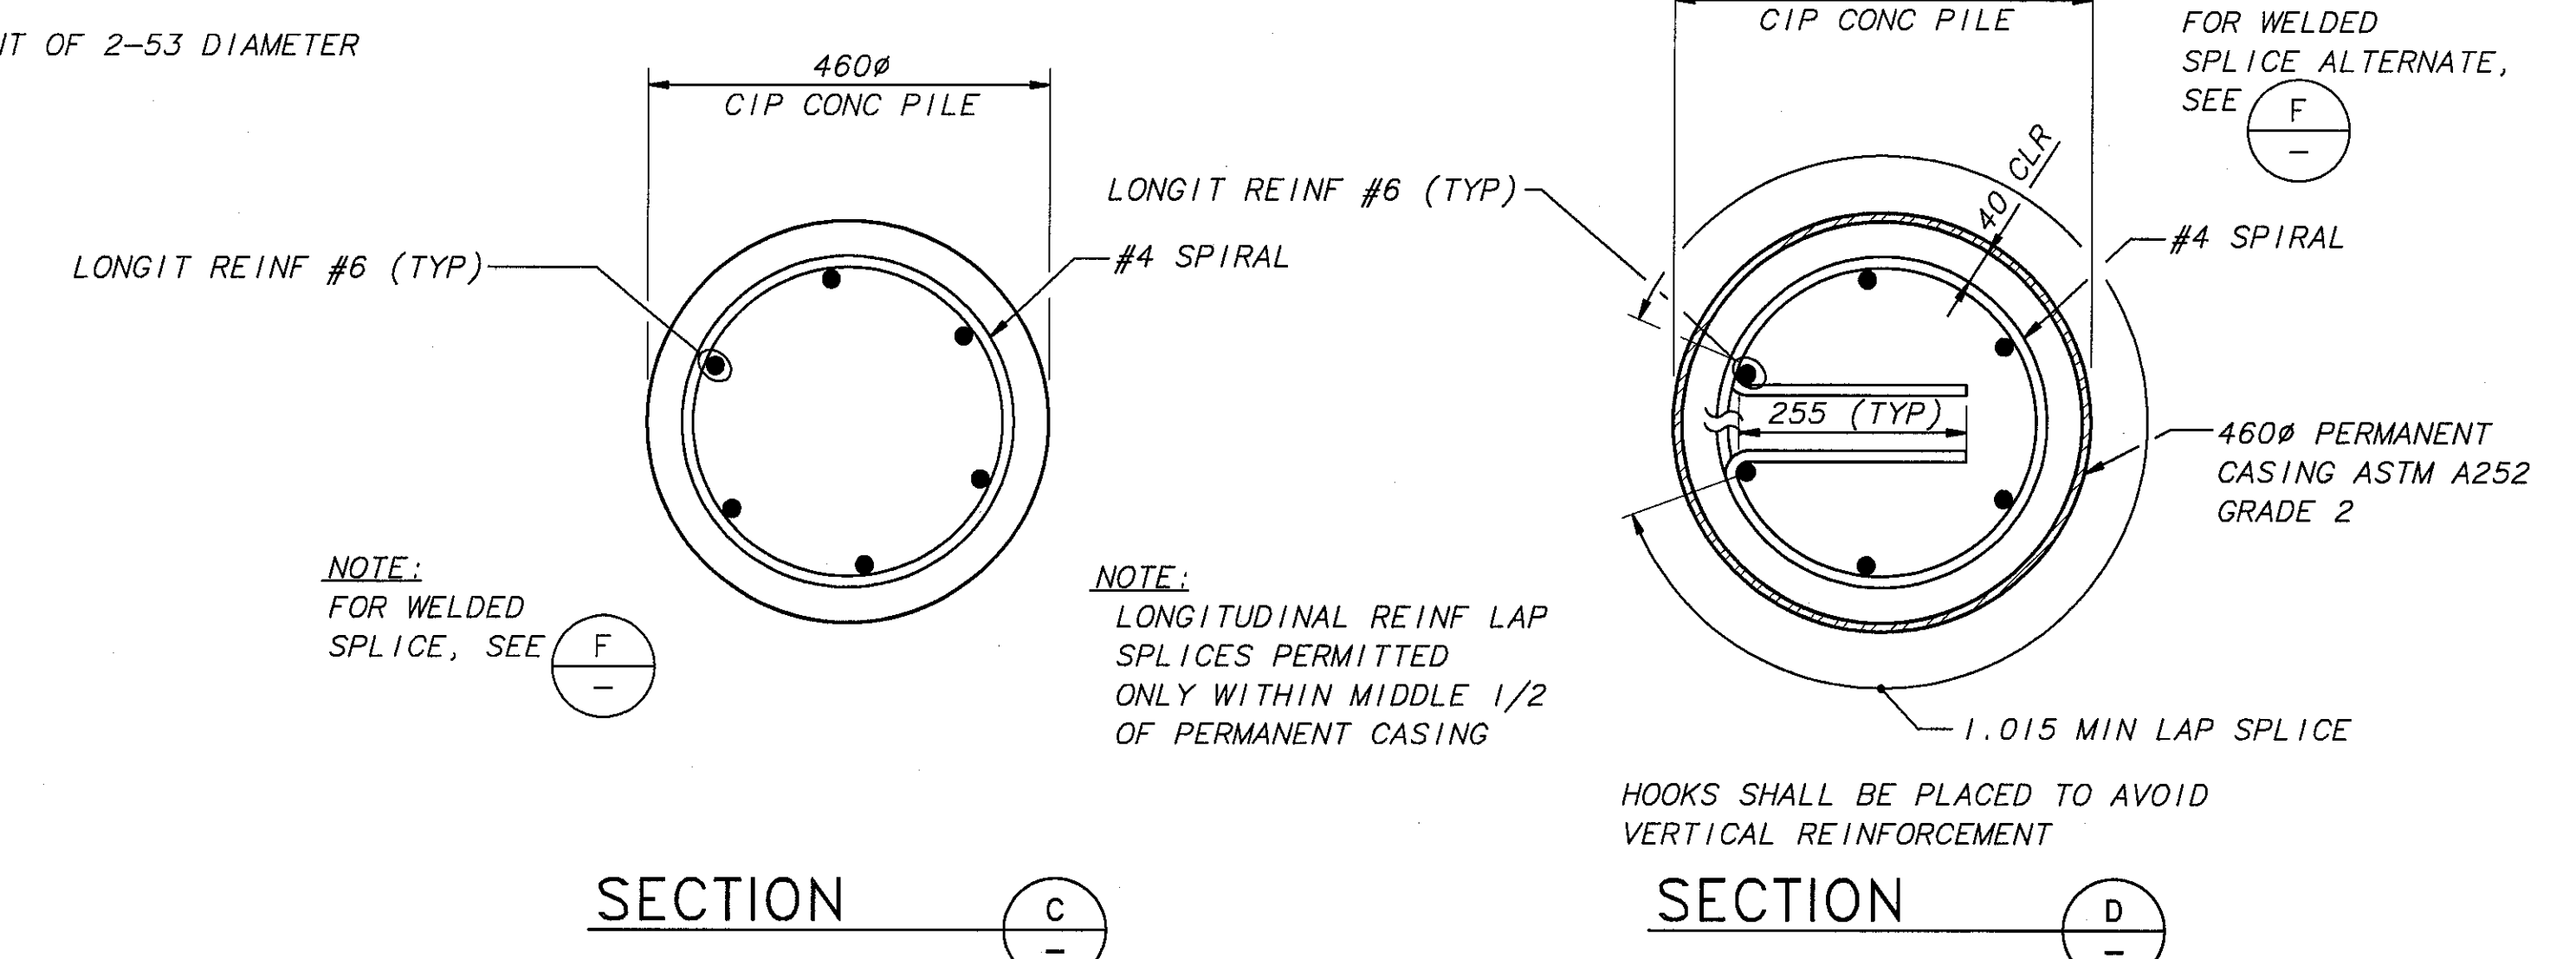

PLOTTED: Tue Nov 12 1996 11:38am FILENAME: X:\196077\BR72\WBDC\5.DWG SCALE: 30
 SR 405 JOB NO. 7071 SHEET 5 OF 19



BRIDGE DESIGN ENGR		REGION NO.	STATE	FED AID PROJ NO.	SHEET NO.	TOTAL SHEETS			SR 405 BOTHELL TO SWAMP CREEK I/C HOV LANES - STAGE 1 NORTH CREEK BRIDGE 405/72 NBDC PIER 1 & 4 STAGE 1	BRIDGE SHEET NO.
SUPERVISOR		I	WASH							5
DESIGNED BY	K. HINKLEY 6/96	JOB NUMBER							SHEET 484 OF 663 SHEETS	
CHECKED BY	C. CORNELL 6/96	CONTRACT NO.								
DATE		5054								

2111A2

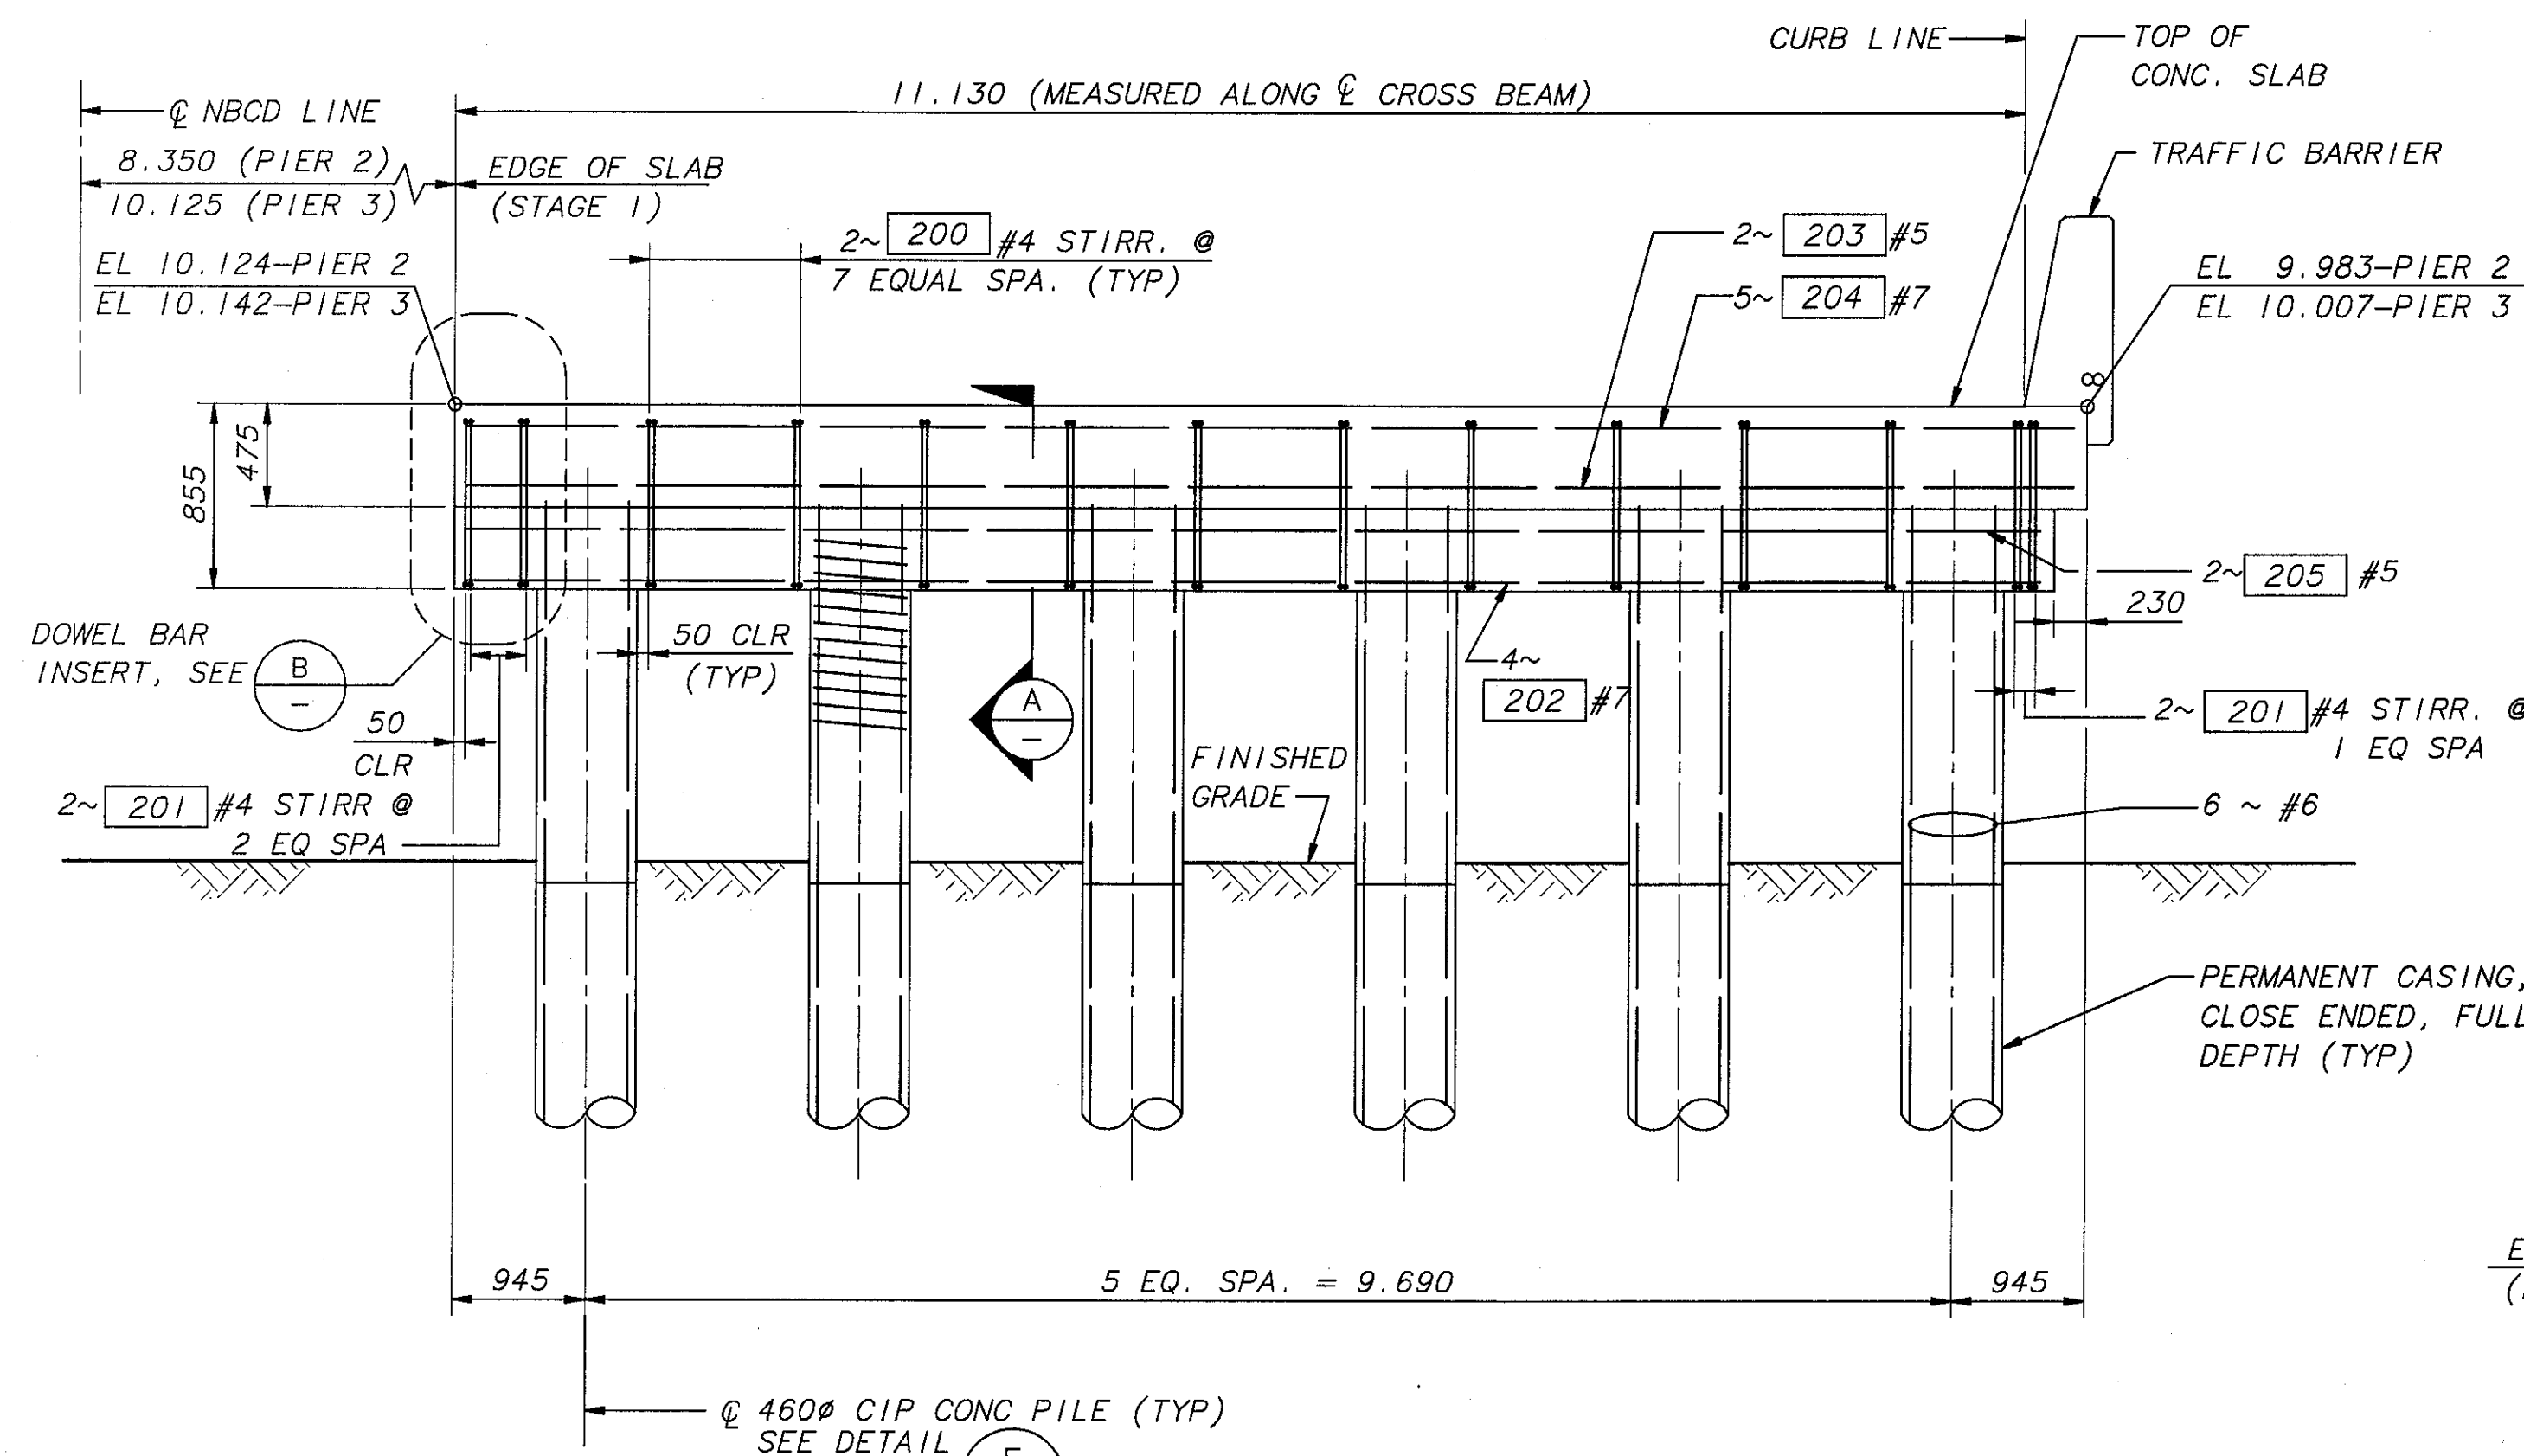


ELEVATION - PIER 2 & 3 (PHASE 2 - STAGE 1)
(LOOKING AHEAD ON STATION)

NOTE: ALL SUBSTRUCTURE DIMENSIONS ARE MEASURED ALONG ϕ CROSS BEAM UNLESS NOTED OTHERWISE.
ALL ELEVATIONS ARE AT ϕ CROSS BEAM.

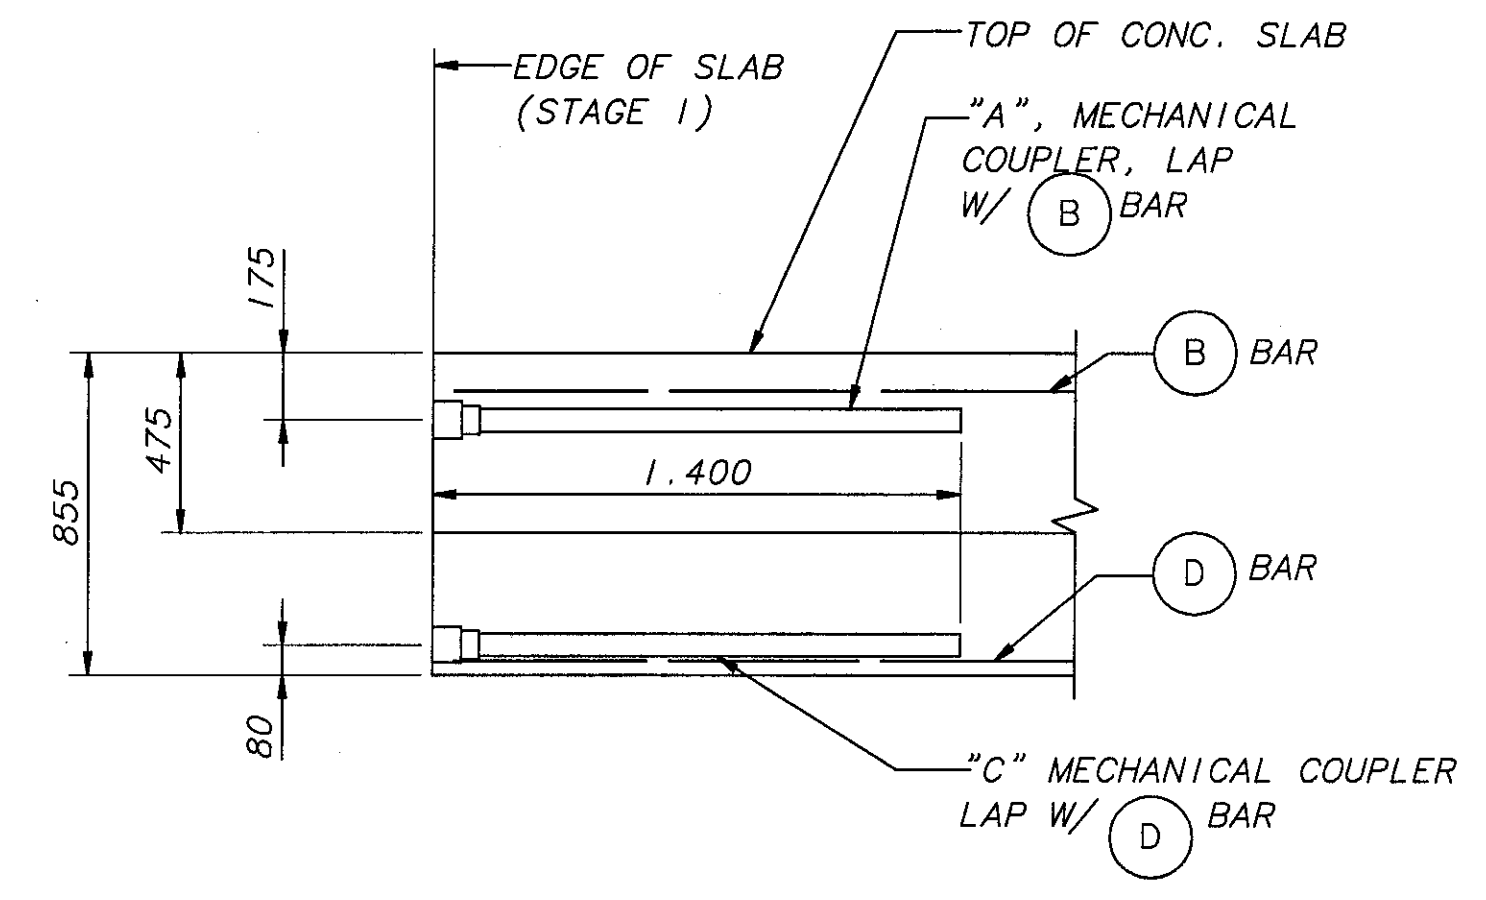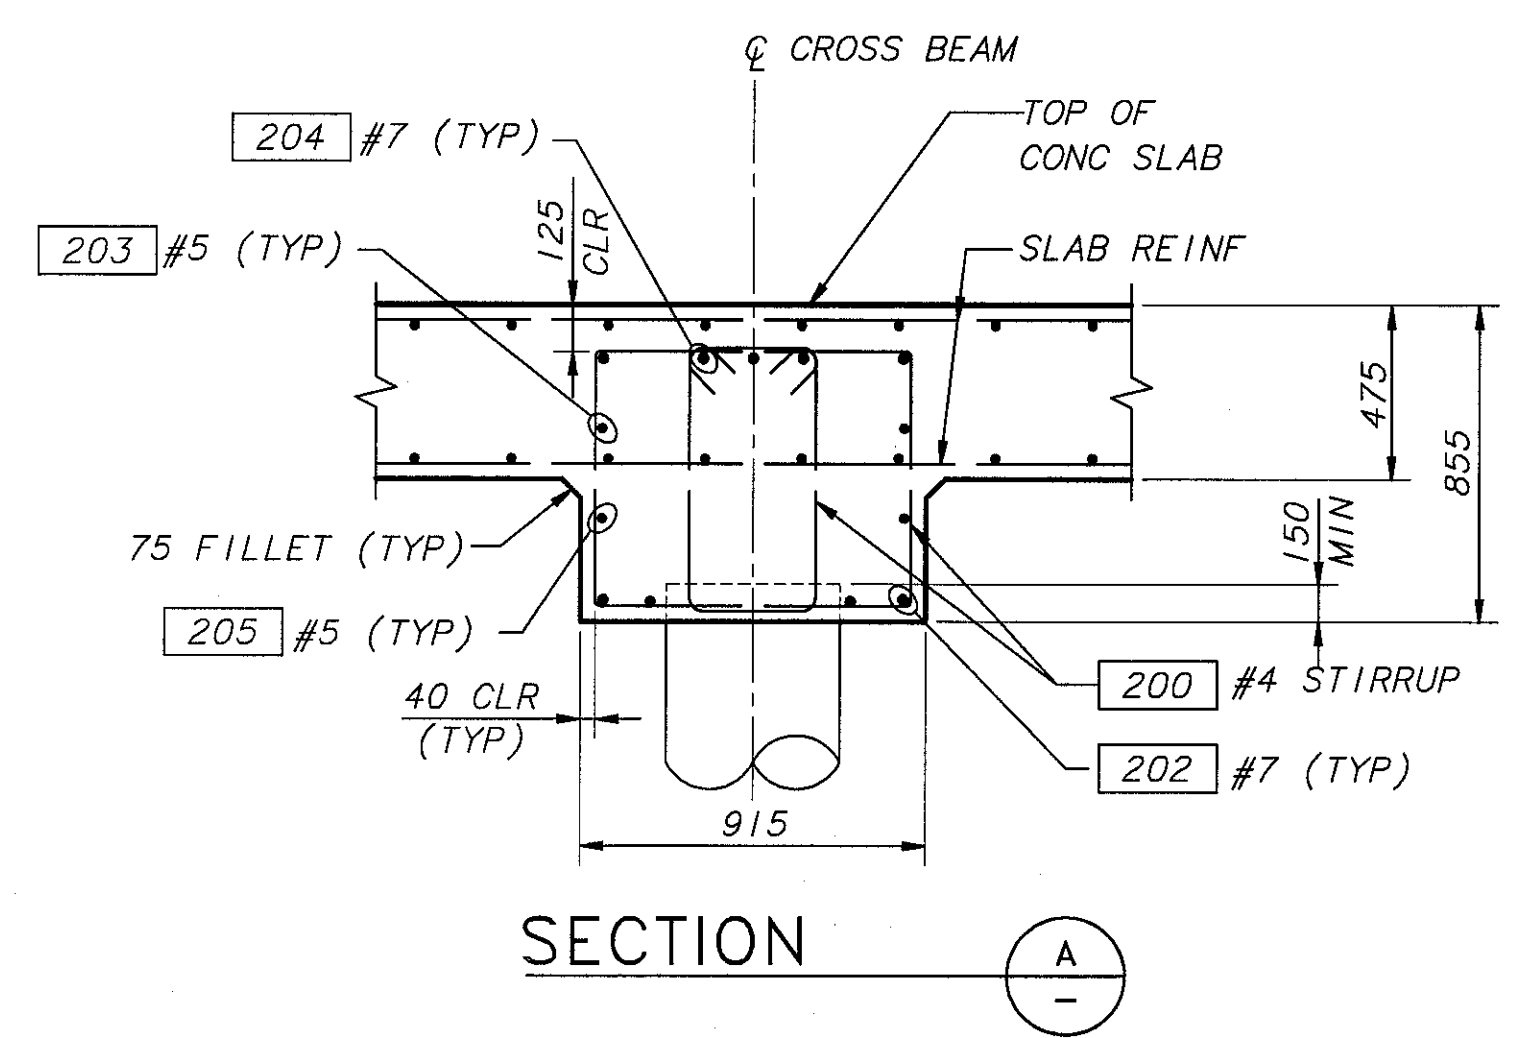

DETAIL - DOWEL BAR INSERT B-5

STAGE 1 ~ PIERS	"A"	B BAR	"C"	D BAR
1 & 4	5~#7	607 #7	5~#7	604 #7
2 & 3	5~#7	204 #7	4~#7	202 #7

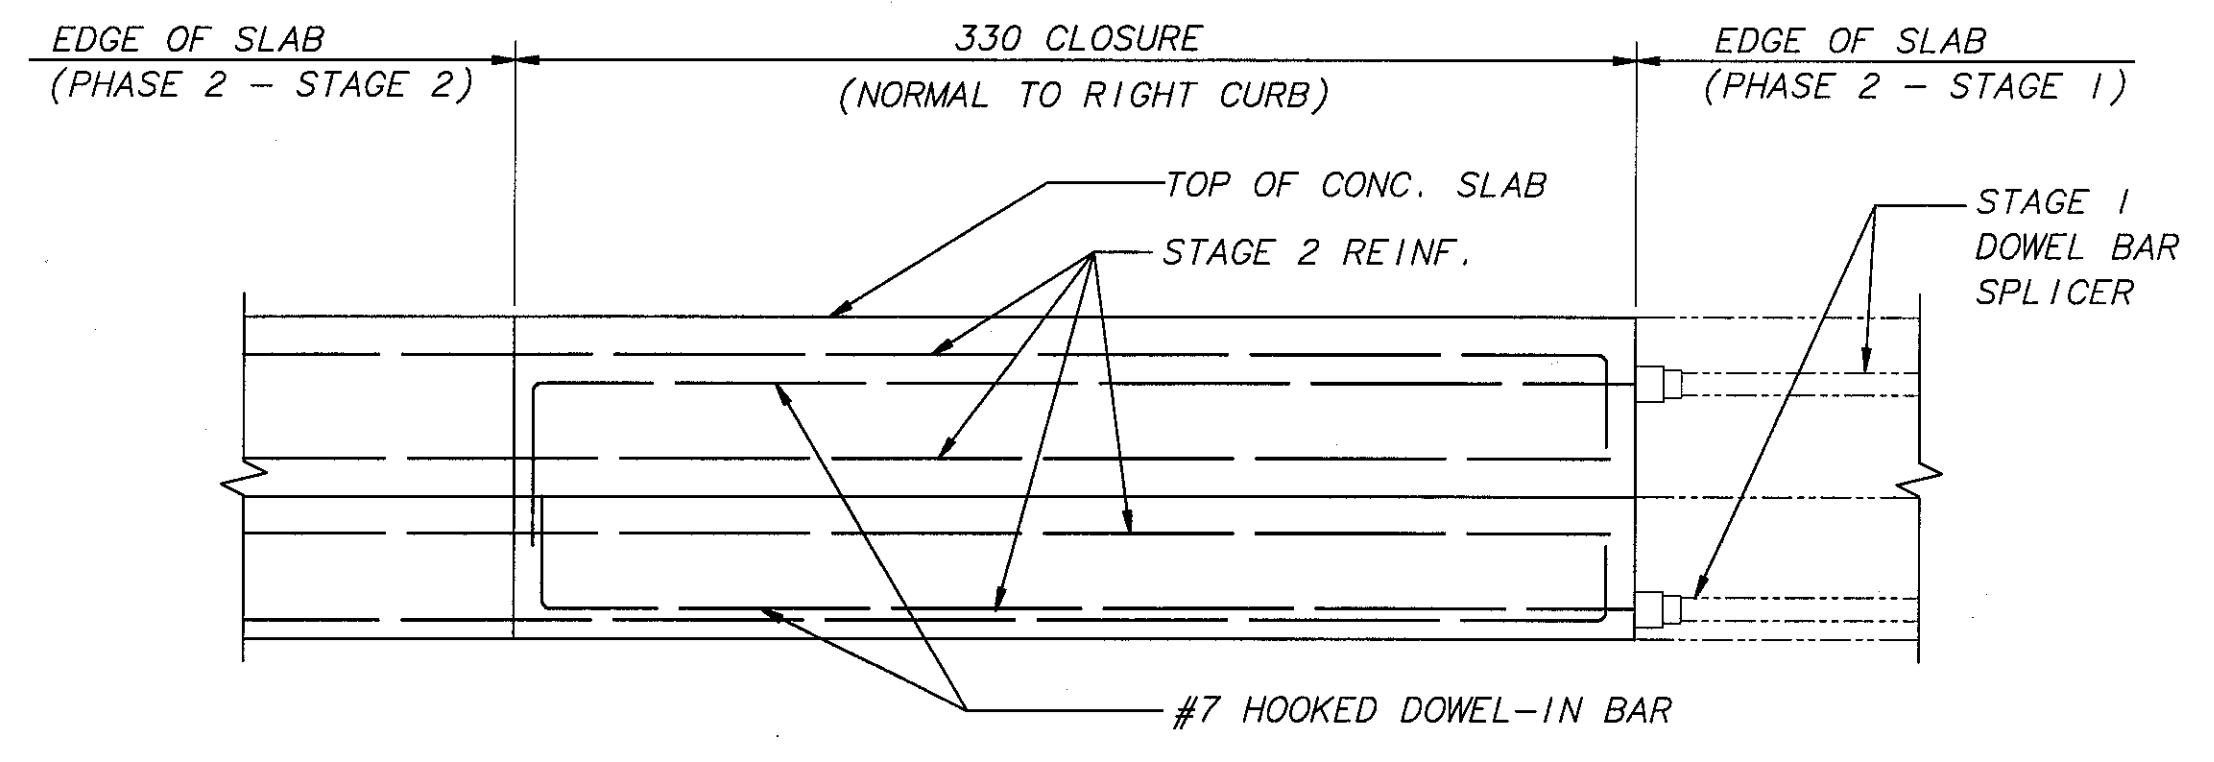


DETAIL - CLOSURE C-7,8

PLOTTED: Tue Nov 12 1996 11:43am FILENAME: X:\A96077\BR72\NBCD\6.DWG SCALE: 30
 SR 405 JOB NO. 7071 SHEET 6 OF 19


BRIDGE DESIGN ENGR		REGION	STATE	FED AID PROJ NO	SHEET	TOTAL SHEETS			SR 405 BOTHELL TO SWAMP CREEK I/C HOV LANES - STAGE 1 NORTH CREEK BRIDGE 405/72 NBCD PIER 2 & 3 - STAGE 1	BRIDGE SHEET NO. 6
SUPERVISOR		I	WASH							SHEET 485 OF 663 SHEETS
DESIGNED BY	K. HINKLEY 6/96	JOB NUMBER	96W035							
CHECKED BY	C. CORNELL 6/96	CONTRACT NO.	5054							
DETAILED BY	T. BRENNAN 6/96									
BRIDGE PROJECTS ENGR										
PRELIM PLAN BY										
ARCHITECT/SPECIALIST		DATE	REVISION	BY	APPR					

JH/11

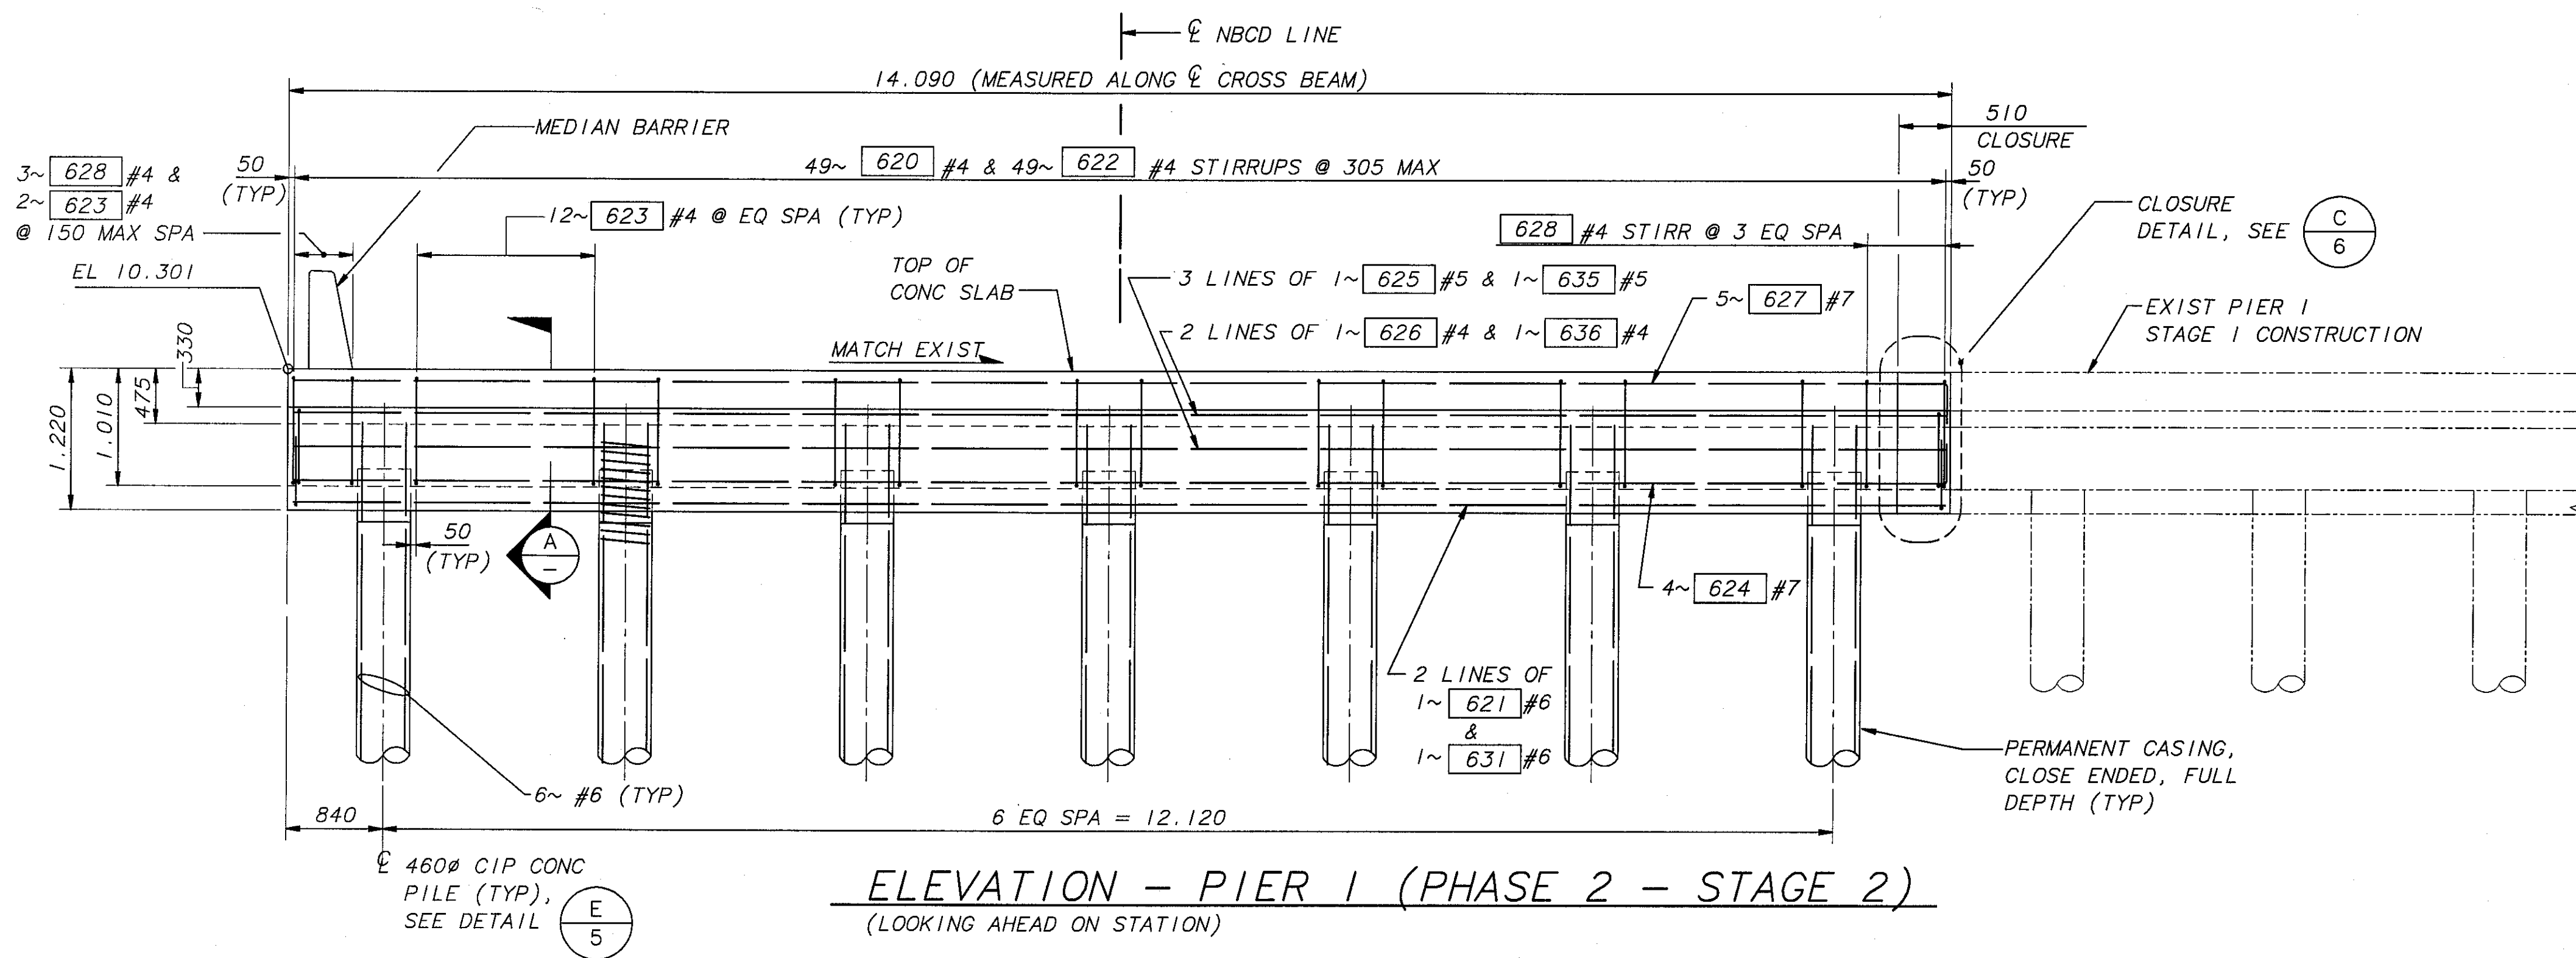


ELEVATION - PIER 1 (PHASE 2 - STAGE 2)
(LOOKING AHEAD ON STATION)

NOTE: ALL SUBSTRUCTURE ARE DIMENSIONS MEASURED ALONG ϕ CROSS BEAM UNLESS NOTED OTHERWISE. ALL ELEVATIONS ARE AT ϕ CROSS BEAM. STAGGER ALL LAP SPLICES, #4 LAP = 610, #5 LAP = 710 & #7 LAP = 1.005

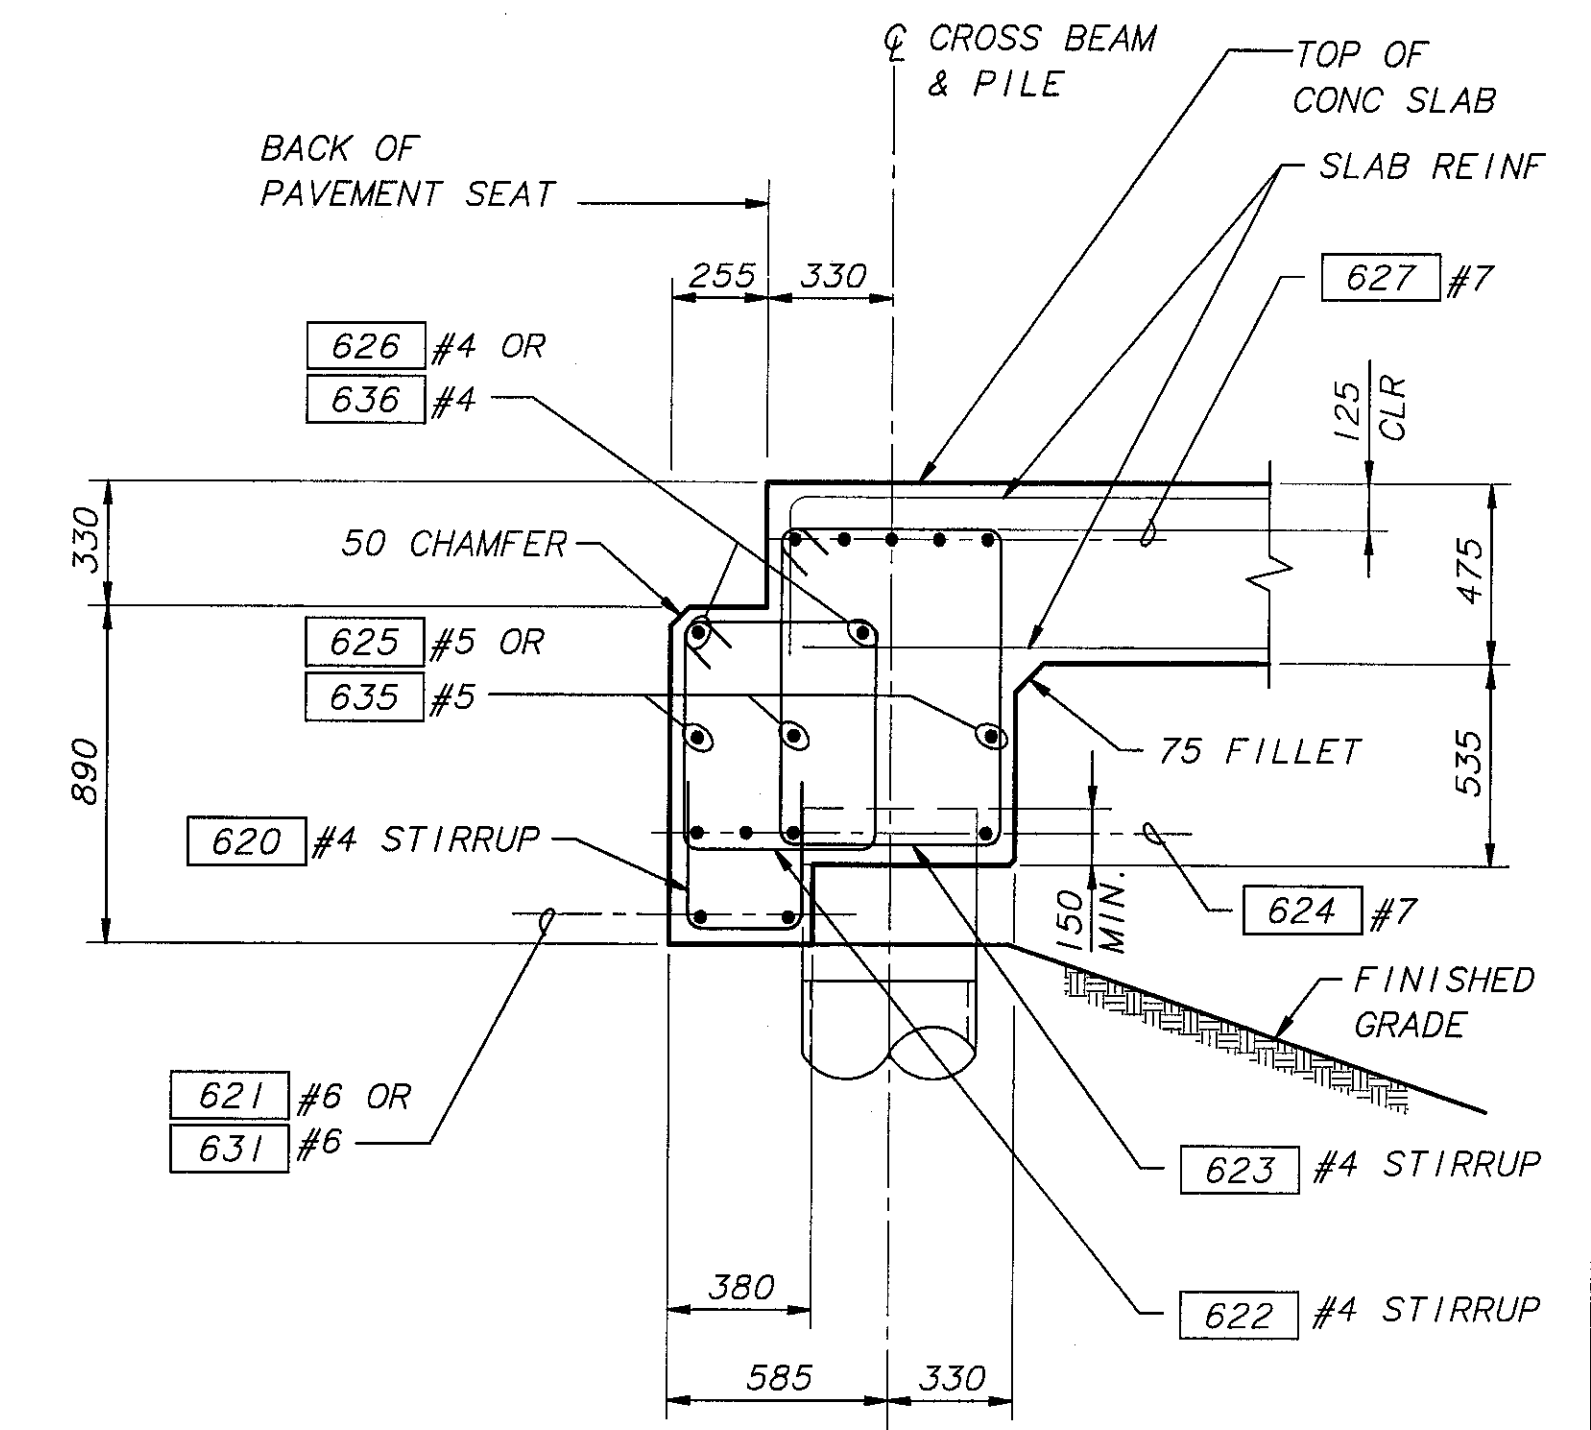


SECTION A

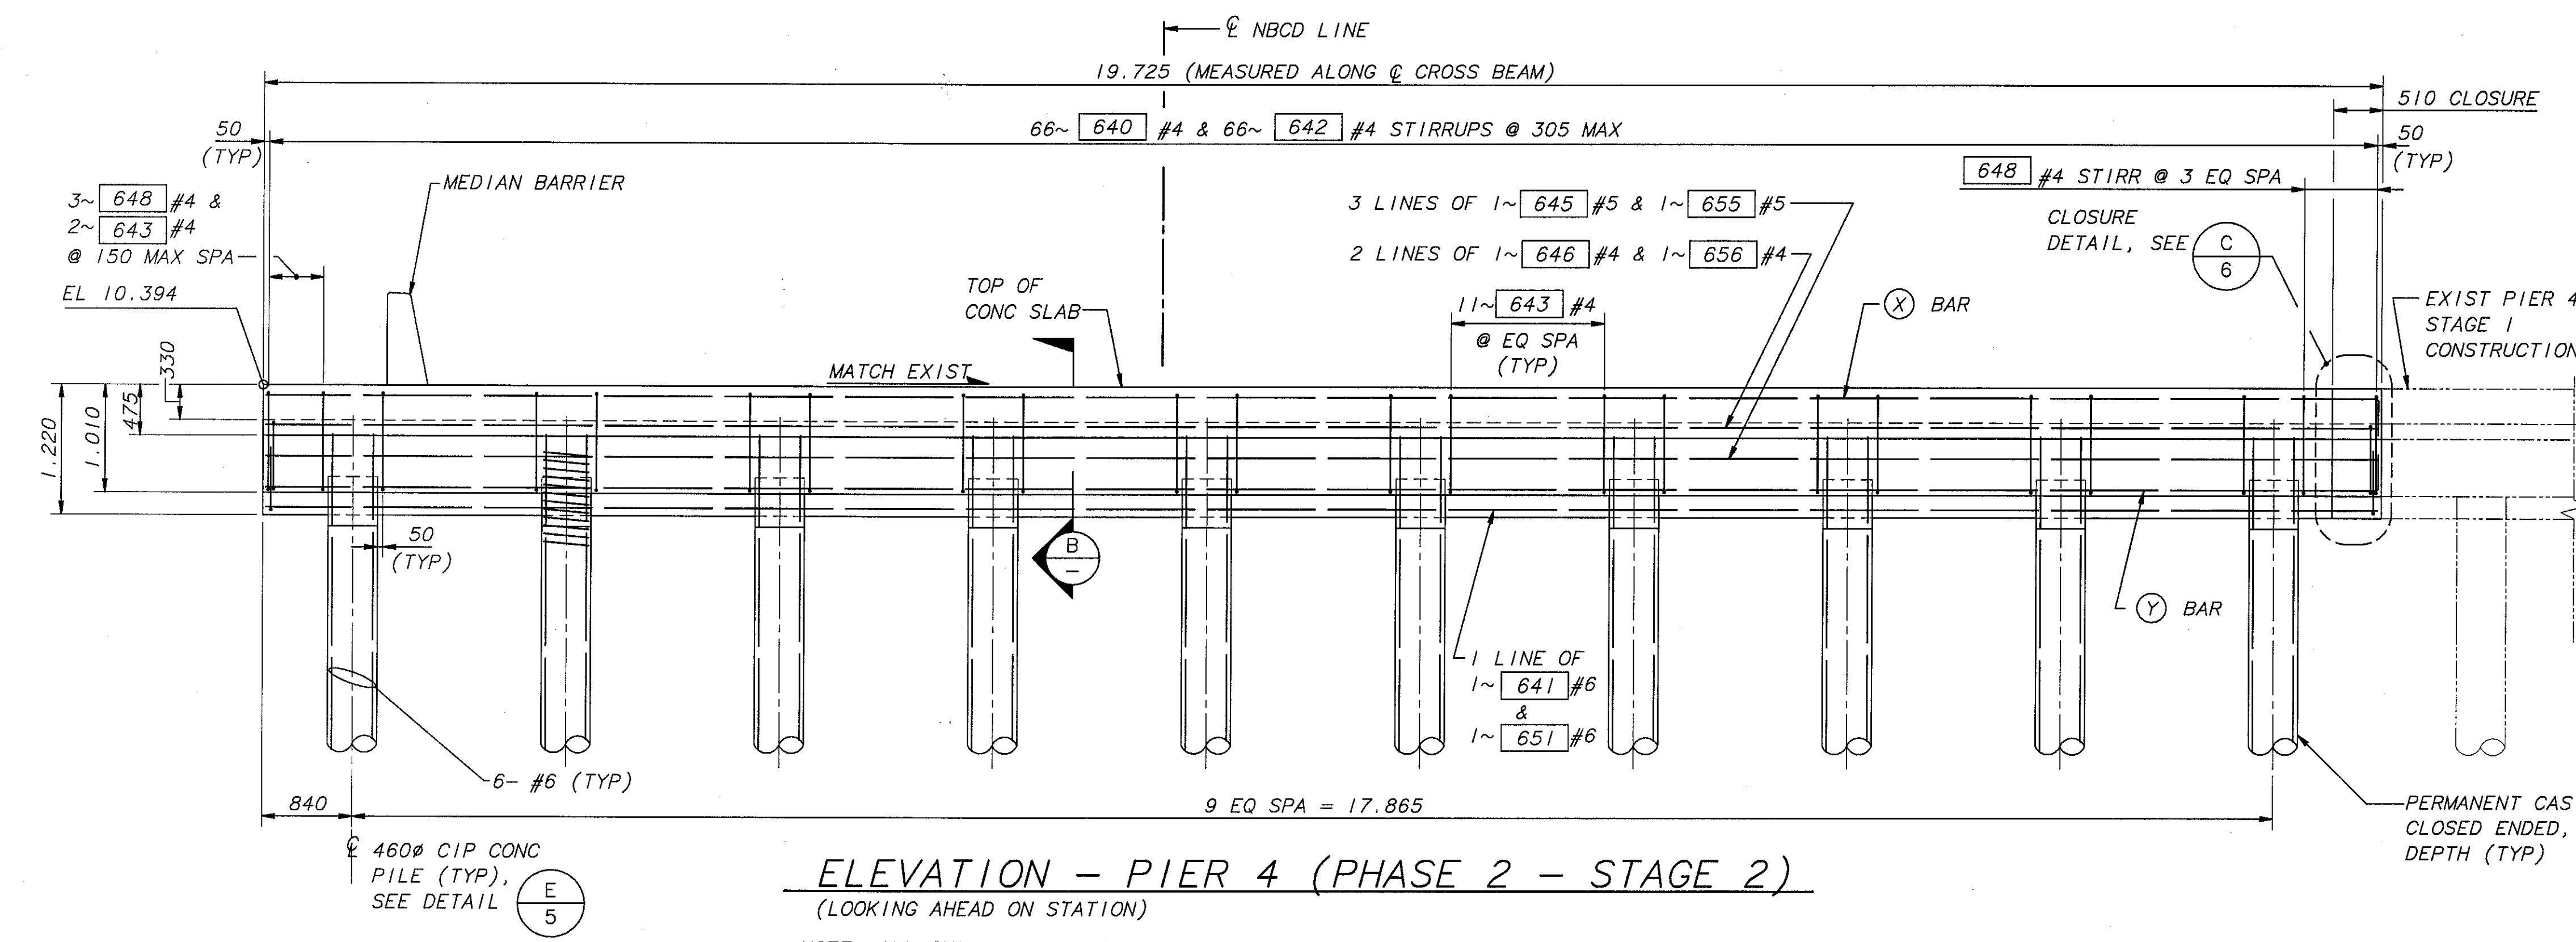

ELEVATION - PIER 4 (PHASE 2 - STAGE 2)
(LOOKING AHEAD ON STATION)

NOTE: ALL SUBSTRUCTURE ARE DIMENSIONS MEASURED ALONG ϕ CROSS BEAM UNLESS NOTED OTHERWISE. ALL ELEVATIONS ARE AT ϕ CROSS BEAM. STAGGER ALL LAP SPLICES, #4 LAP = 610, #5 LAP = 710 & #7 LAP = 1.005

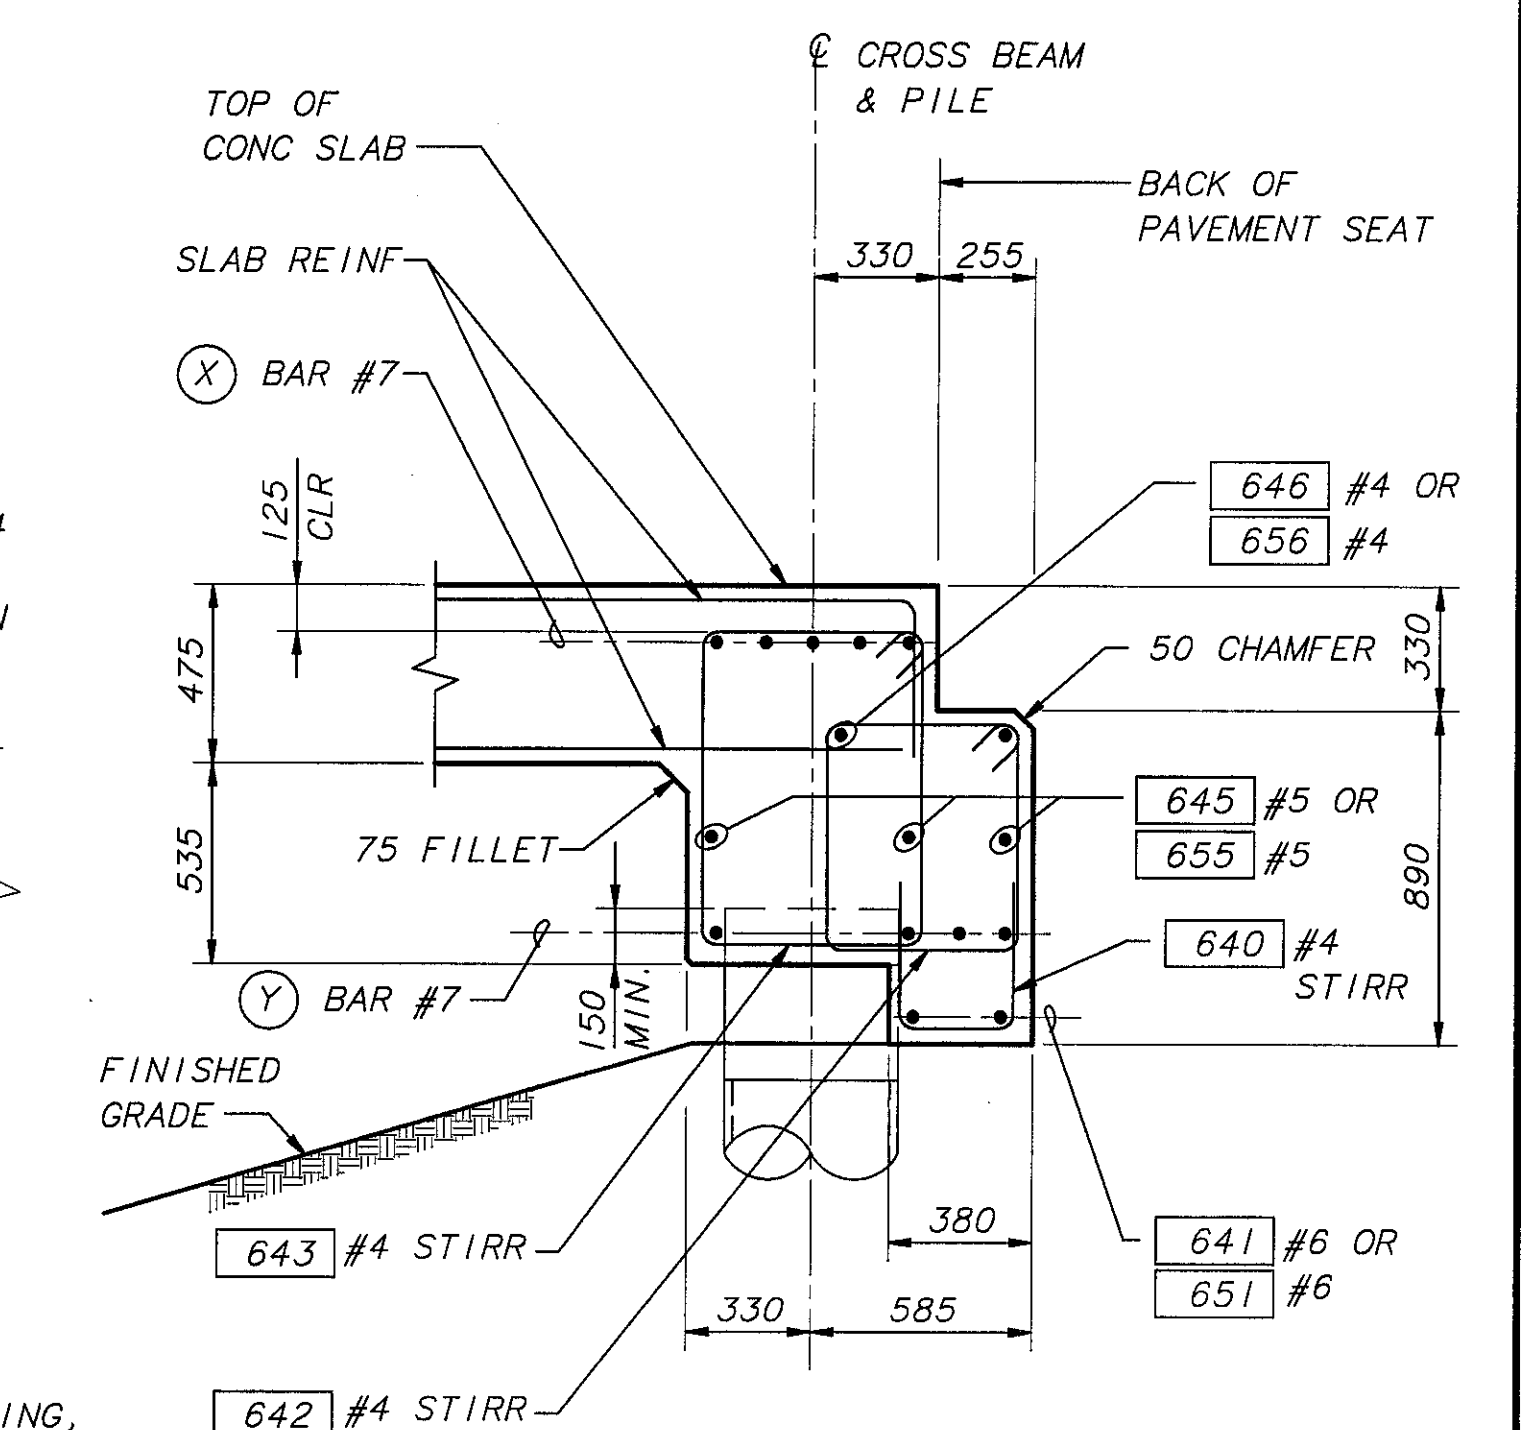

SECTION B

(X) BAR MARK DENOTES 647, 657, 667 OR 677
(Y) BAR MARK DENOTES 644, 654, 664 OR 674

PLOTTED: Tue Nov 12 1996 11:44am FILENAME: X:\A96077\BR72\NBCD\7.DWG SCALE: 40 SR 405 JOB NO. 7071 SHEET 7 OF 19

BRIDGE DESIGN ENGR		REGION	STATE	FED AID PROJ NO	SHEET	TOTAL SHEETS
SUPERVISOR		I	WASH			
DESIGNED BY	K. HINKLEY 6/96	JOB NUMBER	96W035			
CHECKED BY	C. CORNELL 6/96	CONTRACT NO.	5054			
DATE	REVISION	BY	APPR			



BERGER/ABAM
ENGINEERS INC.
33301 9TH AVENUE SOUTH
FEDERAL WAY, WASHINGTON 98003-4395
(206)431-2300 FAX: (206)431-2250




SR 405
BOTHELL TO SWAMP CREEK I/C
HOV LANES - STAGE 1
NORTH CREEK BRIDGE 405/72 NBCD
PIER 1 & 4 - STAGE 2

BRIDGE SHEET NO. 7
SHEET 486 OF 663 SHEETS

241140


PLOTTED: Tue Nov 12 1996 11:44am FILENAME: X:\A96077\BR72\NBCD\&DWG SCALE: 40
 SR 405 JOB NO. 7071 SHEET 8 OF 19

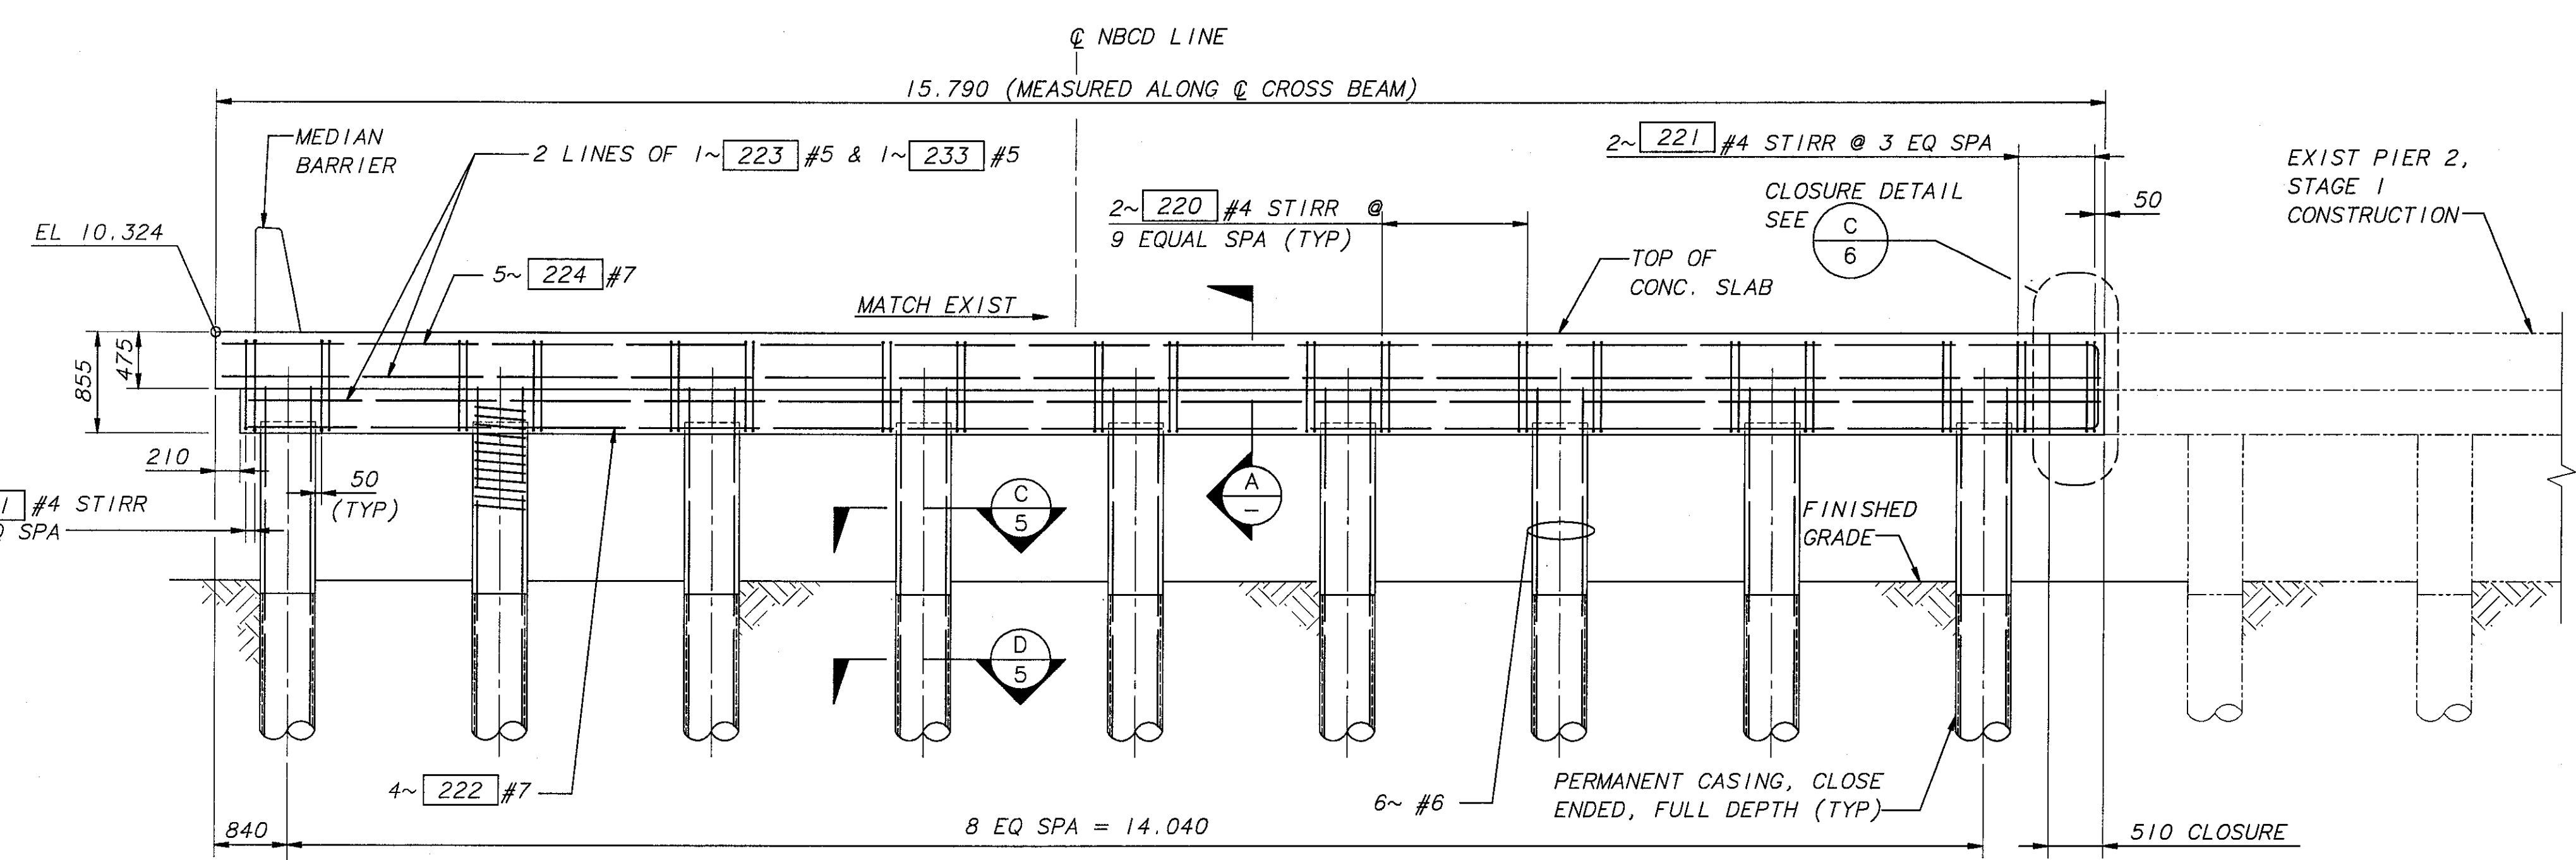


ELEVATION - PIER 2 (PHASE 2 - STAGE 2)

(LOOKING AHEAD ON STATION)

NOTE: ALL SUBSTRUCTURE DIMENSIONS ARE MEASURED ALONG
 @ CROSS BEAM UNLESS NOTED OTHERWISE. ALL ELEVATIONS
 ARE AT @ CROSS BEAM. STAGGER ALL LAP SPLICES, #4 LAP = 610,
 #5 LAP = 710 & #7 LAP = 1.005

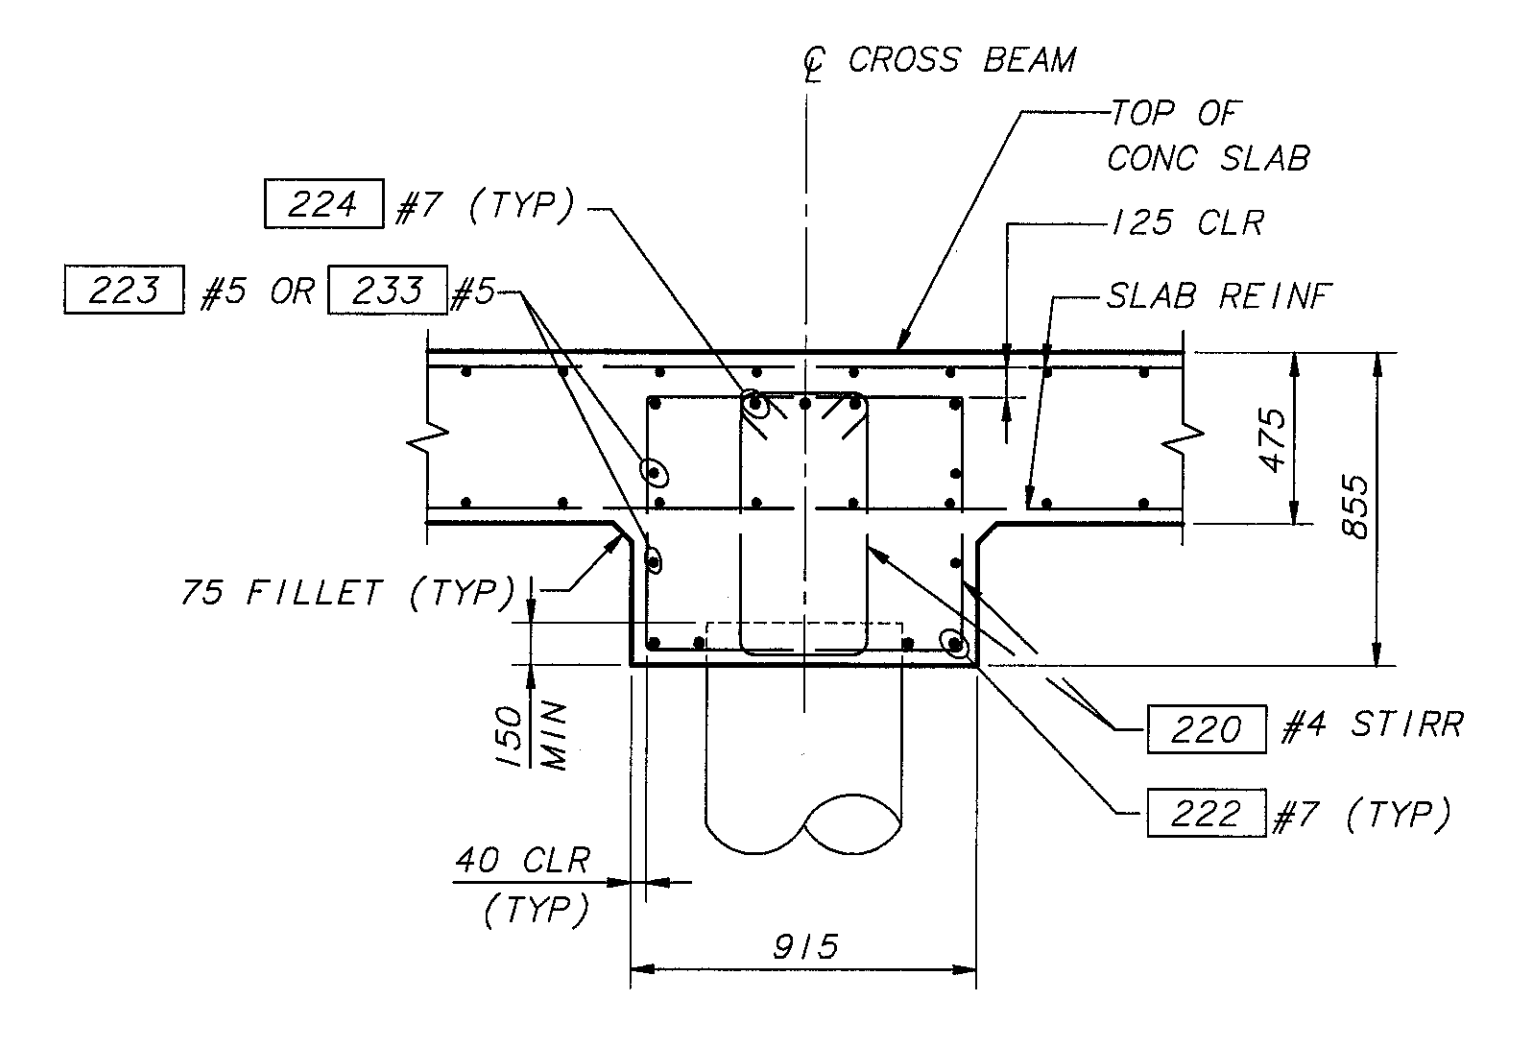


SECTION A

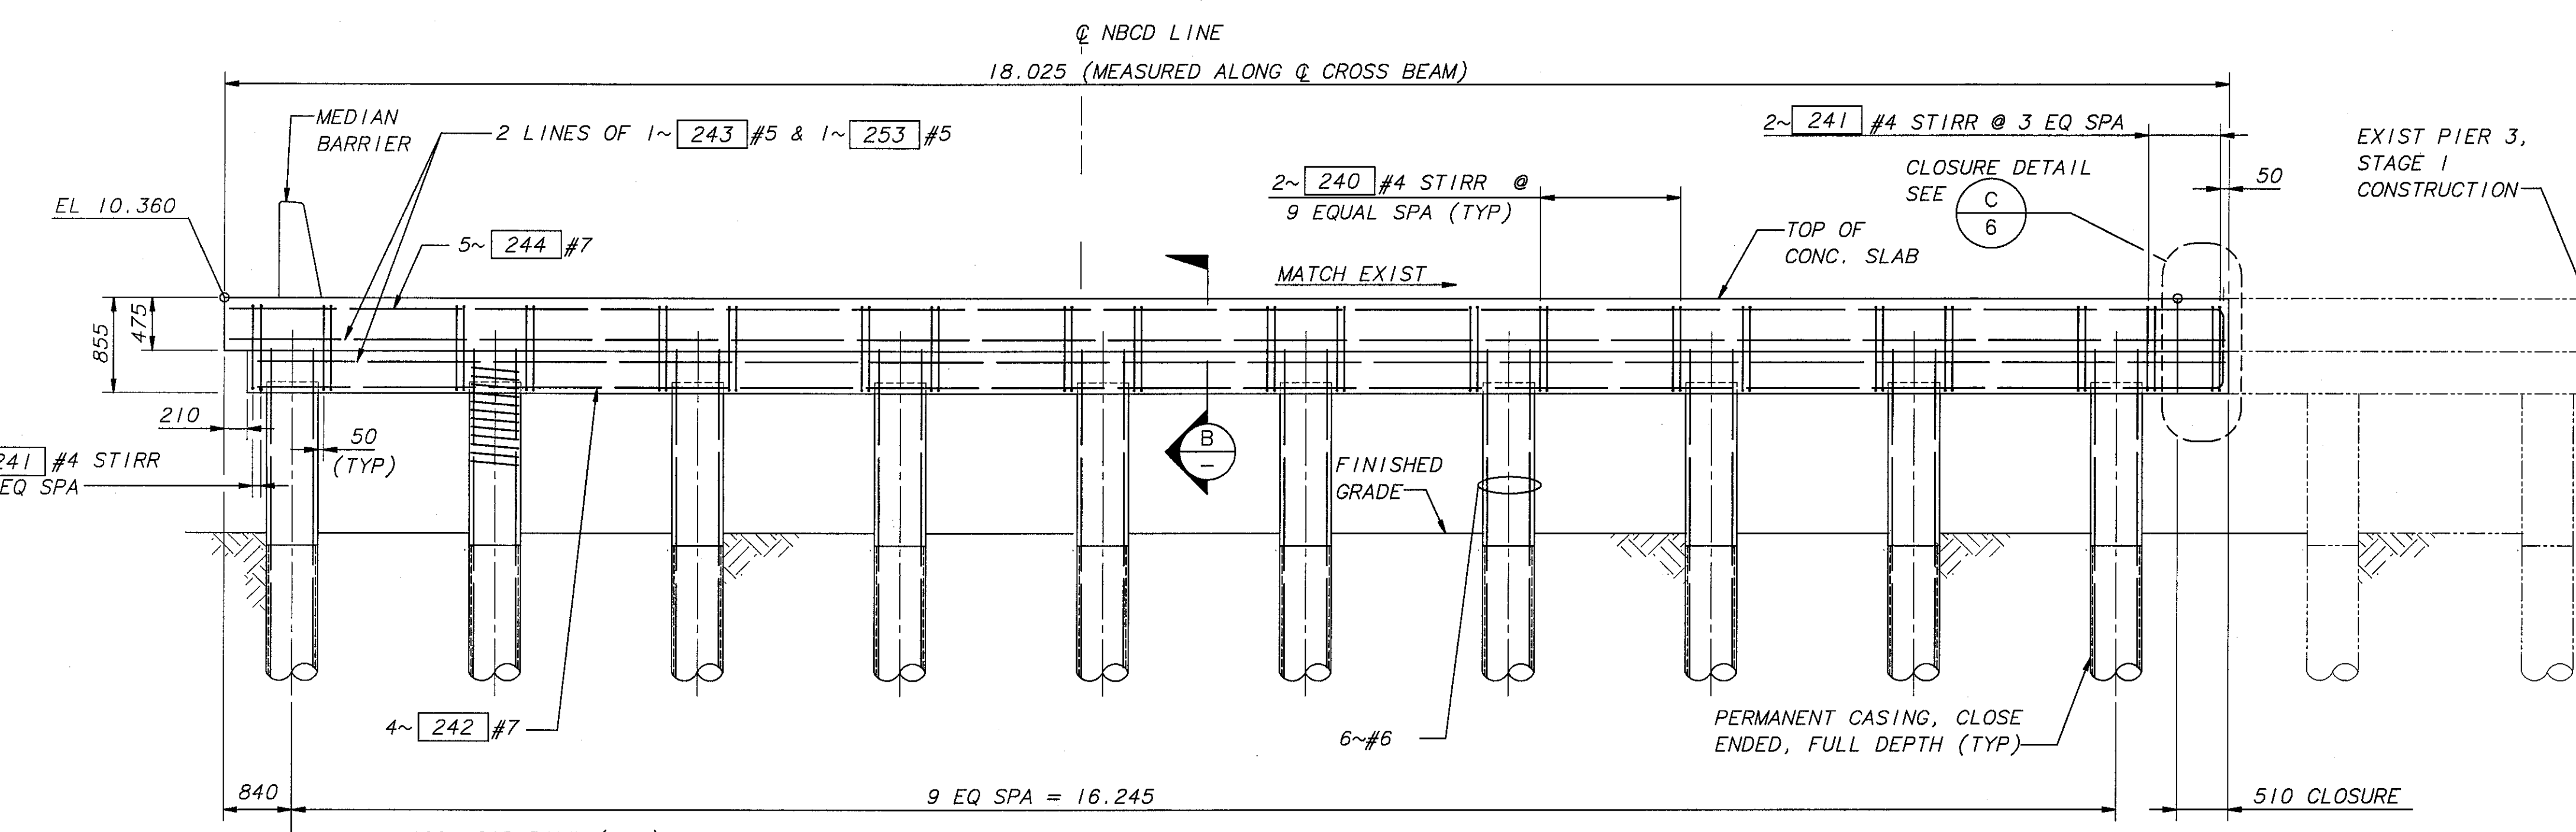

ELEVATION - PIER 3 (PHASE 2 - STAGE 2)

(LOOKING AHEAD ON STATION)


NOTE: ALL SUBSTRUCTURE DIMENSIONS ARE MEASURED ALONG
 @ CROSS BEAM UNLESS NOTED OTHERWISE. ALL ELEVATIONS
 ARE AT @ CROSS BEAM. STAGGER ALL LAP SPLICES, #4 LAP = 610,
 #5 LAP = 710 & #7 LAP = 1.005

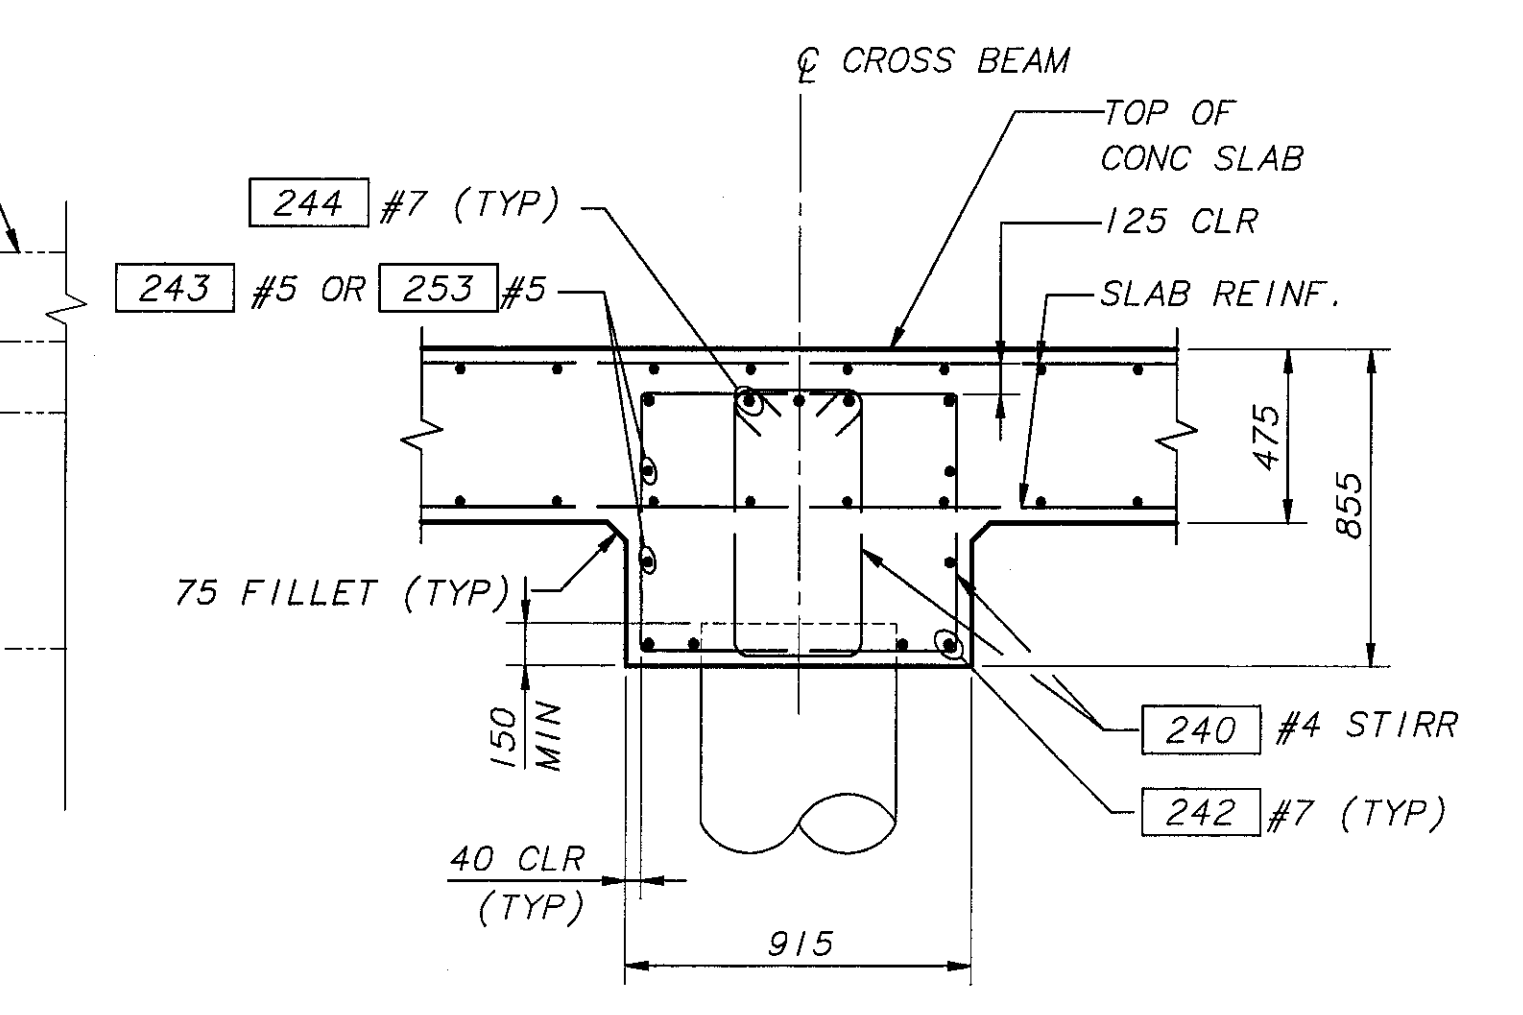

SECTION B

BRIDGE DESIGN ENGR					
SUPERVISOR					
DESIGNED BY	K. HINKLEY	6/96			
CHECKED BY	C. CORNELL	6/96			
DETAILED BY	T. BRENNAN	6/96			
BRIDGE PROJECTS ENGR					
PRELIM PLAN BY					
ARCHITECT/SPECIALIST					
DATE		REVISION		BY	APPR

REGION NO.	STATE	FED AID PROJ NO.	SHEET NO.	TOTAL SHEETS
1	WASH			
JOB NUMBER		96W035		
CONTRACT NO.		5054		

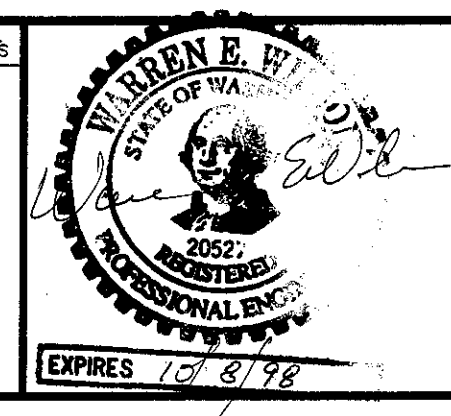


BERGER/ABAM
 ENGINEERS INC.
 33301 5TH AVENUE SOUTH
 FEDERAL WAY, WASHINGTON 98003-8395
 (206)431-2300 FAX: (206)431-2250




SR 405
 BOTHELL TO SWAMP CREEK I/C
 HOV LANES - STAGE 1
 NORTH CREEK BRIDGE 405/72 NBCD
PIER 2 & 3 - STAGE 2

BRIDGE SHEET NO. **8**
 SHEET 487 OF 663 SHEETS

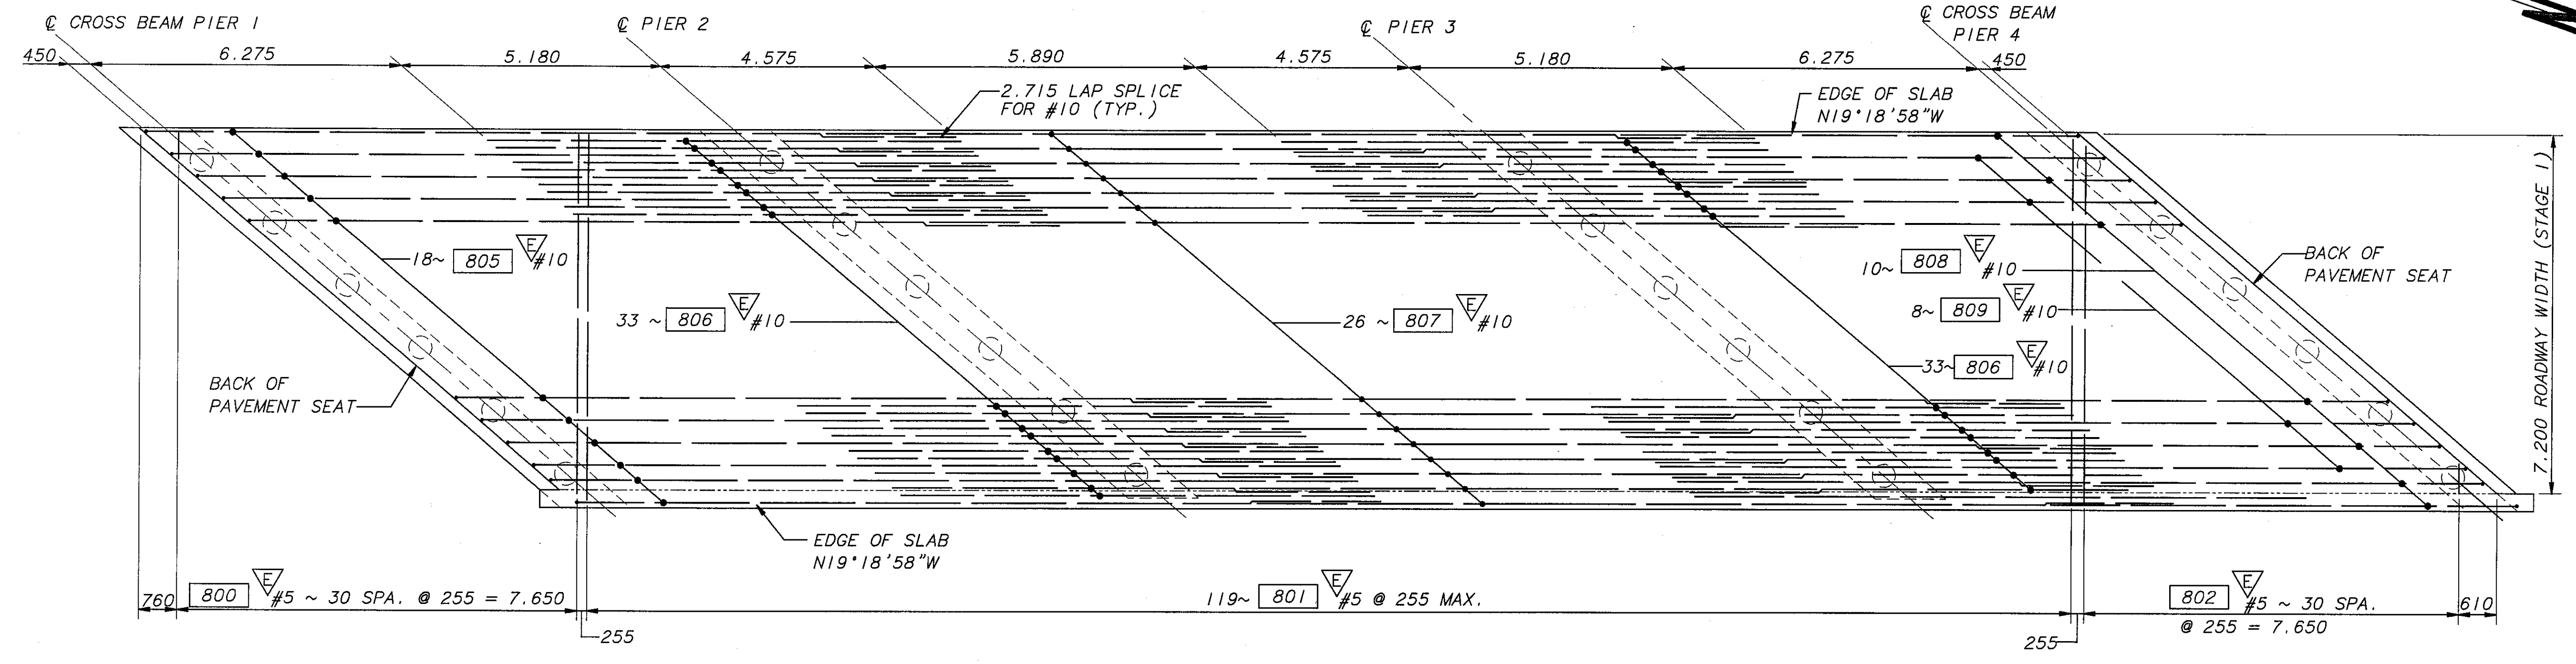

REINFORCEMENT PLAN - TOP MAT (PHASE 2 - STAGE 1)
 (ALL DIMENSIONS ARE MEASURED ALONG OUTSIDE EDGE OF SLAB UNLESS NOTED OTHERWISE)

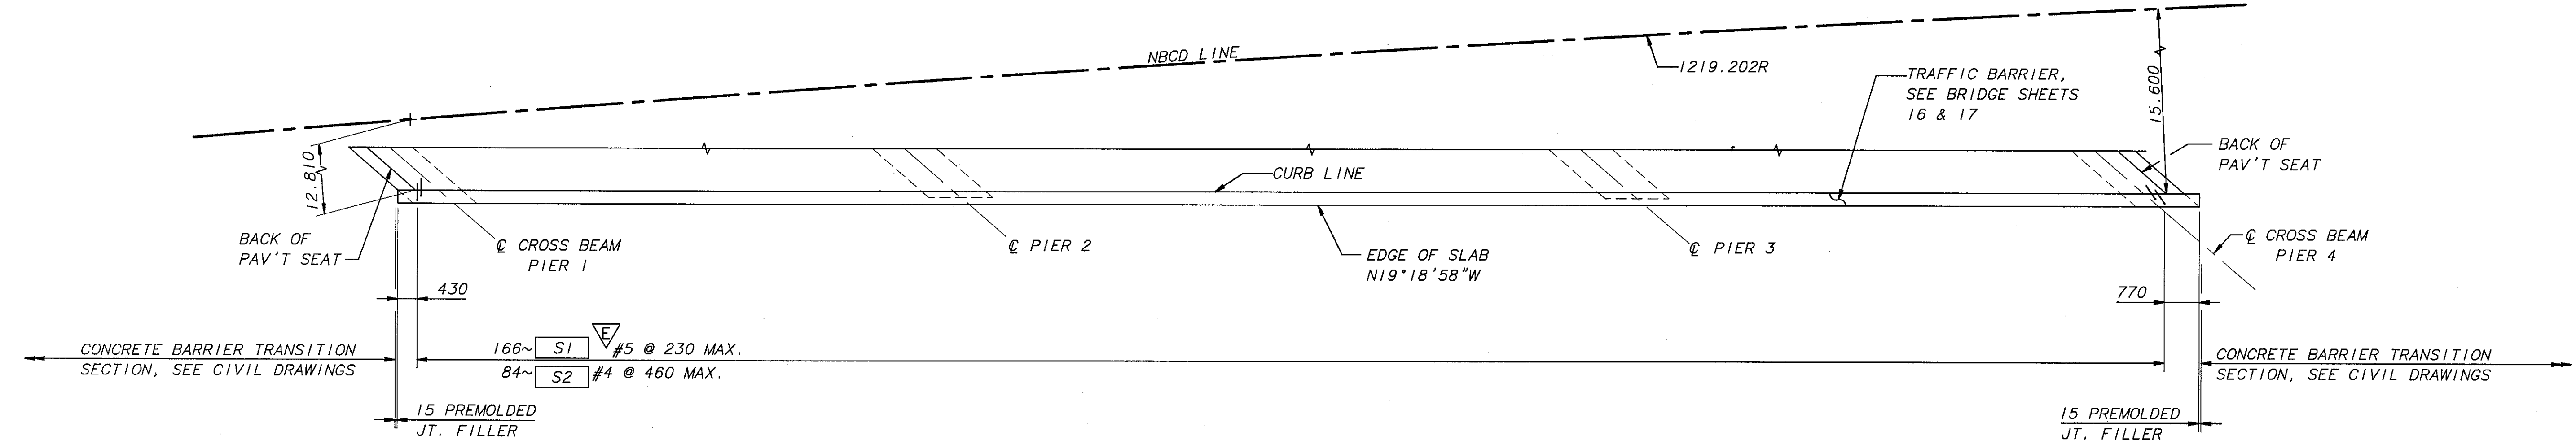


PLAN - TRAFFIC BARRIER (PHASE 2 - STAGE 1)
 (ALL DIMENSIONS ARE MEASURED ALONG OUTSIDE EDGE OF SLAB UNLESS NOTED OTHERWISE)

PLOTTED: Tue Nov 12 1996 11:46am FILENAME: X:\196077\BR72\WBRC2\10.DWG SCALE: 75
 SR 405 JOB NO. 7071 SHEET 10 OF 19

BRIDGE DESIGN ENGR					
SUPERVISOR					
DESIGNED BY	K. HINKLEY	6/96			
CHECKED BY	C. CORNELL	6/96			
DETAILED BY	T. BRENNAN	6/96			
BRIDGE PROJECTS ENGR					
PRELIM PLAN BY					
ARCHITECT/SPECIALIST					
DATE		REVISION	BY	APPR	

REGION NO.	STATE	FED AID PROJ NO.	SHEET NO.	TOTAL SHEETS
1	WASH			
JOB NUMBER	96W035			
CONTRACT NO.	5054			

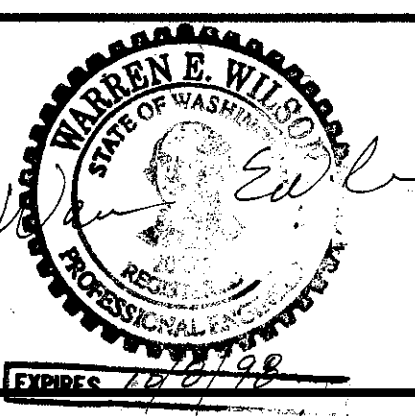


BERGER/ABAM
 ENGINEERS INC.
 33301 9TH AVENUE SOUTH
 FEDERAL WAY, WASHINGTON 98003-8395
 (206)431-2300 FAX: (206)431-2250



SR 405
 BOTHELL TO SWAMP CREEK I/C
 HOV LANES - STAGE 1
 NORTH CREEK BRIDGE 405/72 NBCD
 REINF. PLAN - TOP MAT (STAGE 1)

BRIDGE SHEET NO. 10
 SHEET 489 OF 663 SHEETS

24/101

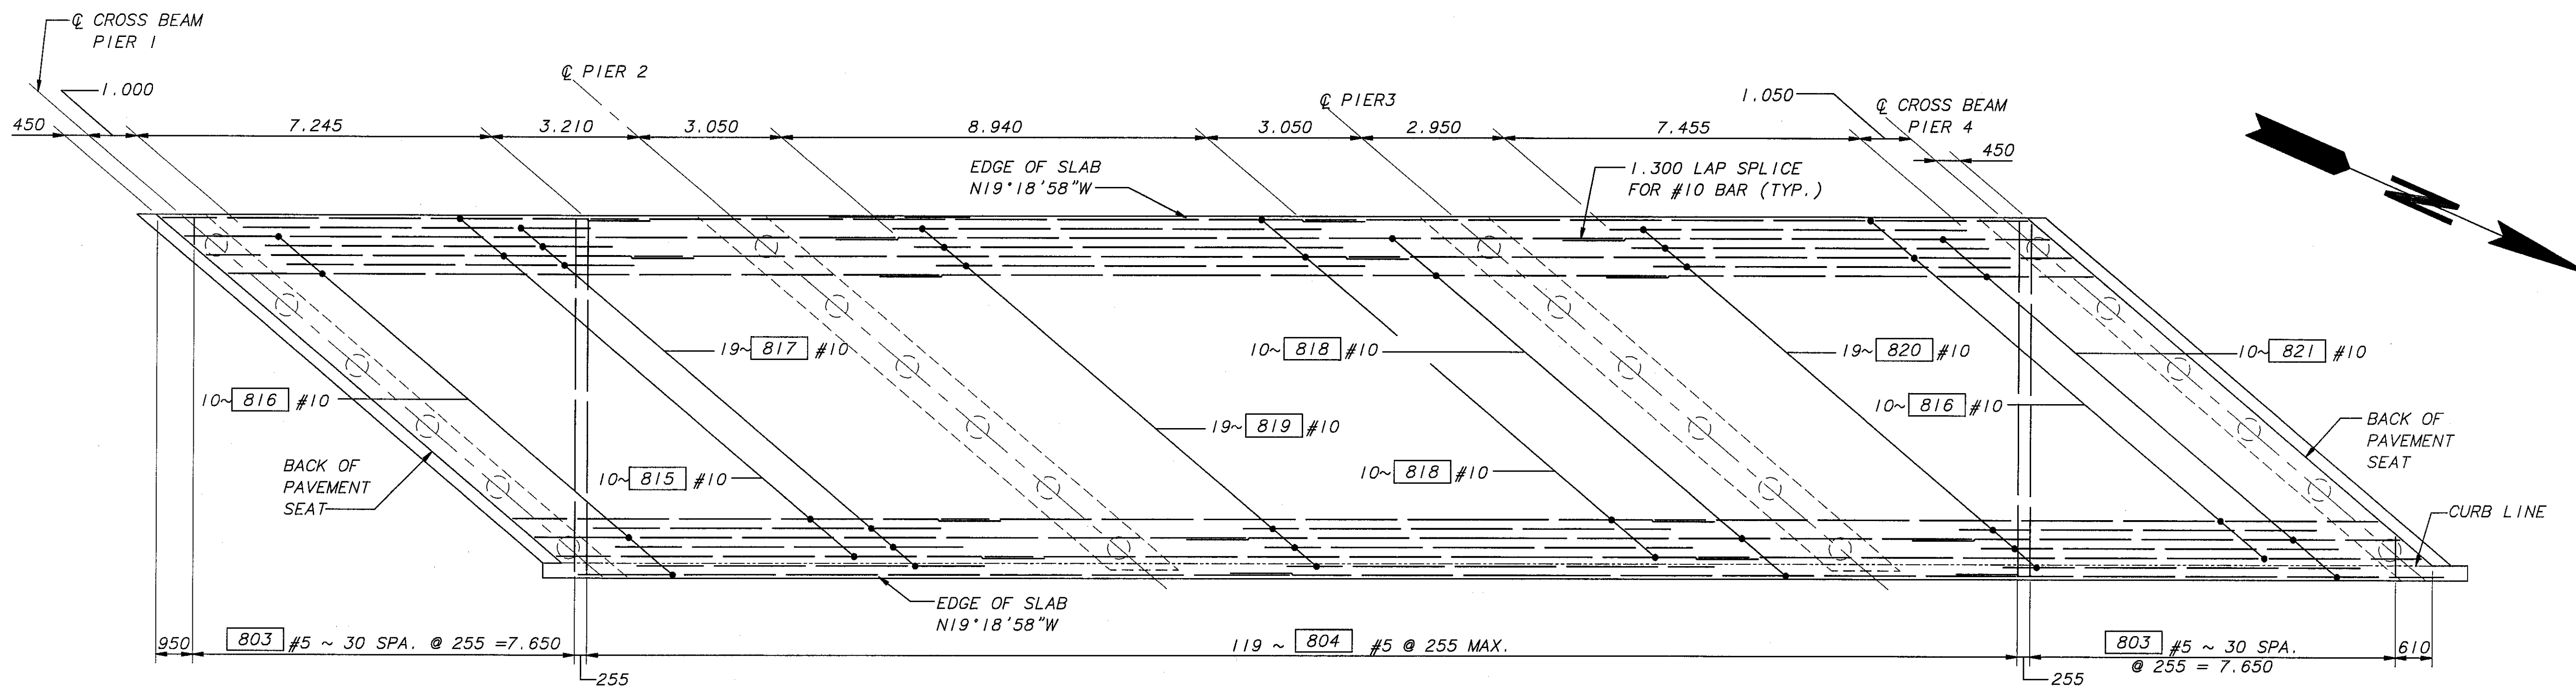


REINFORCEMENT PLAN - BOTTOM MAT (PHASE 2 - STAGE 1)

(ALL DIMENSIONS ARE MEASURED ALONG OUTSIDE RIGHT EDGE OF SLAB UNLESS OTHERWISE NOTED.)

PLOTTED: Tue Nov 12 1996 11:47am FILENAME: X:\496077\BR72\WBCC\1\1.DWG SCALE: 75
 SR 405 JOB NO. 7071 SHEET 11 OF 19

BRIDGE DESIGN ENGR					
SUPERVISOR					
DESIGNED BY	K. HINKLEY	6/96			
CHECKED BY	C. CORNELL	6/96			
DETAILED BY	T. BRENNAN	6/96			
BRIDGE PROJECTS ENGR					
PRELIM PLAN BY					
ARCHITECT/SPECIALIST					
DATE	REVISION	BY	APPR		

REGION NO.	STATE	FED AID PROJ NO.	SHEET NO.	TOTAL SHEETS
1	WASH			
JOB NUMBER		96W035		
CONTRACT NO.		5054		

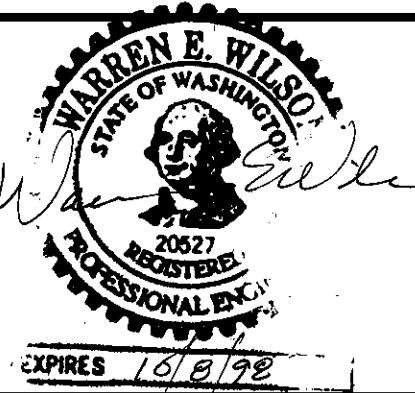


BERGER/ABAM
 ENGINEERS INC.
 33301 9TH AVENUE SOUTH
 FEDERAL WAY, WASHINGTON 98003-6395
 (206)431-2200 FAX: (206)431-2250



SR 405
 BOTHELL TO SWAMP CREEK I/C
 HOV LANES - STAGE 1
 NORTH CREEK BRIDGE 405/72 NBCC
 REINF. PLAN - BOTTOM MAT (STAGE 1)


BRIDGE SHEET NO. 11
 SHEET 490 OF 663 SHEETS

241134

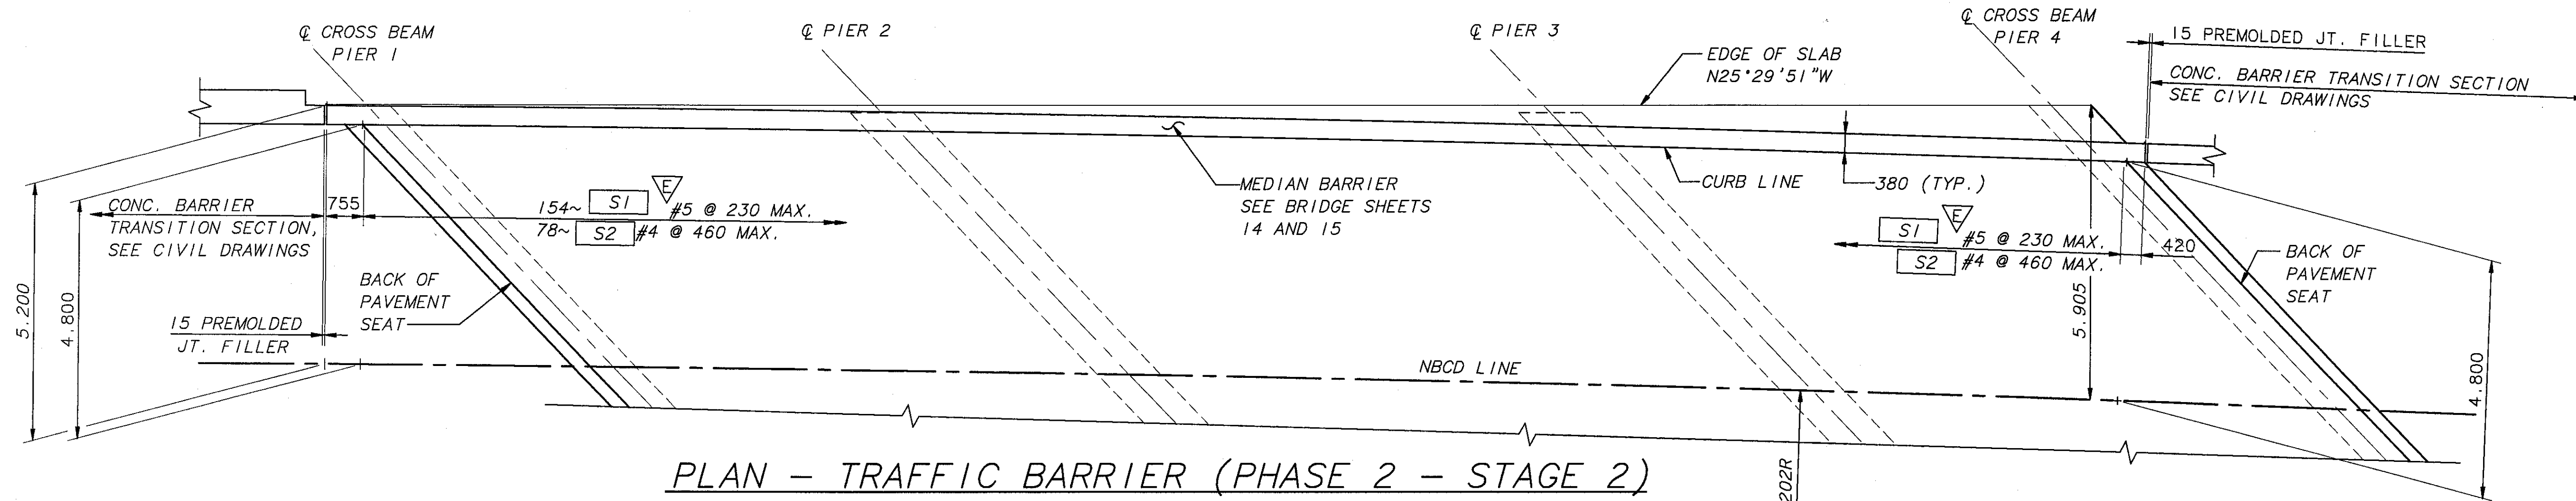

PLAN - TRAFFIC BARRIER (PHASE 2 - STAGE 2)

(ALL DIMENSIONS ARE MEASURED ALONG NBCD LINE UNLESS NOTED OTHERWISE)

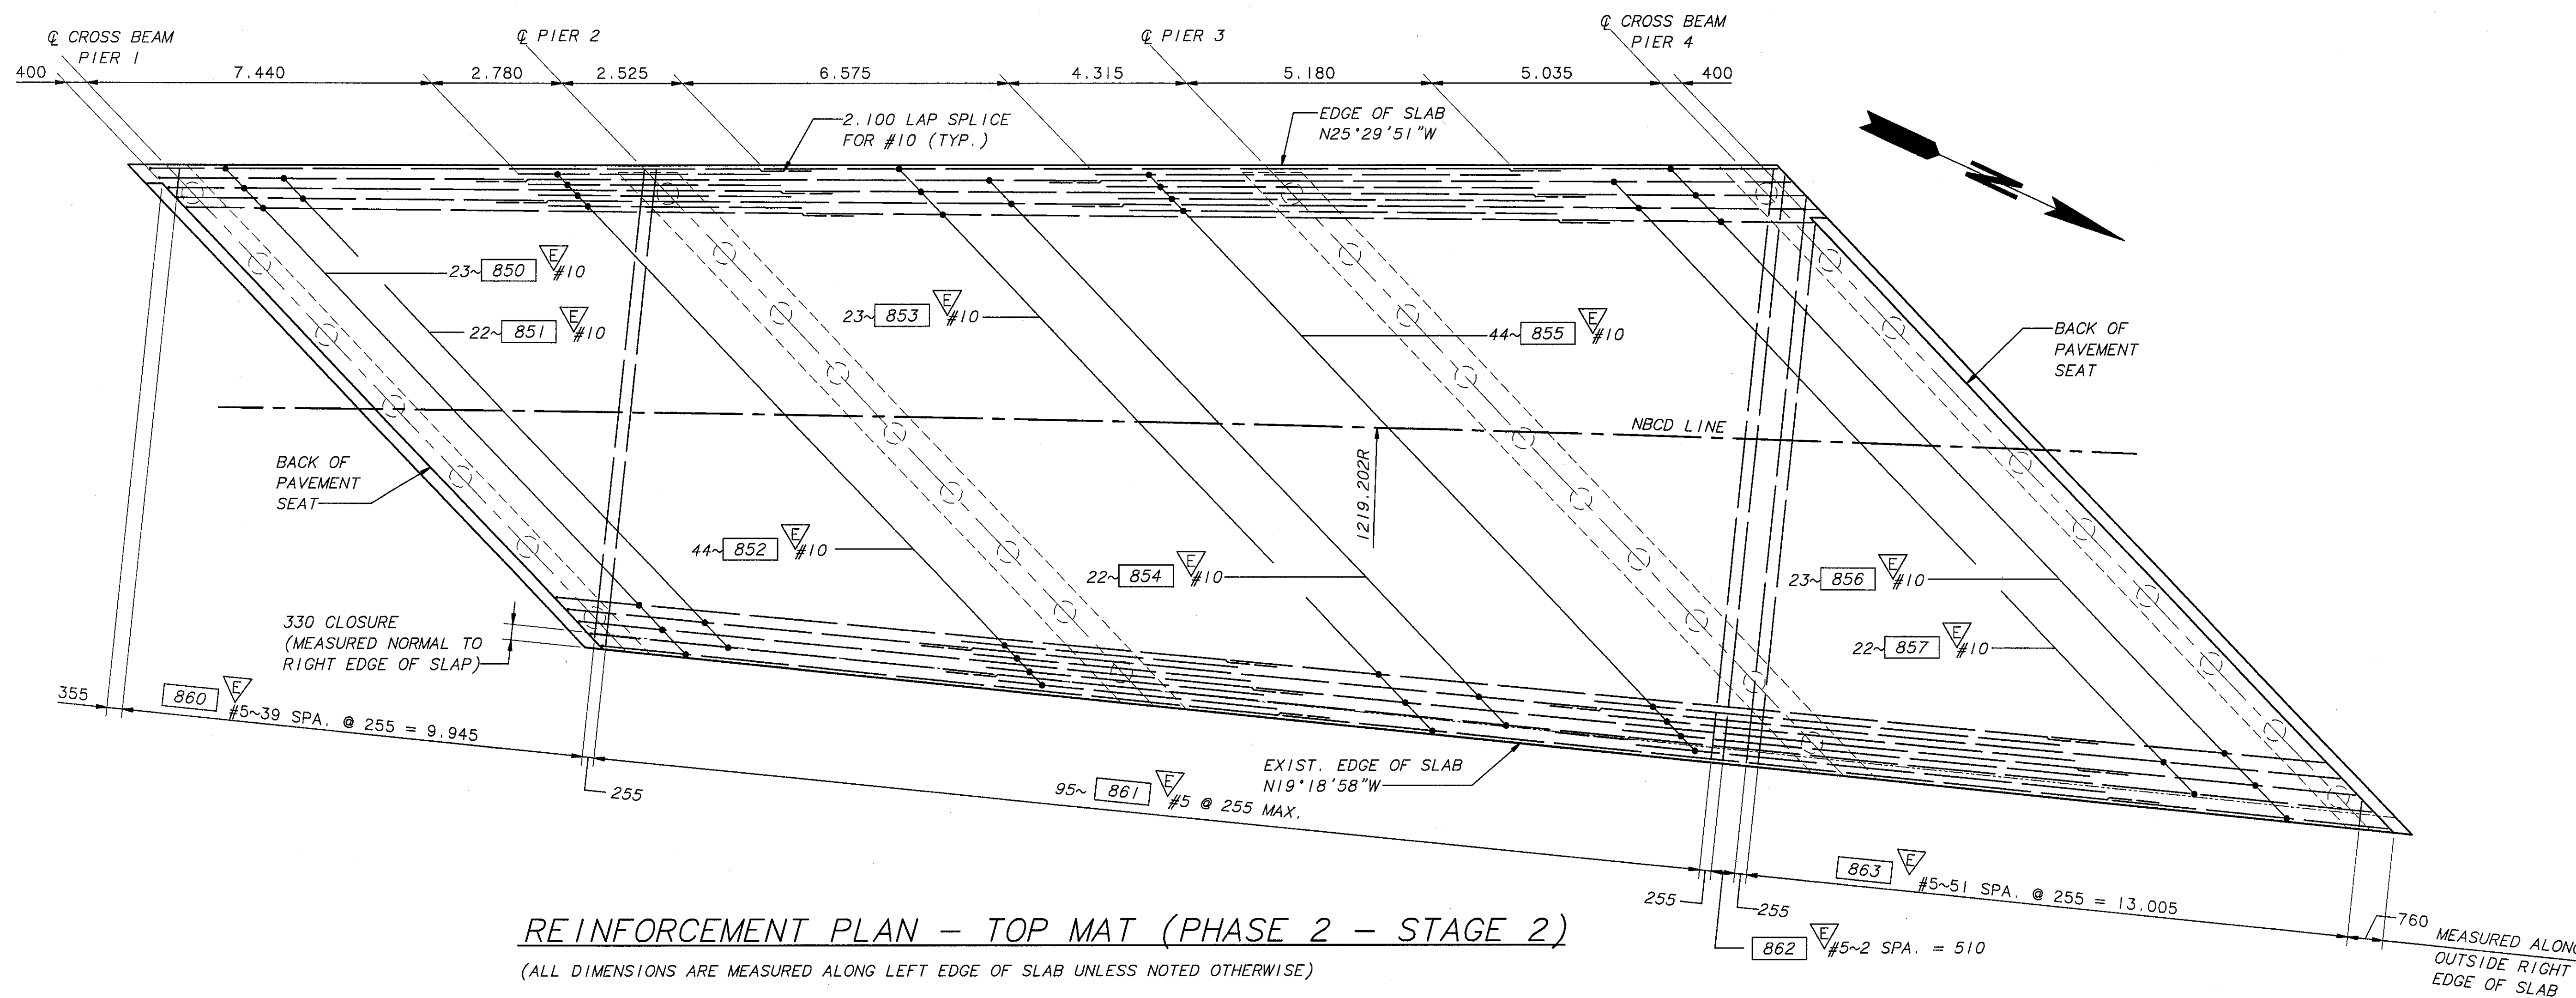


REINFORCEMENT PLAN - TOP MAT (PHASE 2 - STAGE 2)

(ALL DIMENSIONS ARE MEASURED ALONG LEFT EDGE OF SLAB UNLESS NOTED OTHERWISE)

PLOTTED: Tue Nov 12 1996 11:48am FILENAME: X:\196077\BR72\NBCD\12.DWG SCALE: 75
 SR 405 JOB NO. 7071 SHEET 12 OF 19

BRIDGE DESIGN ENGR		REGION NO	STATE	FED AID PROJ NO	SHEET NO	TOTAL SHEETS
SUPERVISOR		1	WASH			
DESIGNED BY	K. HINKLEY 6/96	JOB NUMBER		96W035		
CHECKED BY	C. CORNELL 6/96	CONTRACT NO.		5054		
DATE	REVISION	BY	APPR			

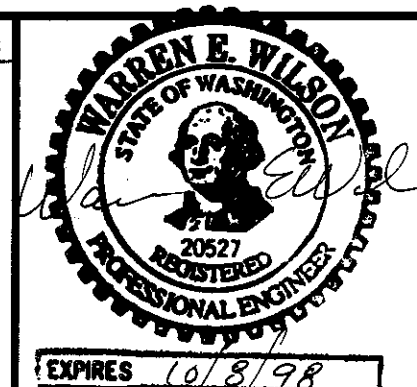


BERGER/ABAM
 ENGINEERS INC.
 33301 9TH AVENUE SOUTH
 FEDERAL WAY, WASHINGTON 98003-6396
 (206)451-2300 FAX: (206)451-2250




SR 405
 BOTHELL TO SWAMP CREEK I/C
 HOV LANES - STAGE 1
 NORTH CREEK BRIDGE 405/72 NBCD
 REINF. PLAN - TOP MAT (STAGE 2)

BRIDGE SHEET NO. 12
 SHEET 491 OF 663 SHEETS

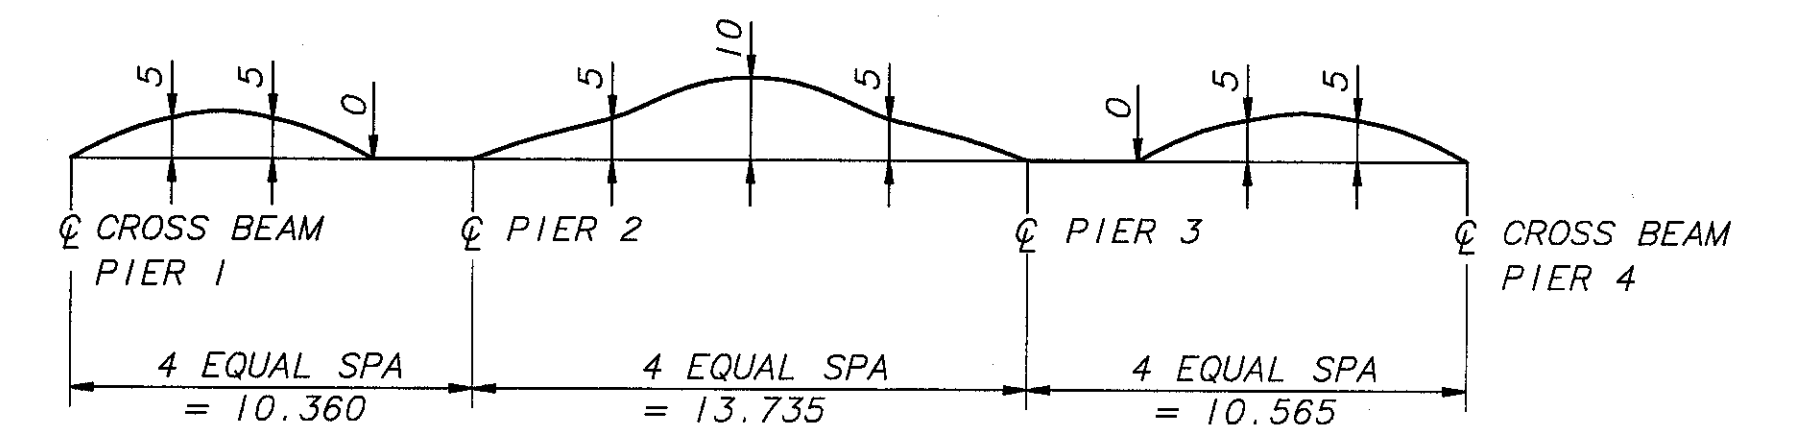

CAMBER DIAGRAM
MEASURED ALONG ϕ NBDC LINE

NOTE: THIS CURVE SHOWS THE DEAD LOAD CAMBER ONLY AND SHALL BE INCREASED BY THE AMOUNT OF ANTICIPATED TAKEUP IN THE FALSEWORK.

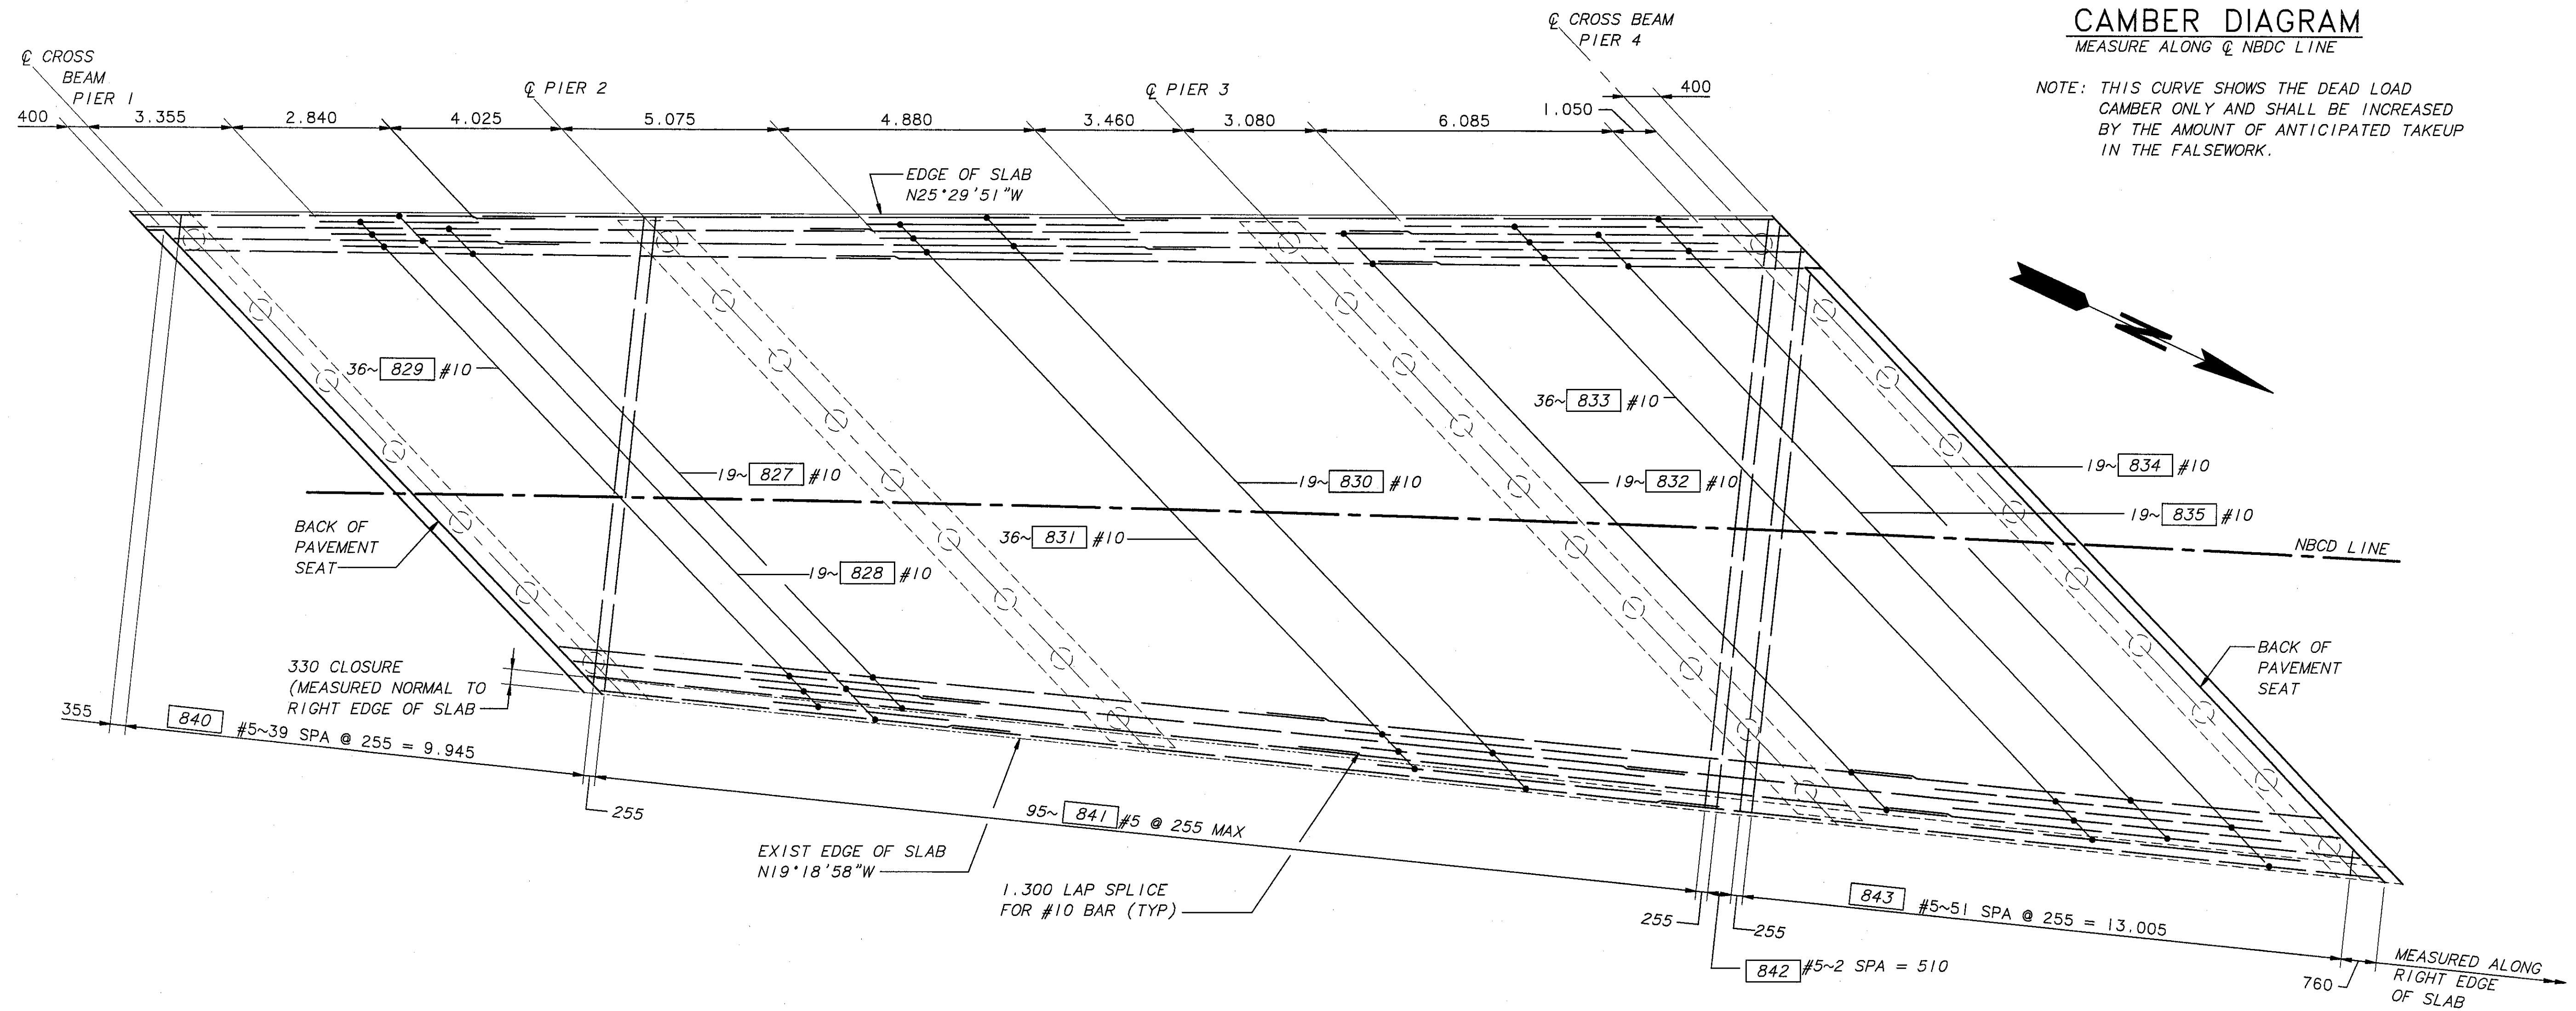


REINFORCEMENT PLAN - BOTTOM MAT (PHASE 2 - STAGE 2)

(ALL DIMENSIONS ARE MEASURED ALONG LEFT EDGE OF SLAB UNLESS NOTED OTHERWISE)

PLOTTED: Tue Nov 12 1996 11:49am FILENAME: X:\496077\BR72\NBDC\13.DWG SCALE: 75 SR 405 JOB NO. 7071 SHEET 13 OF 19

BRIDGE DESIGN ENGR					
SUPERVISOR					
DESIGNED BY	K. HINKLEY	6/96			
CHECKED BY	C. CORNELL	6/96			
DETAILED BY	T. BRENNAN	6/96			
BRIDGE PROJECTS ENGR					
PRELIM PLAN BY					
ARCHITECT/SPECIALIST					
DATE	REVISION	BY	APPR		

REGION NO.	STATE	FED AID PROJ NO.	SHEET NO.	TOTAL SHEETS
1	WASH			
JOB NUMBER		96W035		
CONTRACT NO.		5054		

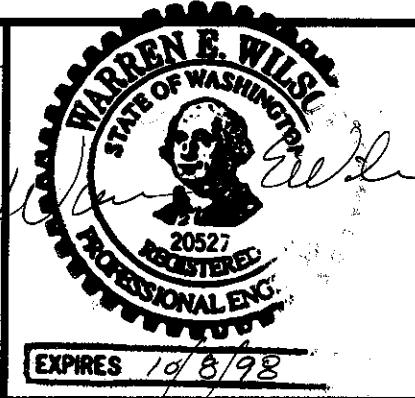


BERGER/ABAM
ENGINEERS INC.
33301 9TH AVENUE SOUTH
FEDERAL WAY, WASHINGTON 98003-8395
(206)431-2300 FAX: (206)431-2250



SR 405
BOTHELL TO SWAMP CREEK 1/C
HOV LANES - STAGE 1
NORTH CREEK BRIDGE 405/72 NBDC
REINF. PLAN - BOTTOM MAT (STAGE 2)


BRIDGE SHEET NO. 13
SHEET 492 OF 663 SHEETS

3A)13*


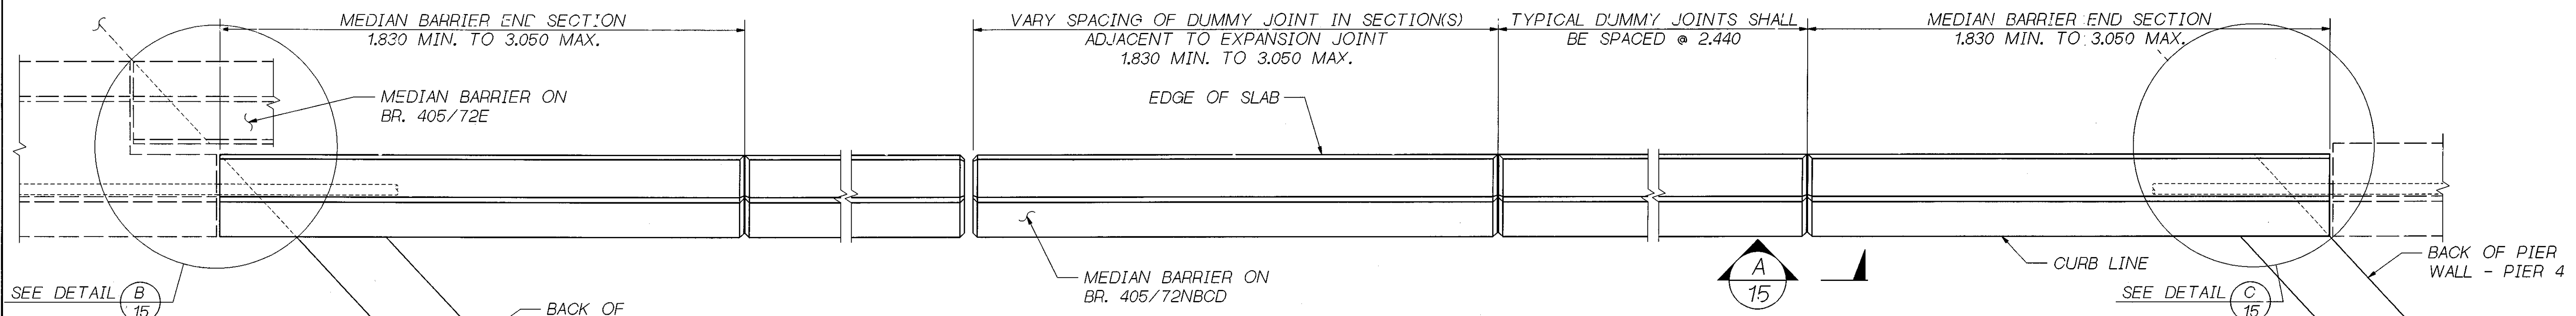


**PLAN
MEDIAN BARRIER**

BARRIER CONTINUOUS BETWEEN ROADWAY EXPANSION JOINTS. CONSTRUCTION JOINTS WITH SHEAR KEYS ARE PERMISSIBLE AT DUMMY JOINT LOCATIONS. FORM JOINTS BETWEEN DUMMY JOINTS SHALL NOT BE PERMITTED.

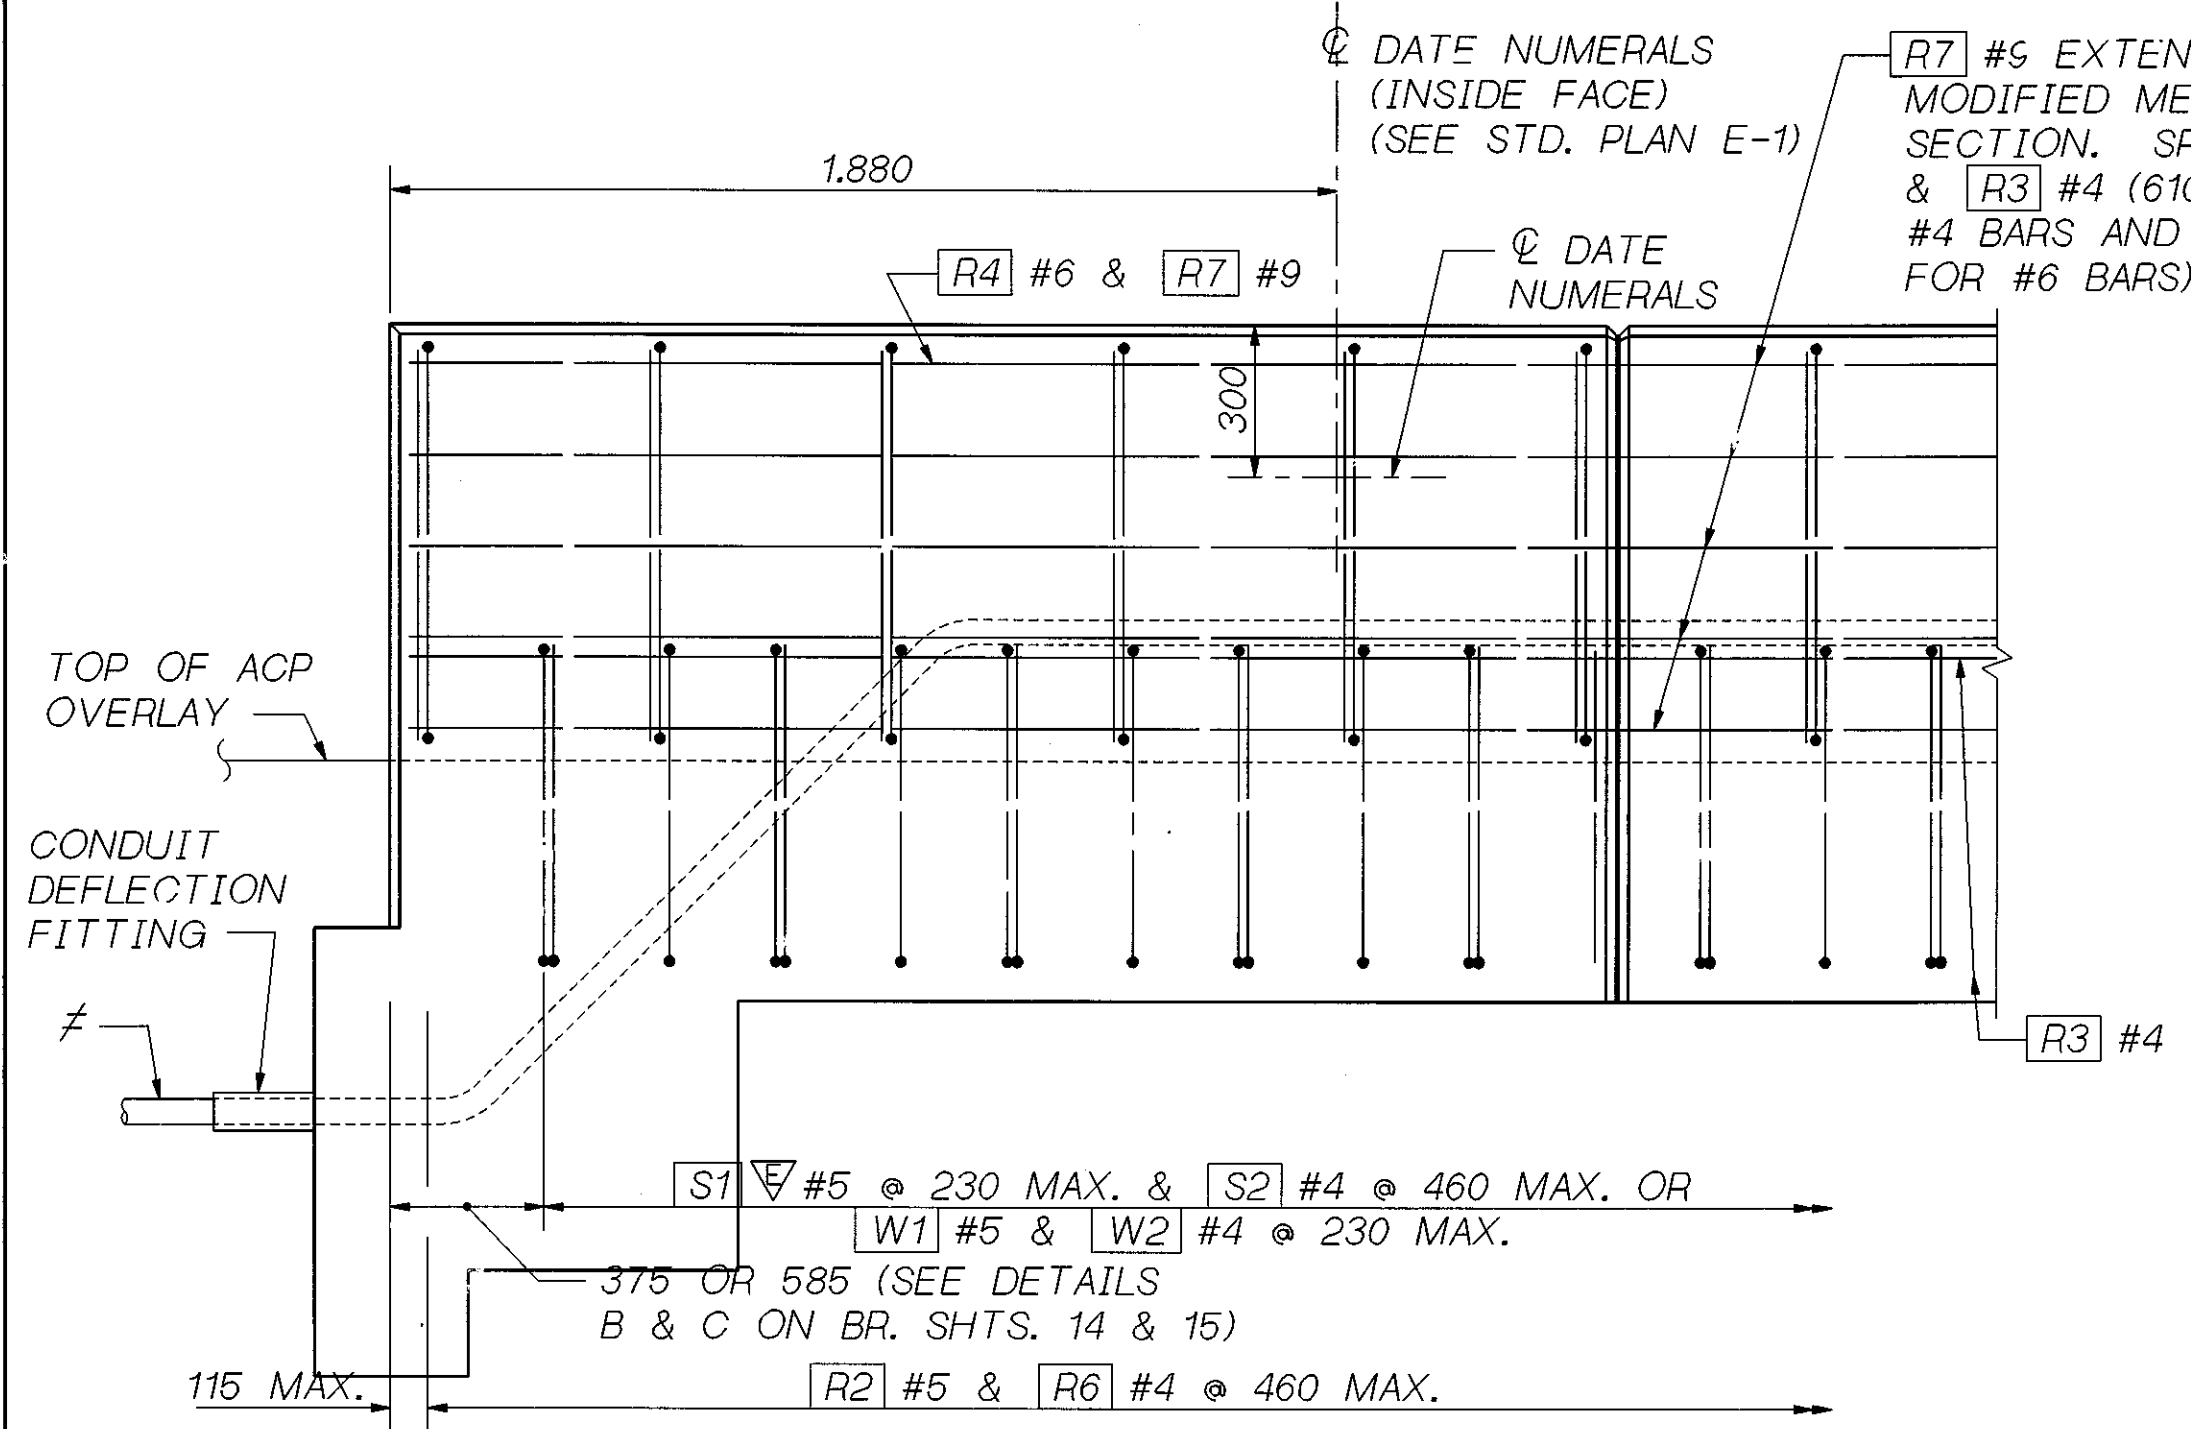

**OUTSIDE ELEVATION
END OF MEDIAN BARRIER**

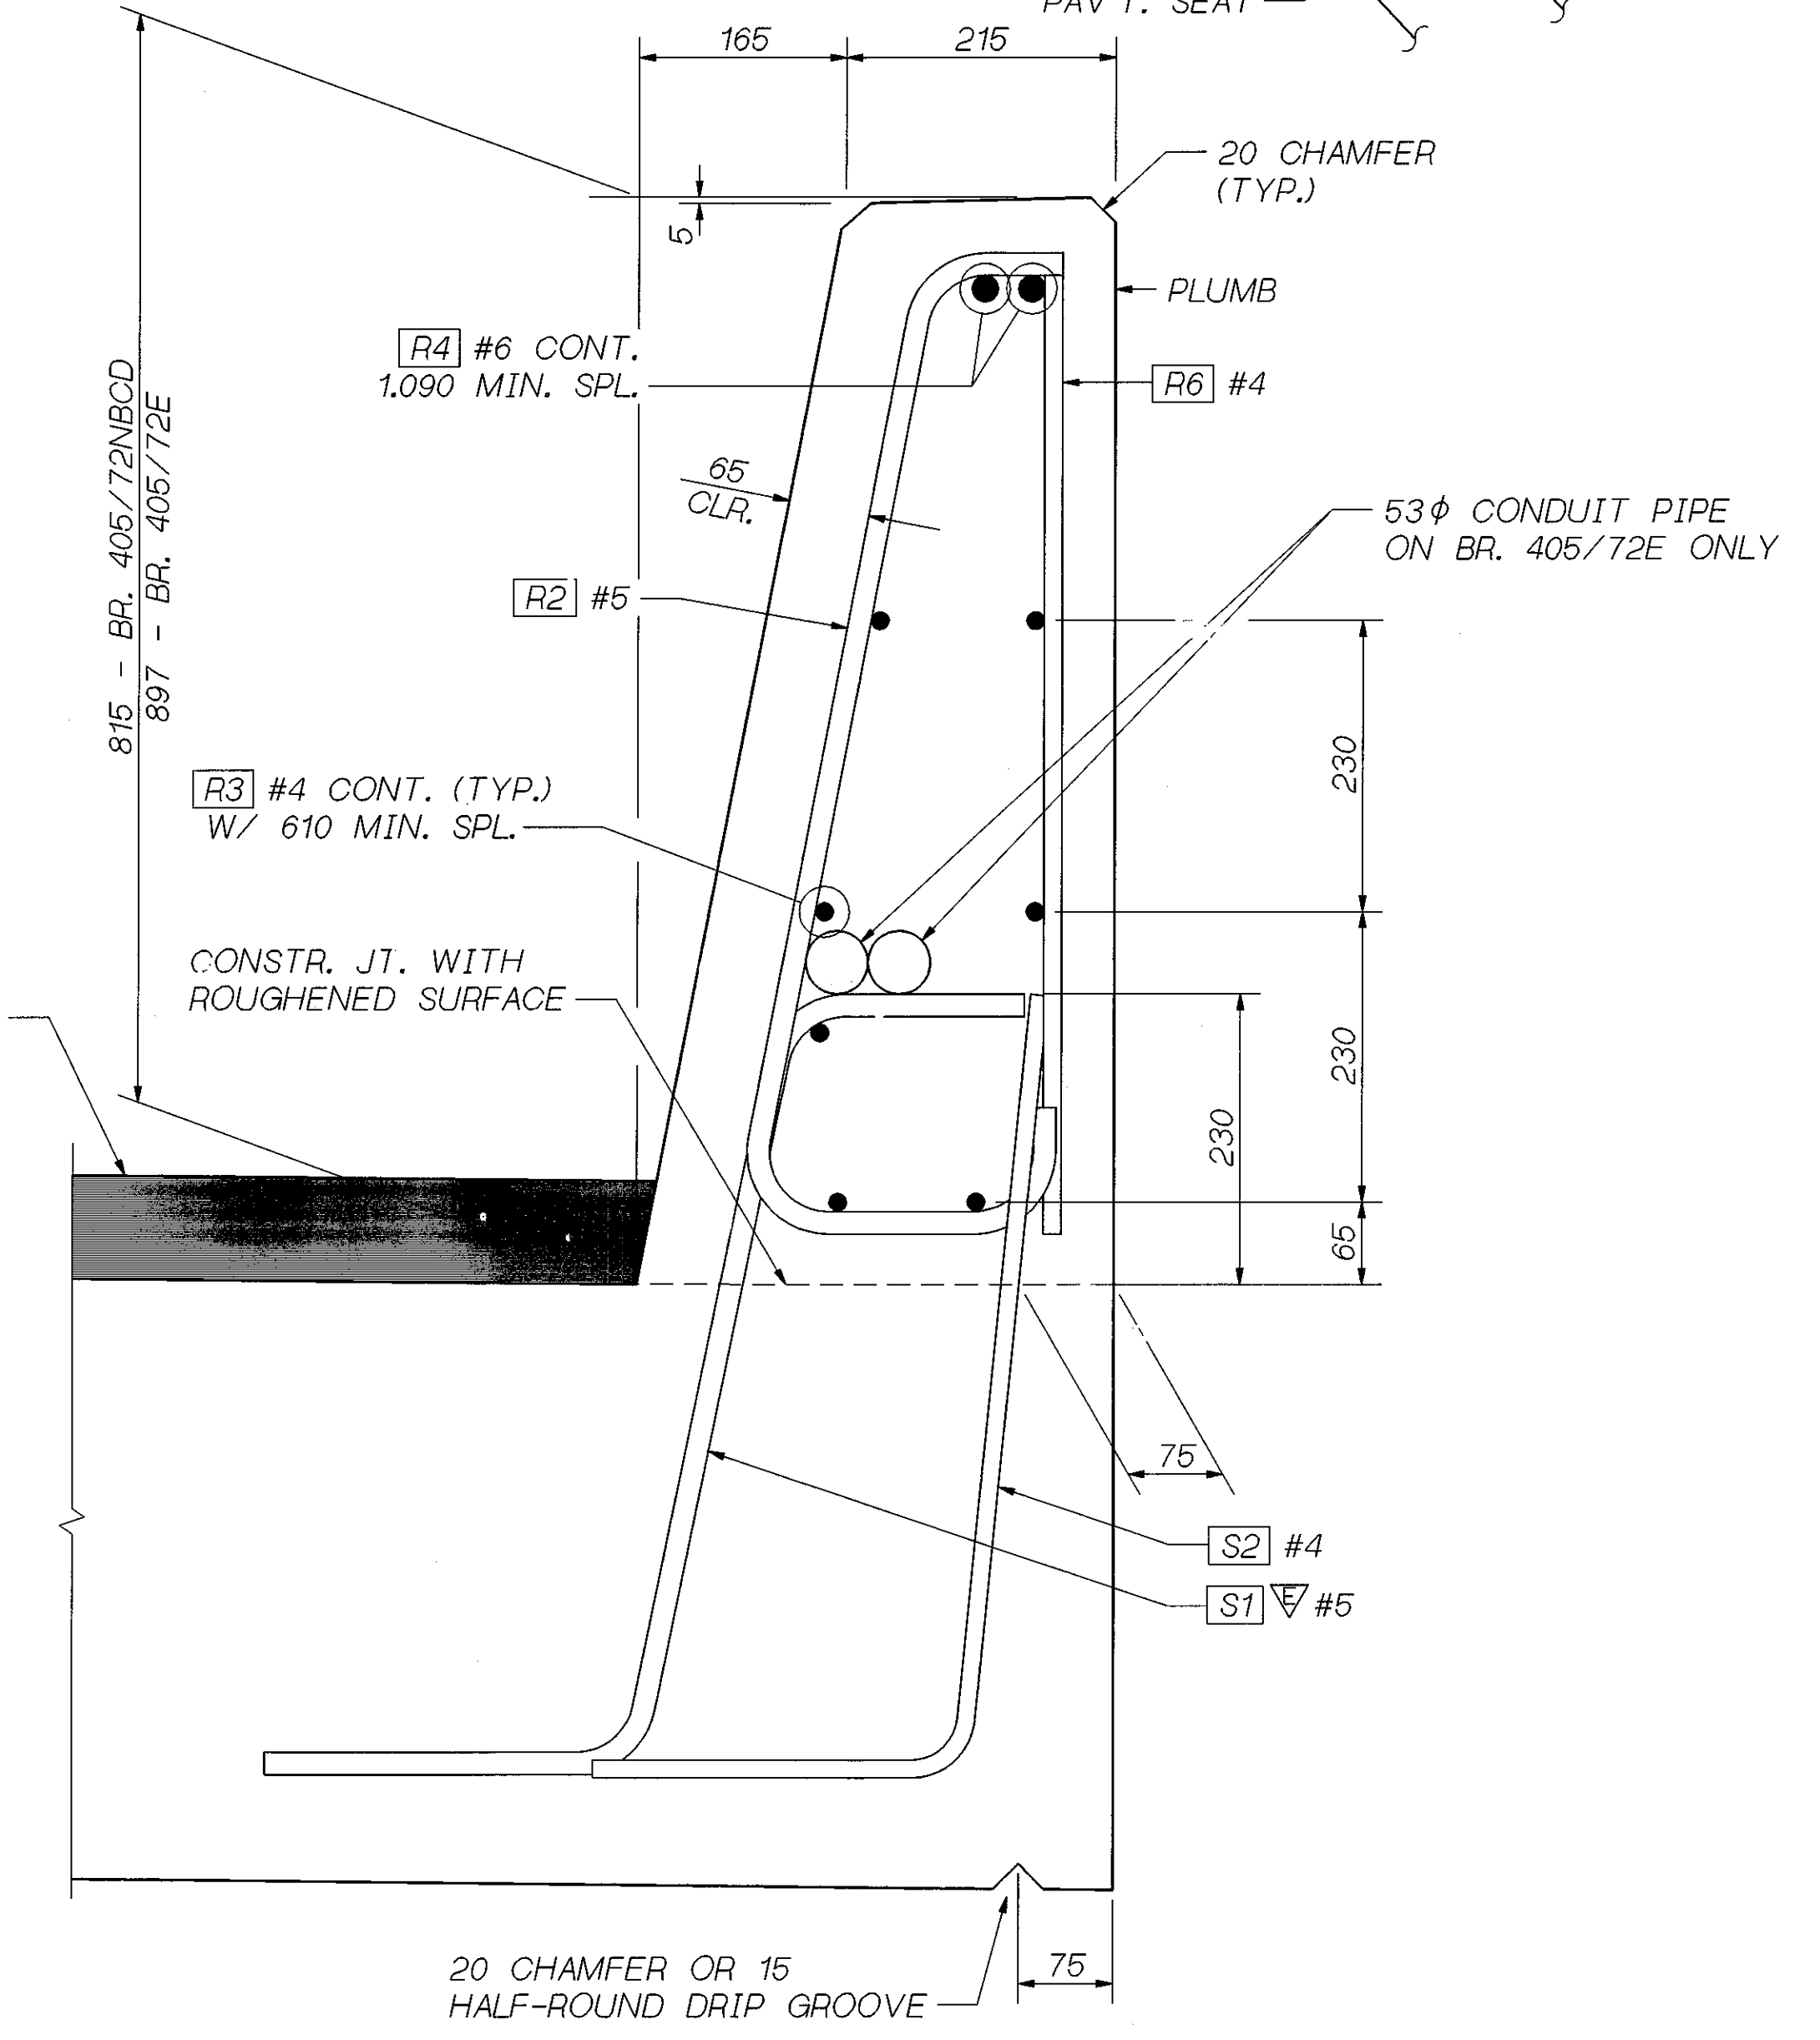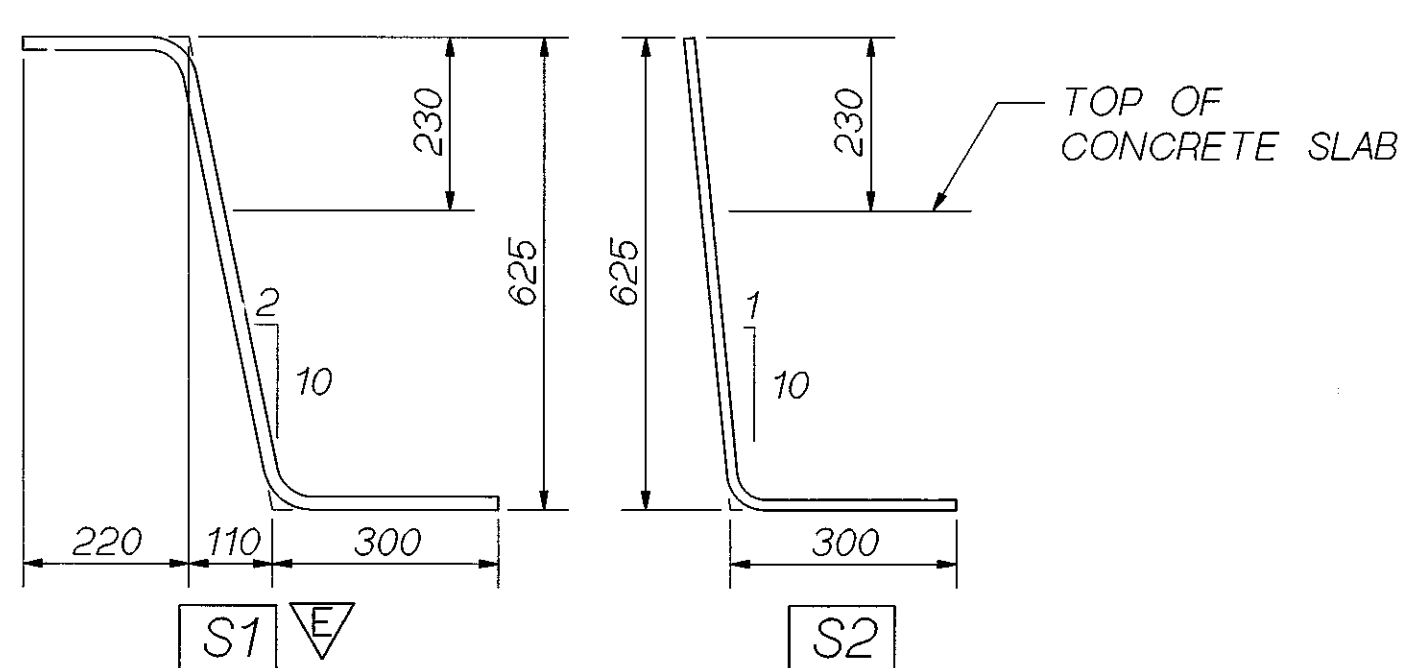


TYPICAL SECTION - MEDIAN BARRIER

MEDIAN BARRIER FOR BR. 405/72E SHOWN, MEDIAN BARRIER FOR BR. 405/72NBCD SIMILAR.

≠ TERMINATE EACH CONDUIT PIPE AT SEPARATE TYPE 1 JUNCTION BOX OFF END OF BRIDGE.

SR 405 JOB NO. 7071 SHEET 14


Bridge Design Engr.	NBCDROOT:\000000.FGB\TB_MED_1.FGB: 1	REGION NO.	STATE	FED. AID PROJ. NO.	SHEET NO.	TOTAL SHEETS
Supervisor		10	WASH.			
Designed By K. HINKLEY	6/96	JOB NUMBER		96W035		
Checked By C. CORNELL	6/96	DATE		5054		
Detailed By D.W. PULSE JR.	6/96	REVISION		BY APP'D		
Bridge Projects Engr.		DATE		BY APP'D		
Prelim. Plan By		DATE		BY APP'D		
Architect/Specialist		DATE		BY APP'D		

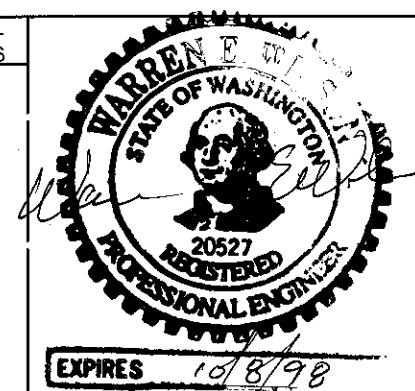


SR 405
BOTHELL TO SWAMP CREEK 1/C
HOV LANES - STAGE 1
NORTH CREEK BRIDGE 405/72 NBCD
MEDIAN BARRIER 1 OF 2

BRIDGE SHEET NO. 14
SHEET 493 OF 663 SHEETS

STANDARD DATE NUMERALS
(NO DATE PANEL)
ON RIGHT OF APPROACH SIDE(S)

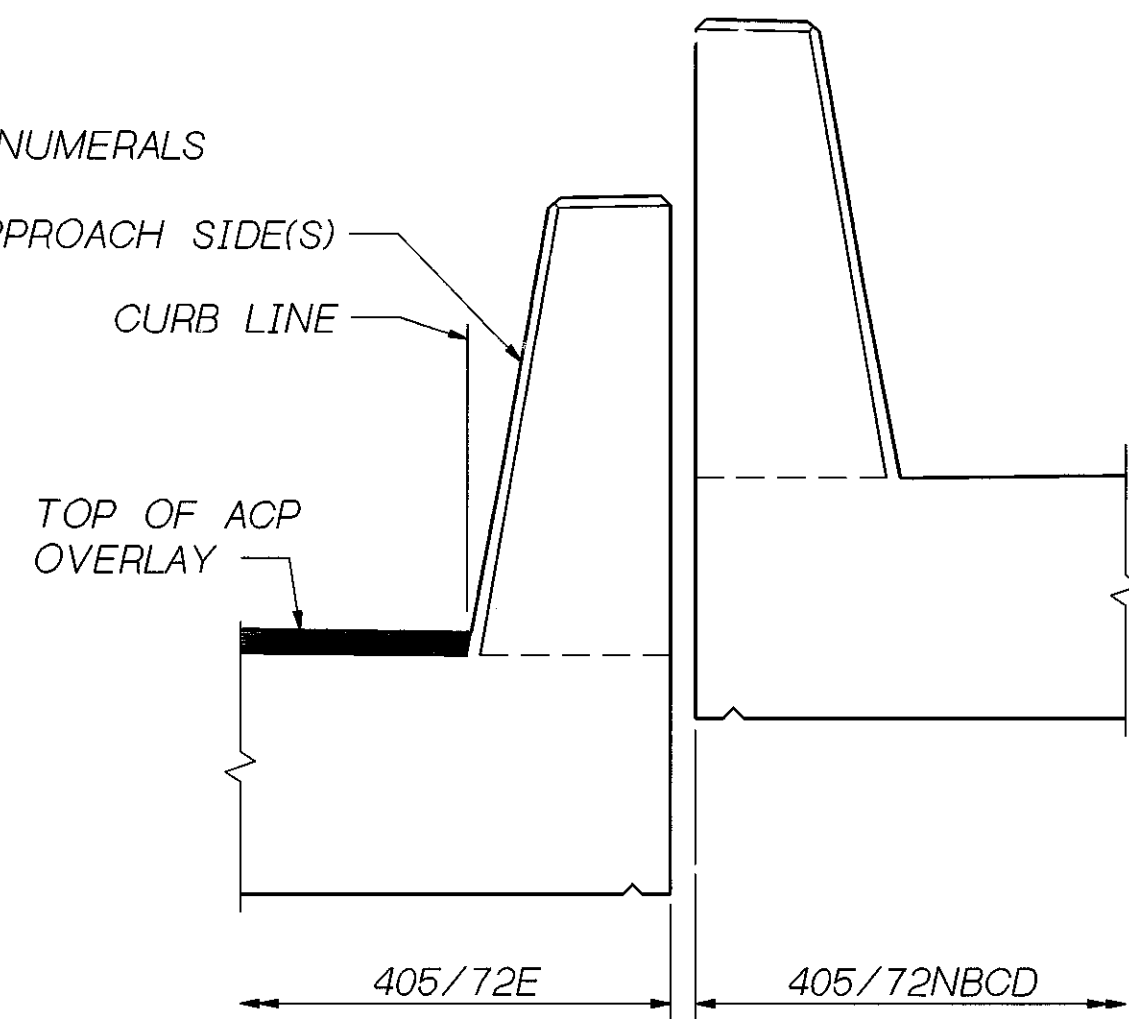


END VIEW

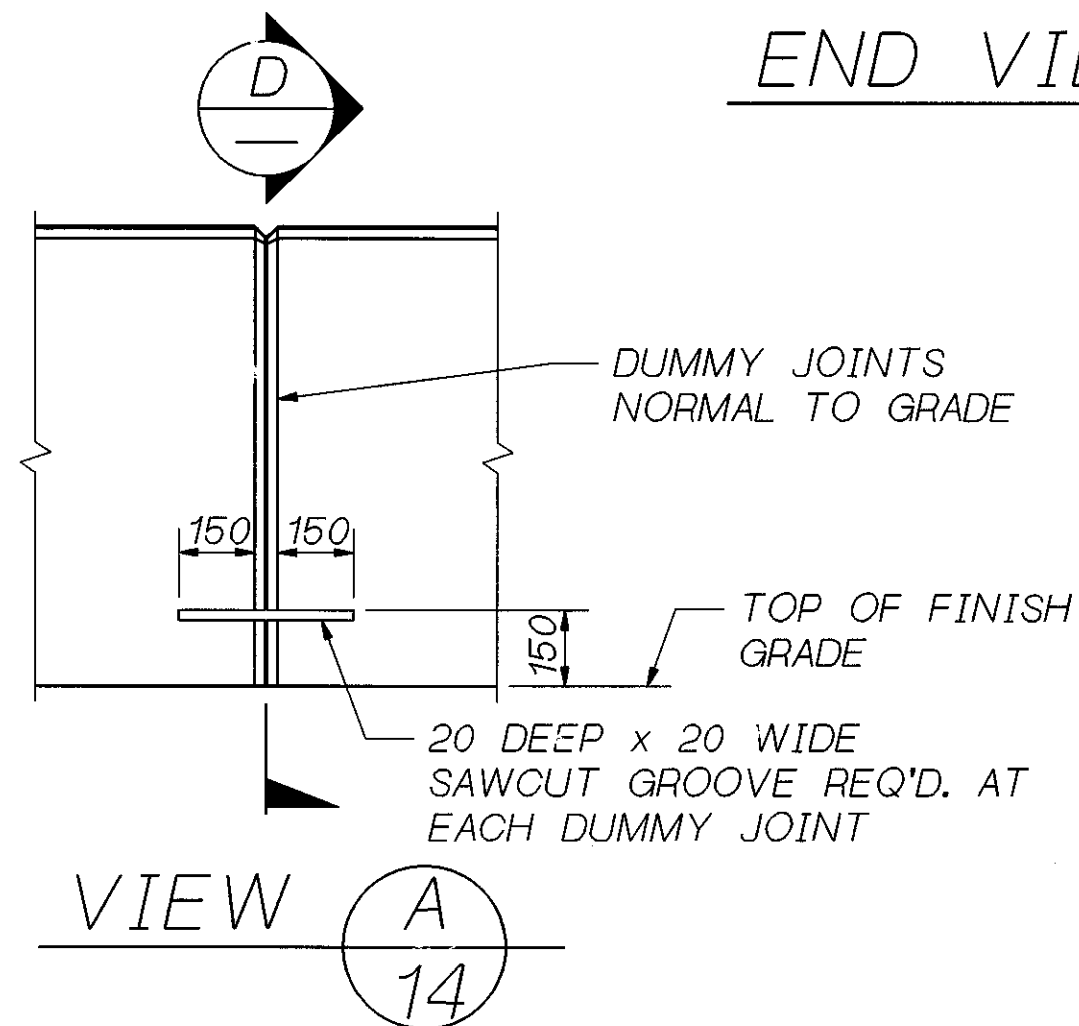


VIEW A
14

NOTE: CONCRETE SURFACE CONSTRUCTION TOLERANCE OF 5 mm IN 3.000 (MAX.) IS REQ'D. FOR TRAFFIC SIDE OF BARRIER.

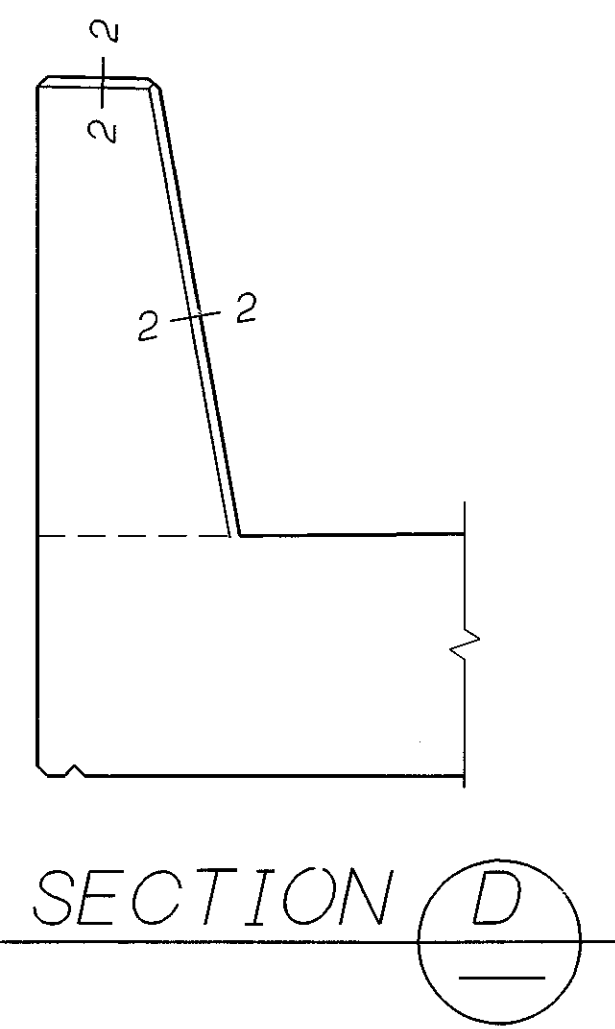


SECTION D
14

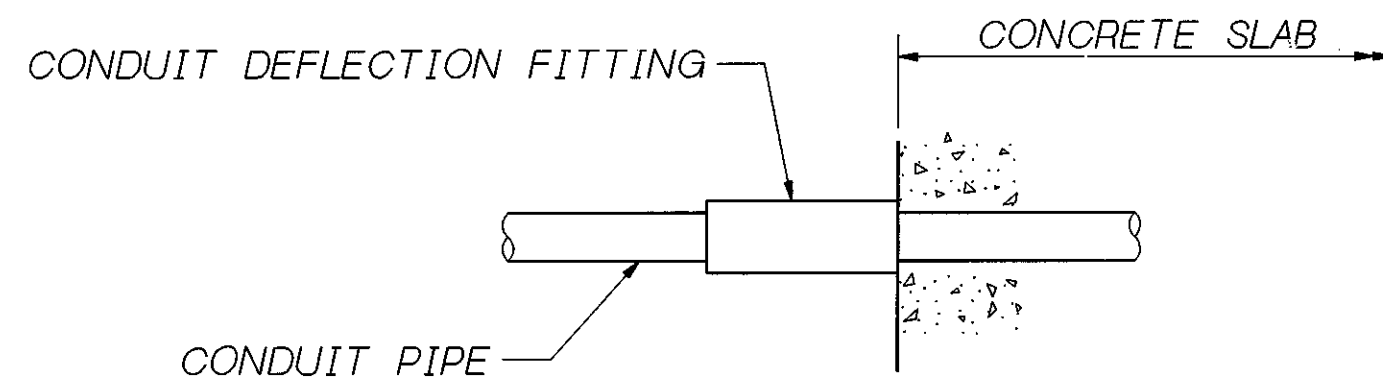


CONDUIT DEFLECTION FITTING

TYPE DX CONDUIT FITTING FOR DEFLECTION OF 30° AND 20 MOVEMENT PLACE AT CONDUIT PIPE EXIT FROM STRUCTURE.

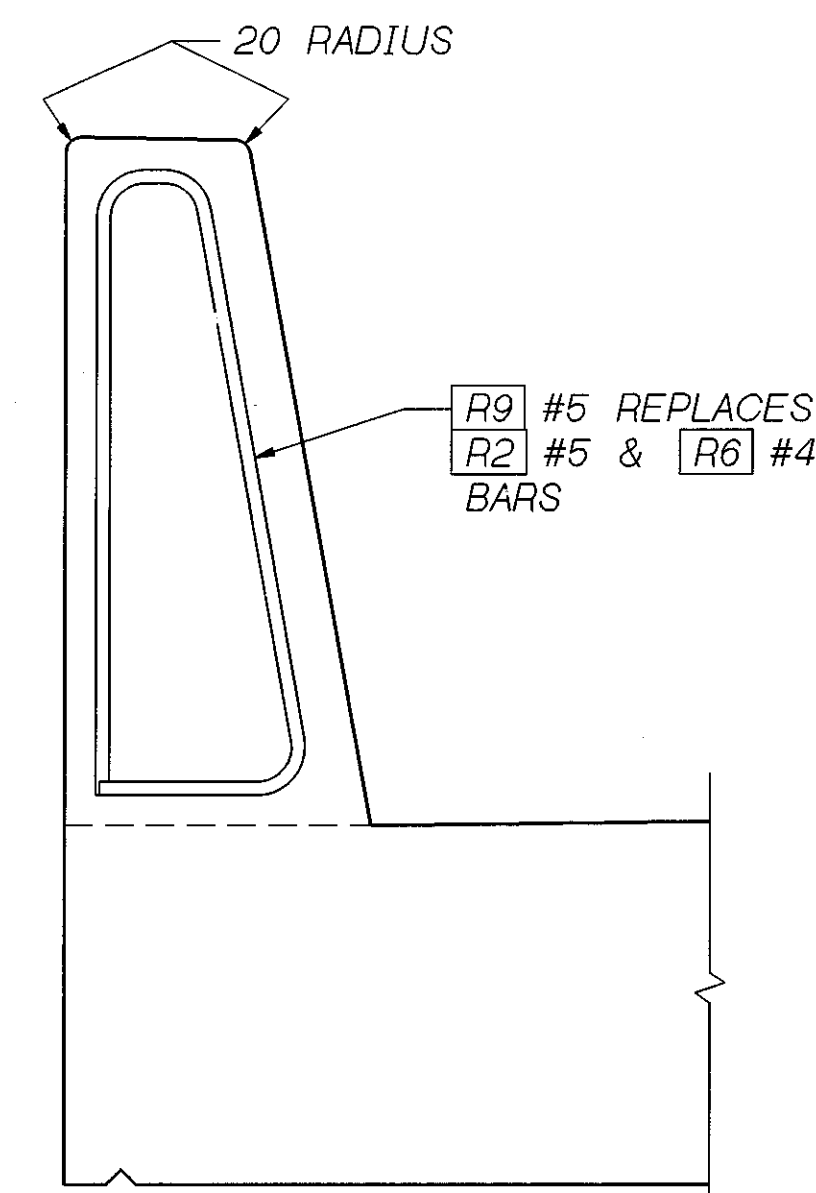


SLIPFORM ALTERNATE


SEE TYPICAL SECTION - MEDIAN BARRIER FOR ADDITIONAL DETAILS.

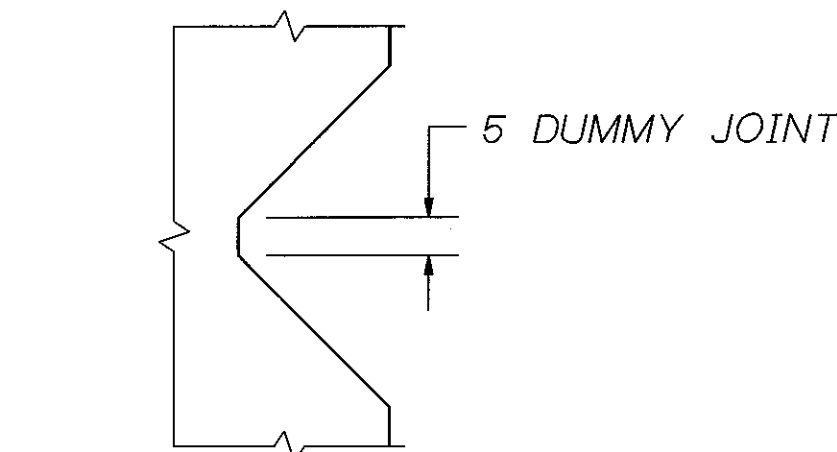

SECTION 2-2

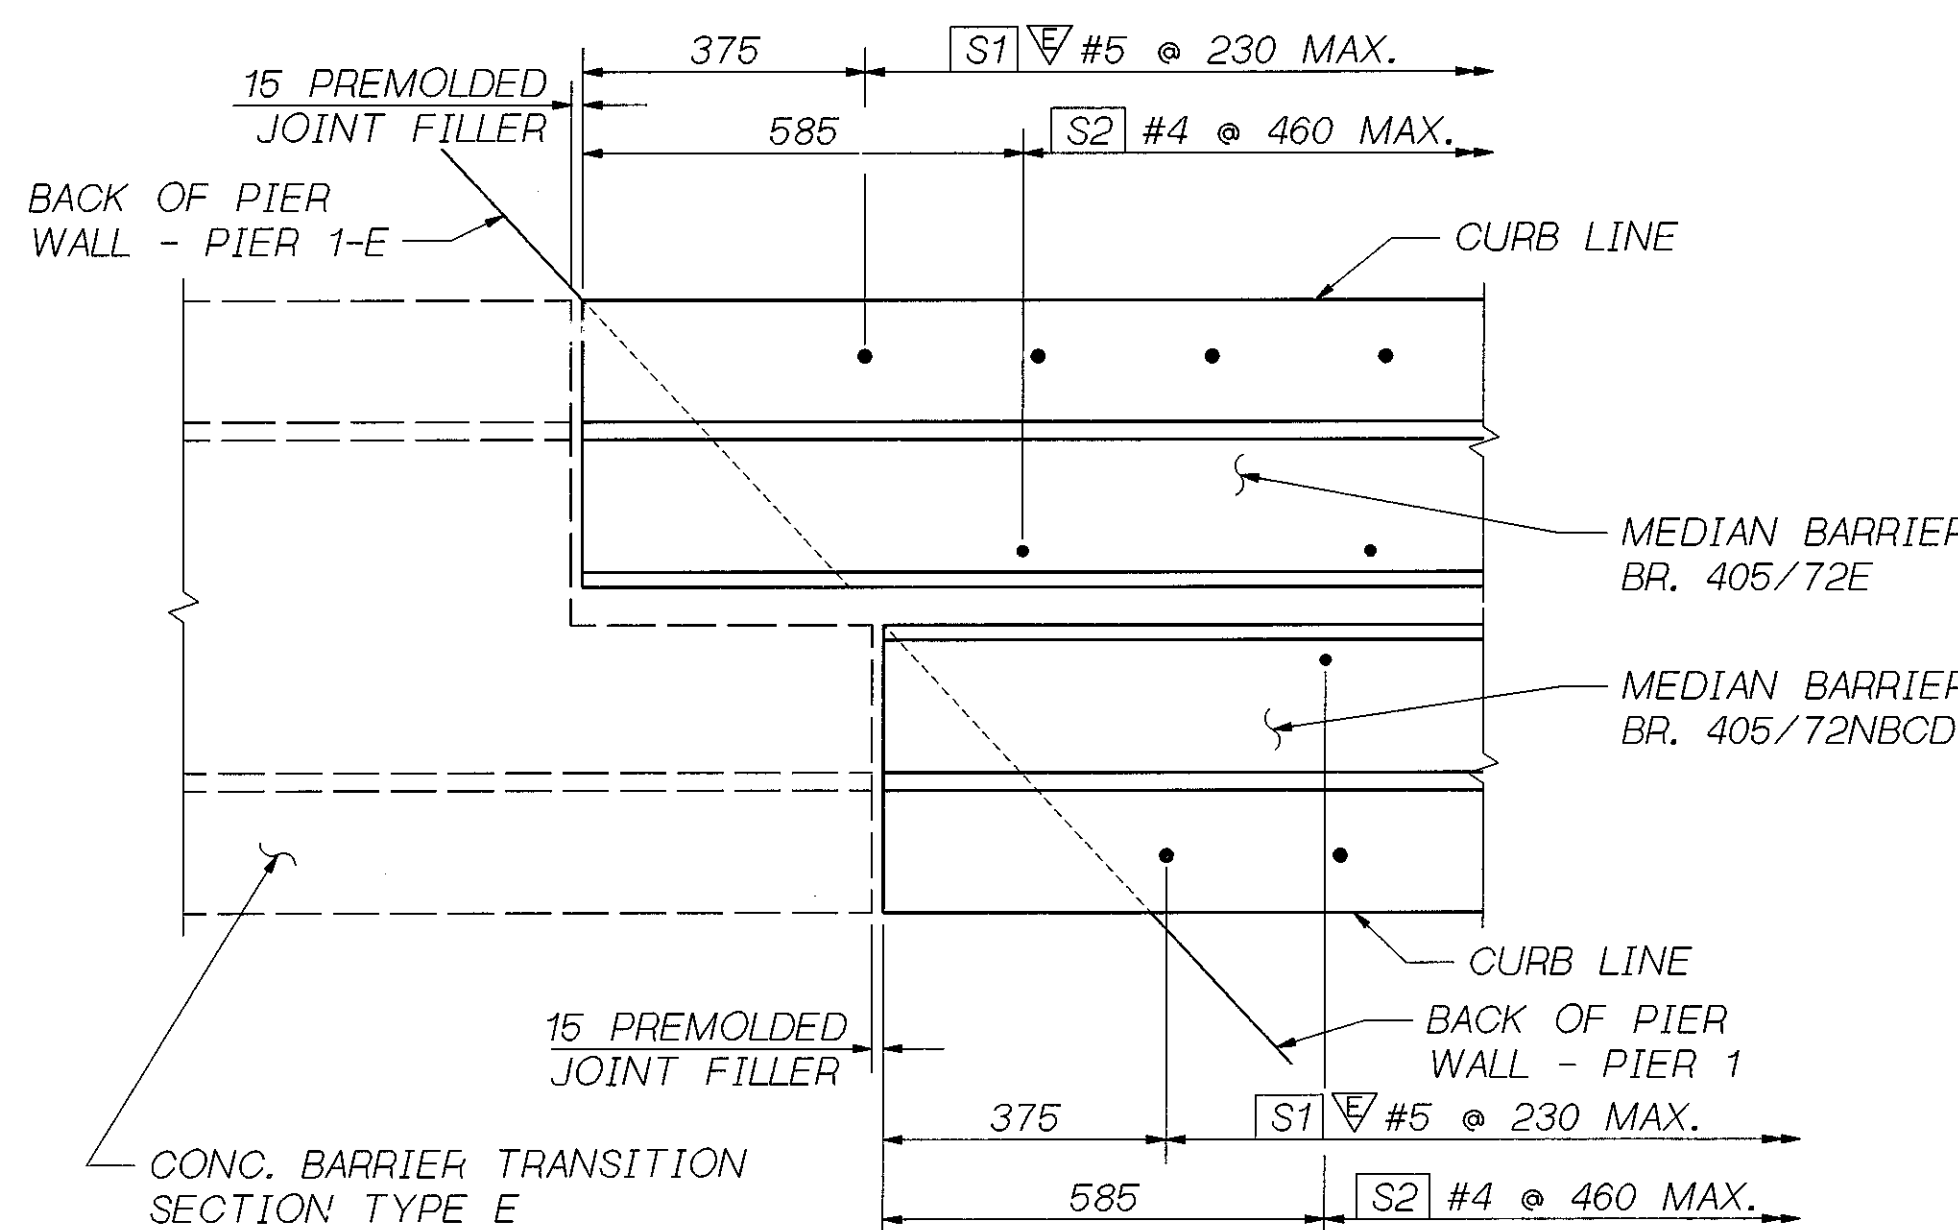

DETAIL B
14

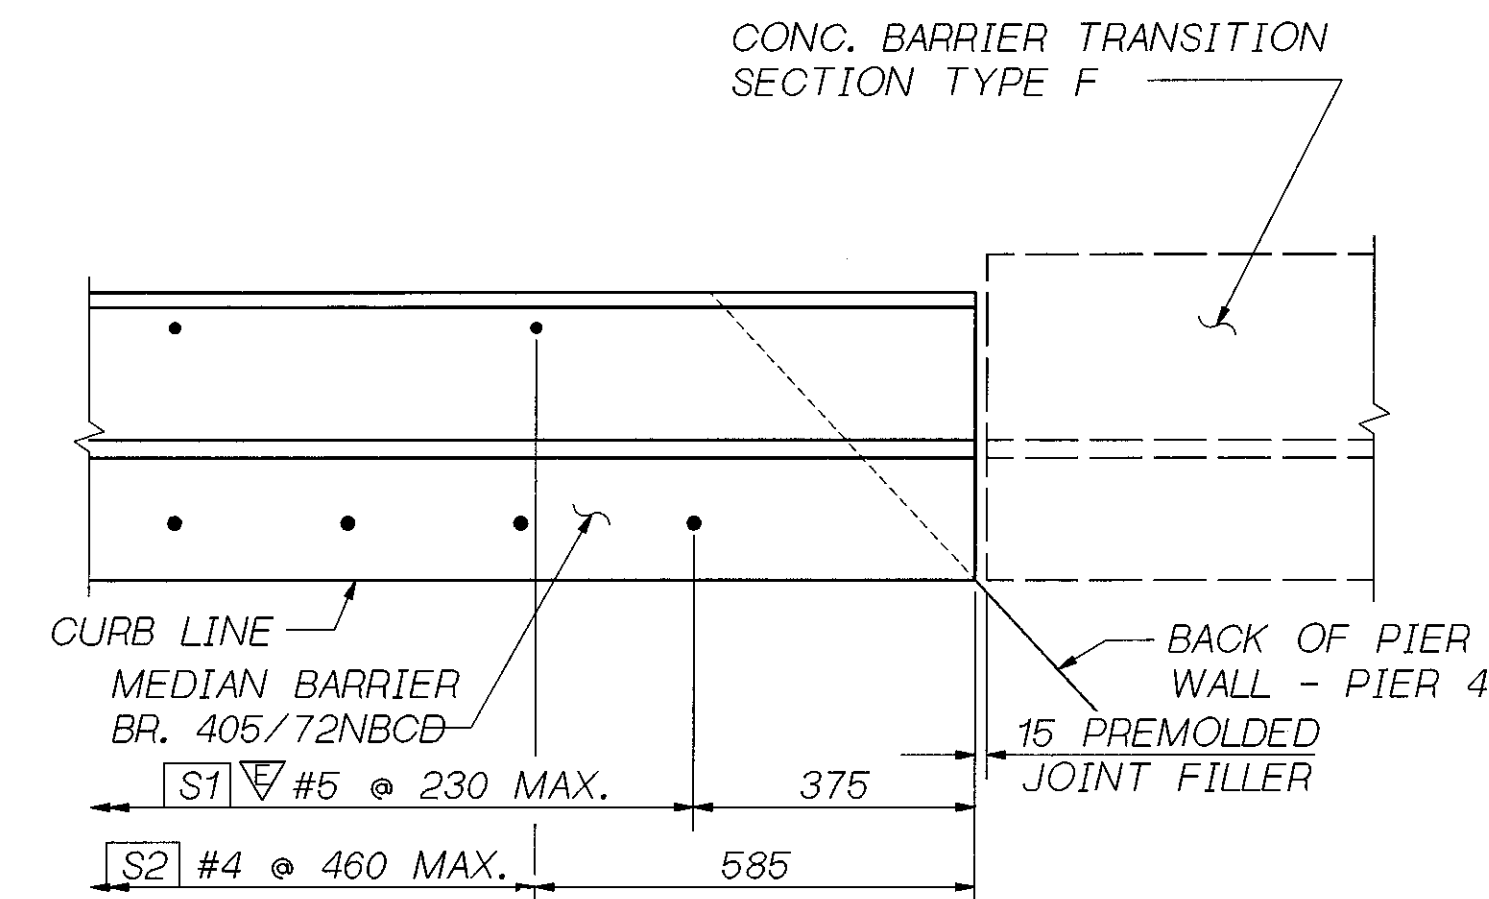

DETAIL C
14

▽ : EPOXY COATED ≠ DIMENSIONS TO POINTS OF INTERSECTION.

MEDIAN BARRIER BAR LIST

ALL REINFORCING SHALL BE AASHTO M31, GR. 60.

MARK SIZE LENGTH BENDING DIAGRAM (ALL DIMENSIONS ARE OUT TO OUT)

MARK	SIZE	LENGTH	BENDING DIAGRAM (ALL DIMENSIONS ARE OUT TO OUT)
R2	5	1.225*	<p>* DIMENSIONS SHOWN ARE FOR BR. 405/72E, TO BE INCREASED FOR BR. 405/72NBCD.</p> <p>(A) DETERMINE FROM PLANS</p> <p>FOR S1 ▽ & S2 BARS SEE BARLIST.</p>
R3	4	(A) STR.	
R4	6	(A) STR.	
R6	4	735* STR.	
R7	9	4.265 STR.	
R9	5	1.860*	

SR 405 JOB NO. 7071 SHEET 15

Bridge Design Engr.	NBCDR001-[.000000.FGB]TB_MED_2.FGB; 1	REGION NO.	STATE	FED. AID PROJ. NO.	SHEET NO.	TOTAL SHEETS
Supervisor						
Designed By	K. HINKLEY 6/96		10 WASH.			
Checked By	C. CORNELL 6/96					
Detailed By	D.W. PULSE JR. 6/96					
Bridge Projects Engr.			JOB NUMBER	96W035		
Prelim. Plan By			DATE	REVISION	BY	APP'D
Architect/Specialist					5054	




SR 405
BOTHELL TO SWAMP CREEK 1/C
HOV LANES - STAGE 1
NORTH CREEK BRIDGE 405/72 NBCD

MEDIAN BARRIER 2 OF 2

BRIDGE SHEET NO. 15
SHEET 494 OF 663 SHEETS


12-NOV-96

24/132

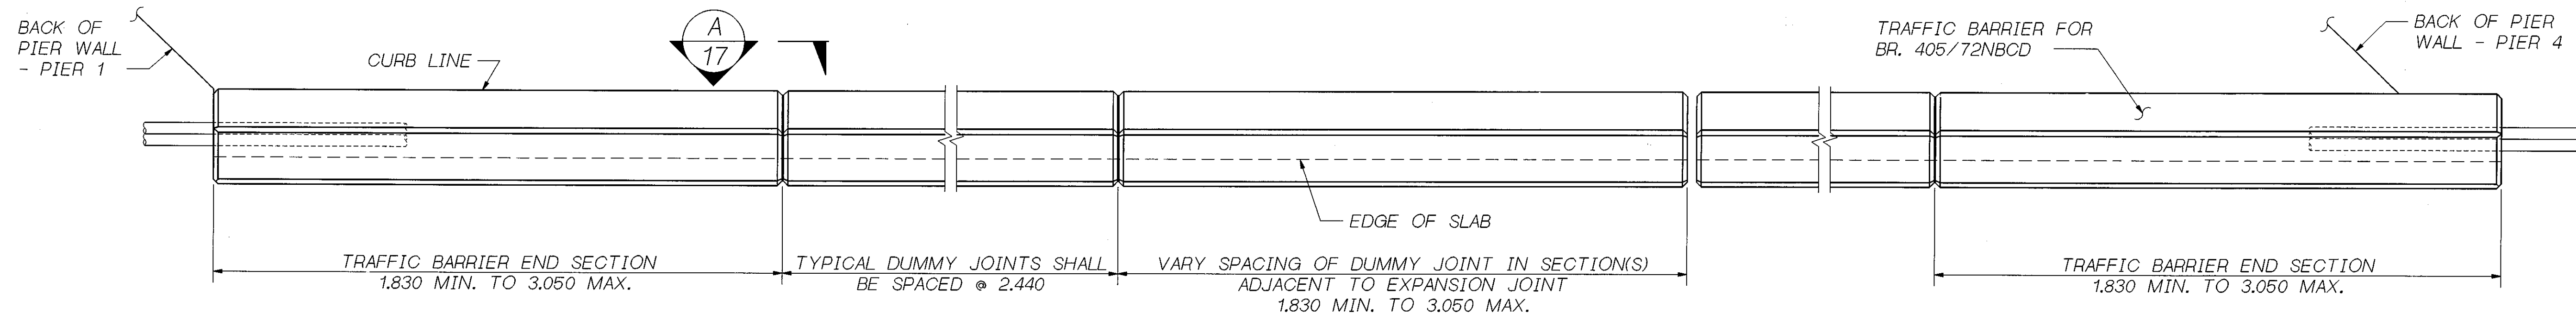


PLAN
TRAFFIC BARRIER

BARRIER CONTINUOUS BETWEEN ROADWAY EXPANSION JOINTS. CONSTRUCTION JOINTS WITH SHEAR KEYS ARE PERMISSIBLE AT DUMMY JOINT LOCATIONS. FORM JOINTS BETWEEN DUMMY JOINTS SHALL NOT BE PERMITTED.

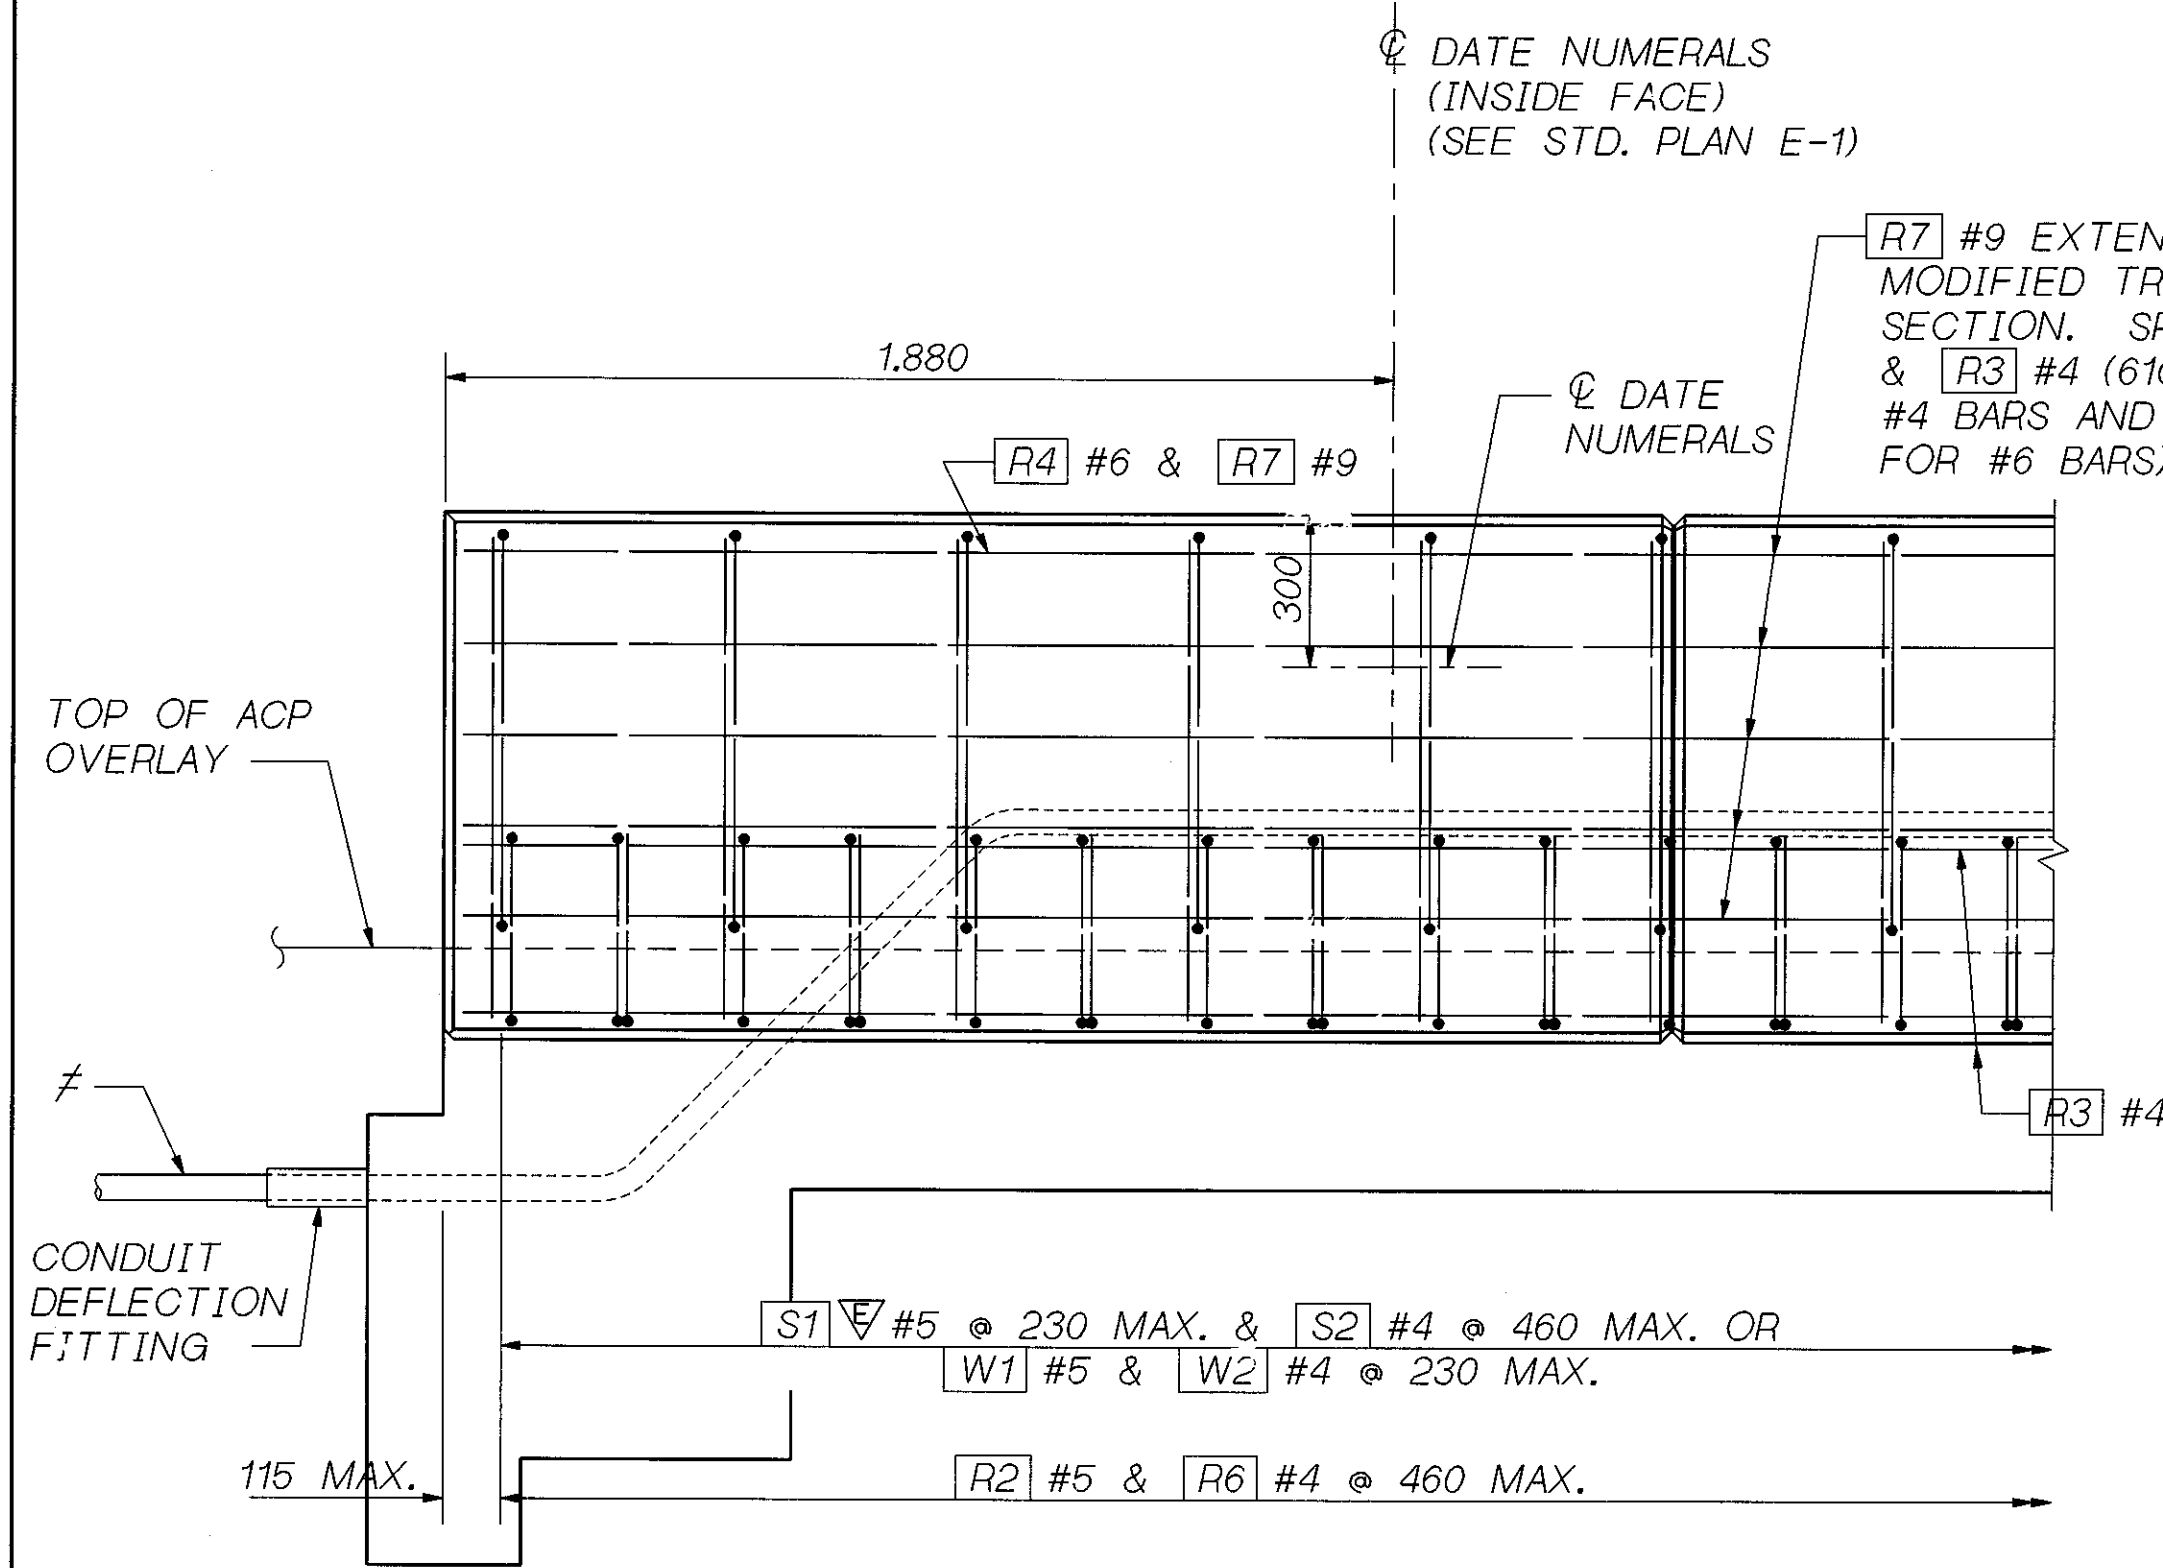


OUTSIDE ELEVATION
END OF MODIFIED TRAFFIC BARRIER

AT SE CORNER OF BR. 405/72NBCD

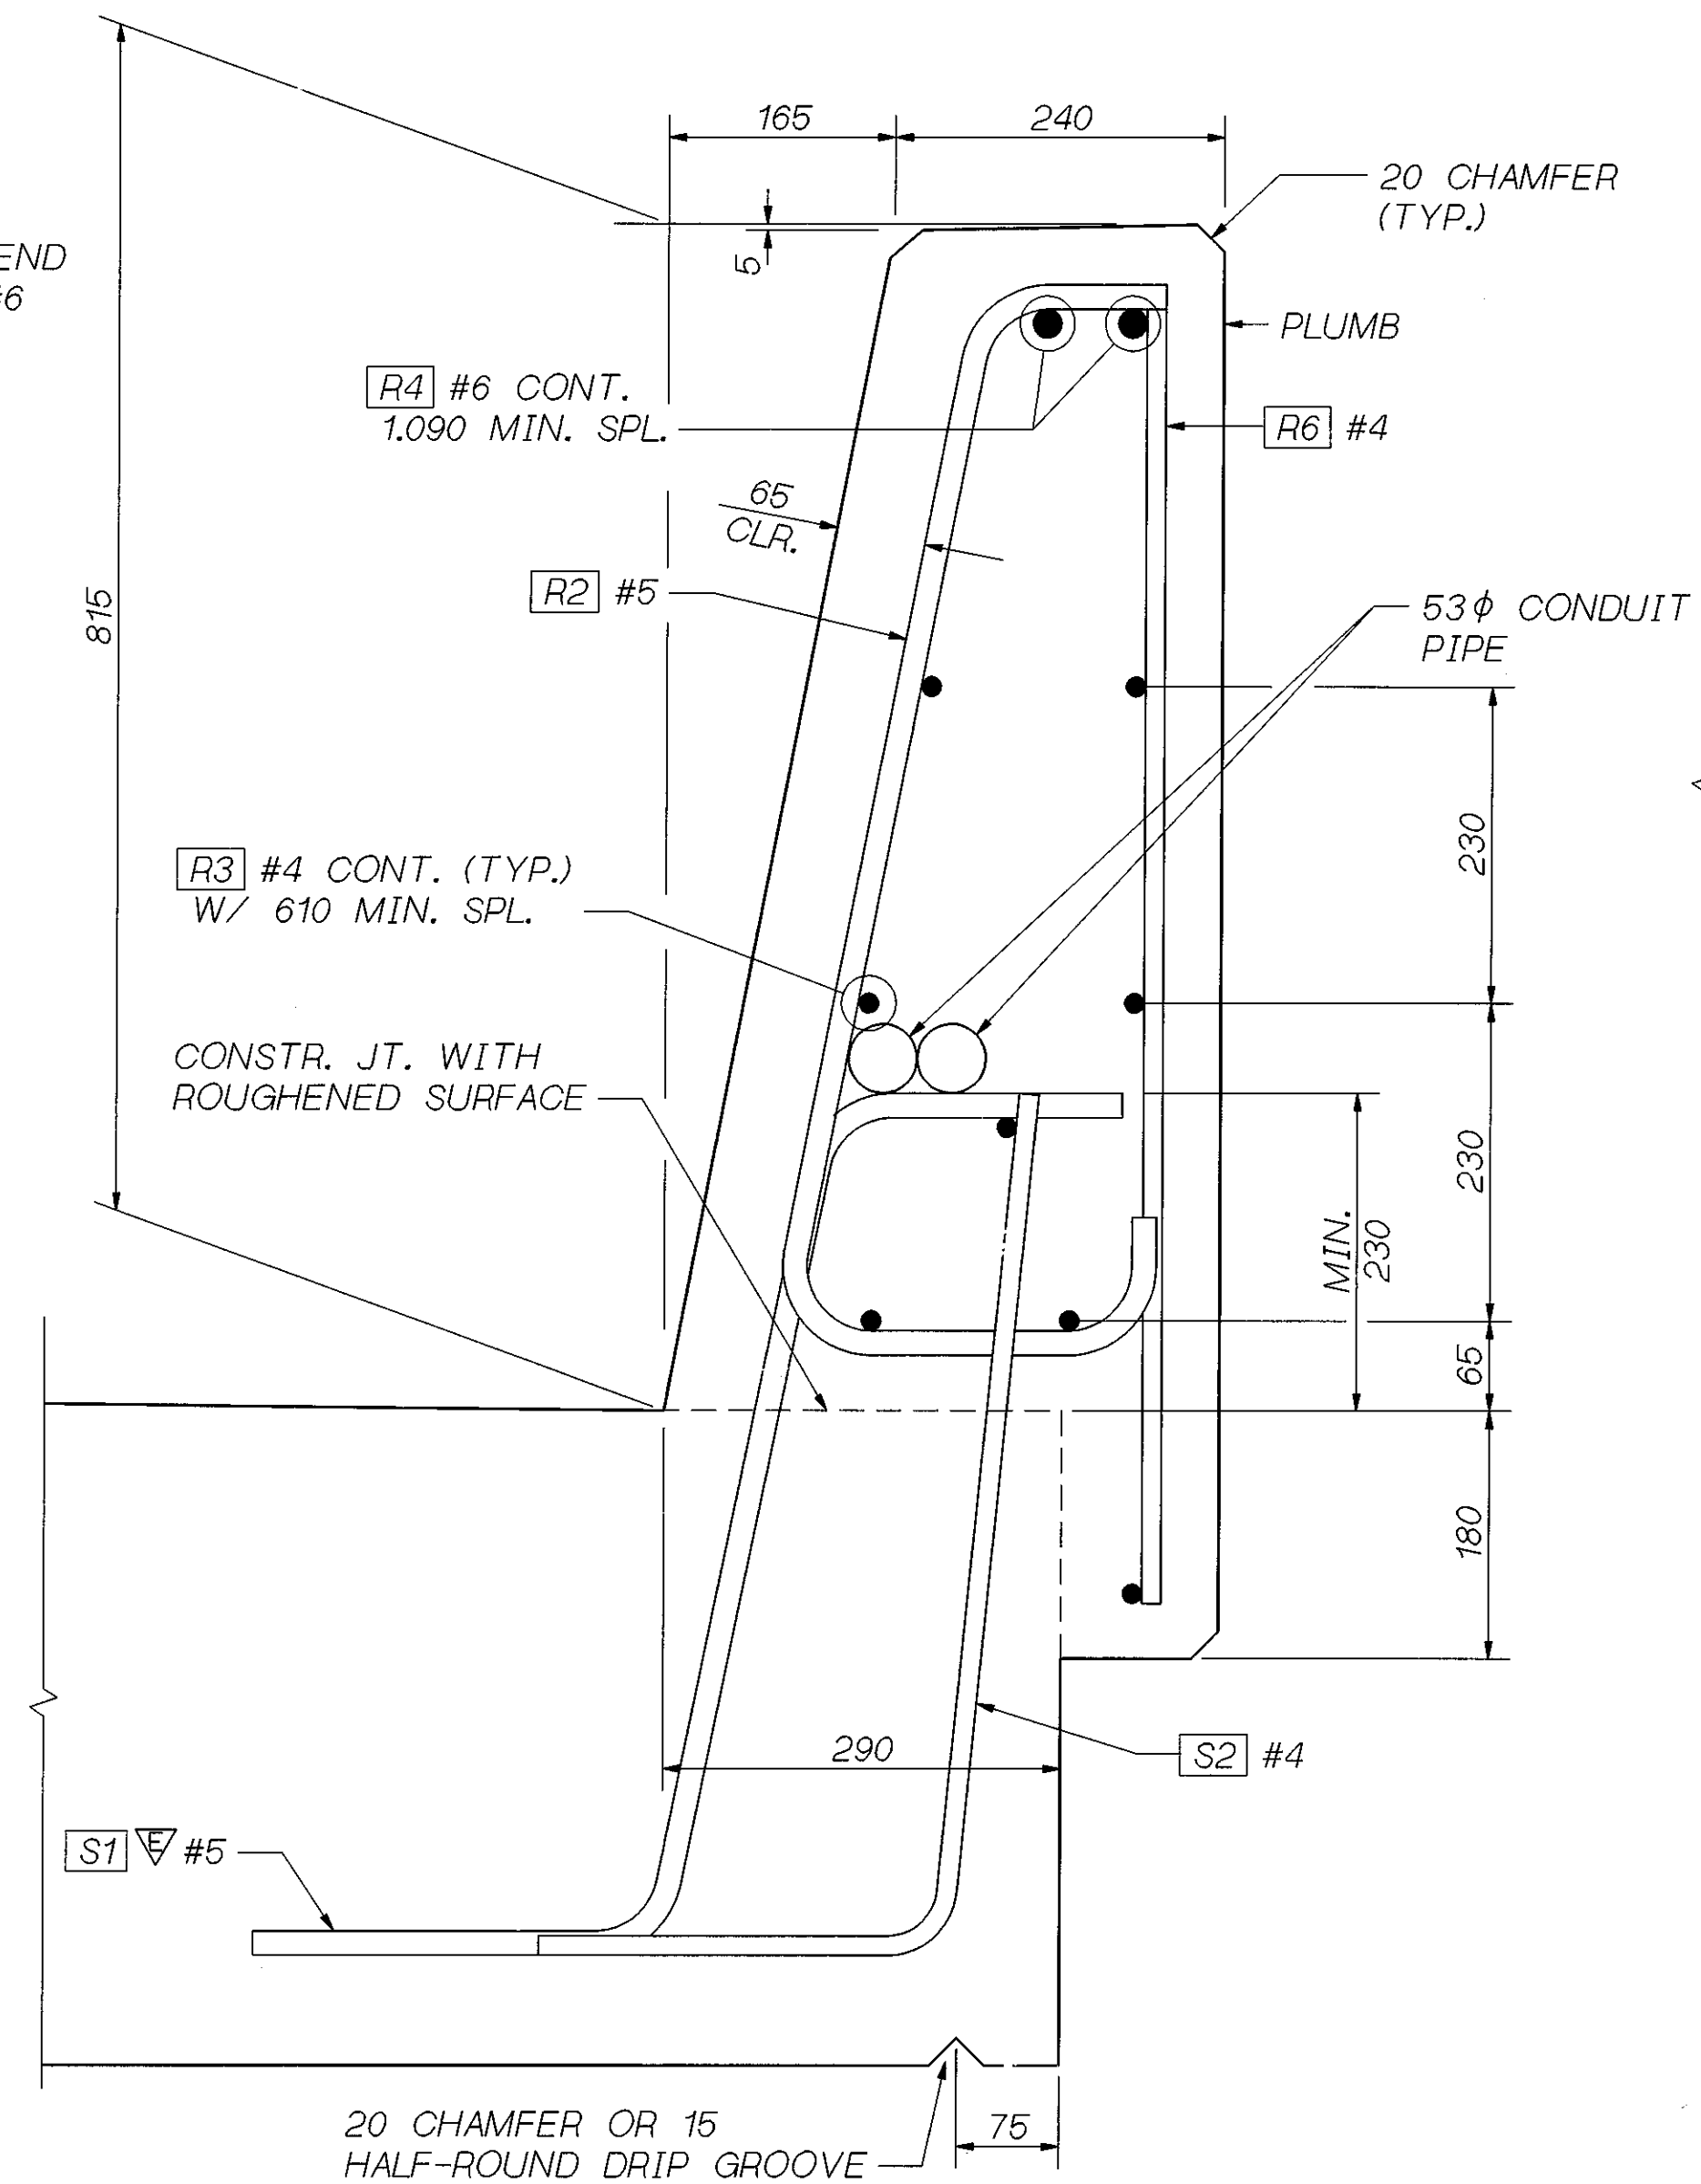

TYPICAL SECTION - TRAFFIC BARRIER

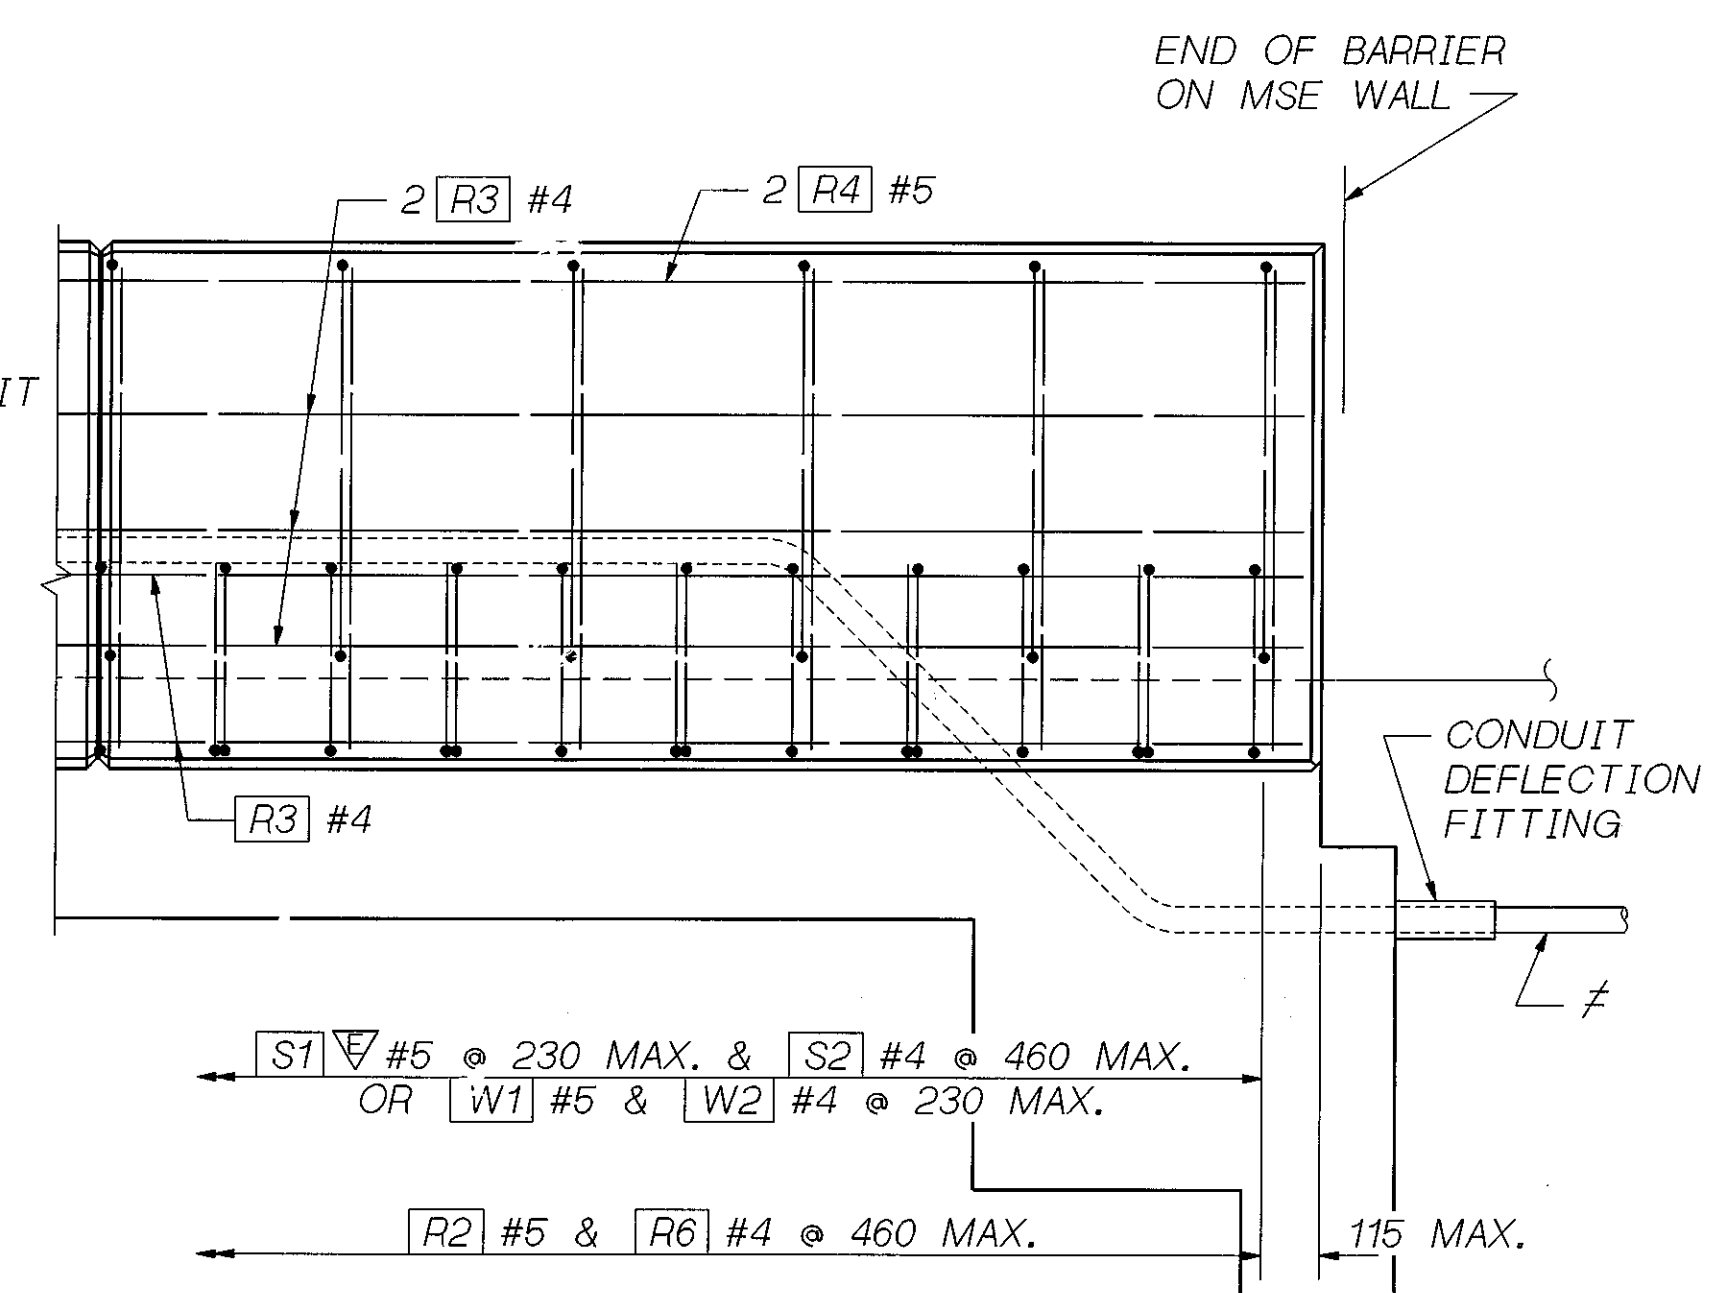


OUTSIDE ELEVATION
TRAFFIC BARRIER

AT NE CORNER OF BR. 405/72NBCD

≠ TERMINATE EACH CONDUIT PIPE AT SEPARATE TYPE 1 JUNCTION BOX OFF END OF BRIDGE.

SR 405 JOB NO. 7071 SHEET 16

Bridge Design Engr.	NBCDROOT: [000000.FGB1MSS_1.FGB; 1	REGION NO.	STATE	FED. AID PROJ. NO.	SHEET NO.	TOTAL SHEETS
Supervisor		10	WASH.			
Designed By	K. HINKLEY 6/96					
Checked By	C. CORNELL 6/96					
Detailed By	D.W. PULSE JR. 6/96					
Bridge Projects Engr.				JOB NUMBER		
Prelim. Plan By				96W035		
Architect/Specialist				5054		
DATE	REVISION	BY	APP'D			

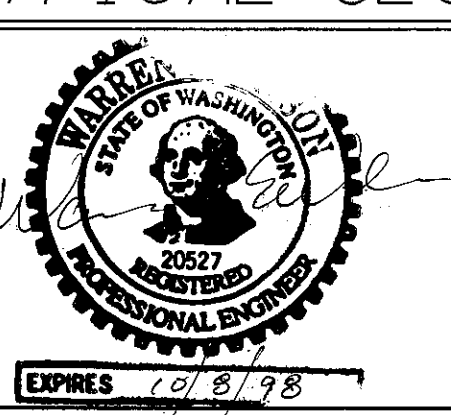


SR 405
BOTHELL TO SWAMP CREEK 1/C
HOV LANES - STAGE 1
NORTH CREEK BRIDGE 405/72 NBCD

TRAFFIC BARRIER 1 OF 2

BRIDGE SHEET NO. 16
SHEET 495 OF 663 SHEETS

24/131

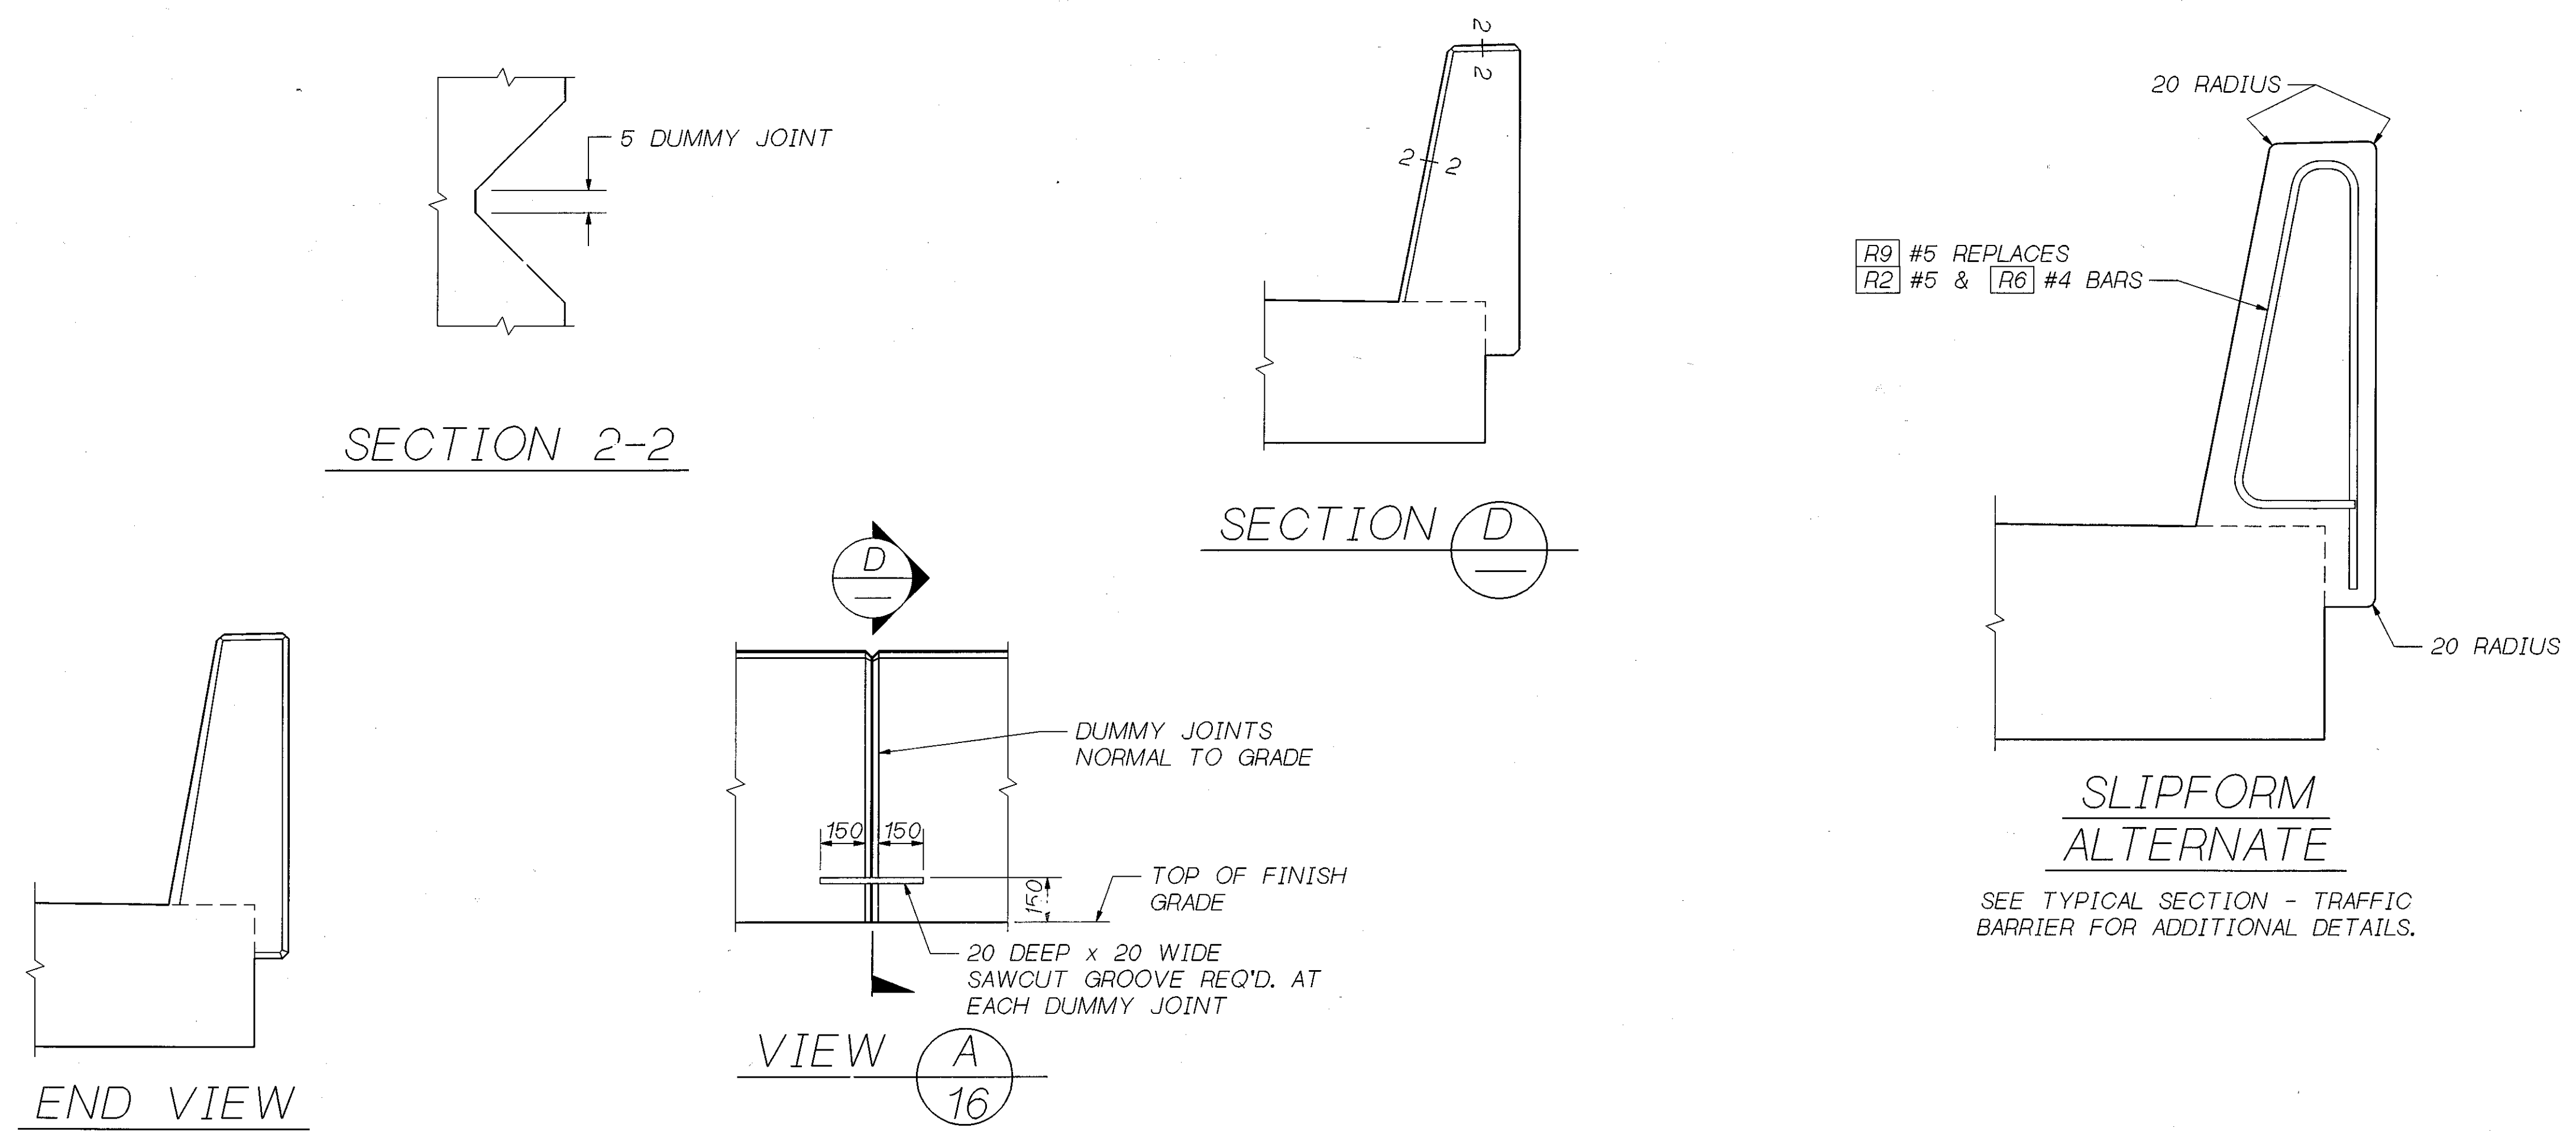

NOTE: CONCRETE SURFACE CONSTRUCTION TOLERANCE OF 5 IN 3,000 (MAX.) IS REQ'D. FOR TRAFFIC SIDE OF BARRIER.


▽ : EPOXY COATED ≠ DIMENSIONS TO POINTS OF INTERSECTION.

TRAFFIC BARRIER BAR LIST

ALL REINFORCING SHALL BE AASHTO M31, GR. 60.

MARK	SIZE	LENGTH	BENDING DIAGRAM (ALL DIMENSIONS ARE OUT TO OUT)	
R2	5	1.270		
R3	4	(A)	STR.	
R4	6	(A)	STR.	
R6	4	915	STR.	
R7	9	4.265	STR.	
R9	5	2.085		

(A) DETERMINE FROM PLANS
FOR [S1]▽ & [S2] BARS SEE BARLIST.

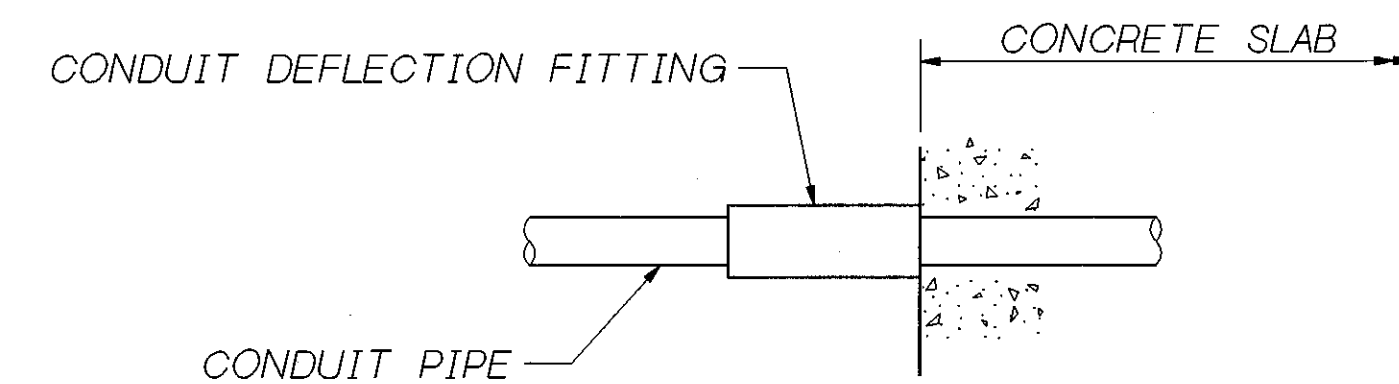


CONDUIT DEFLECTION FITTING

TYPE DX CONDUIT FITTING FOR DEFLECTION OF 30° AND 20 MOVEMENT PLACE AT CONDUIT PIPE EXIT FROM STRUCTURE.

SR 405 JOB NO. 7071 SHEET 17

Bridge Design Engr.	NBCDROOT: L000000.FGB1MSS.2.FGB: 1		REGION NO.	STATE	FED. AID PROJ. NO.	SHEET NO.	TOTAL SHEETS
Supervisor			10	WASH.			
Designed By K. HINKLEY	6/96		JOB NUMBER				
Checked By C. CORNELL	6/96		96W035				
Detailed By D.W. PULSE JR.	6/96		BY	APP'D	5054		
Bridge Projects Engr.			DATE	REVISION			
Prelim. Plan By							
Architect/Specialist							

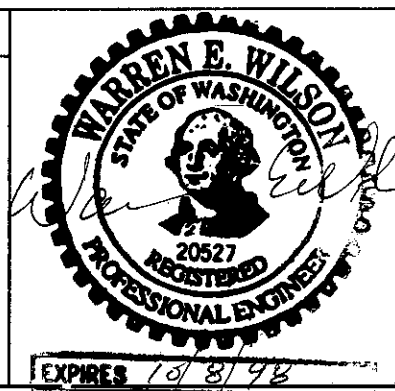

SR 405
BOTHELL TO SWAMP CREEK 1/C
HOV LANES - STAGE 1
NORTH CREEK BRIDGE 405/72 NBCD

TRAFFIC BARRIER 2 OF 2

BRIDGE SHEET NO. 17
SHEET 496 OF 663 SHEETS

24/130

S=BAR IS INCLUDED IN SUBSTRUCTURE QUANTITIES
LUMP SUM QUANTITY
T OR S=T/E OR STIRRUP RADIUS
E=EARTHQUAKE TAIL W/ TIE OR STIRRUP RADIUS


E=BAR IS EPOXY COATED
V=BAR DIMENSIONS VARY BETWEEN DIMENSIONS SHOWN ON THIS LINE AND THE FOLLOWING LINE

MARK NO.	LOCATION	SIZE	NO. REQ'D	BEND TYPE	BEND RADIUS	LUMP SUM SUBSTRUCTURE	EPOXY COATED	VARIES	NO. EACH	DIMENSIONS					LENGTH (EACH)	TOTAL WEIGHT
										U	W	X	Y	Z		
										M	M	M	M	M		
INTERMED. PILE CAPS																
200	PIER CAP 2 & 3 - STAGE 1	4	40	83	T				4	0.625	0.690				3.142	500
201	PIER CAP 2 & 3 - STAGE 1	4	5	83	T				4	0.965	0.690				3.822	76
202	PIER CAP 2 & 3 - STAGE 1	7	4	50					2	11.270					11.270	275
203	PIER CAP 2 & 3 - STAGE 1	5	2	50					2	11.500					11.500	72
204	PIER CAP 2 & 3 - STAGE 1	7	5	50					2	11.500					11.500	350
205	PIER CAP 2 & 3 - STAGE 1	5	2	50					2	11.270					11.270	70
PIER CAP 2 - STAGE 2																
220	PIER CAP 2 - STAGE 2	4	80	83	T				2	0.625	0.690				3.142	500
221	PIER CAP 2 - STAGE 2	4	5	83	T				2	0.965	0.690				3.822	38
222	PIER CAP 2 - STAGE 2	7	4	54					1	15.480					15.480	192
223	PIER CAP 2 - STAGE 2	5	4	50					1	11.820					11.820	73
224	PIER CAP 2 - STAGE 2	7	5	54					1	15.690					15.690	244
PIER CAP 3 - STAGE 2																
233	PIER CAP 3 - STAGE 2	5	4	50					1	4.580					4.580	28
PIER CAP 3 - STAGE 2																
240	PIER CAP 3 - STAGE 2	4	90	83	T				2	0.625	0.690				3.142	563
241	PIER CAP 3 - STAGE 2	4	5	83	T				2	0.965	0.690				3.822	38
242	PIER CAP 3 - STAGE 2	7	7	54					1	17.740					17.740	385
243	PIER CAP 3 - STAGE 2	5	4	50					1	11.965					11.965	74
244	PIER CAP 3 - STAGE 2	7	5	54					1	17.950					17.950	278
PIER CAP 3 - STAGE 2																
253	PIER CAP 3 - STAGE 2	5	4	50					1	6.695					6.695	42
ABUTMENTS																
600	PIER CAP 1 & 4 - STAGE 1	4	38	63	T				2	0.300	0.400				1.049	79
601	PIER CAP 1 & 4 - STAGE 1	6	2	50					2	11.500					11.500	104
602	PIER CAP 1 & 4 - STAGE 1	4	38	83	T				2	0.500	0.810				3.132	237
603	PIER CAP 1 & 4 - STAGE 1	4	36	83	T				2	0.580	0.845				3.362	375
604	PIER CAP 1 & 4 - STAGE 1	7	4	50					2	11.500					11.500	280
605	PIER CAP 1 & 4 - STAGE 1	5	3	50					2	11.500					11.500	107
606	PIER CAP 1 & 4 - STAGE 1	4	2	50					2	11.500					11.500	46
607	PIER CAP 1 & 4 - STAGE 1	7	5	50					2	11.500					11.500	350
608	PIER CAP 1 & 4 - STAGE 1	4	6	83	T				2	1.285	0.600				4.282	51
PIER CAP 1 - STAGE 2																
620	PIER CAP 1 - STAGE 2	4	49	63	T				1	0.300	0.400				1.049	51
621	PIER CAP 1 - STAGE 2	6	2	50					1	11.755					11.755	55
622	PIER CAP 1 - STAGE 2	4	49	83	T				1	0.500	0.810				3.132	153
623	PIER CAP 1 - STAGE 2	4	74	83	T				1	0.580	0.845				3.362	248
624	PIER CAP 1 - STAGE 2	7	4	54					1	14.015					14.015	174
625	PIER CAP 1 - STAGE 2	5	3	50					1	11.755					11.755	55
626	PIER CAP 1 - STAGE 2	4	2	50					1	11.755					11.755	23
627	PIER CAP 1 - STAGE 2	7	5	54					1	14.015					14.015	218
628	PIER CAP 1 - STAGE 2	4	7	83	T				1	1.285	0.845				4.772	33
PIER CAP 1 - STAGE 2																
631	PIER CAP 1 - STAGE 2	6	2	50					1	2.770					2.770	12
PIER CAP 1 - STAGE 2																
635	PIER CAP 1 - STAGE 2	5	3	50					1	2.970					2.970	14
636	PIER CAP 1 - STAGE 2	4	2	50					1	2.870					2.870	6
PIER CAP 4 - STAGE 2																
640	PIER CAP 4 - STAGE 2	4	66	63	T				1	0.300	0.400				1.049	69
641	PIER CAP 4 - STAGE 2	6	2	50					1	12.055					12.055	55
642	PIER CAP 4 - STAGE 2	4	66	83	T				1	0.500	0.810				3.132	206
643	PIER CAP 4 - STAGE 2	4	101	83	T				1	0.580	0.845				3.362	338
644	PIER CAP 4 - STAGE 2	7	2	50					1	10.770					10.770	66
645	PIER CAP 4 - STAGE 2	5	3	50					1	12.055					12.055	56
646	PIER CAP 4 - STAGE 2	4	2	50					1	12.055					12.055	24
647	PIER CAP 4 - STAGE 2	7	2	50					1	11.765					11.765	72
648	PIER CAP 4 - STAGE 2	4	4	83	T				1	1.285	0.845				4.772	19
PIER CAP 4 - STAGE 2																
651	PIER CAP 4 - STAGE 2	6	2	50					1	8.205					8.205	37
PIER CAP 4 - STAGE 2																
654	PIER CAP 4 - STAGE 2	7	2	50					1	8.775					8.775	53
655	PIER CAP 4 - STAGE 2	5	3	50					1	8.305					8.305	39
656	PIER CAP 4 - STAGE 2	4	2	50					1	8.205					8.205	16
657	PIER CAP 4 - STAGE 2	7	3	50					1	9.775					9.775	89
PIER CAP 4 - STAGE 2																
664	PIER CAP 4 - STAGE 2	7	2	54					1	9.885					10.190	62
667	PIER CAP 4 - STAGE 2	7	2	54					1	8.890					9.195	56
674	PIER CAP 4 - STAGE 2	7	2	54					1	11.880					12.185	74
677	PIER CAP 4 - STAGE 2	7	3	54					1	10.880					11.185	102

S=BAR IS INCLUDED IN SUBSTRUCTURE QUANTITIES
LUMP SUM QUANTITY
T OR S=T/E OR STIRRUP RADIUS
E=EARTHQUAKE TAIL W/ TIE OR STIRRUP RADIUS

E=BAR IS EPOXY COATED
V=BAR DIMENSIONS VARY BETWEEN DIMENSIONS SHOWN ON THIS LINE AND THE FOLLOWING LINE

MARK NO.	LOCATION	SIZE	NO. REQ'D	BEND TYPE	BEND RADIUS	LUMP SUM SUBSTRUCTURE	EPOXY COATED	VARIES	NO. EACH	DIMENSIONS					LENGTH (EACH)	TOTAL WEIGHT
										U	W	X	Y	Z		
										M	M	M	M	M		
DECK REINFORCING																
800	SLAB - TOP TRANS. (STAGE 1)	5	31	50					E	V	I	0.715			0.715	191
801	SLAB - TOP TRANS. (STAGE 1)	5	119	51					E			7.410			7.590	1402
802	SLAB - TOP TRANS. (STAGE 1)	5	31	51					E	V	I	0.715			0.893	191
803	SLAB - BOT. TRANS. (STAGE 1)	5	62	50					V	2		0.715			0.715	381
804	SLAB - BOT. TRANS. (STAGE 1)	5	119	50								7.410			7.410	1369
805	SLAB - TOP LONG. (STAGE 1)	10	26	54					E			16.480			16.950	2822
806	SLAB - TOP LONG. (STAGE 1)	10	66	50					E			9.755			9.755	4123
807	SLAB - TOP LONG. (STAGE 1)	10	26	50					E			18.360			18.360	3057
808	SLAB - TOP LONG. (STAGE 1)	10	10	54					E			9.440			9.910	635
810	SLAB - EDGE BEAM (STAGE 1)	10	6	50								13.735			13.735	528
811	SLAB - EDGE BEAM (STAGE 2)	10	6	50								13.735			13.735	528
812	SLAB - STIRRUP (STAGE 1)	4	760	70								0.305	0.305		1.220	922
813	SLAB - STIRRUP (STAGE 2)	4	160	70								0.305	0.305		1.220	1407
815	SLAB - BOT. LONG. (STAGE 1)	10	10	50								9.995			9.995	640
816	SLAB - BOT. LONG. (STAGE 1)	10	20	50								14.995			14.995	1921
817	SLAB - BOT. LONG. (STAGE 1)	10	19	50								7.245			7.245	882
818	SLAB - BOT. LONG. (STAGE 1)	10	20	50								16.500			16.500	2113
819	SLAB - BOT. LONG. (STAGE 1)	10	19	50								9.940			9.940	1209
820	SLAB - BOT. LONG. (STAGE 1)	10	19	50								7.455			7.455	907
821	SLAB - BOT. LONG. (STAGE 1)	10	10	50								10.255			10.255	657
827	SLAB - BOT. LONG. (STAGE 2)	10	19	50					V	I		15.695			15.695	2025
828	SLAB - BOT. LONG. (STAGE 2)	10	19	50					V	I		7.895			7.895	1009
829	SLAB - BOT. LONG. (STAGE 2)	10	36	50					V	I		2.840			2.840	695
830	SLAB - BOT. LONG. (STAGE 2)	10	19	50					V	I		15.280			15.280	1962
831	SLAB - BOT. LONG. (STAGE 2)	10	36	50					V	I		4.880			4.880	1193
832	SLAB - BOT. LONG. (STAGE 2)	10	19	50					V	I		12.720			12.720	1632
833	SLAB - BOT. LONG. (STAGE 2)	10	36	50					V	I		6.085			6.085	1488
834	SLAB - BOT. LONG. (STAGE 2)	10	17	50					V	I		14.075			14.075	1625
835	SLAB - BOT. LONG. (STAGE 2)	10	18	50					V	I		8.835			8.835	1071
840	SLAB - BOT. TRANS. (STAGE 2)	5	40	50					V	I		0.655			0.655	336
841	SLAB - BOT. TRANS. (STAGE 2)	5	95	54					V	I		10.175			10.391	1723

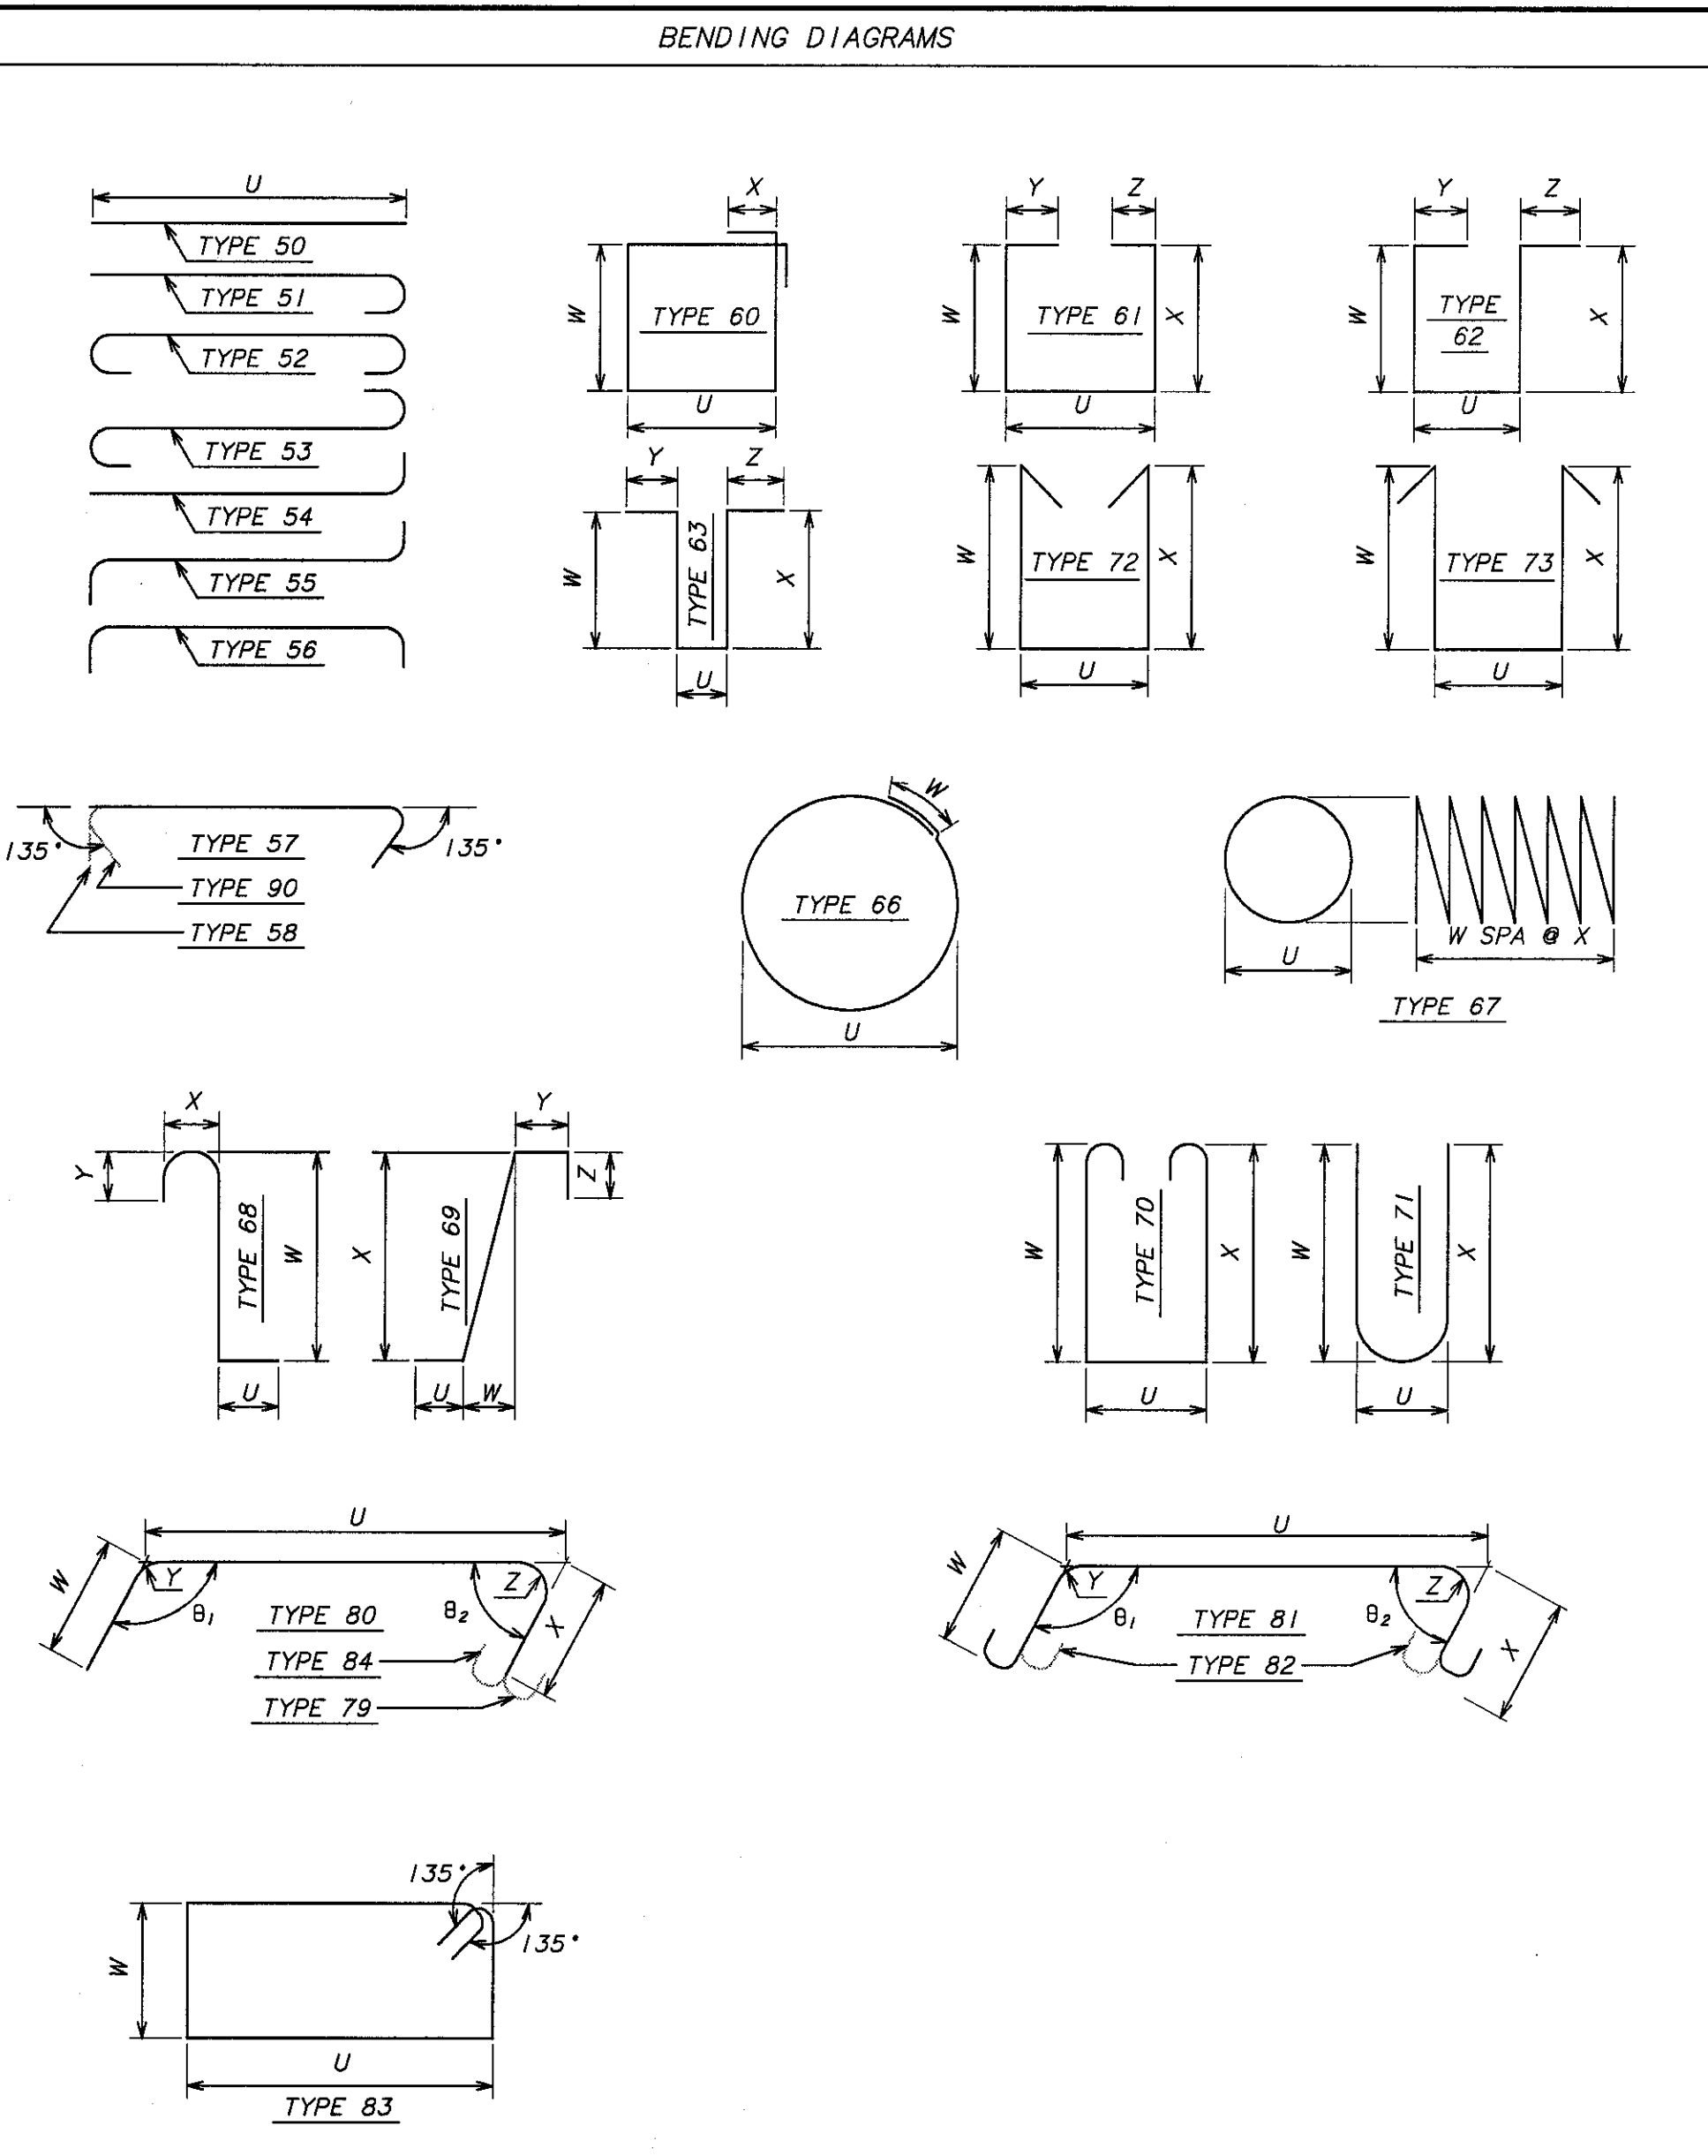

NOTES:
1. ALL REINFORCING BARS ON THIS SHEET SHALL BE AASHTO M31 GRADE 60 UNLESS SHOWN OTHERWISE.
2. REINFORCING FOR MEDIAN & TRAFFIC BARRIER IS NOT SHOWN IN THIS BAR LIST EXCEPT FOR BARS S1 & S2. SEE MEDIAN & TRAFFIC BARRIER, BRIDGE SHEETS 14-17.

PLOTTED: Tue Nov 12 1996 11:50am FILENAME: X:\A96077\BR72\NBCD\18.DWG SCALE: 1 SR 405 JOB NO. 7071 SHEET 18 OF 19


BRIDGE DESIGN ENGR					
SUPERVISOR					
DESIGNED BY	K. HINKLEY	6/96			
CHECKED BY	C. CORNELL	6/96			
DETAILED BY	T. BRENNAN	6/96			
BRIDGE PROJECTS ENGR					
PRELIM PLAN BY					
ARCHITECT/SPECIALIST					
DATE		REVISION		BY	APPR

REGION NO.	STATE	FED AID PROJ NO	SHEET NO.	TOTAL SHEETS
------------	-------	-----------------	-----------	--------------

S-BAR IS INCLUDED IN SUBSTRUCTURE QUANTITIES-
LUMP SUM QUANTITY
T OR S-TIE OR STIRRUP RADIUS
E-EARTHQUAKE TAIL W/ TIE
OR STIRRUP RADIUS

E-BAR IS EPOXY COATED
V-BAR DIMENSIONS VARY BETWEEN DIMENSIONS SHOWN
ON THIS LINE AND THE FOLLOWING LINE

MARK NO.	LOCATION	SIZE	NO. REIN'D	BEND TYPE	BEND RADIUS	LUMP SUM	SUBSTRUCTURE	EPOXY COATED	VARIES	NO. EACH	DIMENSIONS						LENGTH (EACH)	TOTAL WEIGHT		
											U	W	X	Y	Z	θ_1			θ_2	M
842	SLAB - BOT. TRANS. (STAGE 2)	5	3	54					V	1	12.140							12.356	59	
843	SLAB - BOT. TRANS. (STAGE 2)	5	52	54					V	1	0.550							11.806	507	
850	SLAB - TOP LONG. (STAGE 2)	10	23	54					E	V	15.245							17.305	2432	
851	SLAB - TOP LONG. (STAGE 2)	10	22	54					E	V	7.840							9.260	1238	
852	SLAB - TOP LONG. (STAGE 2)	10	44	50					E	V	5.305							5.950	1586	
853	SLAB - TOP LONG. (STAGE 2)	10	23	50					E	V	18.170							20.115	2820	
854	SLAB - TOP LONG. (STAGE 2)	10	22	50					E	V	11.880							13.320	1775	
855	SLAB - TOP LONG. (STAGE 2)	10	44	50					E	V	9.495							10.645	2837	
856	SLAB - TOP LONG. (STAGE 2)	10	23	54					E	V	5.435							6.095	918	
857	SLAB - TOP LONG. (STAGE 2)	10	22	54					E	V	17.030							18.840	2593	
860	SLAB - TOP TRANS. (STAGE 2)	5	40	50					E	V	0.655							10.170	336	
861	SLAB - TOP TRANS. (STAGE 2)	5	95	54					E	V	10.175							12.765	1723	
862	SLAB - TOP TRANS. (STAGE 2)	5	3	54					E	V	12.140							12.570	59	
863	SLAB - TOP TRANS. (STAGE 2)	5	52	54					E	V	0.550							11.590	507	
BRIDGE NO. 405/72E																				
890	TOP SLAB - BR. 72E	10	4	50					E		13.390							13.390	343	
891	BOT. SLAB - BR. 72E	10	4	50							12.645							12.645	324	
892	EDGE BEAM - BR. 72E	10	6	50							12.450							12.450	478	
893	CAP PIER 4 - BR. 72E	6	5	54							0.070							1.124	13	
894	CAP PIER 4 - BR. 72E	4	3	83	S						0.805	0.610						3.262	10	
895	CAP PIER 4 - BR. 72E	5	2	50							0.530							0.530	2	
896	CAP PIER 4 - BR. 72E	5	3	83	S						0.600	0.760						3.152	15	
897	CAP PIER 4 - BR. 72E	5	6	54							0.070							1.086	10	
898	CAP PIER 4 - BR. 72E	4	2	50							0.530							0.530	1	
899	CAP PIER 4 - BR. 72E	4	3	56							0.225							0.555	2	
900	CAP PIER 2 & 3 - BR. 72E	7	8	54							0.070							1.175	29	
901	CAP PIER 2 & 3 - BR. 72E	4	12	83							0.640	0.510						2.732	51	
902	CAP PIER 2 & 3 - BR. 72E	7	8	54							0.070							1.175	29	
903	CAP PIER 2 & 3 - BR. 72E	5	4	50							0.770							0.770	5	
TRAFFIC BARRIER																				
S1	TRAFFIC BARRIER	5	4	90							0.625	0.300	0.220					11.310	0.890	215
S2	TRAFFIC BARRIER	4	4	91							0.625	0.300						5.711	1.081	809

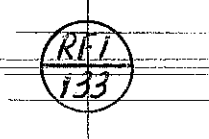


S-BAR IS INCLUDED IN SUBSTRUCTURE QUANTITIES-
LUMP SUM QUANTITY
T OR S-TIE OR STIRRUP RADIUS
E-EARTHQUAKE TAIL W/ TIE
OR STIRRUP RADIUS

E-BAR IS EPOXY COATED
V-BAR DIMENSIONS VARY BETWEEN DIMENSIONS SHOWN
ON THIS LINE AND THE FOLLOWING LINE

MARK NO.	LOCATION	SIZE	NO. REIN'D	BEND TYPE	BEND RADIUS	LUMP SUM	SUBSTRUCTURE	EPOXY COATED	VARIES	NO. EACH	DIMENSIONS						LENGTH (EACH)	TOTAL WEIGHT
											U	W	X	Y	Z	θ_1		

BENDING DIAGRAMS

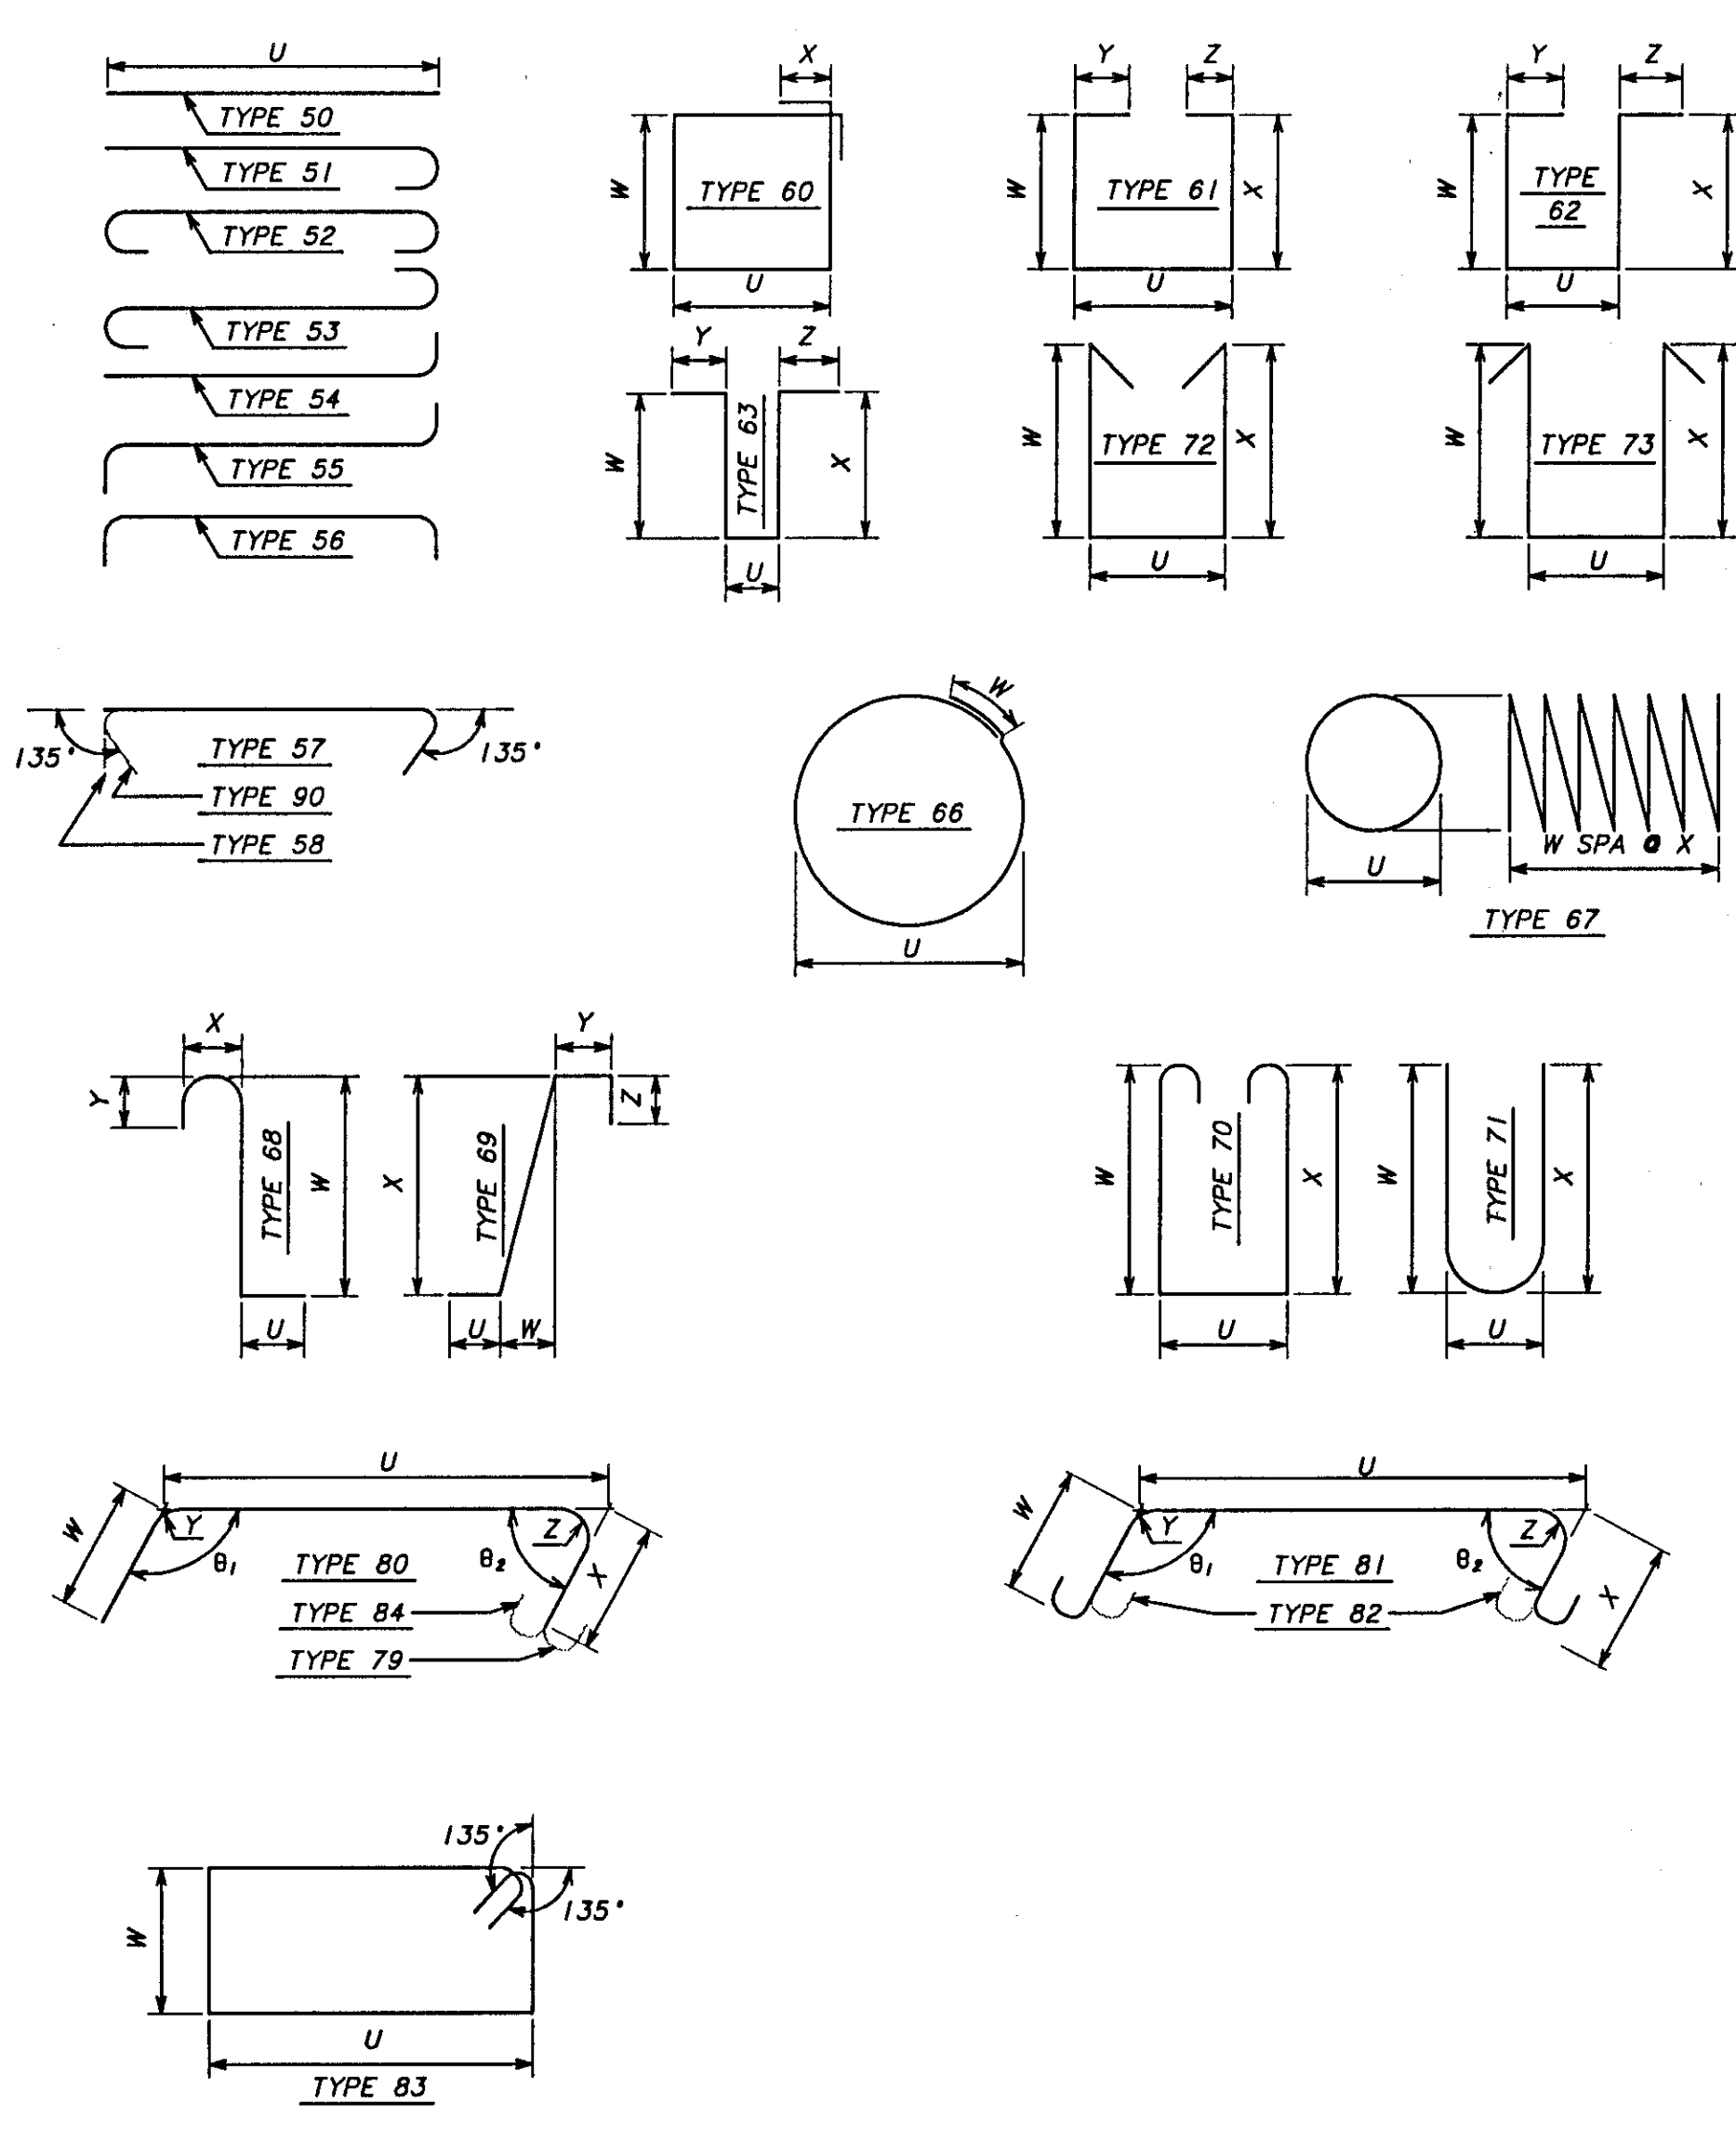

- NOTES:
- ALL REINFORCING BARS ON THIS SHEET SHALL BE AASHTO M31 GRADE 60 UNLESS SHOWN OTHERWISE.
 - REINFORCING FOR MEDIAN & TRAFFIC BARRIER IS NOT SHOWN IN THIS BAR LIST EXCEPT FOR BARS S1 & S2. SEE MEDIAN & TRAFFIC BARRIER, SHEETS 14-17
 - FOR BEND TYPE 90 & 91, SEE BRIDGE SHEET 14.

FOR "AS CONSTRUCTED PLANS" ONLY

PLOTTED: Tue Nov 12 1996 11:51am FILENAME: X:\A96077\BR72\NBCD\19.DWG SCALE: 1 SR 405 JOB NO. 7071 SHEET 19 OF 19

BRIDGE DESIGN ENGR		REGION NO.	STATE	FED AID PROJ NO.	SHEET NO.	TOTAL SHEETS
SUPERVISOR		1	WASH			
DESIGNED BY	K. HINKLEY 6/96					
CHECKED BY	C. CORNELL 6/96					
DETAILED BY	T. BRENNAN 6/96					
BRIDGE PROJECTS ENGR						
PRELIM PLAN BY	7/16/96	RFI-#133	ALM			
ARCHITECT/SPECIALIST	DATE	REVISION	BY	APPR		
					5054	



BERGER/ABAM
ENGINEERS INC.
33301 9TH AVENUE SOUTH
FEDERAL WAY, WASHINGTON 98003-4385
(206)431-2300 FAX: (206)431-2280

Washington State
Department of
Transportation

SR 405
BOTHELL TO SWAMP CREEK I/C
HOV LANES - STAGE 1
NORTH CREEK BRIDGE 405/72 NBCD
BAR LIST

BRIDGE SHEET NO. 19
SHEET 498 OF 663 SHEETS