


SEC. 5 T26N R5EWM

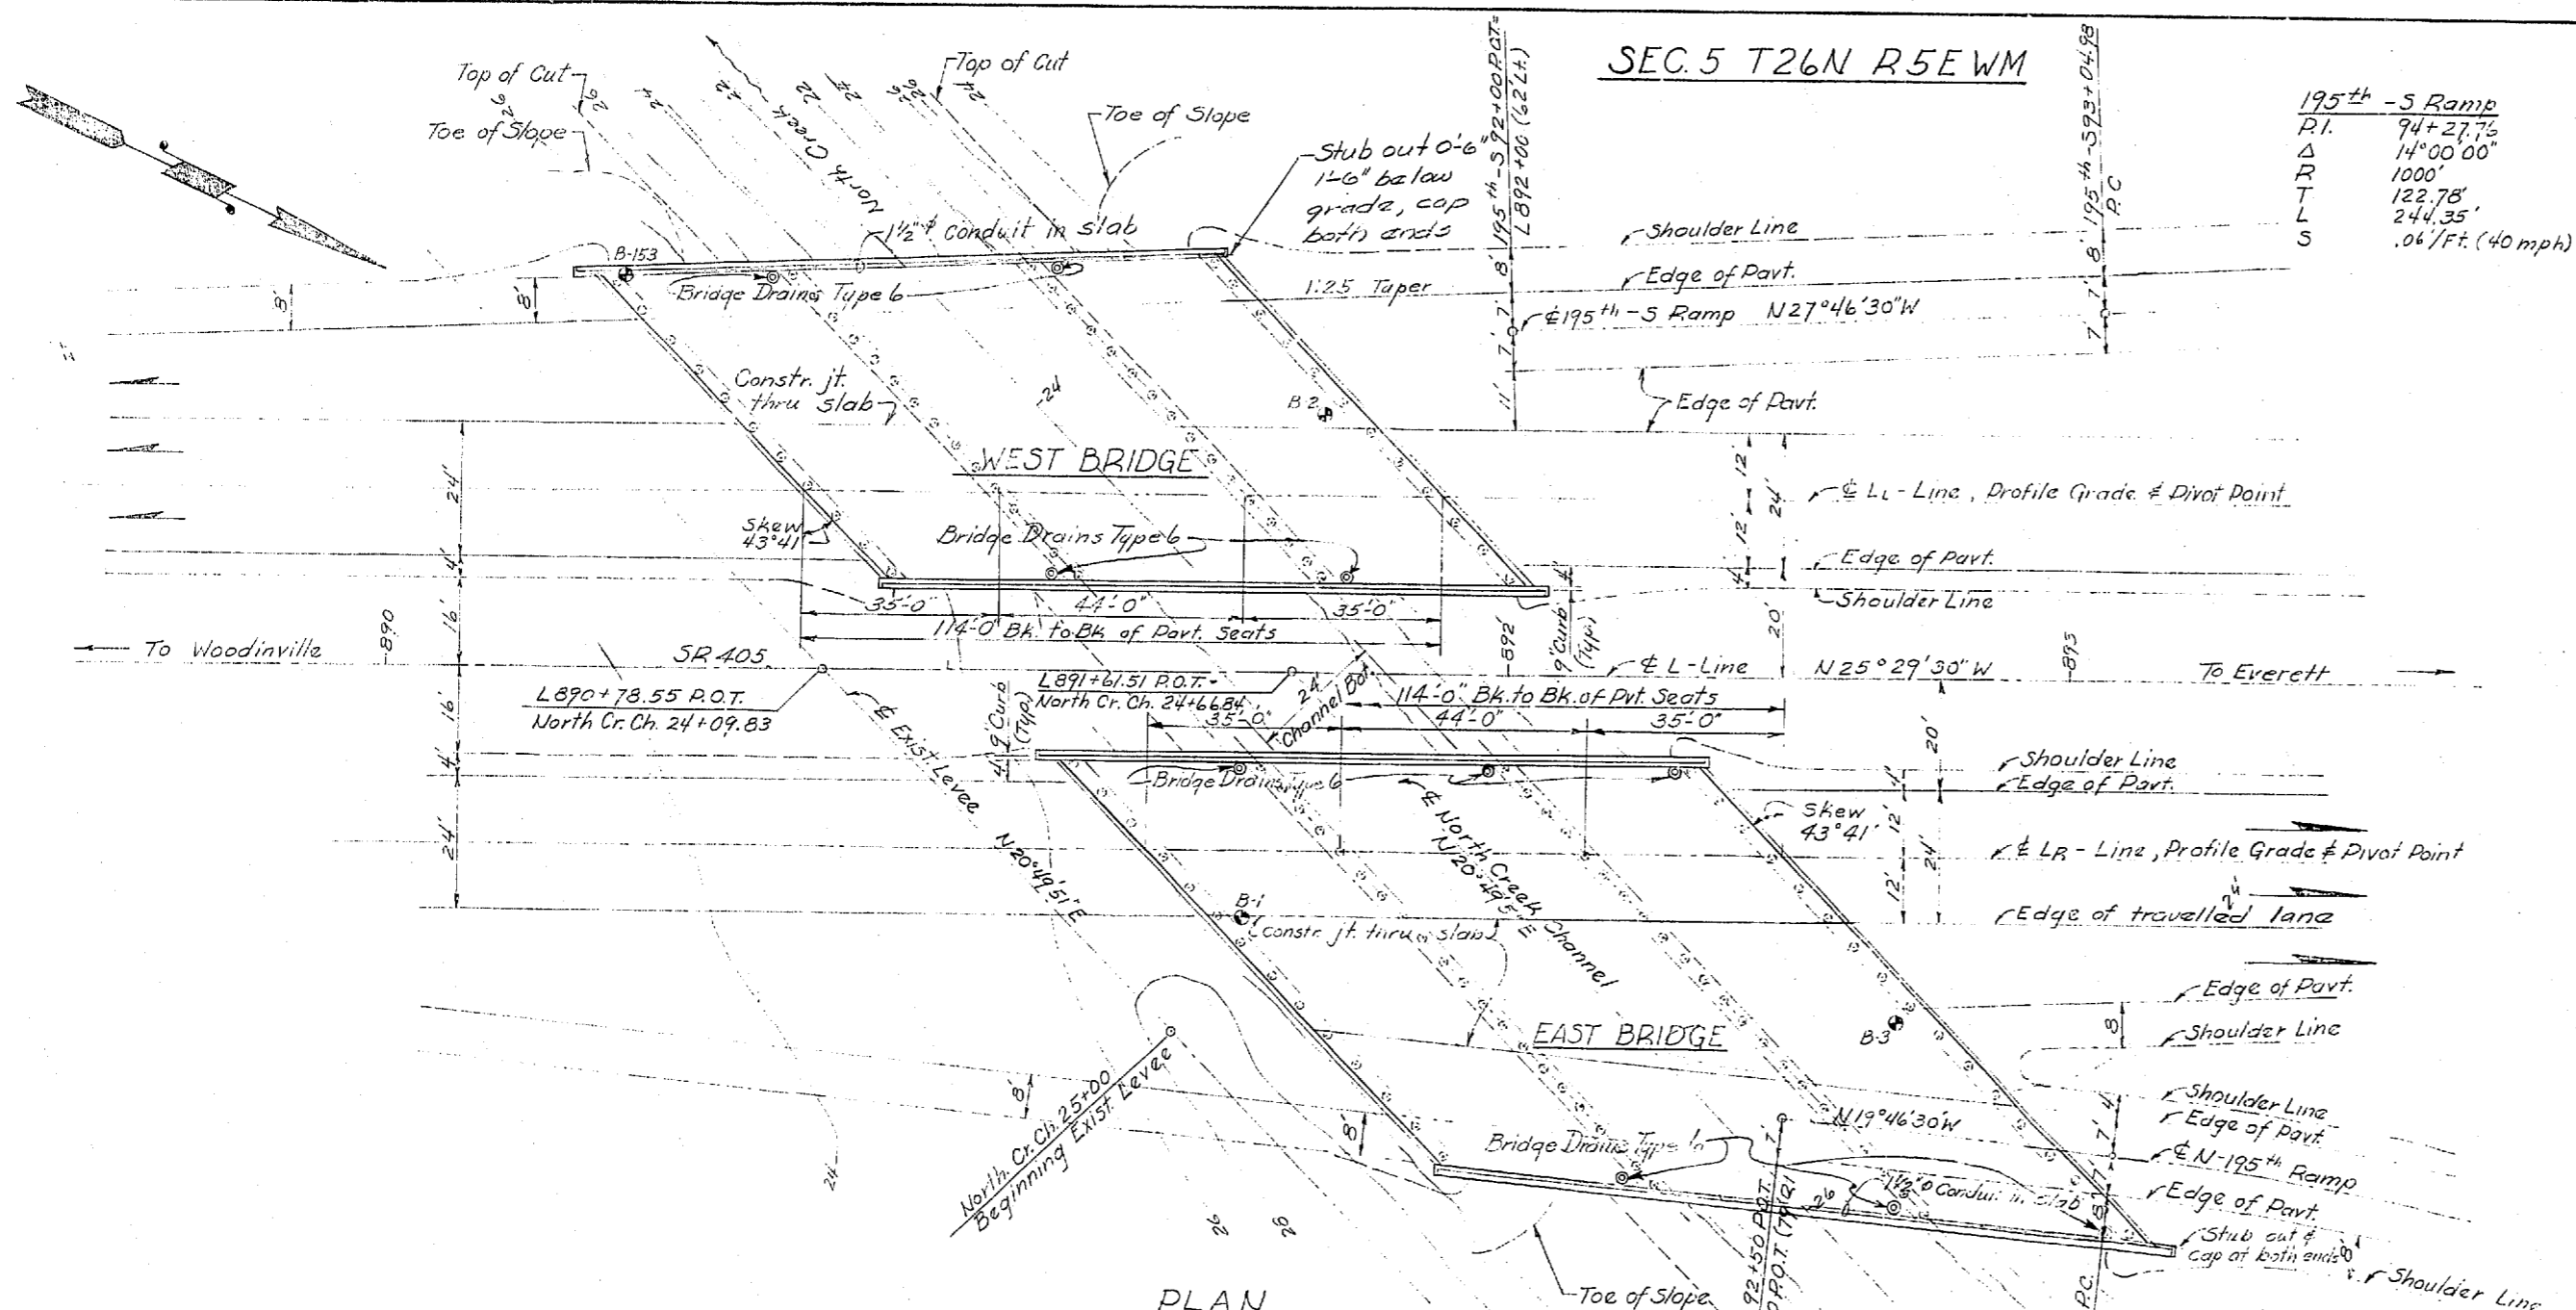

195th - S Ramp
 P.I. 94+27.75
 Δ 14'00'00"
 L 1000'
 122.78'
 244.35'
 .061/Ft. (40 mph)

GENERAL NOTES

All materials and work shall be in accordance with the requirements of the State of Washington, Department of Highways Standard Specifications for Road and Bridge Construction, dated 1963 & Amendment No. 1 dated January 1964.

All concrete shall be class AX mix.


Falsework shall not be released in any span until all concrete, except that in the rail base, has been in place in all spans the required length of time and has developed sufficient strength as outlined in the Specifications. Falsework shall be carefully released to prevent impact or undue stresses in the structure. The rail base shall not be poured until the falsework has been released.

Each pile shall be driven to a depth sufficient to develop a minimum load bearing capacity of forty (40) tons. Minimum penetration shall be to Elev. -20.0'


APPROXIMATE QUANTITIES

	West Bridge	East Bridge	CU Yards
Structure Excavation	65	35	Only
Furnishing & Driving Concrete Test Piles - 13 Inch Diam.	4	4	Only
Furnishing Concrete Piling - 13 Inch Diam.	2810	3820	Lin Ft.
Driving Concrete Piles - 13 Inch Diam.	55	75	Only
Superstructure - North Creek Br. - West Br.	Lump Sum		
Superstructure - North Creek Br. - East Br.		Lump Sum	
Water Reducing	640	1130	Dollars

PLAN

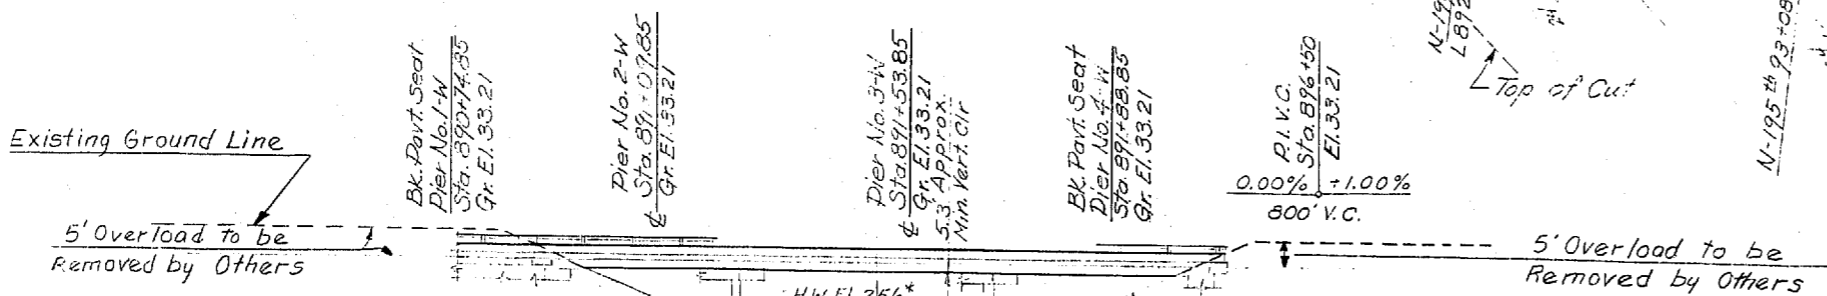


ELEVATION - WEST BRIDGE

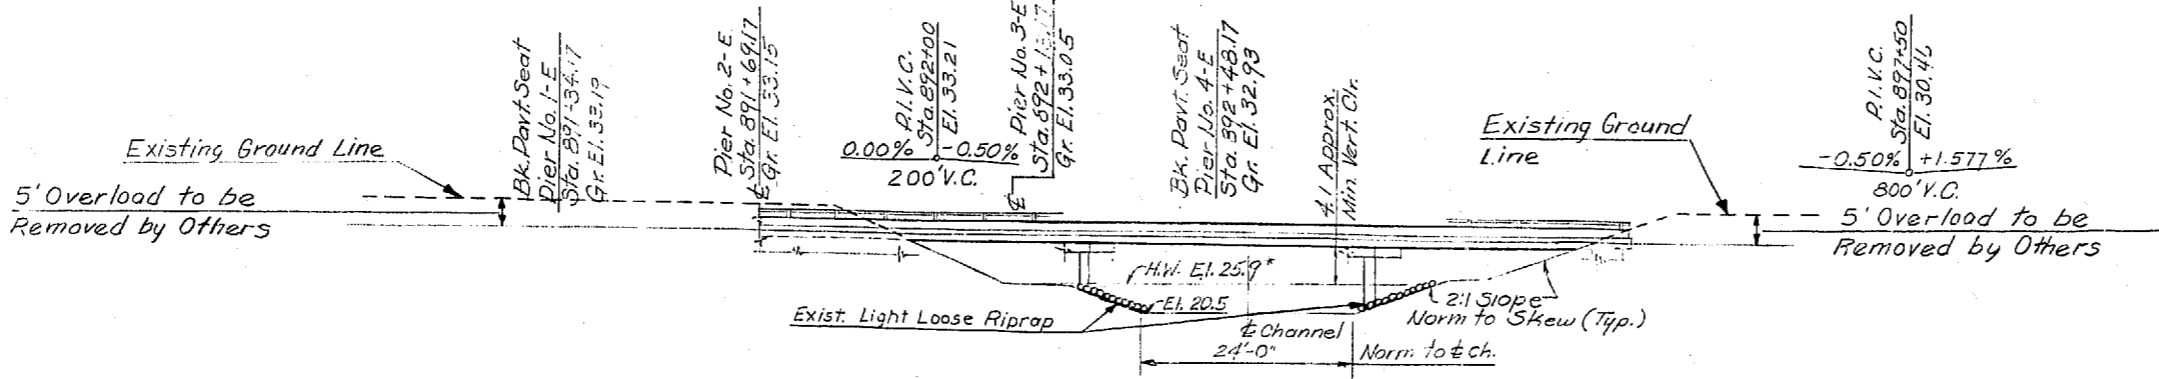

ELEVATION - EAST BRIDGE

Note: Grade elevations shown are finish grades on & L₁-Line & & L₂-Line and are equal to profile grade.

Est. 100 Yr. M.R.I.

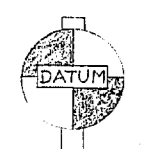

U.S.C. & G.S.

LOADING: HS-20 or 2-24' AXLES @ 4' CTRS.

SR 405
 MP 24.28 TO MP 26.37
 NORTH CR. BR. AND 228TH ST. O'XING
 KING & SNOHOMISH COUNTIES
 NORTH CREEK BRIDGES

LAYOUT

WASHINGTON STATE HIGHWAY COMMISSION
 DEPARTMENT OF HIGHWAYS
 OLYMPIA, WASHINGTON

GEORGE D. ZANK, CHAIRMAN
 E. L. HIRALSON, H. WALSH, SAUER FERGUSON, JOHN H. RUFF

APPROVED Nov. 22, 1967

SHEET 4 OF 26 SHEETS


CONTRACT NUMBER 8376

12-3-67	Change Bridge Drains	WLG
11-30-67	Riprap Added at Bridge Slopes	AR
DATE	REVISION	BY







P.S.H. No 1-RE

8/1992

6/81

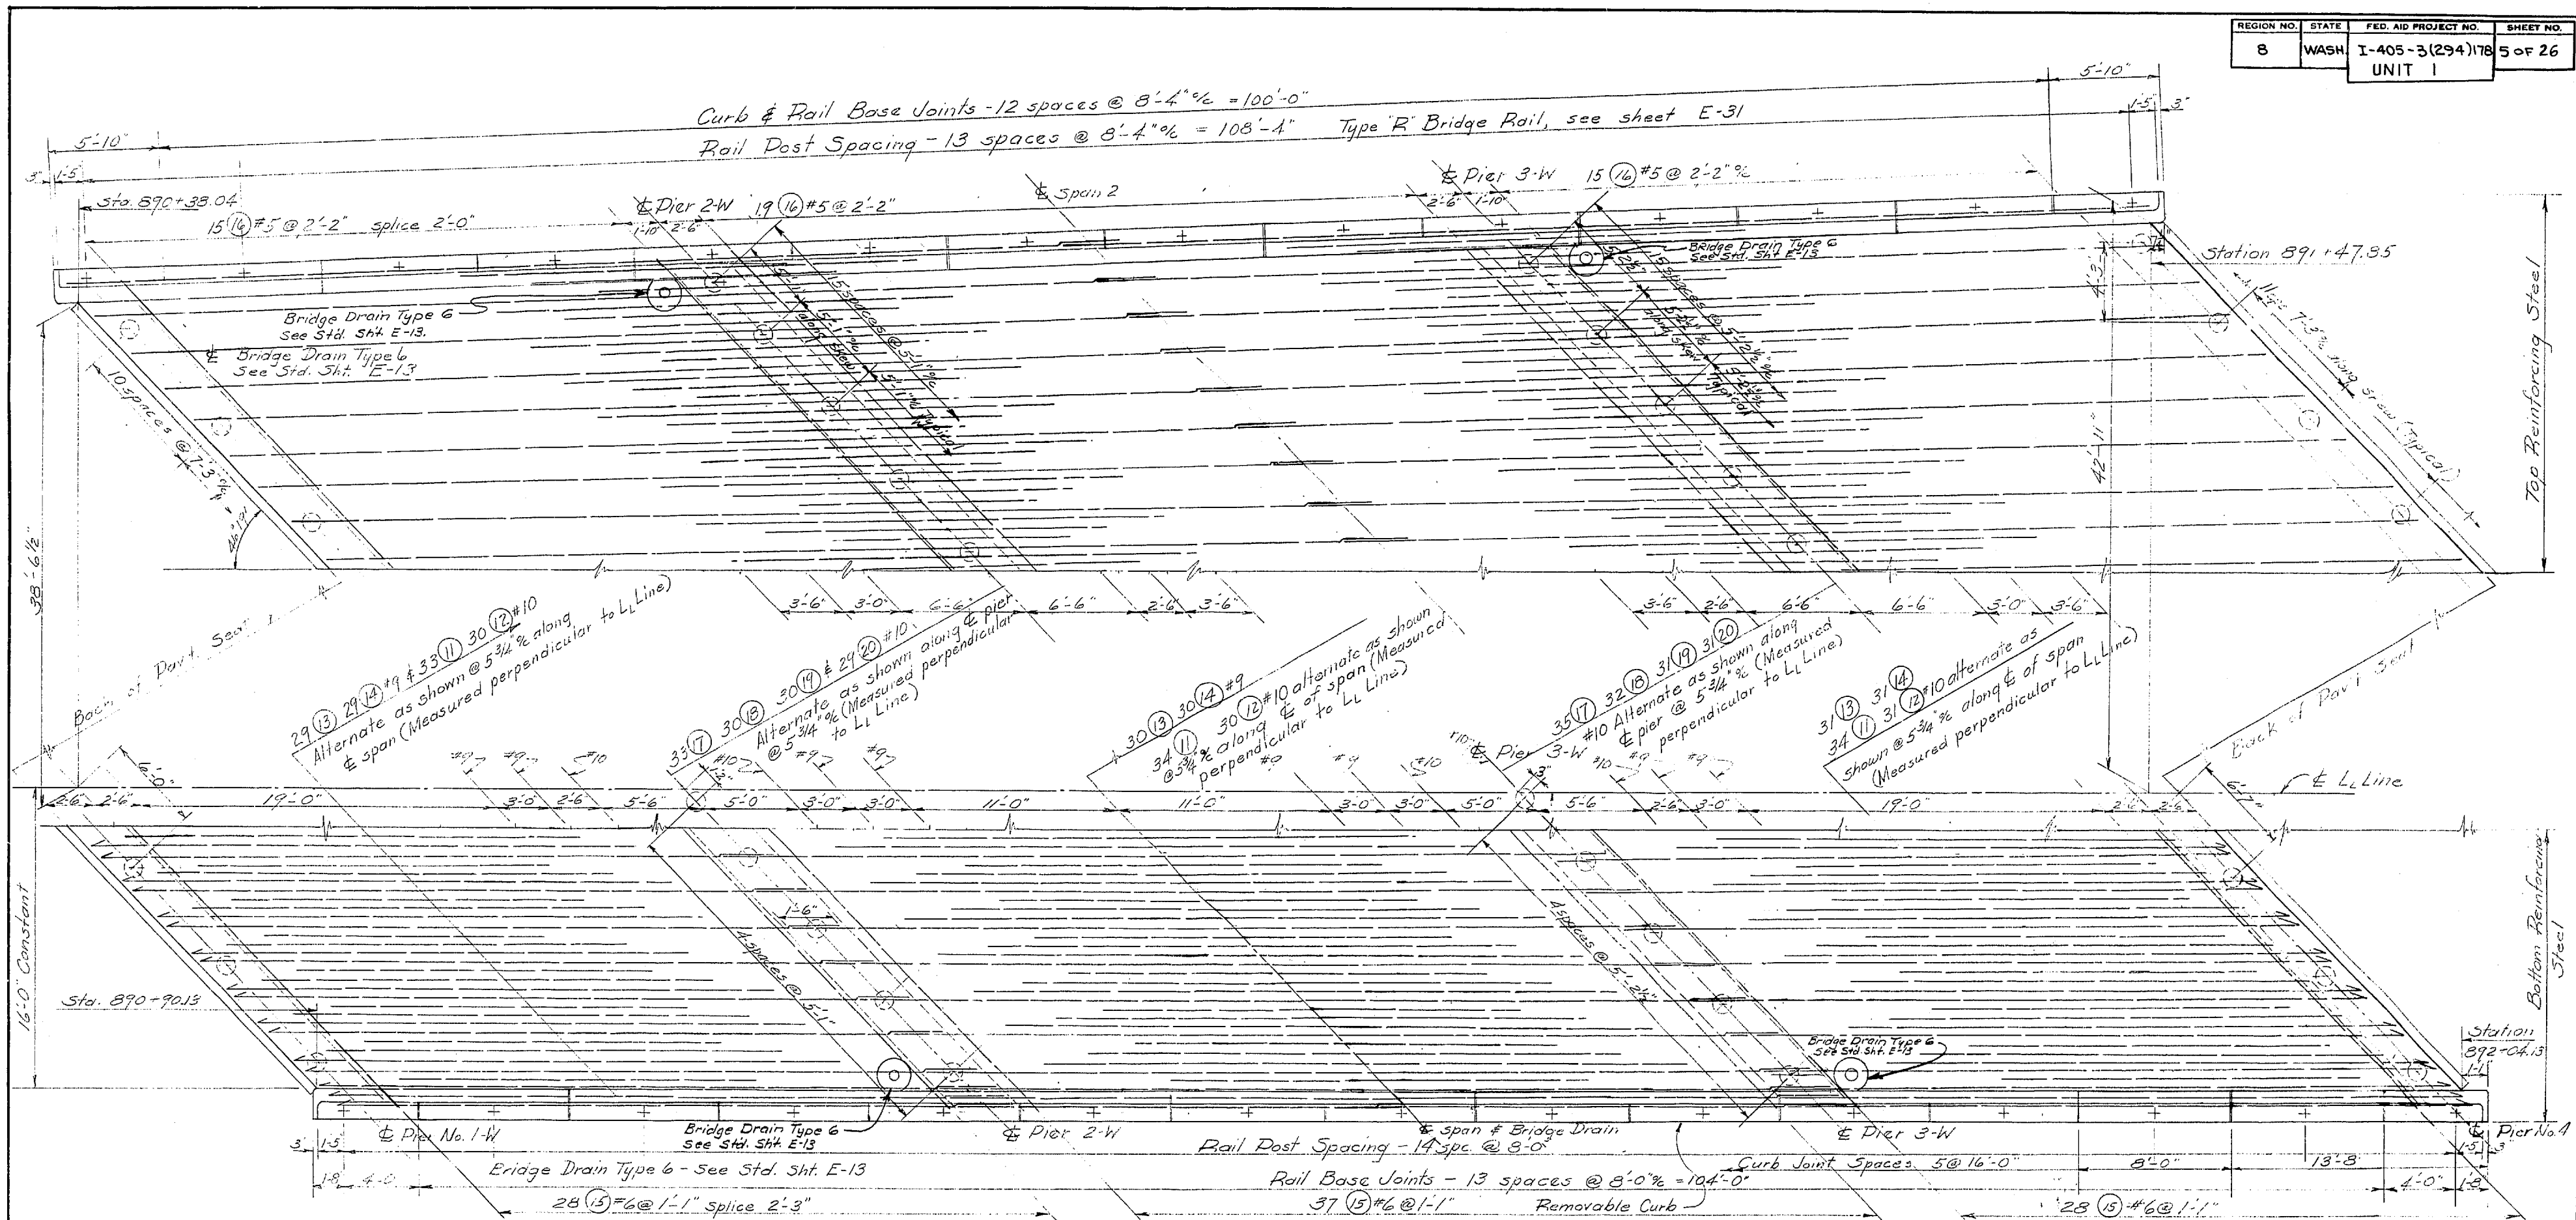

PARTIAL PLAN - WEST BRIDGE

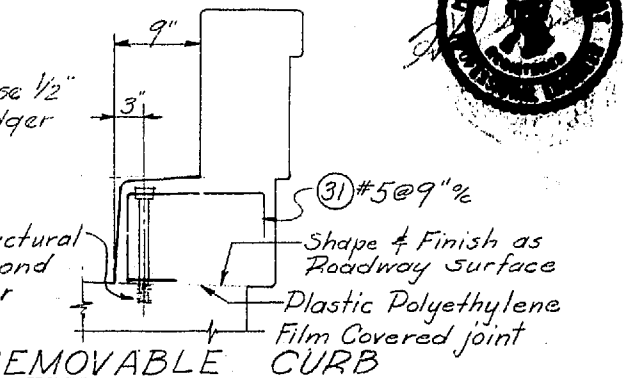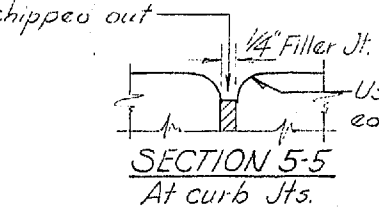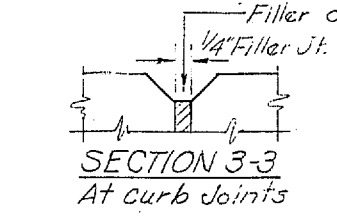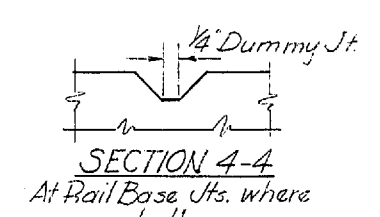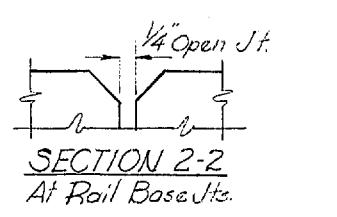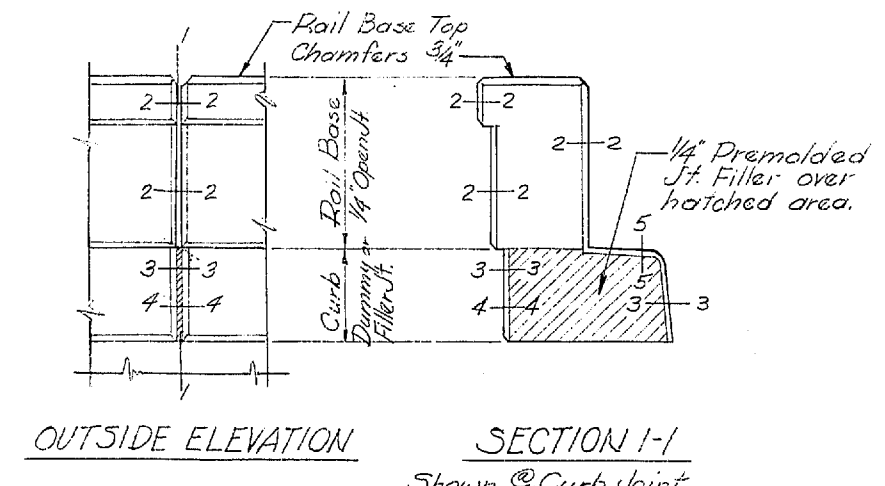

CURB & RAIL BASE JOINTS
All chamfers 1/2" except as noted

DATE	12-3-67	Changed Bridge Drains	W.L.G.
REVISION			BY




SR 405
 MP 24.28 to MP 26.37
 NORTH CR. BR. AND 228TH ST. O'XING
 KING & SNOHOMISH COUNTIES
 NORTH CREEK BRIDGES
 PARTIAL PLAN - WEST BR.


WASHINGTON STATE HIGHWAY COMMISSION
 DEPARTMENT OF HIGHWAYS
 OLYMPIA, WASHINGTON
 GEORGE S. ZAME, CHAIRMAN
 RAZEL FORTSON, JOHN H. HUFF

APPROVED: Nov. 22, 1967
 CONT. No. B375 SHEET 5 of 26 SHEETS
 P/1992


SHEET OF
 1-1575 C.S. 17520 & 3111

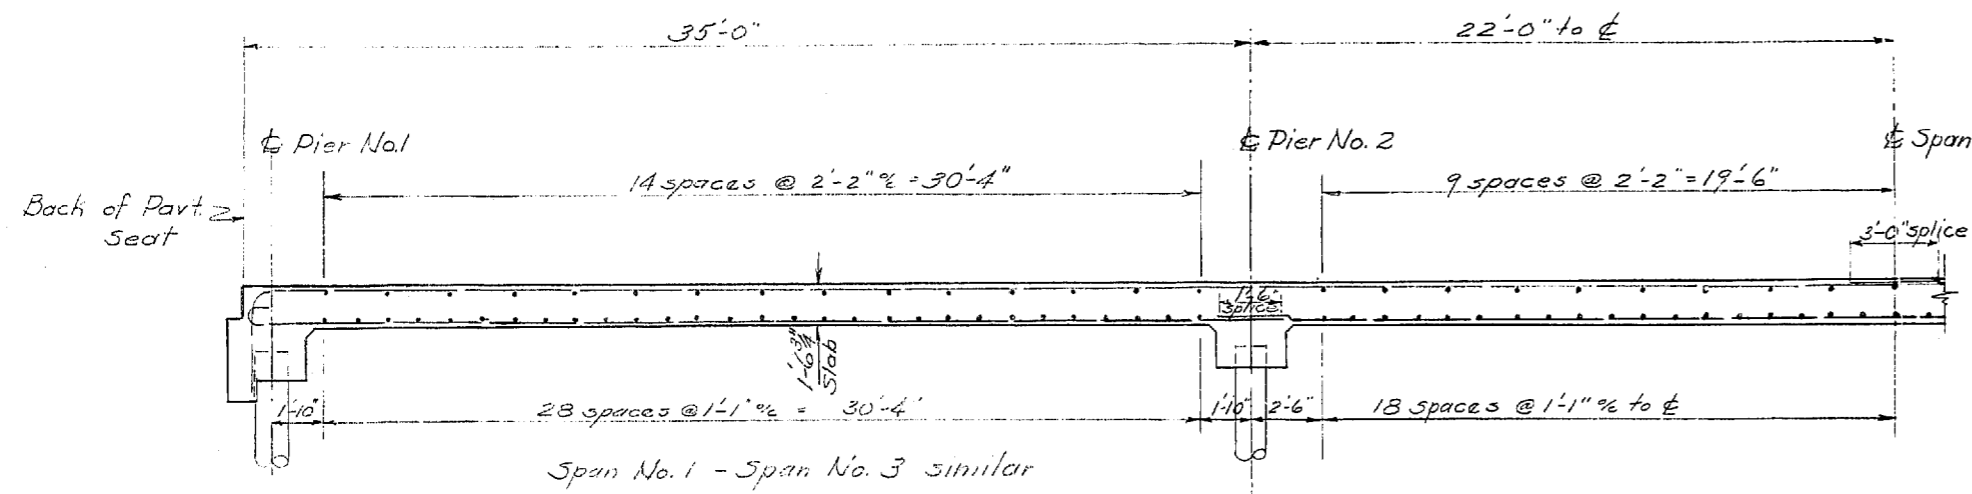


TYPICAL BOTH BRIDGES
PART LONGITUDINAL SECTION

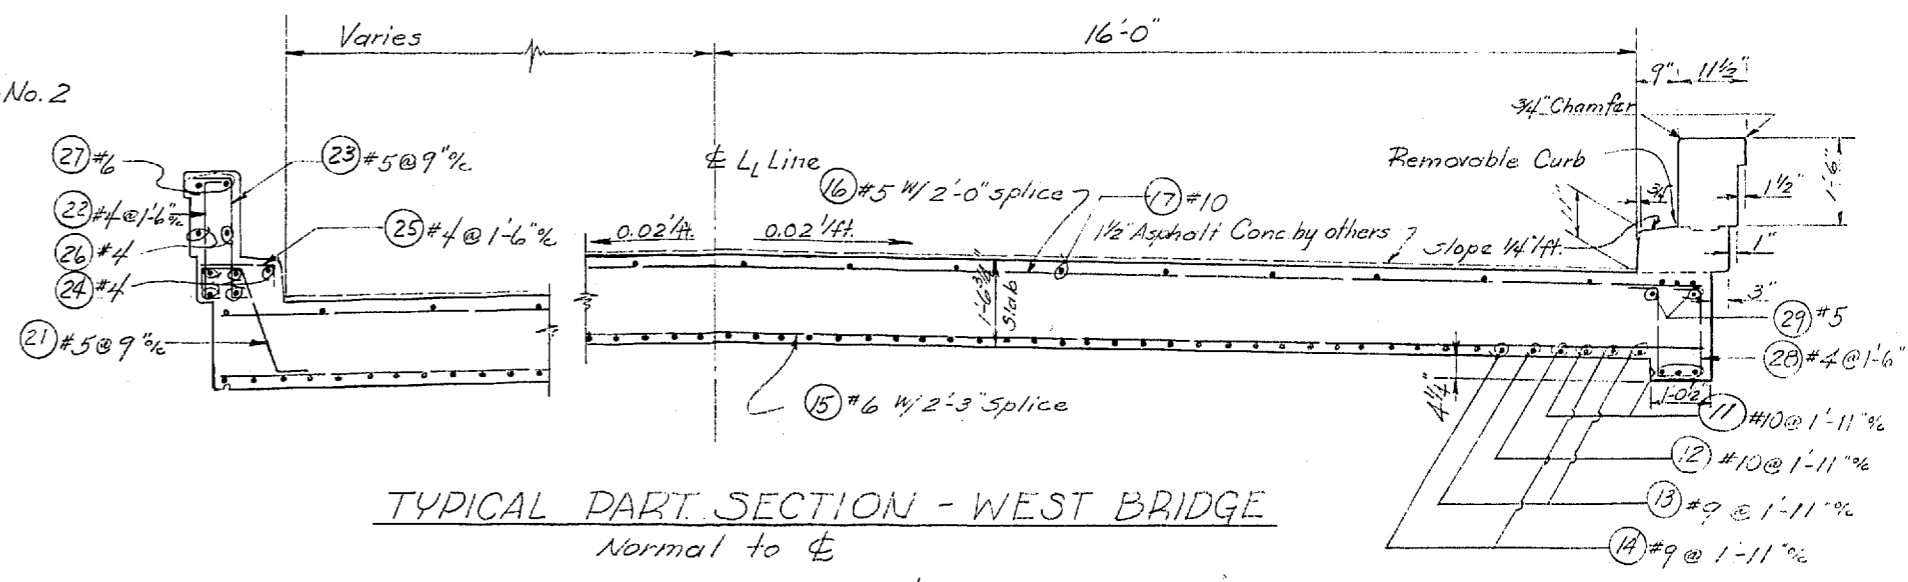


TYPICAL PART SECTION - WEST BRIDGE
Normal to centerline

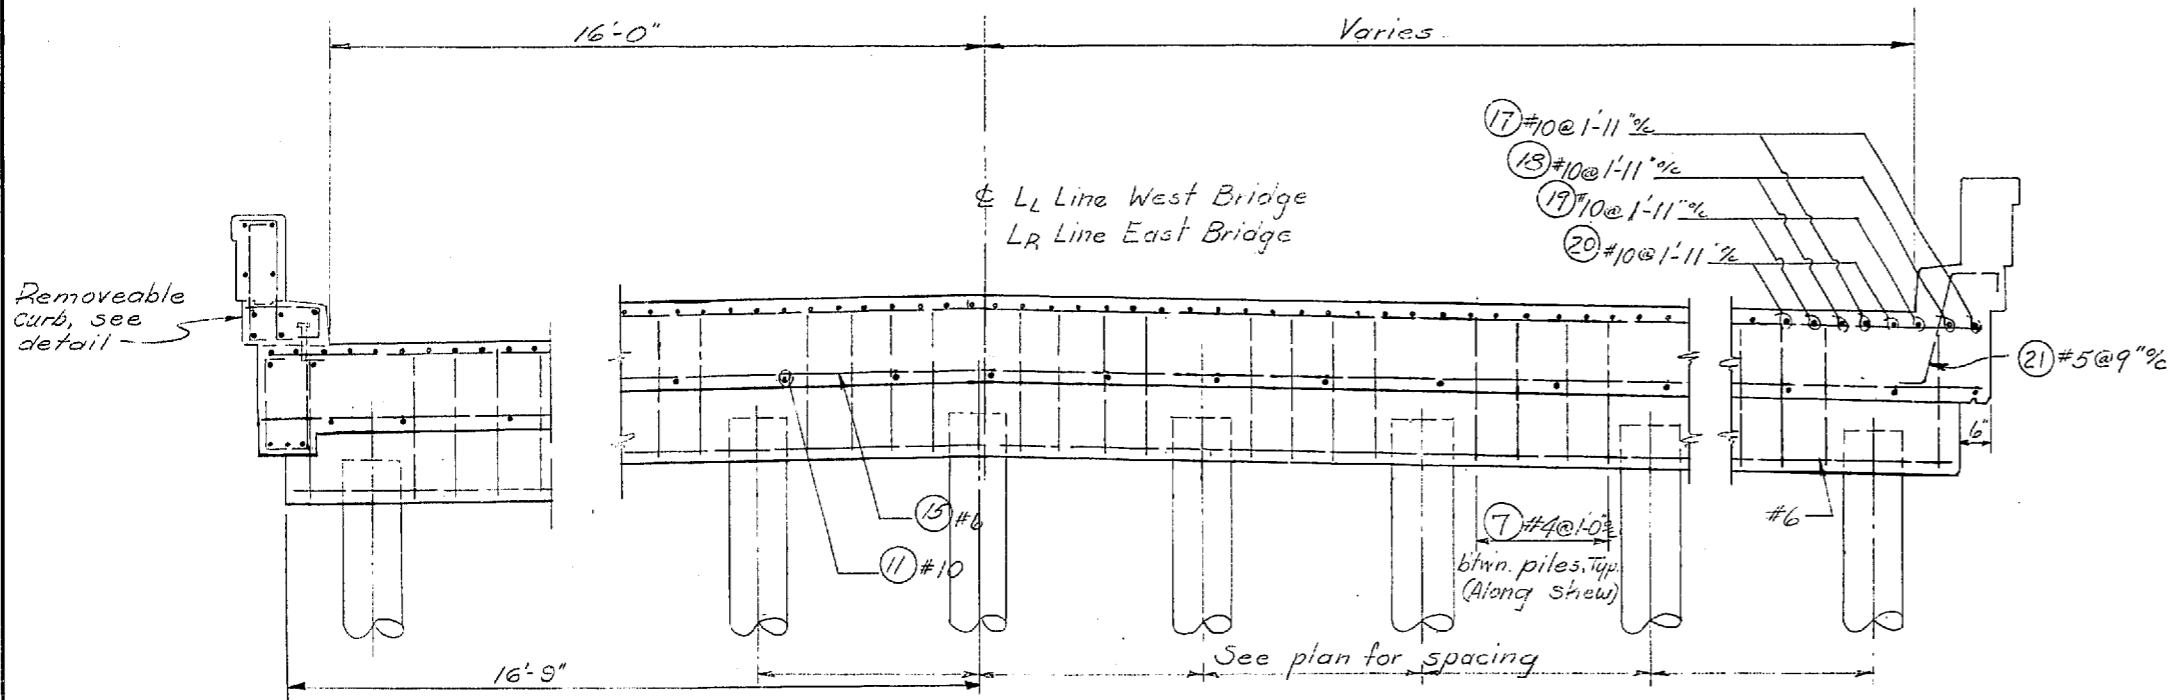


PART SECTION PIERS 2 & 3
NORMAL TO centerline
East Bridge shown looking ahead on stationing. West Bridge shown looking back on stationing.

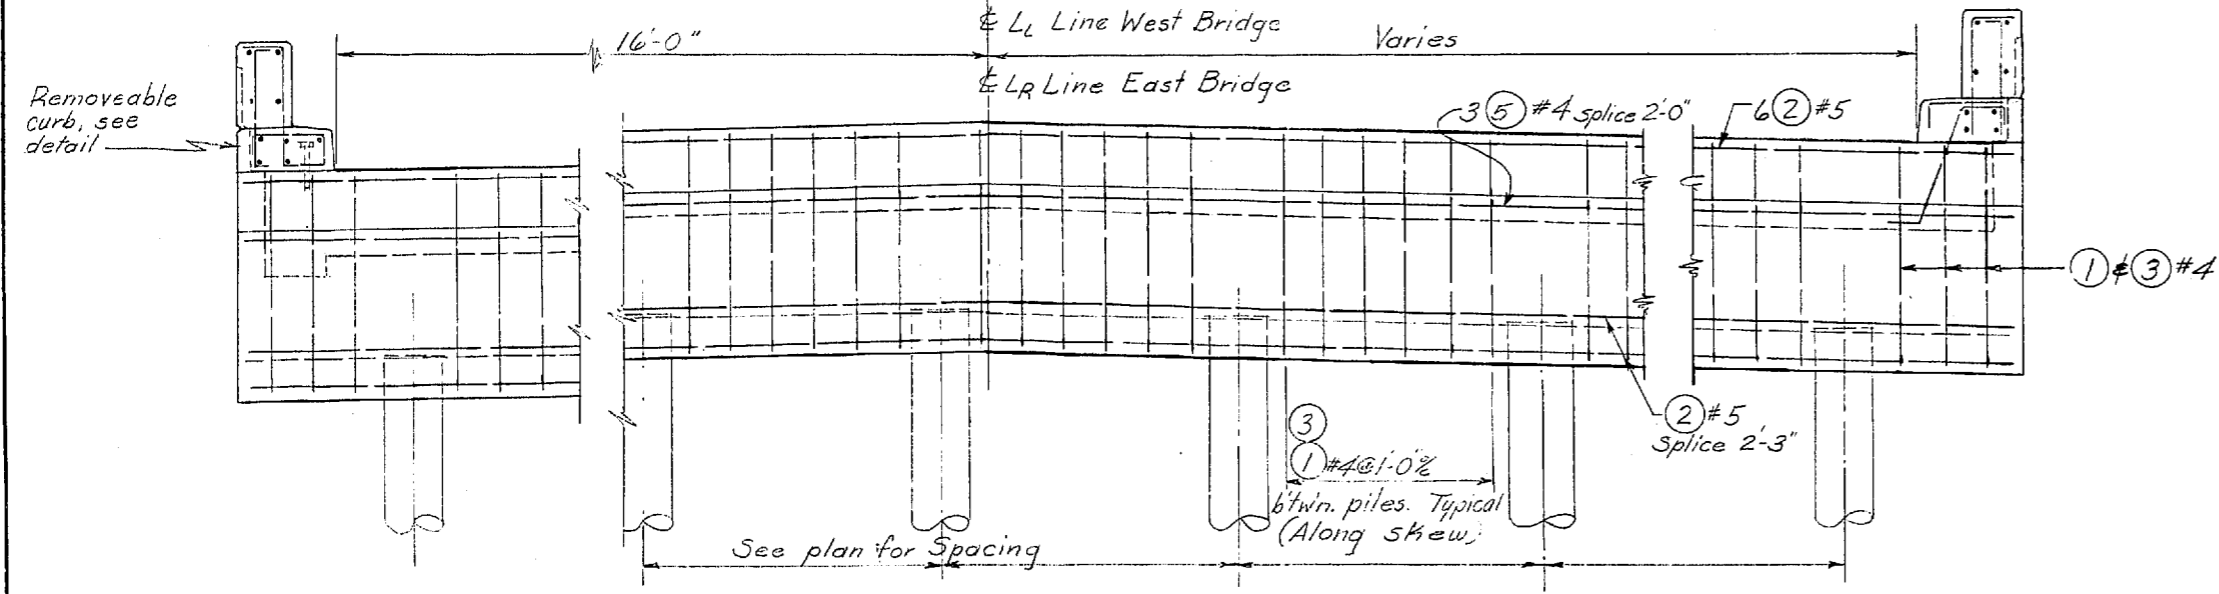


PART END ELEVATION PIERS 1 & 4
Normal to centerline
East Bridge shown looking ahead on stationing. West Bridge shown looking back on stationing.

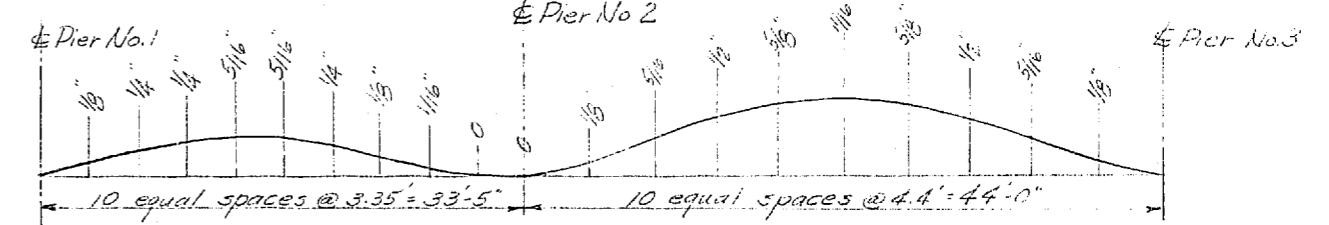


DEAD LOAD CAMBER CURVE
This curve shows the Dead Load Camber only and should be increased by the amount of take up anticipated in the falsework.

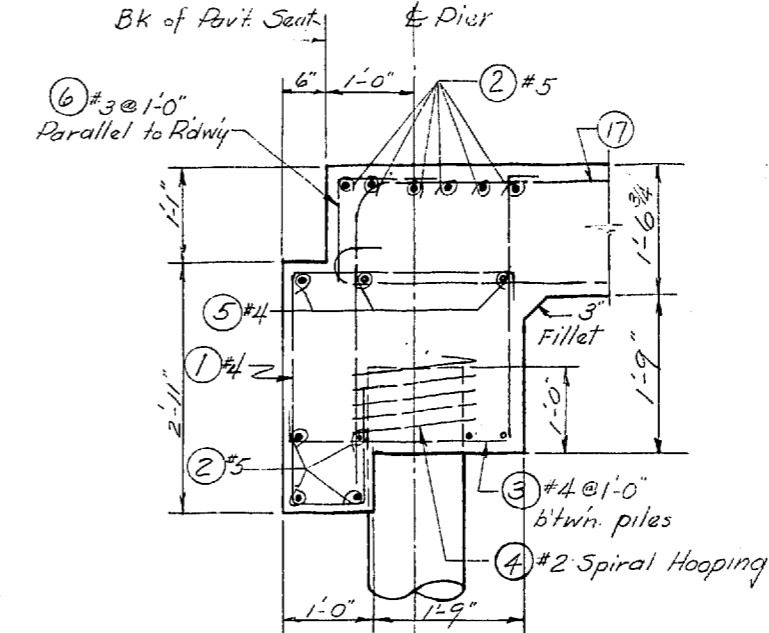

SECTION "A-A"
Typical for Piers No. 1 & 4

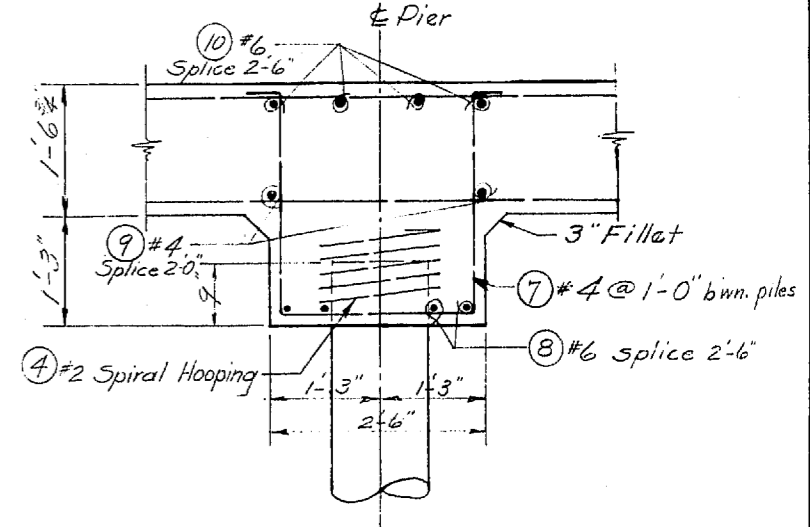

SECTION "B-B"
Typical for Piers No. 2 & 3

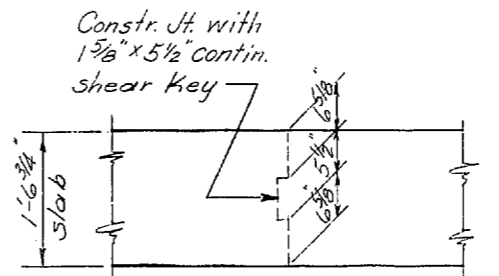

CONSTRUCTION JOINT THRU
SLAB DETAIL

Longitudinal constr. jt. permissible at locations shown on "LAYOUT." Other locations only by permission of the Engineer.







SR 405
MP 24.28 TO MP 26.37
NORTH CR. BR. AND 228TH ST. O'XING
KING & SNOHOMISH COUNTIES
NORTH CREEK BRIDGES

DETAILS

WASHINGTON STATE HIGHWAY COMMISSION
DEPARTMENT OF HIGHWAYS
OLYMPIA, WASHINGTON

APPROVED Nov. 22, 1967
SHEET 6 OF 26 SHEETS
CONTRACT NUMBER 8375



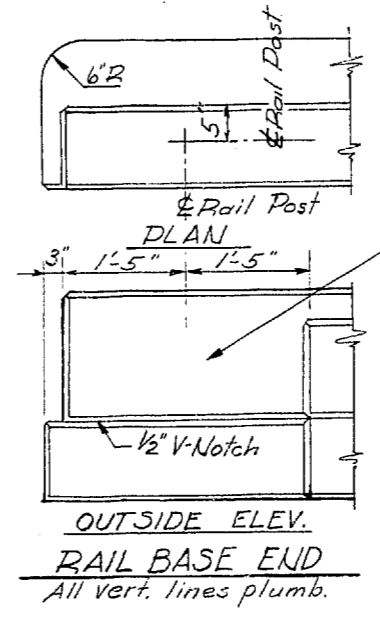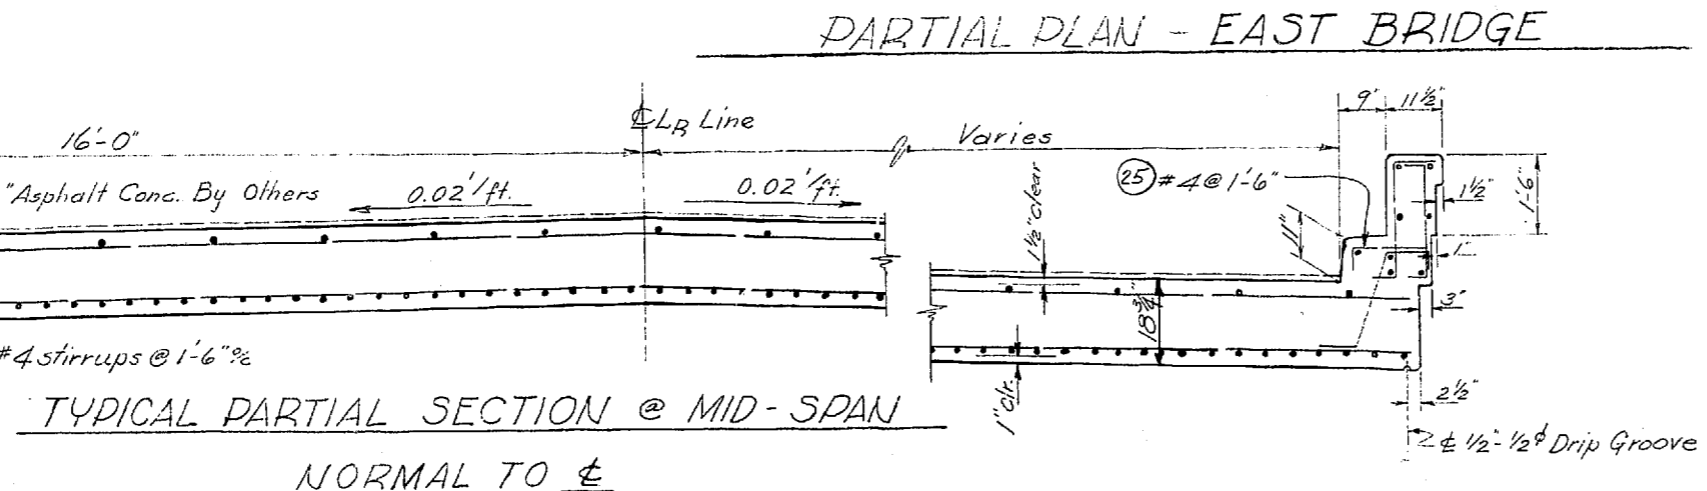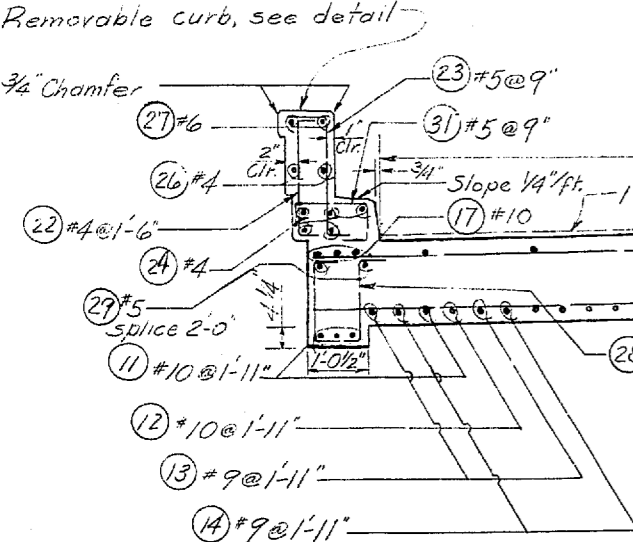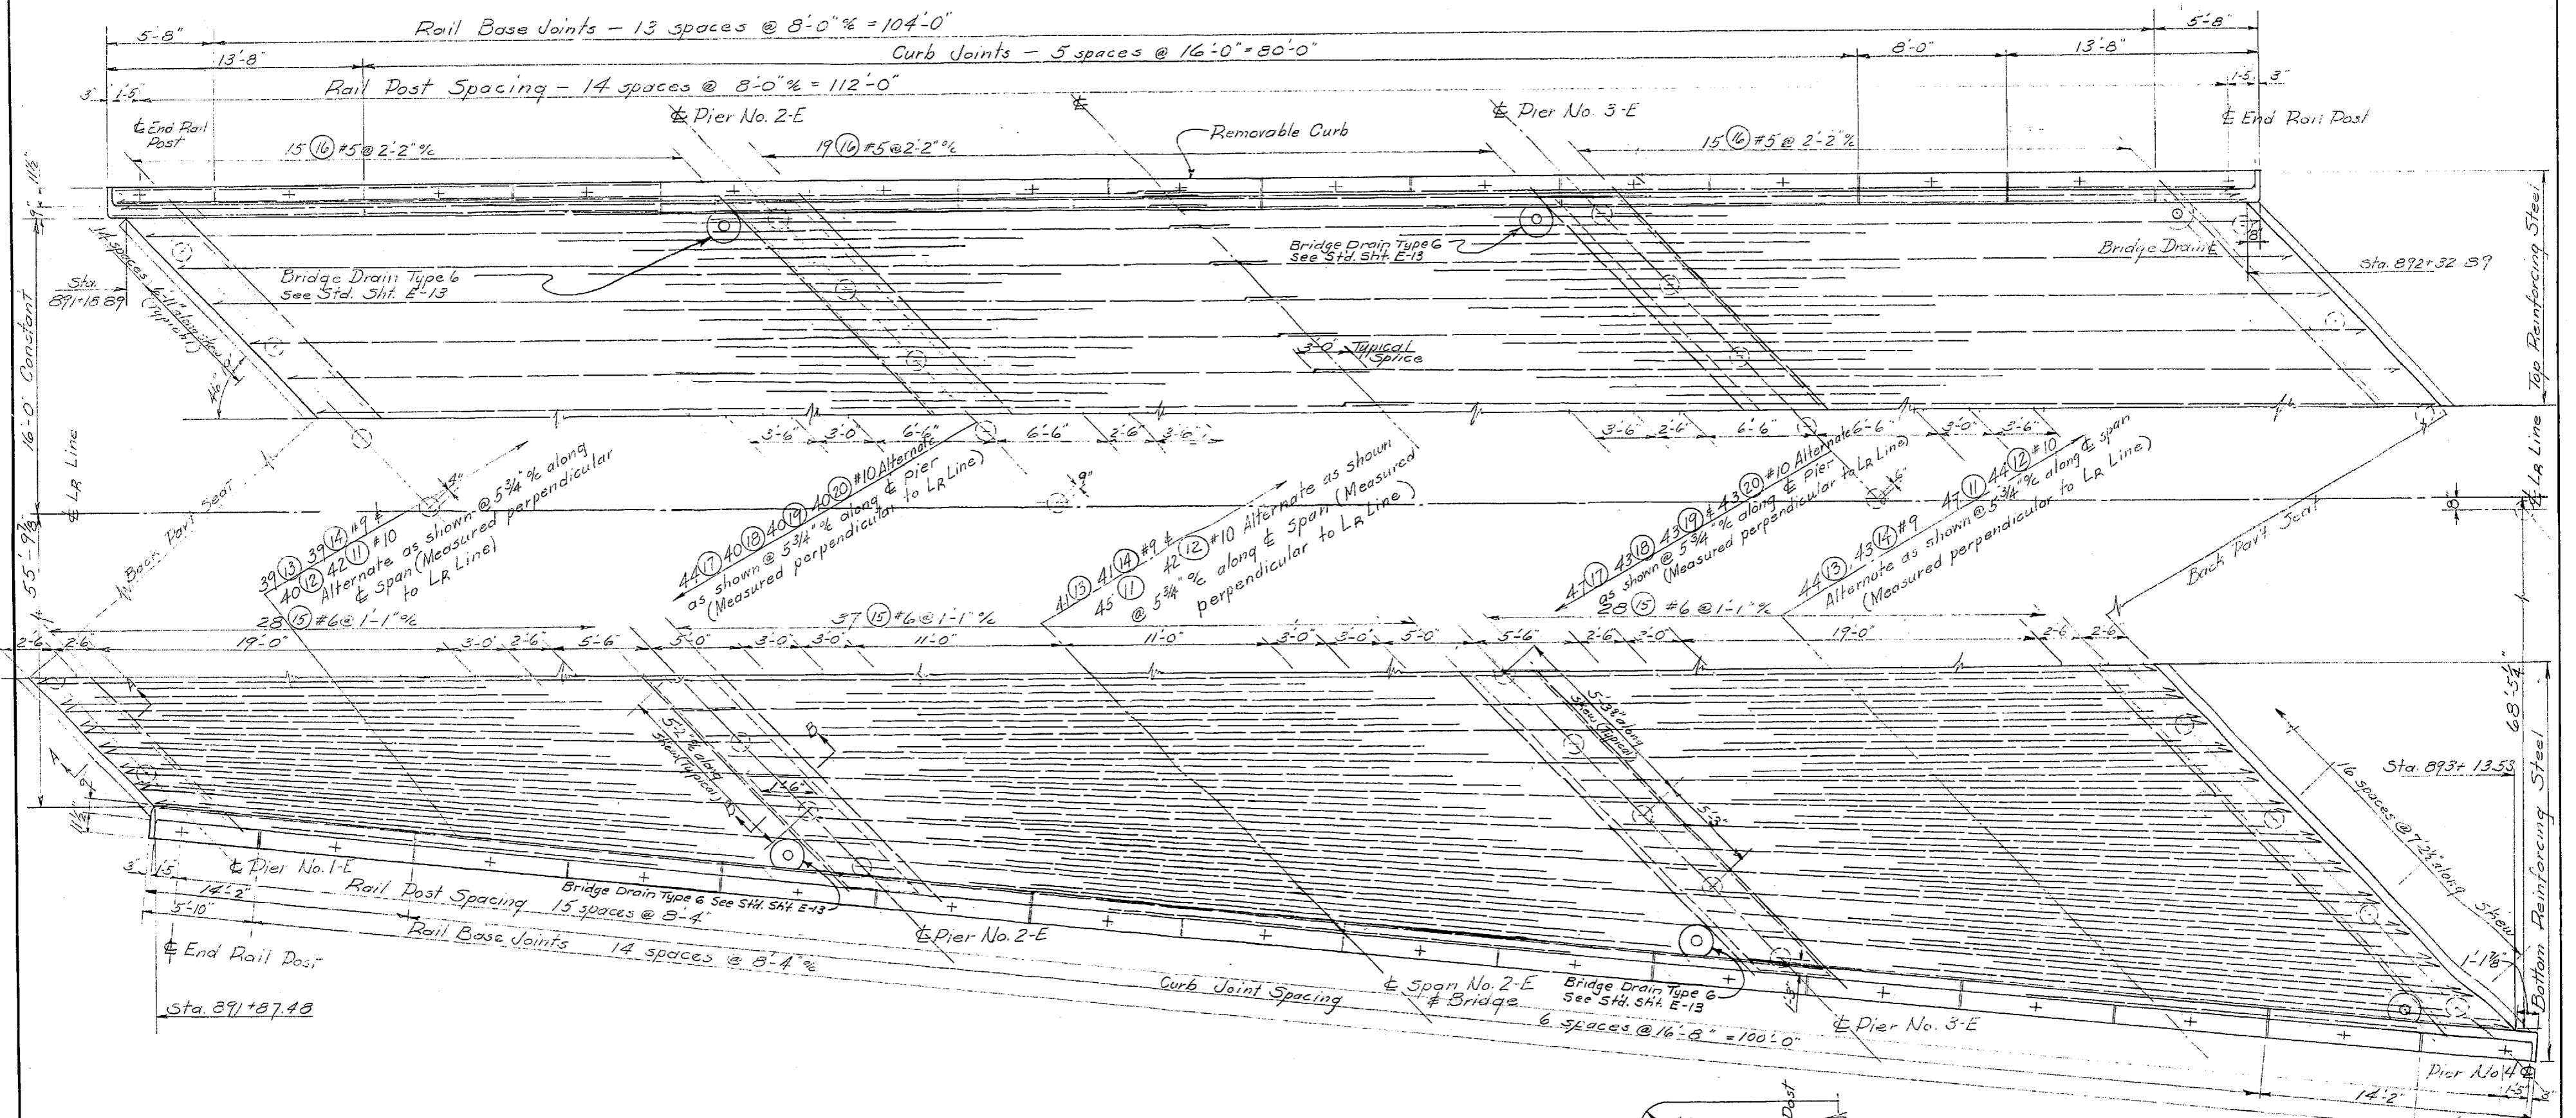

Standard Date Numerals (no date panel) on inside face on right of approaching traffic (center numerals in rail base)



SR 405
MP 24.28 TO MP 26.37
NORTH CR. BR. AND 228TH ST. O'XING
KING & SNOHOMISH COUNTIES
NORTH CREEK BRIDGES

PARTIAL PLAN - EAST BR.

WASHINGTON STATE HIGHWAY COMMISSION
DEPARTMENT OF HIGHWAYS
OLYMPIA, WASHINGTON

GEORGE B. TAMM, CHAIRMAN
E. S. REICHAUSEN
H. WALLEN
EASTE PERKINS
JOHN H. DUFF

APPROVED Nov. 22, 1967
CONTRACT NO. R376 SHEET 7 OF 26 SHEETS
CONTRACT NUMBER

12-3-67	Changed Bridge Drains	W.L.G.
DATE	REVISION	BY

SHEET 7 OF 26 SHEETS


P/1992

6/38

S- Bar is included in substructure quantities.
 F- Bar to be field welded.
 T- Tie or Stirrup.
 H- A.S.T.M. A-432.
 V- Bar dimensions vary between dimensions shown on this line and the following line.

S- Bar is included in substructure quantities.
 F- Bar to be field welded.
 T- Tie or Stirrup.
 H- A.S.T.M. A-432.
 V- Bar dimensions vary between dimensions shown on this line and the following line.

MARK NO.	LOCATION	SIZE	NO.	REG'D	BEND TYPE	TIE OR STIRRUP	FIELD WELDED	SUBSTR.	VARIES	NO. EACH	DIMENSIONS (Out to out)										LENGTH		WEIGHT Lbs.		
											U		W		X		Y		Z		θ ₁ θ ₂			Ft.	In.
											Ft.	In.	Ft.	In.	Ft.	In.	Ft.	In.	Ft.	In.	Deg.	Deg.			
1	PIERS 1+4 W+E BRIDGES	4	330	61							2	8.0	2	6.0	9.0	5.0	1	5.0	7	5.	1635				
2	PIERS 1+4 W+E	3	132	50							3	30							30	0.	4130				
2	PIERS 1 W	2	12	50							2	24							24	2.	302				
2	PIERS 4 W	2	29	50							29	2.0							29	2.	365				
2	PIERS 1 E	2	12	50							20	3.0							20	3.	253				
2	PIERS 4 E	5	12	50							10	2.0							10	2.	127				
3	PIERS 1+4 W+E	4	330	62	T						2	6.0	5.0	3	1.0	0.0	5.0	4	6	2.	1359				
4	PIERS 1+4+2+3 HOOPING	2	130	67							1	3.0	2.0						15	6.	354				
5	PIERS 1+4	4	33	50							30	0.0							30	0.	662				
5	PIERS 1W	4	3	50							23	8.0							23	8.	47				
5	PIERS 4W	4	3	50							29	8.0							29	8.	59				
5	PIERS 1E	4	3	50							20	0.0							20	0.	40				
5	PIERS 4E	4	3	50							9	2.0							9	2.	18				
6	PIERS 1+4 W+E	3	391	65							1	3.0	1	3.0	0.0				2	5.	355				
7	PIERS 2+3 W+E	4	292	63	T						2	3.0	2	6.5	2	6.5	5.0	5.0	7	10.	1522				
8	PIERS 2+3 W+E	6	28	50							40	0.0							40	0.	1008				
8	PIERS 2E	6	4	50							32	0.0							32	0.	192				
8	PIERS 3E	6	4	50							39	0.0							39	0.	234				
8	PIERS 2W	6	4	50							42	2.0							42	2.	253				
8	PIERS 3W	6	4	50							6	8.0							6	8.	40				
9	PIERS 2+3	4	20	50							30	0.0							30	0.	400				
9	PIER 2W	4	2	50							23	8.0							23	8.	32				
9	PIER 3W	4	2	50							25	10.0							25	10.	35				
9	PIER 2E	4	2	50							23	6.0							23	0.	31				
9	PIER 3E	4	2	50							29	4.0							29	4.	32				
10	PIERS 2+3	6	28	50							40	0.0							40	0.	1008				
10	PIER 2W	6	4	50							43	6.0							43	6.	261				
10	PIER 3W	6	4	50							8	0.0							8	0.	48				
10	PIER 2E	6	4	50							33	4.0							33	4.	200				
10	PIER 3E	6	4	50							29	8.0							29	8.	238				
11	BOTTOM LONGIT SPAN 1E	10	42	51							1	35	7.0						37	3.	702				
11	BOTTOM LONGIT SPAN 2E	10	45	50							1	45	6.0						45	6.	924				
11	BOTTOM LONGIT SPAN 3E	10	47	51							1	35	7.0						37	3.	798				
11	BOTTOM LONGIT SPAN 1W	10	33	51							1	35	7.0						36	0.	5208				
11	BOTTOM LONGIT SPAN 2W	10	34	50							1	45	6.0						45	6.	6565				
11	BOTTOM LONGIT SPAN 3W	10	34	51							1	35	7.0						37	3.	5368				
12	BOTTOM	10	145	51							1	34	4.0						31	0.	19342				
12	BOTTOM	10	72	50							34	0.0							34	0.	10534				
13	BOTTOM	9	71	50							28	0.0							28	0.	6722				
13	BOTTOM	9	143	50							24	6.0							24	6.	11912				
14	BOTTOM	9	71	50							19	0.0							19	0.	4887				
14	BOTTOM	9	142	50							22	0.0							22	0.	10622				
15	BOTTOM TRANSV	6	465	50							3	30	0.0						30	0.	20953				
15	BOTTOM TRANSV SPAN 1W	6	28	50							1	24	10.0						23	2.	20952				
15	BOTTOM TRANSV SPAN 2W	6	37	50							1	24	10.0						24	10.	1009				
15	BOTTOM TRANSV SPAN 3W	6	28	50							1	27	2.0						24	10.	1449				
15	BOTTOM TRANSV SPAN 1E	6	28	50							1	19	10.0						27	2.	1185				
15	BOTTOM TRANSV SPAN 2E	6	37	50							1	24	10.0						27	2.	939				
15	BOTTOM TRANSV SPAN 3E	6	28	50							1	31	5.0						24	10.	1563				
16	TOP TRANSV	5	245	50							3	30	0.0						36	10.	1438				
16	TOP TRANSV SPAN 1W	5	15	50							1	22	8.0						30	0.	7666				
16	TOP TRANSV SPAN 2W	5	19	50							1	44	4.0						22	8.	524				
16	TOP TRANSV SPAN 3W	5	15	50							1	26	9.0						24	6.	506				
16	TOP TRANSV SPAN 1E	5	15	50							1	26	9.0						26	9.	433				
16	TOP TRANSV SPAN 2E	5	19	50							1	28	7.0						26	9.	340				
16	TOP TRANSV SPAN 3E	5	15	50							1	19	4.0						19	1.	341				
17	TOP LONGIT EAST	10	44	80							1	58	4.0	3	5.0	0.0	9.0	0.0	90	0	12192				
17	TOP LONGIT EAST	10	48	80							1	58	4.0	3	5.0	0.0	9.0	0.0	90	0	12914				
17	TOP LONGIT WEST	10	33	80							1	58	4.0	3	5.0	0.0	9.0	0.0	90	0	9288				
17	TOP LONGIT WEST	10	35	80							1	58	4.0	3	5.0	0.0	9.0	0.0	90	0	614				
18	TOP LONGIT	10	145	50							56	5.0	3	5.0	0.0	9.0	0.0	90	0	5086					
19	TOP LONGIT	10	144	50							25	6.0							50	5.	15910				
20	TOP LONGIT	10	143	50							18	6.0							18	6.	11463				
21	CURB TIES	5	320	69	T						9	0.0							13	0.	7992				
22	CURB	4	316	64	T						5	0.0	2	8.0	2	2.0	0.0	5.5	4	0.	1324				
23	CURB	5	4	80	65	T					8	5	2	2.0	8.5	0.0			2	10.	998				
24	CURB LONGIT	4	50	50							15	9.0							3	5.	2218				
24	CURB LONGIT	4	50	50							13	5.0							15	9.	526				
24	CURB LONGIT	4	50	50							13	5.0							13	5.	172				
24	CURB LONGIT	4	55	50							16	5.0							16	5.	603				
24	CURB LONGIT	4	10	50							13	9.0							13	9.	92				
24	CURB LONGIT	4	10	50							13	11.0							13	11.	93				
25	CURB	4	388	65	T						5	0.0	1	3.0	0.0				1	7.	334				
26	RAILBASE	4	52	50							7	9.0							7	9.	260				
26	RAILBASE	4	52	50							8	1.0							8	1.	281				
26	RAILBASE	4	52	50							5	2.0							5	2.	20				
26	RAILBASE	4	50	50							5	5.0							5	5.	28				
27	RAILBASE	4	52	50							7	9.0							7	9.	606				
27	RAILBASE	4	52	50							8	1.0							8	1.	831				
27	RAILBASE	6	8	50							5	2.0							5	2.	66				
27	RAILBASE	6	8	50							5	5.0							5	5.	66				
28	EDGE BEAM STIRRUP	4	154	62	T						9	5	1	6.5	1	6.5	5.0	5.0	4	5.	490				
29	STIRRUP HANGER	5	3	16	50						30	0.0							30	0.	903				
31	REMOVABLE CURB	5	308	64	T						6	0.0							2	8.	888				
4	Piers 2+3 Hooping	2	75	67							1	4.5	2.0						15	6.	385				

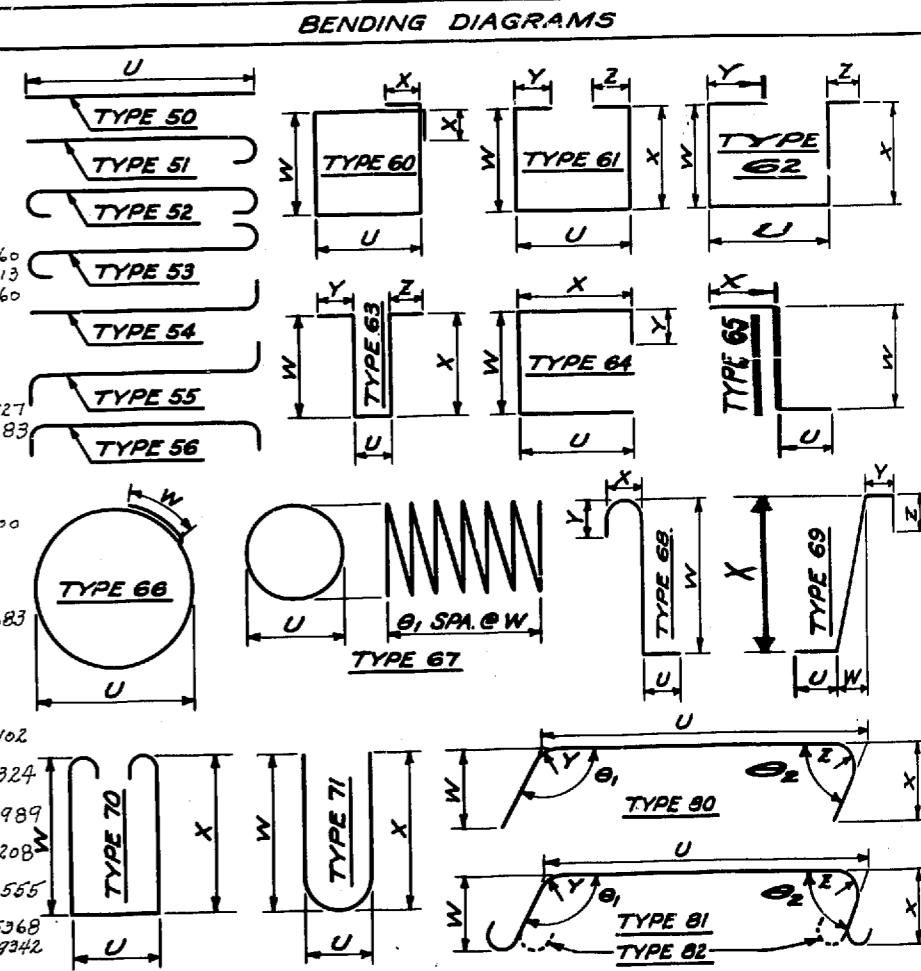

As built changes in Rev 1-2-70
 Note:
 Bends for transverse bars due to roadway crown conditions have not been shown. These bars shall be bent as required to conform to the configuration of the structure.

SR 405
 MP 24.28 TO MP 26.37
 NORTH CR. BR. AND 228TH ST. O'XING
 KING & SNOHOMISH COUNTIES
 NORTH CREEK BRIDGES

BAR LIST

WASHINGTON STATE HIGHWAY COMMISSION
 DEPARTMENT OF HIGHWAYS
 OLYMPIA, WASHINGTON


G. E. BRALSON
 W. WALSH
 GEORGE D. ZARK, CHAIRMAN
 DAVID FRENCH
 JOHN S. BRY



APPROVED Nov. 22, 1967
 CONT. No. 8375 SHEET 8 OF 26 SHEETS
 NORTH Creek Bridges P/199

SEC. 5, T. 26 N., R. 5 E., W.M.
CITY OF BOTHELL

CURVE DATA					
P.I. STATION	Δ	RADIUS	TANGENT	LENGTH	BK. TANGENT BRG.
NBCD 9+334.525	18°30'00" RT.	1219.202	198.560	393.663	N 25°29'51" W
195TH-S 9+203.799	06°06'28" LT.	910.135	48.557	97.021	N 26°38'41" W

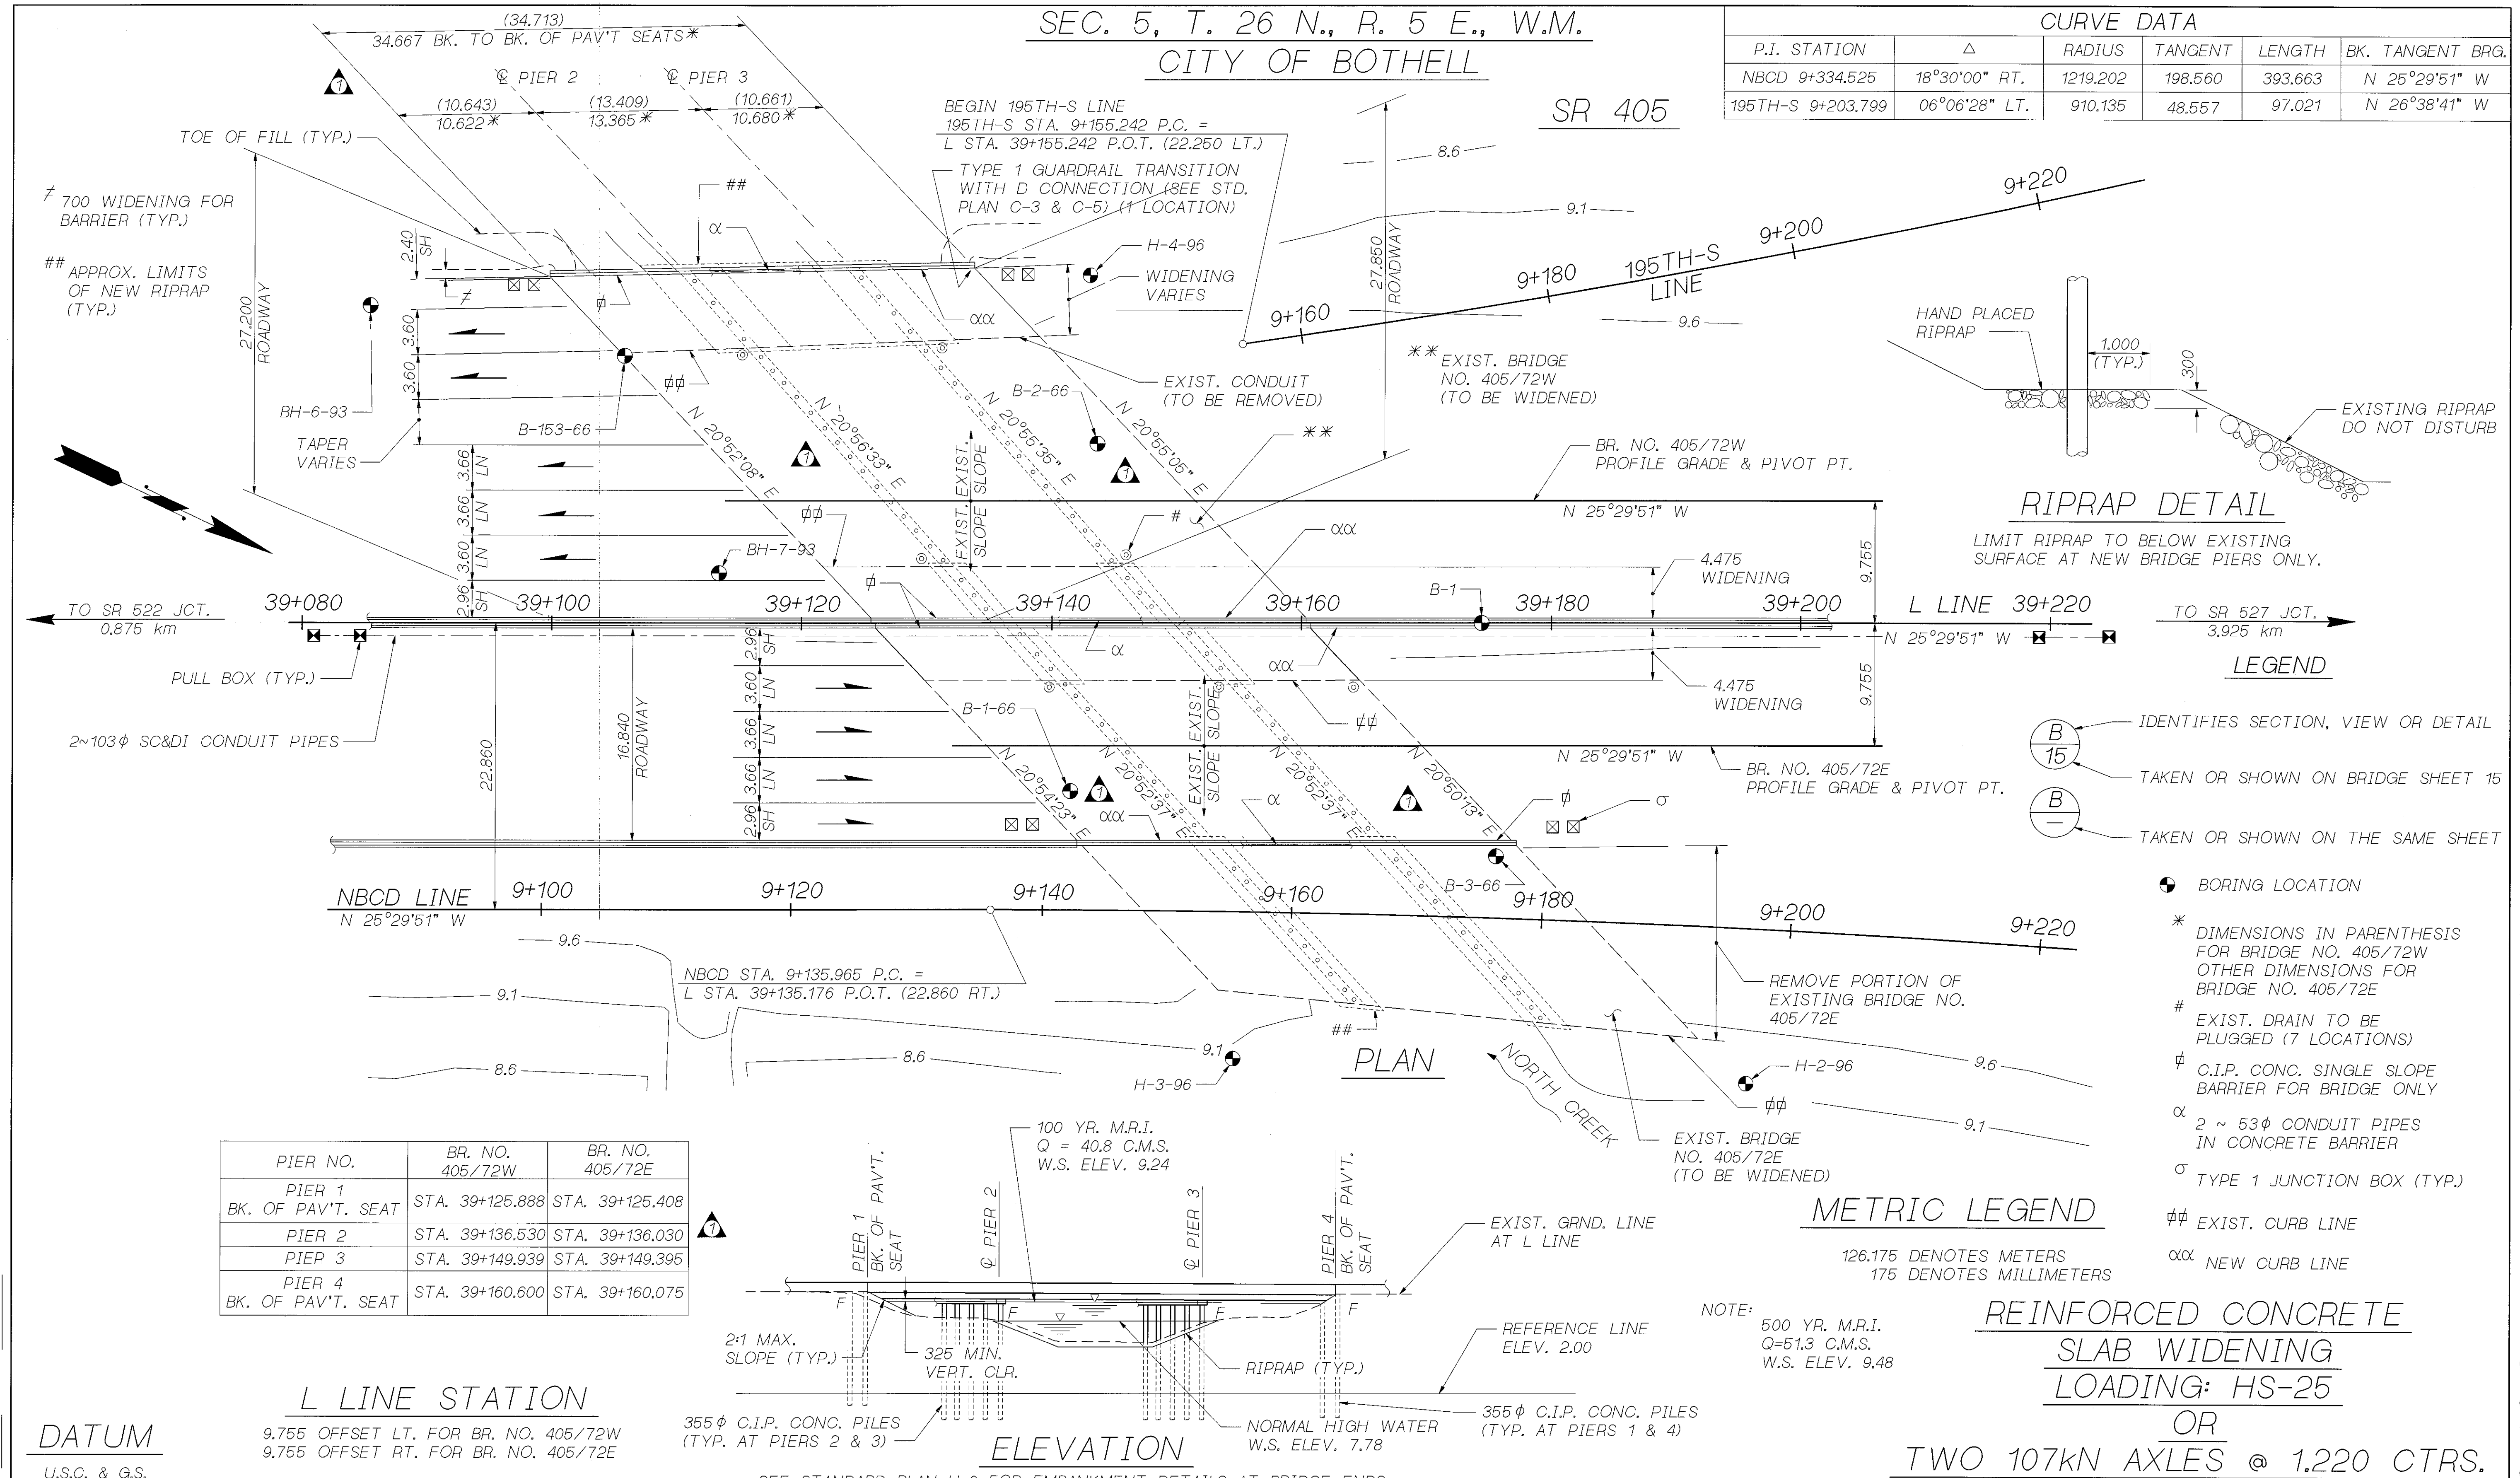

PIER NO.	BR. NO. 405/72W	BR. NO. 405/72E
PIER 1 BK. OF PAV'T. SEAT	STA. 39+125.888	STA. 39+125.408
PIER 2	STA. 39+136.530	STA. 39+136.030
PIER 3	STA. 39+149.939	STA. 39+149.395
PIER 4 BK. OF PAV'T. SEAT	STA. 39+160.600	STA. 39+160.075

L LINE STATION

9.755 OFFSET LT. FOR BR. NO. 405/72W
9.755 OFFSET RT. FOR BR. NO. 405/72E

DATUM
U.S.C. & G.S.

355 φ C.I.P. CONC. PILES (TYP. AT PIERS 2 & 3)
355 φ C.I.P. CONC. PILES (TYP. AT PIERS 1 & 4)
NORMAL HIGH WATER W.S. ELEV. 7.78
RIPRAP (TYP.)
REFERENCE LINE ELEV. 2.00
EXIST. GRND. LINE AT L LINE
100 YR. M.R.I. Q = 40.8 C.M.S. W.S. ELEV. 9.24


ELEVATION

SEE STANDARD PLAN H-9 FOR EMBANKMENT DETAILS AT BRIDGE ENDS.


Bridge Design Engr. C. C. RUTH 4/96	S405D72ROOT-(L.FGB) LAYOUT.FGB:1	REGION NO.	STATE	FED. AID PROJ. NO.	SHEET NO.	TOTAL SHEETS			SR 405 BOTHELL TO SWAMP CREEK I/C HOV LANES - STAGE 1 NORTH CREEK BRIDGE 405/72 E-W LAYOUT	BRIDGE SHEET NO. 1 SHEET 461 OF 663 SHEETS
Supervisor R.T. SHAEFER / W. WILSON 6/96		10	WASH.							
Designed By J. CHEN 6/96										
Checked By C. CORNELL 6/96										
Detailed By L. ANDREOTTI, A. CHU 3/96										
Bridge Projects Engr. K. N. KIRKER 3/96										
Prelim. Plan By A. CHU 3/96	7/97	CONTRACTOR SURVEY - FIT EXIST.								
Architect/Specialist A. YOUNG 3/96	DATE	REVISION	BY	APP'D	5054					

SR 405 JOB NO. 7071 SHEET 1

C.S. 1752 ~ PROJ. NO. OL-2095A ~ NW REGION ~ BOTHELL TO SWAMP CR. ~ SR 405 ~ N. CR. BRIDGE ~ 405/72 E&W WIDENING

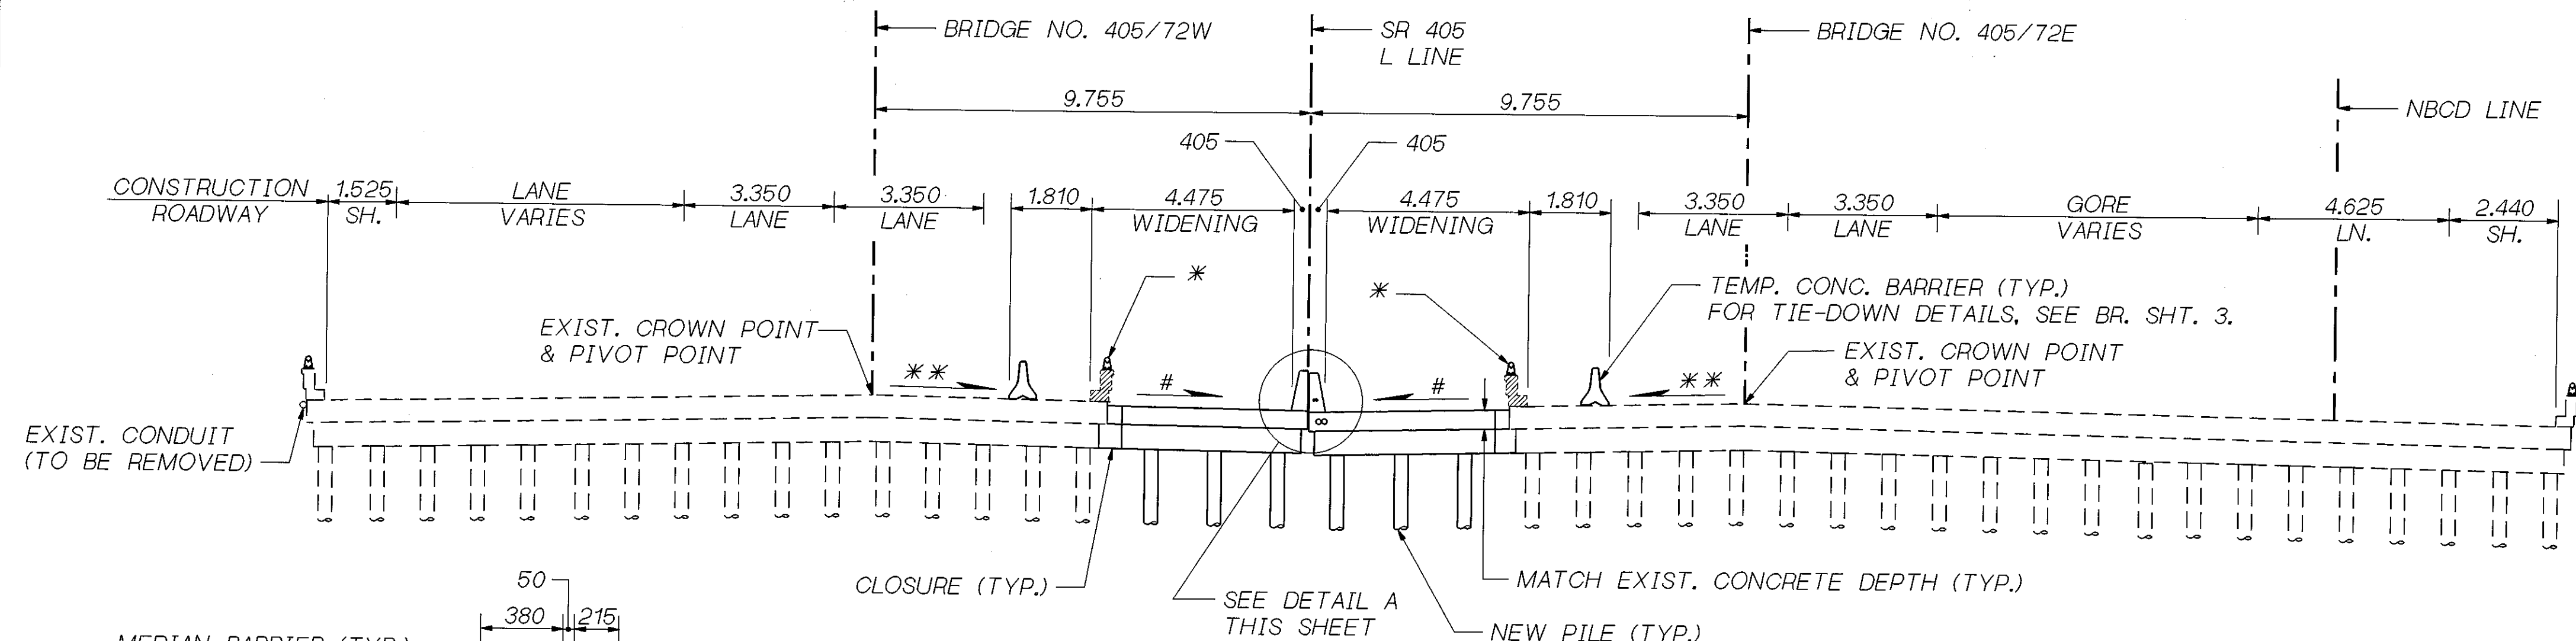


TYPICAL SECTION PHASE 1
SHOWN NEAR AN INTERMEDIATE PIER
DIMENSIONS SHOWN ARE PERPENDICULAR TO C L LINE.

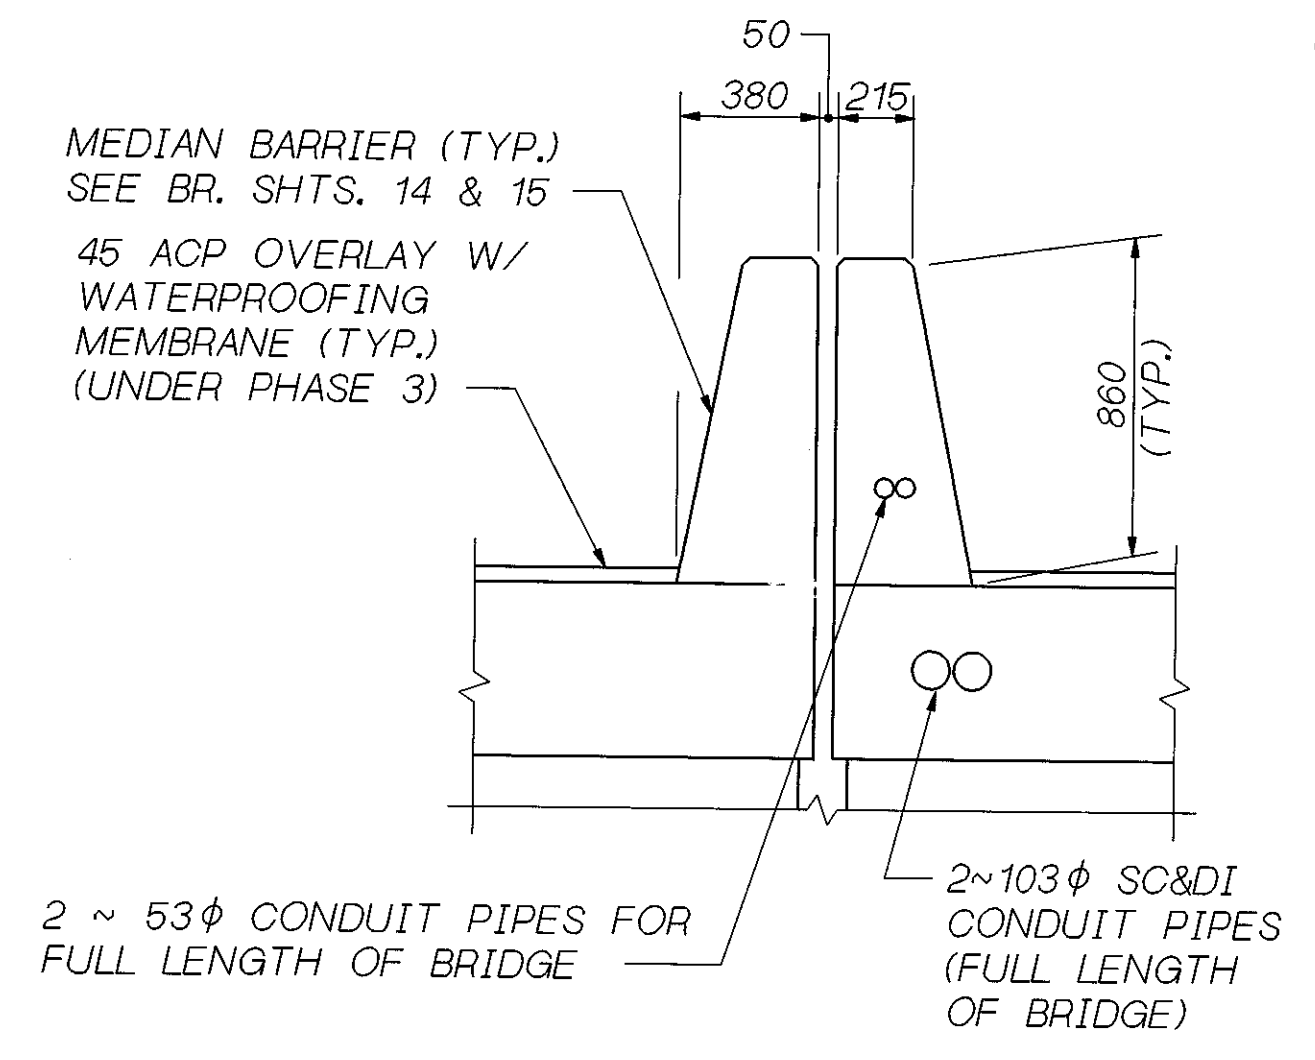

DETAIL A

- * EXIST. CURB AND RAIL BASE (TO BE REMOVED)
EXIST. RAILS TO BE SALVAGED (SEE SPECIAL PROVISIONS)
- ** EXIST. SLOPE
- # MATCH EXIST. SLOPE
- ## 45 ACP OVERLAY WITH MEMBRANE WATERPROOFING (82 ACP OVERLAY ON WESTERLY PORTION OF WEST BRIDGE & EASTERLY PORTION OF EAST BRIDGE)


- CONSTRUCTION SEQUENCE**
- PHASE 1:
1. SET TEMPORARY CONCRETE BARRIER. REMOVE EXISTING CURB AND RAIL BASE FROM MEDIAN PORTIONS.
 2. CONSTRUCT MEDIAN PORTIONS OF PIERS 1 THRU 4 EXCEPT AT THE CLOSURE.
 3. CONSTRUCT MEDIAN PORTIONS OF THE DECK SLAB EXCEPT AT THE CLOSURE.
 4. ALLOW 30 CALENDAR DAYS PRIOR TO SUBSTRUCTURE AND DECK SLAB CLOSURE.
 5. PLACE SUBSTRUCTURE AND DECK SLAB CLOSURES.
 6. PLACE TRAFFIC BARRIER.
- PHASE 2:
1. SET TEMPORARY CONCRETE BARRIER. REMOVE EXISTING CURB AND RAILBASE.
 2. CONSTRUCT OUTBOARD PORTION OF PIERS 1 THRU 4 OF BR. NO. 405/72W EXCEPT AT THE CLOSURE.
 3. CONSTRUCT OUTBOARD PORTION OF THE DECK SLAB OF BR. NO. 405/72W EXCEPT AT THE CLOSURE.
 4. ALLOW 30 CALENDAR DAYS PRIOR TO SUBSTRUCTURE AND DECK SLAB CLOSURE.
 5. PLACE SUBSTRUCTURE AND DECK SLAB CLOSURES.
 6. PLACE TRAFFIC BARRIER.
- PHASE 3:
1. PLACE MEMBRANE WATERPROOFING (DECK SEAL FOR FULL WIDTH OF BRIDGES (CURB TO CURB))
 2. PLACE ACP OVERLAY (##) FOR FULL WIDTH OF BRIDGE (CURB TO CURB). EXISTING PIVOT POINT WILL BE SHIFTED TO NEW LOCATION DURING THE PLACEMENT OF THE OVERLAY - SEE PAVING PLAN SHEETS.

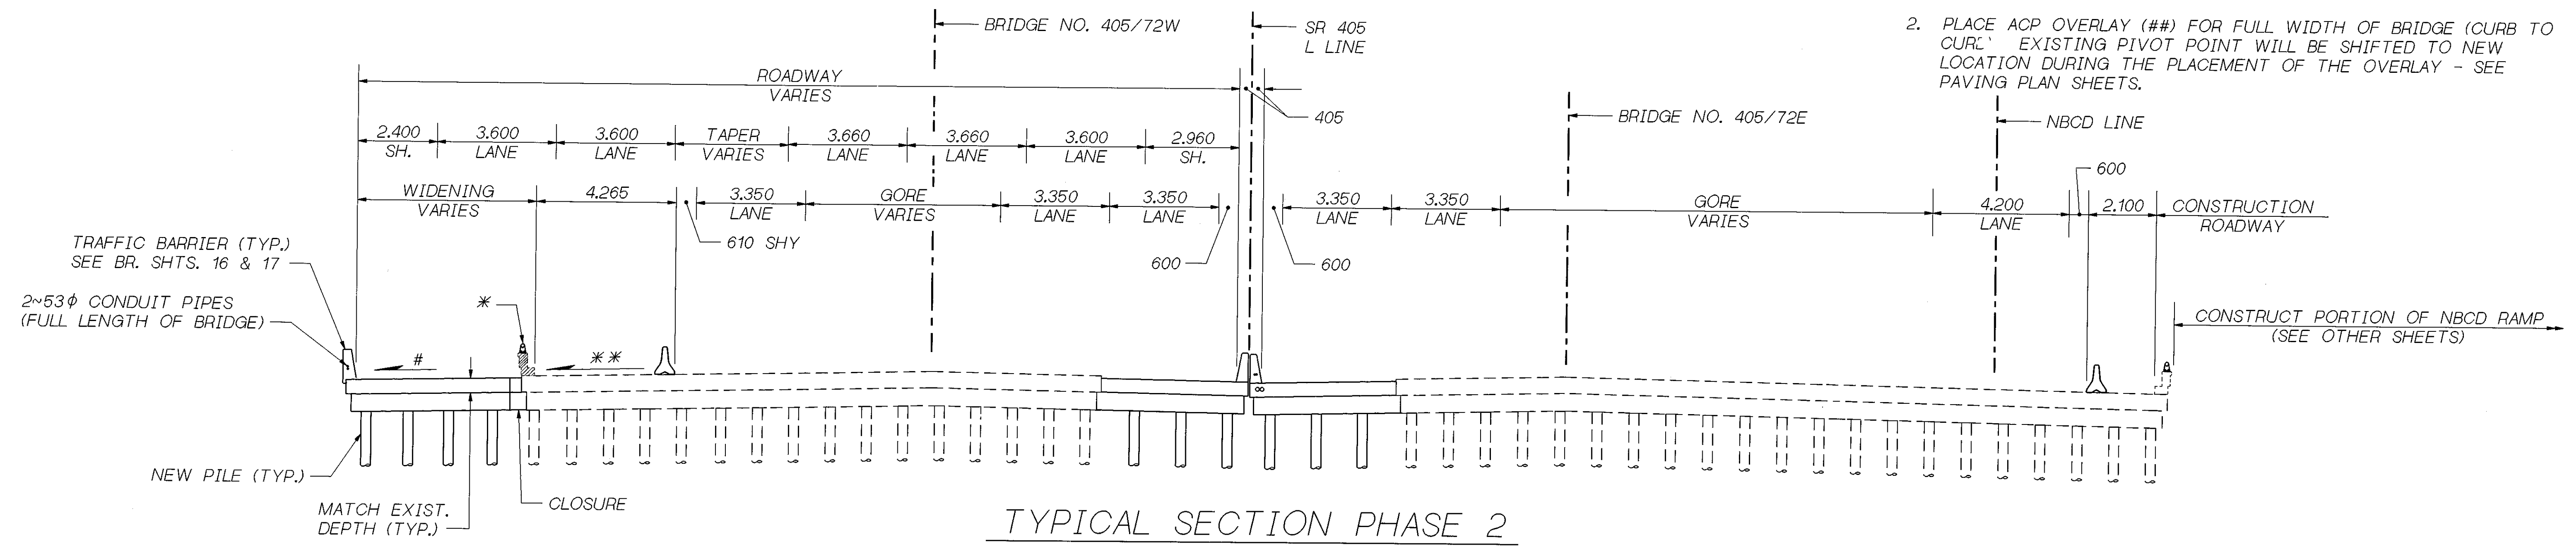

TYPICAL SECTION PHASE 2
SHOWN NEAR AN INTERMEDIATE PIER
DIMENSIONS SHOWN ARE PERPENDICULAR TO C L LINE.

SR 405 JOB NO. 7071 SHEET 2

Bridge Design Engr. C. C. RUTH	4/96	S405D72R00T.L000000.FGB1 STAGING.FGB:1	REGION NO.	STATE	FED. AID PROJ. NO.	SHEET NO.	TOTAL SHEETS
Supervisor R.T. SHAEFER / W. WILSON			10	WASH.			
Designed By C. CORNELL	6/96						
Checked By	6/96						
Detailed By D.W. PULSE JR.	6/96						
Bridge Projects Engr. K. N. KIRKER	3/96						
Prelim. Plan By A. CHU	3/96						
Architect/Specialist A. YOUNG	3/96						
DATE	REVISION	BY	APP'D	5054			

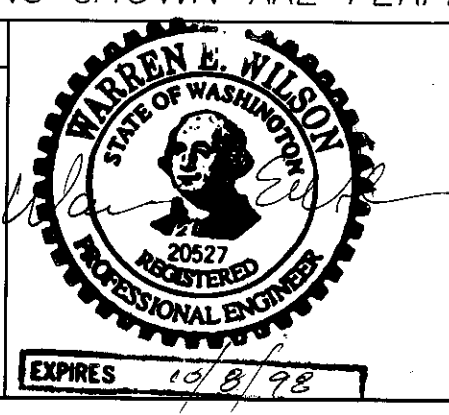

SR 405
BOTHELL TO SWAMP CREEK 1/C
HOV LANES - STAGE 1
NORTH CREEK BRIDGE 405/72 E-W
CONSTRUCTION STAGING

BRIDGE SHEET NO. 2
SHEET 462 OF 663 SHEETS

24114

BRIDGE 405/72W
SHOULDER WIDENING

L-LINE STATION	EXIST. OFFSET	EXIST. ELEV. AT CURB LINE	PROPOSED OFFSET	PROPOSED ELEV. AT CURB LINE
39+099.322	-	-	27.864 LT.	9.684
39+105.405	21.482 LT.	9.823	27.984 LT.	9.693
39+109.991	21.672 LT.	9.828	28.075 LT.	9.700
39+114.970	21.870 LT.	9.828	28.173 LT.	9.702
39+119.979	22.064 LT.	9.816	28.272 LT.	9.698
39+124.962	22.262 LT.	9.815	28.371 LT.	9.696
39+129.968	22.455 LT.	9.814	28.470 LT.	9.694
39+133.438	-	-	28.538 LT.	9.691
39+134.973	22.670 LT.	9.809	-	-
39+138.851	22.820 LT.	9.807	-	-

BRIDGE 405/72W
MEDIAN WIDENING

L-LINE STATION	EXIST. OFFSET	EXIST. ELEV. AT CURB LINE	PROPOSED OFFSET	PROPOSED ELEV. AT CURB LINE
39+121.271	4.856 LT.	9.969	-	-
39+125.026	4.862 LT.	9.972	-	-
39+125.864	-	-	0.025 LT.	9.877
39+130.017	4.853 LT.	9.983	0.025 LT.	9.880
39+135.005	4.855 LT.	9.977	0.025 LT.	9.885
39+139.992	4.838 LT.	9.991	0.025 LT.	9.895
39+145.009	4.827 LT.	10.002	0.025 LT.	9.906
39+150.001	4.827 LT.	10.006	0.025 LT.	9.910
39+155.007	4.813 LT.	10.024	0.025 LT.	9.928
39+155.996	4.818 LT.	10.021	-	-
39+160.576	-	-	0.025 LT.	9.911


BRIDGE 405/72E
MEDIAN WIDENING

L-LINE STATION	EXIST. OFFSET	EXIST. ELEV. AT CURB LINE	PROPOSED OFFSET	PROPOSED ELEV. AT CURB LINE
39+125.431	-	-	0.025 RT.	9.887
39+130.083	4.927 RT.	9.980	0.025 RT.	9.882
39+135.008	4.949 RT.	9.983	0.025 RT.	9.885
39+140.007	4.945 RT.	9.997	0.025 RT.	9.899
39+145.029	4.949 RT.	9.996	0.025 RT.	9.898
39+150.008	4.956 RT.	9.996	0.025 RT.	9.897
39+155.018	4.929 RT.	10.003	0.025 RT.	9.905
39+160.026	4.937 RT.	10.010	0.025 RT.	9.912
39+160.099	-	-	0.025 RT.	9.912
39+164.792	4.946 RT.	10.007	-	-


NOTE: ELEVATIONS ARE AT TOP OF CONCRETE DECK.

GENERAL NOTES

- ALL MATERIAL AND WORKMANSHIP SHALL BE IN ACCORDANCE WITH THE REQUIREMENTS OF THE STATE OF WASHINGTON, DEPARTMENT OF TRANSPORTATION, STANDARD SPECIFICATIONS FOR ROAD, BRIDGE, AND MUNICIPAL CONSTRUCTION METRIC DATED 1996 AND AMENDMENTS.
- THE WIDENED PORTION OF THIS STRUCTURE HAS BEEN DESIGNED IN ACCORDANCE WITH THE REQUIREMENTS OF THE AASHTO STANDARD SPECIFICATIONS FOR HIGHWAY BRIDGES FIFTEENTH EDITION - 1992 AND INTERIM SPECIFICATIONS THROUGH 1995. ALL NEW STRUCTURAL ELEMENTS HAVE BEEN DESIGNED IN ACCORDANCE WITH LOAD FACTOR DESIGN. SEISMIC DESIGN OF THIS STRUCTURE HAS BEEN PERFORMED USING AN ACCELERATION COEFFICIENT OF 0.25 AND A TYPE III SOIL PROFILE RESPONSE SPECTRUM.
- SUBSTRUCTURE DETAILS ARE SUBJECT TO CHANGE DEPENDING UPON FOUNDATION MATERIAL ENCOUNTERED. REINFORCING STEEL FOR PILES SHALL NOT BE CUT UNTIL FINAL ELEVATIONS HAVE BEEN DETERMINED AND SUBSTRUCTURE DETAILS HAVE BEEN MODIFIED, IF NECESSARY.
- CONCRETE IN THE PILES SHALL BE CLASS 28P. CONCRETE IN THE ROADWAY SLAB SHALL BE CLASS 28D. ALL OTHER CONCRETE, EXCEPT WHERE SPECIFICALLY SHOWN OTHERWISE ON THE PLANS, SHALL BE CLASS 28.
- THE ULTIMATE DESIGN LOAD FOR THE PILES FOR PIERS 1 & 4 IS 1320 KN. THE ULTIMATE DESIGN LOAD FOR PIERS 2 & 3 IS 1590 KN. A DOWNDRAG FORCE OF 230 KN WAS INCLUDED IN THE ULTIMATE DESIGN LOAD. A FACTOR OF SAFETY OF 2.5 WAS USED IN THE DETERMINATION OF THE ULTIMATE DESIGN LOAD.
- FALSEWORK SHALL BE CAREFULLY RELEASED TO PREVENT IMPACT OR UNDUE STRESS IN THE STRUCTURE. THE TRAFFIC BARRIER CONCRETE SHALL NOT BE PLACED UNTIL THE FALSEWORK HAS BEEN RELEASED.
- ALL EXISTING DIMENSIONS AND ELEVATIONS SHALL BE MEASURED IN THE FIELD BY THE CONTRACTOR PRIOR TO ORDERING OR FABRICATING ANY MATERIAL (SEE SPECIAL PROVISIONS).
- UNLESS OTHERWISE SHOWN ON THE PLANS, CLEAR CONCRETE COVER FROM THE TOP OF THE ROADWAY SLAB TO ANY REINFORCEMENT SHALL BE 50, 25 FROM THE BOTTOM OF THE ROADWAY SLAB, 75 FROM THE BOTTOM OF THE PILES, 190 FROM THE BOTTOM OF FOOTINGS WITH PILES, AND 40 FROM ALL OTHER CONCRETE SURFACES.

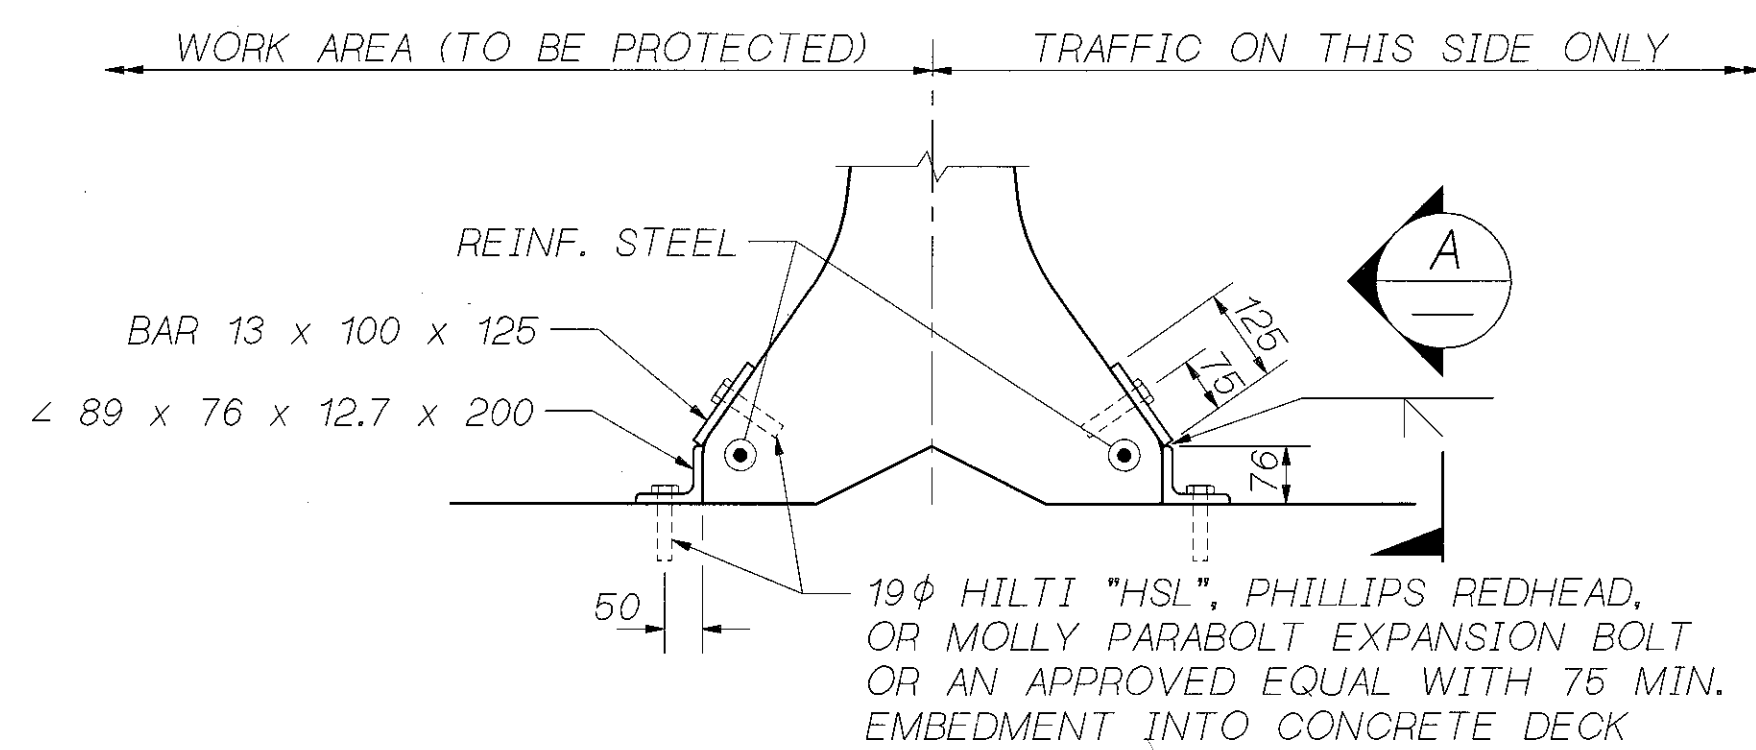

ANCHOR ASSEMBLY DETAIL

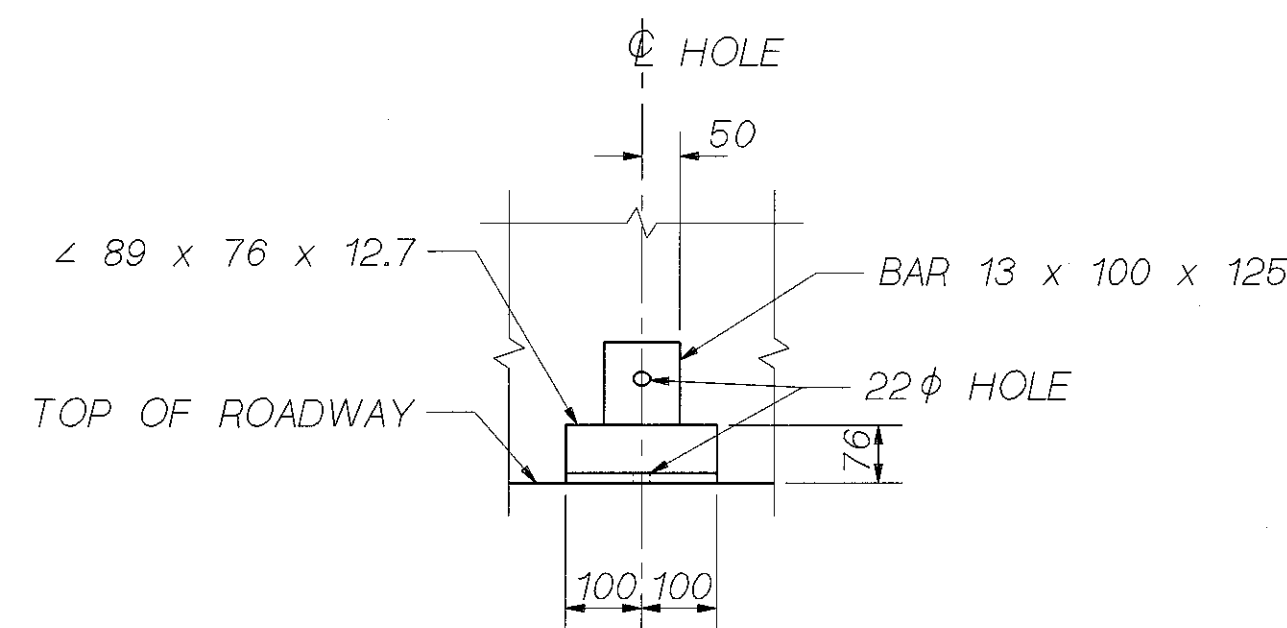


SECTION A

METRIC LEGEND

126.175 DENOTES METERS
175 DENOTES MILLIMETERS

SR 405 JOB NO. 7071 SHEET 3

Bridge Design Engr. C. C. RUTH	4/96	S405D72R001 (FGB) GEO. FGB: 1	REGION NO.	STATE	FED. AID PROJ. NO.	SHEET NO.	TOTAL SHEETS
Supervisor R.T. SHAEFER / W. WILSON			10	WASH.			
Designed By C. CORNELL							
Checked By							
Detailed By G. A. T. WALDRON	3/96						
Bridge Projects Engr. K. N. KIRKER	3/96						
Prelim. Plan By A. CHU	3/96	7/97					
Architect/Specialist A. YOUNG	3/96	DATE					
		REVISION	BY	APP'D	5054		

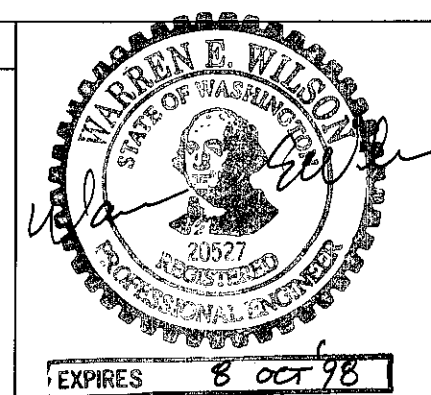


SR 405
BOTHELL TO SWAMP CREEK 1/C
HOV LANES - STAGE 1
NORTH CREEK BRIDGE 405/72 E-W

GEOMETRY & GENERAL NOTES

BRIDGE SHEET NO. 3
SHEET 463 OF 663 SHEETS

PLOTTED: Sat Jul 12 1997 5:08pm FILENAME: X:\A96077\BR72\NEW\REV1\4R1.DWG SCALE: 100


SR 405 JOB NO. 7071 SHEET 4 OF 19

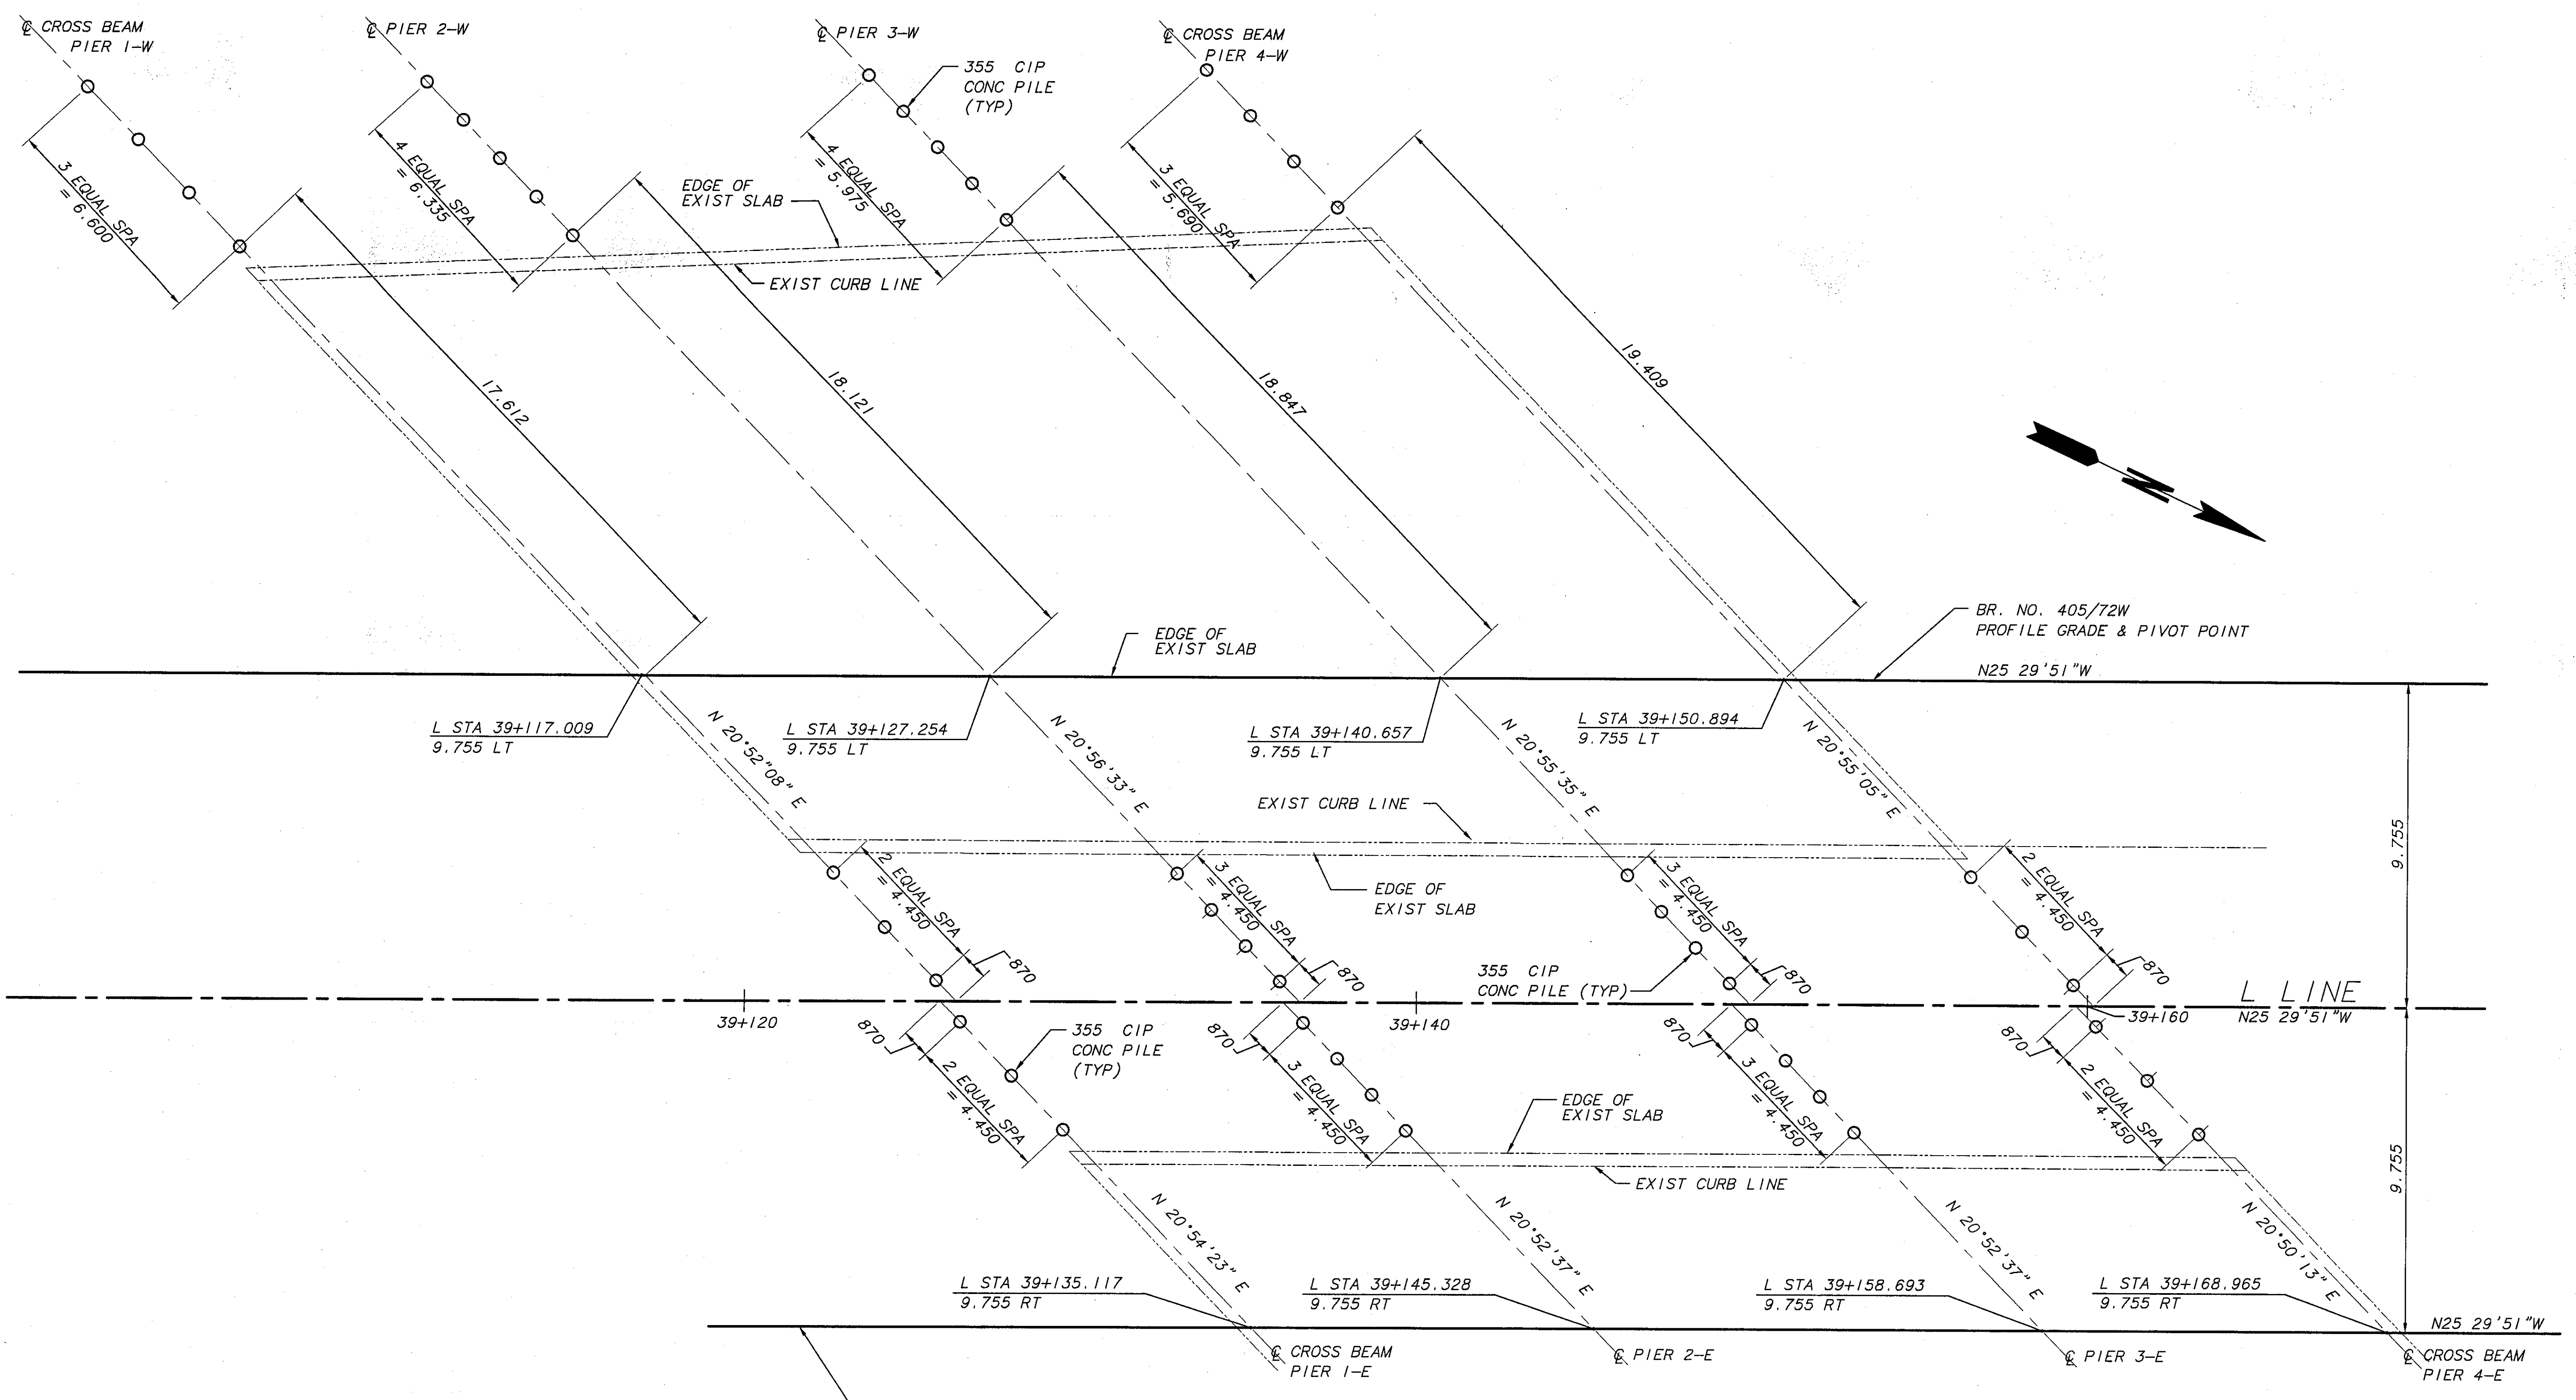

FOUNDATION LAYOUT
 REDRAWN

BRIDGE DESIGN ENGR									
SUPERVISOR									
DESIGNED BY	J. CHEN	6/96							
CHECKED BY	C. CORNELL	6/96							
DETAILED BY	T. BRENNAN	6/96							
BRIDGE PROJECTS ENGR									
PRELIM PLAN BY	7/97	CONTRACTORS SURVEY DATA- FIT EXISTING	NEW						
ARCHITECT/SPECIALIST	DATE	REVISION	BY	APPR					

REGION NO.	STATE	FED AID PROJ NO.	SHEET NO.	TOTAL SHEETS
10	WASH			
JOB NUMBER	96W035			
CONTRACT NO.	5054			


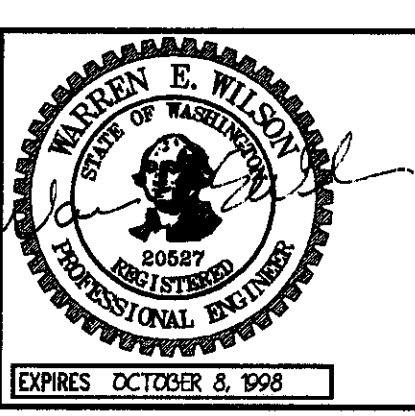


BERGER/ABAM
 ENGINEERS INC.
 33301 8TH AVENUE SOUTH
 FEDERAL WAY, WASHINGTON 98003-8385
 (206)431-6300 FAX: (206)431-2250




SR 405
 BOTHELL TO SWAMP CREEK I/C
 HOV LANES - STAGE 1
 NORTH CREEK BRIDGE 405/72 E-W
 FOUNDATION LAYOUT (MEDIAN & OUTBOARD WIDENING)

BRIDGE SHEET NO. 4
 SHEET 464 OF 663 SHEETS

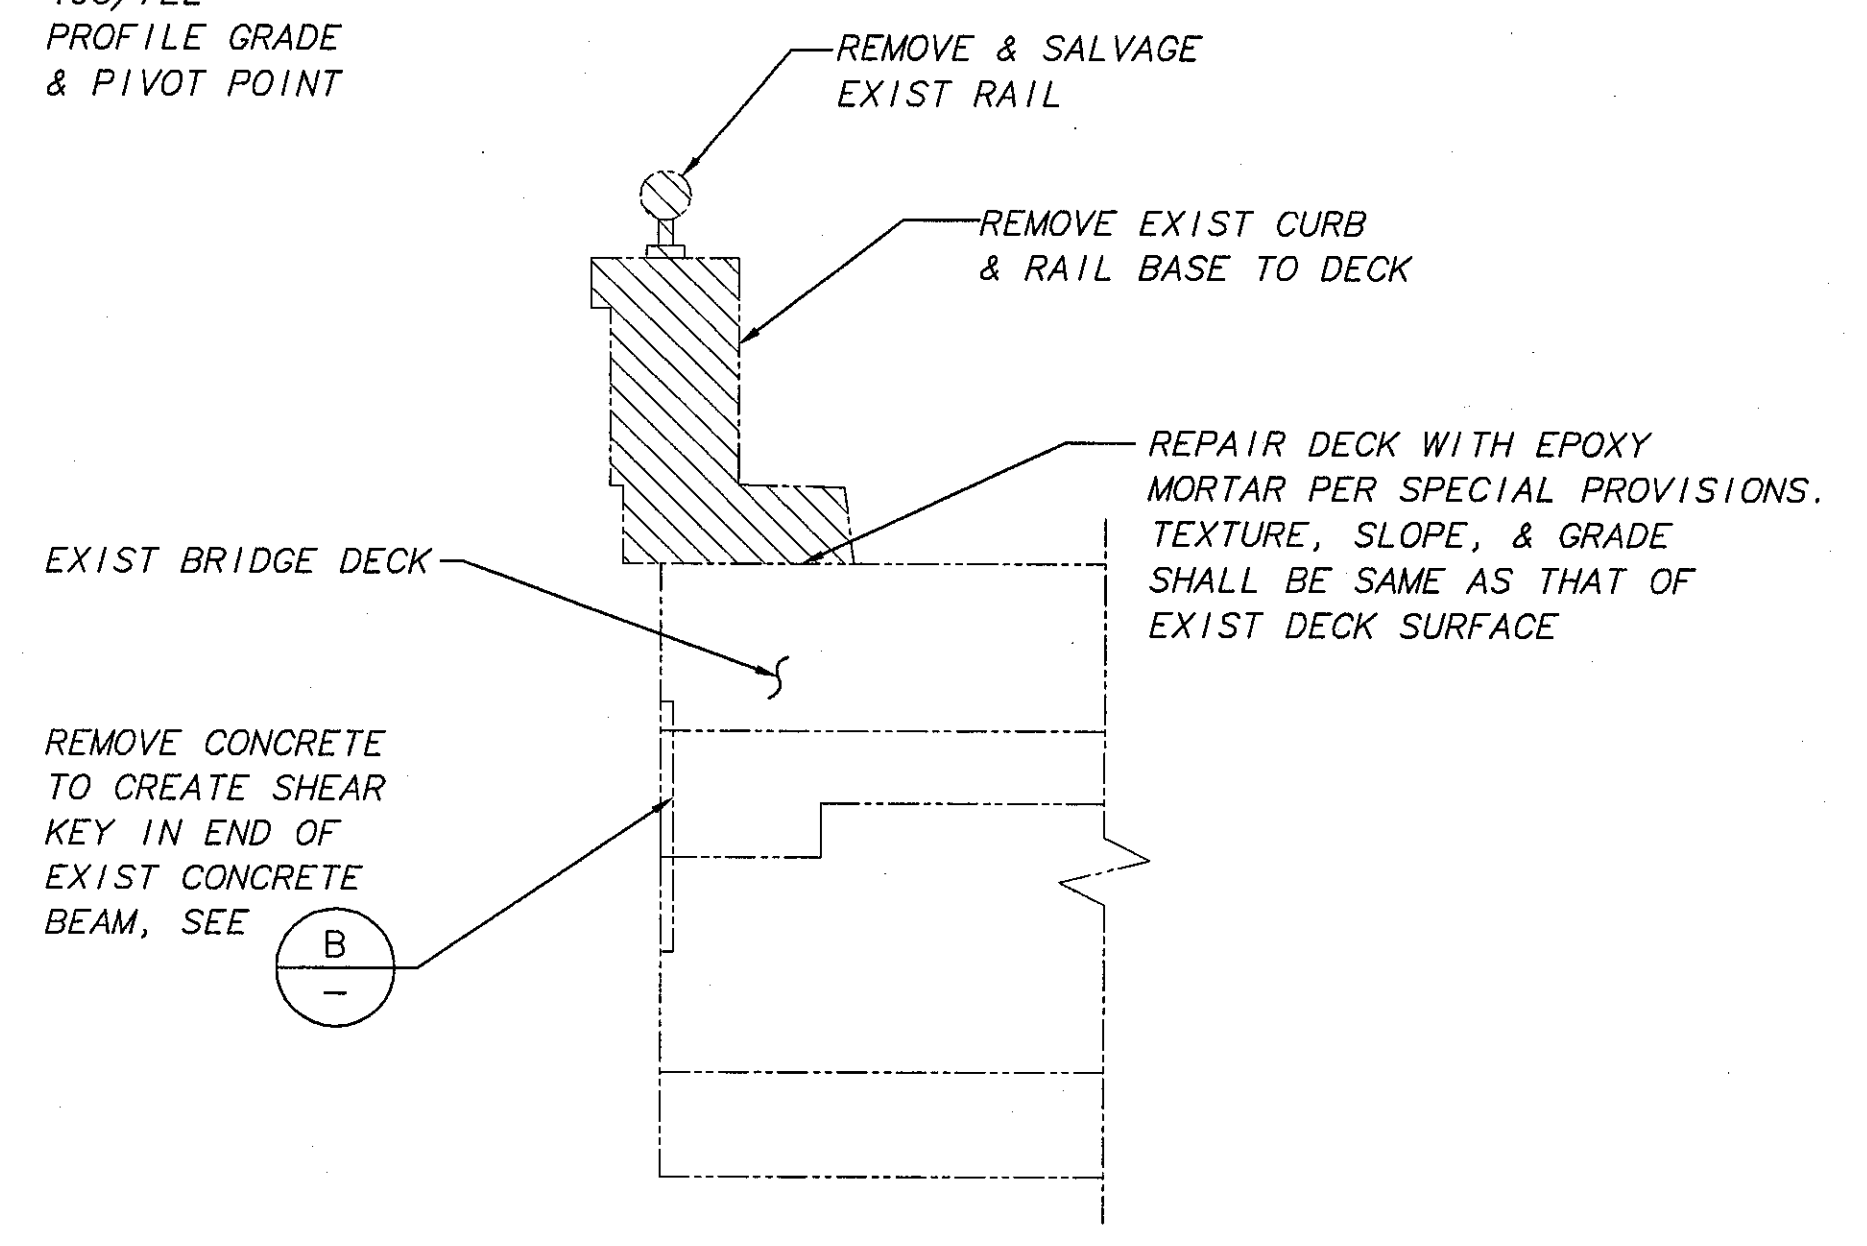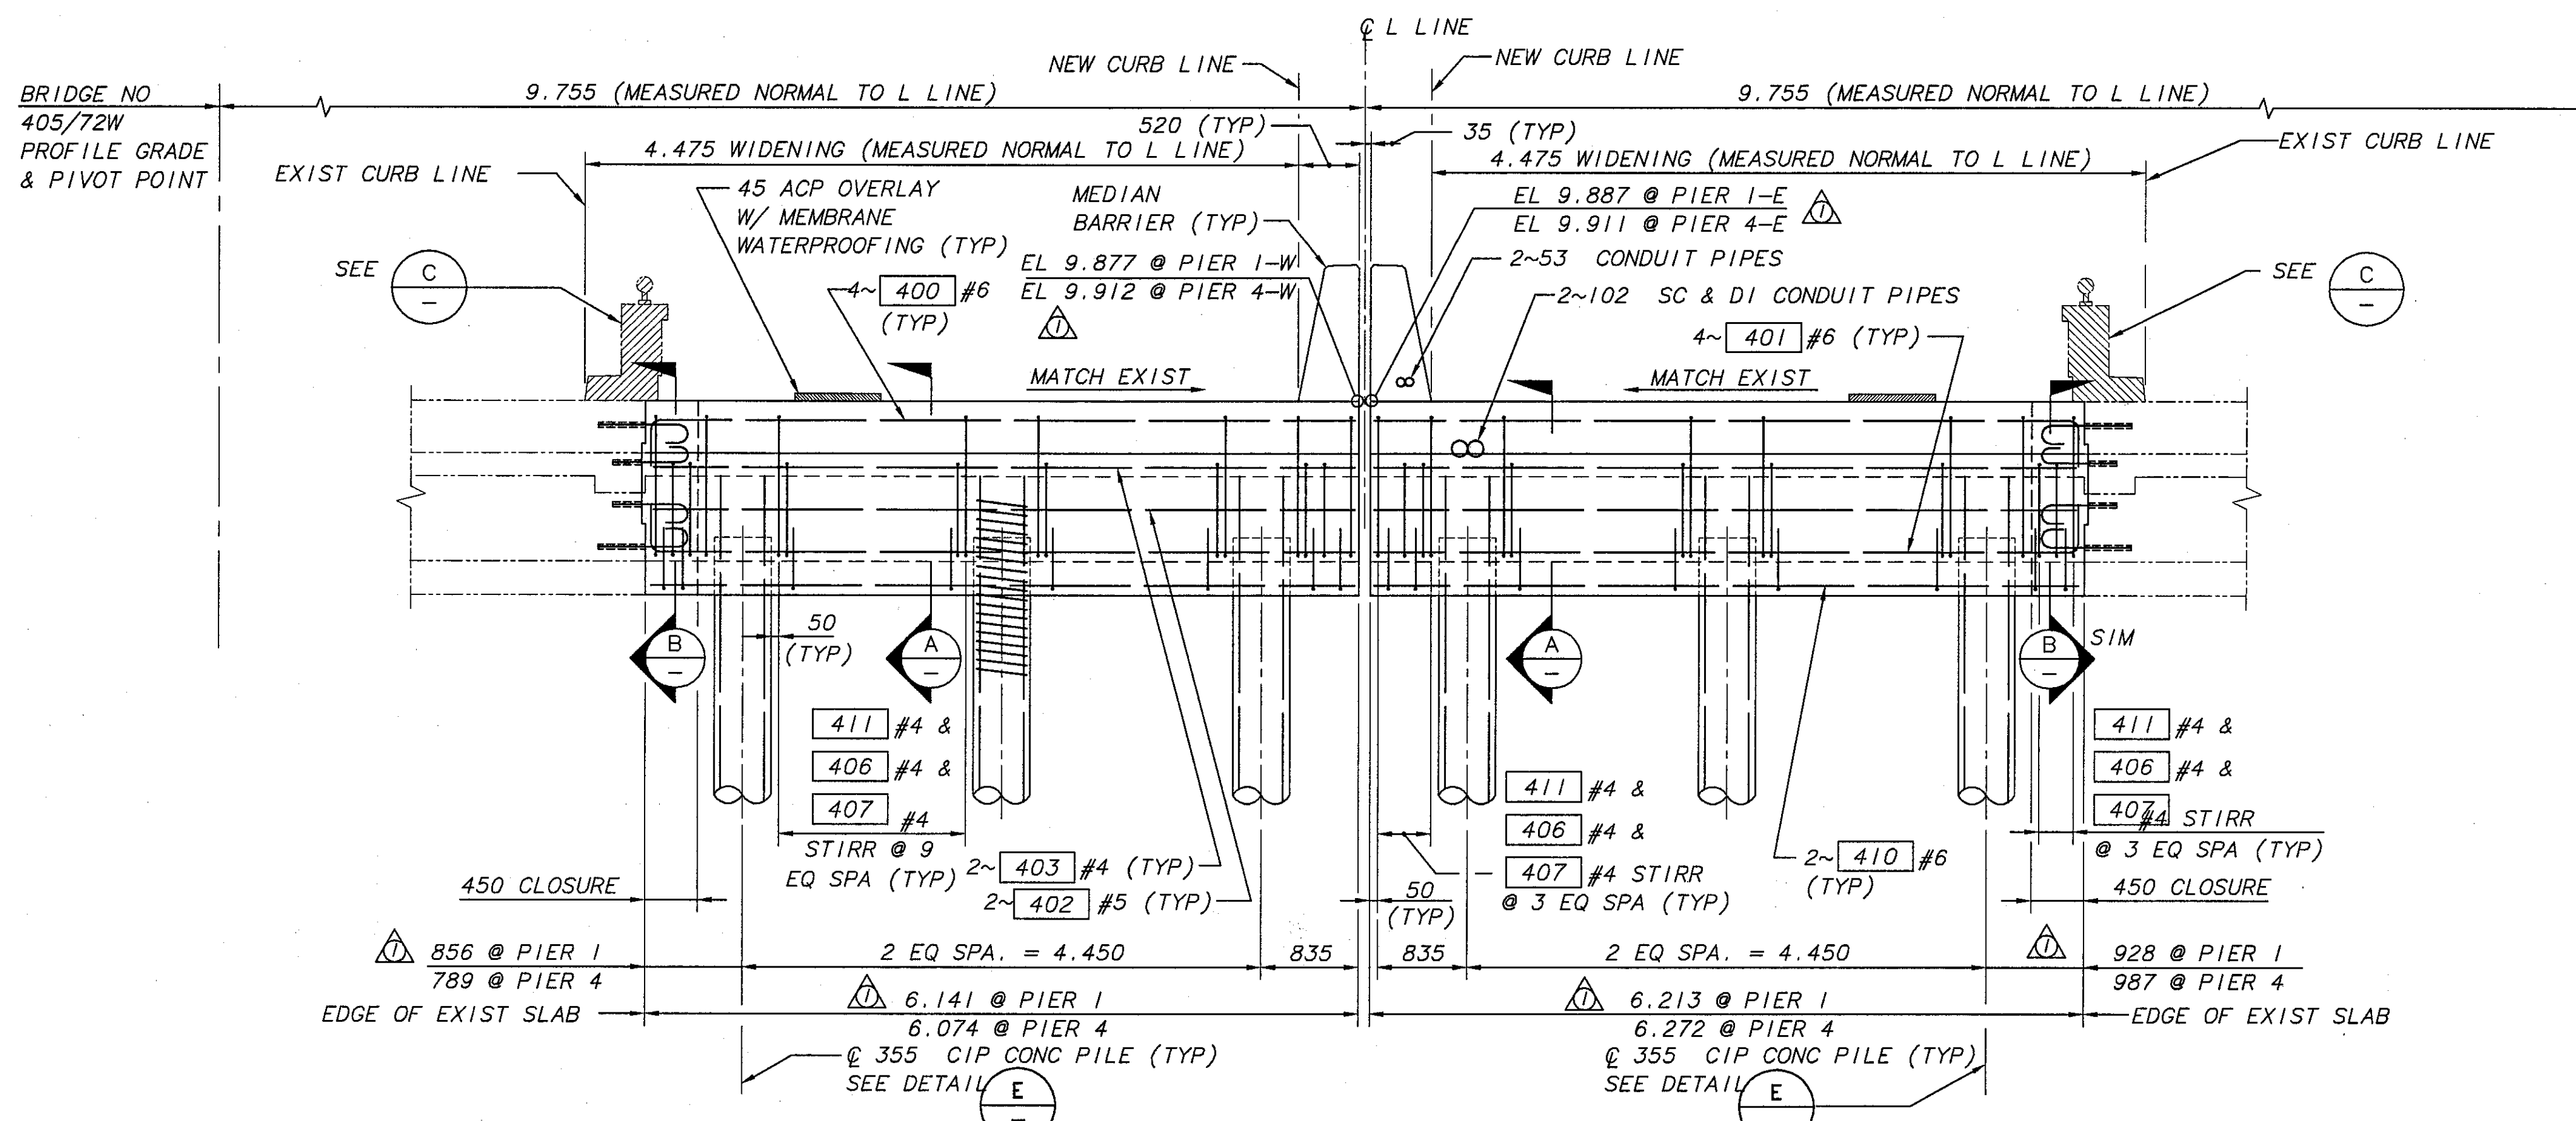

ELEVATION - PIER 1 & 4 (MEDIAN WIDENING)
 (LOOKING AHEAD ON STATION - PIER 1)
 (LOOKING BACK ON STATION - PIER 4)
 (ALL DIMENSIONS ARE MEASURED ALONG THE ϕ CROSS BEAM UNLESS NOTED OTHERWISE)


DETAIL - EXIST CURB & RAIL REMOVAL C
 -6,7,8 & 9

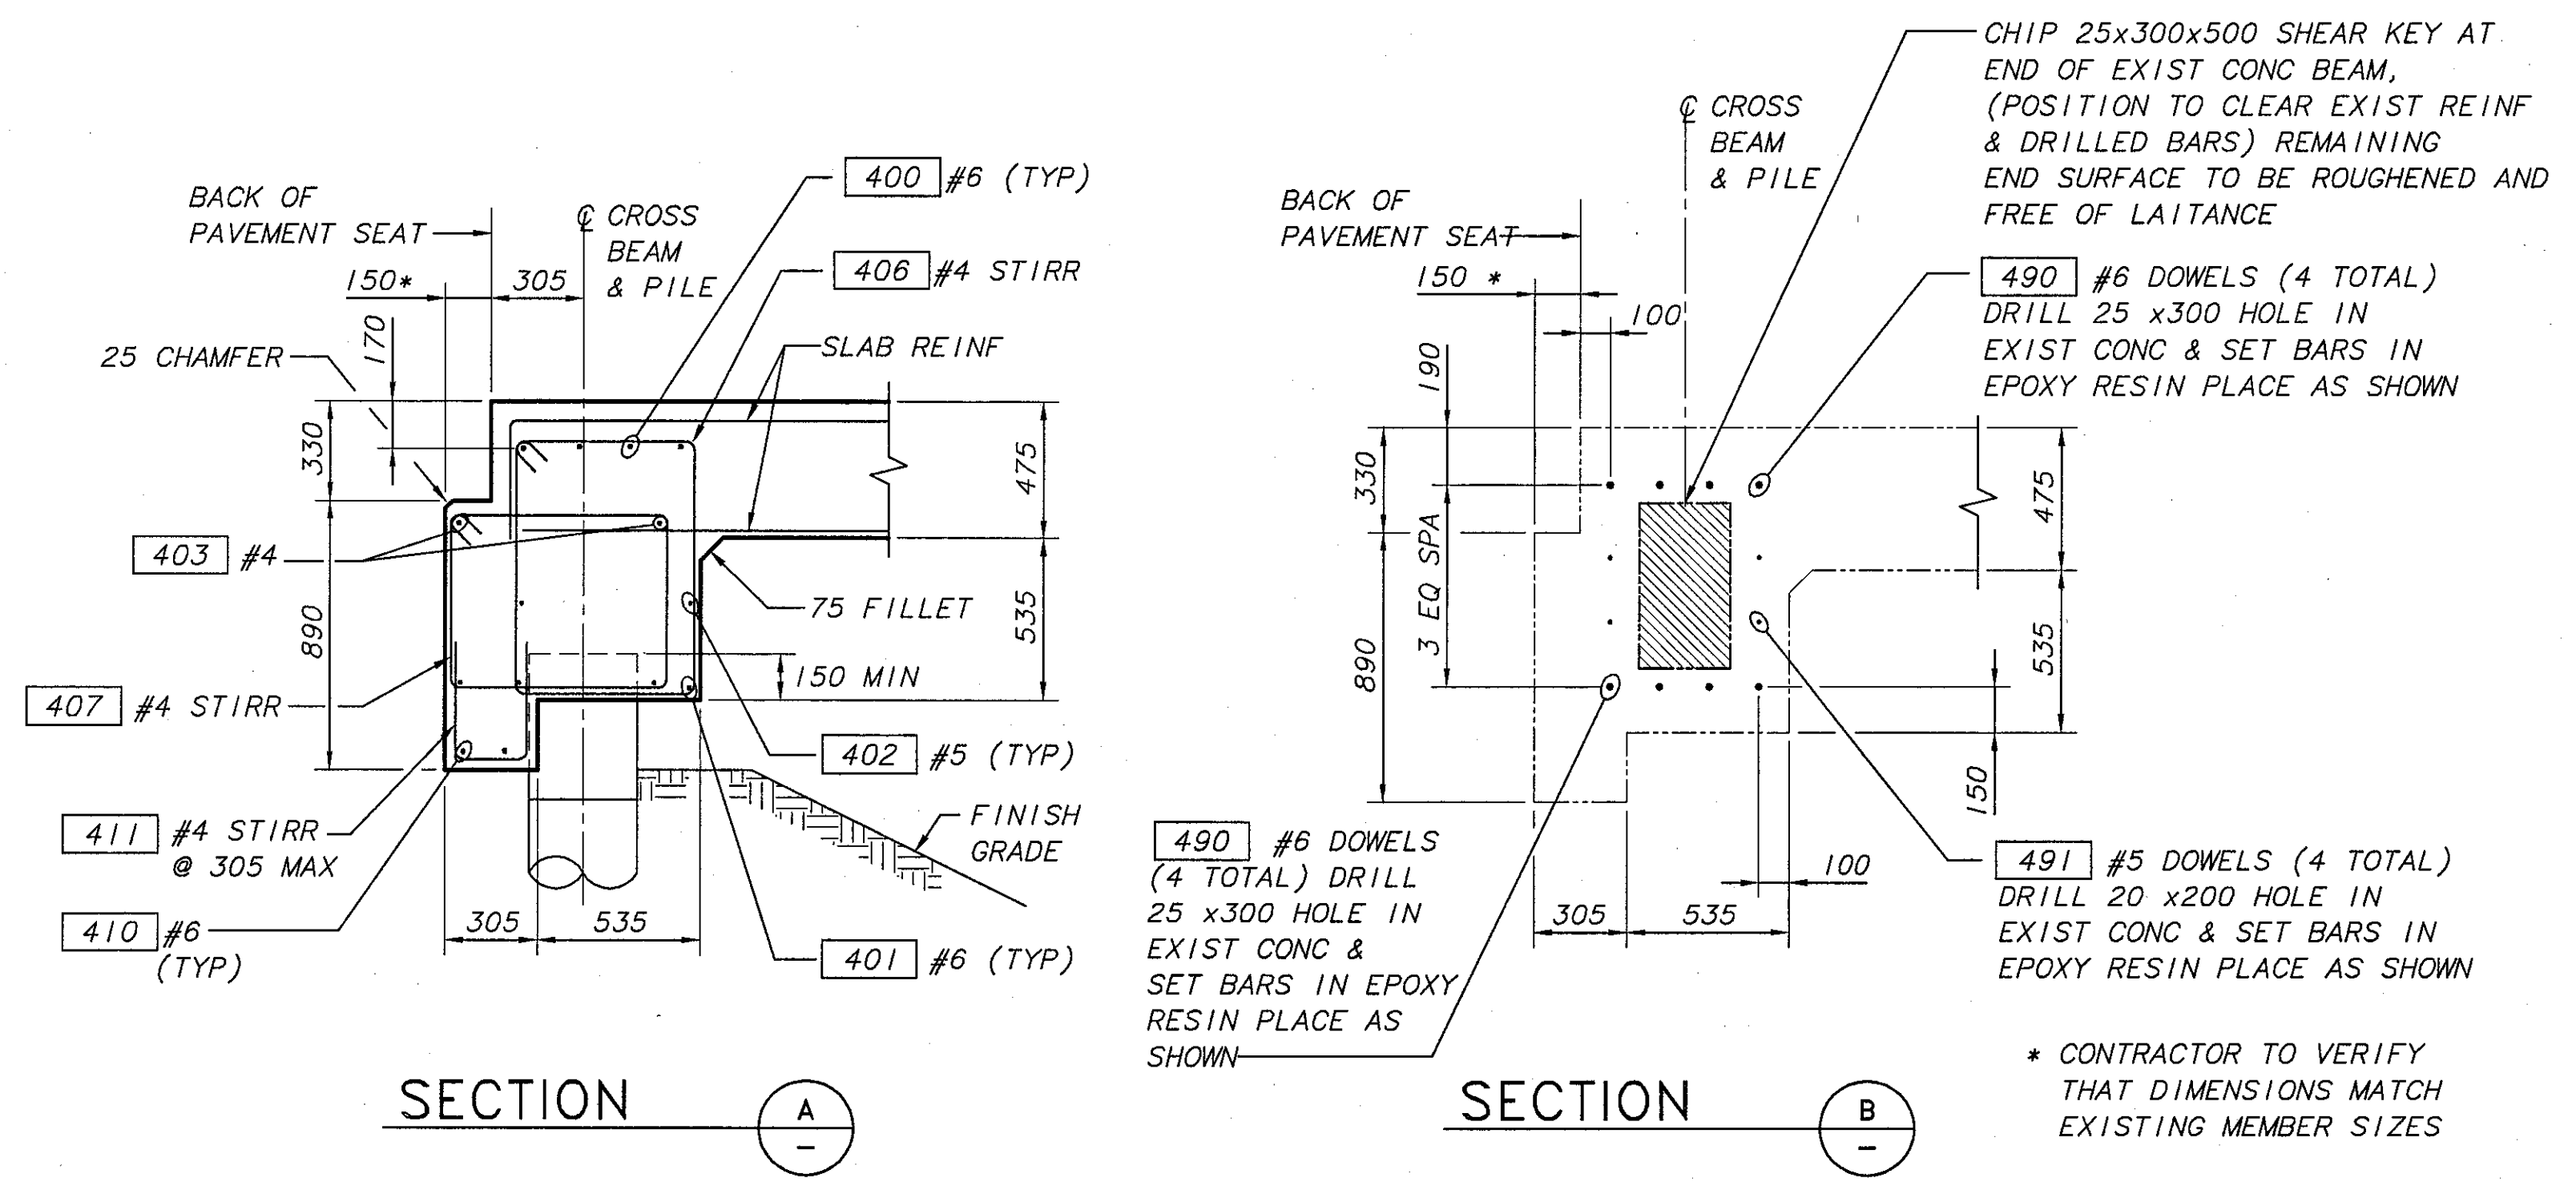

SR 405 JOB NO. 7071 SHEET 5 OF 19

FILENAME: X:\96077\BR72\LEW\REV1\5R1.DWG SCALE: 30

BRIDGE DESIGN ENGR		REGION	STATE	FED AID PROJ NO	SHEET	TOTAL SHEETS
SUPERVISOR		10	WASH			
DESIGNED BY	J. CHEN 6/96	JOB NUMBER		96W035		
CHECKED BY	C. CORNELL 6/96	CONTRACT NO.		5054		
DATE	7/97	CONTRACTOR SURVEY DATA - FIT EXISTING	NEW			
ARCHITECT/SPECIALIST		DATE	REVISION	BY	APPR	

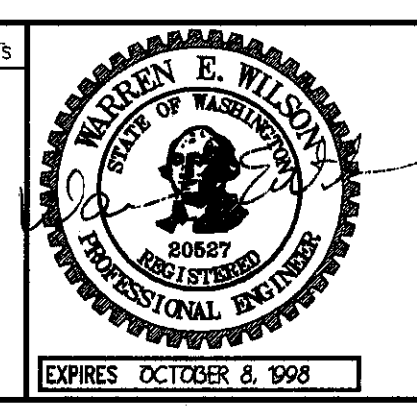


BERGER/ABAM
 ENGINEERS INC.
 33301 9TH AVENUE SOUTH
 FEDERAL WAY, WASHINGTON 98003-8385
 (206)431-2300 FAX: (206)431-2250




SR 405
 BOTHELL TO SWAMP CREEK I/C
 HOV LANES - STAGE 1
 NORTH CREEK BRIDGE 405/72 E-W
 PIER 1 & 4 (MEDIAN WIDENING)

BRIDGE SHEET NO. **5**
 SHEET 465 OF 663 SHEETS

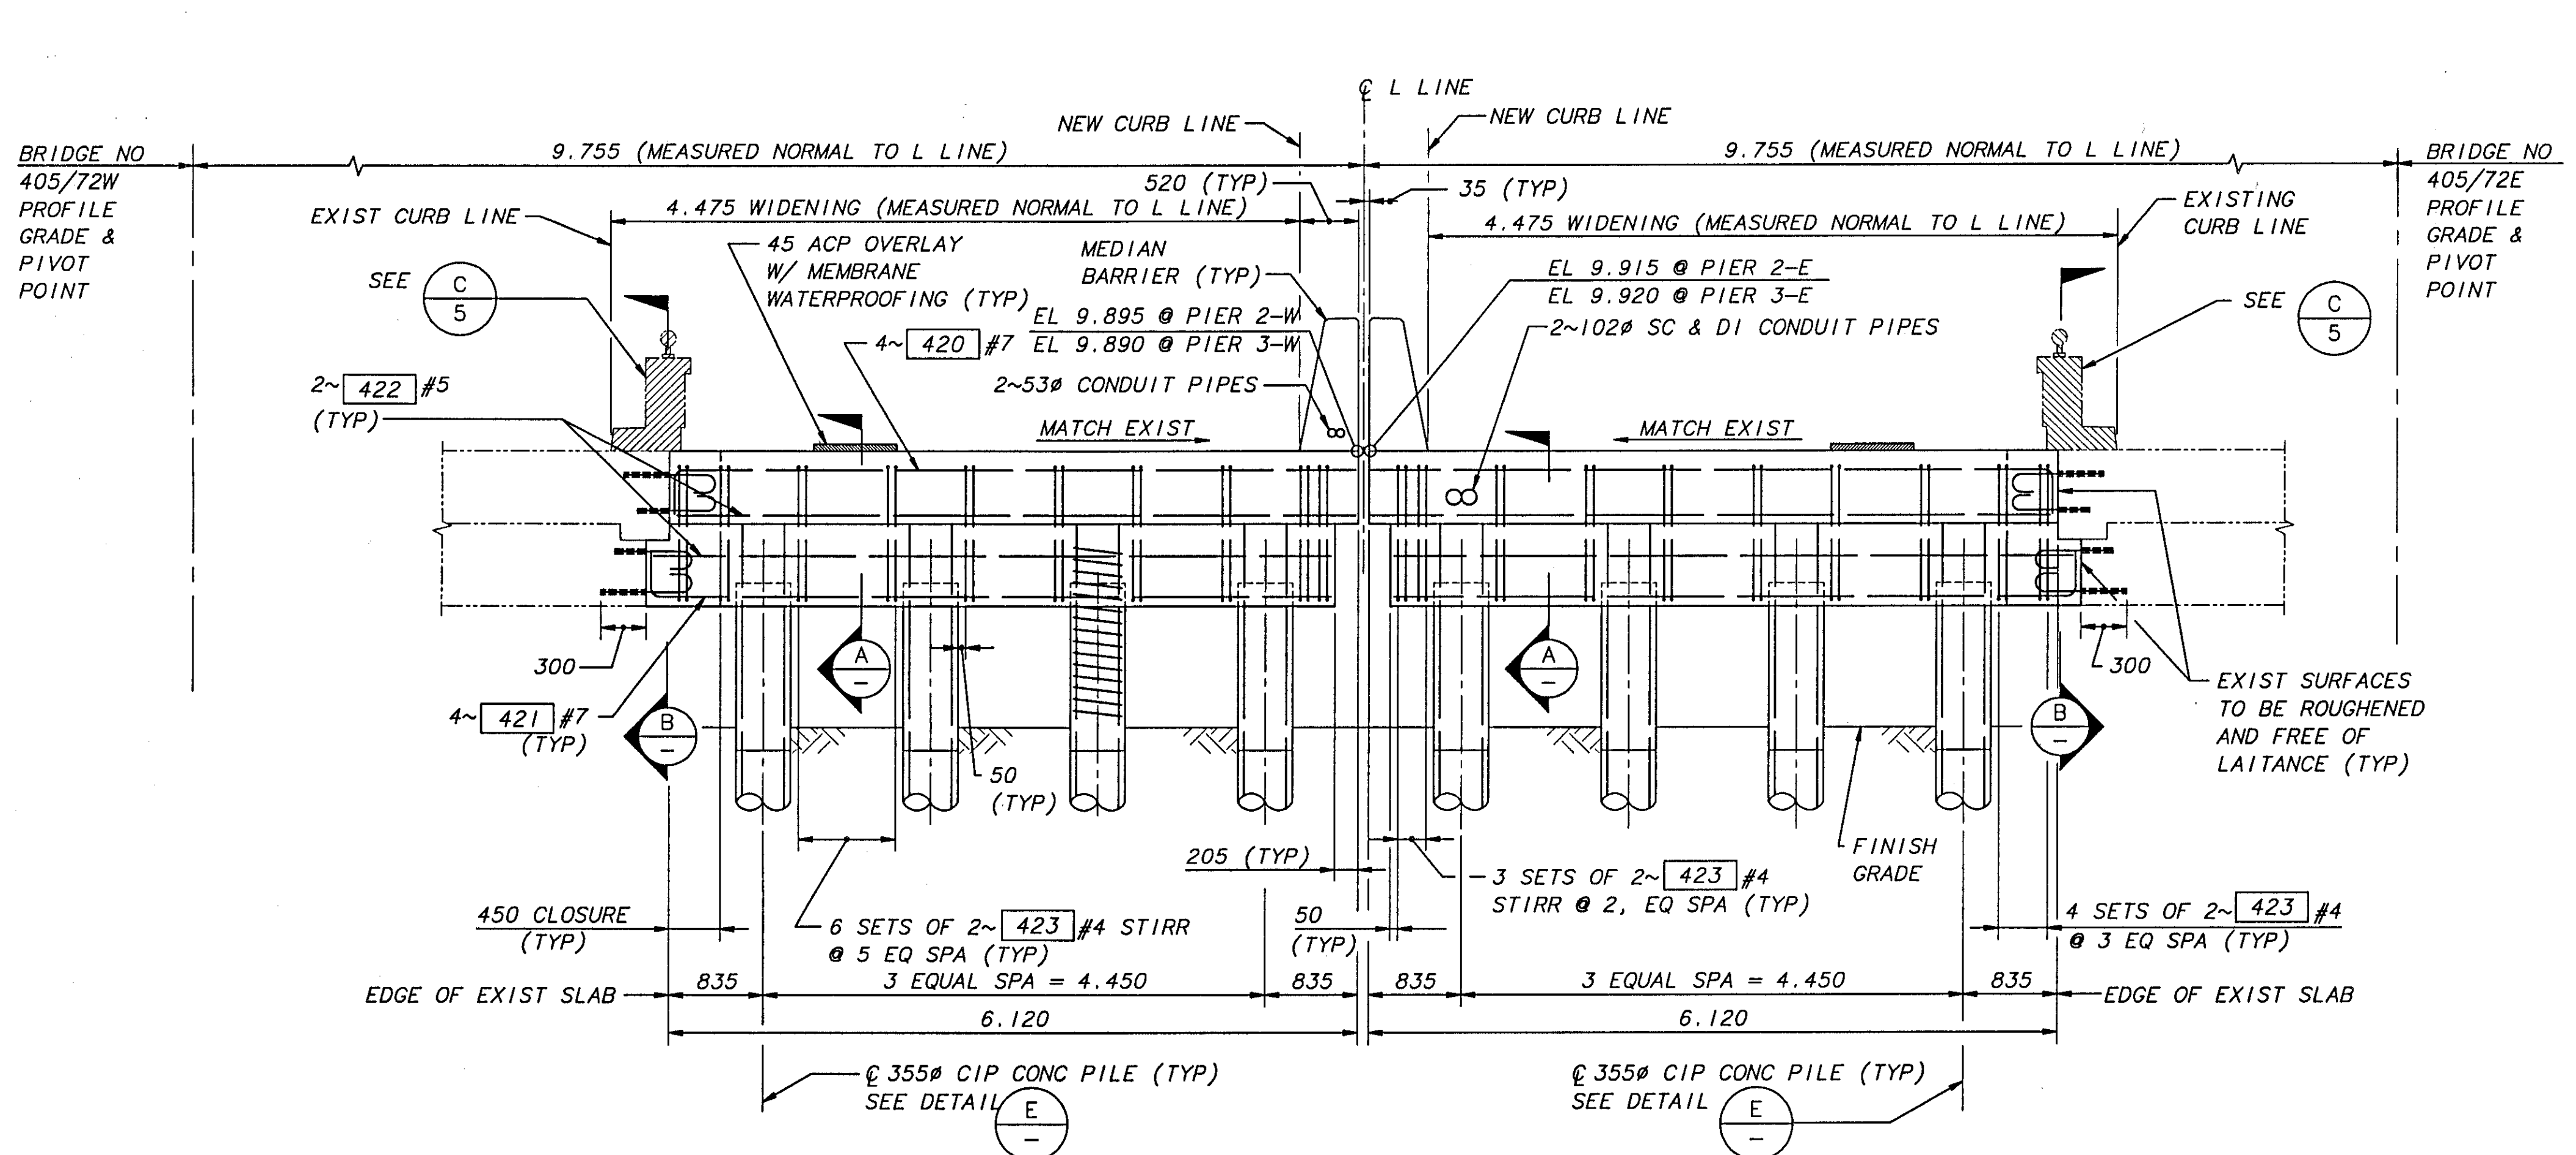






ELEVATION - PIER 2 & 3 (MEDIAN WIDENING)
 (LOOKING AHEAD ON STATION)
 (ALL DIMENSIONS ARE MEASURED ALONG Q CROSS BEAM UNLESS NOTED OTHERWISE)

SPIRAL ALTERNATIVES			
DEFORMED BARS	PLAIN SMOOTH BARS	COLD DRAWN WIRE	DEFORMED WIRE
#4	13#	W20	D20

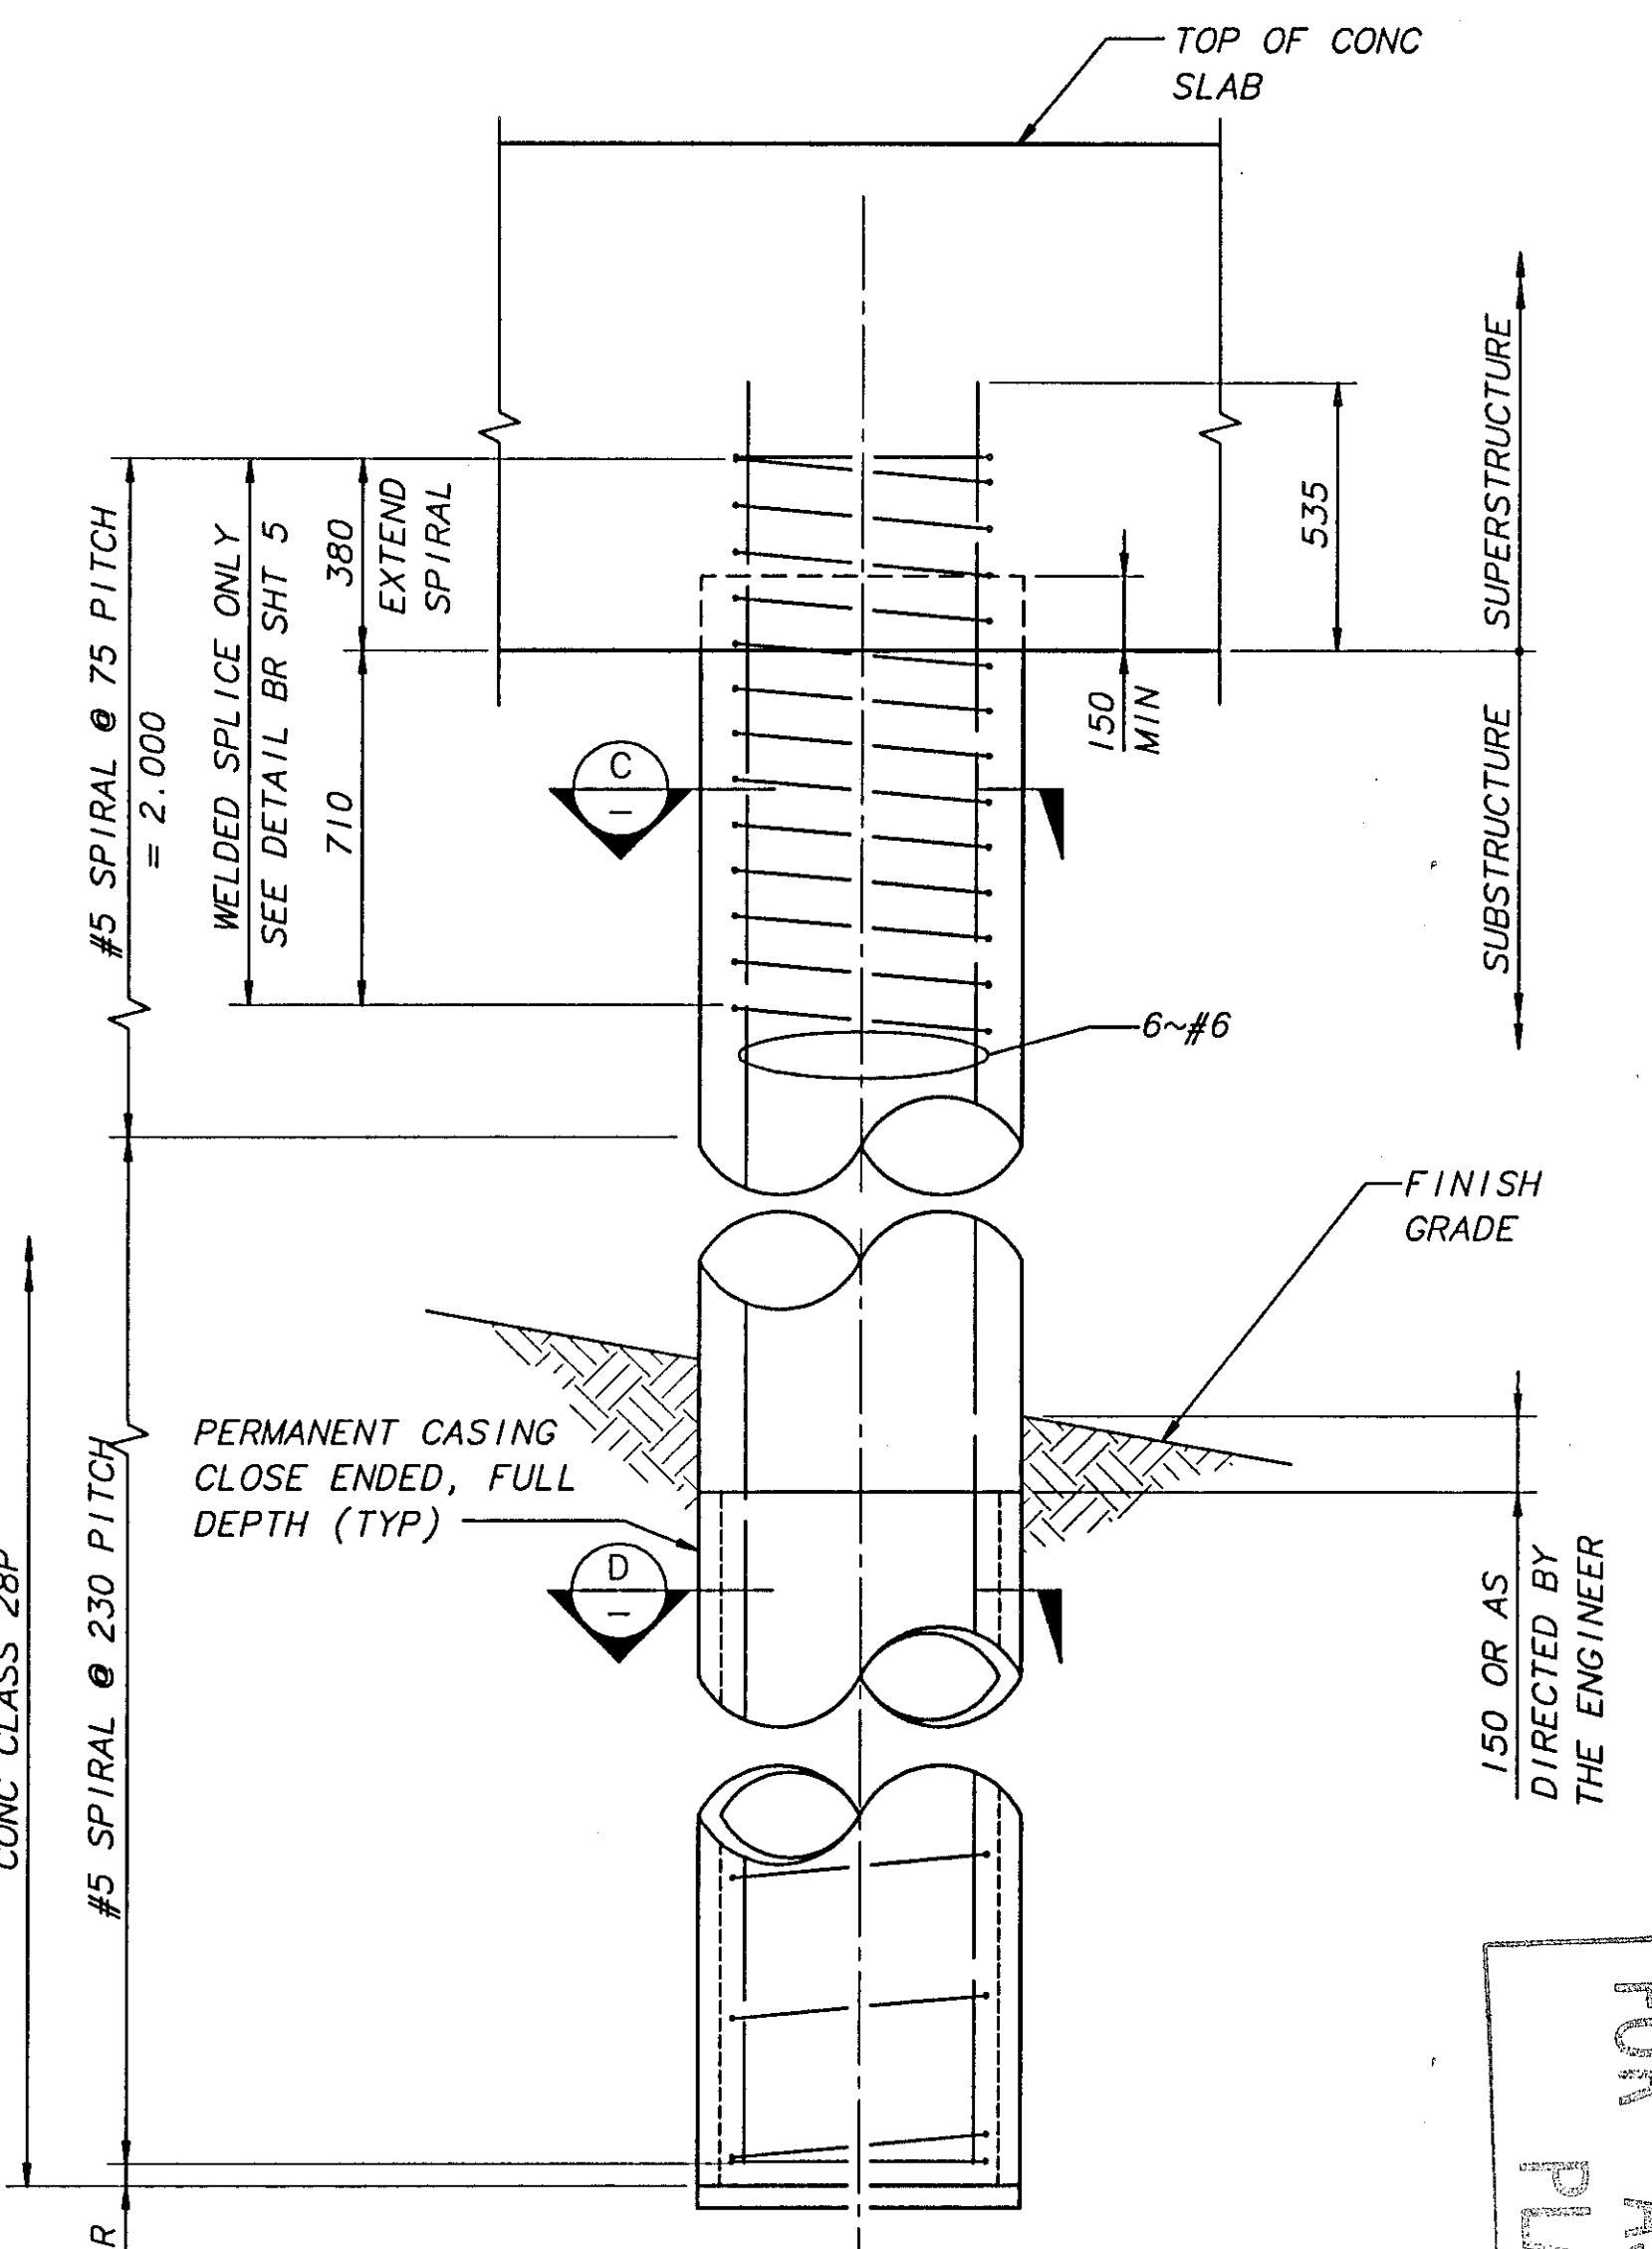

DETAIL - CIP CONC PILE E-8

FOR "AS CONSTRUCTED PLANS" ONLY

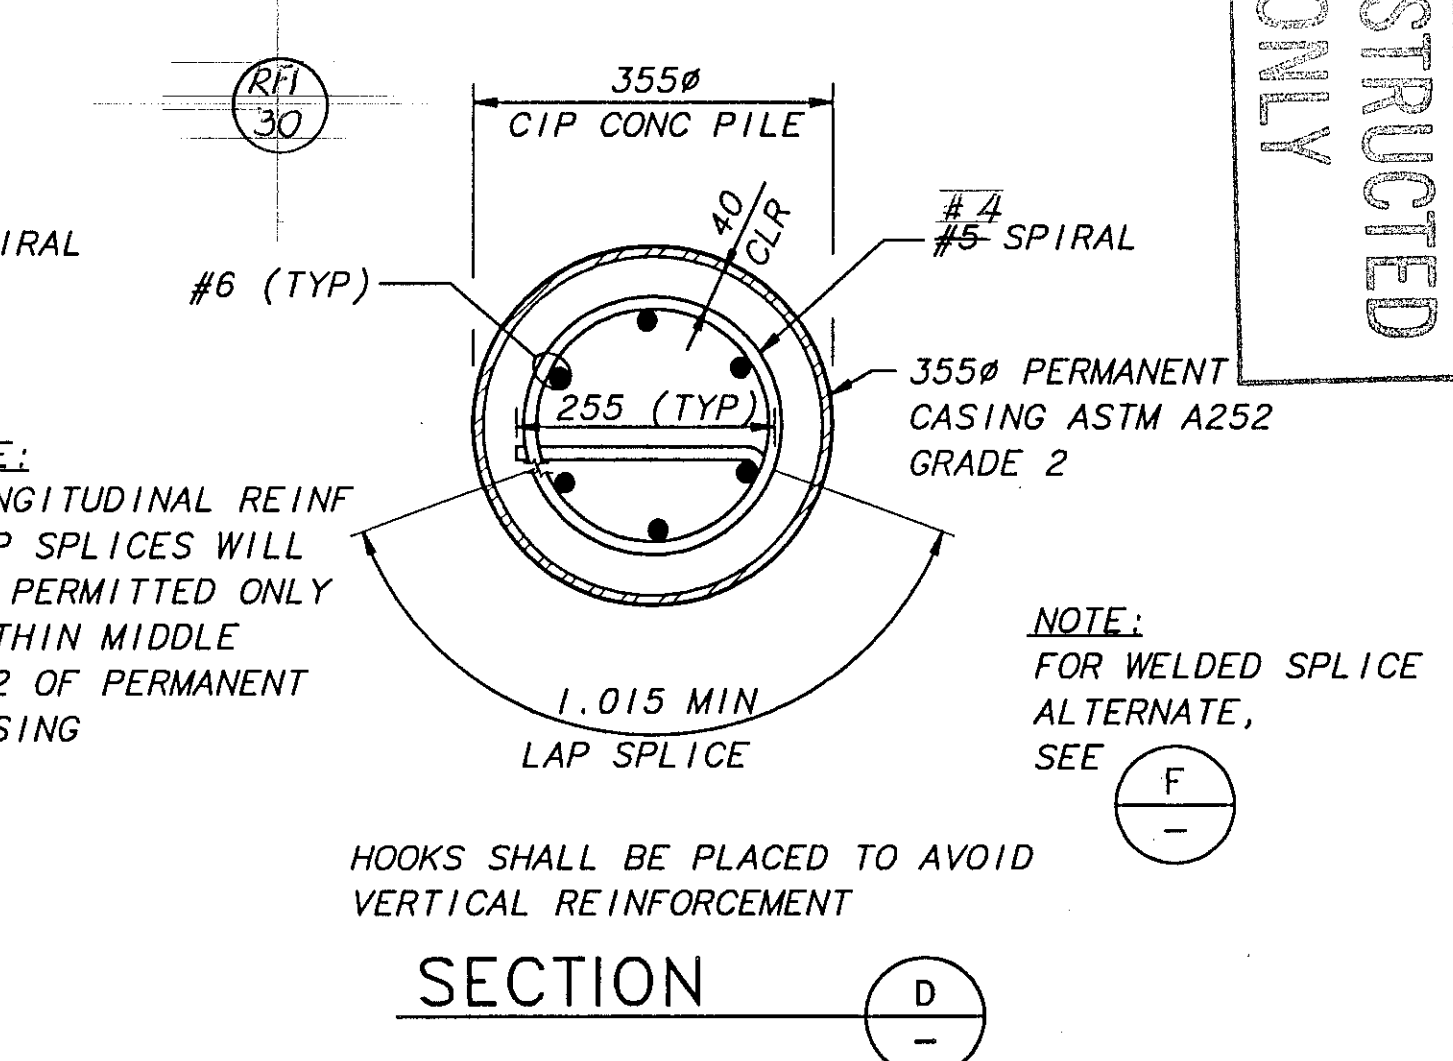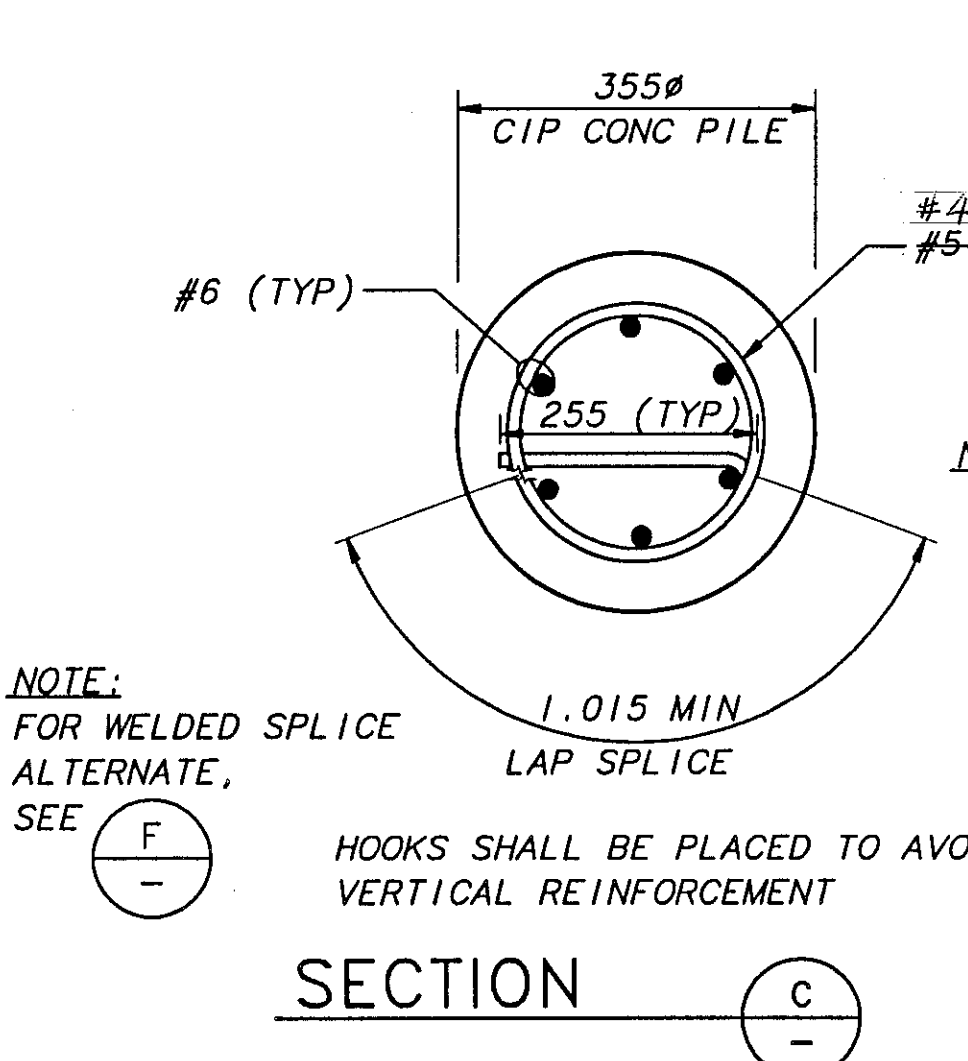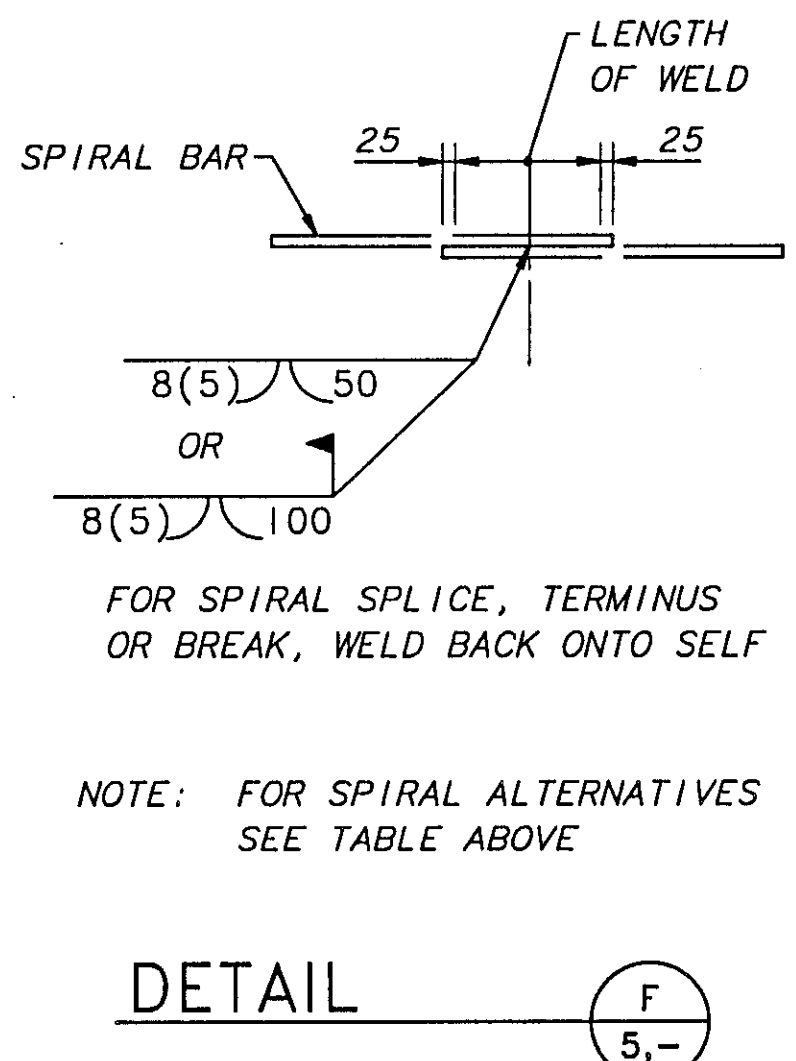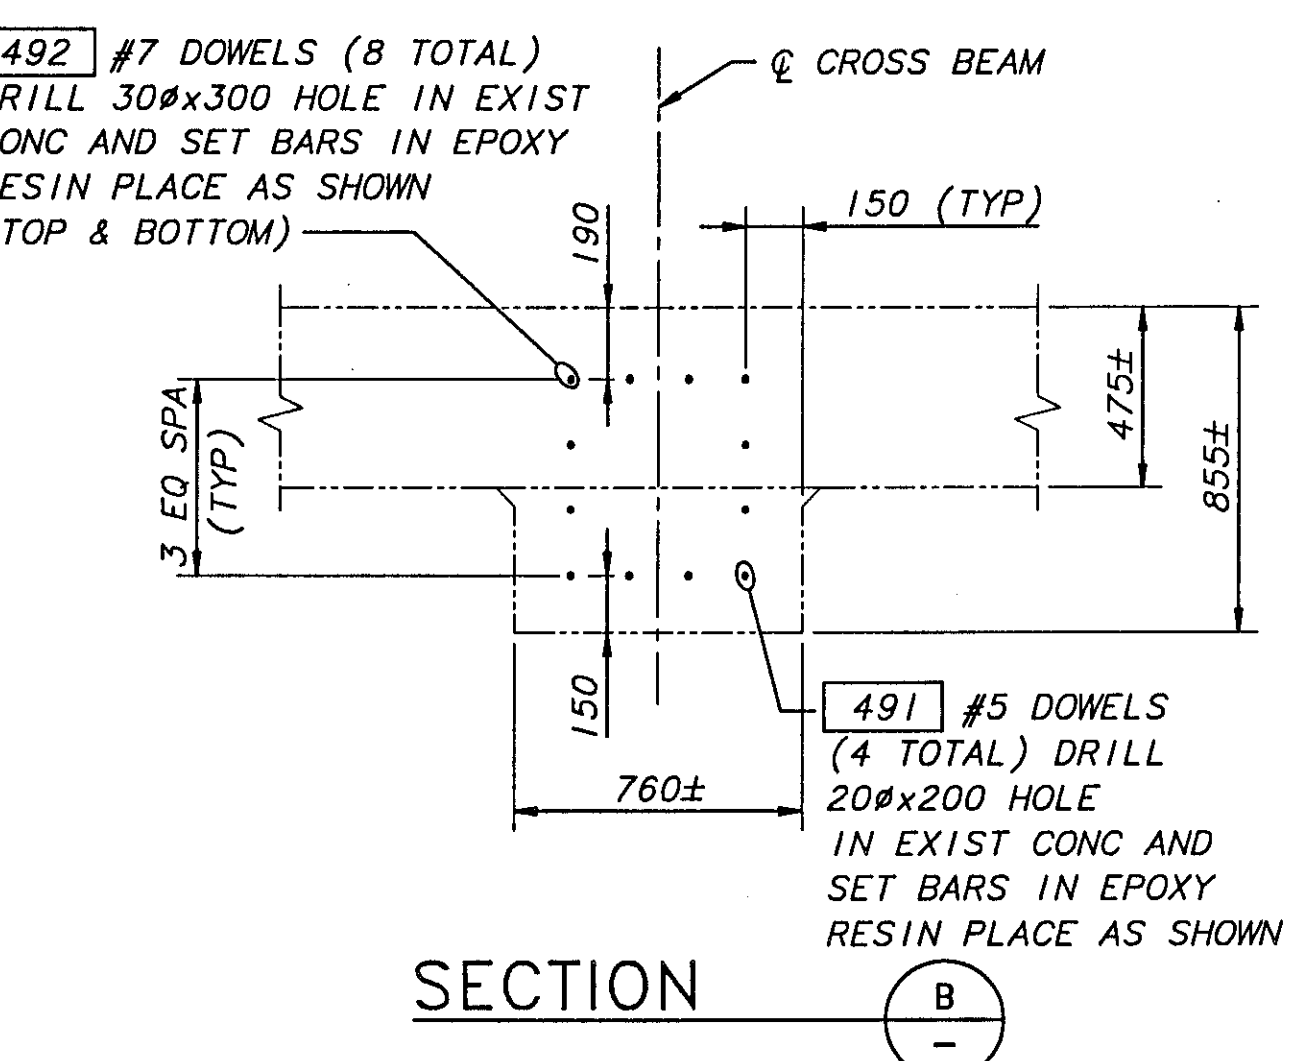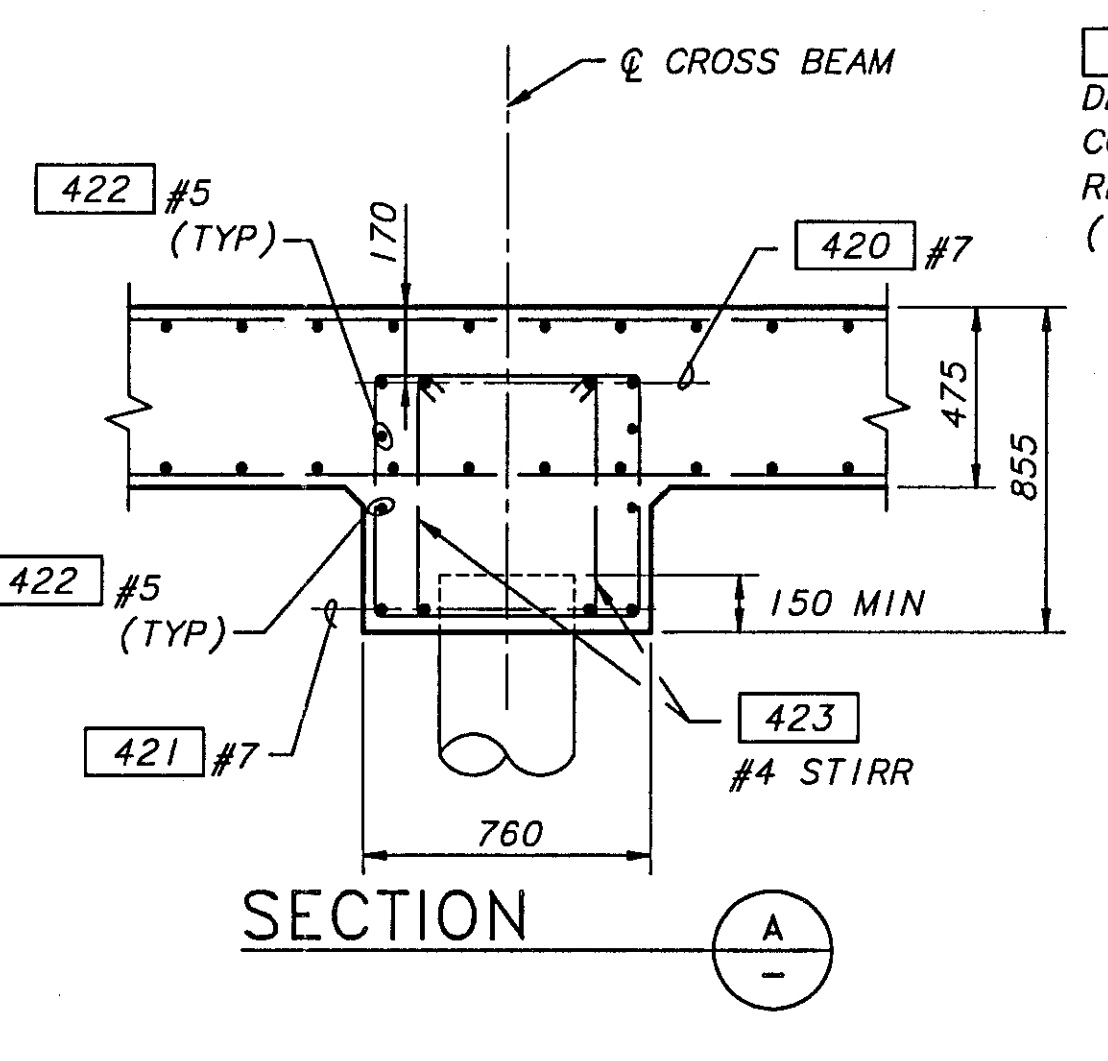

SR 405 JOB NO. 7071 SHEET 6 OF 19


BRIDGE DESIGN ENGR		REGION NO.	STATE	FED AID PROJ NO.	SHEET	TOTAL SHEETS
SUPERVISOR						
DESIGNED BY	J. CHEN	6/96	1	WASH		
CHECKED BY	C. CORNELL	6/96				
DETAILED BY	T. BRENNAN	6/96				
BRIDGE PROJECTS ENGR						
PRELIM PLAN BY	6/3/97	RFI-30	ALM			
ARCHITECT/SPECIALIST	DATE	REVISION	BY	APPR		
				5054		

BERGER/ABAM
ENGINEERS INC.
33301 9TH AVENUE SOUTH
FEDERAL WAY, WASHINGTON 98003-8395
(206)431-2300 FAX: (206)431-2280

Washington State
Department of
Transportation


SR 405
BOTHELL TO SWAMP CREEK I/C
HOV LANES - STAGE 1
NORTH CREEK BRIDGE 405/72 E-W
PIER 2 & 3 (MEDIAN WIDENING)

BRIDGE SHEET NO. 6
SHEET 466 OF 663 SHEETS

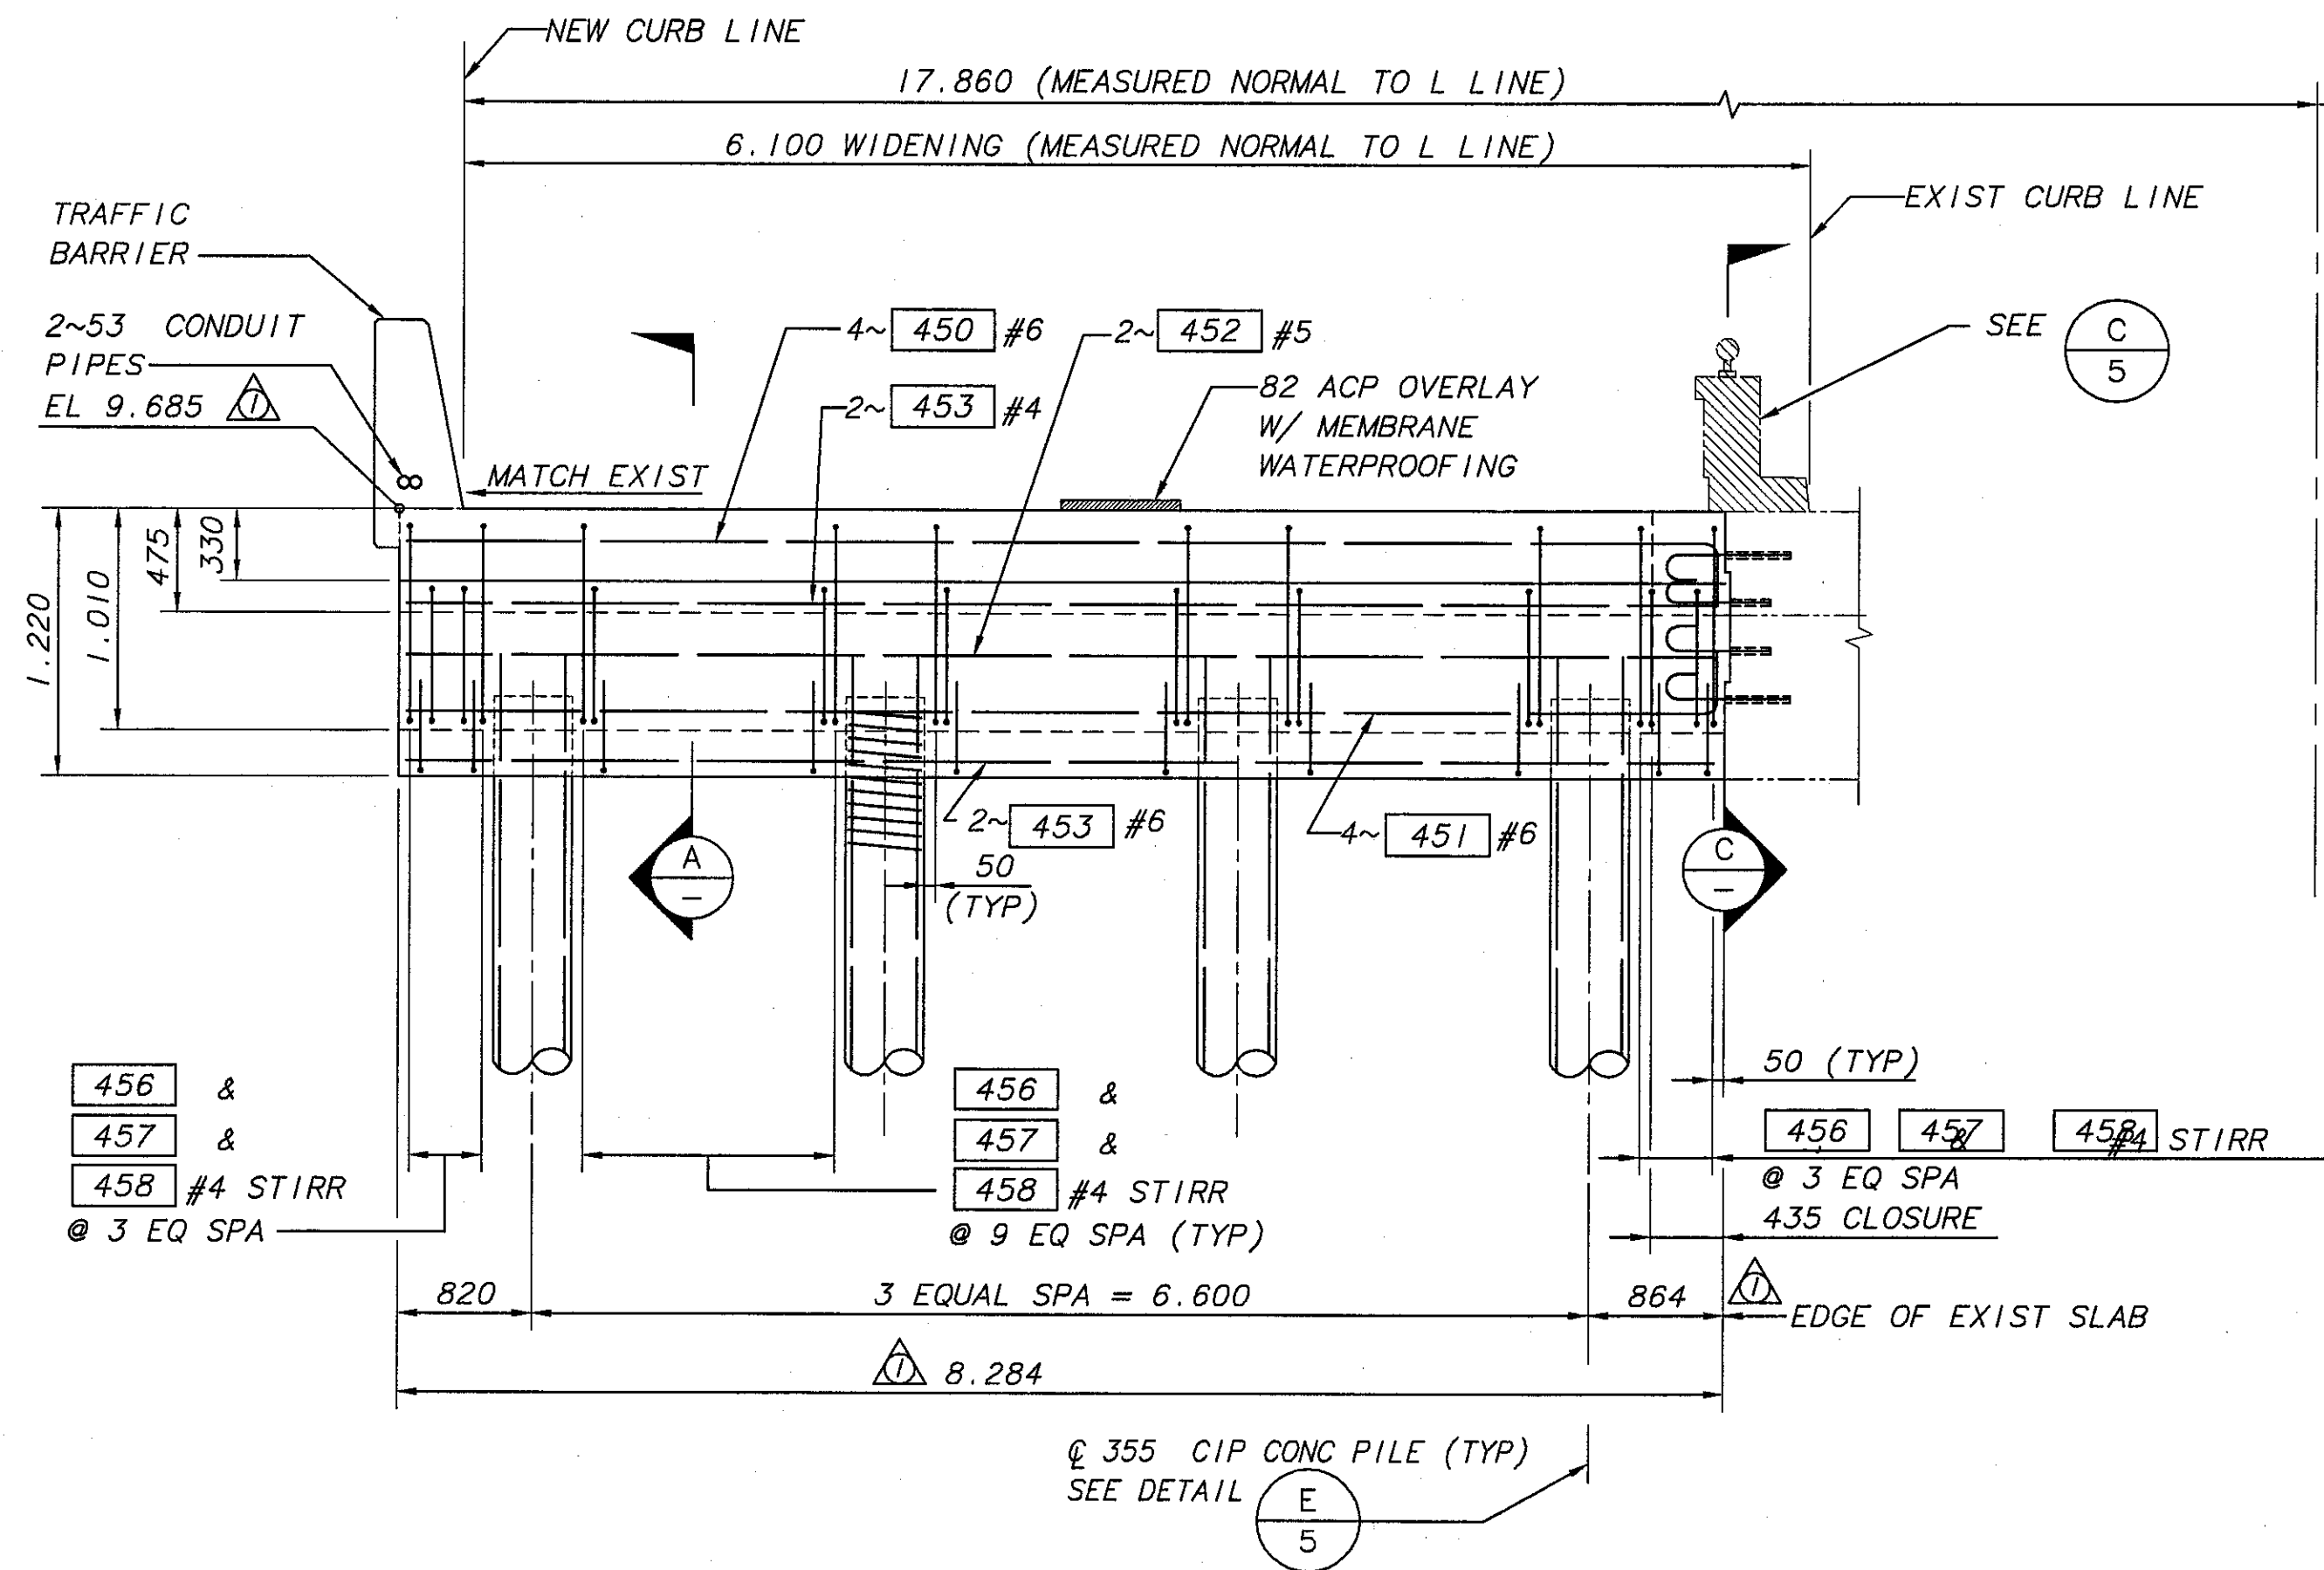


ELEVATION - PIER 1-W (OUTBOARD WIDENING)
(LOOKING AHEAD ON STATION)

NOTES: 1. ALL DIMENSIONS ARE MEASURED ALONG THE ϕ CROSS BEAM UNLESS NOTED OTHERWISE.
2. SEE BRIDGE SHEET 16 FOR PLACEMENT OF 2-53 DIAMETER CONDUITS AT END PIER.

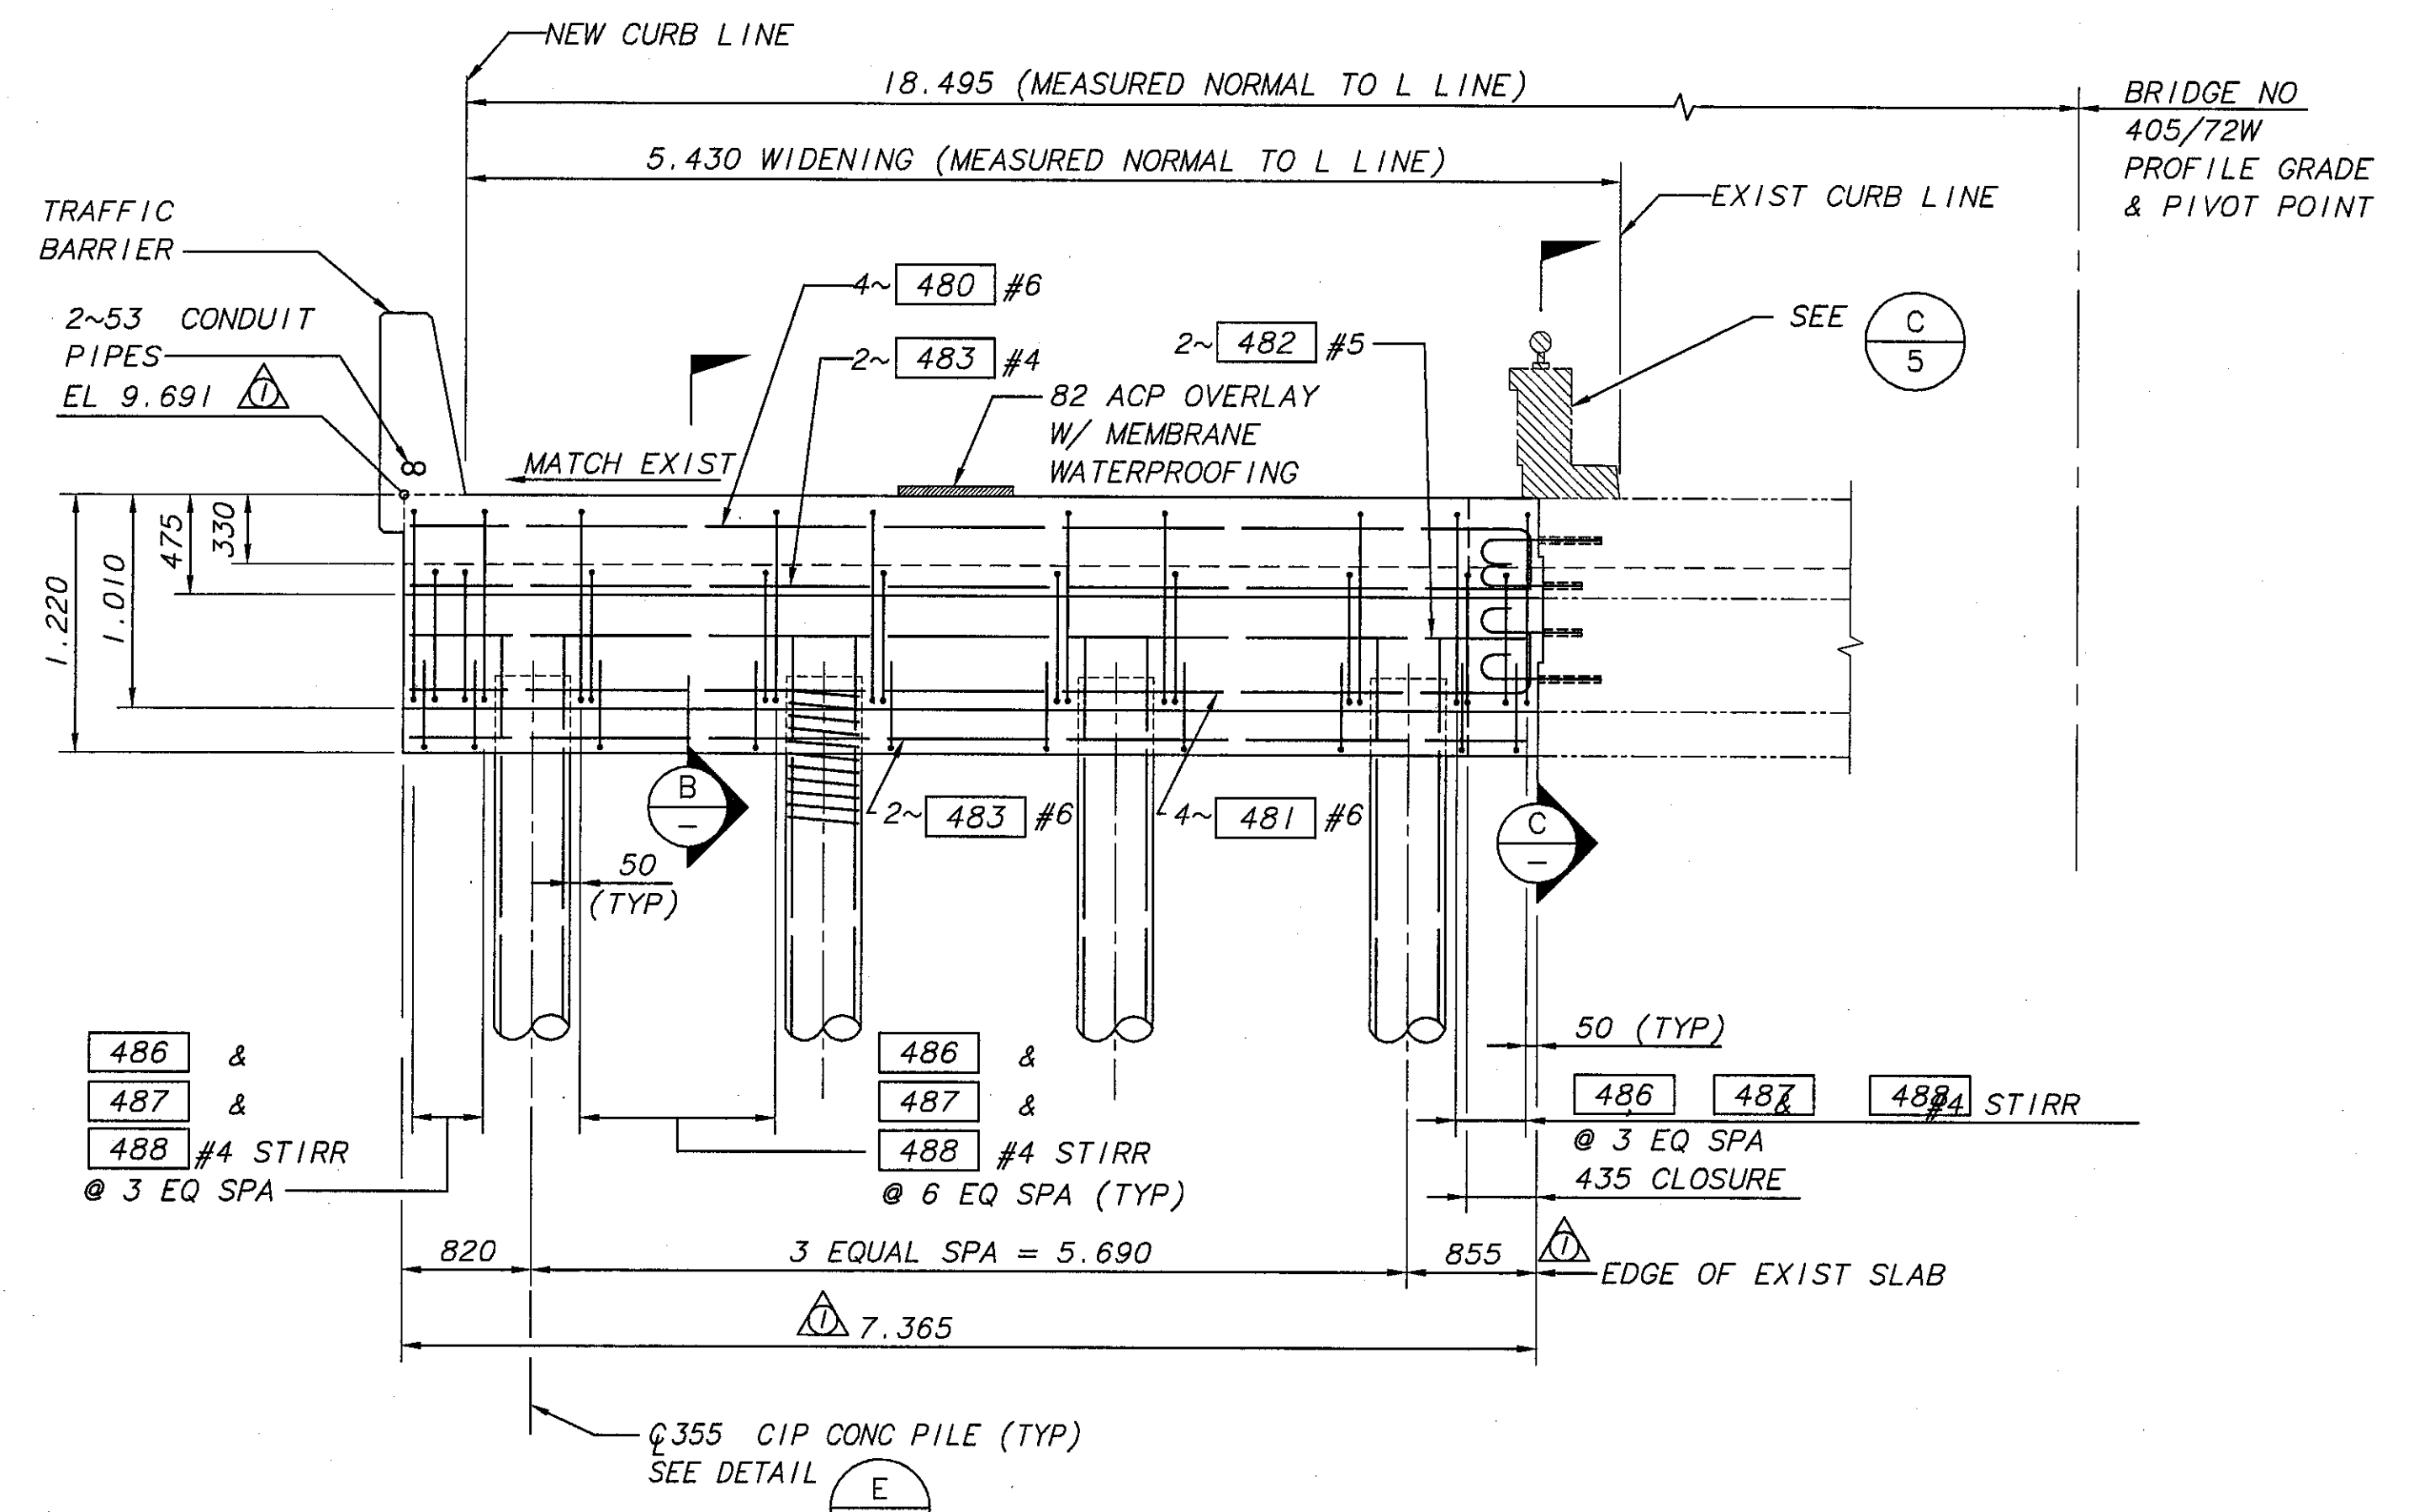


ELEVATION - PIER 4-W (OUTBOARD WIDENING)
(LOOKING AHEAD ON STATION)


NOTES: 1. ALL DIMENSIONS ARE MEASURED ALONG THE ϕ CROSS BEAM UNLESS NOTED OTHERWISE.
2. SEE BRIDGE SHEET 16 FOR PLACEMENT OF 2-53 DIAMETER CONDUITS AT END PIER.

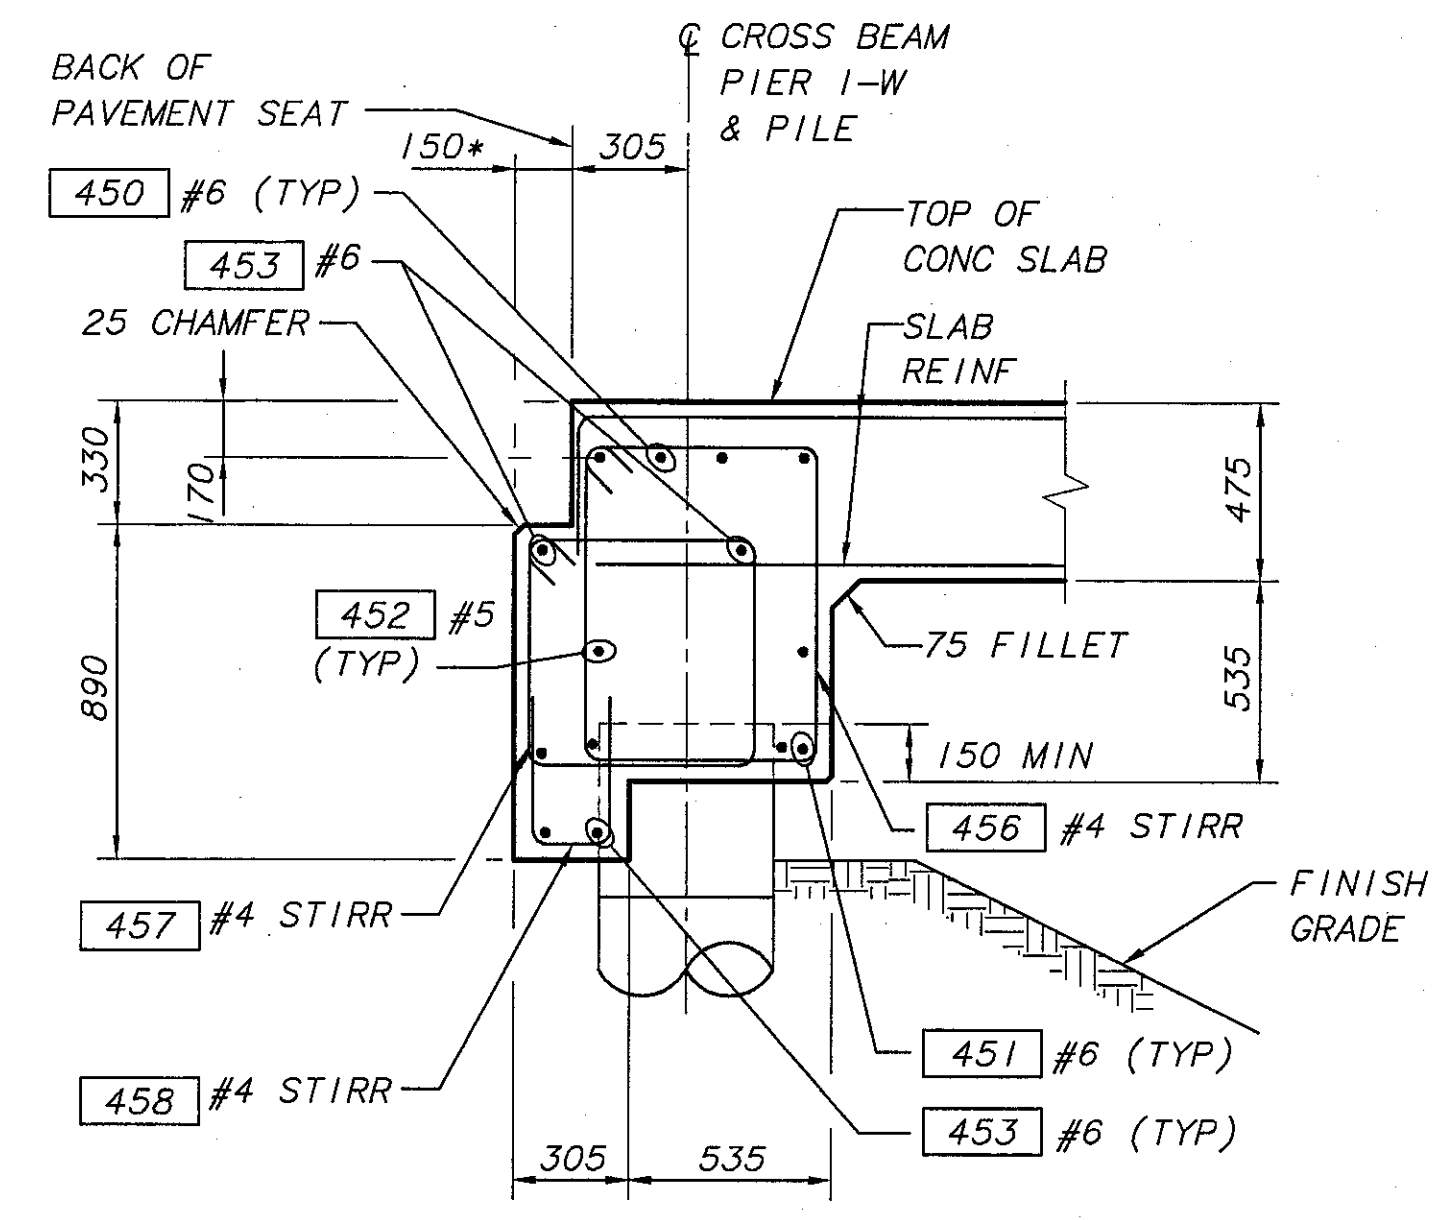

SECTION A

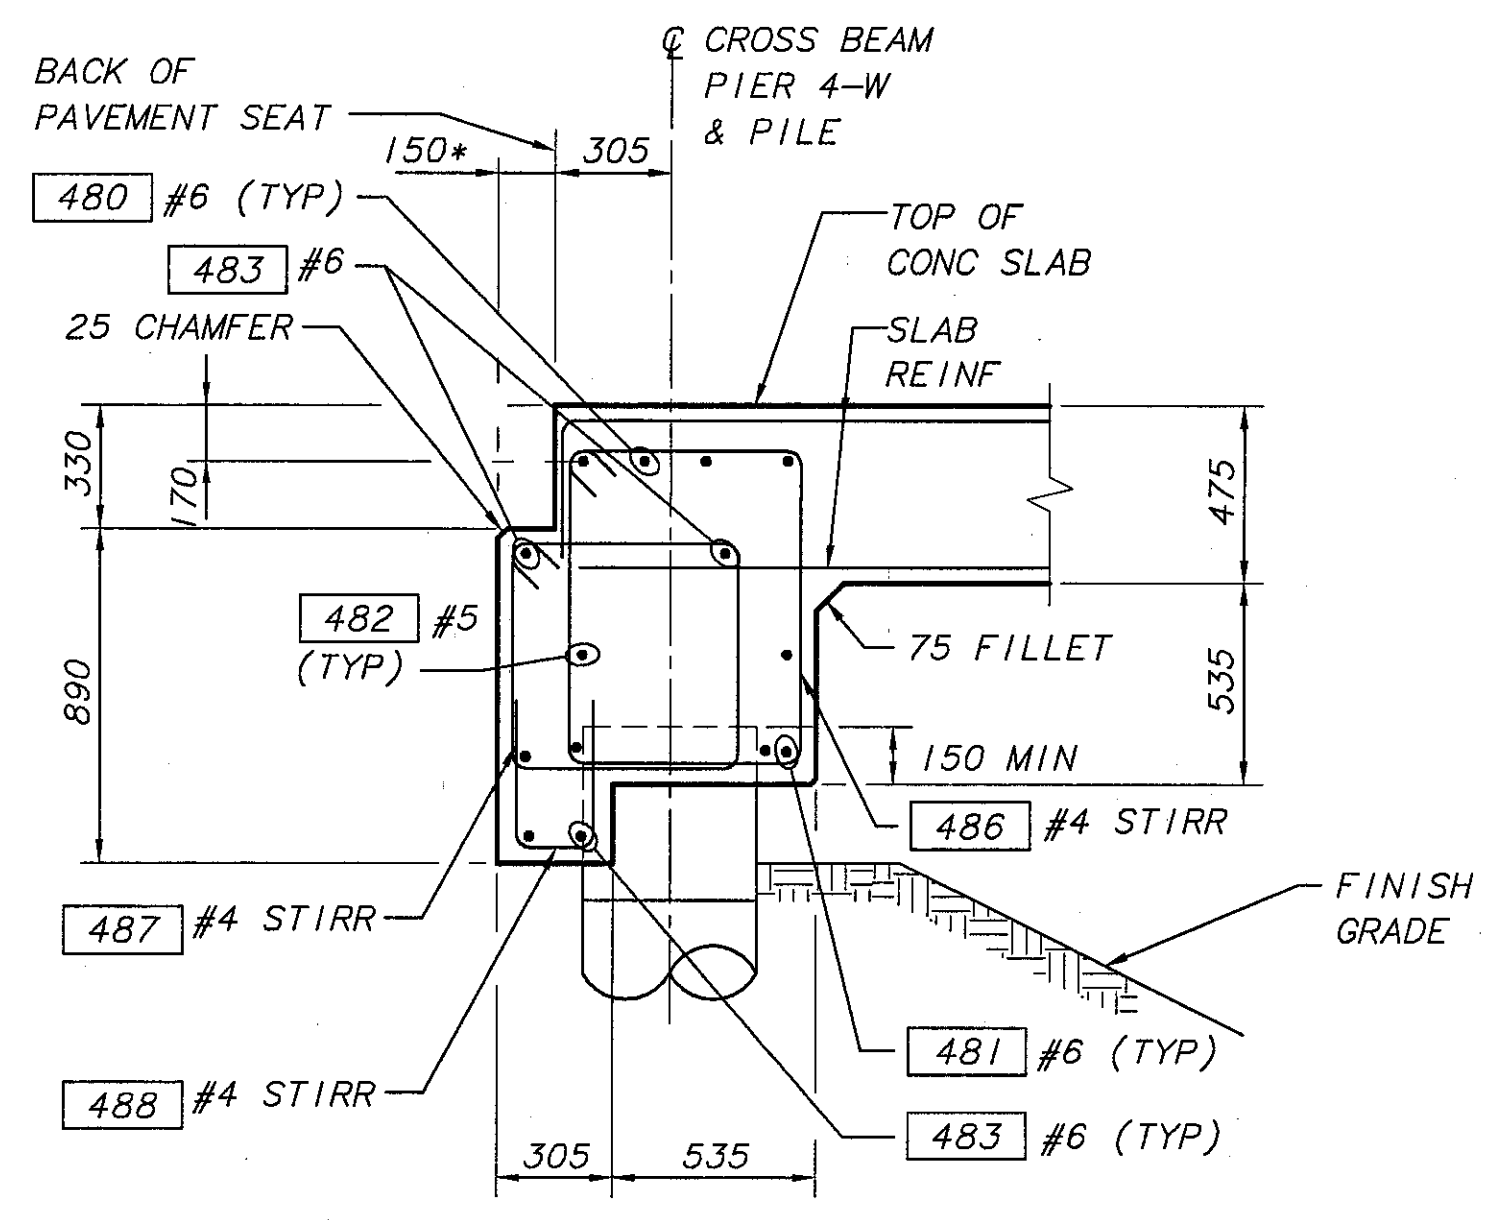

SECTION B

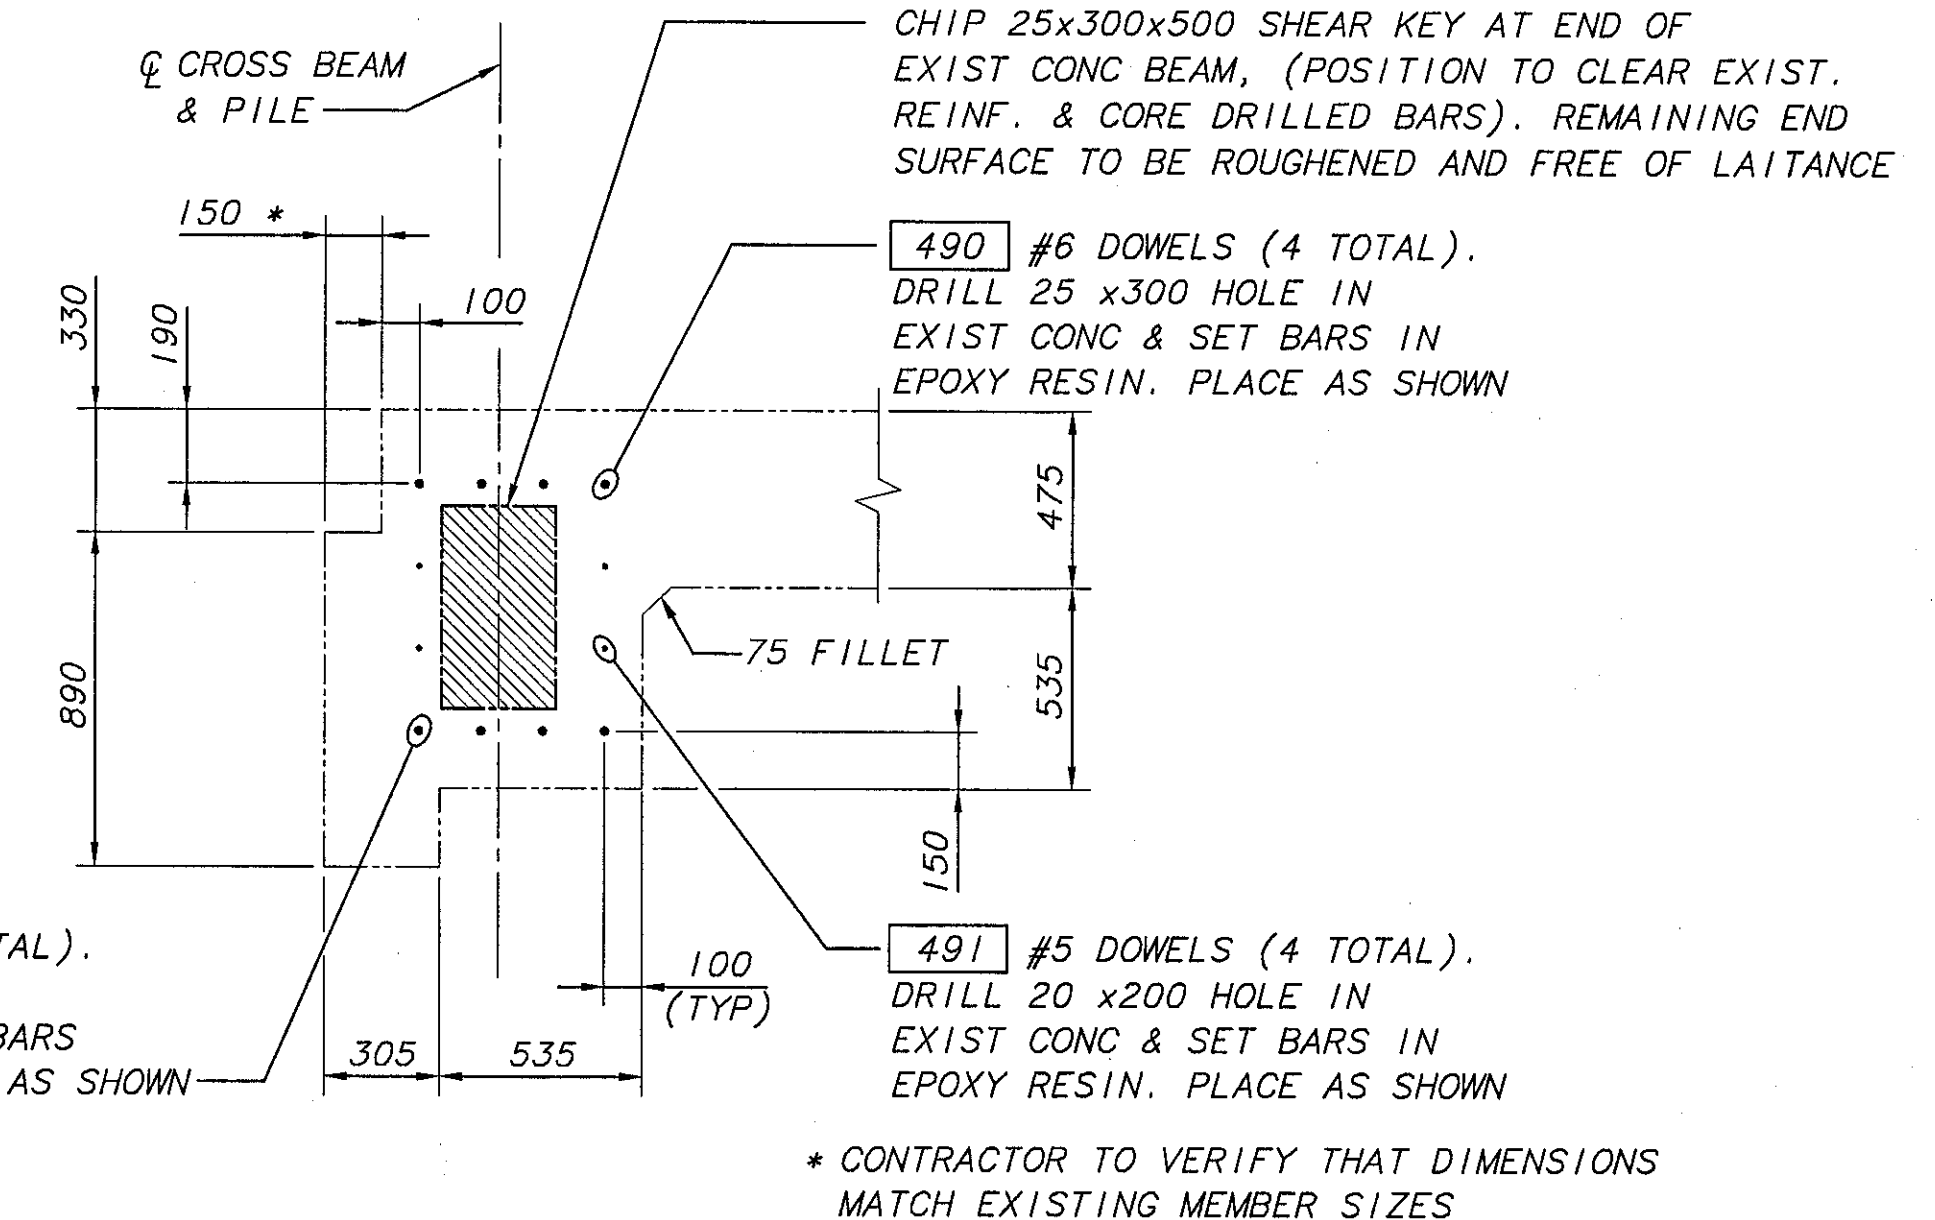


SECTION C

SR 405 JOB NO. 7071 SHEET 7 OF 19

PLOTTED: Sat Jul 12 1997 11:12am FILENAME: X:\A66077\BR72\EW\REV1\YR1.DWG SCALE: 30

BRIDGE DESIGN ENGR		REGION NO.	STATE	FED AID PROJ NO.	SHEET NO.	TOTAL SHEETS
SUPERVISOR		10	WASH			
DESIGNED BY	J. CHEN 6/96	JOB NUMBER		96W035		
CHECKED BY	C. CORNELL 6/96	CONTRACT NO.		5054		
DETAILED BY	T. BRENNAN 6/96	DATE	REVISION	BY	APPR	
BRIDGE PROJECTS ENGR		7/97	CONTRACTORS SURVEY DATA- FIT EXISTING	NEW		
PRELIM PLAN BY						
ARCHITECT/SPECIALIST						

BRIDGE DESIGN ENGR		REGION NO.	STATE	FED AID PROJ NO.	SHEET NO.	TOTAL SHEETS
SUPERVISOR		10	WASH			
DESIGNED BY	J. CHEN 6/96	JOB NUMBER		96W035		
CHECKED BY	C. CORNELL 6/96	CONTRACT NO.		5054		
DETAILED BY	T. BRENNAN 6/96	DATE	REVISION	BY	APPR	
BRIDGE PROJECTS ENGR		7/97	CONTRACTORS SURVEY DATA- FIT EXISTING	NEW		
PRELIM PLAN BY						
ARCHITECT/SPECIALIST						


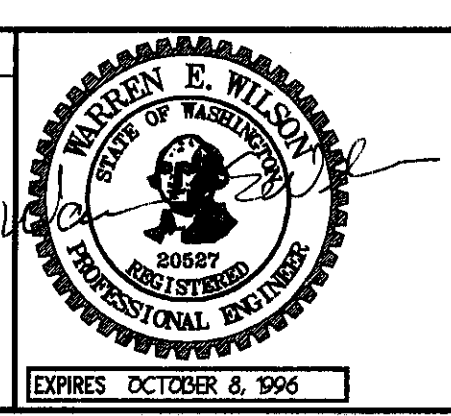


BERGER/ABAM
ENGINEERS
33301 9TH AVENUE SOUTH
FEDERAL WAY, WASHINGTON 98003-8385
(206)431-2300 FAX: (206)431-2250






SR 405
BOTHELL TO SWAMP CREEK I/C
HOV LANES - STAGE 1
NORTH CREEK BRIDGE 405/72 E-W
PIER 1-W & 4-W (OUTBOARD WIDENING)

BRIDGE SHEET NO. 7
SHEET 467 OF 663 SHEETS

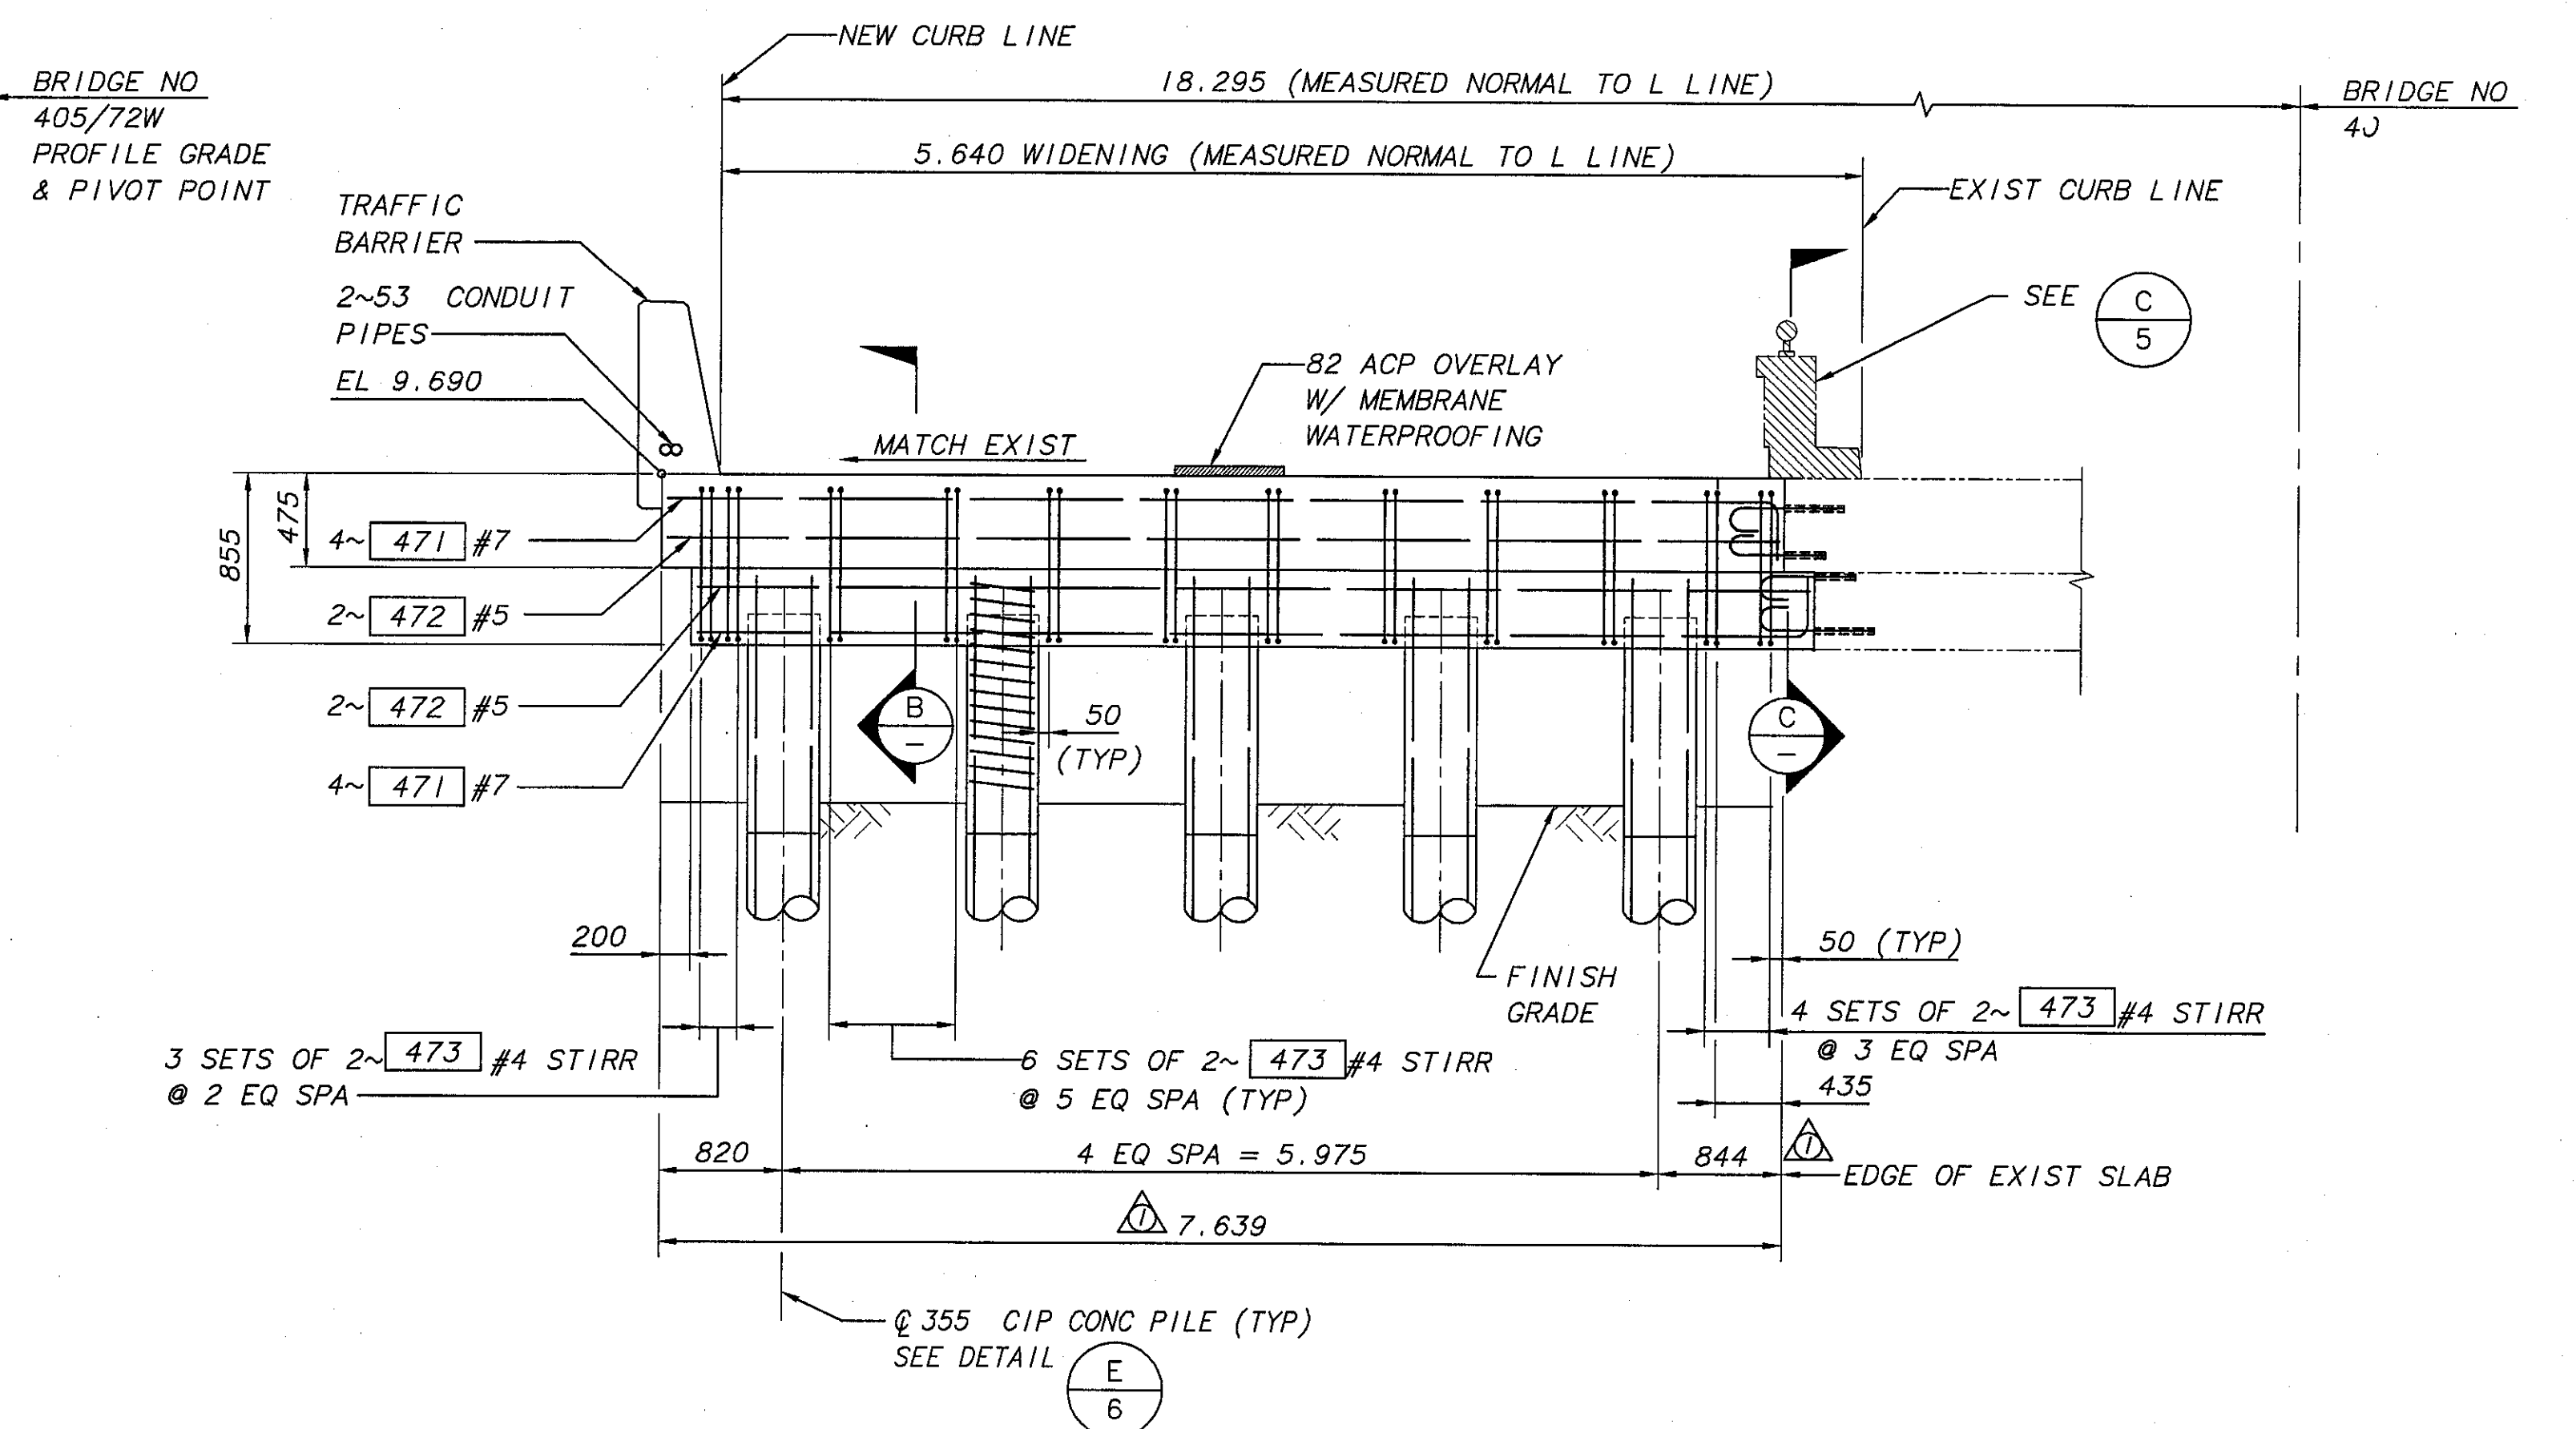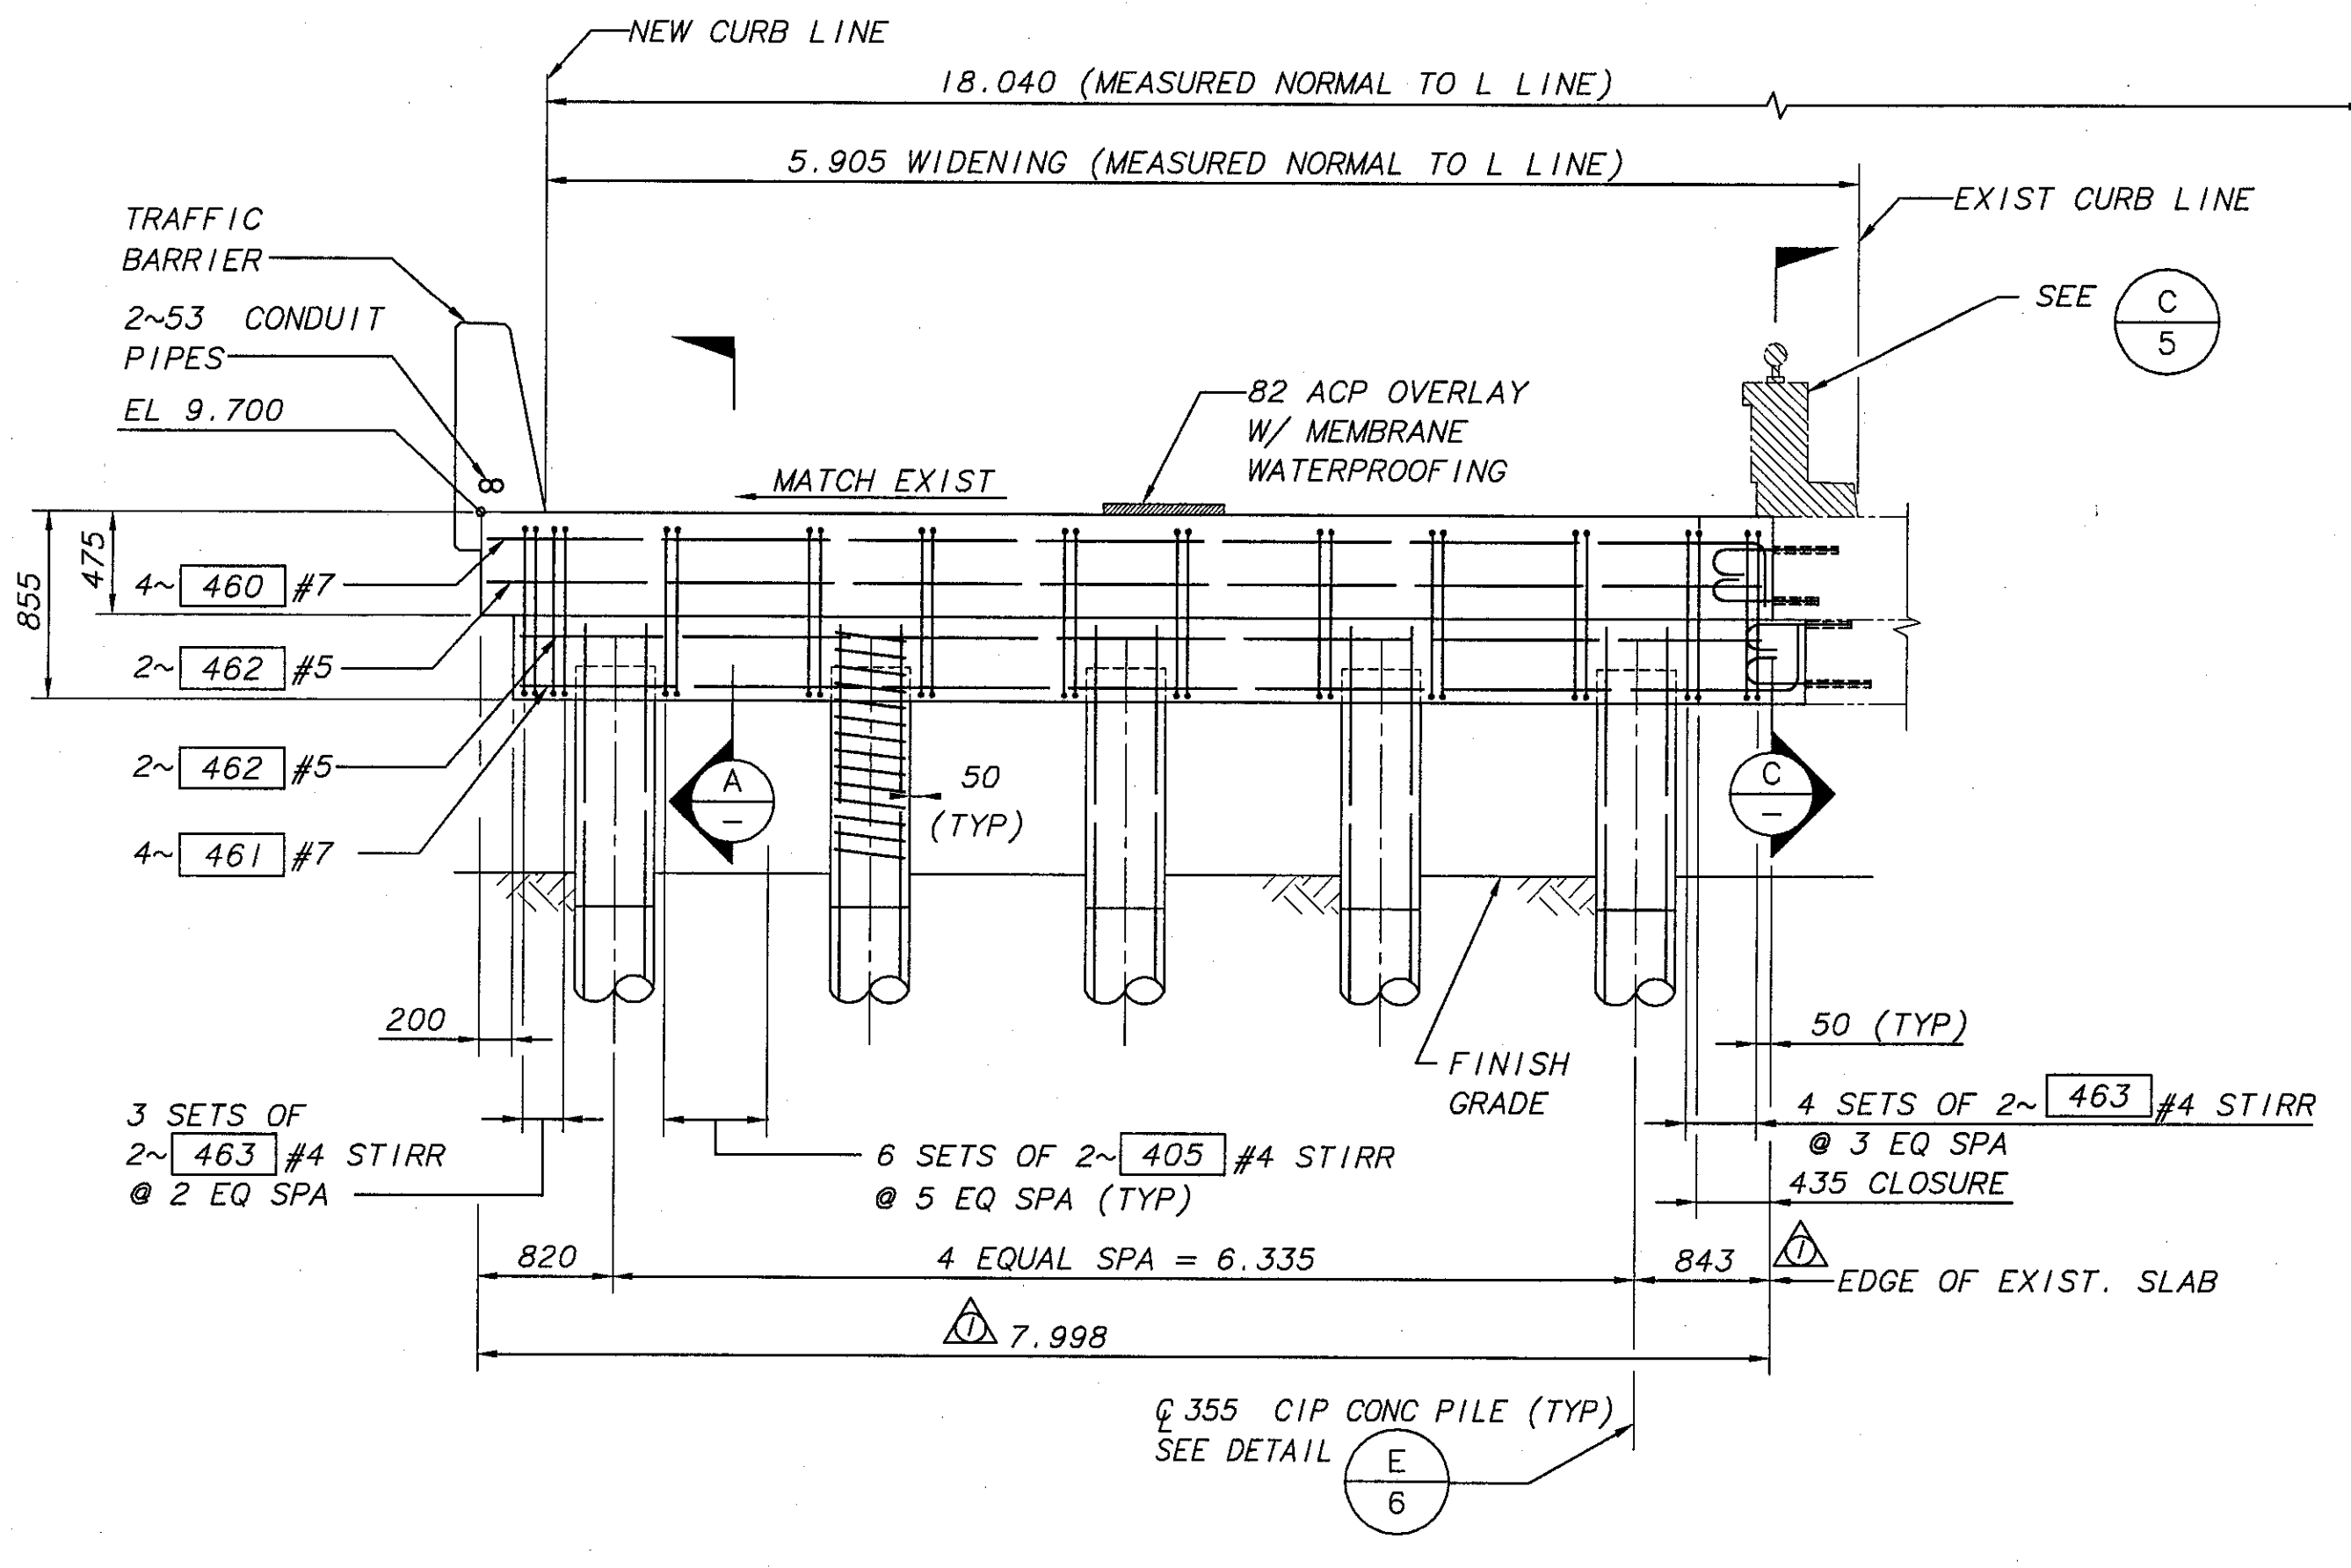

ELEVATION - PIER 2-W (OUTBOARD WIDENING)
 (LOOKING AHEAD ON STATION)
 (ALL DIMENSIONS ARE MEASURED ALONG THE ϕ CROSS BEAM UNLESS NOTED OTHERWISE)


ELEVATION - PIER 3-W (OUTBOARD WIDENING)
 (LOOKING AHEAD ON STATION)
 (ALL DIMENSIONS ARE MEASURED ALONG THE ϕ CROSS BEAM UNLESS NOTED OTHERWISE)

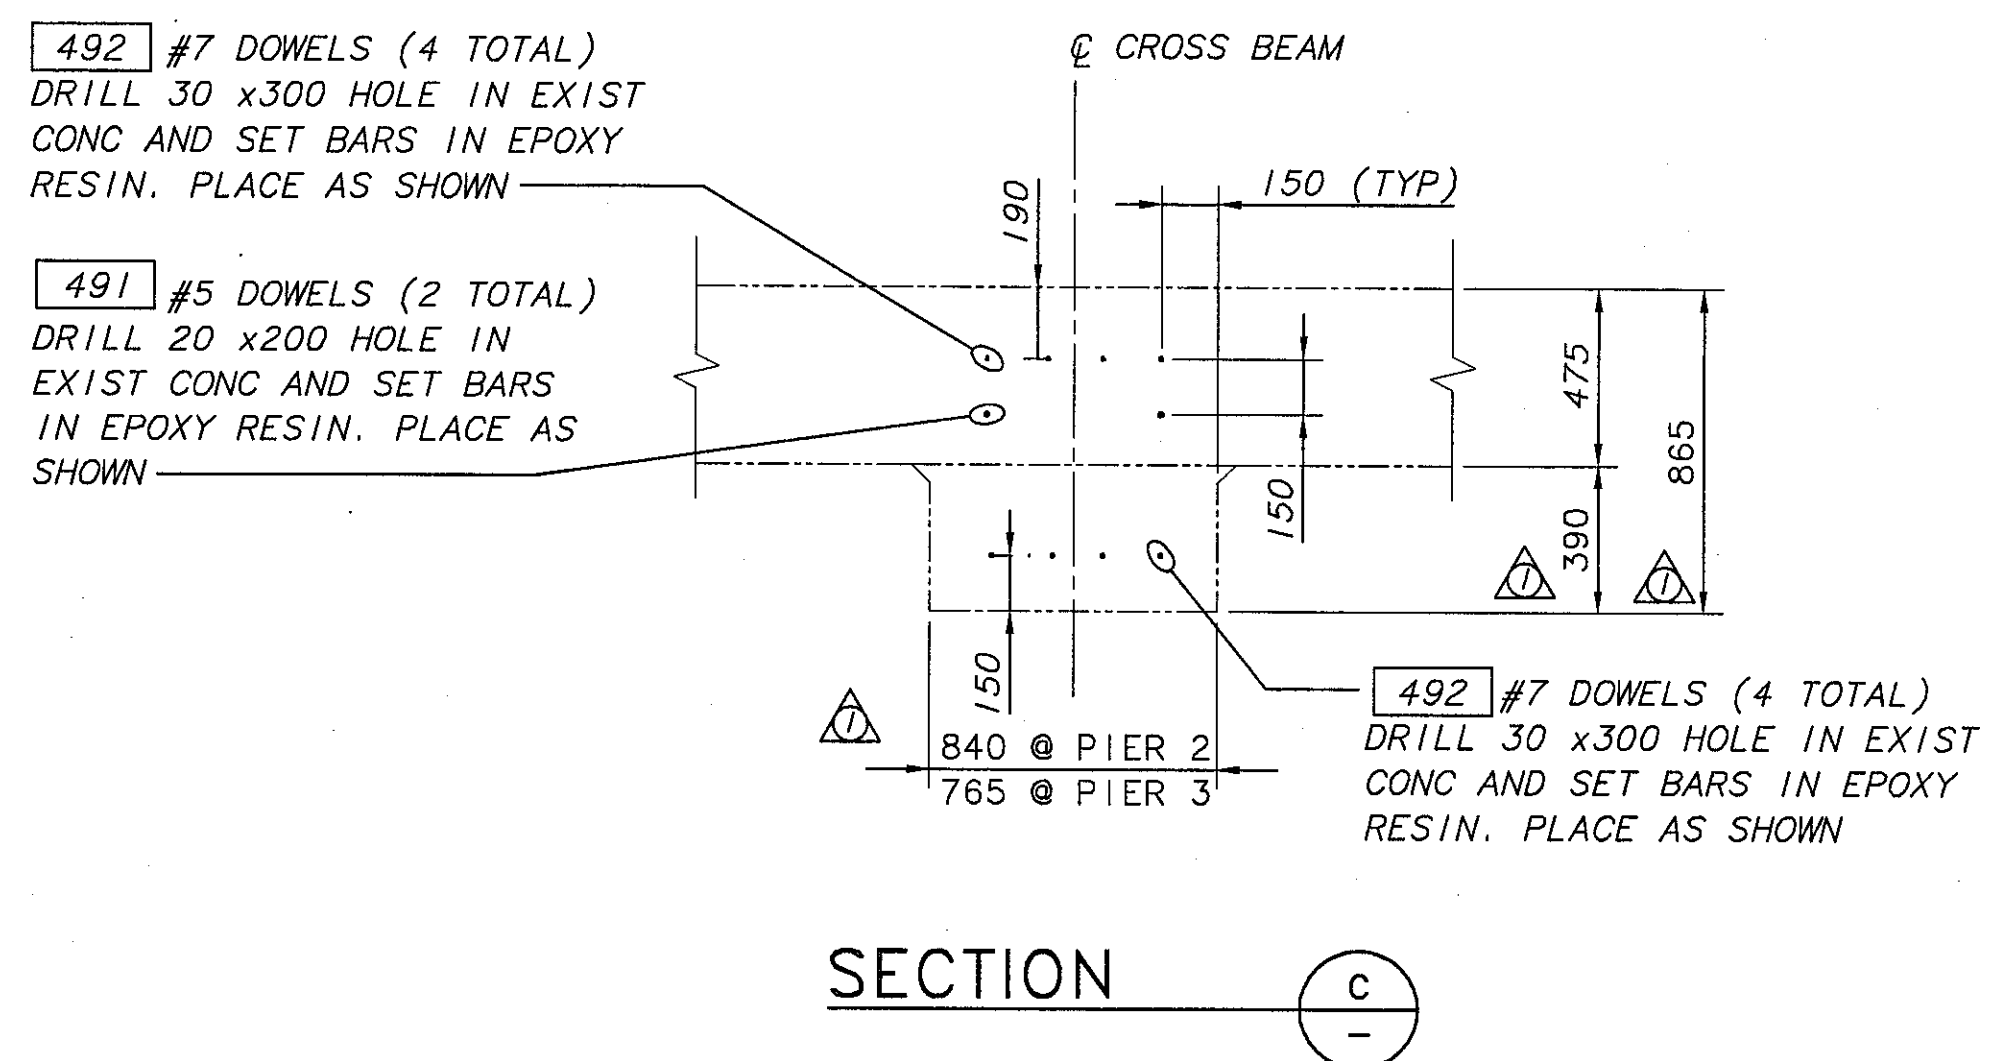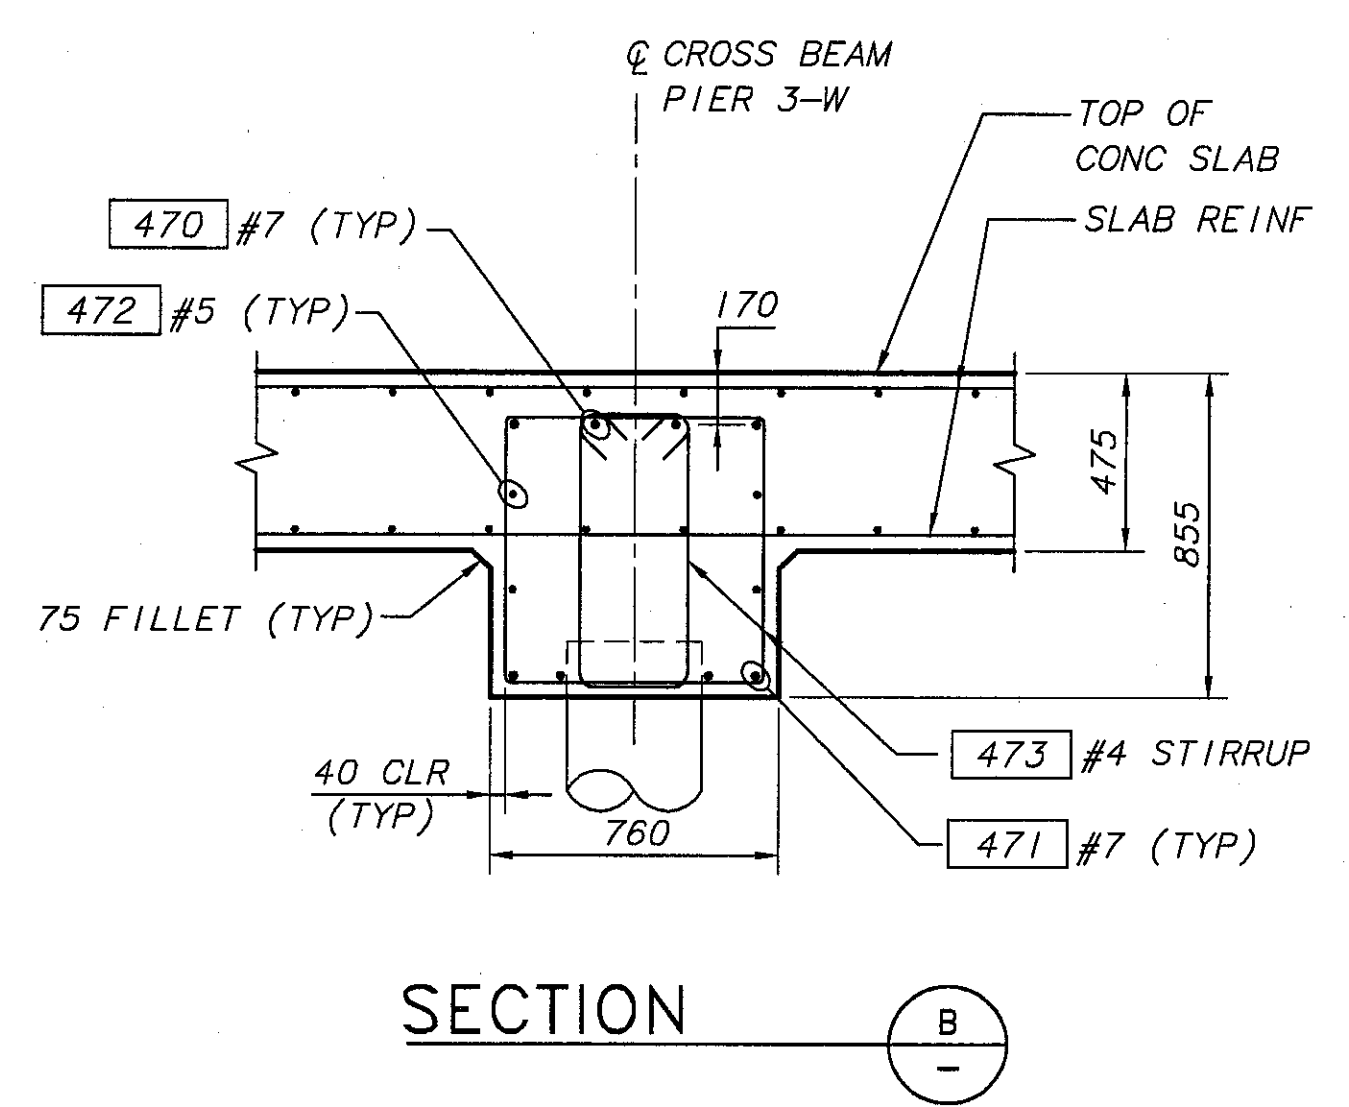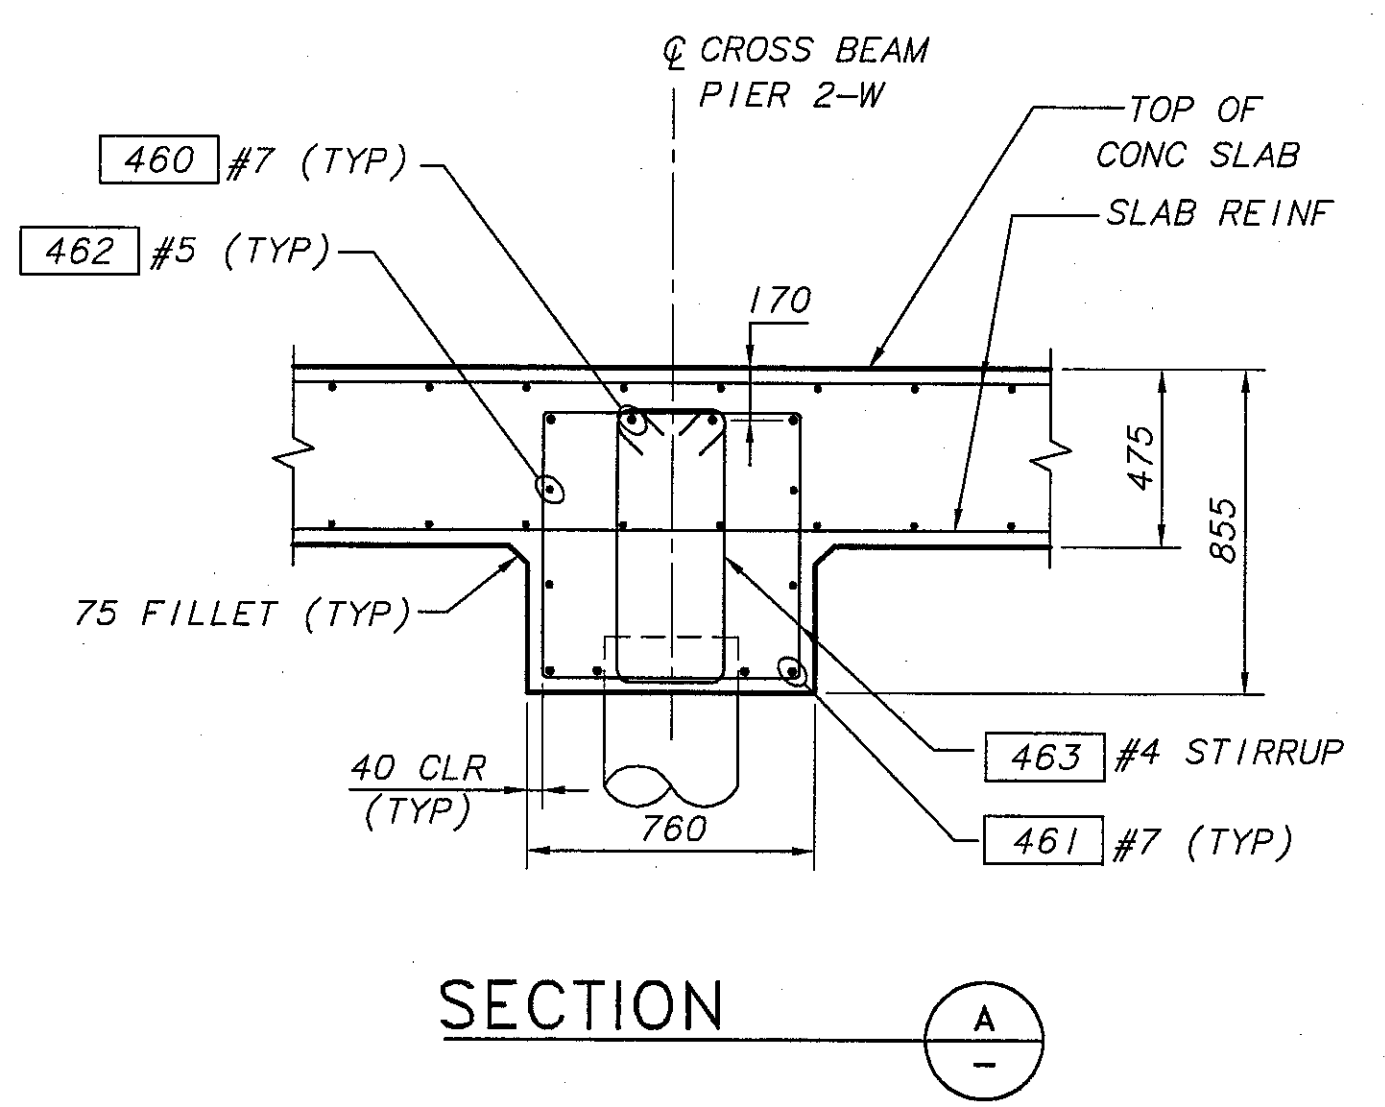

SR 405 JOB NO. 7071 SHEET 8 OF 19

PLOTTED: Wed Oct 22 1997 11:41am FILENAME: V:\AS6077\BR72\EW\8.dwg SCALE: 30

BRIDGE DESIGN ENGR		REGION NO.	STATE	FED AID PROJ NO.	SHEET NO.	TOTAL SHEETS
SUPERVISOR		10	WASH			
DESIGNED BY	J. CHEN 6/96	JOB NUMBER	96W035			
CHECKED BY	C. CORNELL 6/96	CONTRACT NO.	5054			
DATE	7/97	CONTRACTOR SURVEY DATA - FIT EXISTING	NEW	BY	APPR	
ARCHITECT/SPECIALIST		REVISION				

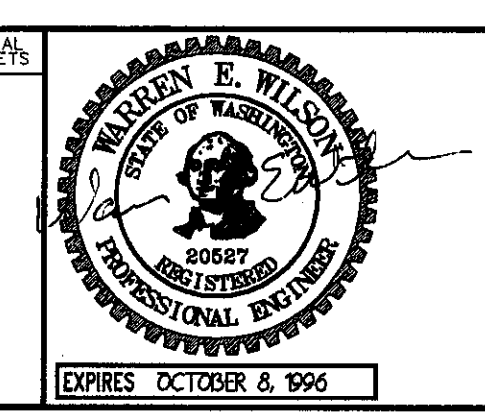


SR 405
 BOTHELL TO SWAMP CREEK I/C
 HOV LANES - STAGE 1
 NORTH CREEK BRIDGE 405/72 E-W
 PIER 2-W & 3-W (OUTBOARD WIDENING)

BRIDGE SHEET NO. 8
 SHEET 468 OF 663 SHEETS

PLOTTED: Sat Jul 12 1997 11:10am FILENAME: X:\96077\BR72\EM\REV1\10RT.DWG SCALE: 60


SR 405 JOB NO. 7071 SHEET 10 OF 19

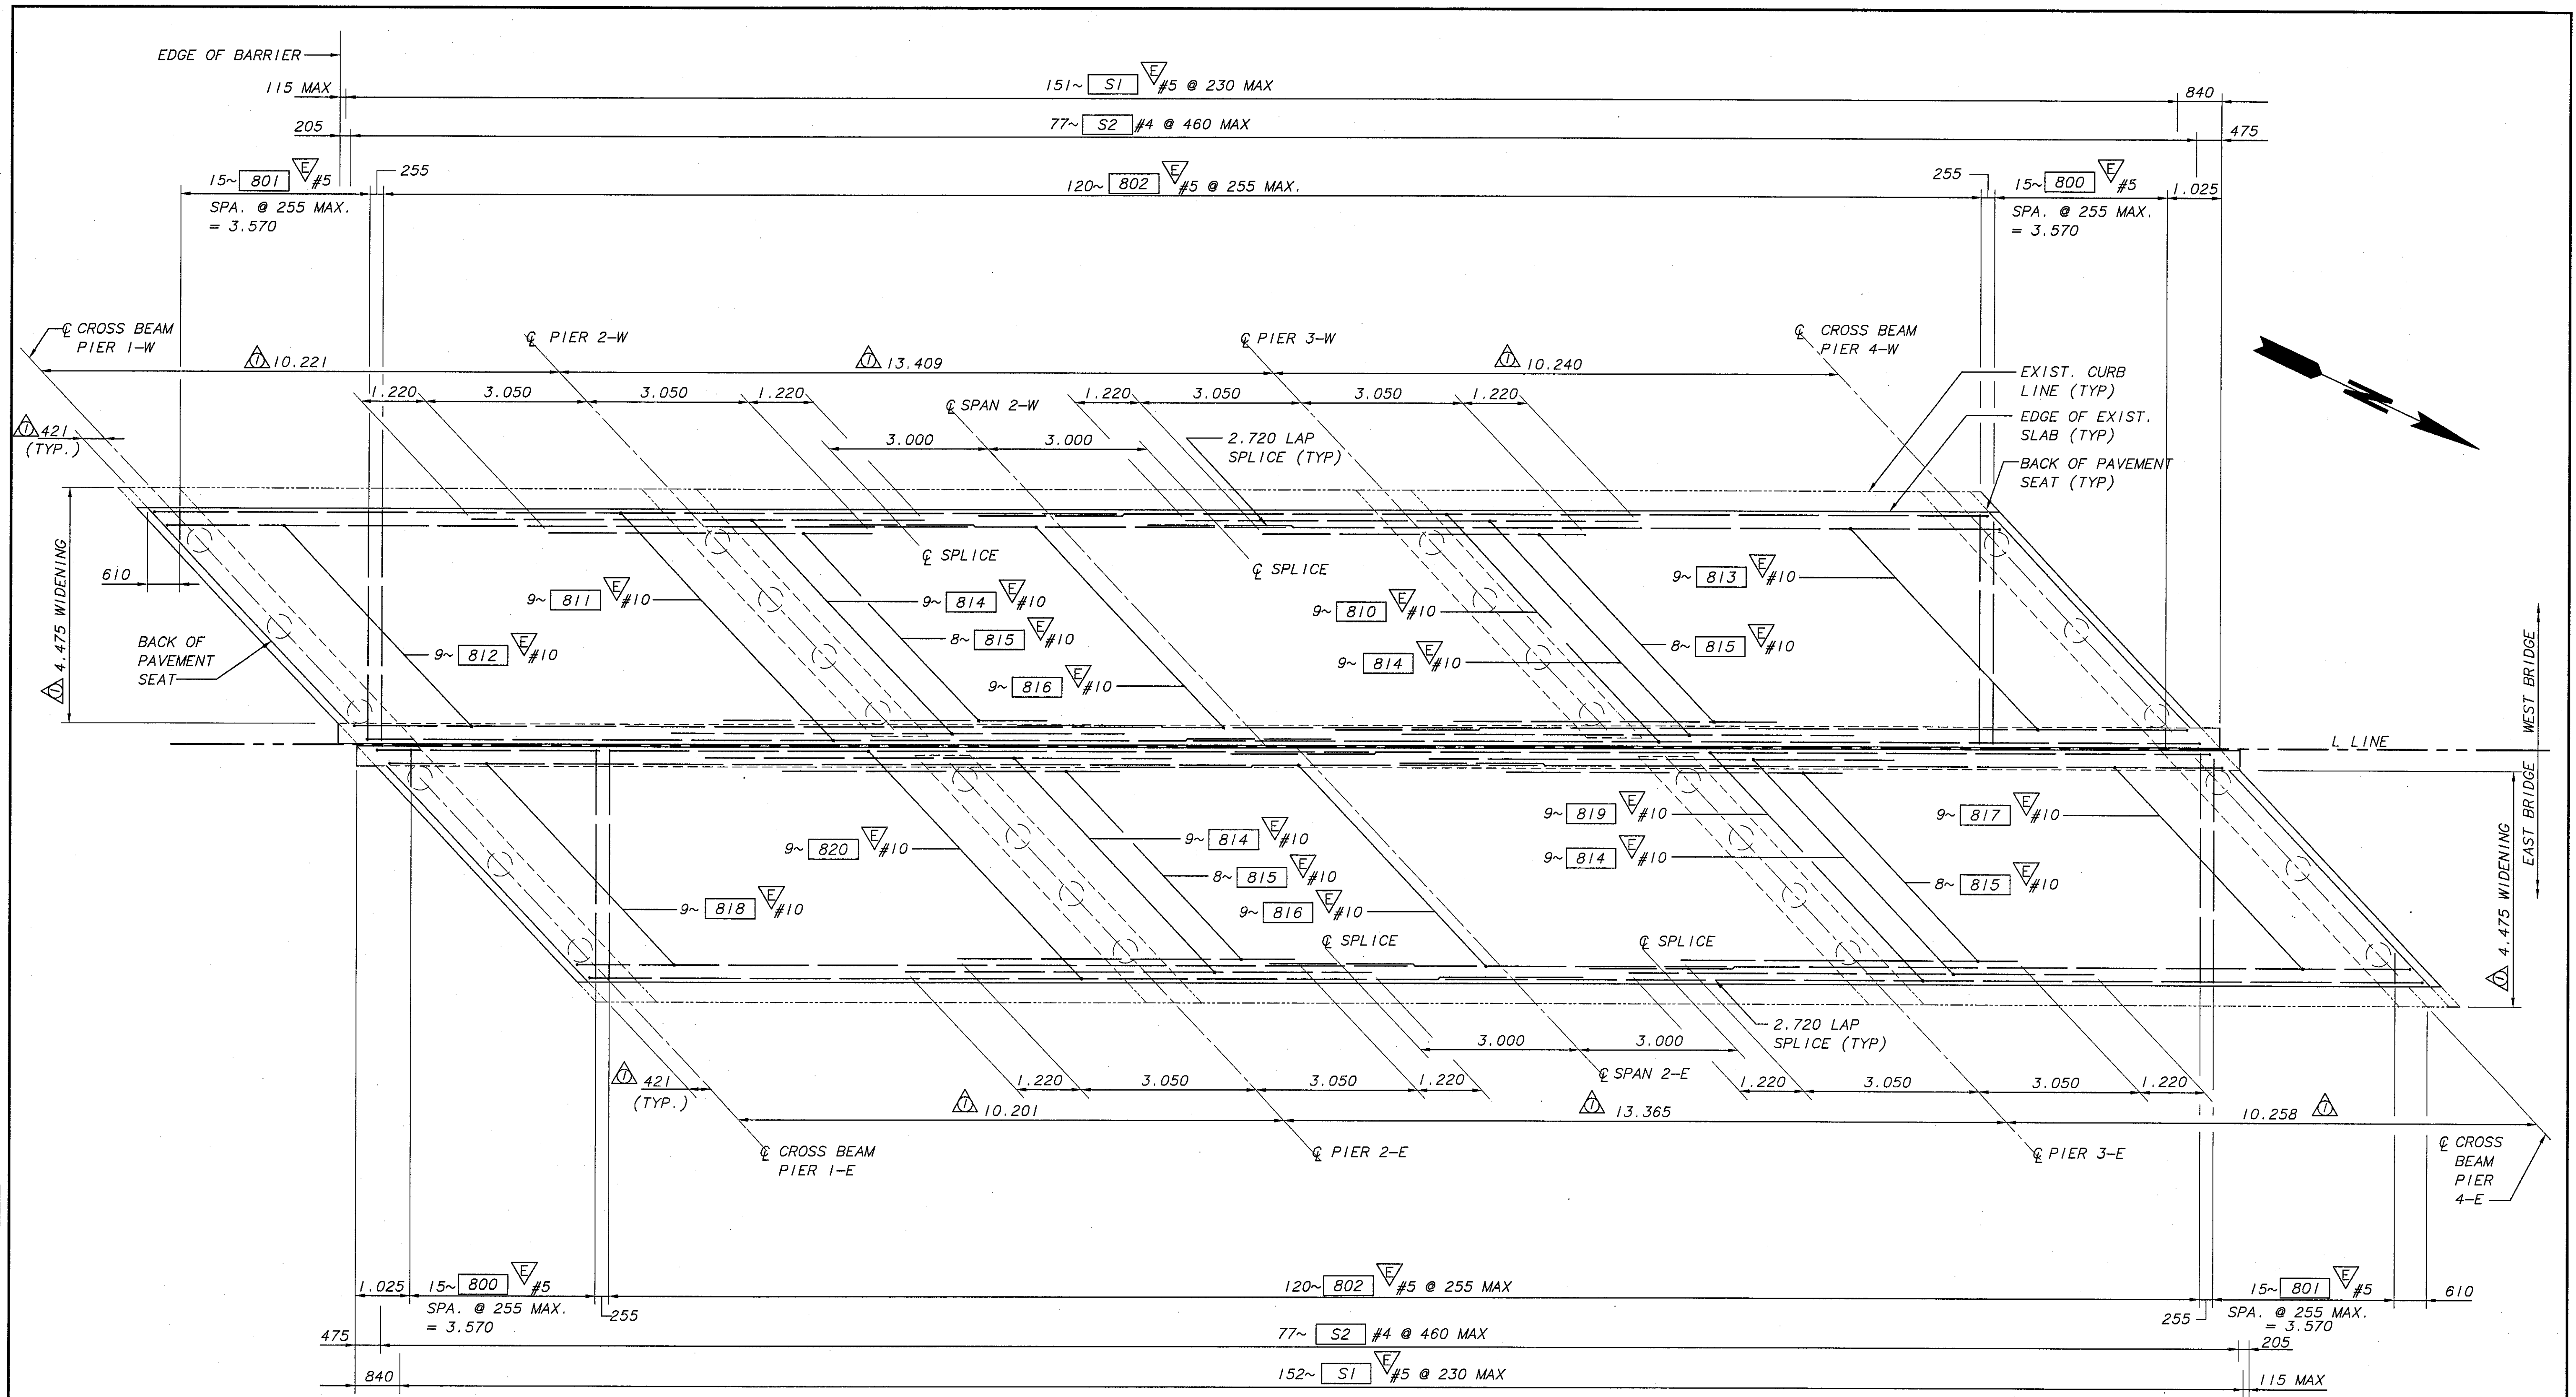

REINFORCEMENT PLAN - TOP MAT (MEDIAN WIDENING)
 (ALL DIMENSIONS MEASURED ALONG L LINE UNLESS OTHERWISE NOTED)

BRIDGE DESIGN ENGR					
SUPERVISOR					
DESIGNED BY	J. CHEN	6/96			
CHECKED BY	C. CORNELL	6/96			
DETAILED BY	T. BRENNAN	6/96			
BRIDGE PROJECTS ENGR					
PRELIM PLAN BY	7/97	CONTRACTOR SURVEY DATA - FIT EXISTING	NEW		
ARCHITECT/SPECIALIST	DATE	REVISION	BY	APPR	

REGION	STATE	FED AID PROJ NO	SHEET NO	TOTAL SHEETS
10	WASH			
JOB NUMBER				
96W035				
CONTRACT NO.				
5054				

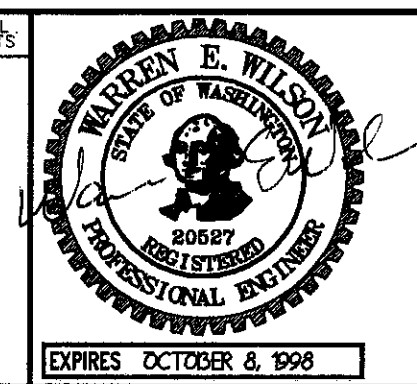

BERGER/ABAM
 ENGINEERS INC.
 33301 9TH AVENUE SOUTH
 FEDERAL WAY, WASHINGTON 98003-5385
 (206)431-2300 FAX: (206)431-2280




SR 405
 BOTHELL TO SWAMP CREEK I/C
 HOV LANES - STAGE 1
 NORTH CREEK BRIDGE 405/72 E-W
 REINF. PLAN - TOP MAT (MEDIAN WIDENING)

BRIDGE SHEET NO. 10
 SHEET 470 OF 663 SHEETS

PLOTTED: Sat Jul 12 1997 11:08am FILENAME: X:\A96027\BR72\LEW\REV1\1R1.DWG SCALE: 60

SR 405 JOB NO. 7071 SHEET 11 OF 19

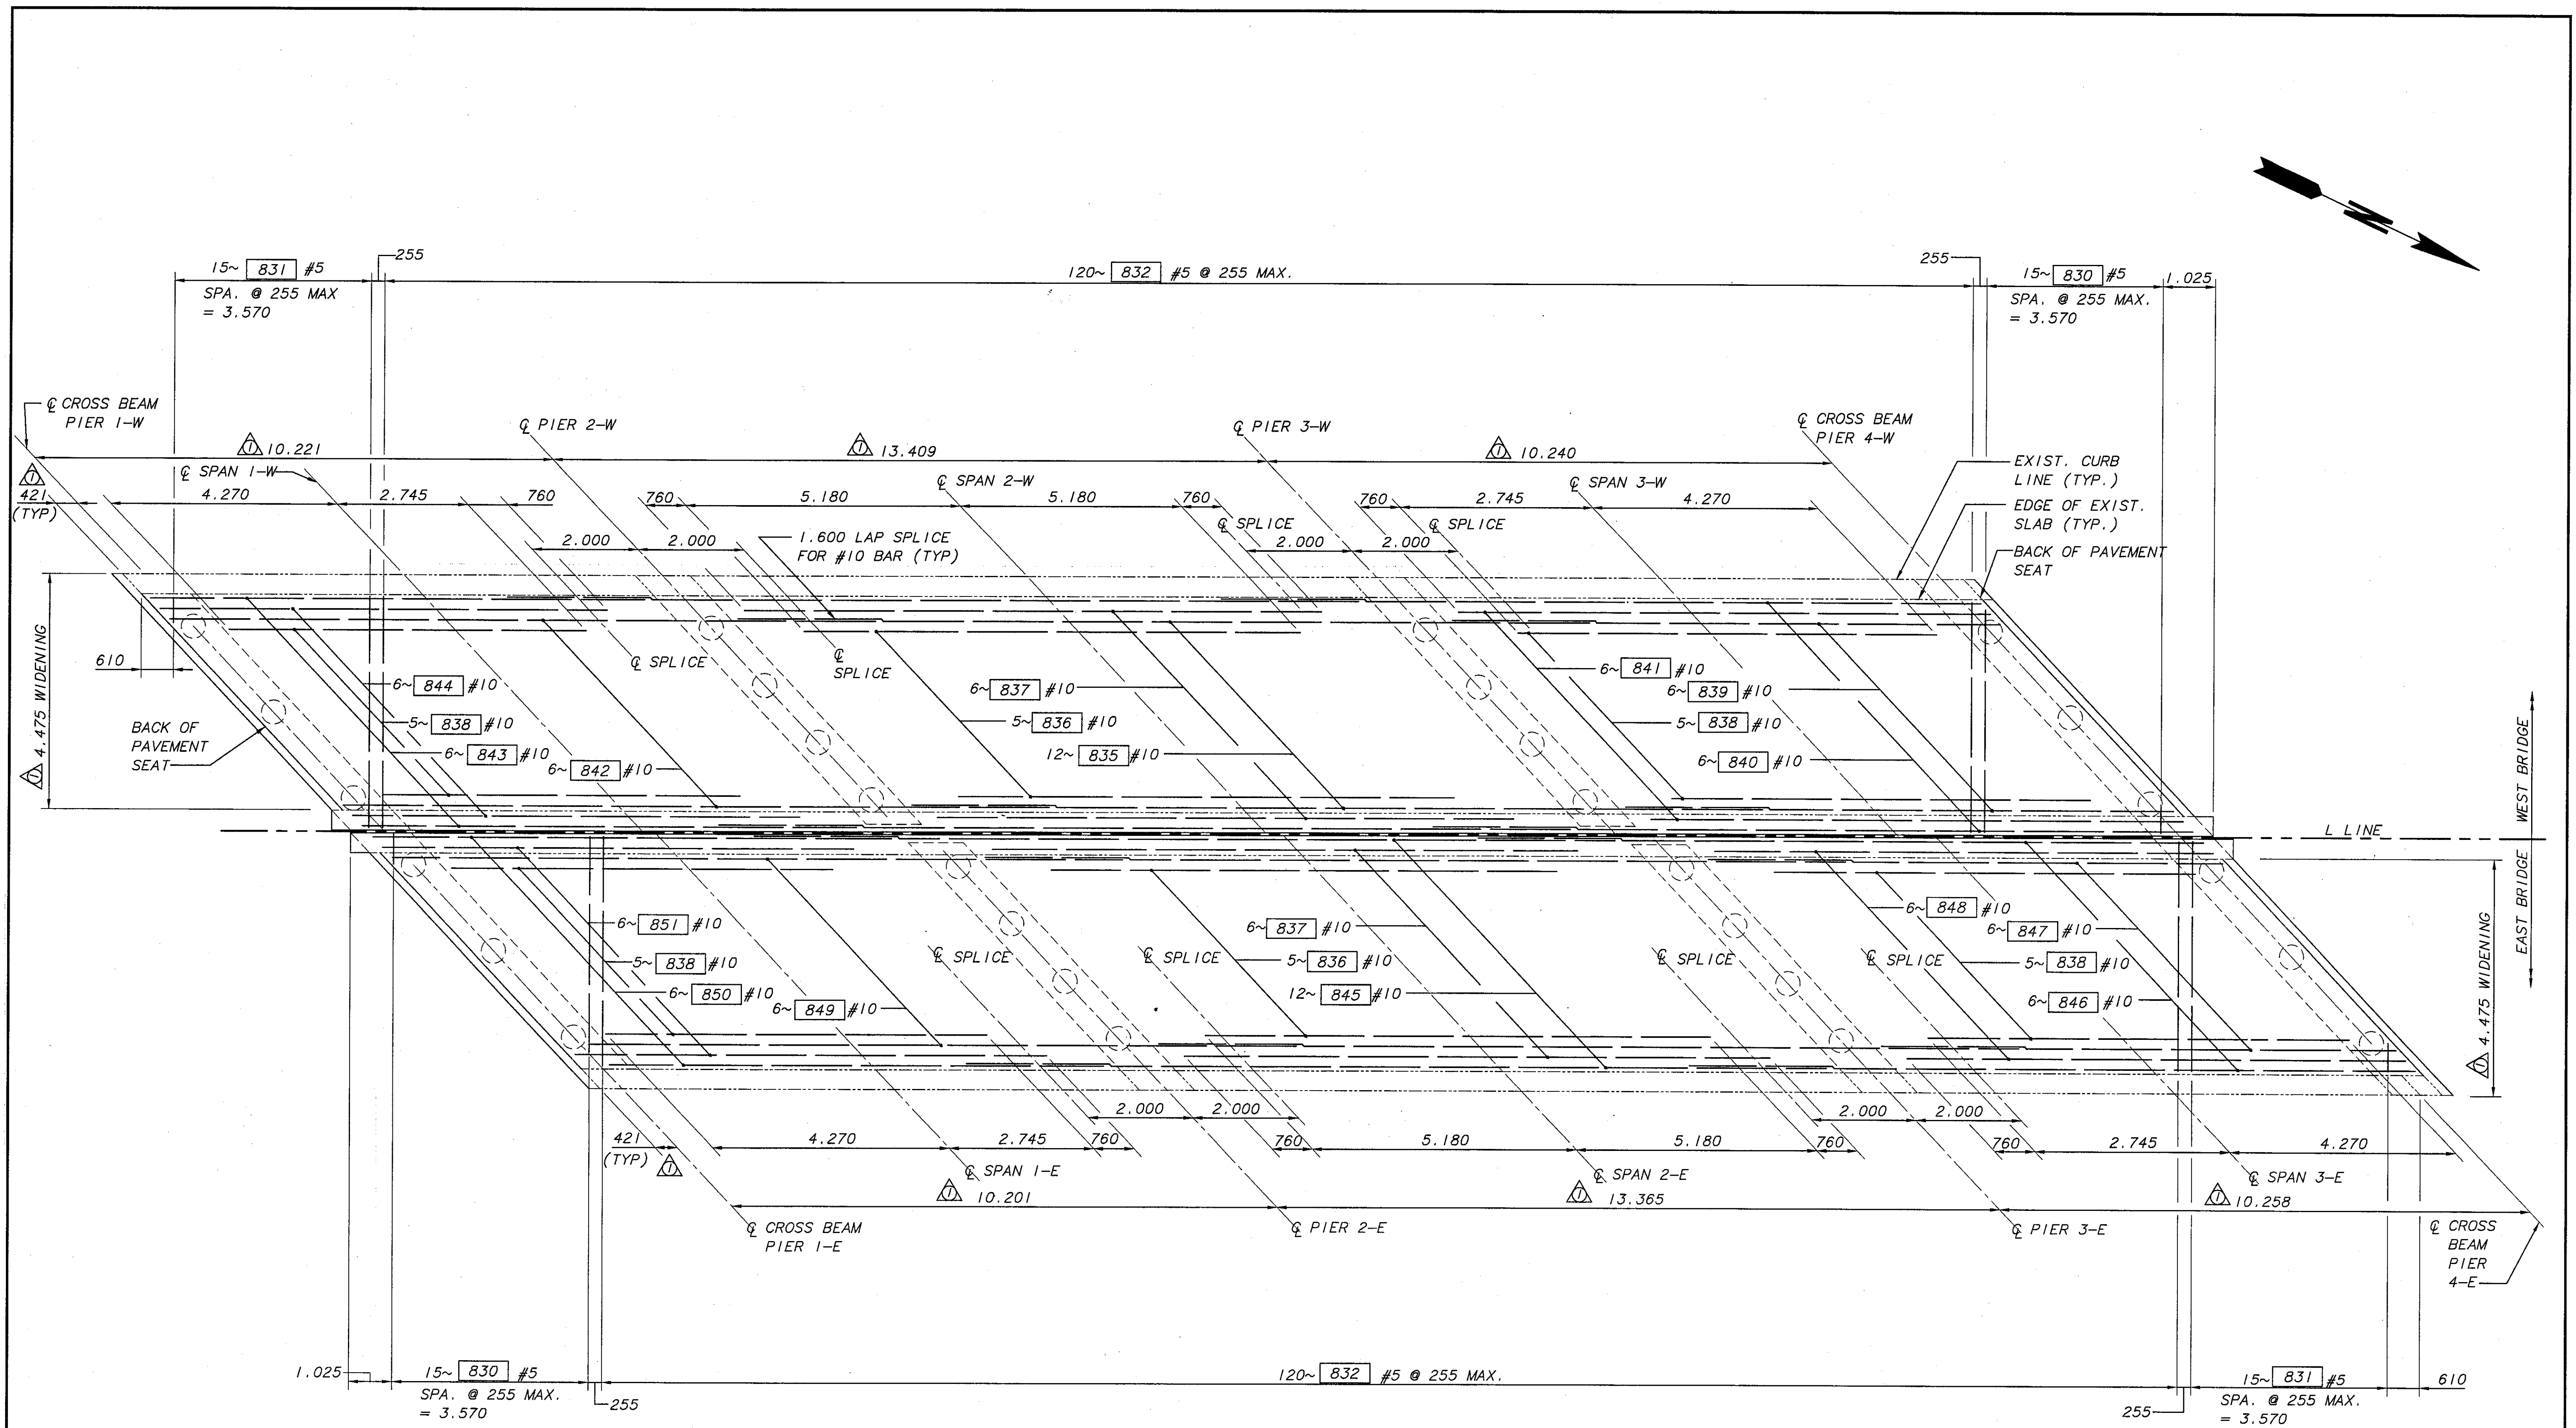


REINFORCEMENT PLAN - BOTTOM MAT (MEDIAN WIDENING)

(ALL DIMENSIONS MEASURED ALONG L LINE UNLESS OTHERWISE NOTED)

BRIDGE DESIGN ENGR					
SUPERVISOR					
DESIGNED BY	J. CHEN	6/96			
CHECKED BY	C. CORNELL	6/96			
DETAILED BY	T. BRENNAN	6/96			
BRIDGE PROJECTS ENGR					
PRELIM PLAN BY	7/97	CONTRACTOR SURVEY DATA - FIT EXISTING	NEW		
ARCHITECT/SPECIALIST	DATE	REVISION	BY	APPR	

REGION NO.	STATE	FED AID PROJ NO.	SHEET NO.	TOTAL SHEETS
10	WASH			
JOB NUMBER	96W035			
CONTRACT NO.	5054			

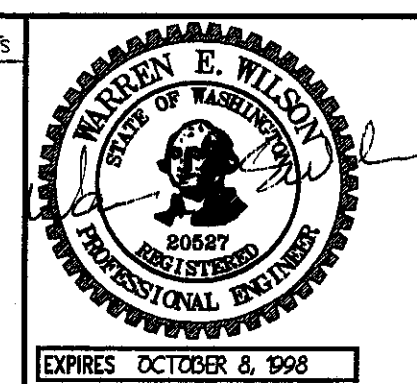

BERGER/ABAM
ENGINEERS INC.
33301 9TH AVENUE SOUTH
FEDERAL WAY, WASHINGTON 98003-8386
(206)431-2300 FAX: (206)431-2250




SR 405
BOTHELL TO SWAMP CREEK 1/C
HOV LANES - STAGE 1
NORTH CREEK BRIDGE 405/72 E-W
REINF. PLAN - BOTTOM MAT (MEDIAN WIDENING)


BRIDGE SHEET NO.	11
SHEET 471 OF 663 SHEETS	

PLOTTED: Fri Jul 11 1997 8:03pm FILENAME: X:\96077\BR72\EW\REV\12R1.DWG SCALE: 60

SR 405 JOB NO. 7071 SHEET 12 OF 19

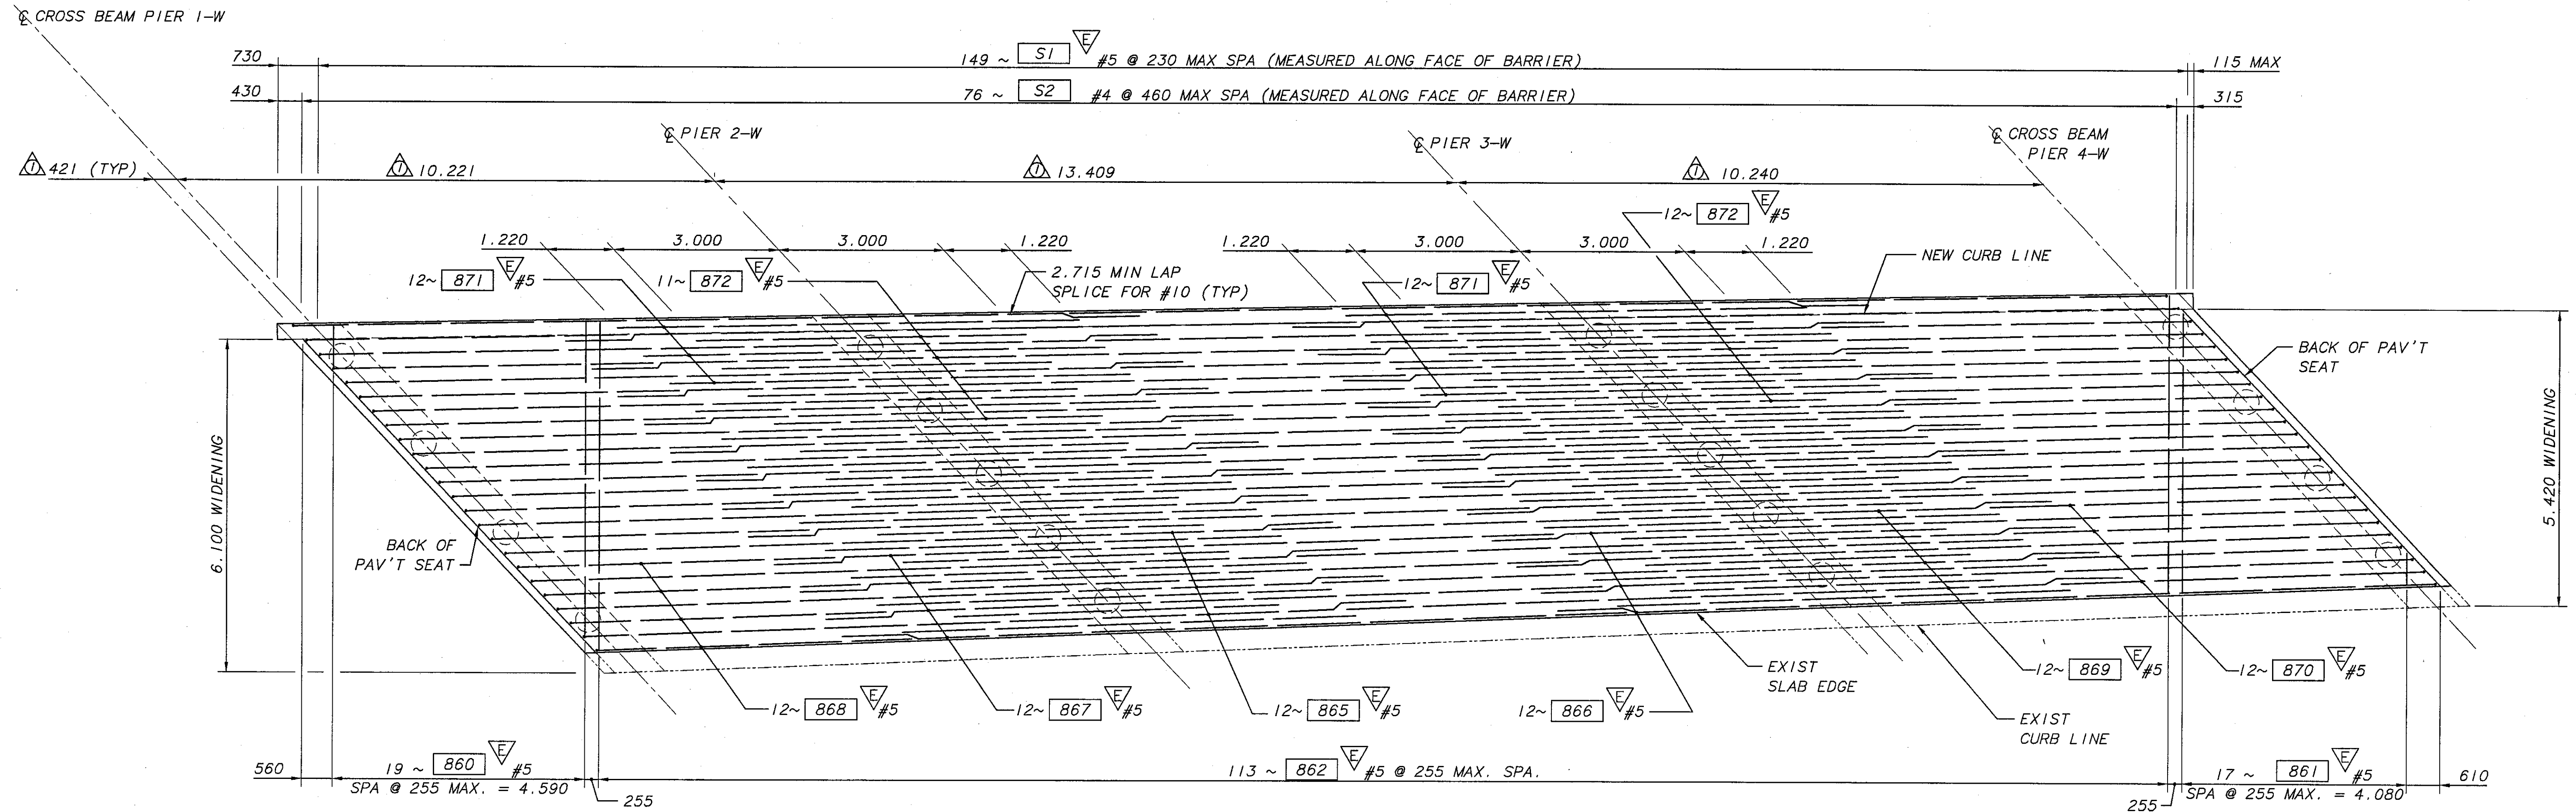

REINFORCEMENT PLAN - TOP MAT (OUTBOARD WIDENING)
 (ALL DIMENSIONS MEASURED ALONG L LINE UNLESS OTHERWISE NOTED)

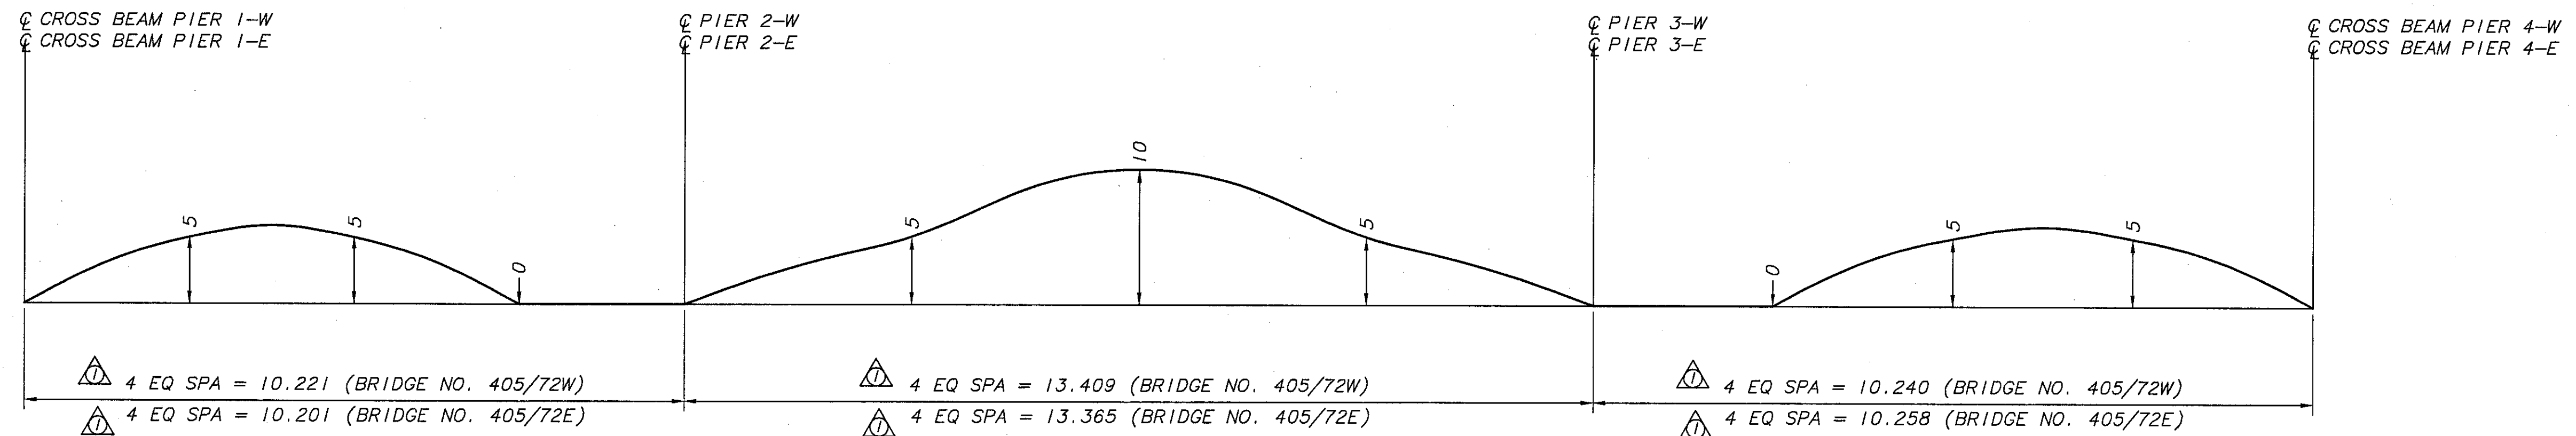


CAMBER DIAGRAM (BRIDGE 405/72 E & W)

NOTE: THIS DIAGRAM SHOWS THE DEAD LOAD CAMBER ONLY AND SHALL BE INCREASED BY THE AMOUNT OF ANTICIPATED TAKEUP IN THE FALSEWORK.
 (ALL DIMENSIONS ARE MEASURED ALONG Q L LINE)

BRIDGE DESIGN ENGR					
SUPERVISOR					
DESIGNED BY	J. CHEN	6/96			
CHECKED BY	C. CORNELL	6/96			
DETAILED BY	T. BRENNAN	6/96			
BRIDGE PROJECTS ENGR					
PRELIM PLAN BY					
ARCHITECT/SPECIALIST					

REGION	STATE	FED AID PROJ NO	SHEET	TOTAL SHEETS
10	WASH			
JOB NUMBER		96W035		
CONTRACT NO.		5054		

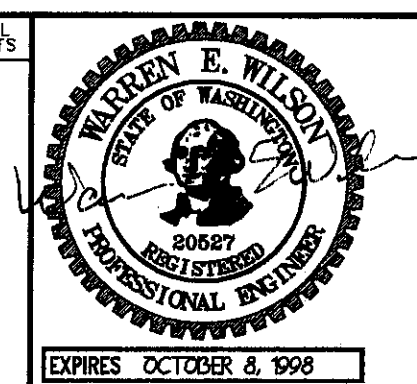

BERGER/ABAM
 ENGINEERS INC.
 33301 9TH AVENUE SOUTH
 FEDERAL WAY, WASHINGTON 98003-8385
 (206)451-2300 FAX: (206)451-2280




SR 405
 BOTHELL TO SWAMP CREEK I/C
 HOV LANES - STAGE 1
 NORTH CREEK BRIDGE 405/72 E-W
 REINF. PLAN - TOP MAT (OUTBOARD WIDENING)

BRIDGE SHEET NO. **12**
 SHEET 472 OF 663 SHEETS

PLOTTED: Fri Jul 11 1997 8:05pm FILENAME: X:\A9607\BR72\EW\REV1\3R1.DWG SCALE: 60


SR 405 JOB NO. 7071 SHEET 13 OF 19

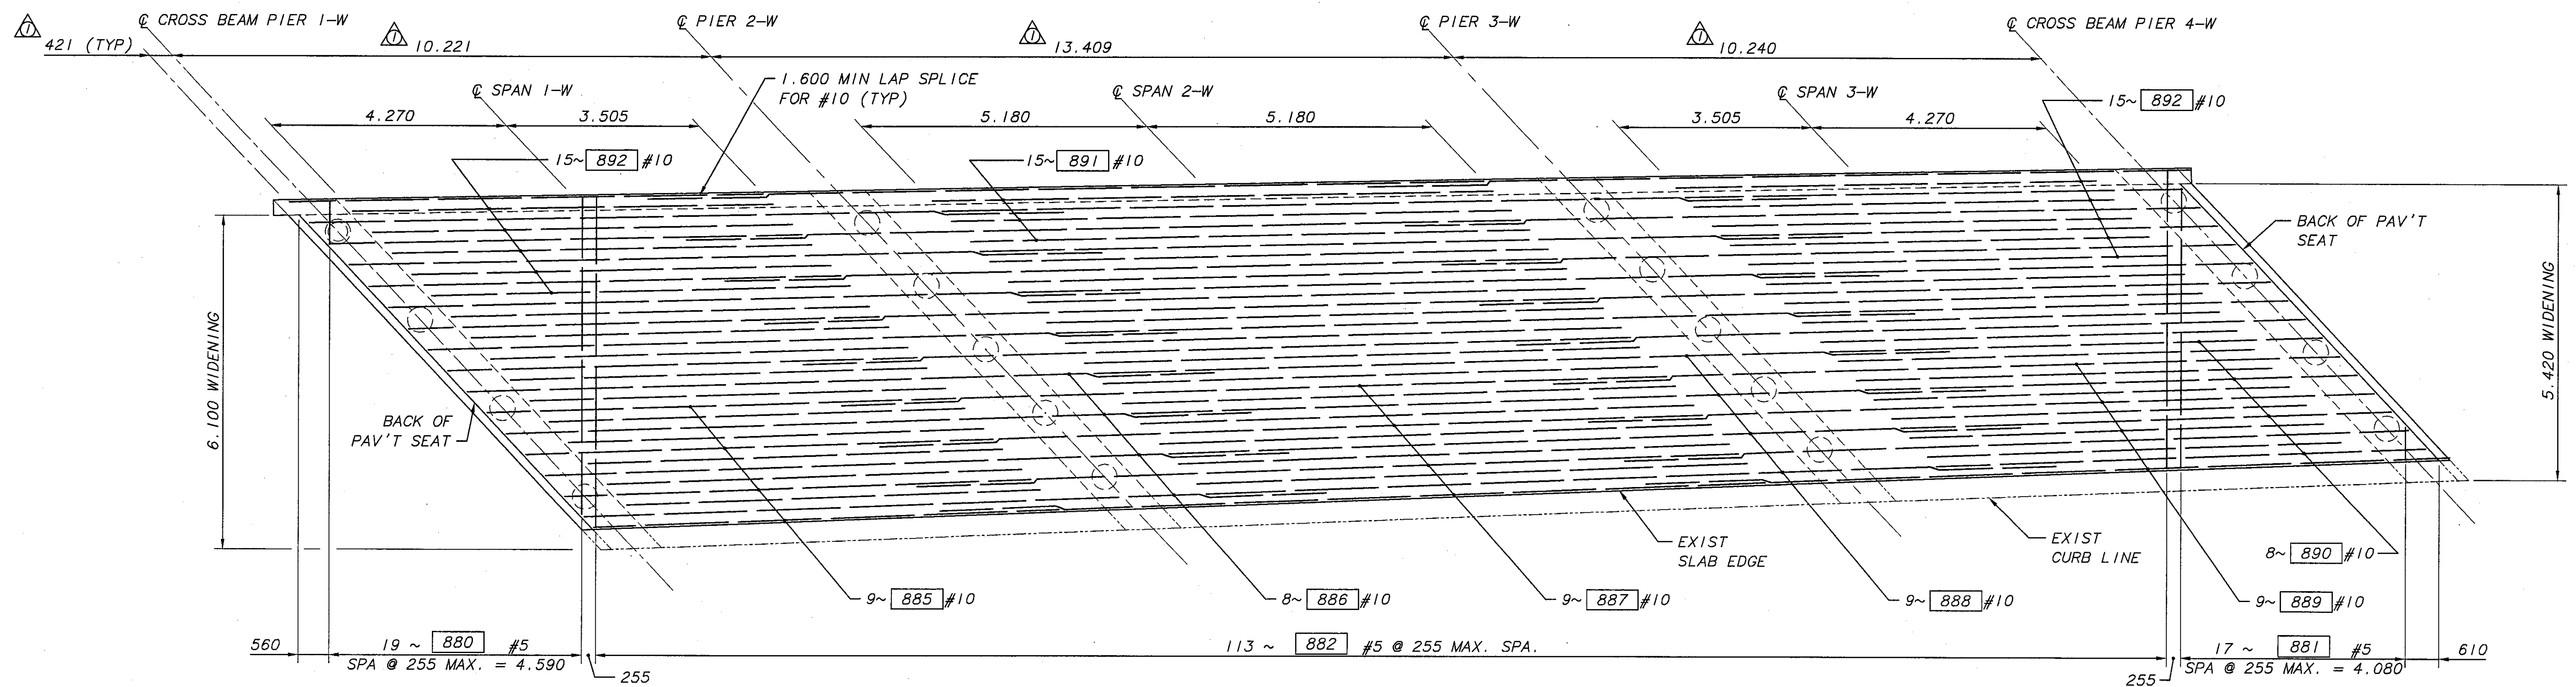

REINFORCEMENT PLAN - BOTTOM MAT (OUTBOARD WIDENING)
 (ALL DIMENSIONS MEASURED ALONG L LINE UNLESS OTHERWISE NOTED)

BRIDGE DESIGN ENGR					
SUPERVISOR					
DESIGNED BY	J. CHEN	6/96			
CHECKED BY	C. CORNELL	6/96			
DETAILED BY	T. BRENNAN	6/96			
BRIDGE PROJECTS ENGR					
PRELIM PLAN BY	7/97	CONTRACTORS SURVEY DATA- FIT EXISTING	WEW		
ARCHITECT/SPECIALIST	DATE	REVISION	BY	APPR	

REGION NO.	STATE	FED AID PROJ NO.	SHEET NO.	TOTAL SHEETS
10	WASH			
JOB NUMBER		CONTRACT NO.		
96W035		5054		

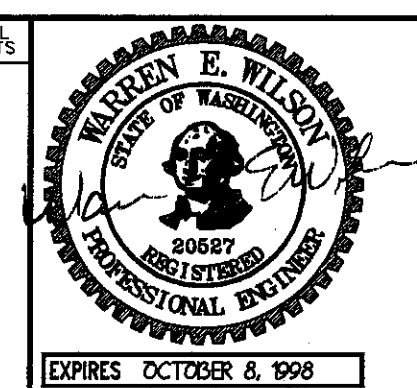


BERGER/ABAM
 ENGINEERS INC.
 33301 9TH AVENUE SOUTH
 FEDERAL WAY, WASHINGTON 98003-8388
 (206) 451-0300 FAX: (206) 451-0200




SR 405
 BOTHELL TO SWAMP CREEK I/C
 HOV LANES - STAGE 1
 NORTH CREEK BRIDGE 405/72 E-W
 REINF. PLAN - BOT. MAT (OUTBOARD WIDENING)

BRIDGE SHEET NO. **13**
 SHEET 473 OF 663 SHEETS

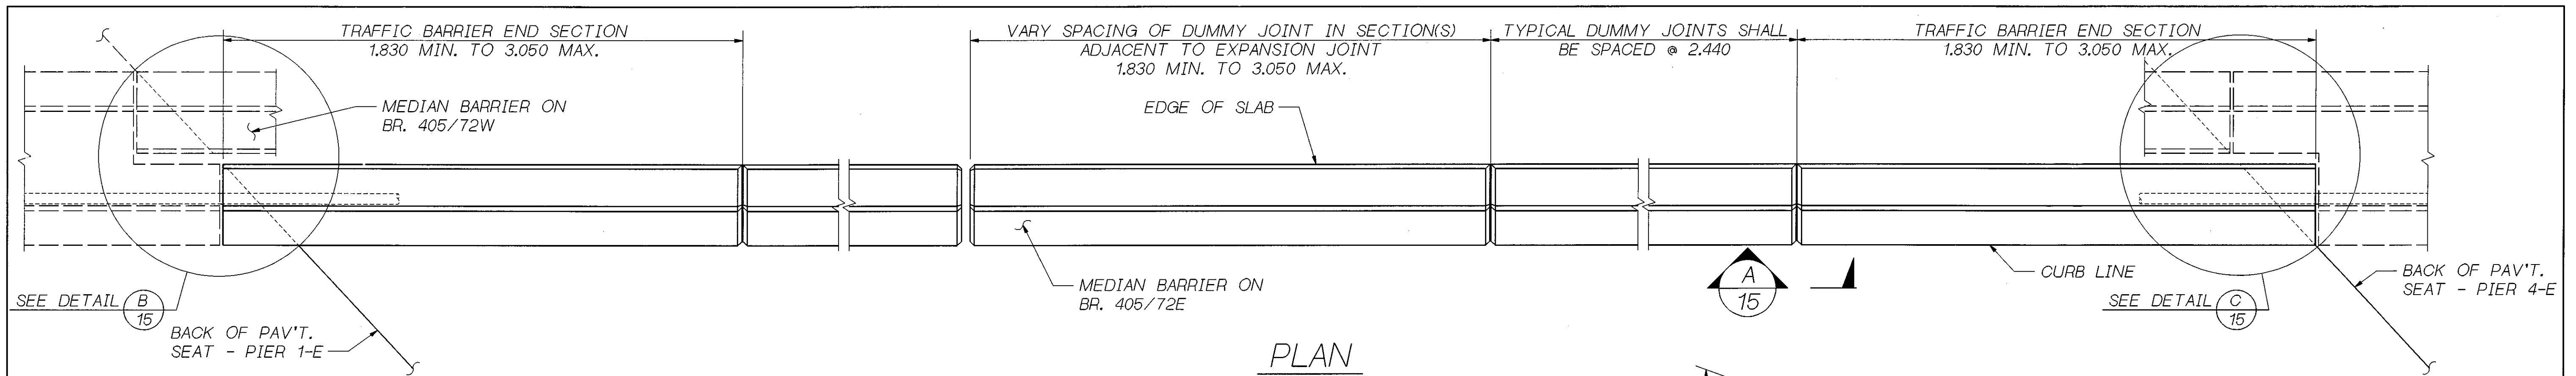



PLAN TRAFFIC BARRIER

BARRIER CONTINUOUS BETWEEN ROADWAY EXPANSION JOINTS. CONSTRUCTION JOINTS WITH SHEAR KEYS ARE PERMISSIBLE AT DUMMY JOINT LOCATIONS. FORM JOINTS BETWEEN DUMMY JOINTS SHALL NOT BE PERMITTED.

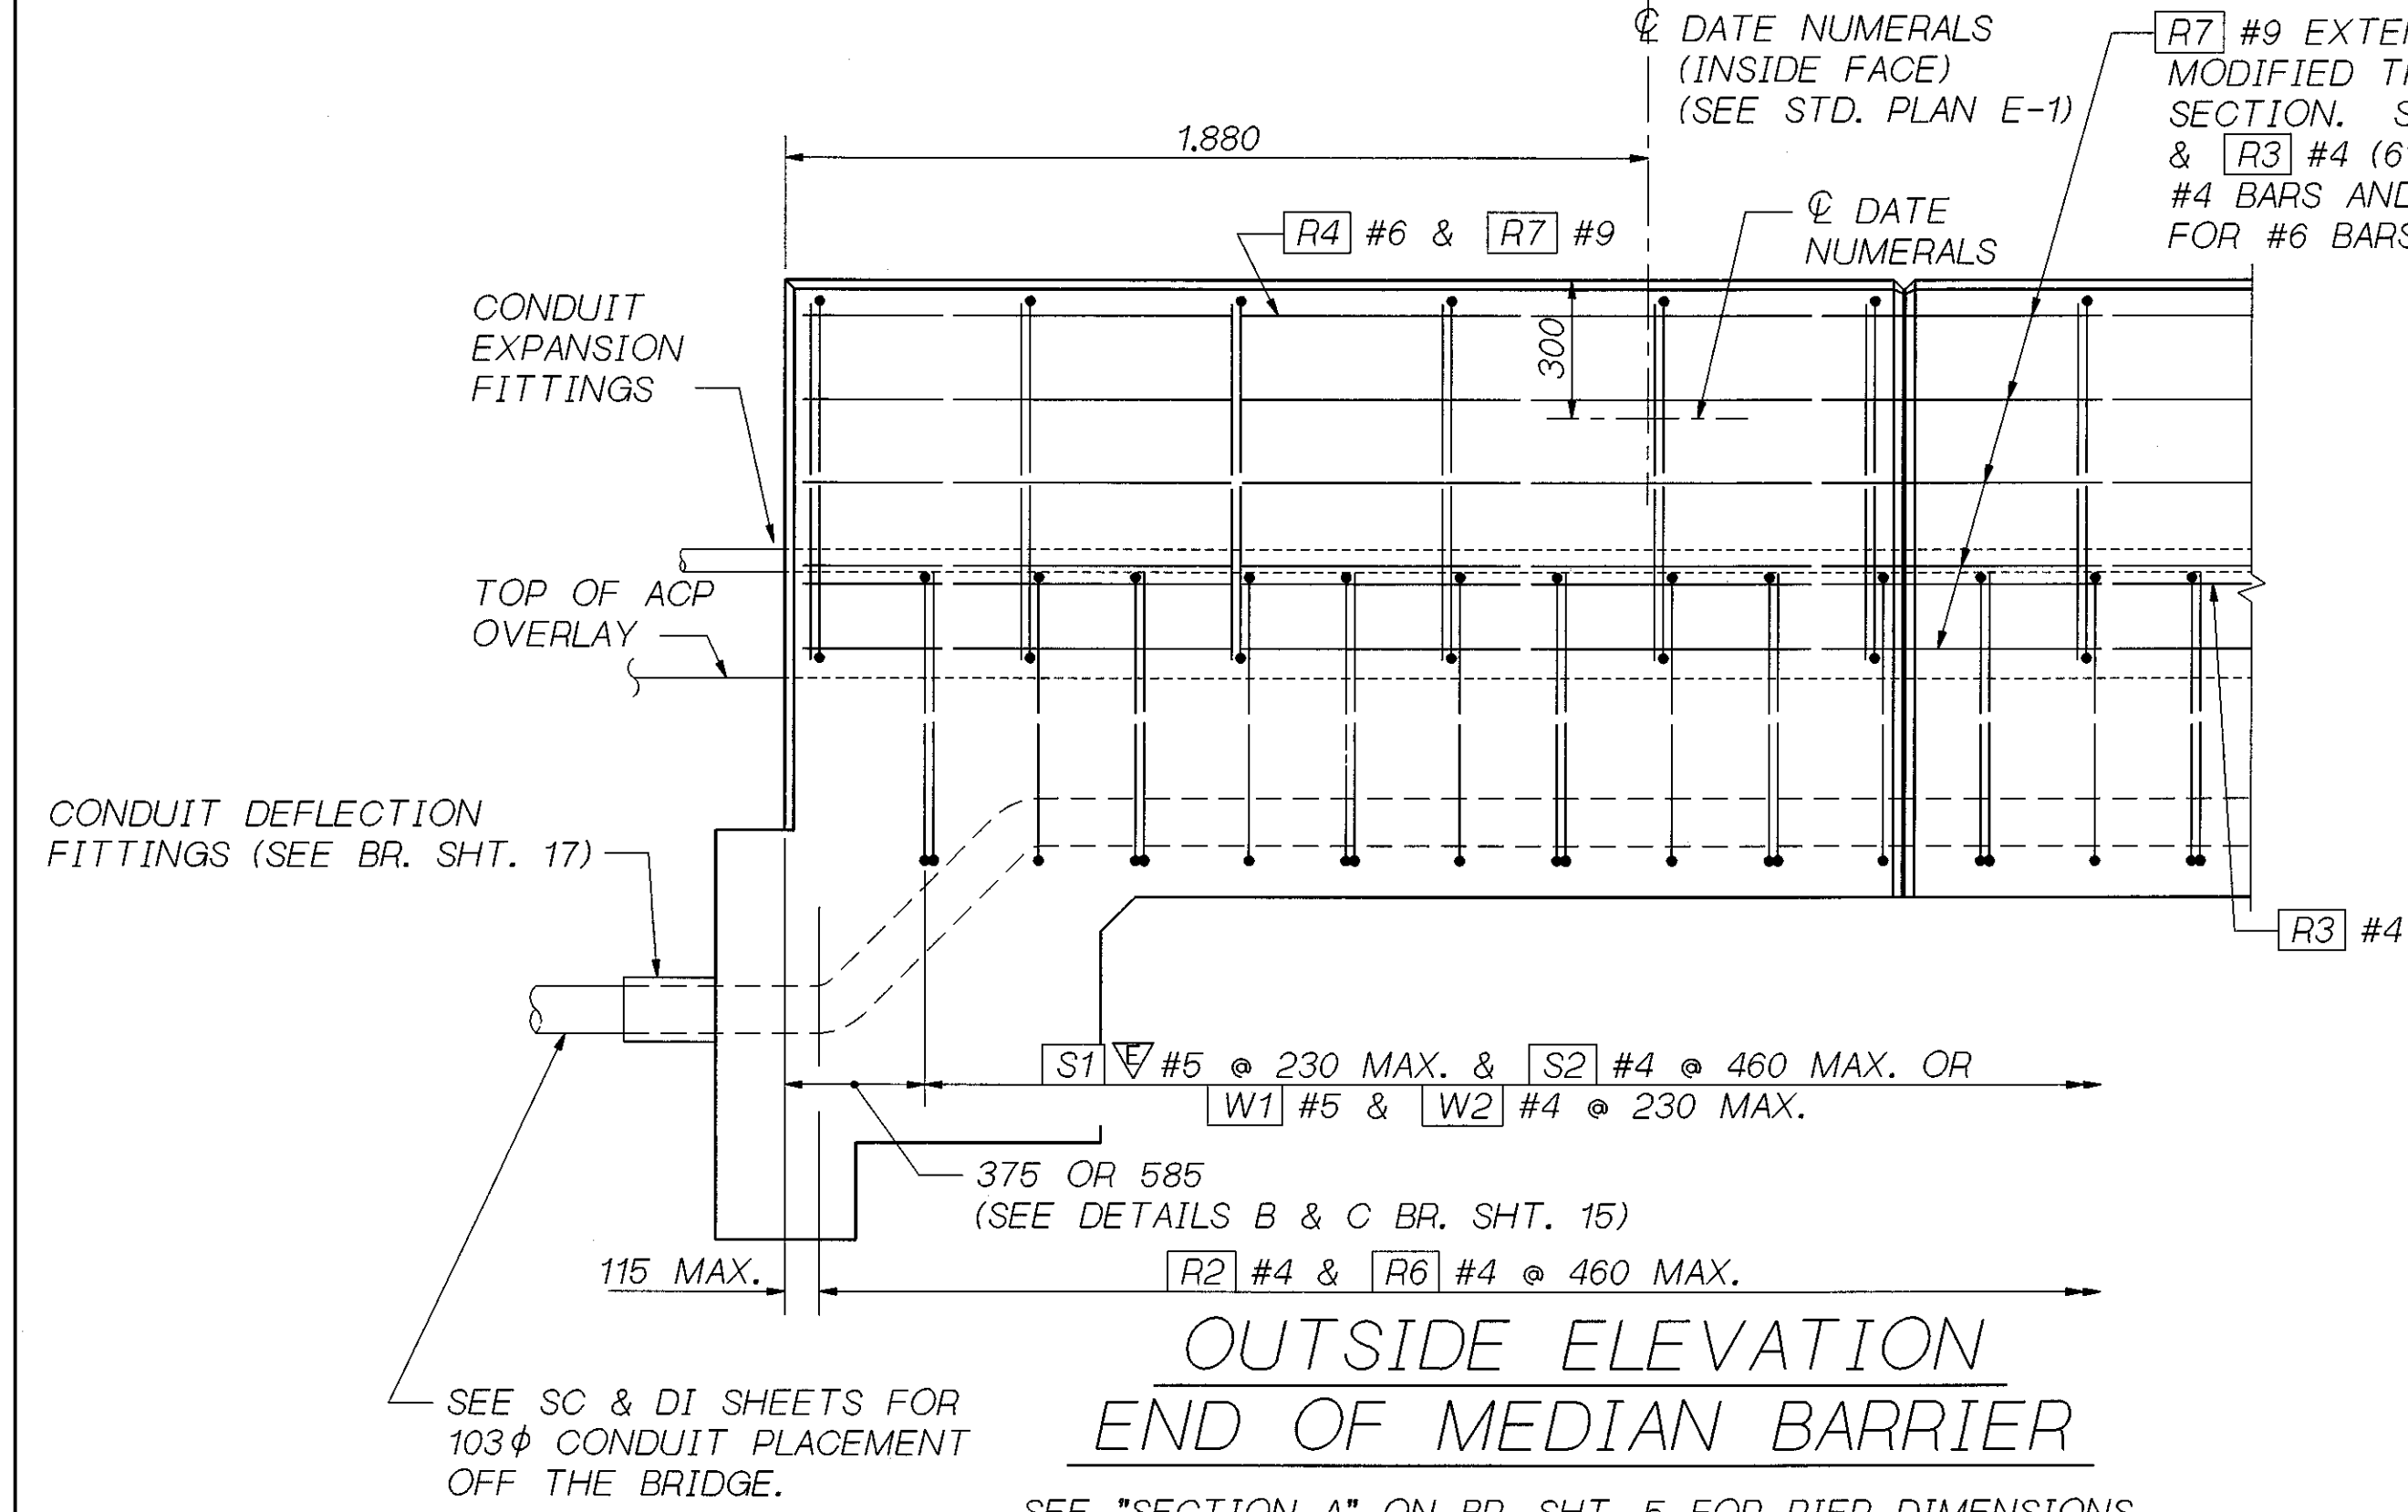

OUTSIDE ELEVATION END OF MEDIAN BARRIER

SEE "SECTION A" ON BR. SHT. 5 FOR PIER DIMENSIONS.

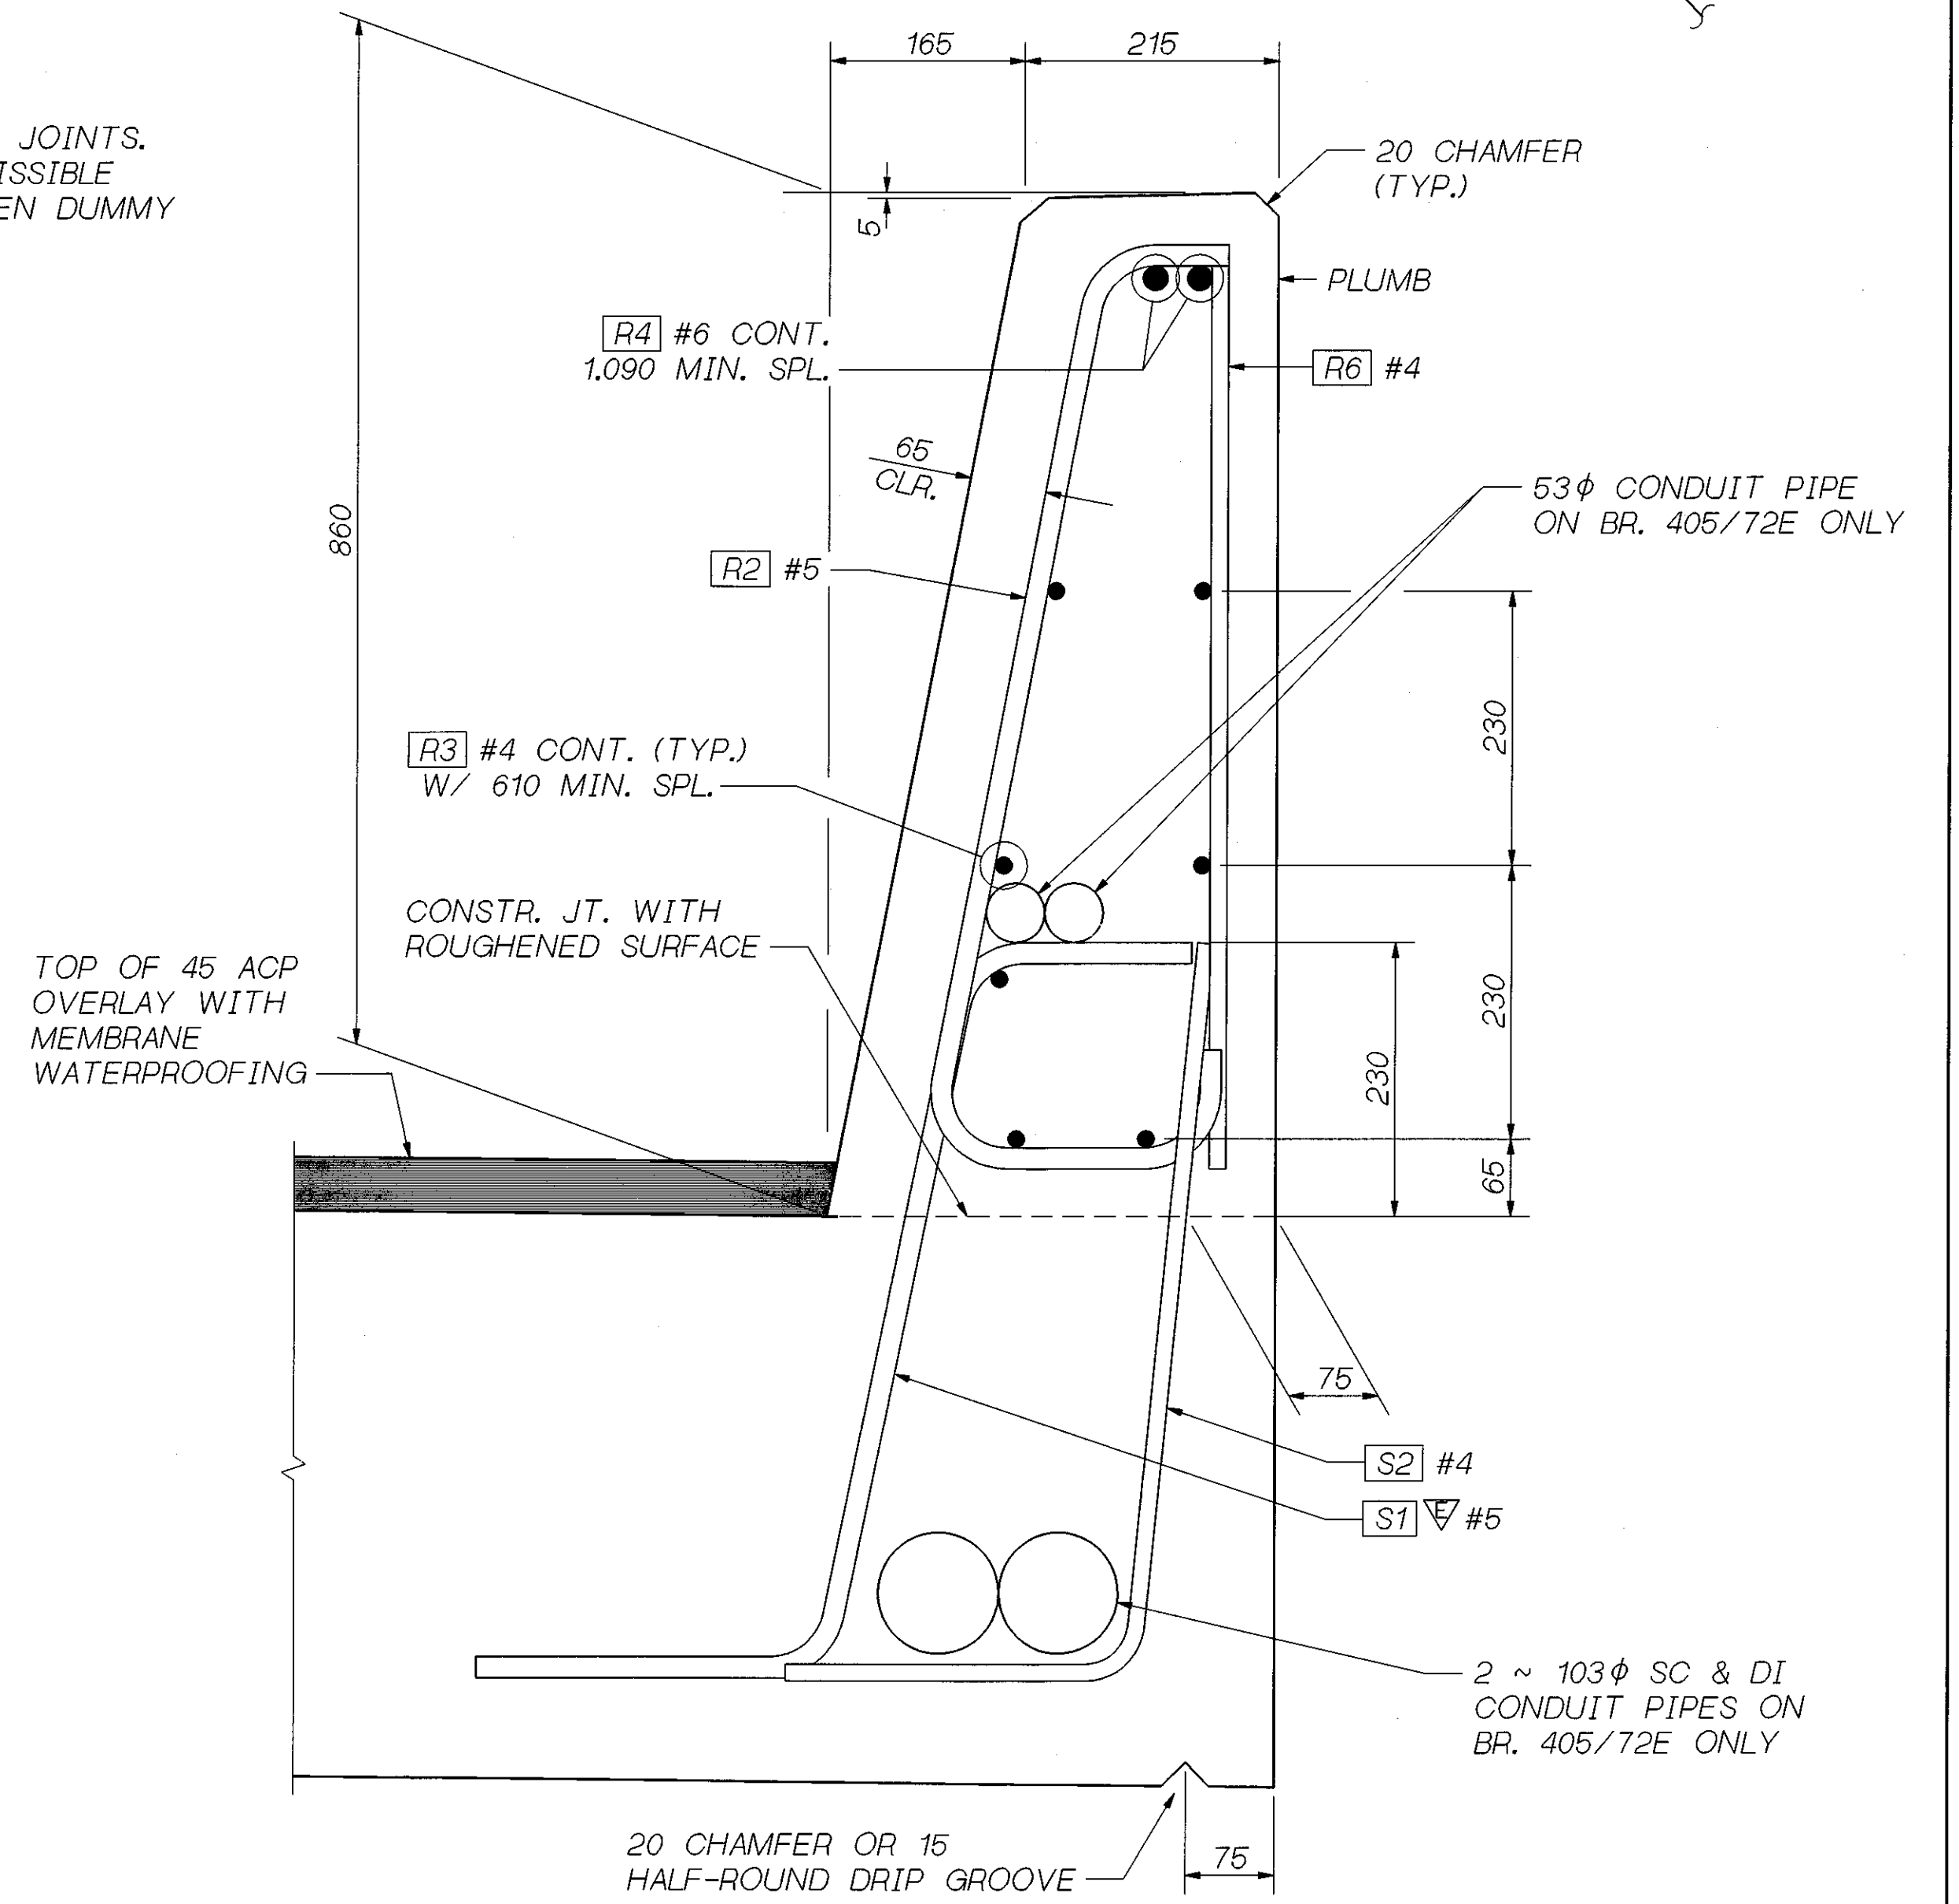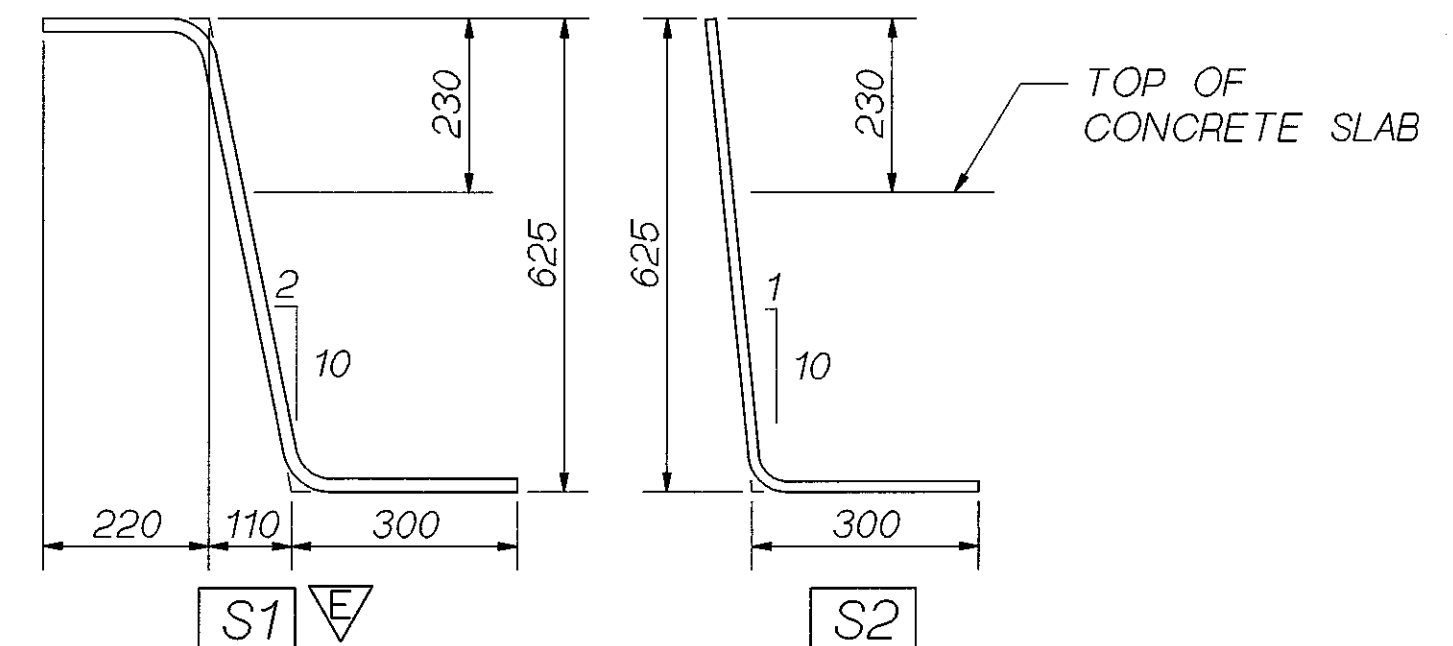


TYPICAL SECTION - MEDIAN BARRIER

MEDIAN BARRIER FOR BR. 405/72W SHOWN, MEDIAN BARRIER FOR BR. 405/72E SIMILAR.

SR 405 JOB NO. 7071 SHEET 14

Bridge Design Engr.	S405D72R00T:[000900.FGB]TB_MED_1.FGB:1	REGION NO.	STATE	FED. AID PROJ. NO.	SHEET NO.	TOTAL SHEETS
Supervisor			10 WASH.			
Designed By	J. CHEN 6/96					
Checked By	C. CORNELL 6/96					
Detailed By	D.W. PULSE JR. 6/96					
Bridge Projects Engr.						
Prelim. Plan By						
Architect/Specialist	DATE	REVISION	BY	APP'D	5054	

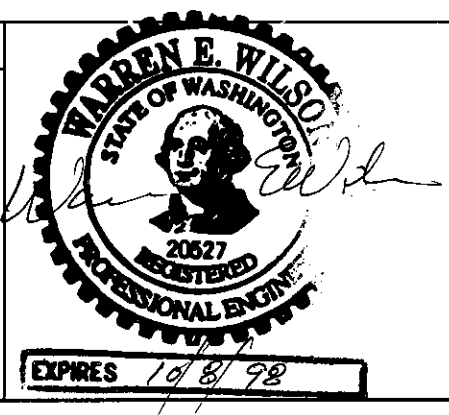


SR 405
BOTHELL TO SWAMP CREEK 1/2
HOV LANES - STAGE 1
NORTH CREEK BRIDGE 405/72 E-W
MEDIAN BARRIER 1 OF 2


BRIDGE SHEET NO.	14
SHEET OF	474
SHEETS	663

2/11/52

STANDARD DATE NUMERALS
(NO DATE PANEL)
ON RIGHT OF APPROACH SIDE(S)

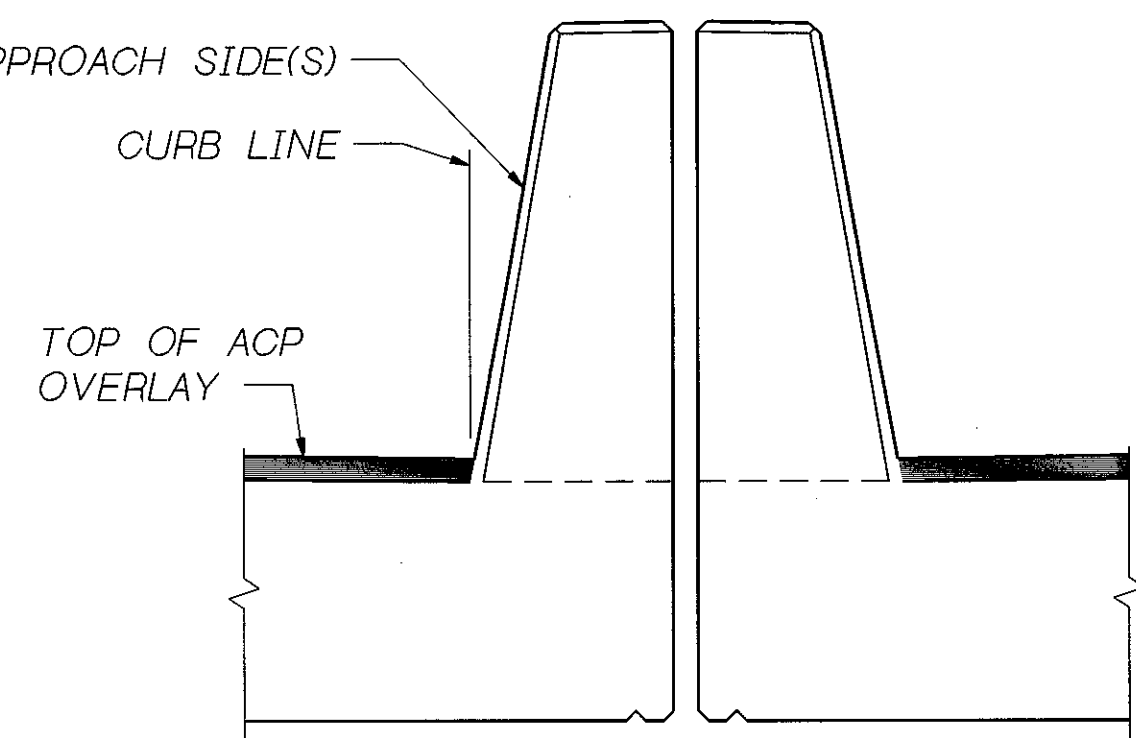


END VIEW

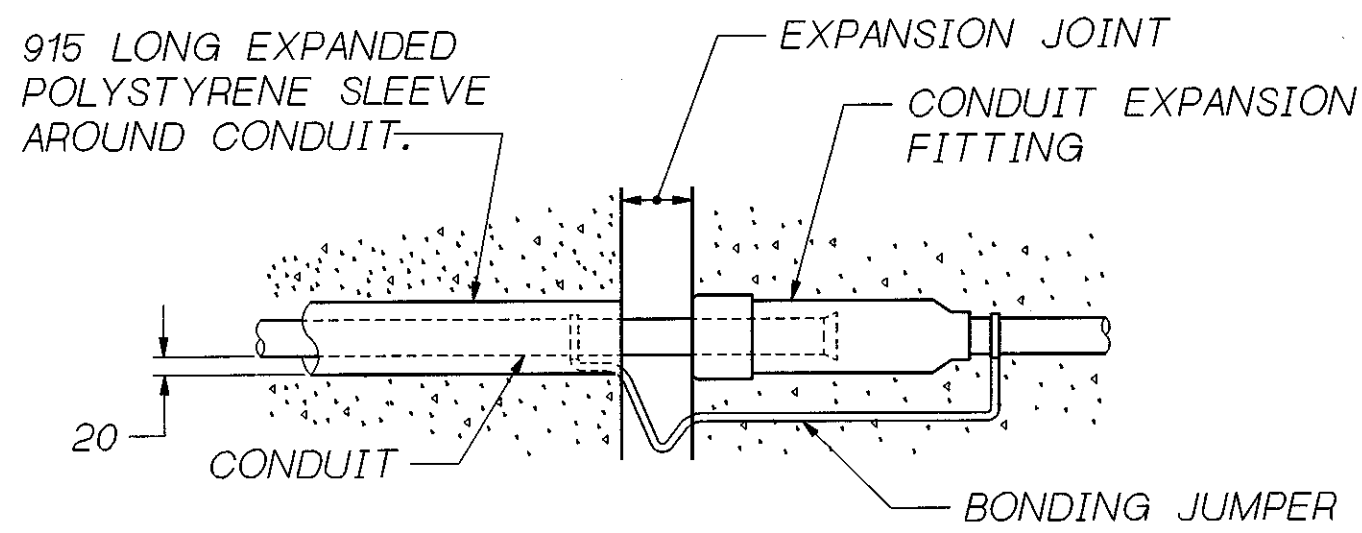


CONDUIT EXPANSION FITTING

TYPE AX CONDUIT FITTING FOR MOVEMENT OF ± 50 MAX.
FOR BRIDGE EXPANSION JOINTS AT PIERS 1-E, 4-E, 1-W & 4-W

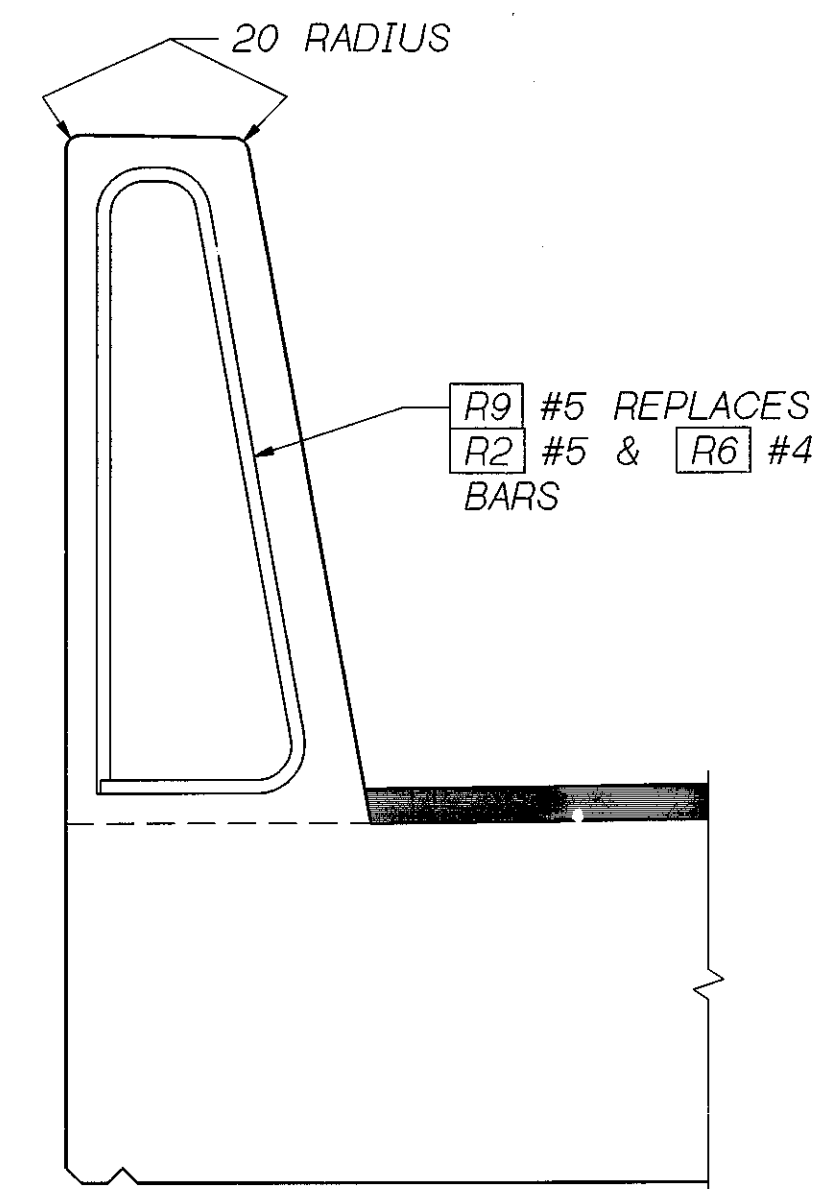


SLIPFORM ALTERNATE


SEE TYPICAL SECTION - TRAFFIC BARRIER FOR ADDITIONAL DETAILS.

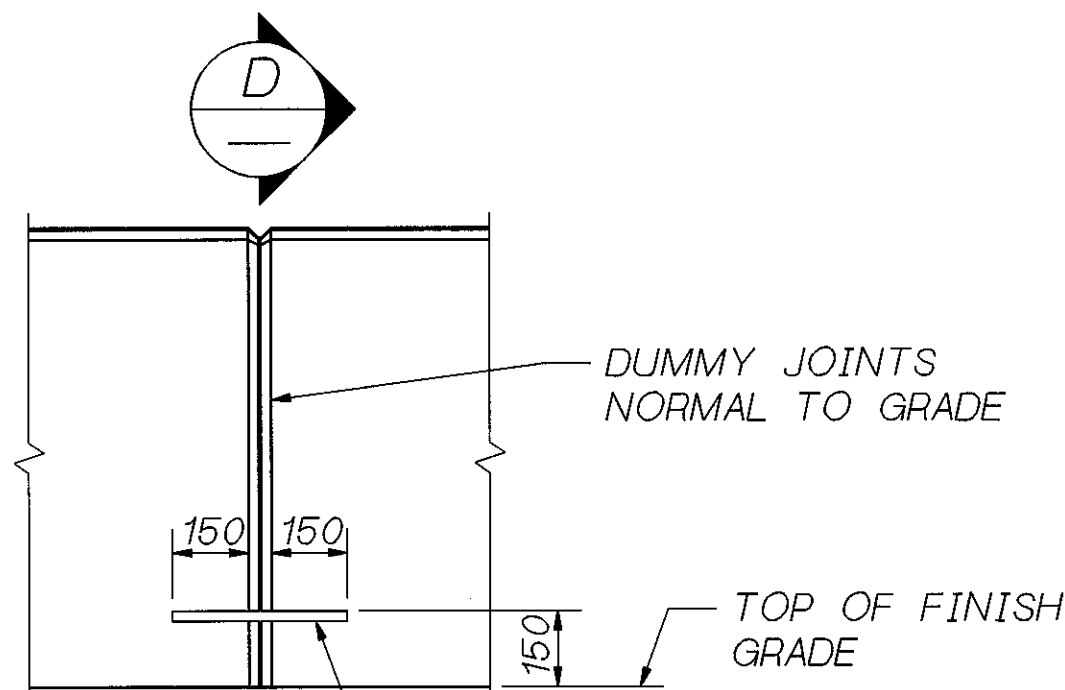

VIEW A
14

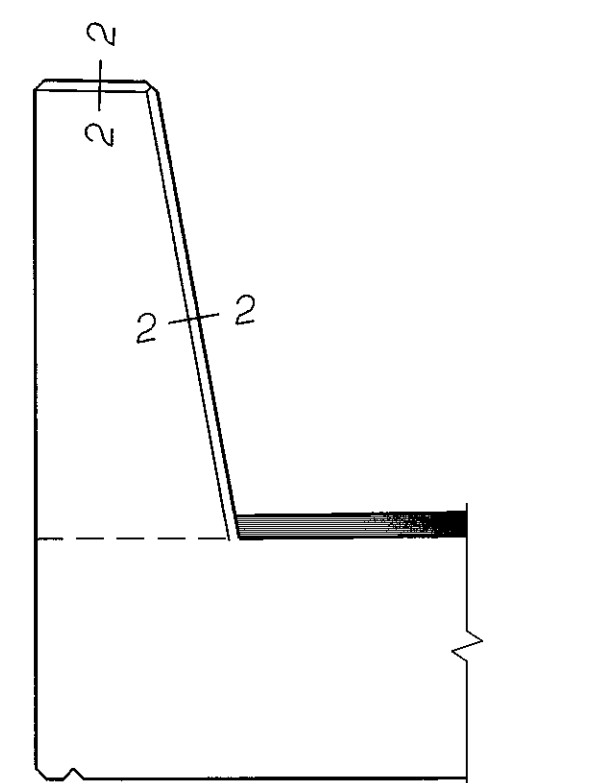

SECTION D
14

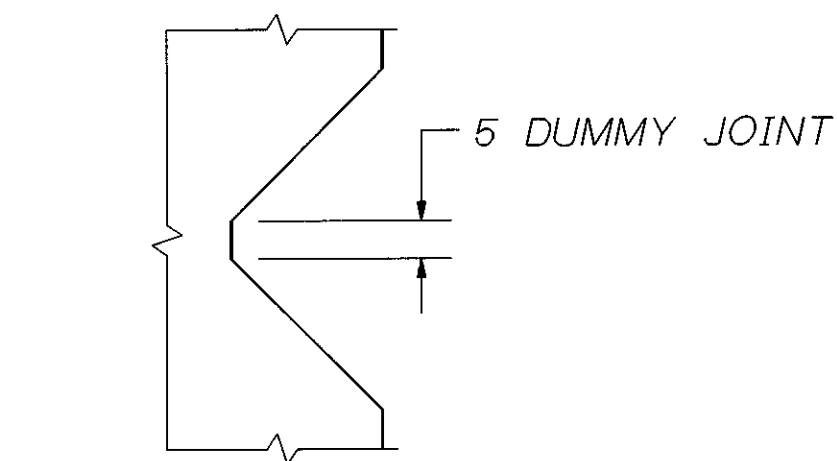

SECTION 2-2

NOTE: CONCRETE SURFACE CONSTRUCTION TOLERANCE OF 5 mm IN 3.000 (MAX.) IS REQ'D. FOR TRAFFIC SIDE OF BARRIER.


∇ : EPOXY COATED ≠ DIMENSIONS TO POINTS OF INTERSECTION.

TRAFFIC BARRIER BAR LIST

ALL REINFORCING SHALL BE AASHTO M31, GR. 60.


MARK SIZE LENGTH BENDING DIAGRAM (ALL DIMENSIONS ARE OUT TO OUT)

MARK	SIZE	LENGTH	BENDING DIAGRAM (ALL DIMENSIONS ARE OUT TO OUT)
R2	5	1,265	
R3	4	(A)	STR.
R4	6	(A)	STR.
R6	4	775	STR.
R7	9	4,265	STR.
R9	5	1,940	

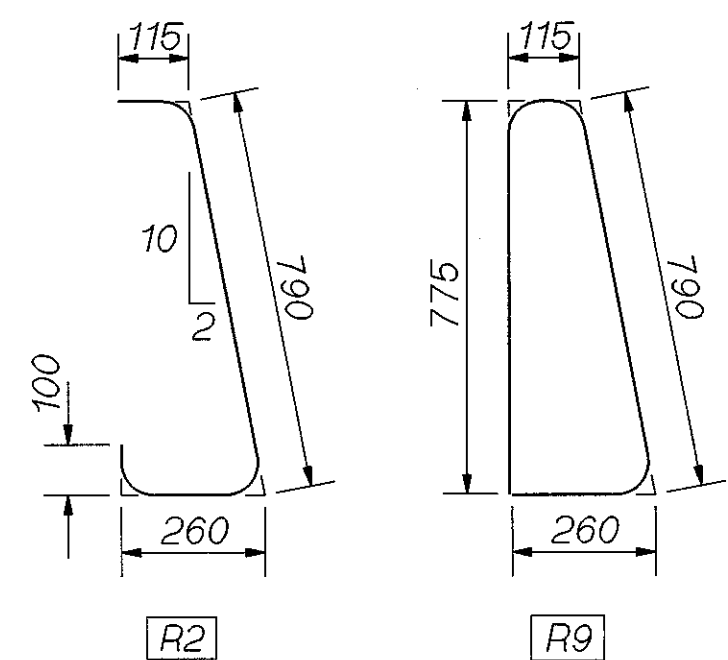


(A) DETERMINE FROM PLANS

FOR S1∇ & S2 BARS SEE BARLIST.

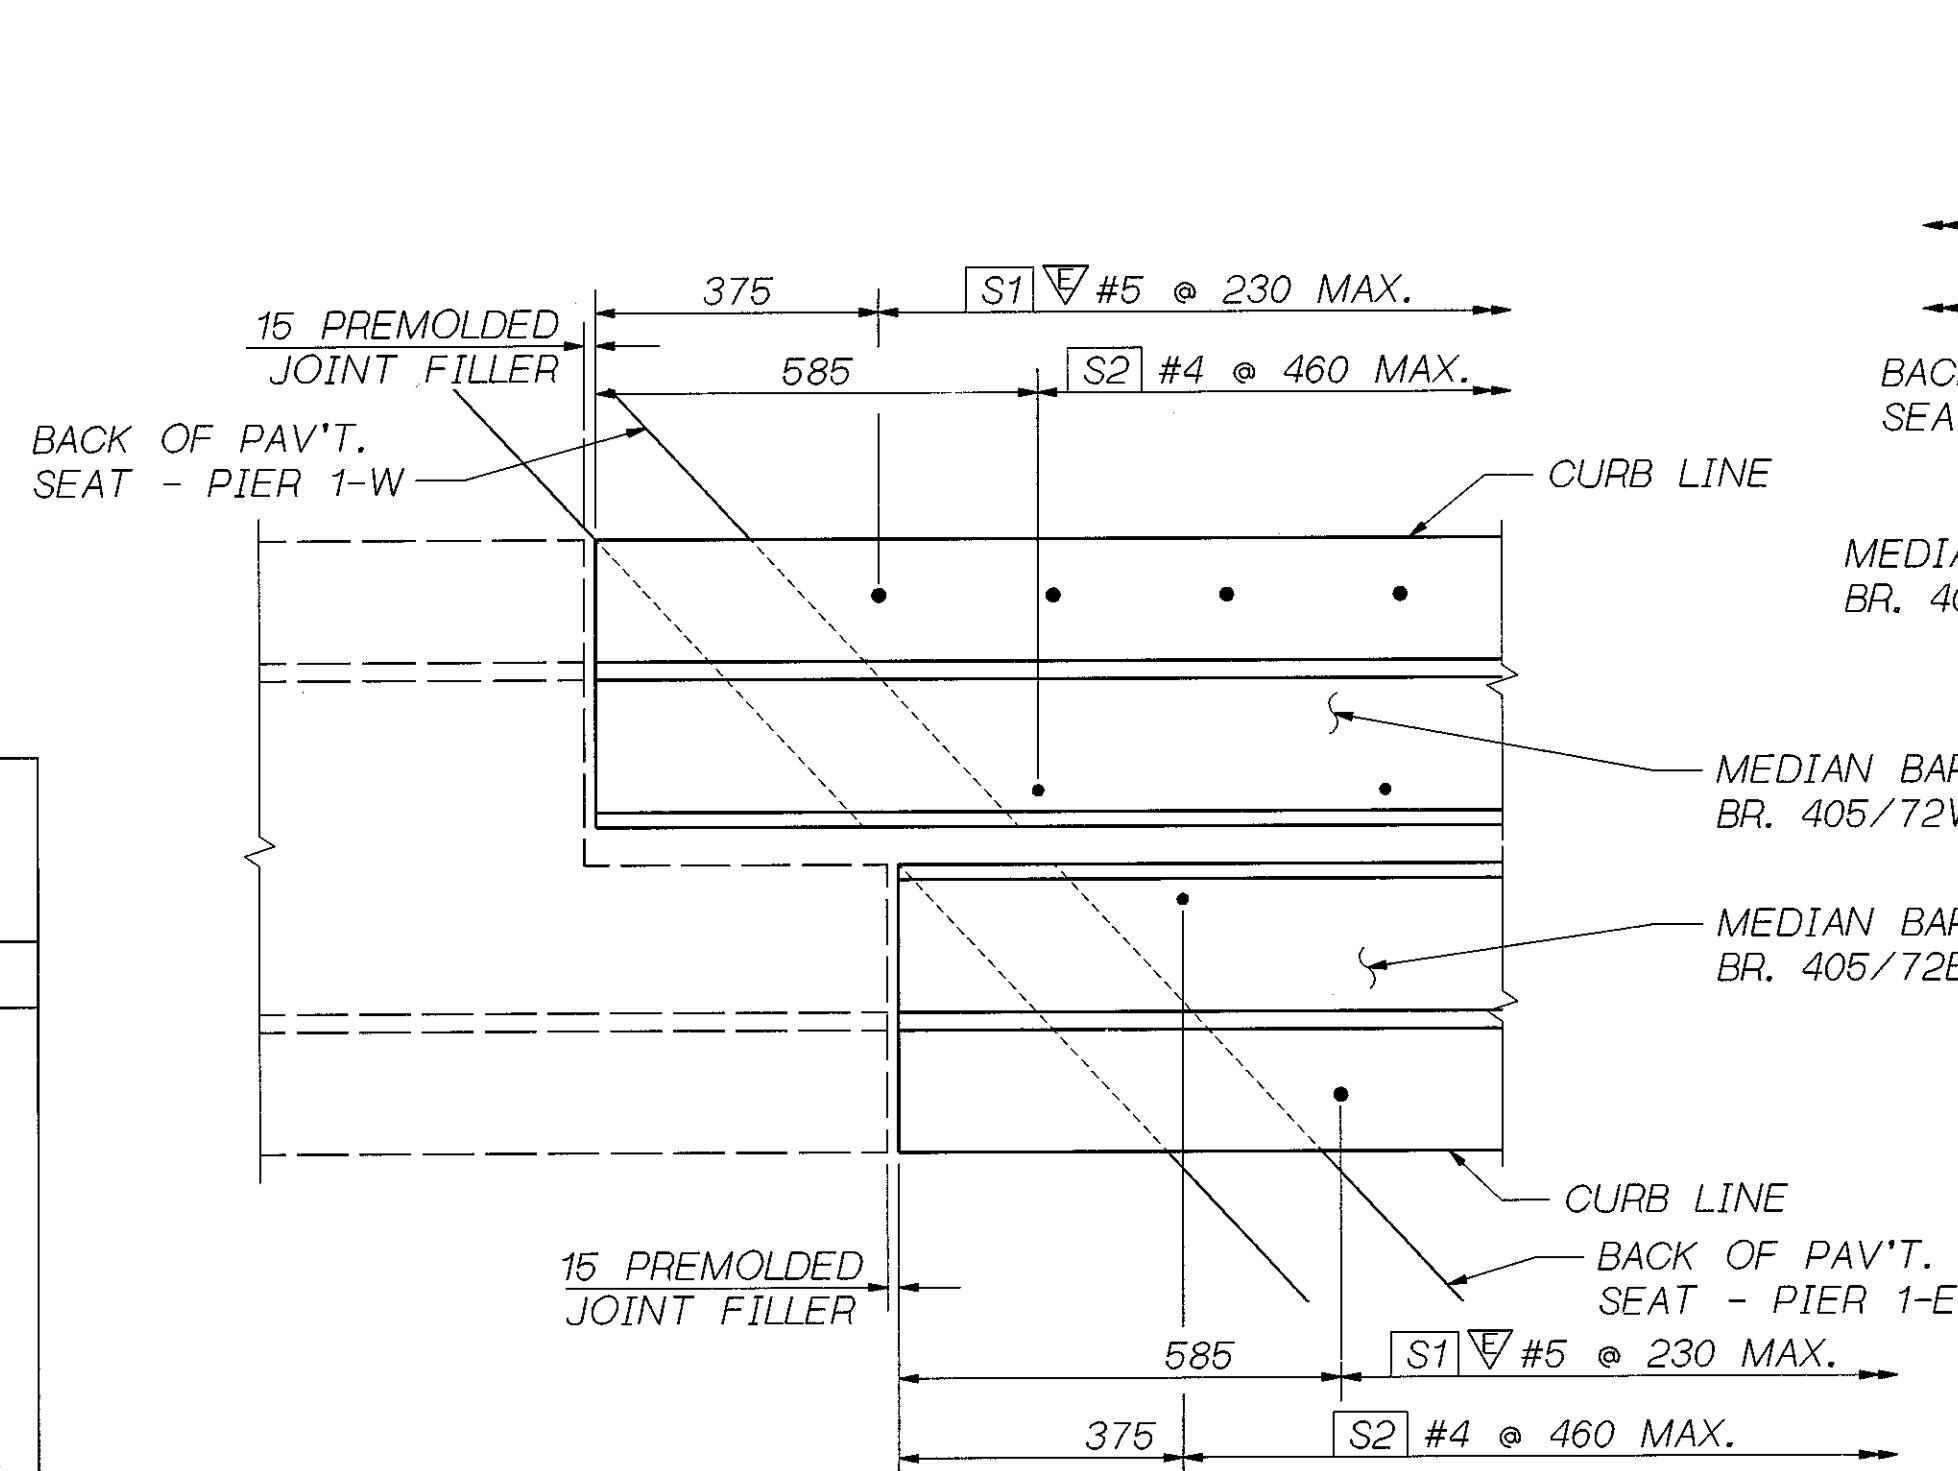


DETAIL B
14

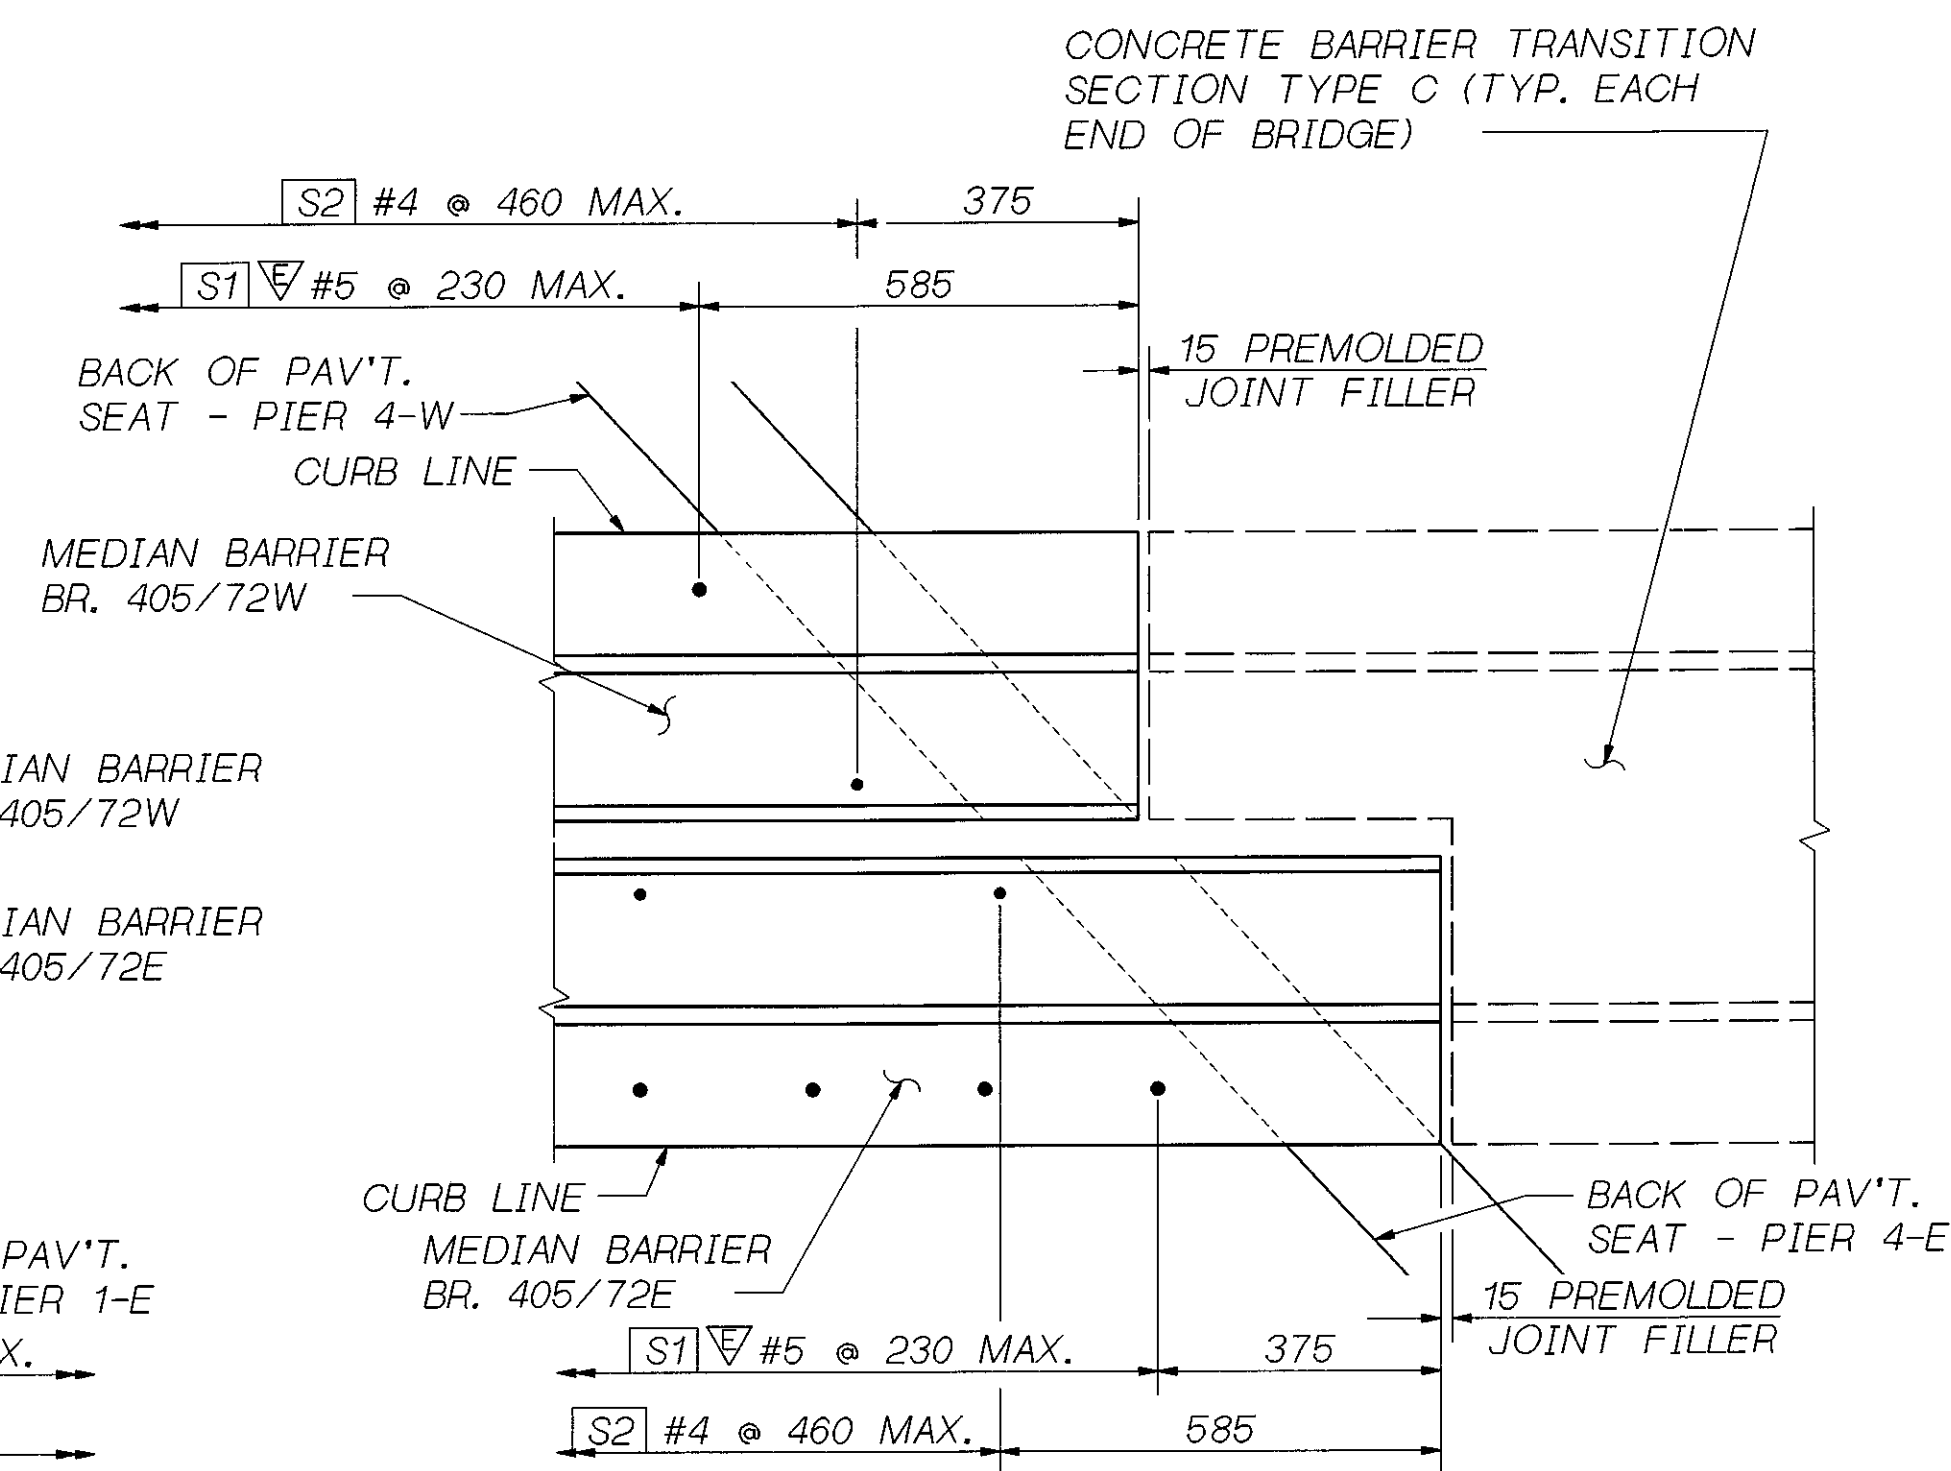

DETAIL C
14

JOB NO. 15 SHEET 15


Bridge Design Engr.	S405D72R00T: (000000.FGB) TB_MED_2.FGB:1	REGION NO.	STATE	FED. AID PROJ. NO.	SHEET NO.	TOTAL SHEETS
Supervisor			10 WASH.			
Designed By	J. CHEN					
Checked By	C. CORNELL					
Detailed By						
Bridge Projects Engr.						
Prelim. Plan By						
Architect/Specialist		DATE	REVISION	BY	APP'D	5054

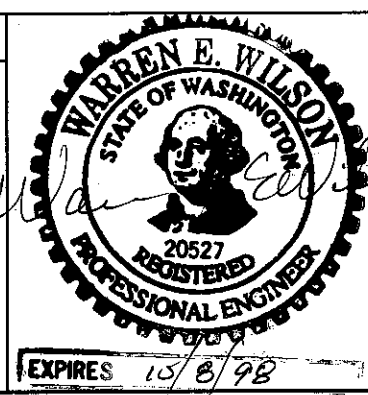

SR 405
BOTHELL TO SWAMP CREEK 1/C
HOV LANES - STAGE 1
NORTH CREEK BRIDGE 405/72 E-W
MEDIAN BARRIER 2 OF 2


BRIDGE SHEET NO. 15
SHEET 475 OF 663 SHEETS

341/151

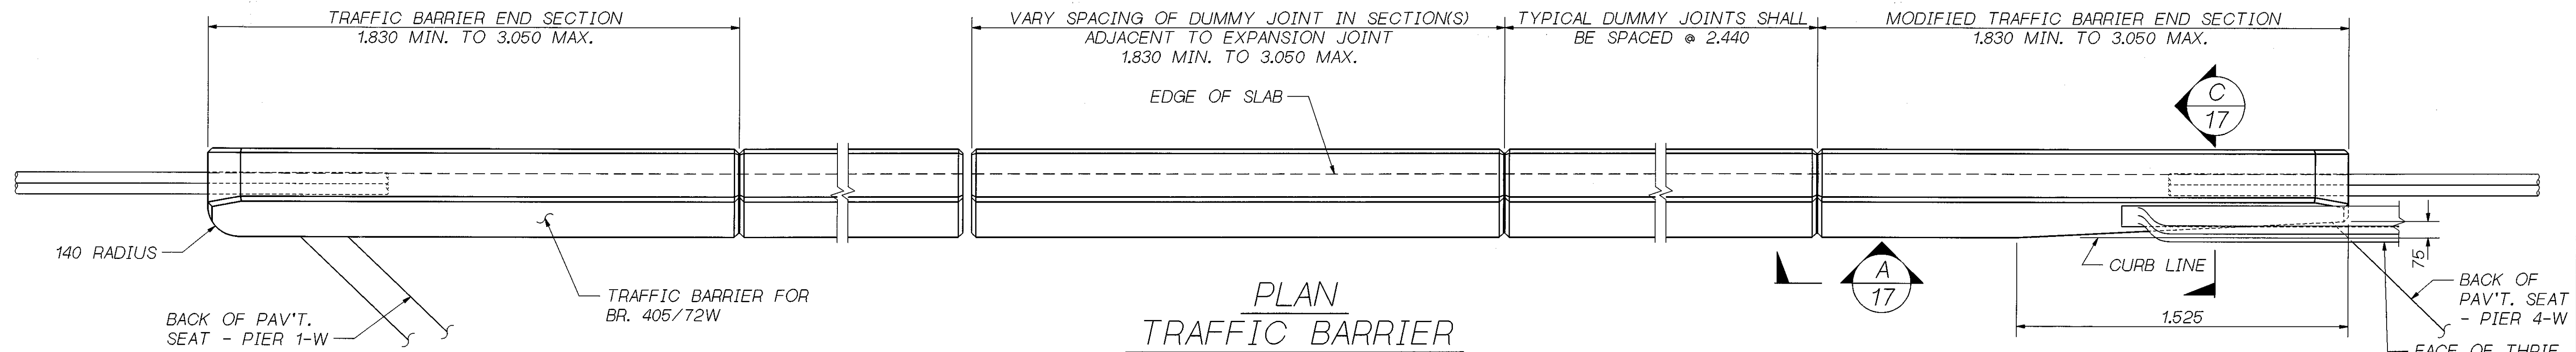



PLAN
TRAFFIC BARRIER

BARRIER CONTINUOUS BETWEEN ROADWAY EXPANSION JOINTS. CONSTRUCTION JOINTS WITH SHEAR KEYS ARE PERMISSIBLE AT DUMMY JOINT LOCATIONS. FORM JOINTS BETWEEN DUMMY JOINTS SHALL NOT BE PERMITTED.

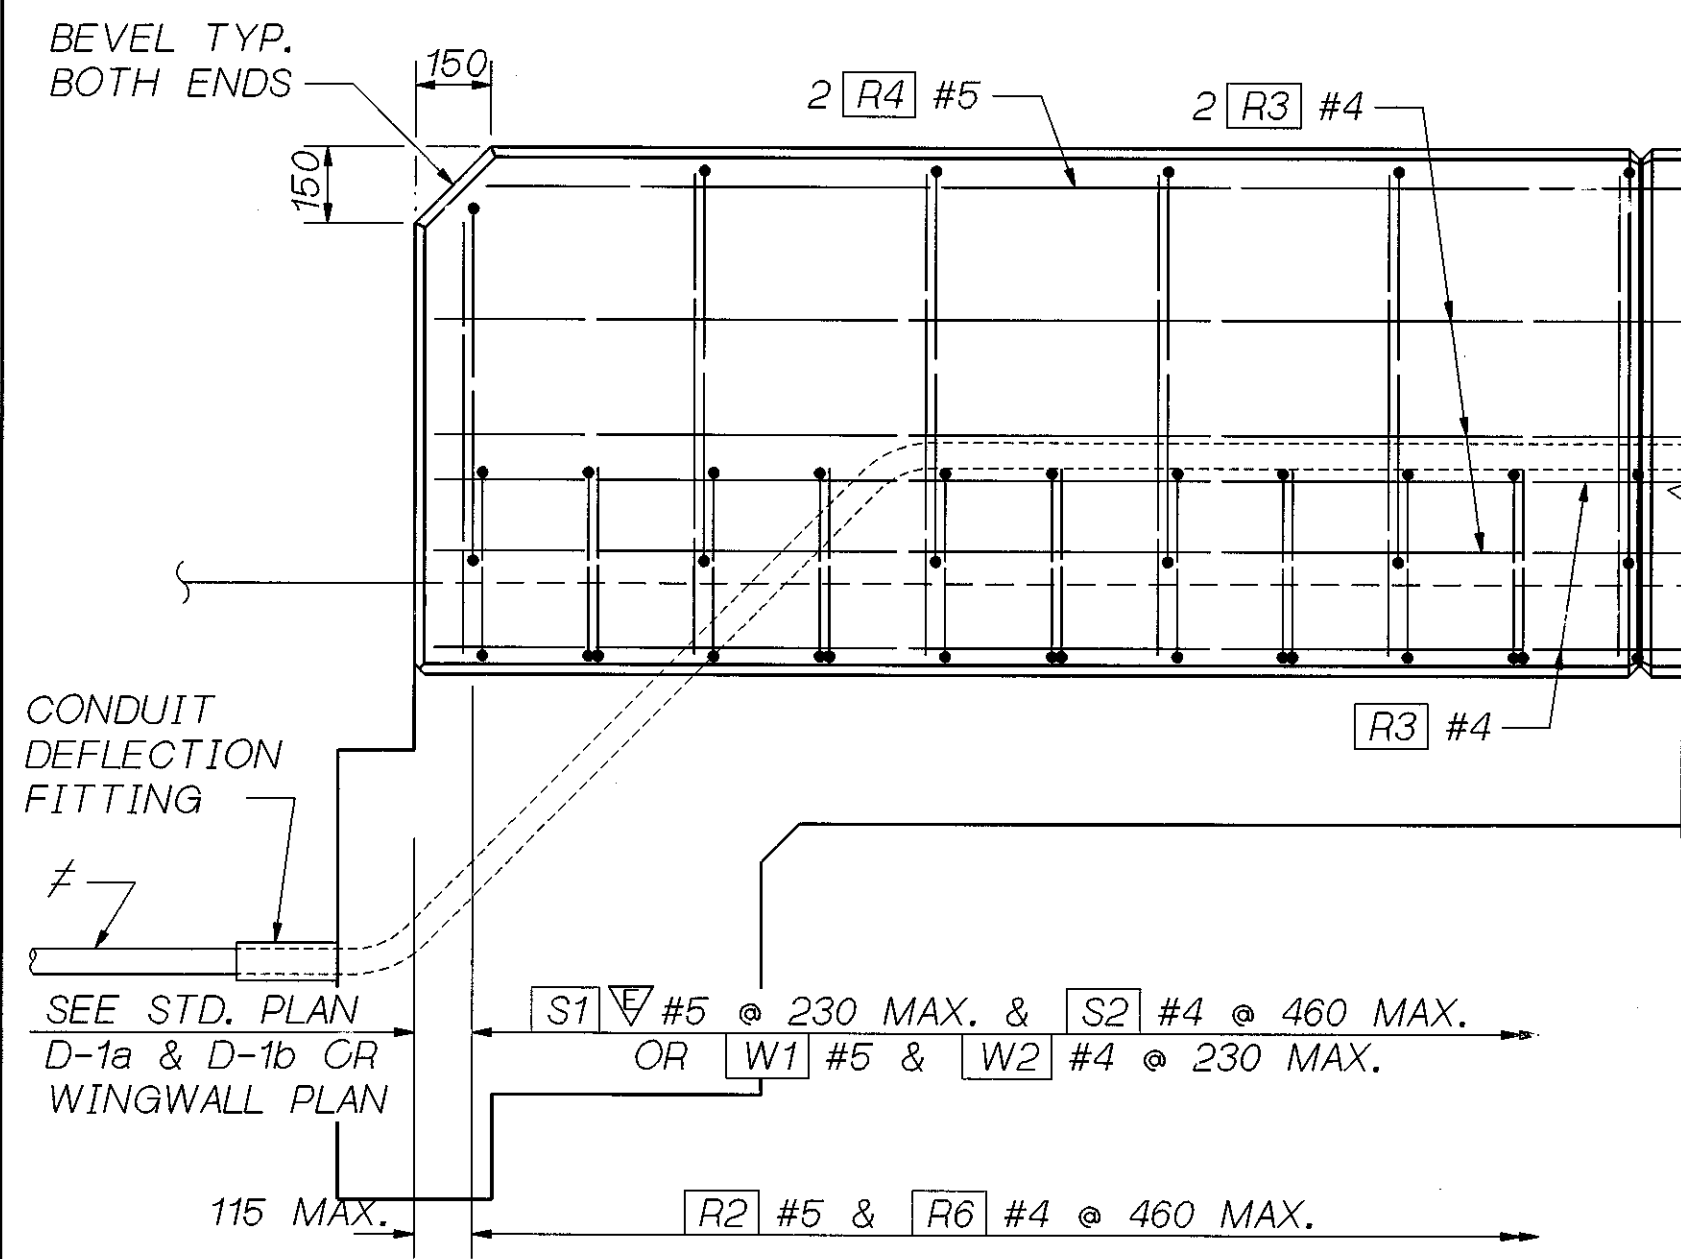


OUTSIDE ELEVATION
TRAFFIC BARRIER

AT SW CORNER OF BR. 405/72W

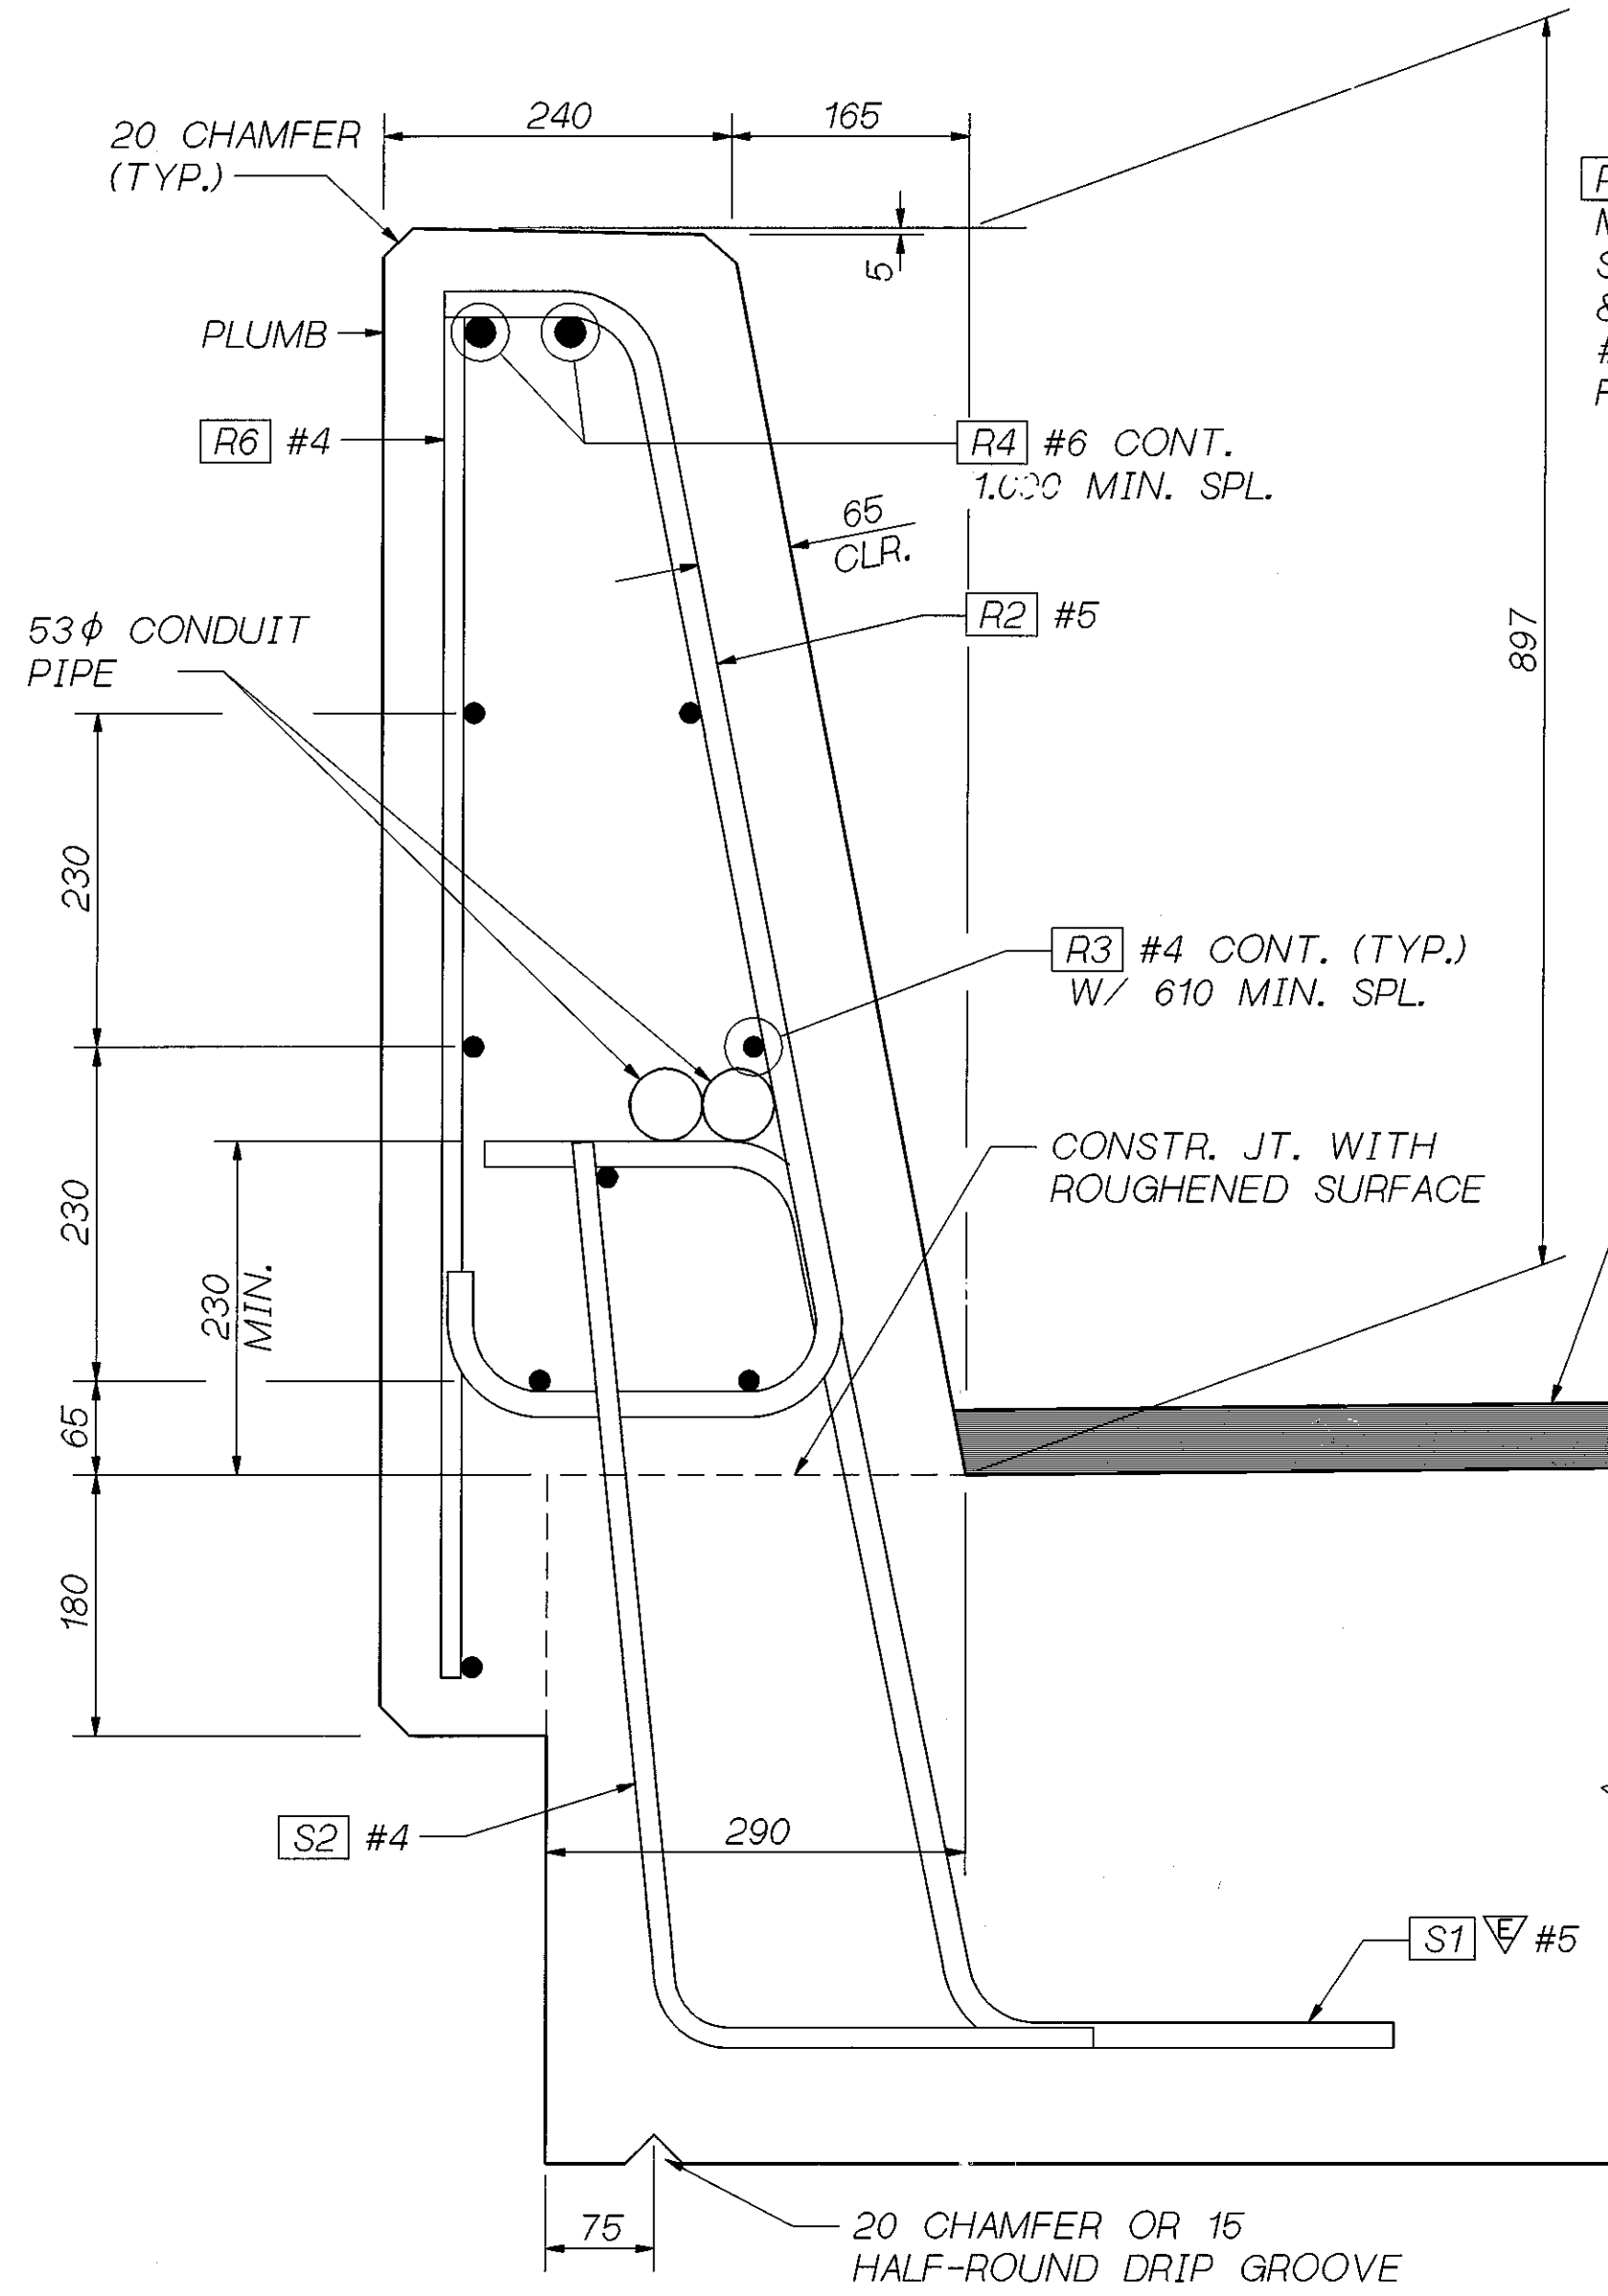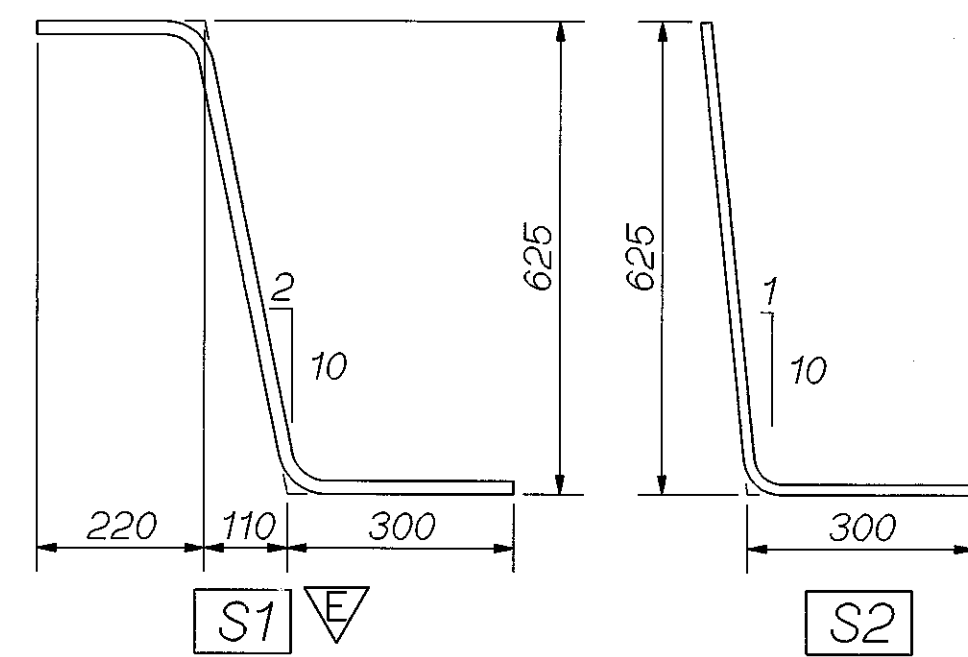

TYPICAL SECTION - TRAFFIC BARRIER

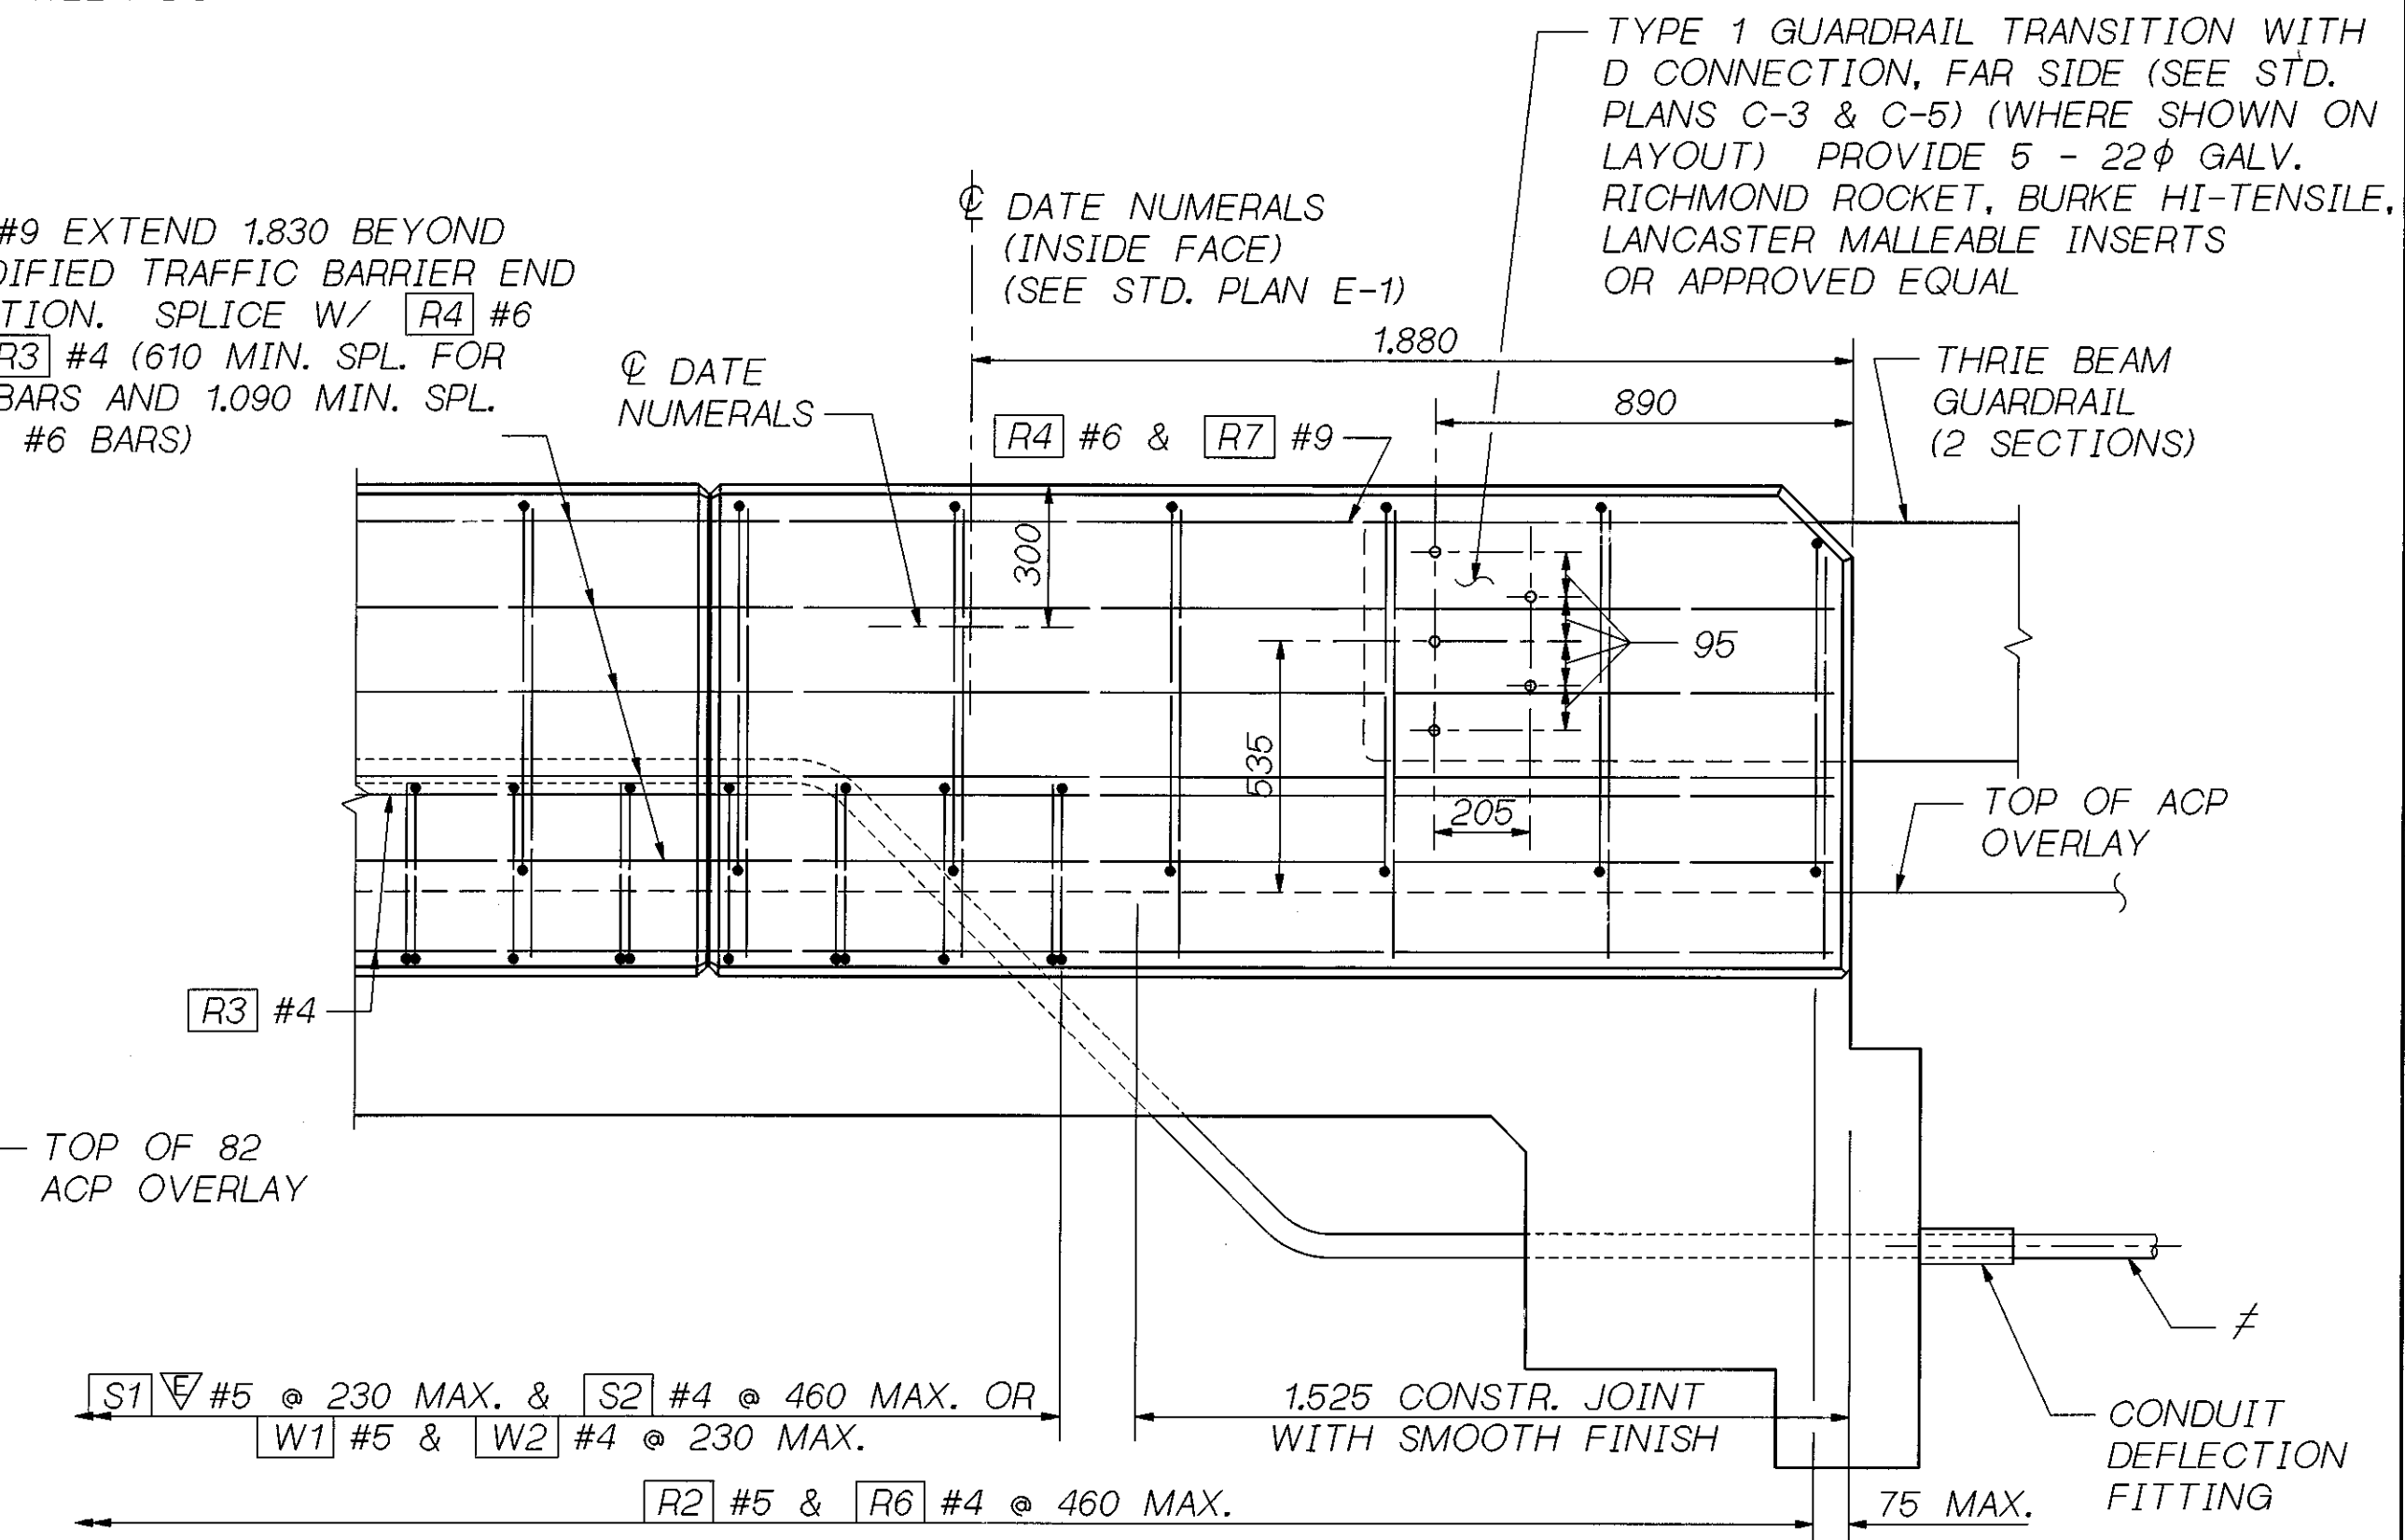


OUTSIDE ELEVATION
END OF MODIFIED TRAFFIC BARRIER

AT NW CORNER OF BR. 405/72W

≠ TERMINATE EACH CONDUIT PIPE AT SEPARATE TYPE 1 JUNCTION BOX OFF END OF BRIDGE.


SR 405 JOB NO. 7071 SHEET 16

Bridge Design Engr.	S405072R00T:1.000000.FGB\MSS_1.FGB:1			REGION NO.	STATE	FED. AID PROJ. NO.	SHEET NO.	TOTAL SHEETS
Supervisor				10	WASH.			
Designed By	J. CHEN	6/96						
Checked By	G. CORNELL	6/96						
Detailed By	D.W. PULSE JR.	6/96						
Bridge Projects Engr.								
Prelim. Plan By								
Architect/Specialist		DATE	REVISION	BY	APP'D	5054		

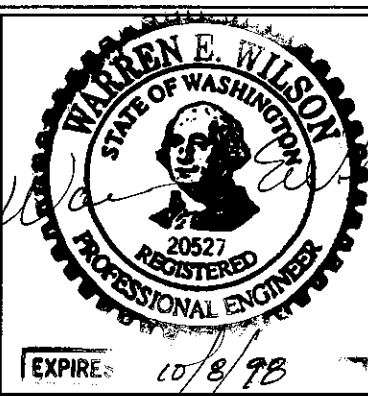


SR 405	BRIDGE SHEET NO.
BOTHELL TO SWAMP CREEK 1/3	16
HOV LANES - STAGE 1	
NORTH CREEK BRIDGE 405/72 E-W	
TRAFFIC BARRIER 1 OF 2	SHEET 476 OF 663 SHEETS


24/150

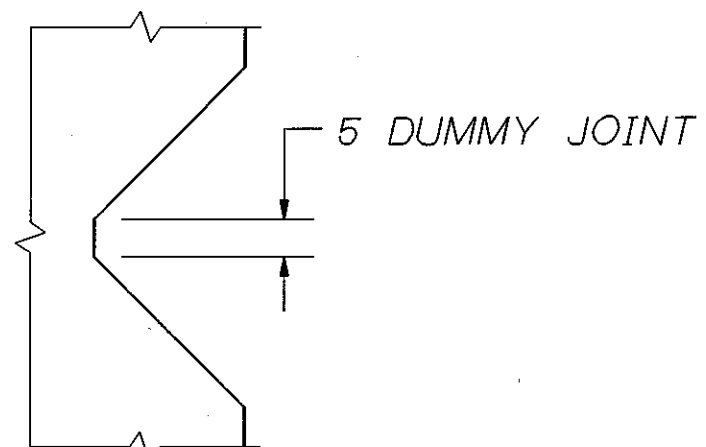

SECTION 2-2

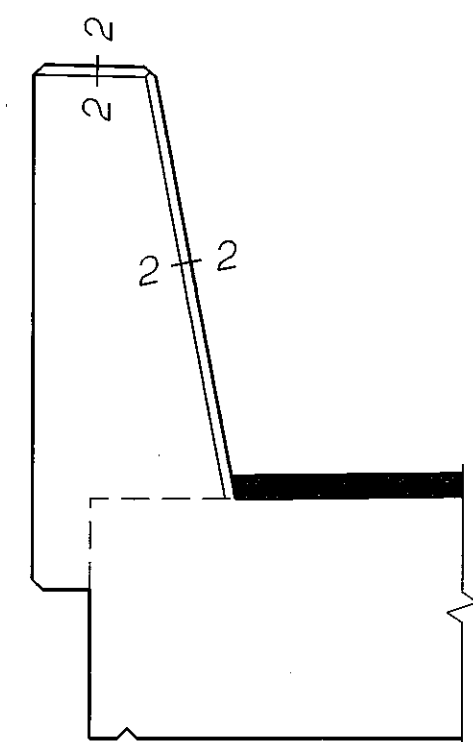


SECTION D

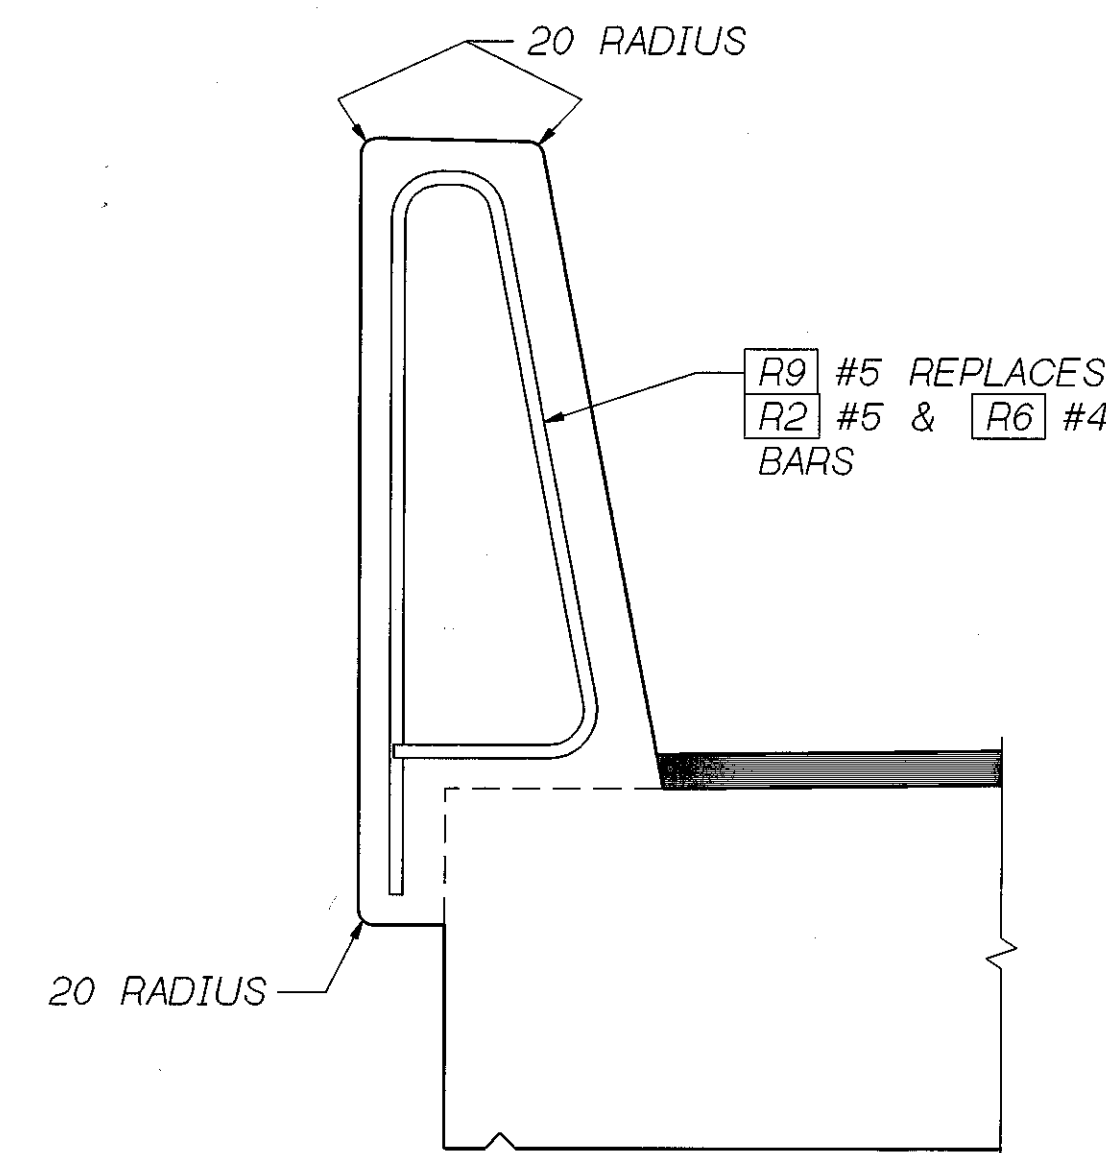


SLIPFORM ALTERNATE

SEE TYPICAL SECTION - TRAFFIC BARRIER FOR ADDITIONAL DETAILS.


STANDARD DATE NUMERALS (NO DATE PANEL) ON RIGHT OF APPROACH SIDE(S)

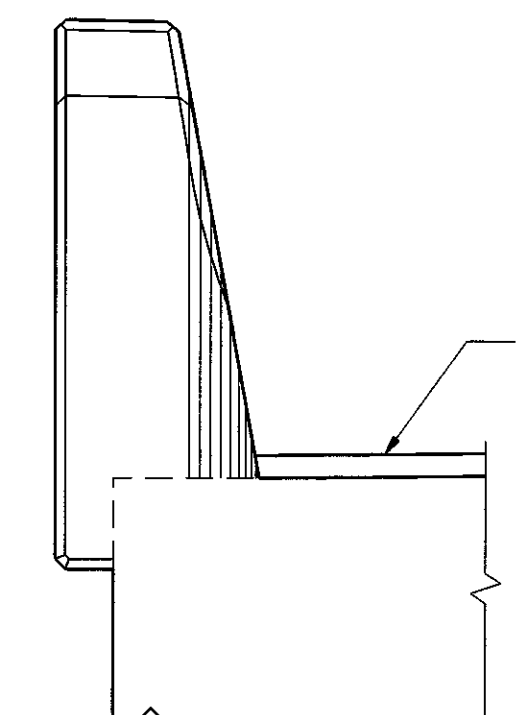

END VIEW

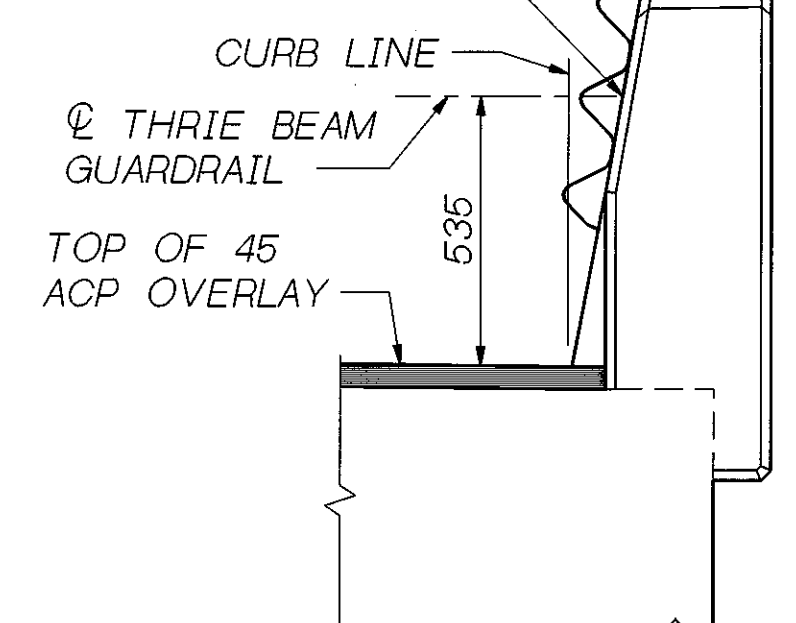

END VIEW WITH D CONNECTION

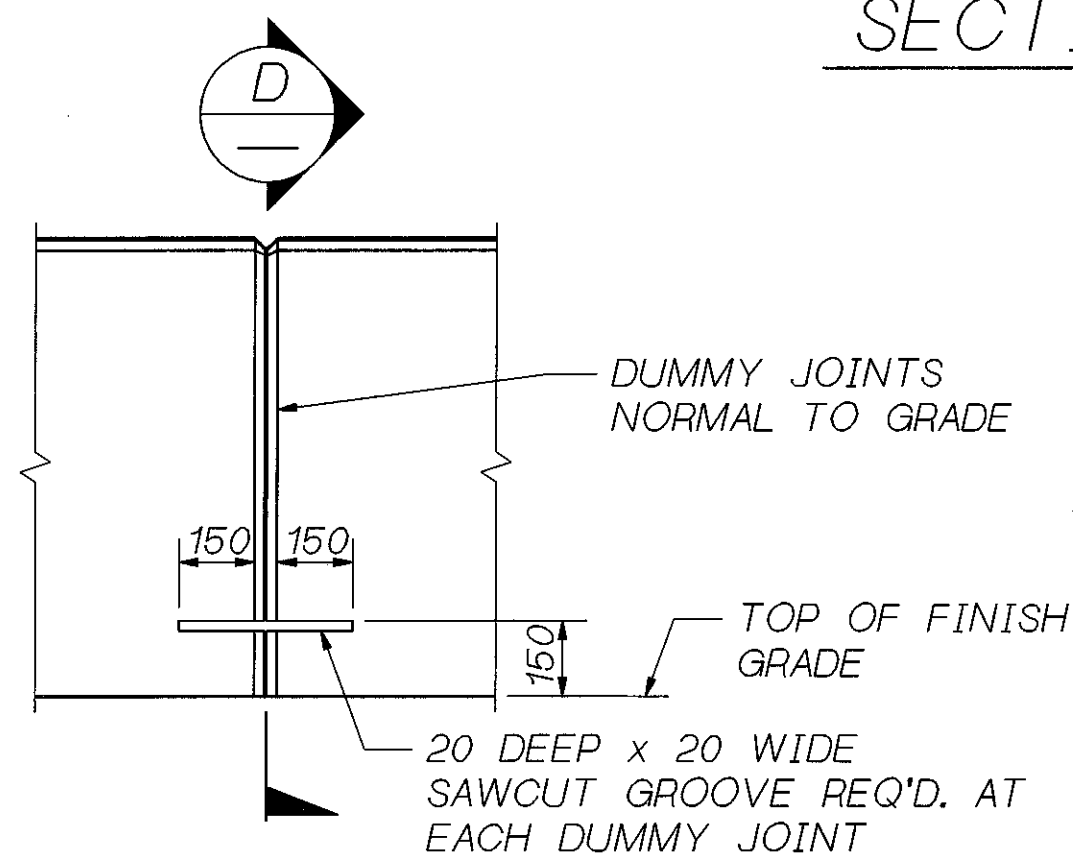

VIEW A 16


NOTE: CONCRETE SURFACE CONSTRUCTION TOLERANCE OF 5 IN 3,000 (MAX.) IS REQ'D. FOR TRAFFIC SIDE OF BARRIER.

∇ : EPOXY COATED ≠ DIMENSIONS TO POINTS OF INTERSECTION.

TRAFFIC BARRIER BAR LIST
ALL REINFORCING SHALL BE AASHTO M31, GR. 60.


MARK	SIZE	LENGTH	BENDING DIAGRAM (ALL DIMENSIONS ARE OUT TO OUT)	
R2	5	1.365		
R3	4	(A)		STR.
R4	6	(A)		STR.
R6	4	1.005		STR.
R7	9	4.265		STR.
R9	5	2.270		

(A) DETERMINE FROM PLANS
FOR [W1] & [W2] BARS SEE WINGWALL OR RETAINING WALL PLANS. FOR [S1] & [S2] BARS SEE BARLIST.

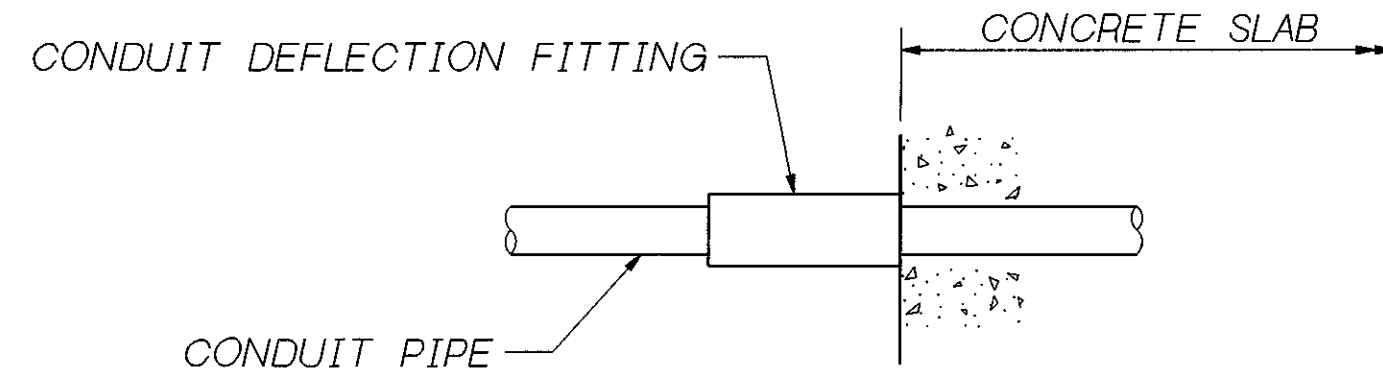

CONDUIT DEFLECTION FITTING

TYPE DX CONDUIT FITTING FOR DEFLECTION OF 30° AND 20 MOVEMENT PLACE AT CONDUIT PIPE EXIT FROM STRUCTURE.

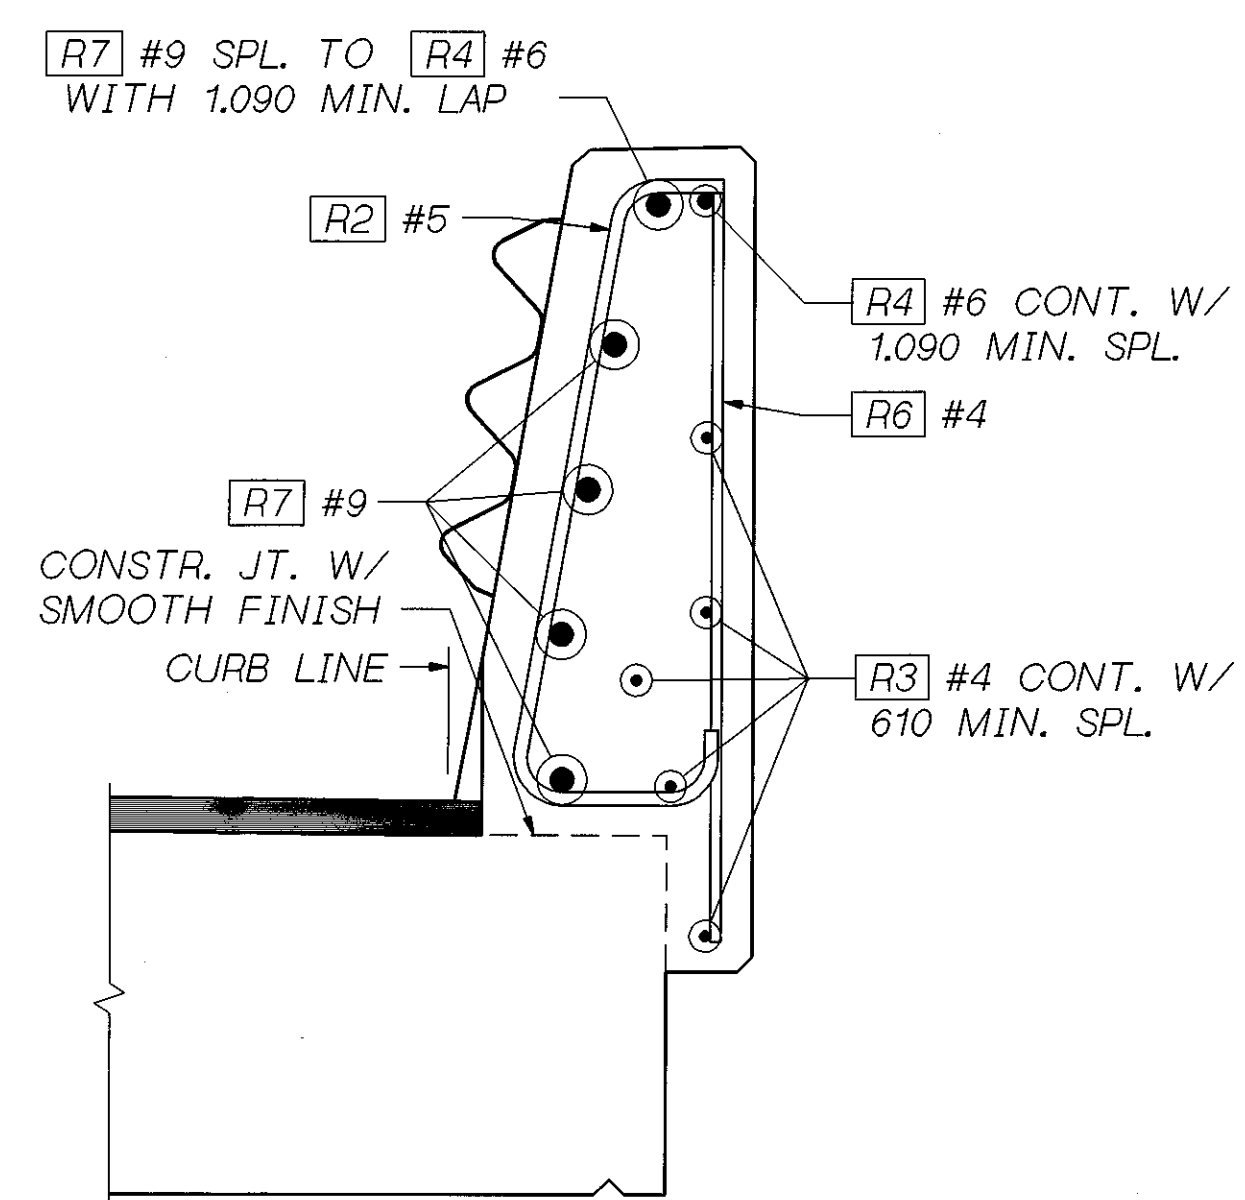


SECTION C BRIDGE

DETAIL FOR BRIDGE 16 FOR DETAILS NOT SHOWN SEE "OUTSIDE ELEVATION" AND "TYPICAL SECTION"

SR 405 JOB NO. 7071 SHEET 17

Bridge Design Engr.	S405D72R00T-1.000000.FGB\MSS.2.FGB.1	REGION NO.	STATE	FED. AID PROJ. NO.	SHEET NO.	TOTAL SHEETS
Supervisor		10	WASH.			
Designed By J. CHEN	6/96					
Checked By G. CORNELL	6/96					
Detailled By D.W. PULSE JR.	6/96					
Bridge Projects Engr.				JOB NUMBER		
Prelim. Plan By				96W035		
Architect/Specialist	DATE	REVISION	BY	AFP'D	5054	

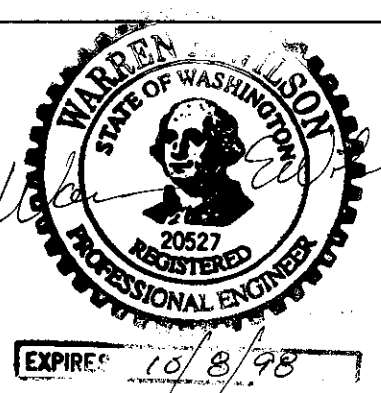

SR 405
BOTHELL TO SWAMP CREEK 1/C
HOV LANES - STAGE 1
NORTH CREEK BRIDGE 405/72 E-W
TRAFFIC BARRIER 2 OF 2

BRIDGE SHEET NO. 17
SHEET OF 477
663 SHEETS

2A1/141

S-BAR IS INCLUDED IN SUBSTRUCTURE QUANTITIES - LUMP SUM QUANTITY
T OR S=T/E OR STIRRUP RADIUS
E-EARTHQUAKE TAIL W/ TIE OR STIRRUP RADIUS


E-BAR IS EPOXY COATED
V-BAR DIMENSIONS VARY BETWEEN DIMENSIONS SHOWN ON THIS LINE AND THE FOLLOWING LINE

MARK NO.	LOCATION	SIZE	NO. REIN. D.	BEND TYPE	BEND RADIUS	LUMP SUM QUANTITY	SUBSTRUCTURE	EPOXY COATED	VARIES NO. EACH	DIMENSIONS						LENGTH (EACH)	TOTAL WEIGHT
										U	W	X	Y	Z	θ ₁		
400	ABUT. - MEDIAN WIDENING	6	16	54						6.040						6.294	225
401	CAP BEAM - TOP	6	16	54						6.040						6.294	225
402	CAP BEAM - INTERMEDIATE	5	8	50						6.040						6.040	75
403	CAP BEAM - INTERMEDIATE	4	8	50						6.040						6.040	48
406	CAP BEAM - STIRRUP	4	112	60	S					0.825	0.610					3.200	356
407	CAP BEAM - STIRRUP	4	112	60	S					0.600	0.685					2.900	323
410	CAP BEAM - BOTTOM	6	8	50						6.040						6.040	108
411	CAP BEAM - STIRRUP	4	112	71	T					0.225	0.305	0.305				0.760	85
420	INTER. PIERS - MED. WIDENING	7	16	54						6.040						6.345	309
421	CAP BEAM - BOTTOM	7	16	54						6.040						6.345	309
422	CAP BEAM - INTER.	5	16	50						6.040						6.040	150
423	CAP BEAM - STIRRUP	4	104	60	S					0.670	0.630					2.930	927
450	OUT. WIDENING (PIER 1-W)	6	4	54						8.145						8.399	75
451	CAP BEAM - BOT.	6	4	54						8.145						8.399	75
452	CAP BEAM - INTER.	5	2	50						8.145						8.145	25
453	CAP BEAM - INTER.	6	4	50						8.145						8.145	73
456	CAP BEAM - STIRRUP	4	18	60	S					0.825	0.610					3.200	57
457	CAP BEAM - STIRRUP	4	18	60	S					0.600	0.685					2.900	52
458	CAP BEAM - STIRRUP	4	18	71	T					0.225	0.305	0.305				0.760	14
460	OUT. WIDENING (PIER 2-W)	7	4	54						7.880						8.185	100
461	CAP BEAM - BOTTOM	7	4	54						7.880						8.185	100
462	CAP BEAM - INTER.	5	4	50						7.880						7.880	49
463	CAP BEAM - STIRRUP	4	26	60	S					0.670	0.630					2.930	232
470	OUT. WIDENING (PIER 3-W)	7	4	54						7.520						7.825	95
471	CAP BEAM - BOTTOM	7	4	54						7.520						7.825	95
472	CAP BEAM - INTER.	5	4	50						7.520						7.520	47
473	CAP BEAM - STIRRUP	4	26	60	S					0.670	0.630					2.930	232
480	OUT. WIDENING (PIER 4-W)	6	4	54						7.235						7.489	67
481	CAP BEAM - BOT.	6	4	54						7.235						7.489	67
482	CAP BEAM - INTER.	5	2	50						7.235						7.235	22
483	CAP BEAM - INTER.	6	4	50						7.235						7.235	65
486	CAP BEAM - STIRRUP	4	15	60	S					0.825	0.610					3.200	48
487	CAP BEAM - STIRRUP	4	15	60	S					0.600	0.685					2.900	43
488	CAP BEAM - STIRRUP	4	15	71	T					0.225	0.305	0.305				0.760	11
490	DOWELS - CLOSURE POURS	6	48	51						0.255						0.458	34
491	CAP BEAM - DOWELS	5	48	51						0.230						0.408	30
492	CAP BEAM - DOWELS	7	48	51						0.305						0.559	82

S-BAR IS INCLUDED IN SUBSTRUCTURE QUANTITIES - LUMP SUM QUANTITY
T OR S=T/E OR STIRRUP RADIUS
E-EARTHQUAKE TAIL W/ TIE OR STIRRUP RADIUS

E-BAR IS EPOXY COATED
V-BAR DIMENSIONS VARY BETWEEN DIMENSIONS SHOWN ON THIS LINE AND THE FOLLOWING LINE

MARK NO.	LOCATION	SIZE	NO. REIN. D.	BEND TYPE	BEND RADIUS	LUMP SUM QUANTITY	SUBSTRUCTURE	EPOXY COATED	VARIES NO. EACH	DIMENSIONS						LENGTH (EACH)	TOTAL WEIGHT	
										U	W	X	Y	Z	θ ₁			θ ₂
800	TOP SLAB - MEDIAN WIDENING	5	30	51						0.555						0.733	123	
801	TOP TRANSVERSE	5	30	54						0.555						0.771	125	
802	TOP TRANSVERSE	5	240	84						4.395	0.255	0.000			90	0	4.789	1784
810	TOP LONGITUDINAL	10	9	54						19.145						19.615	1131	
811	TOP LONGITUDINAL	10	9	54						18.250						18.720	1079	
812	TOP LONGITUDINAL	10	9	54						15.250						15.720	906	
813	TOP LONGITUDINAL	10	9	54						16.145						16.615	958	
814	TOP LONGITUDINAL	10	36	50						8.540						8.540	1969	
815	TOP LONGITUDINAL	10	32	50						6.100						6.100	1250	
816	TOP LONGITUDINAL	10	18	50						8.720						8.720	1005	
817	TOP LONGITUDINAL	10	9	54						15.575						16.045	925	
818	TOP LONGITUDINAL	10	9	54						15.845						16.315	940	
819	TOP LONGITUDINAL	10	9	54						18.575						19.045	1098	
820	TOP LONGITUDINAL	10	9	54						18.845						19.315	1113	
830	BOT. TRANSVERSE	5	30	50						0.555						0.555	115	
831	BOT. TRANSVERSE	5	30	54						0.555						0.771	125	
832	BOT. TRANSVERSE	5	240	54						4.395						4.611	1718	
835	BOT. LONGITUDINAL	10	12	50						15.080						15.080	1159	
836	BOT. LONGITUDINAL	10	10	50						10.360						10.360	663	
837	BOT. LONGITUDINAL	10	12	50						11.880						11.880	913	
838	BOT. LONGITUDINAL	10	20	50						7.015						7.015	898	
839	BOT. LONGITUDINAL	10	6	50						9.900						9.900	380	
840	BOT. LONGITUDINAL	10	6	50						13.900						13.900	534	
841	BOT. LONGITUDINAL	10	6	50						9.265						9.265	356	
842	BOT. LONGITUDINAL	10	6	50						13.005						13.005	500	
843	BOT. LONGITUDINAL	10	6	50						9.005						9.005	346	
844	BOT. LONGITUDINAL	10	6	50						8.815						8.815	339	
845	BOT. LONGITUDINAL	10	12	50						15.265						15.265	1173	
846	BOT. LONGITUDINAL	10	6	50						13.235						13.235	509	
847	BOT. LONGITUDINAL	10	6	50						9.235						9.235	355	
848	BOT. LONGITUDINAL	10	6	50						8.930						8.930	343	
849	BOT. LONGITUDINAL	10	6	50						13.505						13.505	519	
850	BOT. LONGITUDINAL	10	6	50						9.505						9.505	365	
851	BOT. LONGITUDINAL	10	6	50						9.065						9.065	348	

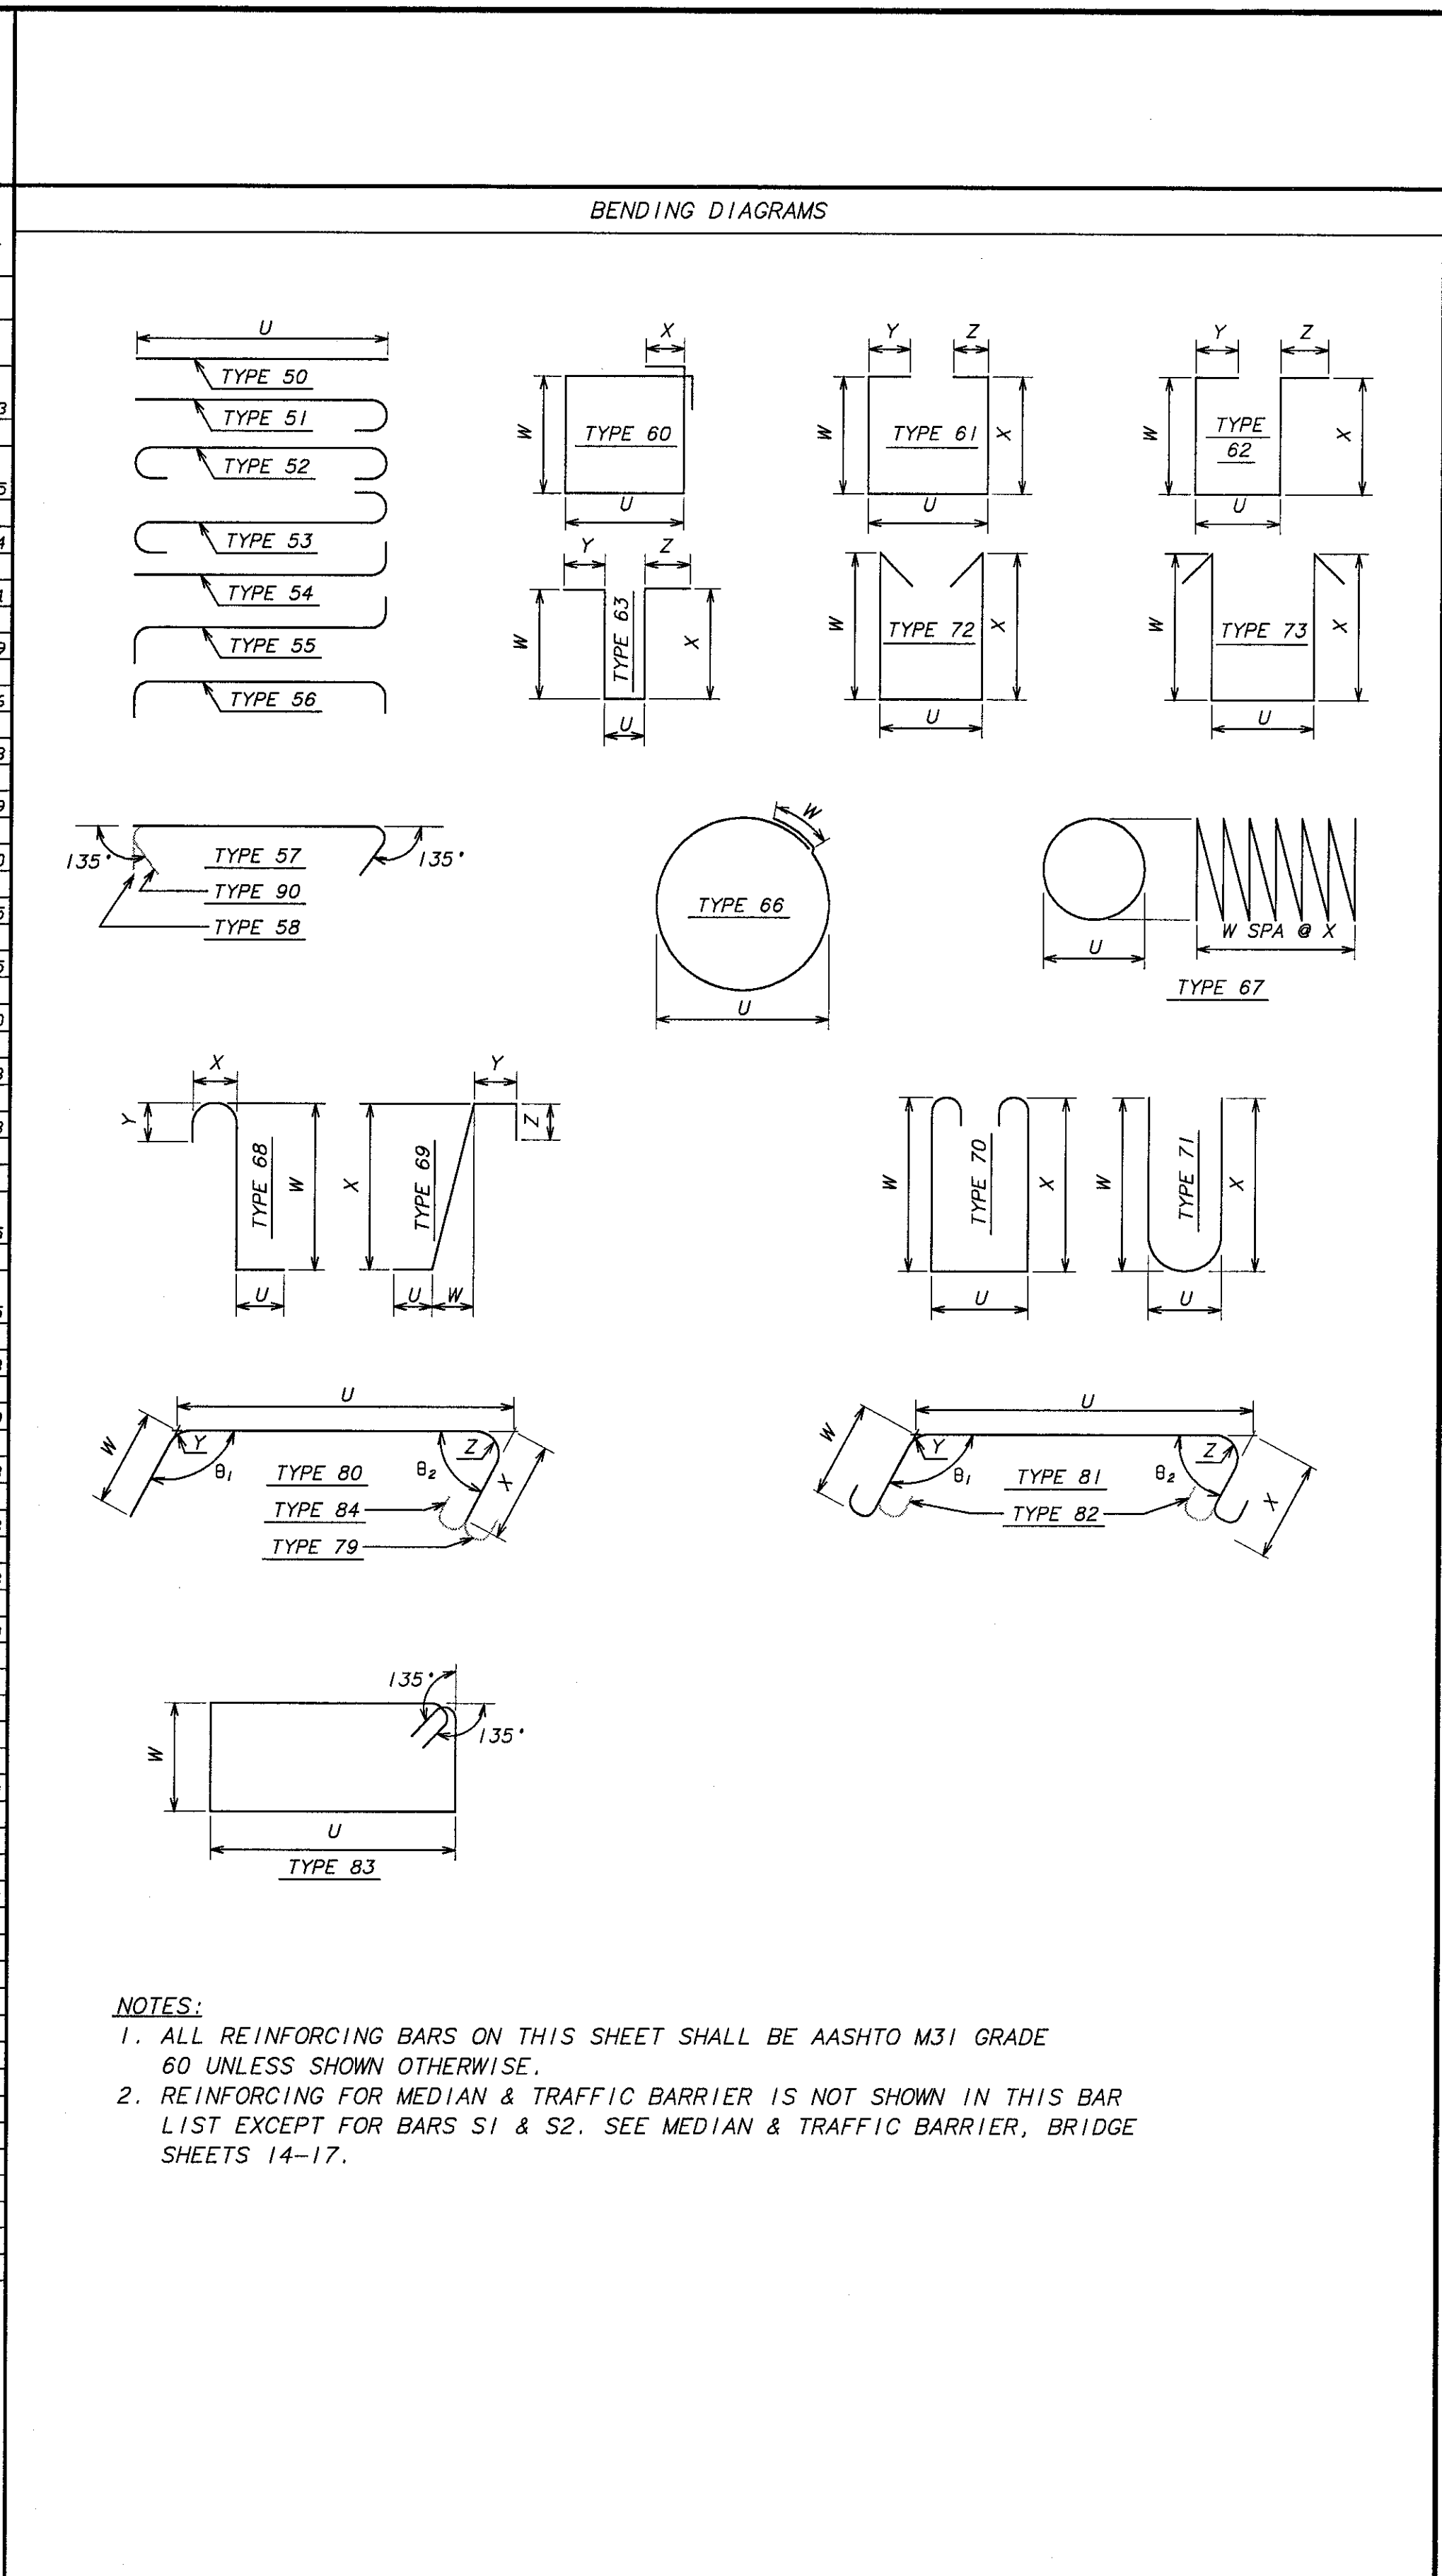

NOTES:
1. ALL REINFORCING BARS ON THIS SHEET SHALL BE AASHTO M31 GRADE 60 UNLESS SHOWN OTHERWISE.
2. REINFORCING FOR MEDIAN & TRAFFIC BARRIER IS NOT SHOWN IN THIS BAR LIST EXCEPT FOR BARS S1 & S2. SEE MEDIAN & TRAFFIC BARRIER, BRIDGE SHEETS 14-17.

PLOTTED: Tue Nov 12 1996 11:34am FILENAME: X:\A9607\BR72\EM\18.DWG SCALE: 1
SR 405 JOB NO. 7071 SHEET 18 OF 19

BRIDGE DESIGN ENGR	REGION NO.	STATE	FED AID PROJ NO.	SHEET NO.	TOTAL SHEETS			SR 405 BOTHELL TO SWAMP CREEK I/C HOV LANES - STAGE 1 NORTH CREEK BRIDGE 405/72 E-W BAR LIST	BRIDGE SHEET NO. 18 SHEET 478 OF 663 SHEETS
SUPERVISOR	1	WASH							
DESIGNED BY J. CHEN 6/96	JOB NUMBER 96W035		DATE		REVISION	BY	APPR		
CHECKED BY C. CORNELL 6/96	CONTRACT NO.		5054						
DETAILED BY T. BRENNAN 6/96									
BRIDGE PROJECTS ENGR									
PRELIM PLAN BY									
ARCHITECT/SPECIALIST									

BERGER/ABAM ENGINEERS INC. 33301 9TH AVENUE SOUTH FEDERAL WAY, WASHINGTON 98003-6395 (206)431-2300 FAX: (206)431-2250

