

WASHINGTON STATE HIGHWAY COMMISSION
DEPARTMENT OF HIGHWAYS
OLYMPIA, WASHINGTON

SR 405
MP 23.49 TO MP 23.76
WOODINVILLE INTERCHANGE
FEDERAL AID INTERSTATE ROUTE NO. 405
KING COUNTY
FEDERAL AID INTERSTATE PROJECT NO. I-405-3 (297)178


FED. ROAD DIV. NO.	STATE	FEDERAL AID PROJECT NO.	SHEET NO.	TOTAL SHEETS
8	WASH.	I-405-3(297)178		

CONVENTIONAL SIGNS

STATE AND COUNTY LINE	----
CORPORATE LIMITS	----
TOWNSHIP LINE	----
SECTION LINE	----
1/4 SECTION LINE	----
1/16 SECTION LINE	----
LAND GRANT LINE	----
MEANDER LINE	----
FENCE LINE	x-x-x-x
PROPERTY LINE	----
BASE OR SURVEY LINE	----
EXISTING RIGHT OF WAY	----
PROPOSED RIGHT OF WAY LINE	----
LIMITED ACCESS	----
EASEMENT LINE	----
RAILROAD	----
RAILROAD RIGHT WAY LINE	----
EXISTING ROAD	----
CULVERTS (EXISTING - PROPOSED)	----
BRIDGES (EXISTING - PROPOSED)	----
GUARDRAIL (EXISTING - PROPOSED)	----
TRANSMISSION TOWERS (WOOD - STEEL)	+
UTILITY POLES	+
MARSH	
TREES	o-o-o-o-o

LAYOUT

GROSS LENGTH	0.261	MILE
EXCEPTION	0.000	MILE
NET LENGTH	0.261	MILE

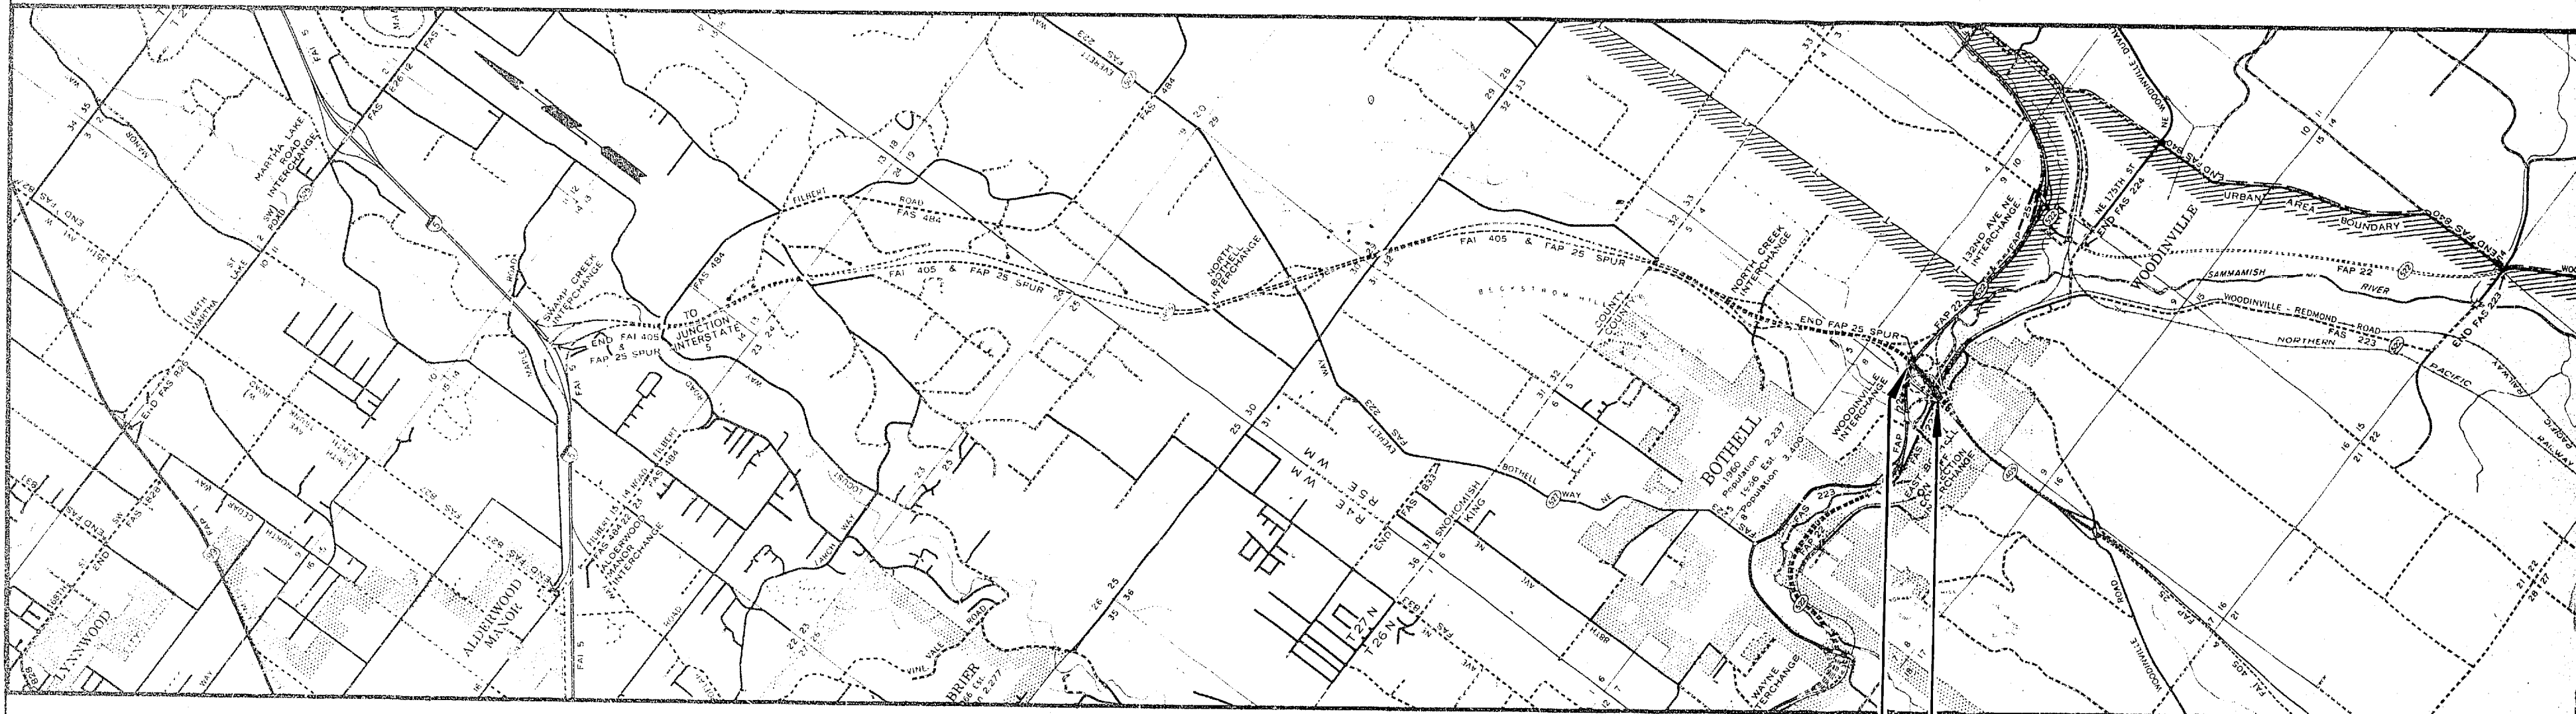

STA. L 863+50.27
END OF I-405-3(297)178

STA. L 849+69.64
BEG. OF I-405-3(297)178

Approved: December 7, 1967



Assistant Director for Highway Development

U. S. DEPARTMENT OF TRANSPORTATION
FEDERAL HIGHWAY ADMINISTRATION
BUREAU OF PUBLIC ROADS

APPROVED:

DISTRICT ENGINEER DATE

Cont. 8382

P/1995

INDEX

SHEET NO.	TITLE
1-6	INDEX
7	SUMMARY OF QUANTITIES
8	VICINITY MAP
9	PERSPECTIVE DRAWING NB STRUCTURE
10-11	NORTHBOUND LAYOUT
12	PIER LOCATION PLAN
13	COLUMN SHAFT DETAILS
	UNIT 1
14	FRAMING PLAN
15	PIER NO. 1
16-17	BOTTOM SLAB
18	LONGITUDINAL SECTIONS
19	PIER CROSSBEAMS
20	TRANSVERSE SECTIONS
21-22	ROADWAY SLAB
	UNIT 2
23	FRAMING PLAN
24-25	BOTTOM SLAB
26	LONGITUDINAL SECTION
27	PIER CROSSBEAMS
28	TRANSVERSE SECTION
29-30	ROADWAY SLAB


INDEX (CONTINUED)

SHEET NO.	TITLE
	UNIT 3
31	FRAMING PLAN
32-33	BOTTOM SLAB
34	LONGITUDINAL SECTION
35	PIER CROSSBEAMS
36-37	TRANSVERSE SECTIONS
38-39	ROADWAY SLAB
	UNIT 4
40	FRAMING PLAN
41	PIER NO. 13
42-44	BOTTOM SLAB
45	LONGITUDINAL SECTIONS
46	PIER CROSSBEAMS
47	CROSSBEAM SECTIONS
48-49	TRANSVERSE SECTIONS
50-52	ROADWAY SLAB
53-54	NB/E-N INTERSECTION CONTOUR PLAN
55	HINGE DETAILS

SR 405
MP 23.49 TO MP 23.76
WOODINVILLE INTERCHANGE
 KING COUNTY
 WASHINGTON STATE HIGHWAY COMMISSION
 DEPARTMENT OF HIGHWAYS
 OLYMPIA, WASHINGTON
 GEORGE D. ZAHN, CHAIRMAN

D. L. MIRALSON
 M. WALSH

 ASS'T. DIRECTOR FOR
 HIGHWAY DEVELOPMENT

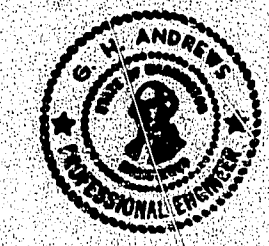

BAKER FERGUSON
 JOHN H. RUPP

APPROVED December 7, 1967

CONTRACT NO. 8382 SHEET 1 TO 297 SHEETS INCL

H/1995

INDEX

SHEET NO.	TITLE
56	BEARING ASSEMBLY & EXPANSION JOINT DETAIL
57	DRAINAGE DETAILS
58	ELECTRICAL DETAILS
59	TEST HOLE DATA
60	BAR LIST UNIT 1
61 - 62	BAR LIST UNIT 2
63 - 64	BAR LIST UNIT 3
65 - 67	BAR LIST UNIT 4
E-N STRUCTURE	
68	LAYOUT
69	FRAMING PLAN
70	PIER NO. 1
71	BOTTOM SLAB
72	LONGITUDINAL SECTIONS
73	TRANSVERSE SECTIONS
74	ROADWAY SLAB
75 - 76	BAR
SB STRUCTURE	
UNIT 1	
77 - 78	SOUTHBOUND LAYOUT
79	PIER LOCATION PLAN
80	COLUMN AND SHAFT DETAILS
81	FRAMING PLAN
82 - 83	BOTTOM SLAB
84	LONGITUDINAL SECTIONS

INDEX (CONTINUED)

SHEET NO.	TITLE
85	PIER CROSSBEAMS
86	TRANSVERSE SECTIONS
87 - 88	ROADWAY SLAB
UNIT 2	
89	FRAMING PLAN
90 - 91	BOTTOM SLAB
92	LONGITUDINAL SECTION
93	PIER CROSSBEAMS
94	TRANSVERSE SECTIONS
95 - 96	ROADWAY SLAB
UNIT 3	
97	FRAMING PLAN
98 - 100	BOTTOM SLAB
101	LONGITUDINAL SECTION
102 - 103	PIER CROSSBEAMS
104	TRANSVERSE SECTIONS
105 - 108	ROADWAY SLAB

SR 405
MP 23.49 TO MP 23.76
WOODINVILLE INTERCHANGE

KING COUNTY
 WASHINGTON STATE HIGHWAY COMMISSION
 DEPARTMENT OF HIGHWAYS
 OLYMPIA, WASHINGTON
 GEORGE D. ZAHN, CHAIRMAN

MIKALOP H. WALSH
 BAKER FERGUSON
 JOHN N. RUPP



APPROVED: Dec. 7, 1967

CONTRACT NO. 8392 SHEET 2 OF 297 SHEETS

P/1995

INDEX


SHEET NO.	TITLE
	UNIT 4
109	FRAMING PLAN
110	PIER NO. 13
111 - 112	BOTTOM SLAB
113	LONGITUDINAL SECTION
114	PIER CROSSBEAMS
115	CROSSBEAM SECTIONS
116	TRANSVERSE SECTIONS
117 - 118	ROADWAY SLAB
119	SB/S-E INTERSECTION CONTOUR PLAN
120	HINGE DETAILS
121	BEARING ASSEMBLY & EXPANSION JOINT DETAIL
122	DRAINAGE DETAILS
123	ELECTRICAL DETAILS
124	BAR LIST UNIT 1
125	BAR LIST UNIT 2
126 - 127	BAR LIST UNIT 3
128 - 129	BAR LIST UNIT 4
	S-E STRUCTURE
	UNIT 1
130	LAYOUT
131	FRAMING PLAN
132	PIER NO. 1
133 - 134	BOTTOM SLAB
135 - 136	LONGITUDINAL/TRANSVERSE SECTIONS

INDEX (CONTINUED)

SHEET NO.	TITLE
137-138	ROADWAY SLAB
	UNIT 2
139	LONGITUDINAL/TRANSVERSE SECTIONS
140	BOTTOM AND ROADWAY SLABS
141 - 142	BAR LIST UNIT 1
143	BAR LIST UNIT 2
	W-S & E-S STRUCTURES
144-146	LAYOUT
147-148	PIER LOCATION PLAN
149	COLUMN AND SHAFT DETAILS
150	COLLISION WALL W-S/E-S PIER 4
151	TYPICAL PIER CROSSBEAMS, W-S STRUCTURE
152	TYPICAL TRANSVERSE SECTIONS
	W-S & E-S UNIT 1
153-154	FRAMING PLAN
155-157	BOTTOM SLAB
158	LONGITUDINAL SECTIONS
159	PIER CROSSBEAMS 1 & 2

SR 405
MP 23.49 TO MP 23.76
WOODINVILLE INTERCHANGE
 KING COUNTY
 WASHINGTON STATE HIGHWAY COMMISSION
 DEPARTMENT OF HIGHWAYS
 OLYMPIA, WASHINGTON
 GEORGE D. ZAHN, CHAIRMAN

H. WALSH

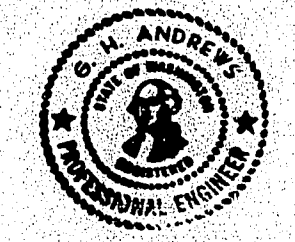

BAKER FERGUSON
JOHN H. RUPP

APPROVED: Dec. 7, 1967

CONTRACT NO. 8382 SHEET 3 OF 297 SHEETS

P/1995

INDEX

SHEET NO.	TITLE
160	PIER CROSSBEAMS 3 & 4
161	SECTIONS, PIER CROSSBEAMS
162	TRANSVERSE SECTIONS
163 - 165	ROADWAY SLAB
	E-S UNIT 2
166	FRAMING PLAN
167 - 168	BOTTOM SLAB
169	LONGITUDINAL SECTION
170	PIER CROSSBEAMS, TRANSVERSE SECTIONS
171 - 172	ROADWAY SLAB
	W-S UNIT 2
173	FRAMING PLAN
174 - 175	BOTTOM SLAB
176	LONGITUDINAL SECTIONS
177 - 178	ROADWAY SLAB
	W-S UNIT 3
179	FRAMING PLAN
180 - 181	BOTTOM SLAB
182	LONGITUDINAL SECTIONS
183 - 184	ROADWAY SLAB
	W-S UNIT 4
185	FRAMING PLAN
186 - 187	BOTTOM SLAB
188	LONGITUDINAL SECTIONS
189 - 190	ROADWAY SLAB

INDEX (CONTINUED)

SHEET NO.	TITLE
	W-S UNIT 5
191	FRAMING PLAN
192 - 193	BOTTOM SLAB
194	LONGITUDINAL SECTIONS
195 - 196	ROADWAY SLAB
	W-S UNIT 6
197	FRAMING PLAN
198	PIER 22
199 - 200	BOTTOM SLAB
201	LONGITUDINAL SECTIONS
202 - 203	ROADWAY SLAB
204	W-S INTERSECTION CONTOUR PLAN
205	E-S INTERSECTION CONTOUR PLAN
206	HINGE DETAILS
207	BEARING ASSEMBLY & EXPANSION JOINT DETAILS
208	DRAINAGE DETAILS
209	ELECTRICAL DETAILS
210 - 211	TEST HOLE DATA

SR 405
MP 23.49 TO MP 23.76
WOODINVILLE INTERCHANGE

KING COUNTY
WASHINGTON STATE HIGHWAY COMMISSION
DEPARTMENT OF HIGHWAYS
OLYMPIA, WASHINGTON
GEORGE D. ZAHN, CHAIRMAN

BY: MIKALSON
H. WALSH



BAKER FERGUSON
JOHN N. RUPP

APPROVED: Dec. 7, 1967

CONTRACT NO 8382 SHEET 4 OF 297 SHEETS

P/1995

INDEX

SHEET NO.	TITLE
212 - 214	BAR LIST UNIT 1
215 - 216	BAR LIST E-S UNIT 2
217 - 218	BAR LIST W-S UNIT 2
219 - 220	BAR LIST W-S UNIT 3
221 - 222	BAR LIST W-S UNIT 4
223 - 224	BAR LIST W-S UNIT 5
225 - 226	BAR LIST W-S UNIT 6
	N-W & N-E STRUCTURES
227 - 228	LAYOUT
229	PIER LOCATION PLAN
230	COLUMN AND SHAFT DETAILS
	UNIT 1
231	FRAMING PLAN
232	PIER NO. 1
233 - 234	N-W/N-E BOTTOM SLAB
235	LONGITUDINAL SECTIONS N-W/N-E
236	CROSSBEAM N-W/N-E PIER 2 AND N-E PIER 3
237	CROSSBEAM N-W PIER 3
238 - 239	N-W/N-E ROADWAY SLAB
	UNIT 2 N. W.
240	FRAMING PLAN
241 - 242	BOTTOM SLAB
243	LONGITUDINAL SECTIONS
244	TRANSVERSE SECTIONS
245 - 246	ROADWAY SLAB

INDEX (CONTINUED)

SHEET NO.	TITLE
	UNIT 3 N-W
247	FRAMING PLAN
248 - 249	BOTTOM SLAB
250	LONGITUDINAL SECTIONS
251	TRANSVERSE SECTIONS
252 - 253	ROADWAY SLAB
	UNIT 4 N-W
254	FRAMING PLAN
255	BOTTOM SLAB
256	LONGITUDINAL SECTIONS
257	TRANSVERSE SECTIONS
258	ROADWAY SLAB
	UNIT 5 N-W
259	FRAMING PLAN
260 - 261	BOTTOM SLAB
262	LONGITUDINAL SECTIONS
263	TRANSVERSE SECTIONS
264 - 265	ROADWAY SLAB

SR 405
MP 23.49 TO MP 23.76
WOODINVILLE INTERCHANGE

KING COUNTY
 WASHINGTON STATE HIGHWAY COMMISSION
 DEPARTMENT OF HIGHWAYS
 OLYMPIA, WASHINGTON
 GEORGE D. ZAHN, CHAIRMAN

B I MIKALSON
 H. WALSH



BAKER FERGUSON
 JOHN N. RUPP

ASS'T. DIRECTOR FOR
 HIGHWAY DEVELOPMENT

APPROVED: Dec. 7, 1967

CONTRACT NO. 8382 SHEET 5 OF 297 SHEETS

PROJECT LIMITS:
STATION L 849+69.64 TO STATION L 863+50.27

SUMMARY OF QUANTITIES

FED. ROAD DIV. NO.	STATE	FED. AID PROJECT NO.	FISCAL YEAR	SHEET NO.	TOTAL SHEETS
8	WASH.	I-405-3(297)178		7	297

LENGTH: 0.261 Mile

ITEM NO.	TOTAL QUANTITY	UNIT	ITEM	NORTHBOUND	SOUTHBOUND	S-E RAMP	E-N RAMP	N-W&N-E RAMP	W-S&E-S RAMP	W-S&E-S COLLISION WALL
1	LUMP SUM	L.S.	MOBILIZATION	L.S.	L.S.	L.S.	L.S.	L.S.	L.S.	L.S.
2	10	ONLY	SPECIAL CONCRETE INLETS	2	1			3	4	
3	782	LIN.FT.	DRAIN PIPE 8 INCH DIAMETER	145	120	50	67	215	185	
4	8.5	CU.YD.	HAND PLACED RIPRAP	1.5	1	0.5	0.5	2.5	2.5	
5	EST.4,000	DOLLAR	FLAGGING	EST.1,000	EST.1000			EST.1000	EST.1000	
BRIDGE ITEMS										
6	4,014	CU.YD.	SHAFT EXCAVATION	775	961			988	1,290	
7	16,373	CU.YD.	STRUCTURE EXCAVATION	3008	2,566	1,082	415	2,381	6,913	8
8	LUMP SUM	L.S.	SHORING AND CRIBS OR EXTRA EXCAVATION	L.S.	L.S.			L.S.	L.S.	
9	2,474	LIN.FT.	PREBORING FOR CONCRETE PILES	794	594	192	294		600	
10	6	ONLY	FURNISHING AND DRIVING CONCRETE TEST PILES 18" DIAMETER	1	1	1	1		2	
11	11,632	LIN.FT.	FURNISHING CONCRETE PILING 18" DIAMETER	2,798	2,282	864	933		4,755	
12	158	ONLY	DRIVING CONCRETE PILES 18" DIAMETER	32	26	15	15		70	
13	54	ONLY	FURNISHING AND DRIVING TIMBER TEST PILES	7	7	4	2	15	19	
14	111,064	LIN.FT.	FURNISHING TIMBER PILING (CREOSOTE TREATED)	18,473	15,276	6,324	2,400	18,199	50,482	
15	2,931	ONLY	DRIVING TIMBER PILES (CREOSOTE TREATED)	470	443	168	84	548	1,218	
16	2,666,615	POUND	STEEL REINFORCING BARS	386,429	410,491	117,879	73,314	640,253	1,037,091	1,158
17	778	CU.YD.	CONCRETE CLASS D	103	112			157	406	
18	3,931	CU.YD.	SHAFT CONCRETE	765	947			964	1,255	
19	6,677	CU.YD.	CONCRETE CLASS B	1,177	1,019	474	116	1,091	2,780	20
20	2,872	CU.YD.	CONCRETE CLASS AX	310	312	85	50	845	1,270	
21	LUMP SUM	L.S.	SUPERSTRUCTURE - NORTHBOUND	L.S.						
22	LUMP SUM	L.S.	SUPERSTRUCTURE - SOUTHBOUND		L.S.					
23	LUMP SUM	L.S.	SUPERSTRUCTURE - S-E RAMP			L.S.				
24	LUMP SUM	L.S.	SUPERSTRUCTURE - E-N RAMP				L.S.			
25	LUMP SUM	L.S.	SUPERSTRUCTURE - N-W AND N-E RAMP					L.S.		
26	LUMP SUM	L.S.	SUPERSTRUCTURE - W-S AND E-S RAMP						L.S.	
27	2,782	LIN.FT.	DOWNSPOUTS	465	560	133	44	380	1,200	
28	EST.2,785	DOLLAR	WATER REDUCING ADDITIVE	EST. 316	EST.315	EST. 74	EST. 60	EST. 870	EST.1,150	

SR 405
MP 23.49 TO MP 23.76
WOODINVILLE INTERCHANGE
 KING COUNTY
 WASHINGTON STATE HIGHWAY COMMISSION
 DEPARTMENT OF HIGHWAYS
 OLYMPIA, WASHINGTON
 GEORGE D. ZAHN, CHAIRMAN

I. HIKALSON
 H. WAISH
 BAKER FERGUSON
 JOHN N. RUPP




APPROVED Dec. 7, 1967

CONTRACT NO. 8-382 SHEET 7 OF 29 SHEETS

Feb 8, 1968	Changed Quant. Items 7, 13-16, 19 & 20	WMS.
Jan. 8, 1968	changed Quantities Items 14 & 15	D.L.M.
DATE	REVISION	BY

NOTE: For special features see special provisions.

1/1995

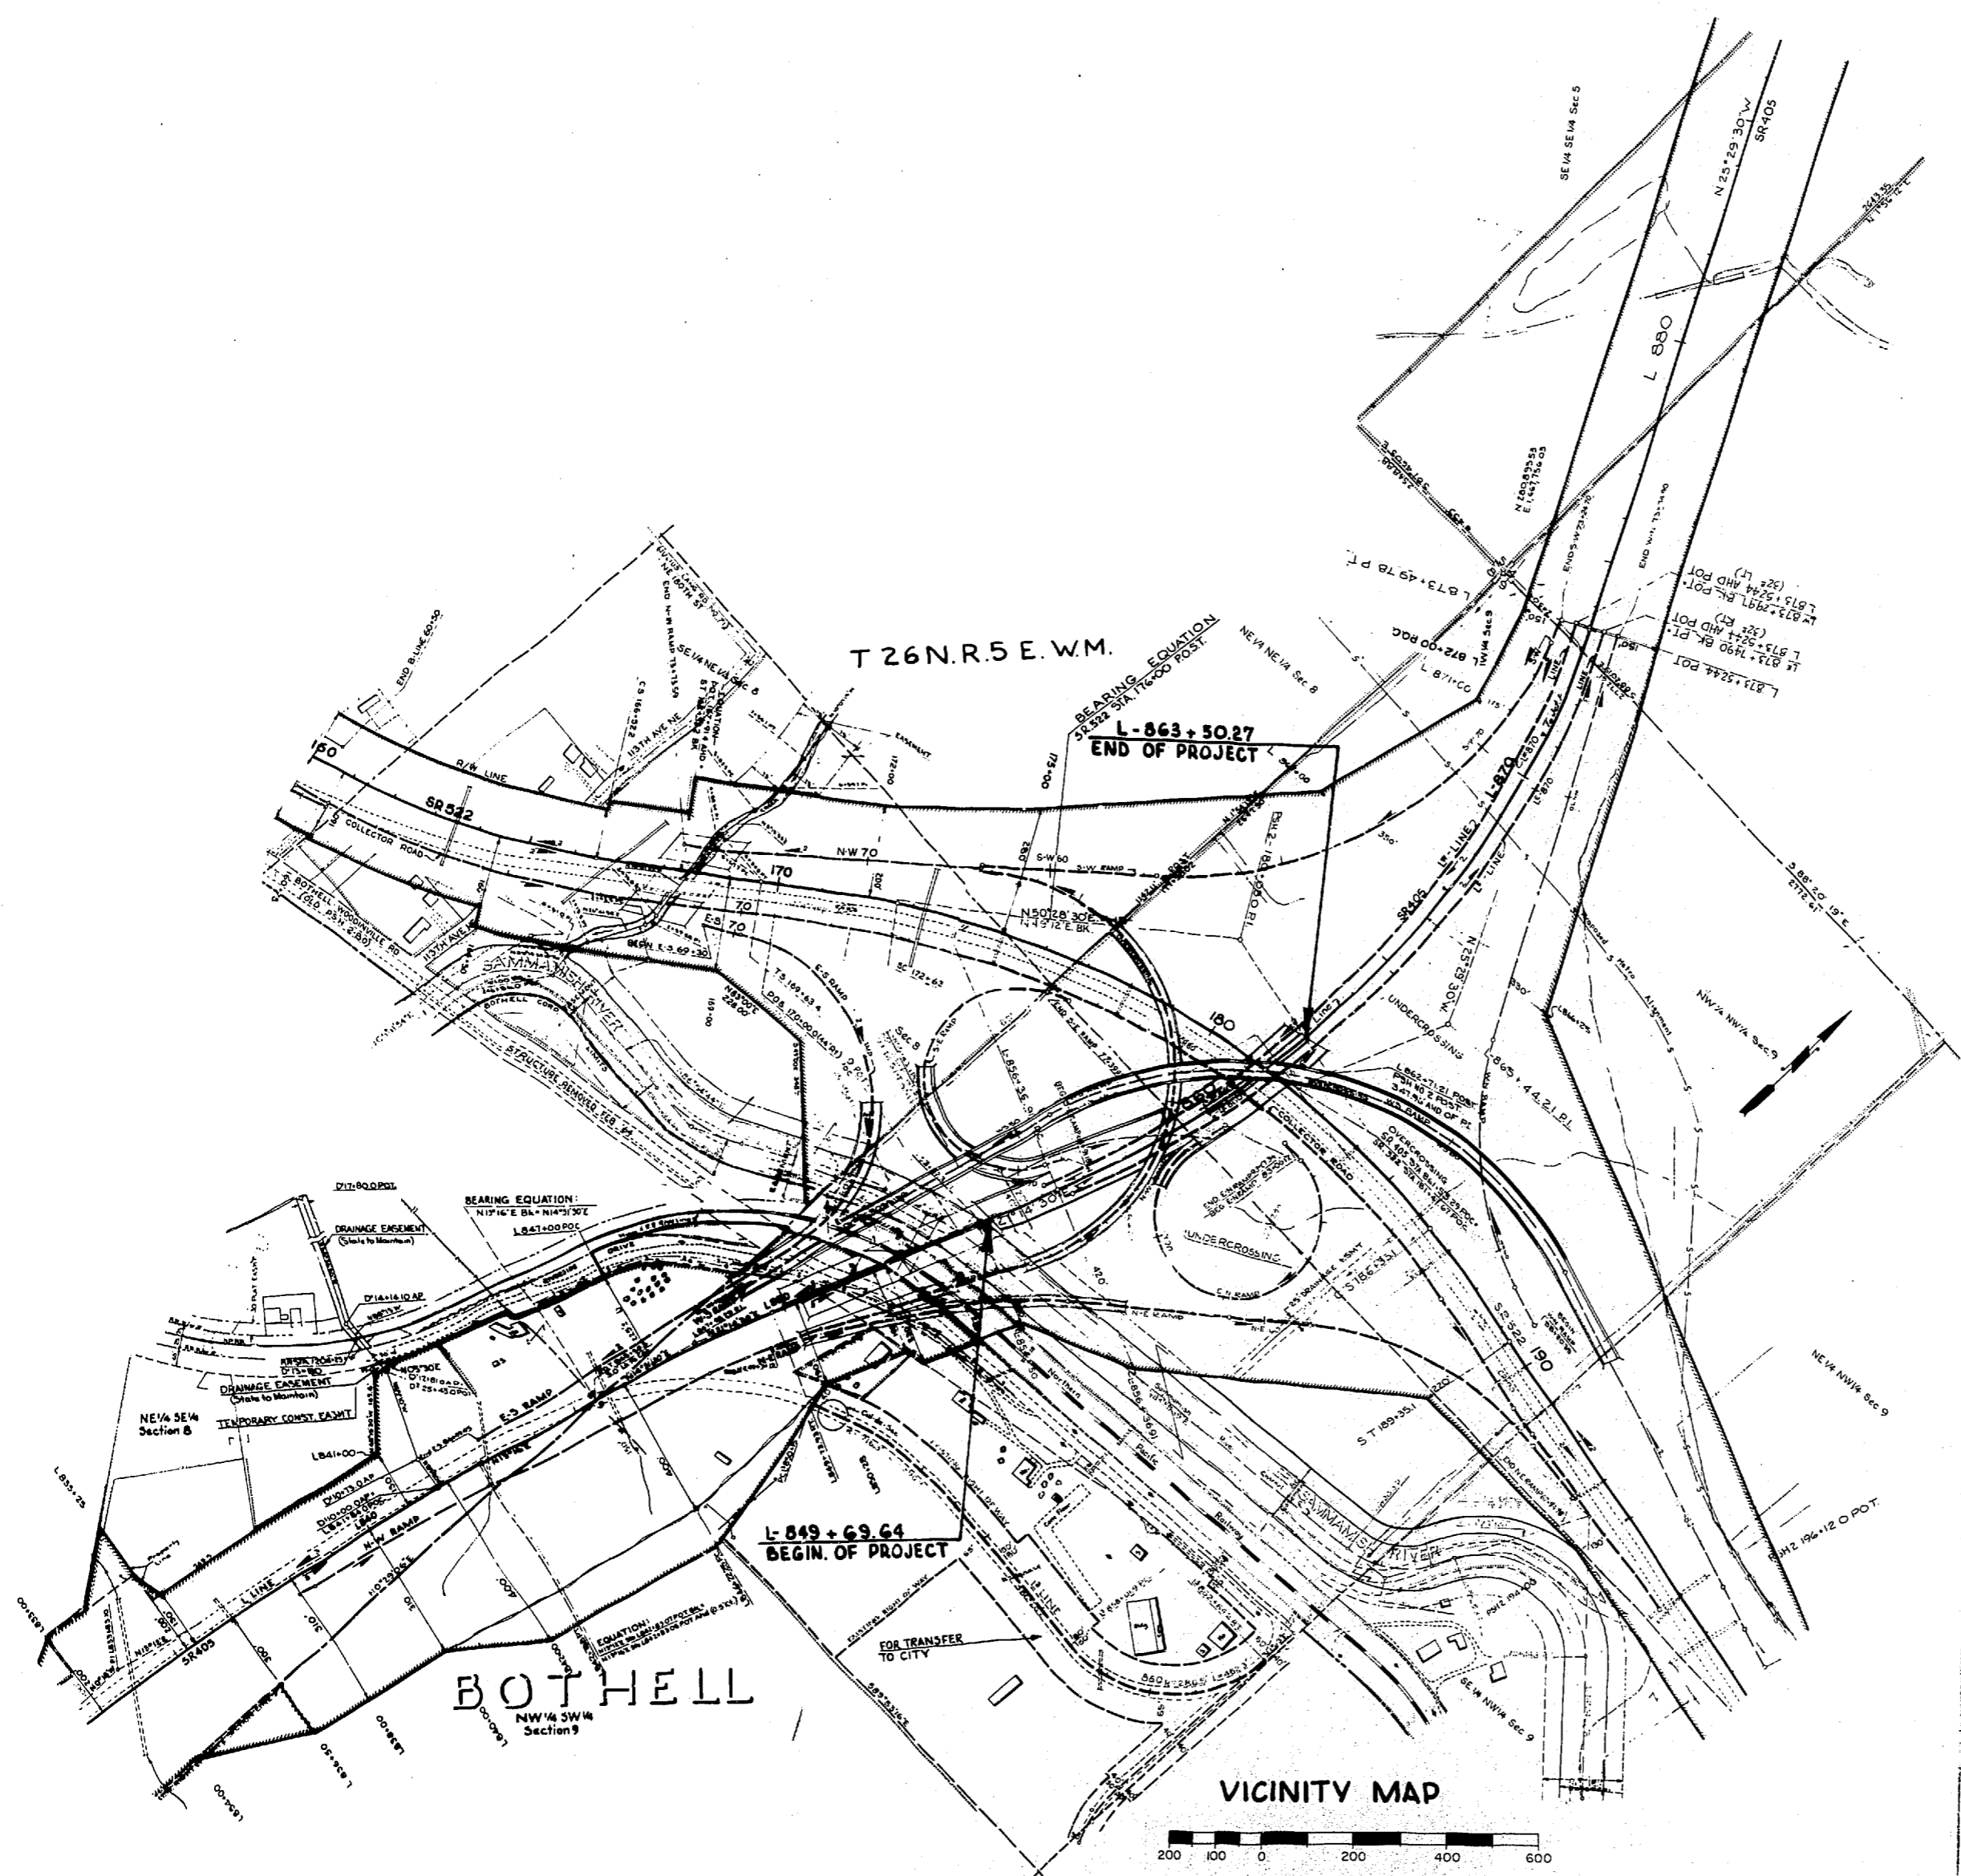


SR 405
MP 23.49 TO MP 23.76
WOODINVILLE INTERCHANGE
 KING COUNTY

VICINITY MAP

WASHINGTON STATE HIGHWAY COMMISSION
 DEPARTMENT OF HIGHWAYS
 OLYMPIA, WASHINGTON

GEORGE D. ZAHN, CHAIRMAN

R. L. REASON BAKER PRODUCTIONS
 H. WALSH JOHN H. BURT



Approved December 7, 1967

SHEET **8** OF 297 SHEETS

CONTRACT NO. 9382

132nd AVE. N.E. INTERCHANGE

WOODINVILLE



SR. 522

RIVERSIDE DRIVE

INTERSTATE 405

TO EVERETT

TO BELLEVUE

END PROJECT
L 863+50.27

BEGIN PROJECT
L 849+69.64

113th AVE. N.E.

TO BOTHELL

WOODINVILLE INTERCHANGE





DESIGNING ENGINEER	
DESIGNED	
TRACED	
DRAWN BY	
QUANTITIES FIGURED	
QUANTITIES CHECKED	

DATE	
BY	
DRAWN	
TRACED	
LOG. ENGR.	
DIRT. ENGR.	

WOODVILLE INTERCHANGE
 PSH NO. 1-RE/FSH NO. 2-BO
 STRUCTURE
 LAYOUT
 SHEET 227 OF 297

SEC. 9 T.26N., R.5E., W.M.

FED. ROAD DIV. NO.	STATE	FED. AID PROJ. NO.	SHEET NO.	TOTAL SHEETS
8	WASH.	I-405-3(297)118	227	297

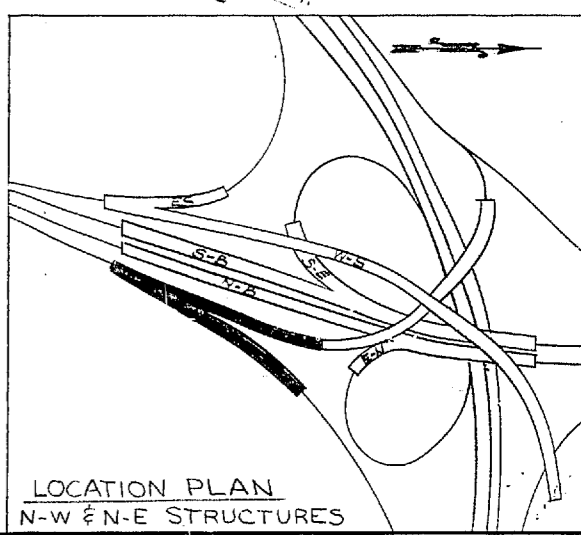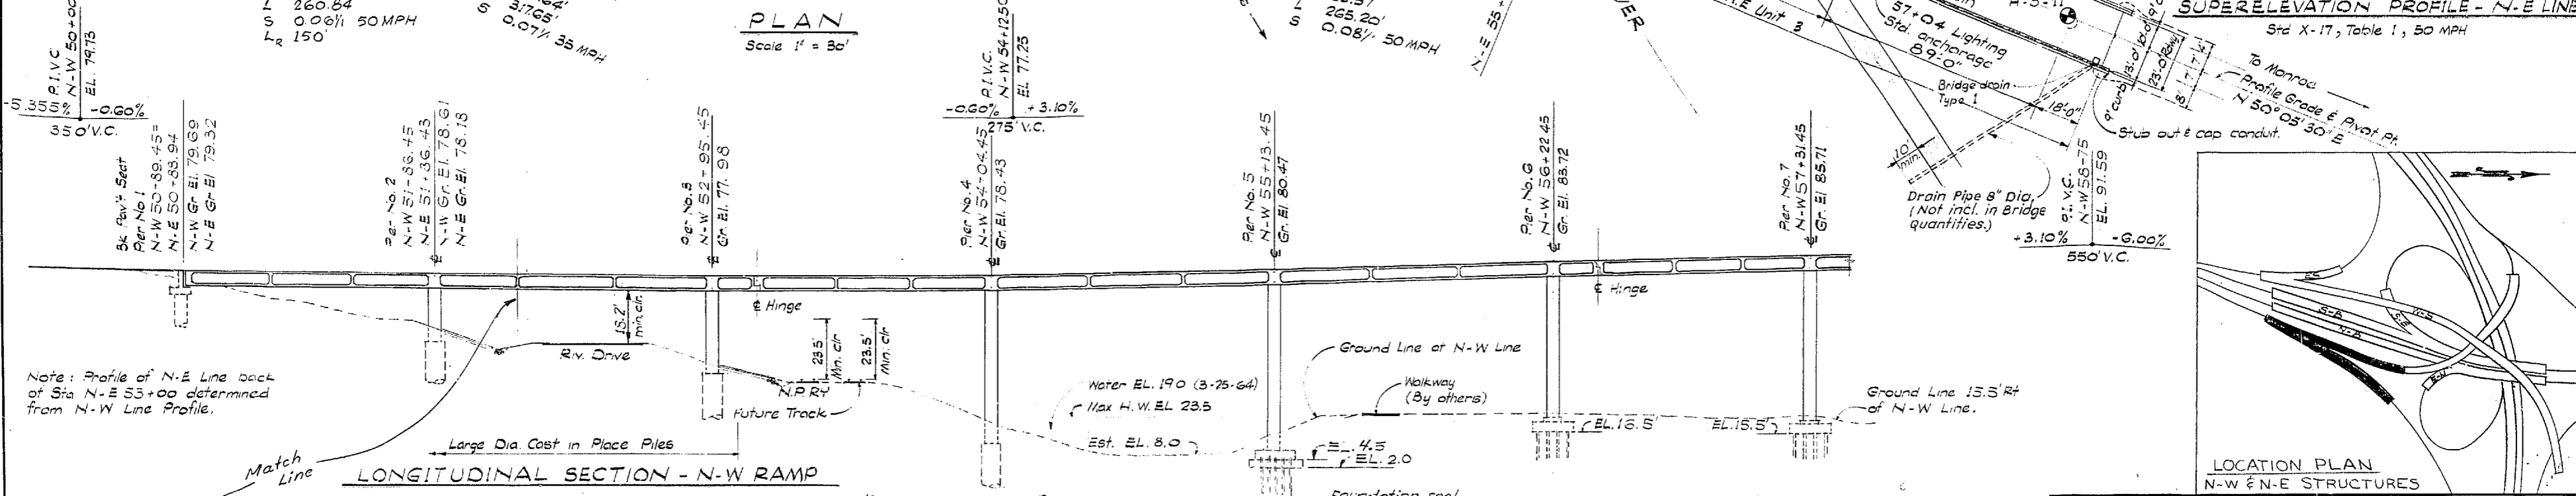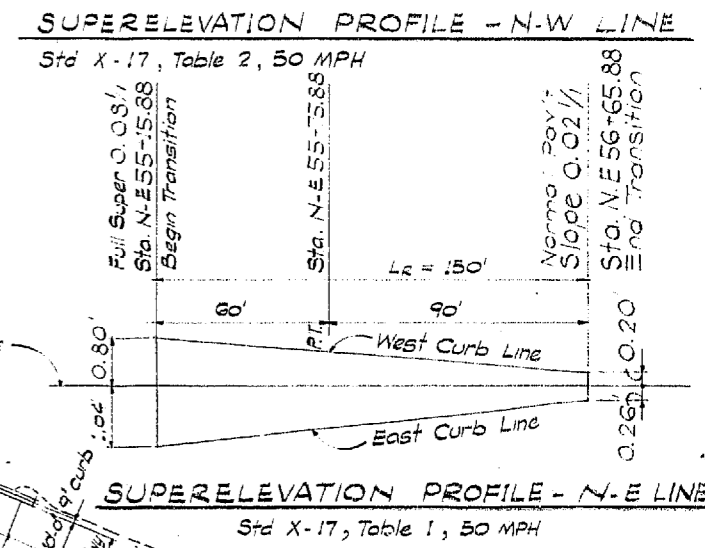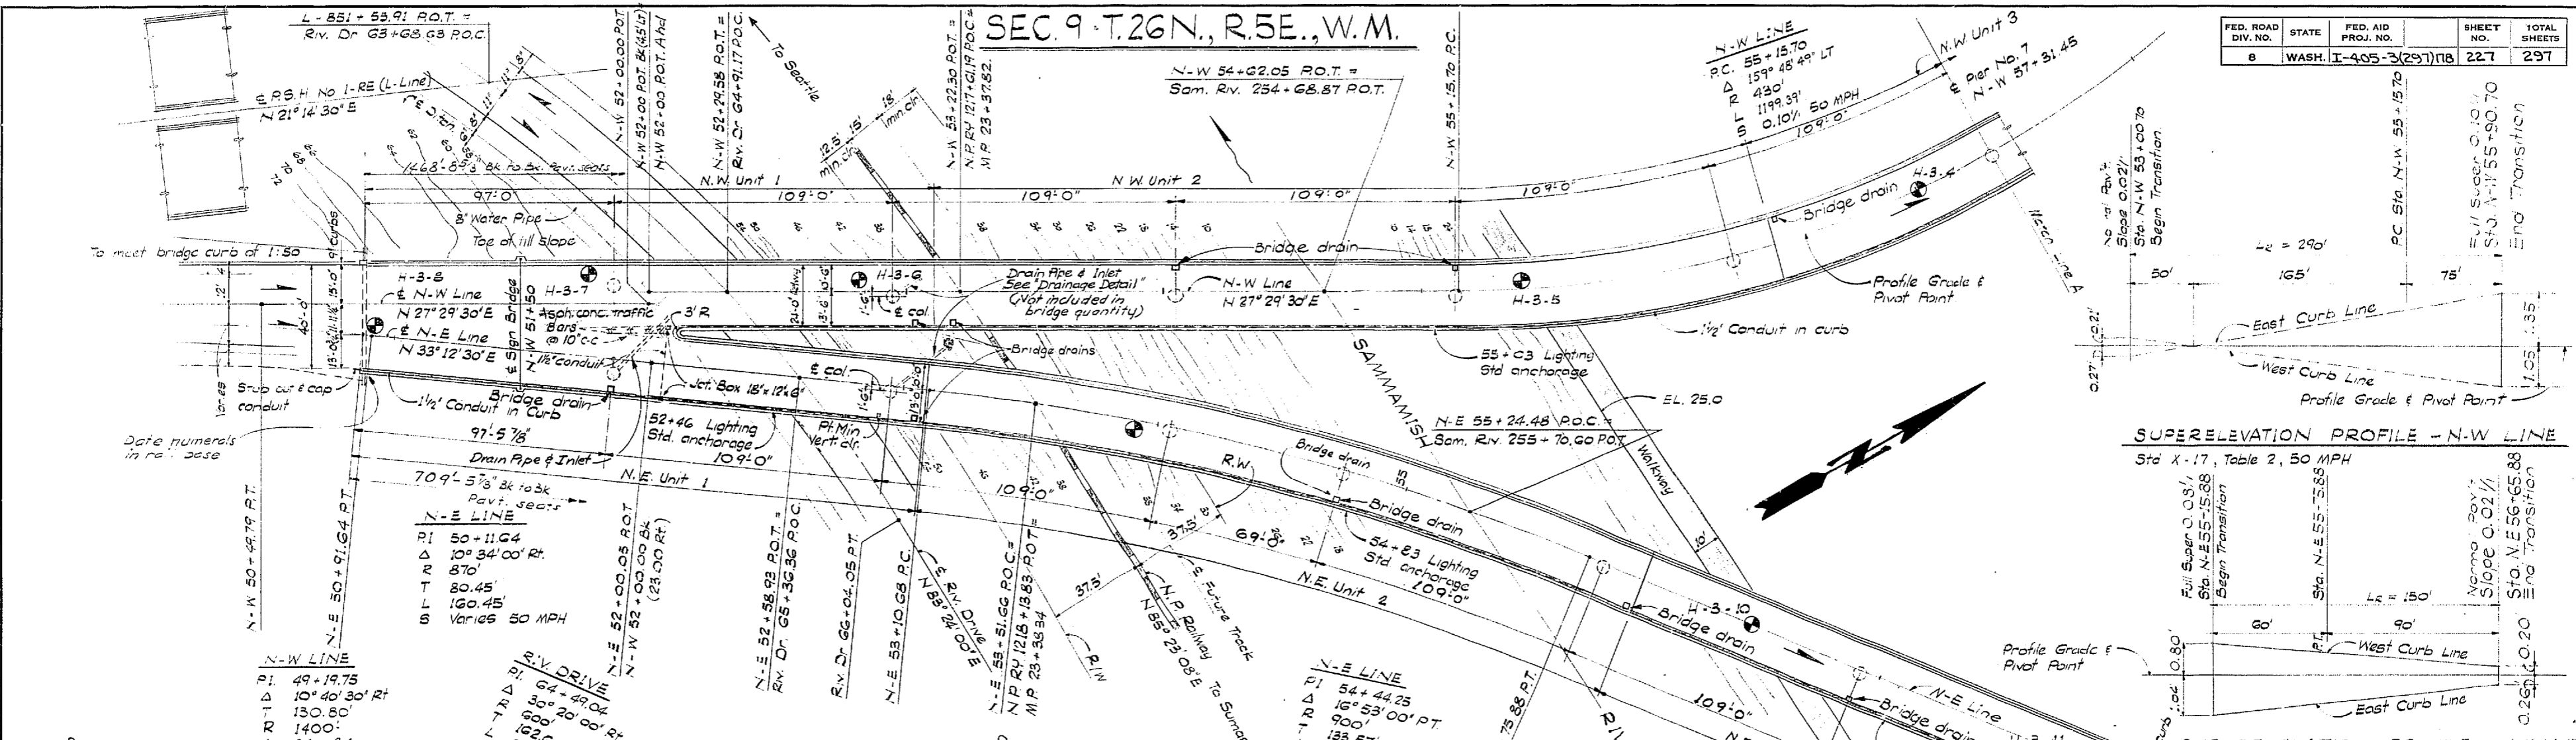

Max H.W.	EL. 23.5	50 yr flood
Norm H.W.	EL. 19.0	3-64
Norm stage	EL. 16.3	3-64
Extreme L.W.	EL. 13.0	

DATE _____ REVISION _____ BY _____

WORTHINGTON, SKILLING HELLE & JACKSON
 Consulting Civil and Structural Engineers
 SEATTLE WASHINGTON

SR 405
MP 23.49 TO MP 23.76
WOODVILLE INTERCHANGE
 KING COUNTY
N-W & N-E STRUCTURE

LAYOUT

WASHINGTON STATE HIGHWAY COMMISSION
 DEPARTMENT OF HIGHWAYS
 OLYMPIA, WASHINGTON

GEORGE D. ZANK, CHAIRMAN

F. L. M'ISAISON
 H. WASH

BAKER FERGUSON
 JOHN H. RUPP

APPROVED: December 7, 1967
 SHEET 227 OF 297 SHEETS
 CONTRACT NO. 8382

11-16-67

P/1995

FED. ROAD DIV. NO.	STATE	FED. AID PROJ. NO.	SHEET NO.	TOTAL SHEETS
8	WASH.	I-405-3(297)178	228	297

SEC. 8 & 9 T.26N., R5E. W.M.

N-W LINE
 PC 55+15.70
 Δ 159° 48' 49" Lt
 R 430'
 L 1199.39'
 S 0.10%

L, L & L LINES
 P.I. L 865+19.09
 P.I. L 865+44.21
 P.I. L 865+69.33
 Δ 46° 44' Lt
 R 2100'
 L 1712.87'
 S 0.08%



W-S LINE
 P.I. 59+13.15
 Δ 91° 42' 14" Rt
 R 800'
 T 824.15'
 L 1280.43'
 S 0.07% (40 MPH)

P.S.H. No. 2.50
 P.I. 180+08.00
 Δ 50° 09' Rt
 R 41' 04"
 CA 3'
 RO 19.10 d'
 T 1024.60'
 L 1371.70'
 S 0.07%
 DE 4' 30"
 Ls 3.00

EBCD LINE
 P.I. 80+42.71
 Δ 49° 29' Rt
 R 1839'
 T 847.47'
 L 1588.25'
 S 0.04%

DESIGNED BY	
CHECKED BY	
DRAWN BY	
QUANTITIES CHECKED	

DATE	
BY	
TRACED	
CHECKED	
LOC. ENGR.	
DIST. ENGR.	

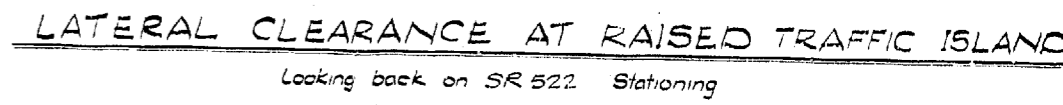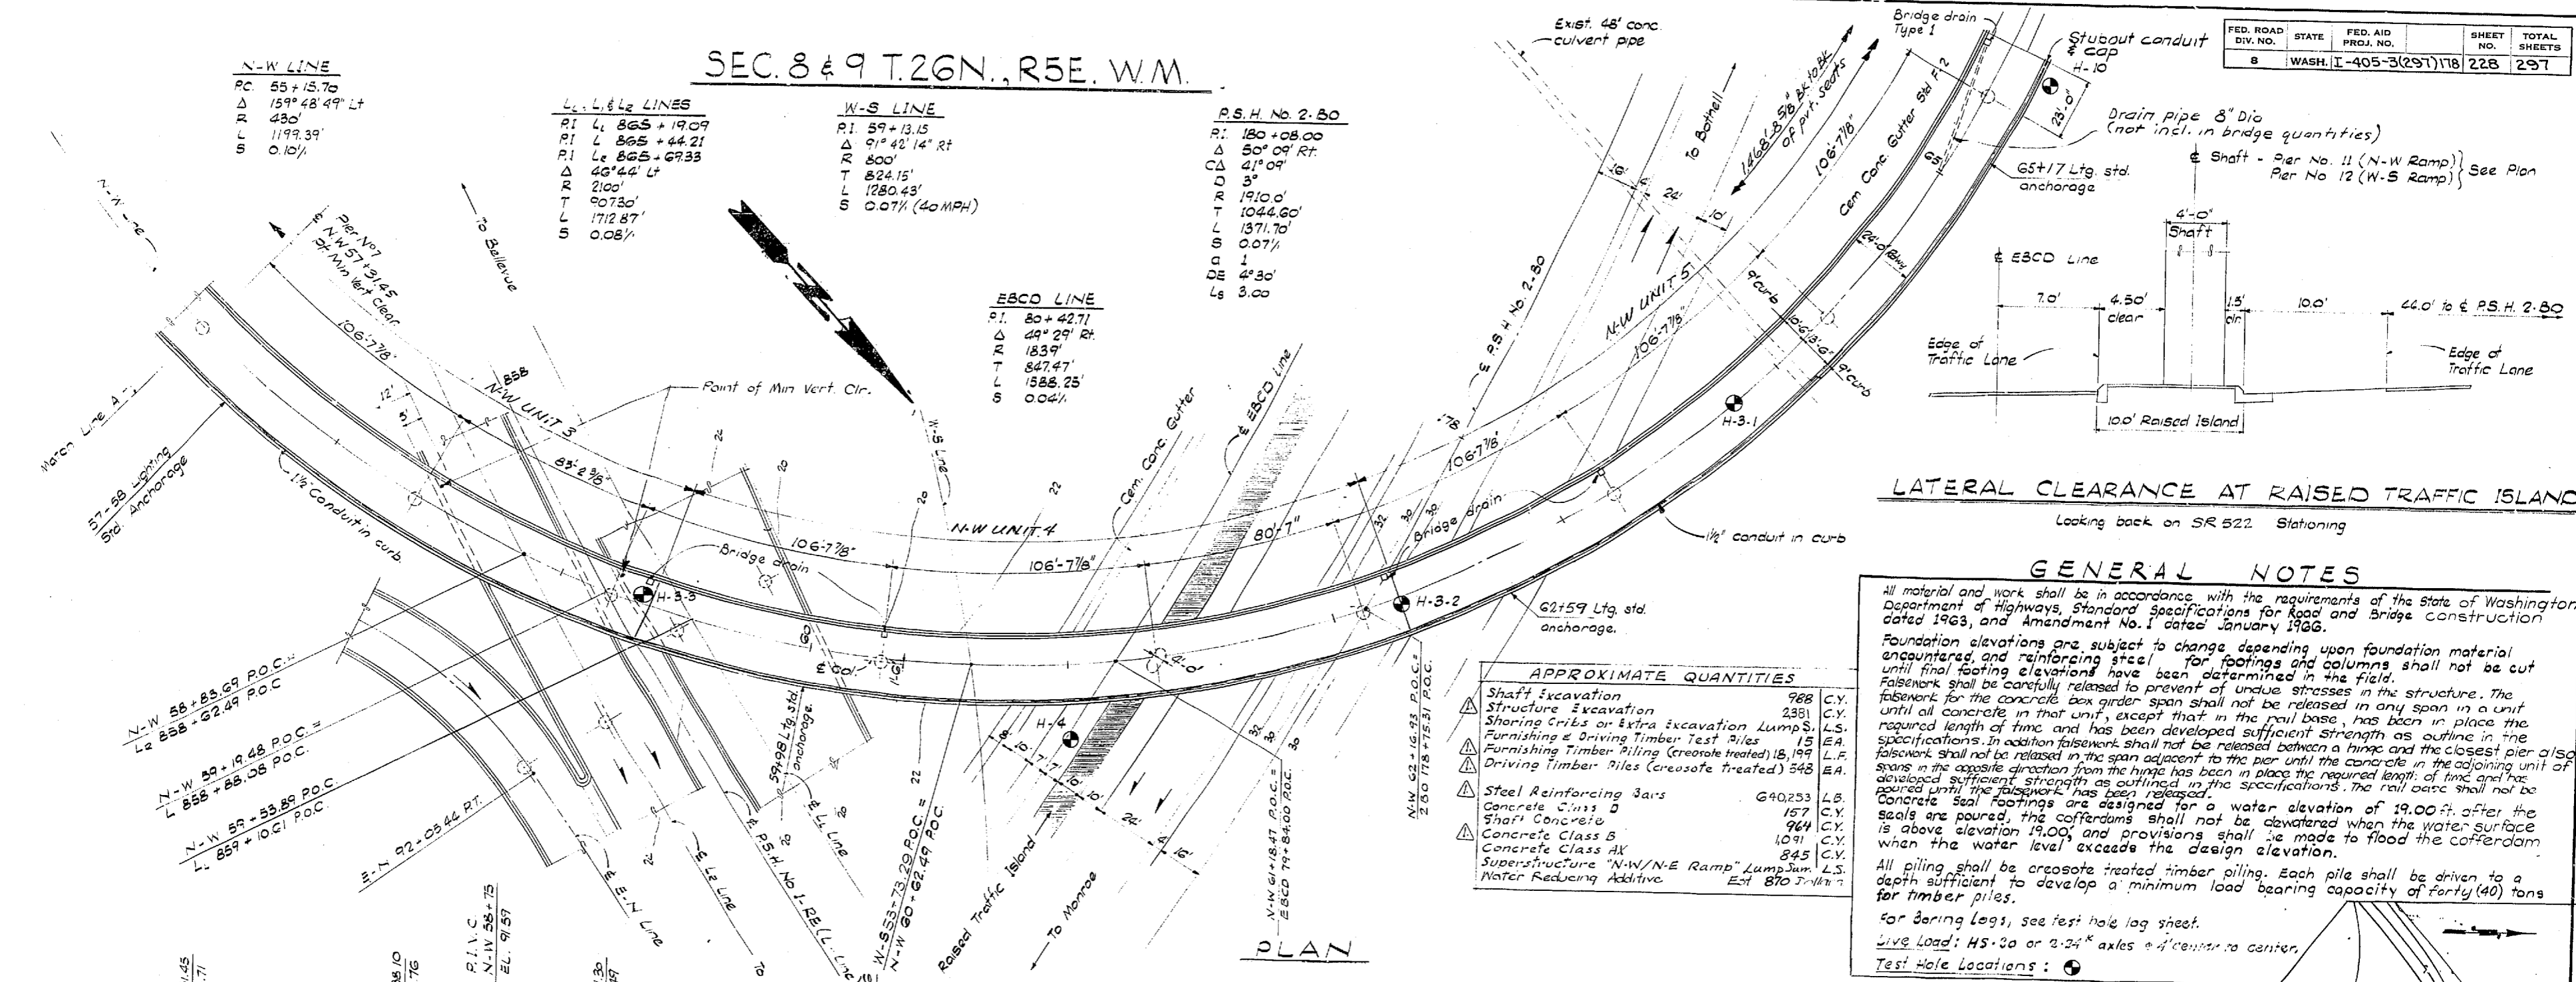

GENERAL NOTES

All material and work shall be in accordance with the requirements of the State of Washington Department of Highways, Standard Specifications for Road and Bridge Construction dated 1963, and Amendment No. 1 dated January 1966.

Foundation elevations are subject to change depending upon foundation material encountered and reinforcing steel for footings and columns shall not be cut until final footing elevations have been determined in the field.

Falswork shall be carefully released to prevent of undue stresses in the structure. The falswork for the concrete box girder span shall not be released in any span in a unit until all concrete in that unit, except that in the rail base, has been in place the required length of time and has been developed sufficient strength as outlined in the specifications. In addition falswork shall not be released between a hinge and the closest pier also falswork shall not be released in the span adjacent to the pier until the concrete in the adjoining unit of spans in the opposite direction from the hinge has been in place the required length of time and has developed sufficient strength as outlined in the specifications. The rail base shall not be poured until the falswork has been released.

Concrete Seal Footings are designed for a water elevation of 19.00 ft. after the seals are poured, the cofferdams shall not be dewatered when the water surface is above elevation 19.00, and provisions shall be made to flood the cofferdam when the water level exceeds the design elevation.

All piling shall be creosote treated timber piling. Each pile shall be driven to a depth sufficient to develop a minimum load bearing capacity of forty (40) tons for timber piles.

For boring logs, see test hole log sheet.


Live Load: HS-20 or 3-24' axles 4' center to center.

Test Hole Locations: ●

APPROXIMATE QUANTITIES


Shaft Excavation	988	C.Y.
Structure Excavation	2381	C.Y.
Shoring Cribbs or Extra Excavation Lump Sum	15	L.S.
Furnishing & Driving Timber Test Piles	15	EA.
Furnishing Timber Piling (Creosote treated)	18,199	L.F.
Driving Timber Piles (Creosote treated)	548	EA.
Steel Reinforcing Bars	640,253	L.B.
Concrete Class B	157	C.Y.
Shaft Concrete	964	C.Y.
Concrete Class B	1,091	C.Y.
Concrete Class A	845	C.Y.
Superstructure "N-W/N-E Ramp" Lump Sum	Est 870	L.S.
Water Reducing Additive	Est 11.7	L.B.

PLAN

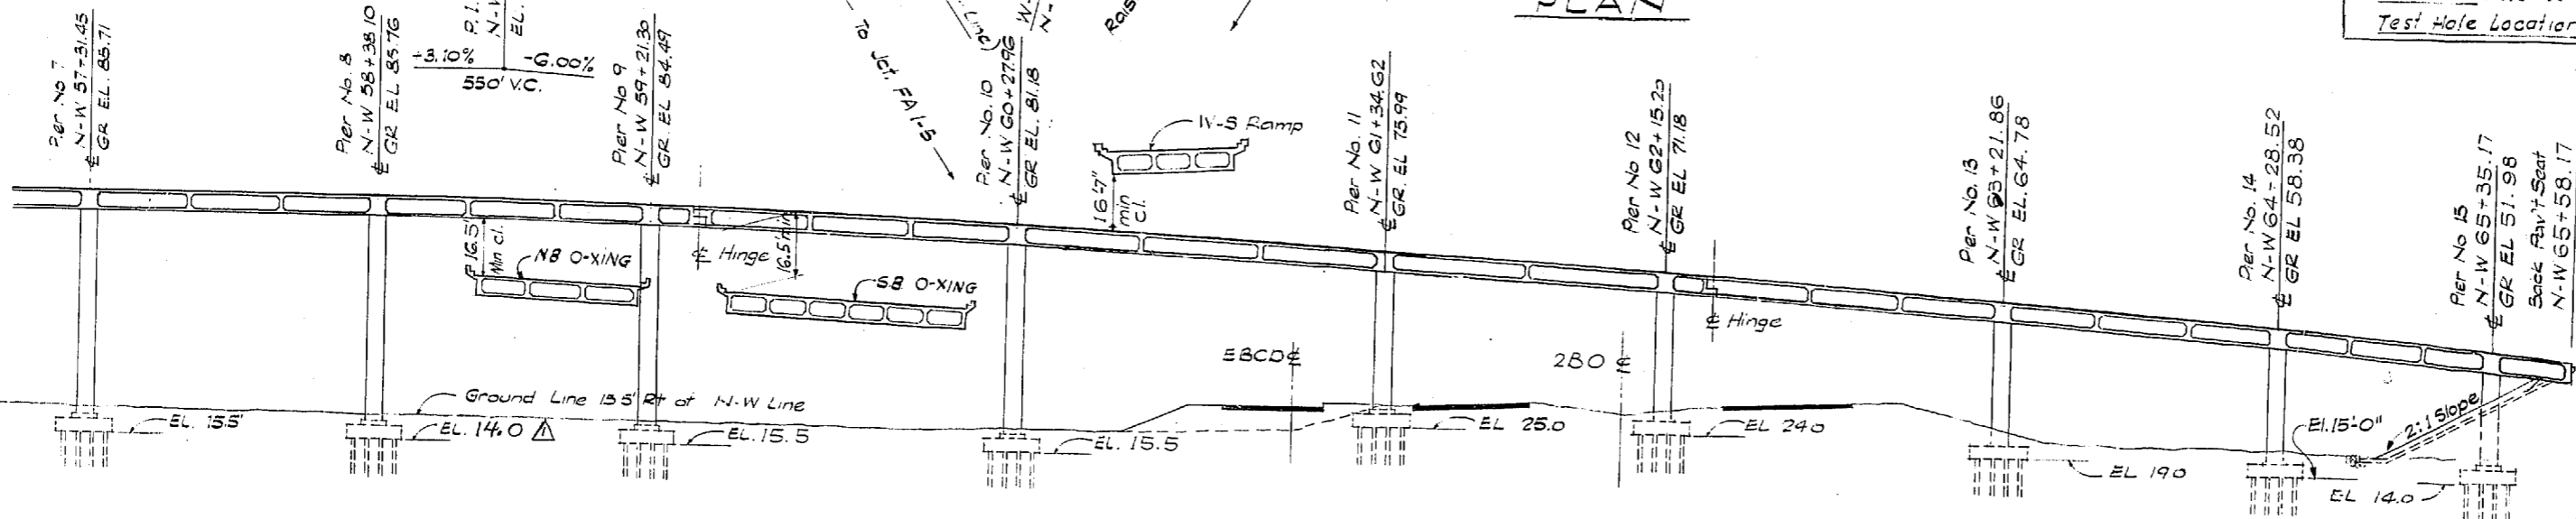

DEVELOPED LONGITUDINAL SECTION - N-W RAMP

Grade elevations shown are finished grade on N-W Line & are equal to profile grade.

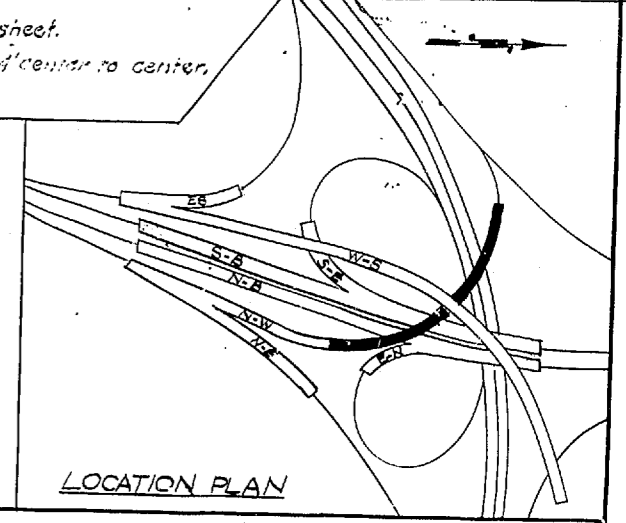

SR 405
MP 23.49 TO MP 23.76
WOODINVILLE INTERCHANGE
 KING COUNTY
N-W & N-E STRUCTURE

LAYOUT

WASHINGTON STATE HIGHWAY COMMISSION
 DEPARTMENT OF HIGHWAYS
 OLYMPIA, WASHINGTON

F. I. MYAISON
 M. WASH
 GEORGE D. ZAMM, CHAIRMAN
 BAKER PEROUSS
 JOHN H. RUPP

APPROVED December 7, 1967
 SHEET 228 OF 297 SHEETS
 CONTRACT NO. 8982

2-8-66	Revised Fty Elev. & Approx Quant	WJS
DATE	REVISION	BY

**WORTHINGTON, SKILLING
 HELLE & JACKSON**
 Consulting Civil and Structural Engineers
 SEATTLE WASHINGTON

U.S.C. & G.S.
 Mean Sea Level - 1947 Adj.


11-16-67

WOODINVILLE INTERCHANGE
 PSH NO STRUCTURE NO. 180
 N-W RAMP
 SHEET 228 OF 297

P/1995

REINFORCING ENGINEER
DESIGNED
CHECKED
DRAWN BY
DATE

DATE
BY
CHECKED
LOC. ENGR.
DIST. ENGR.

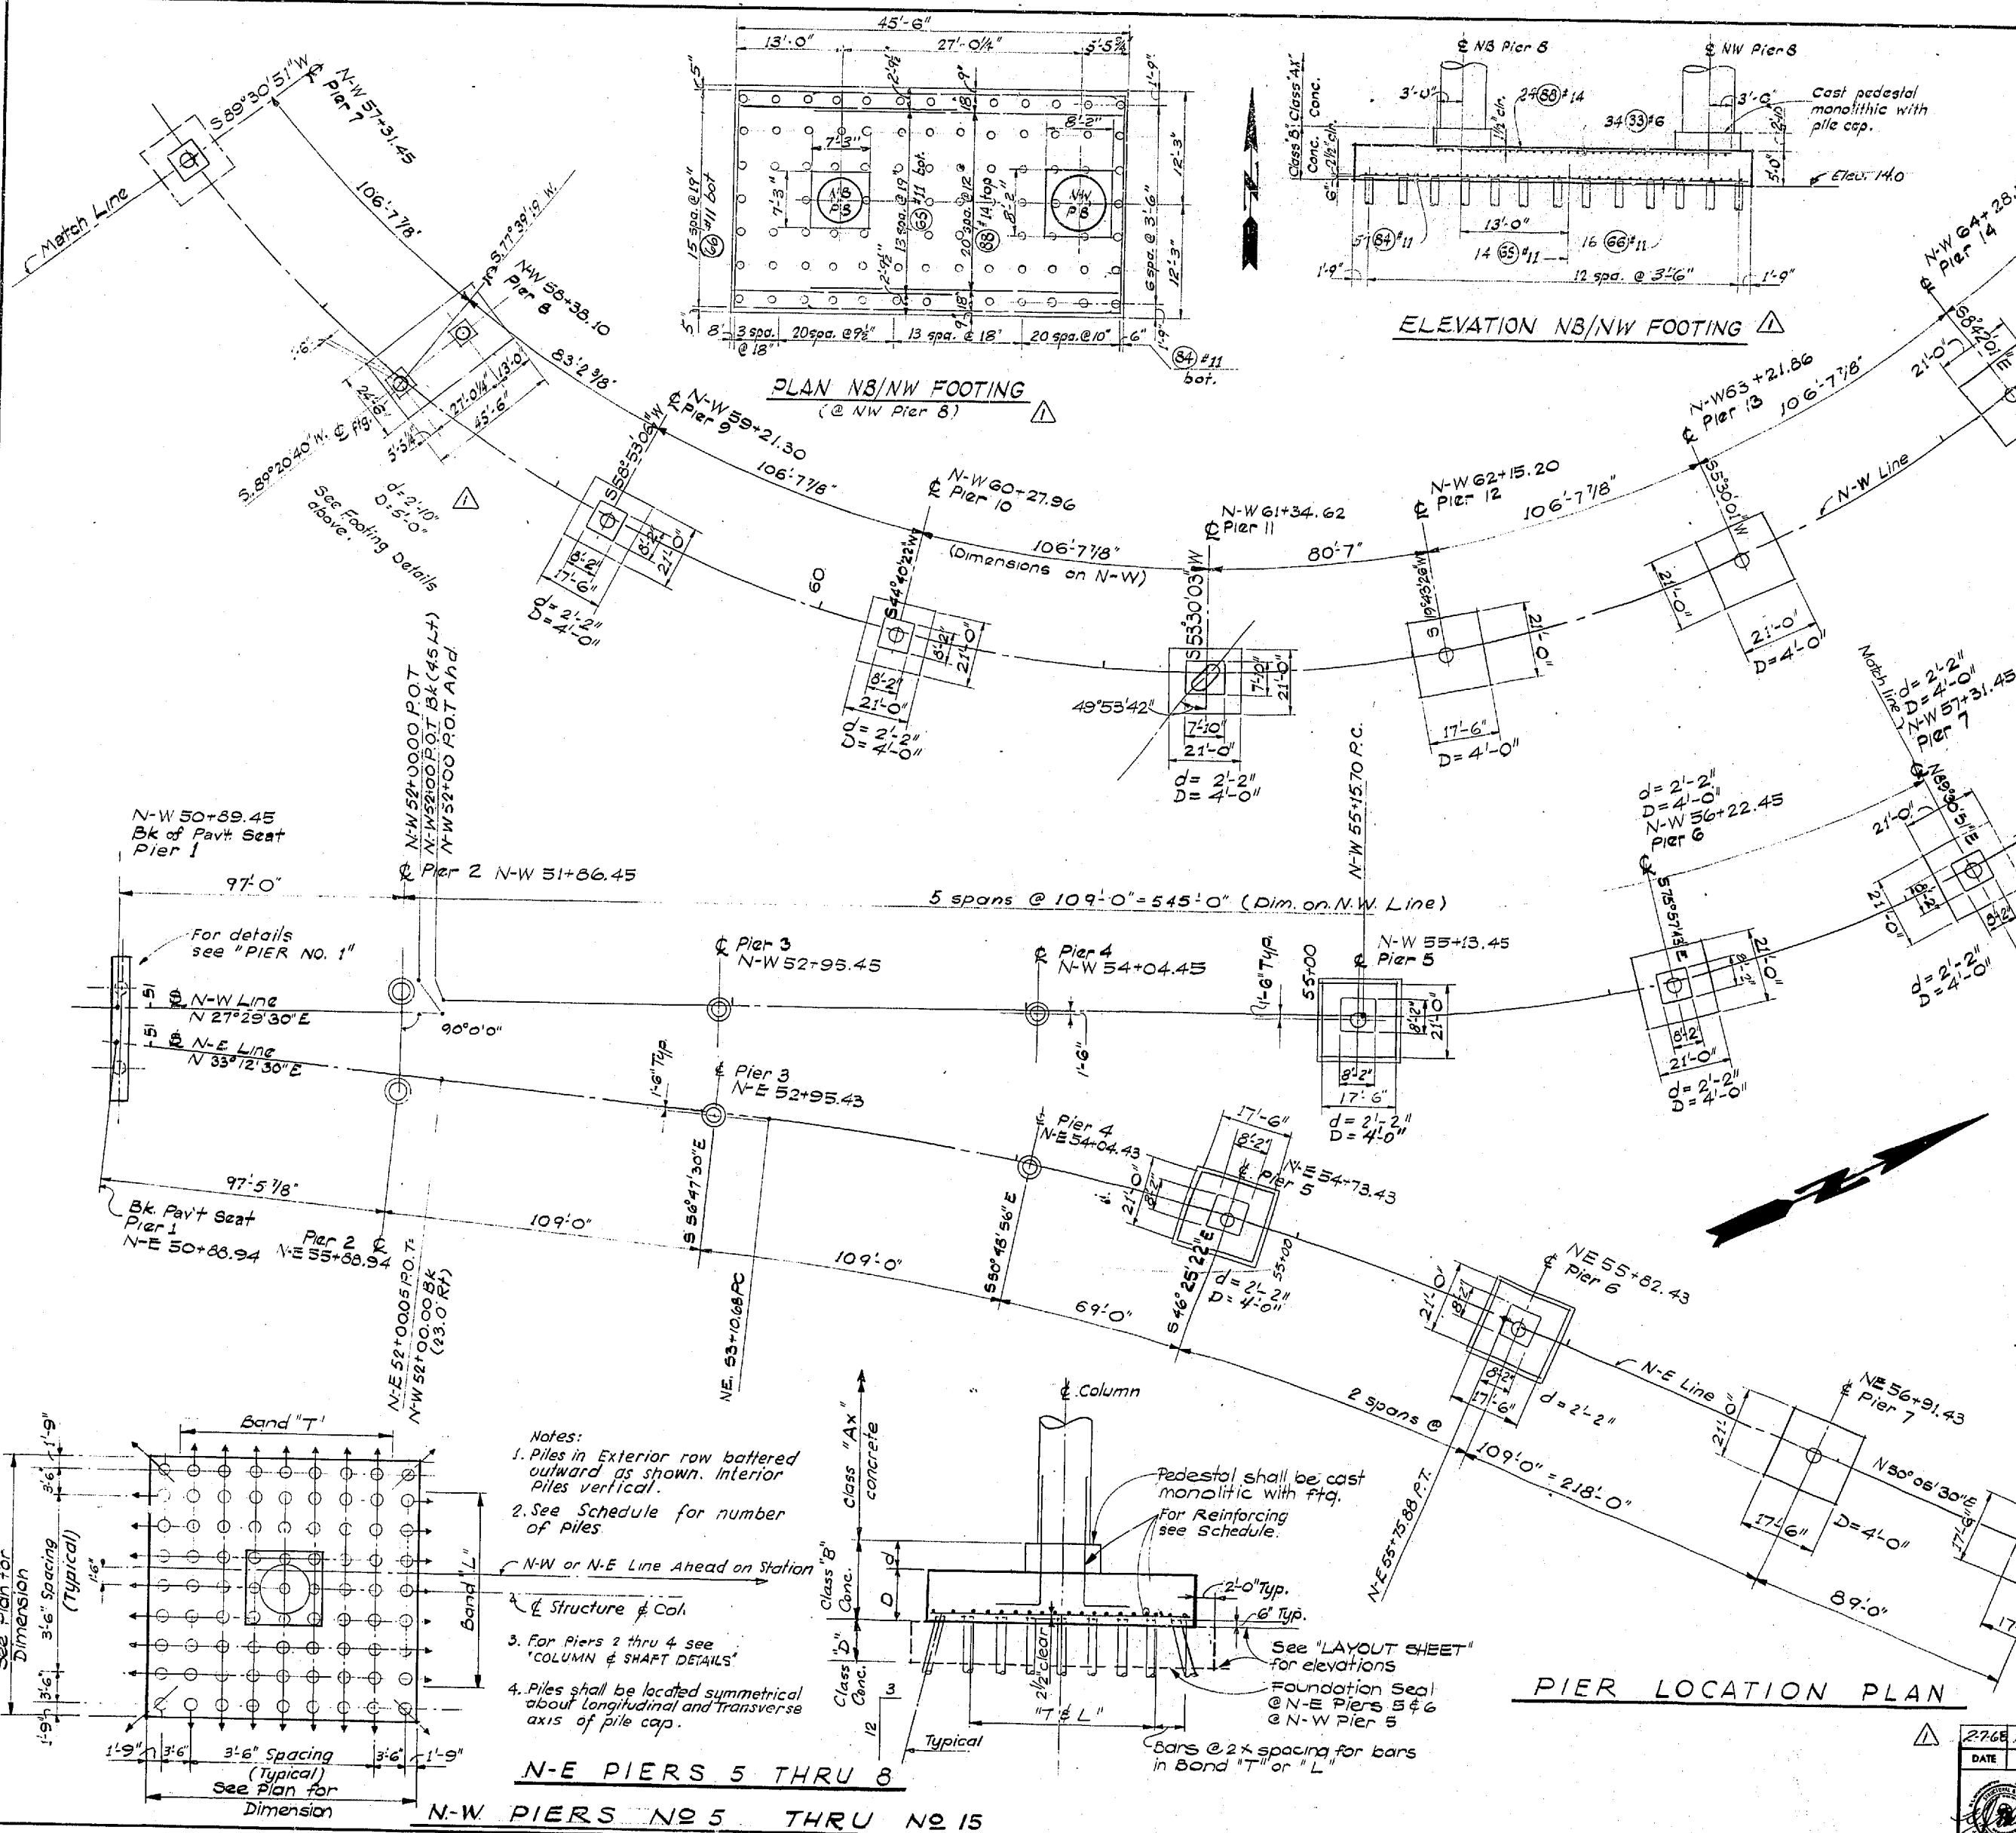

PIER FOOTING SCHEDULE

PIER NO.	PILES/ROW LONGIT.	PILES/ROW TRANS.	TOTAL PILES	MIN TIP ELEV.	BARS IN BAND		REINFORCING BARS			
					BAND "L"	BAND "T"	TOT. LONGIT.	TOT. TRANS.		
N-W/N-E STRUCTURE										
N-W STRUCTURE										
5	5	6	30	-20	2429	3226	26(54)*11	34(55)*11	13(56)*18	13(53)*18
6	6	6	36	-20	3526	3526	39(57)*11	39(58)*11	17(59)*14	17(60)*14
7	6	6	36	-20	3526	3526	39(61)*11	39(62)*11	18(63)*14	18(64)*14
8	SEE DETAIL	91	-20	SEE DETAIL	SEE DETAIL	SEE DETAIL	16(67)*14	16(68)*14		
9	5	6	30	-10	2429	3226	26(69)*11	34(70)*11	12(71)*14	12(72)*14
10	6	6	36	-10	3526	3526	39(73)*11	39(74)*11	14(75)*14	14(76)*14
11	6	6	36	-15	3526	3526	39(77)*11	39(78)*11	14(79)*18	14(80)*18
12	5	6	30	-20	2429	3226	26(81)*11	34(82)*11	26(83)*11	26(84)*11
15	6	6	36	-20	3526	3526	39(85)*11	39(86)*11	26(87)*11	26(88)*11
14	6	6	36	-15	3526	3526	39(89)*11	39(90)*11	26(91)*11	26(92)*11
15	6	6	36	-20	3526	3526	39(92)*11	39(93)*11	20(94)*14	20(95)*14
N-E STRUCTURE										
5	5	6	30	-10	2429	3226	26(96)*11	34(97)*11	14(98)*18	14(99)*18
6	5	6	30	-20	2429	3226	26(100)*11	34(101)*11	14(102)*18	14(103)*18
7	5	6	30	-15	2429	3226	26(104)*11	34(105)*11	19(106)*11	19(107)*11
8	5	5	25	-15	2526	2526	27(107)*9	27(108)*9	19(109)*11	19(110)*11

**SR 405
MP 23.49 TO MP 23.76
WOODINVILLE INTERCHANGE
KING COUNTY
N-W & N-E STRUCTURE**

PIER LOCATION PLAN

WASHINGTON STATE HIGHWAY COMMISSION
DEPARTMENT OF HIGHWAYS
OLYMPIA, WASHINGTON

GEORGE D. ZAHM, CHAIRMAN

F. L. HAYSON
N. WALSH

BATES FERRELLSON
JOHN N. RUPP

APPROVED December 7, 1967
SHEET 229 OF 297 SHEETS
CONTRACT NO. 8382

BRIDGE ENGINEER

2768 Revised N.W. Pier 8. Ftg. & Add. Det. WJS

DATE	REVISION	BY




**WORTHINGTON, SKILLING
HELLE & JACKSON**
Consulting Civil and Structural Engineers
SEATTLE WASHINGTON

As Built Changes in Red 9-15-70

1/1995

TABLE OF REINFORCING & ELEVATIONS

COLUMN	ELEV. A	ELEV. B	COLUMN DIAMETER	BAR "A"	BAR "B"	BAR "C"	BARS "D"	BARS "E"	BARS "F"
N-W & N-E STRUCTURE									
1				- SEE PIER NO 2 PLAN SHEET -					
2 East	-43.0	52.0	6'-0"	52 (35) #4	28 (11) #4	50 (36) #4	17 (12) #14	17 (13) #14	17 (37) #14
2 West	-46.0	52.0	6'-0"	54 (35) #4	28 (11) #4	50 (39) #4	17 (14) #14	17 (15) #14	17 (40) #14
N-W STRUCTURE									
3	-39.5	40.5	6'-0"	49 (45) #4	38 (11) #4	38 (42) #14	23 (116) #18	23 (117) #18	23 (43) #18
4	-76.5	18.5	6'-0"	53 (45) #4	62 (11) #4	100 (46) #18	26 (118) #11		26 (47) #11
5	4.5	6'-0"	6'-0"		74 (11) #4				73 (110) #18
6	16.5	6'-0"	6'-0"		64 (11) #4				13 (119) #18
7	15.5	6'-0"	6'-0"		67 (11) #4				17 (120) #14
8	15.0	6'-0"	6'-0"		66 (11) #4				18 (122) #14
9	15.5	6'-0"	6'-0"		66 (11) #4				16 (124) #14
10	15.5	6'-0"	6'-0"		66 (11) #4				12 (126) #14
11	25.0	6'-0"	6'-0"		63 (11) #4				14 (128) #14
12	24.0	6'-0"	6'-0"	see Sec C-C	48 (130) #4				14 (133) #18
13	19.0	6'-0"	6'-0"		44 (11) #4				26 (134) #11
14	15.0	6'-0"	6'-0"		43 (11) #4				26 (136) #11
15	14.0	6'-0"	6'-0"		40 (11) #4				26 (138) #11
N-E STRUCTURE									
3	-31.5	48.5	6'-0"	49 (45) #4	29 (11) #4	36 (48) #14	23 (141) #18	23 (142) #18	23 (49) #18
4	-51.5	28.5	5'-0"	52 (45) #4	47 (143) #4	46 (51) #18	19 (144) #11		19 (52) #11
5	4.0	5'-0"	5'-0"		65 (143) #4				14 (146) #18
6	4.0	5'-0"	5'-0"		67 (143) #4				14 (148) #18
7	19.0	5'-0"	5'-0"		40 (143) #4				19 (150) #11
8	40.0	5'-0"	5'-0"		15 (143) #4				19 (151) #11

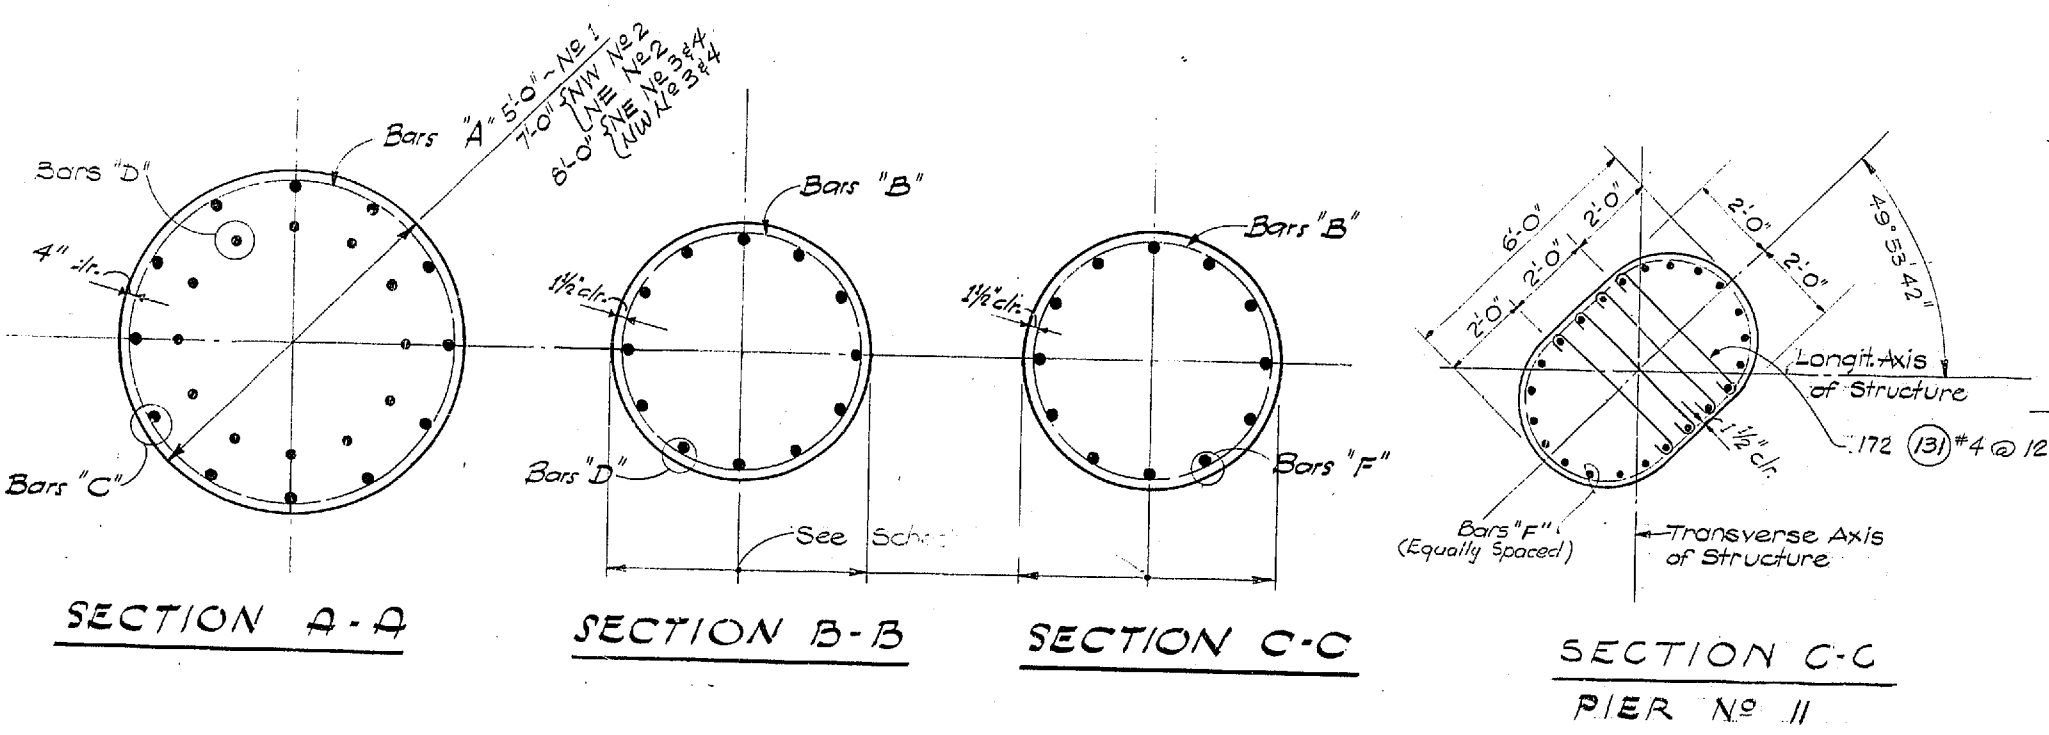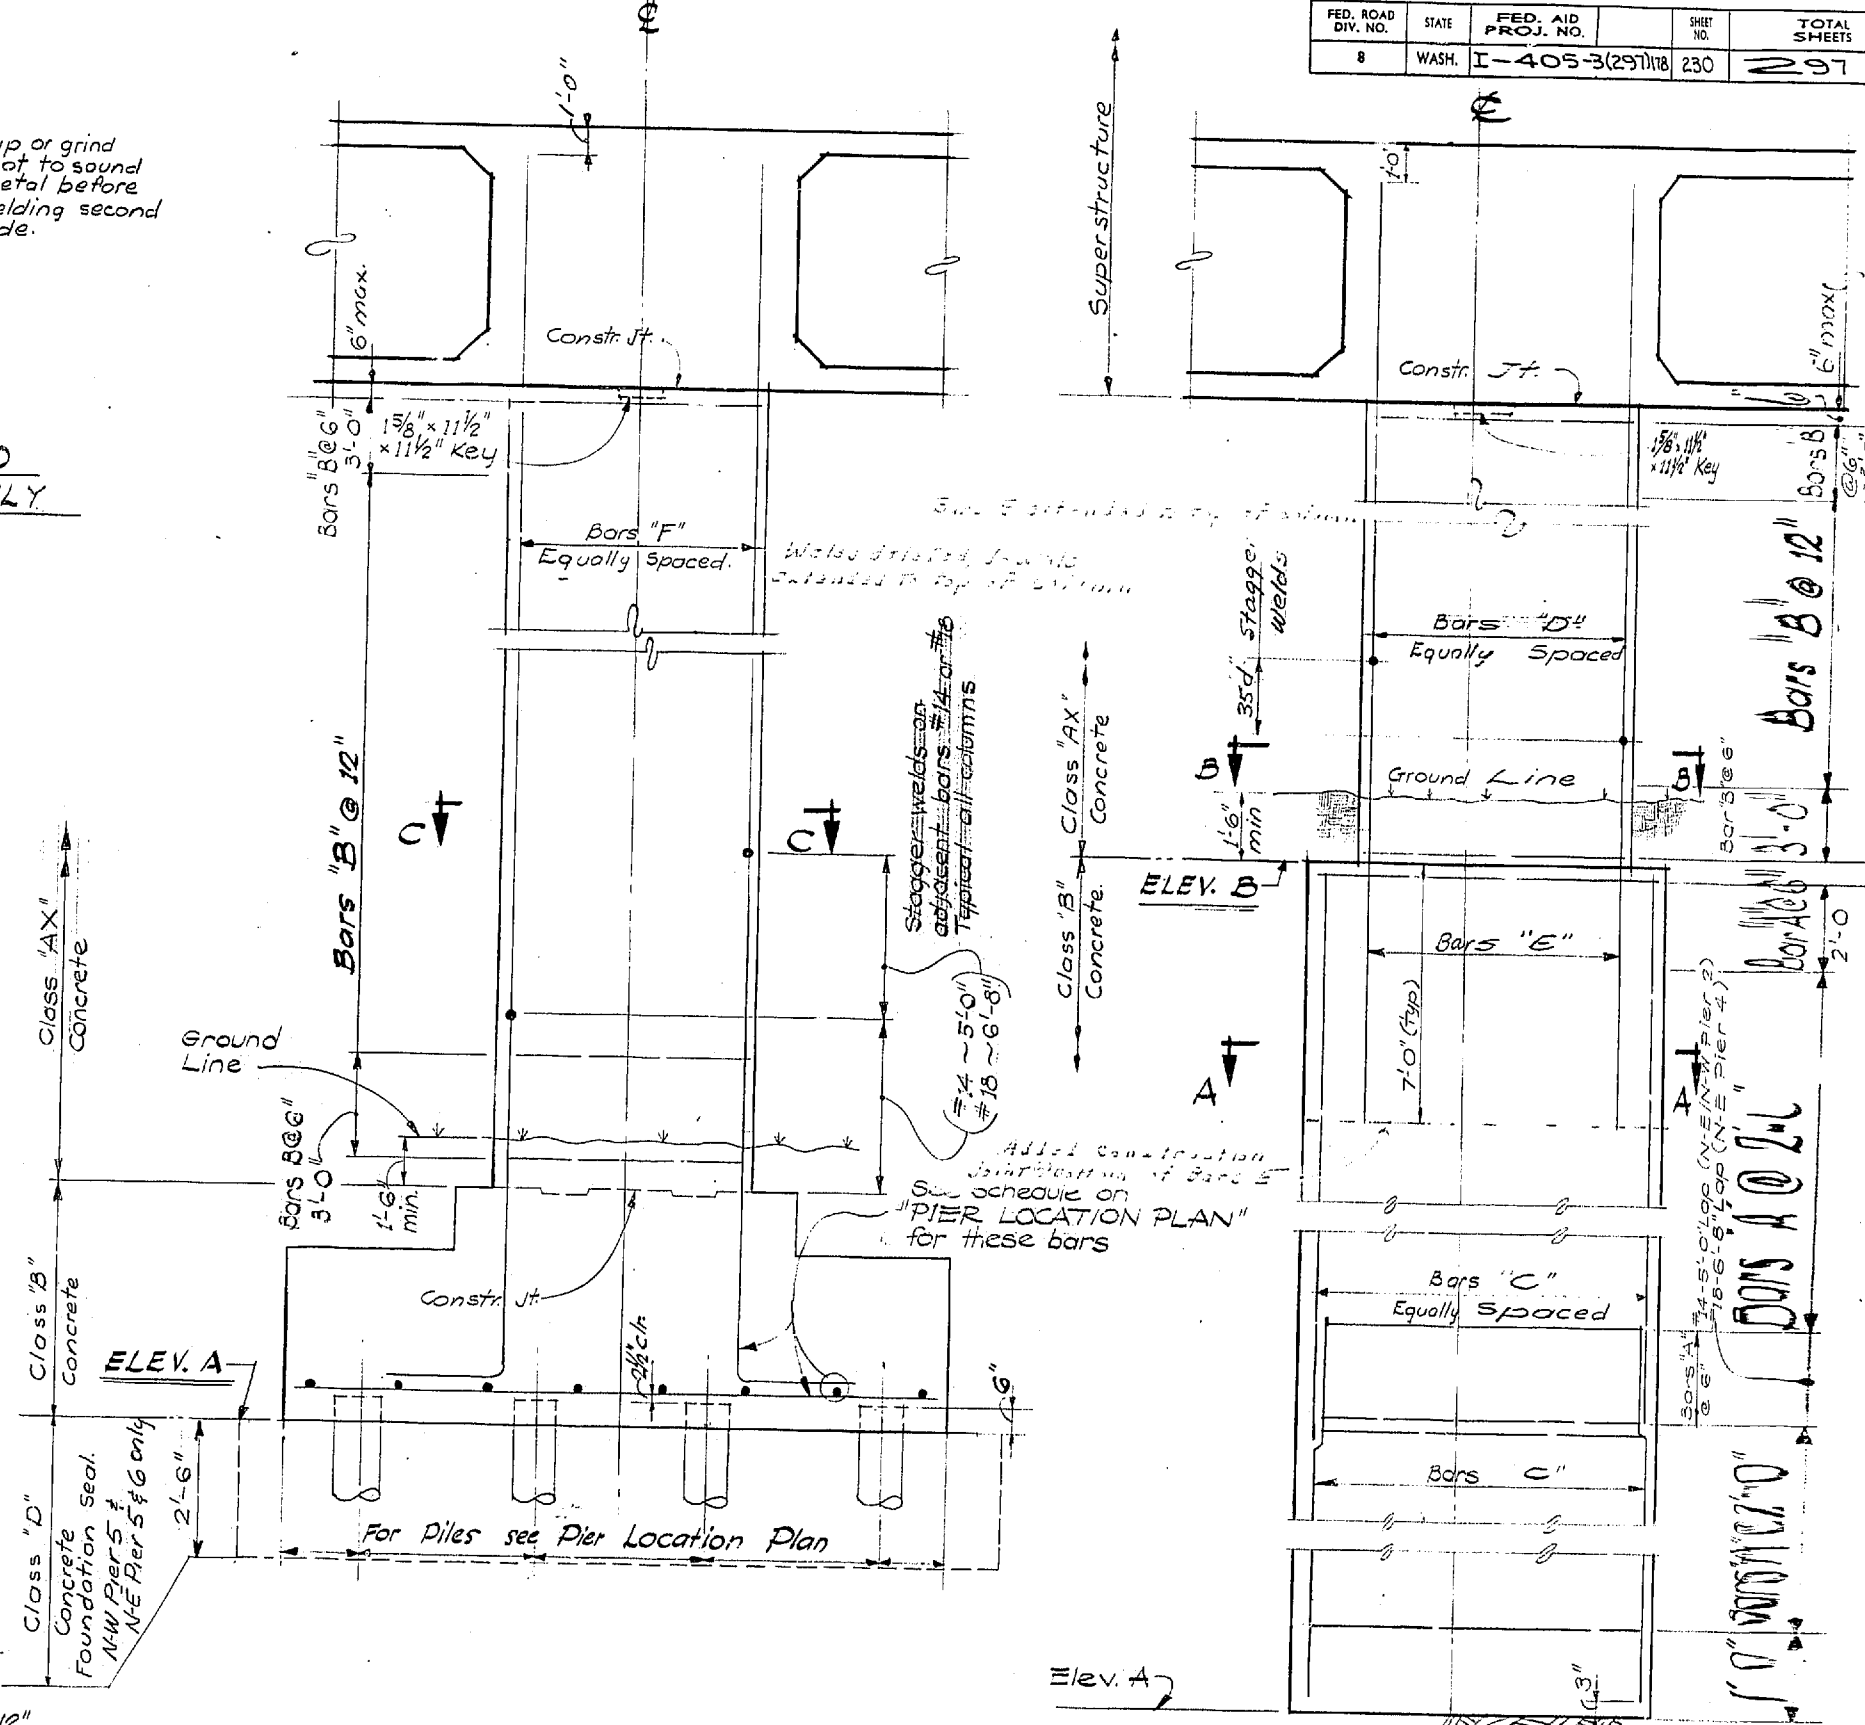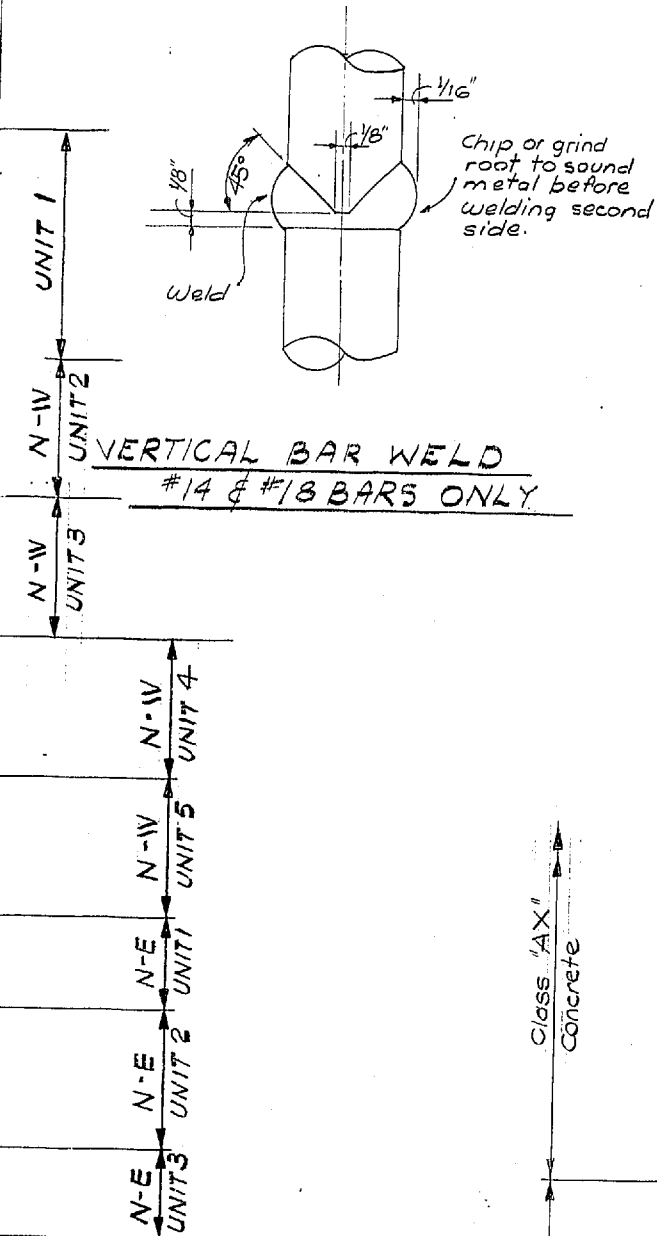

COLUMN & SHAFT DETAILS

PIER N°5 THRU PIER N°15 N-W RAMP
PIER N°5 THRU PIER N°8 N-E RAMP

PIER N°2 THRU PIER N°4 N-W RAMP
PIER N°2 THRU PIER N°4 N-E RAMP

SR 405
MP 23.49 TO MP 23.76
WOODVILLE INTERCHANGE
KING COUNTY
N-W & N-E STRUCTURE

COLUMN AND SHAFT DETAILS

WASHINGTON STATE HIGHWAY COMMISSION
DEPARTMENT OF HIGHWAYS
OLYMPIA, WASHINGTON

APPROVED December 7, 1967
SHEET 230 of 297 SHEETS

DATE	REVISION	BY

WORTHINGTON, SKILLING
HELLE & JACKSON
Consulting Civil and Structural Engineers
SEATTLE WASHINGTON

CONTRACT NO. 8382


DESIGNING ENGINEER
 DRAWN BY
 CHECKED BY
 QUANTITIES CHECKED

DATE
 BY
 DRAWN
 CHECKED
 QUANTITIES CHECKED


11-16-67

REVISION NO. 1-50
 N-W & N-E STRUCTURE
 COLUMN & SHAFT DETAILS
 SHEET 230 OF 297


P/1995

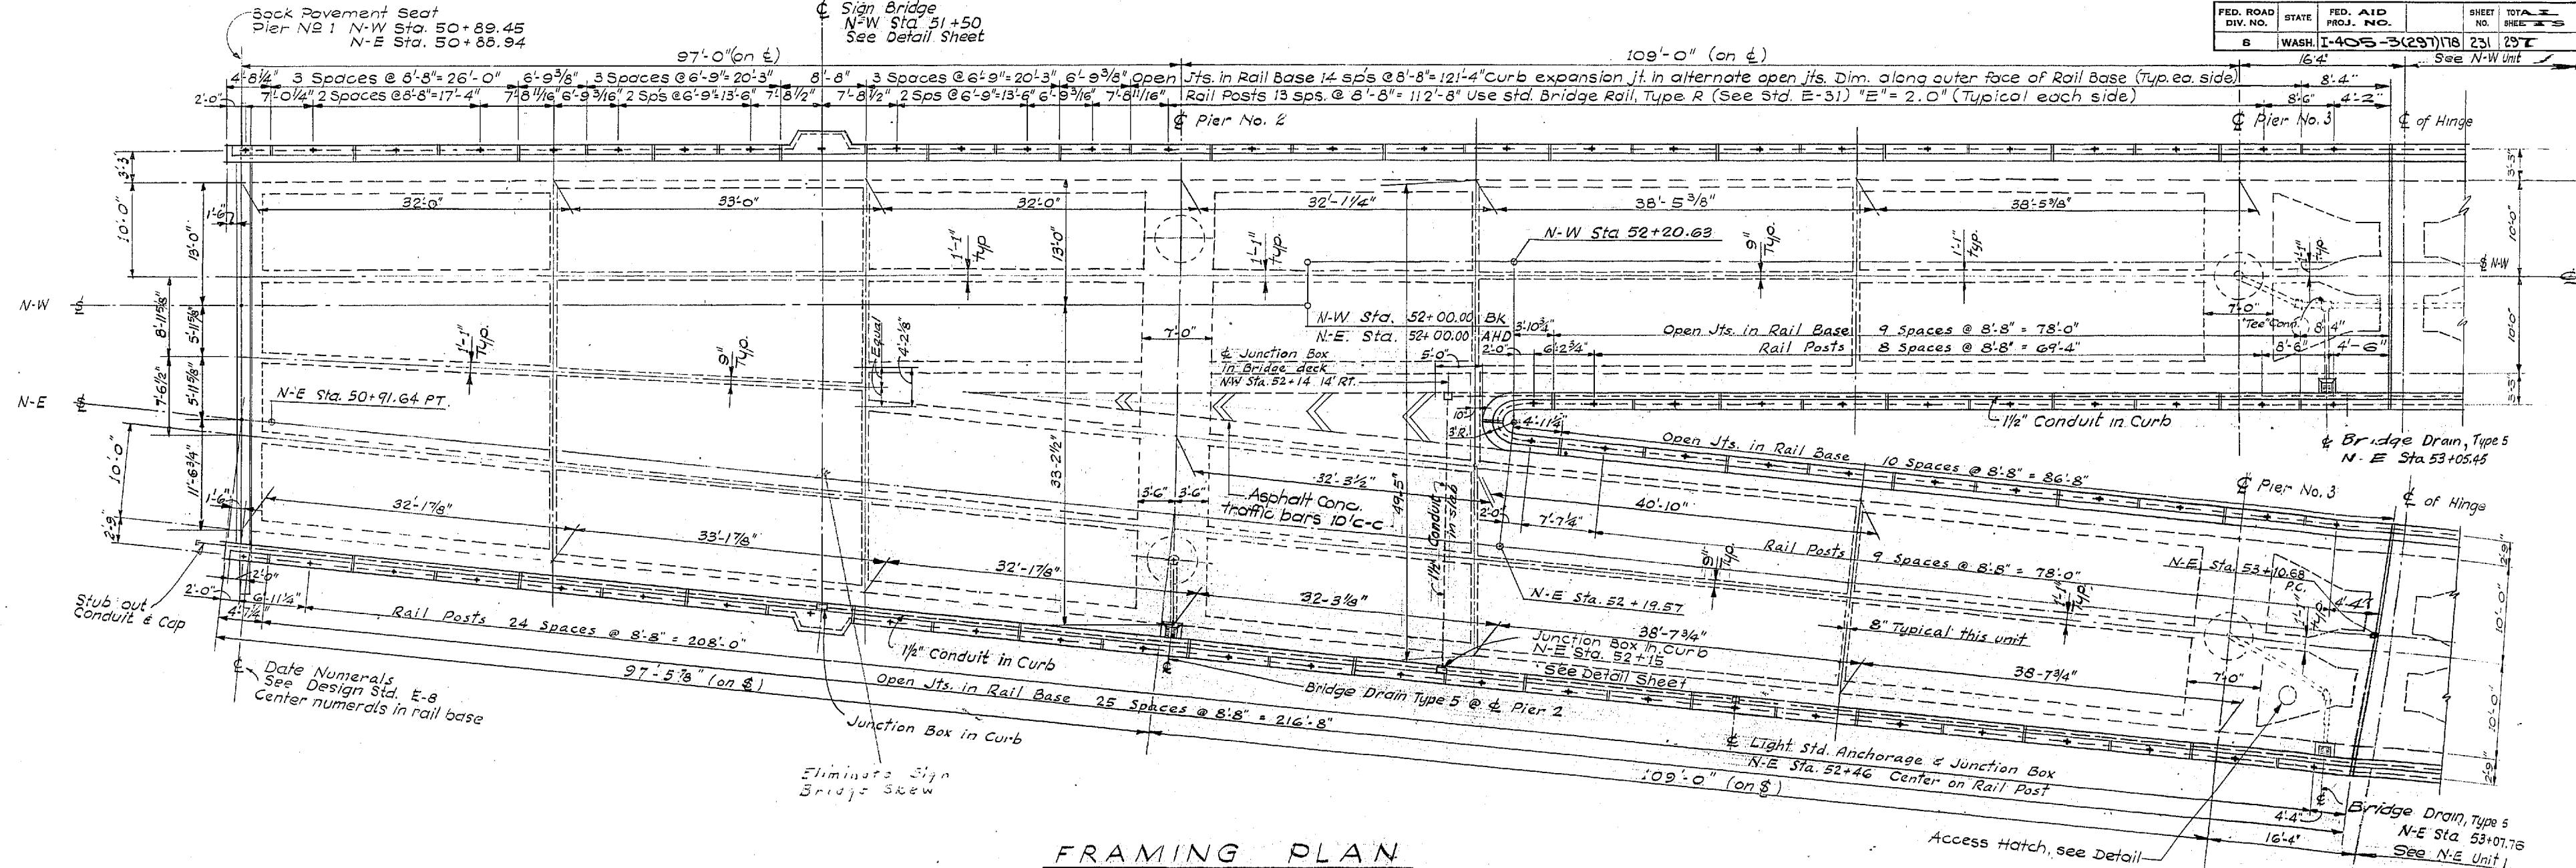

FRAMING PLAN

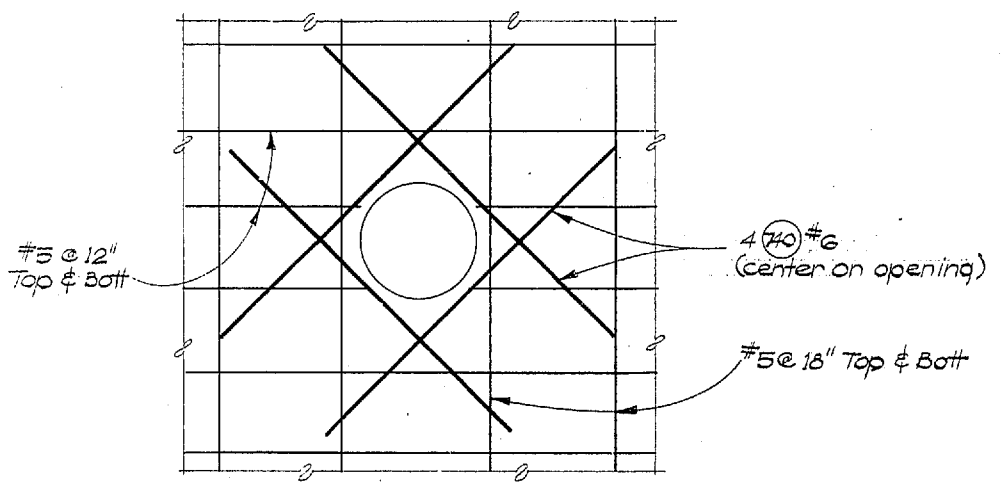


ACCESS HATCH PLAN

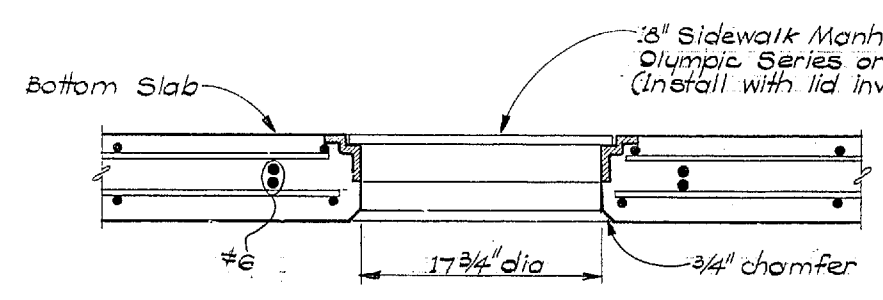

ACCESS HATCH DETAIL

GENERAL NOTES

- For conduit, Light Std. Anchorage, and Junction Box Details - See "ELECTRICAL DETAILS"
- For hinge & expansion joint details - See "HINGE DETAILS"
- For open joints in rail base and curb expansion joints see Design Std. E-29.
- For rail base anchor bolt pattern See Design Std. E-31
- For bridge drain and downspout details - see "DRAINAGE DETAILS"

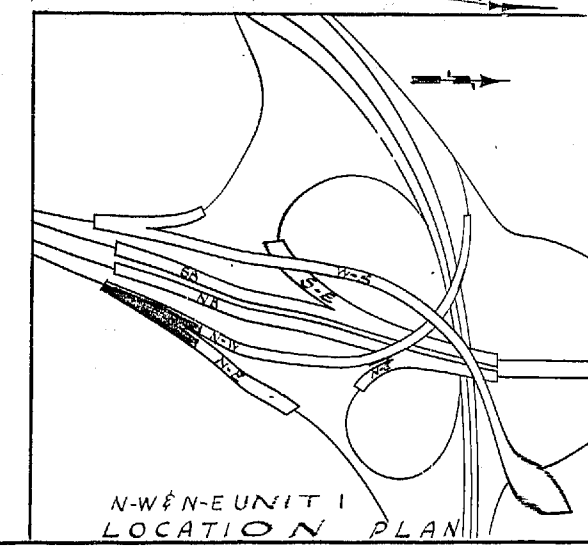

N-W & N-E UNIT LOCATION PLAN

**SR 405
MP 23.49 TO MP 23.76
WOODINVILLE INTERCHANGE
KING COUNTY
N-W & N-E STRUCTURE**

FRAMING PLAN

WASHINGTON STATE HIGHWAY COMMISSION
DEPARTMENT OF HIGHWAYS
OLYMPIA, WASHINGTON

F. L. McPHEON
H. WALSH



BAKER JOHNSON
JOHN A. RIPP

APPROVED December 7, 1967

SHEET 231 OF 297 SHEETS

CONTRACT NO. 8382

DATE	REVISION	BY

**WORTHINGTON, SKILLING
HELLE & JACKSON**
Consulting Civil and Structural Engineers
SEATTLE WASHINGTON

As Built Changes in Red 7-15-70










DESIGNED	
DRAWN BY	
QUANTITIES FIGURED	
QUANTITIES CHECKED	

DATE	
BY	
DRAWN	
TRACED	
CHECKED	
DIST. ENGR.	

WOODINVILLE INTERCHANGE
FSH NO. 1-RE/PSH NO. 2-BO
N-W & N-E STRUCTURE
FRAMING PLAN
SHEET 231 OF 297

11-16-67

9/1995

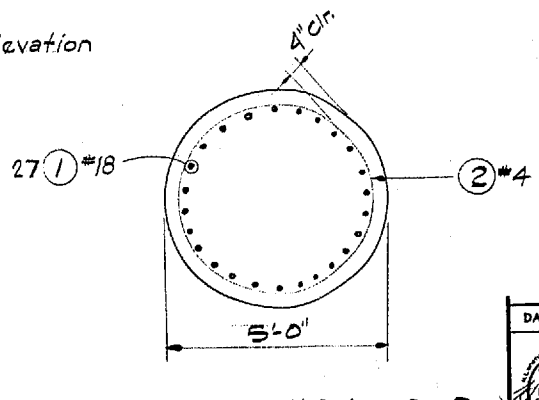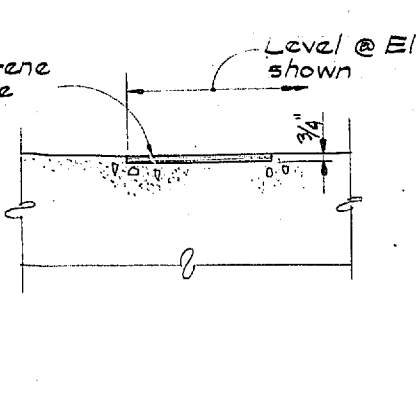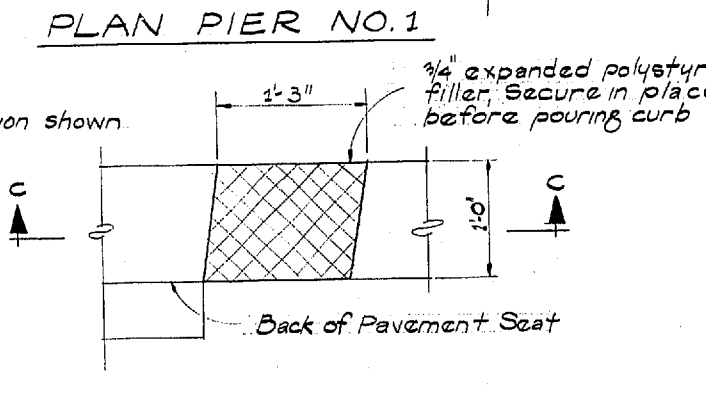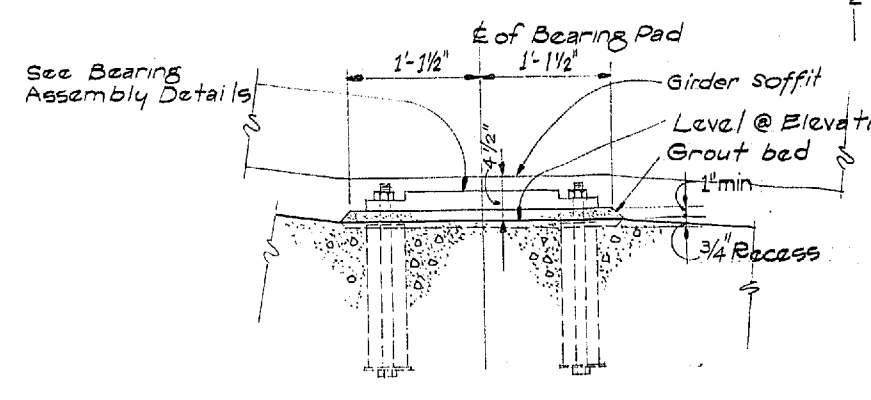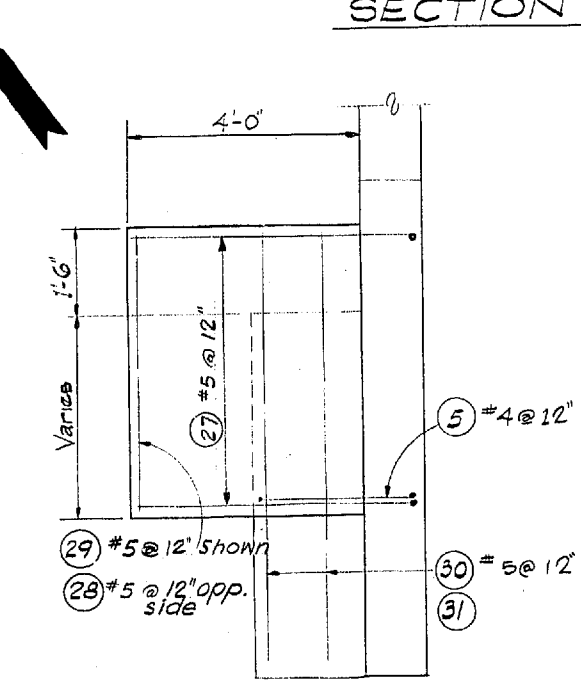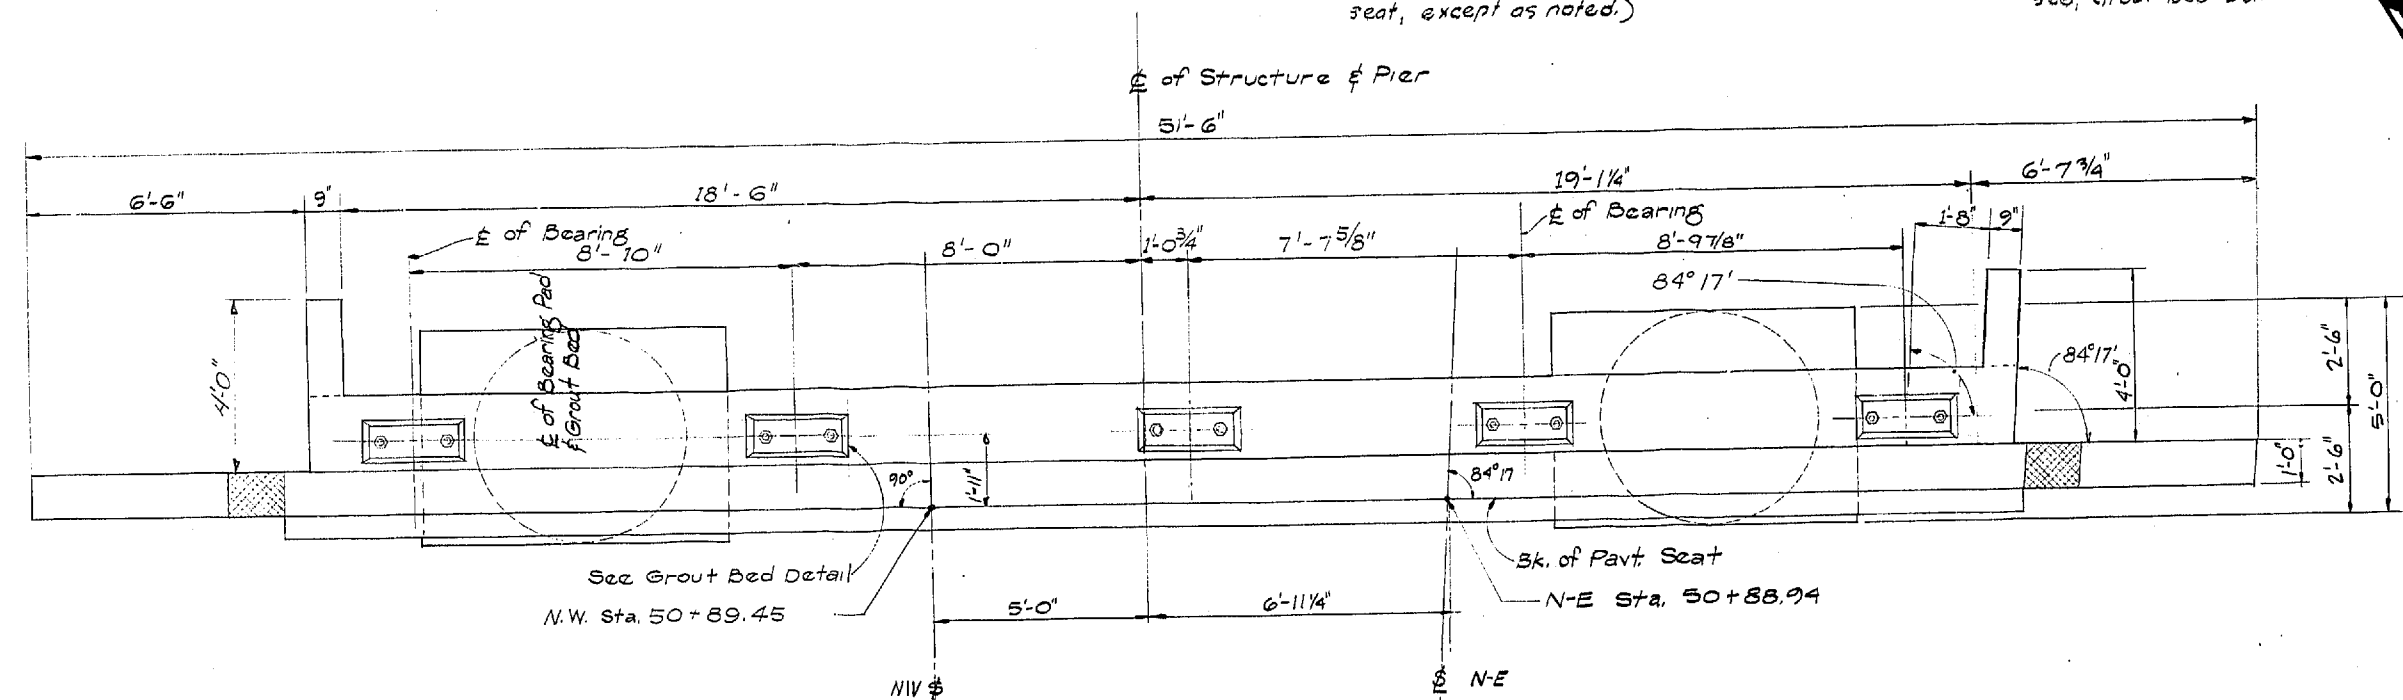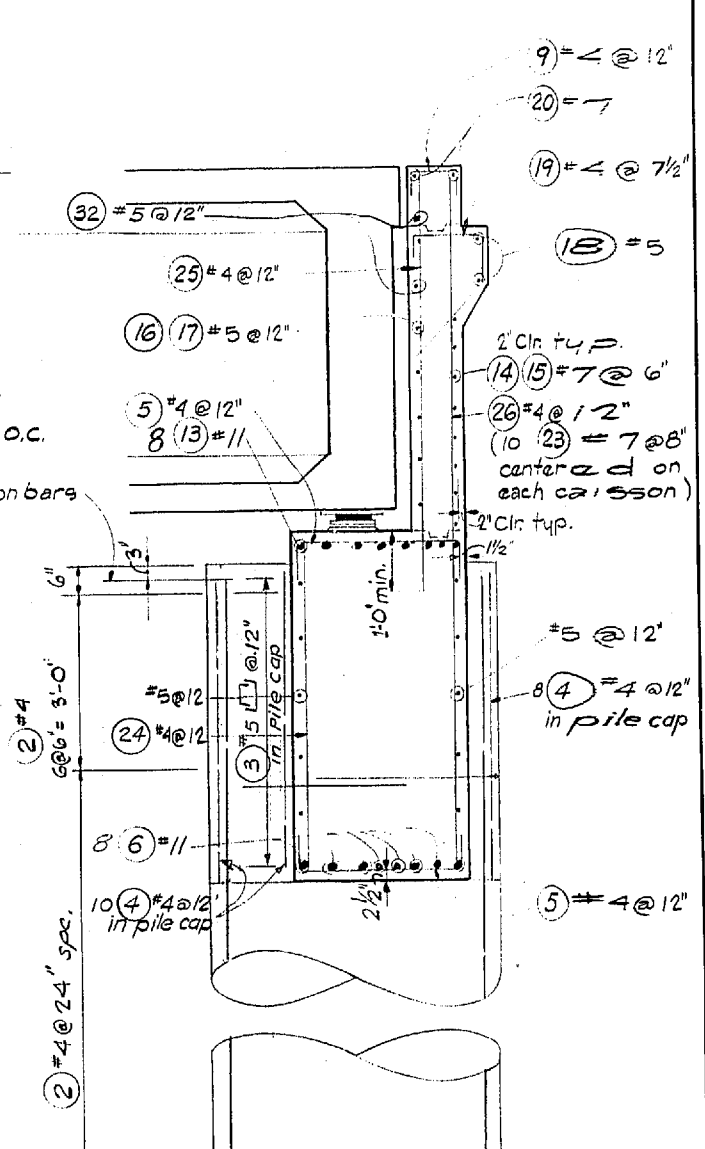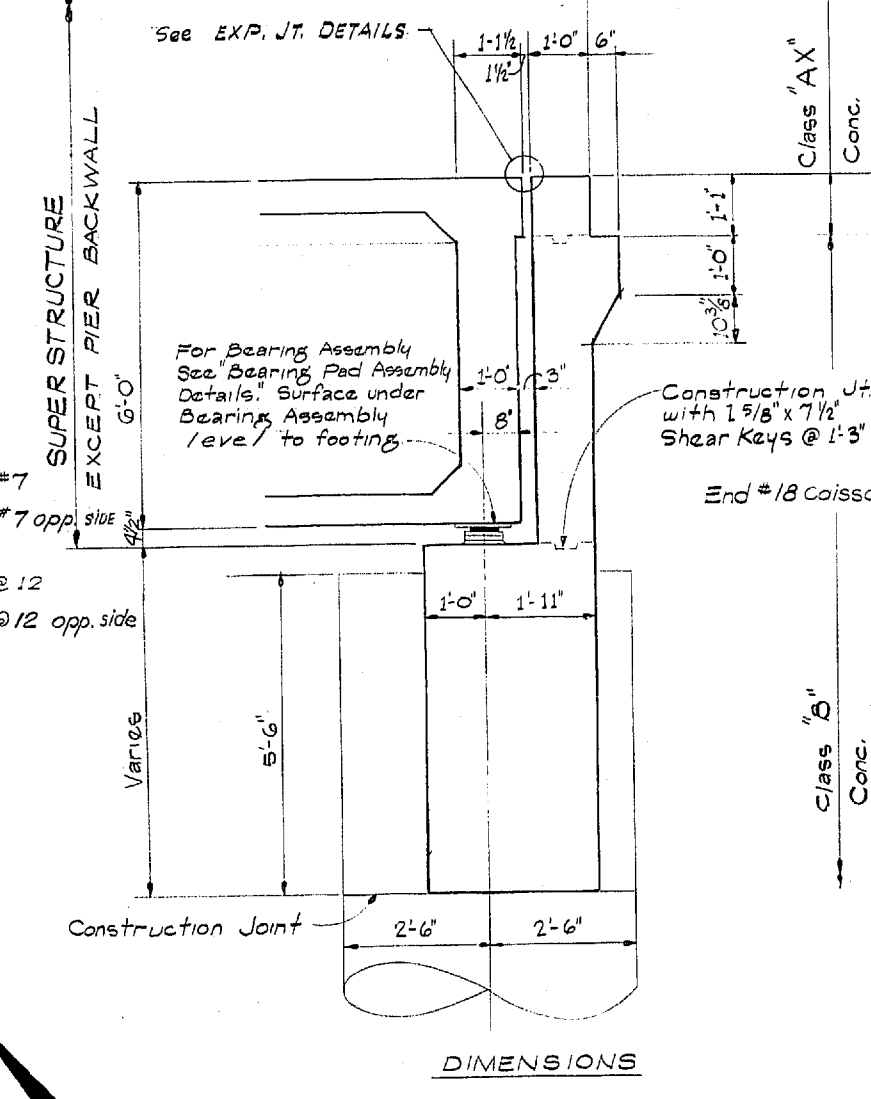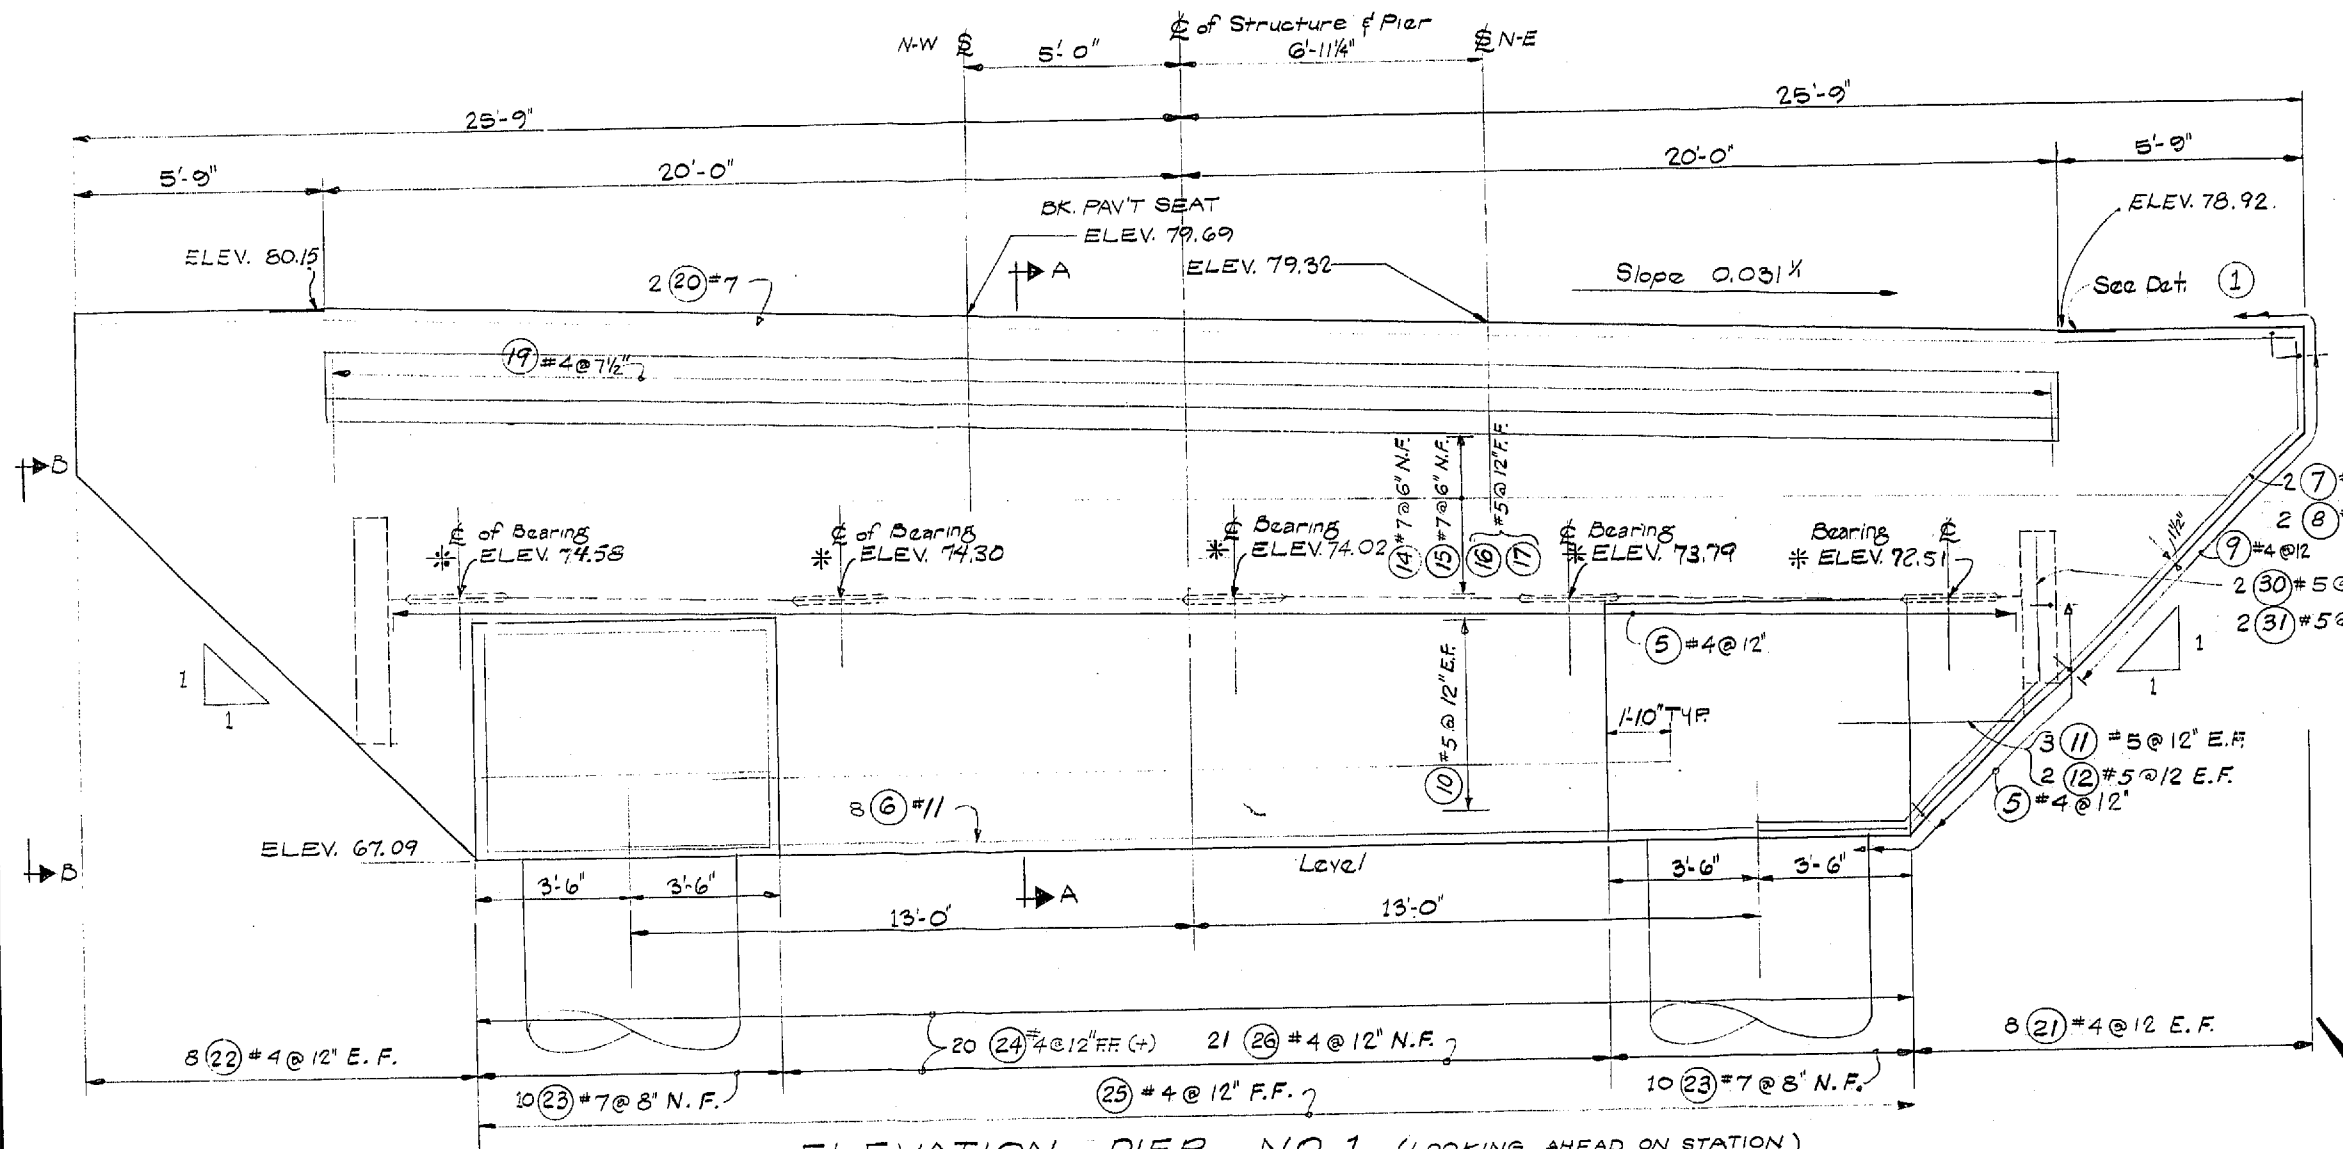

DATE REVISION BY

WORTHINGTON, SKILLING HELLE & JACKSON
Consulting Civil and Structural Engineers
SEATTLE WASHINGTON

SR 405
MP 23.49 TO MP 23.76
WOODINVILLE INTERCHANGE
KING COUNTY
N-W&N-E STRUCTURE

PIER NO. 1

WASHINGTON STATE HIGHWAY COMMISSION
DEPARTMENT OF HIGHWAYS
OLYMPIA, WASHINGTON

GEORGE D. ZAHN, CHAIRMAN
F. L. McALISON, H. WALSH, BARBER FERGUSON, JOHN H. RUPP

APPROVED December 7, 1967
SHEET 232 OF 297 SHEETS
CONTRACT NO. 8 382




11-16-67

1/1995


FED. ROAD DIV. NO.	STATE	FED. AID PROJ. NO.	SHEET NO.	TOTAL SHEETS
8	WASH.	I-405-3(297)178	233	297

Each of pavement strip
Pier N#2

Pier N#2
2(211)#14

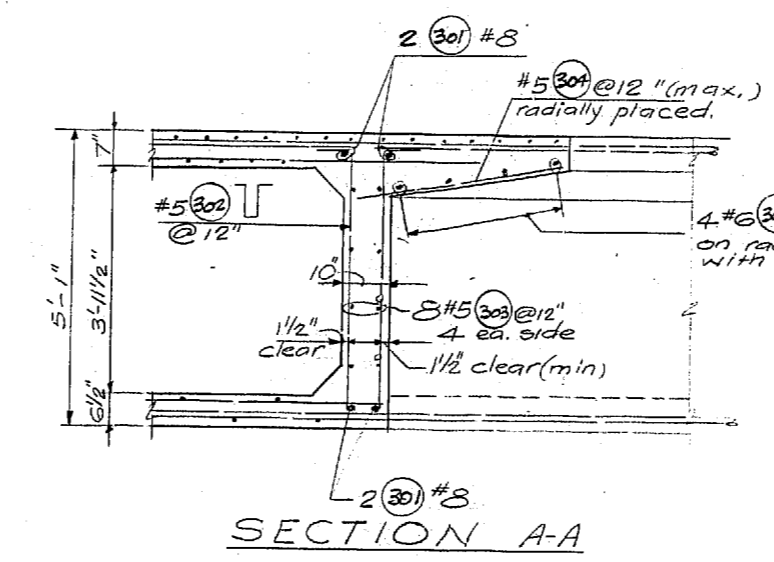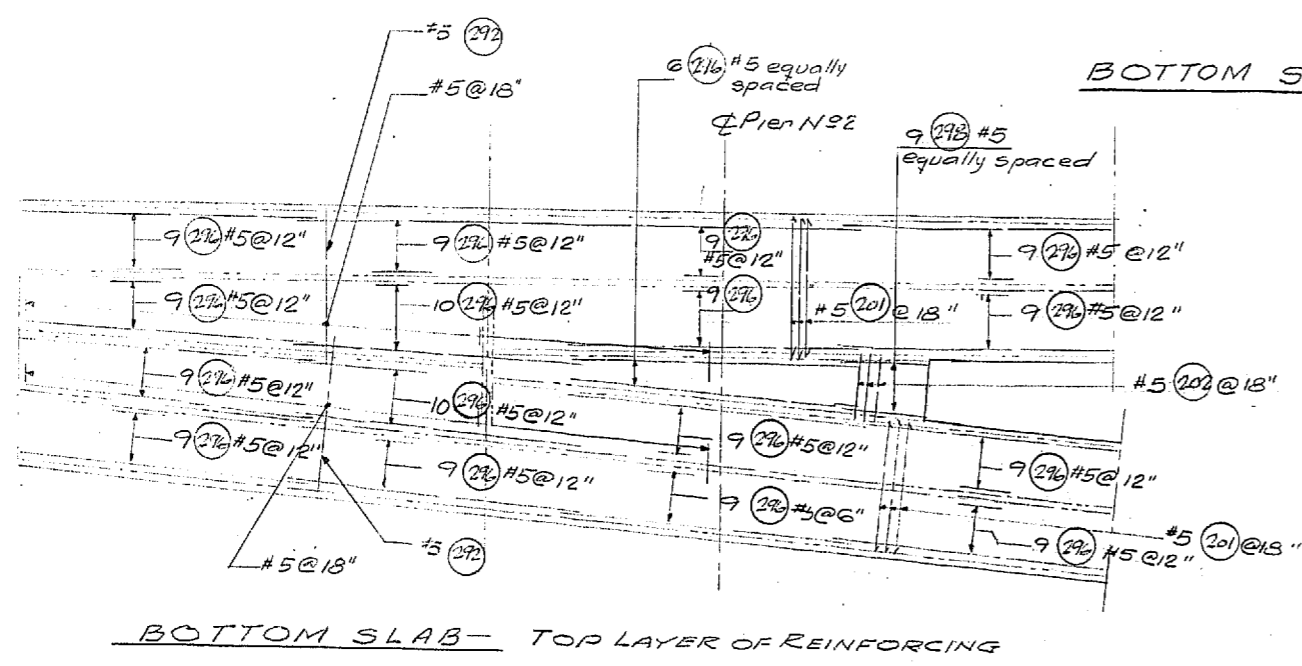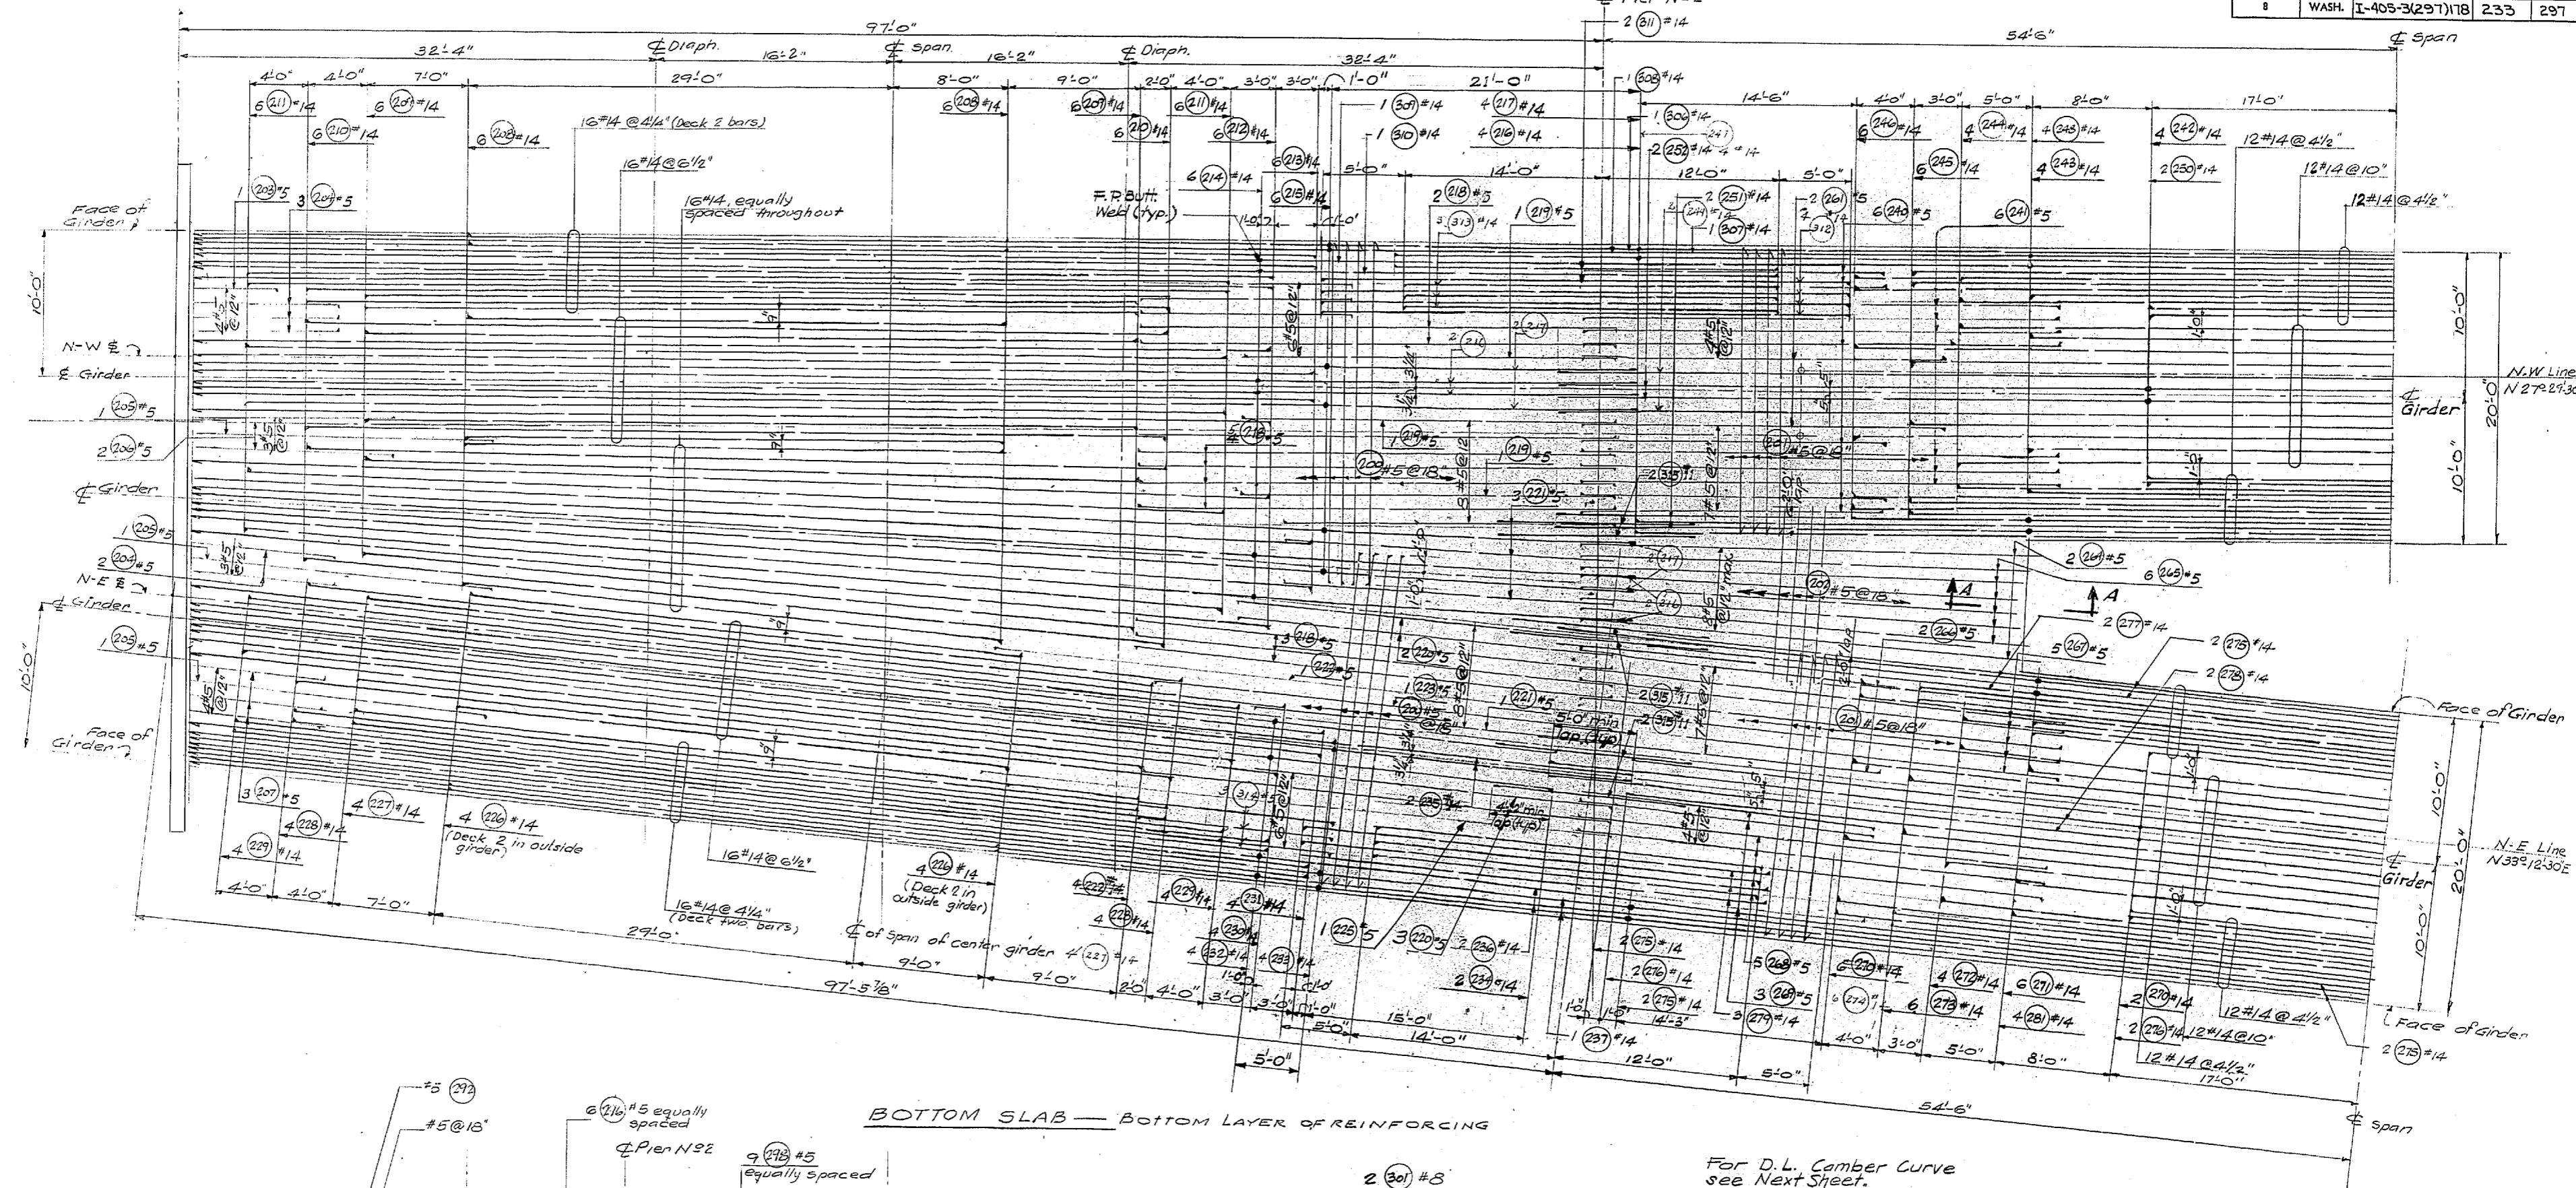

For D.L. Camber Curve see Next Sheet.
For Bottom Slab Cell Drain Detail see next sheet

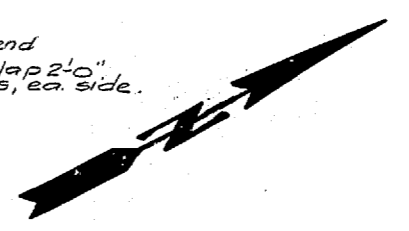

DESIGNING ENGINEER	
DESIGNED	
CHECKED	
QUANTITIES FIGURED	
QUANTITIES CHECKED	

DATE	
BY	
DRAWN	
CHECKED	
LOC. ENGR.	
DIST. ENGR.	

WOODVILLE INTERCHANGE
PSH NO. 1-REV/PSH NO. 2-50
1-1-53/STRUCTURE
BOTTOM SLAB
SHEET 233 OF 297

11-16-67

As Built Changes in Red 9-15-74

DATE	REVISION	BY

WORTHINGTON, SKILLING
HELLE & JACKSON
Consulting Civil and Structural Engineers
SEATTLE WASHINGTON

SR 405
MP 23.49 TO MP 23.76
WOODVILLE INTERCHANGE
KING COUNTY
N-W & N-E STRUCTURE


N-W & N-E BOTTOM SLAB

WASHINGTON STATE HIGHWAY COMMISSION
DEPARTMENT OF HIGHWAYS
OLYMPIA, WASHINGTON


GEORGE D. ZAHM, CHAIRMEN
I. MIFALSON, H. WASH
BAKER FERGUSON, JOHN N. RUPP

APPROVED: December 7, 1967
SHEET 233 OF 297 SHEETS
CONTRACT NO. 8382


9/1995

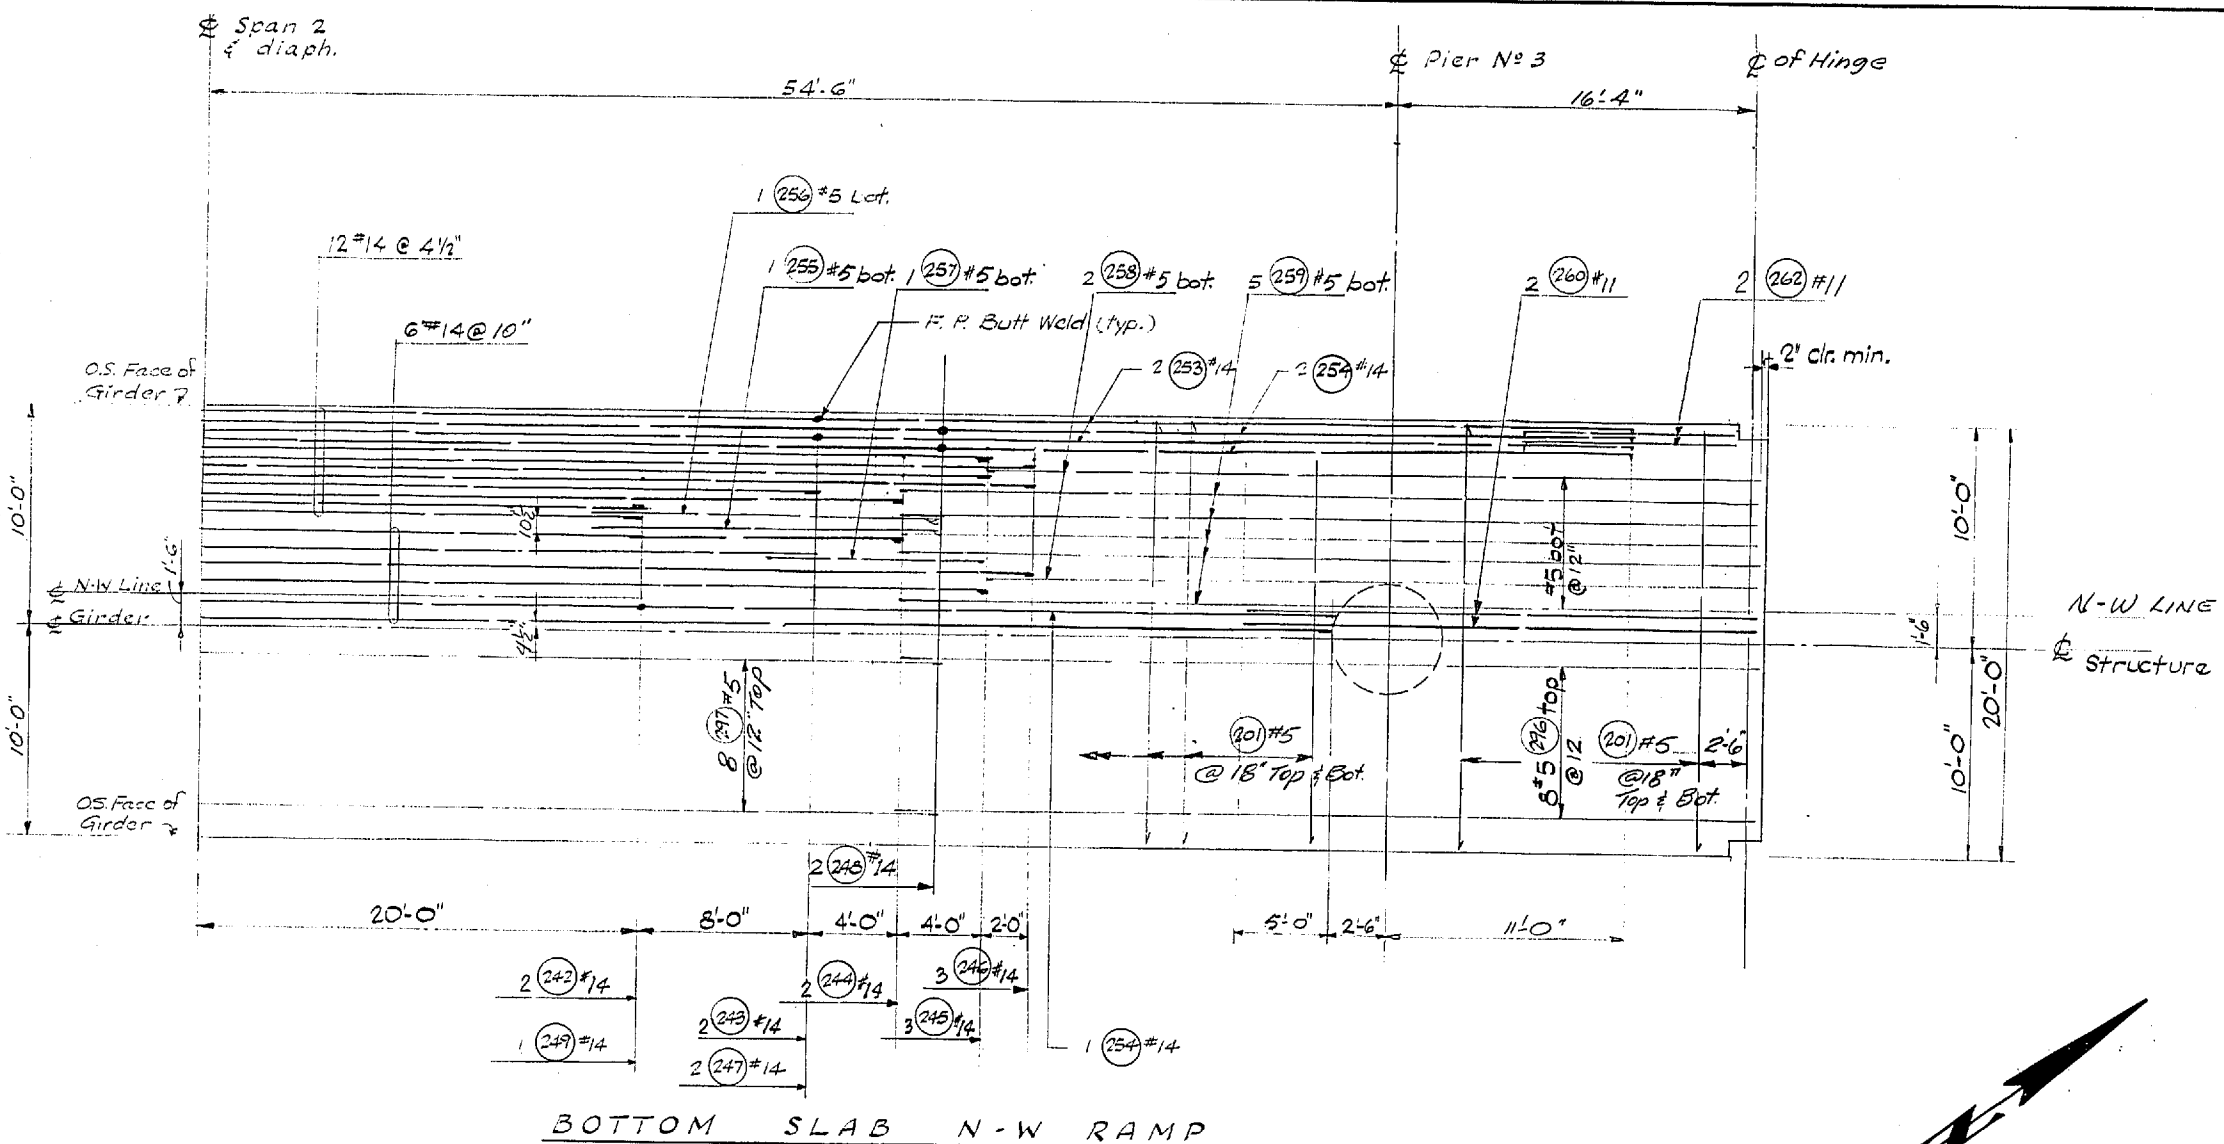

BOTTOM SLAB N-W RAMP

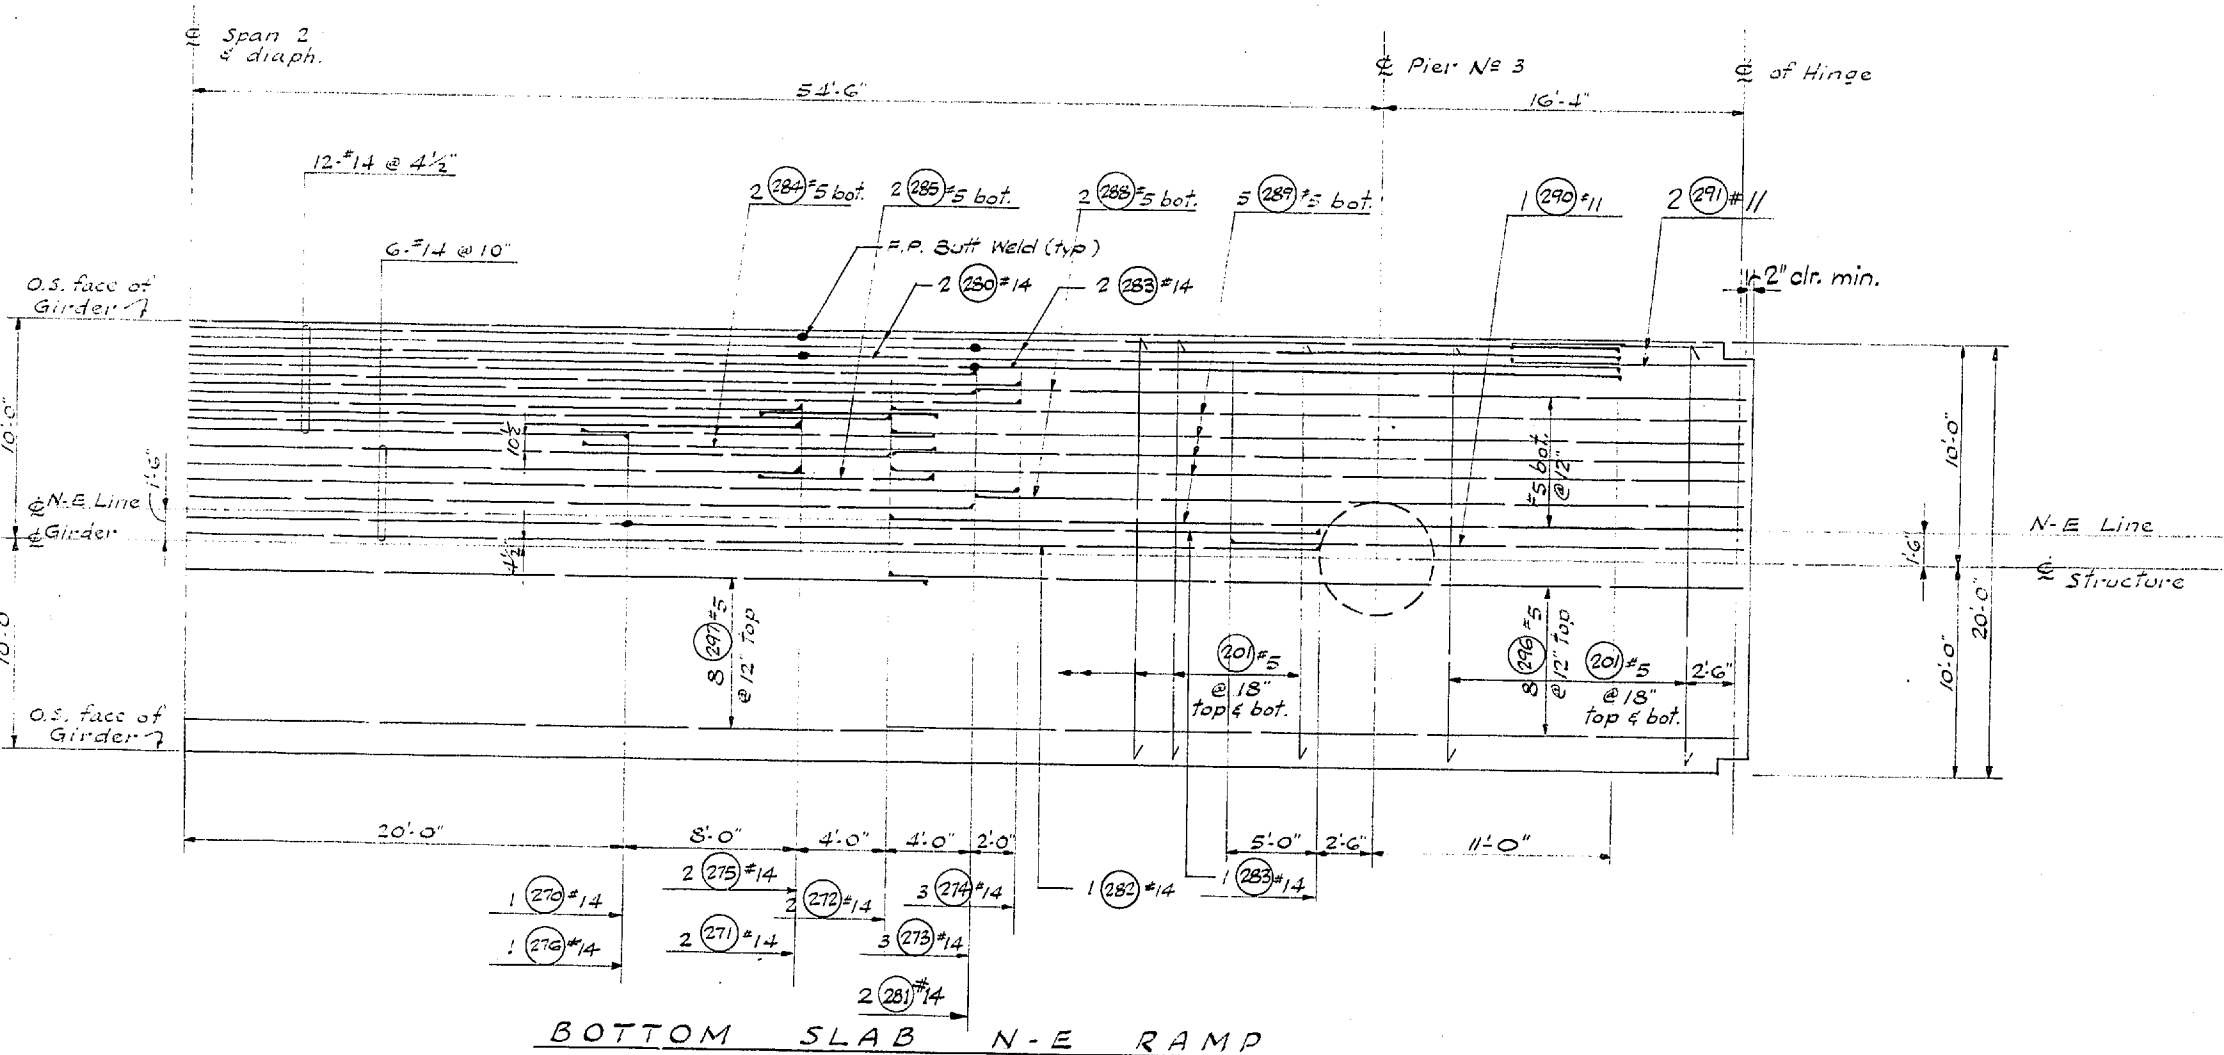


BOTTOM SLAB N-E RAMP

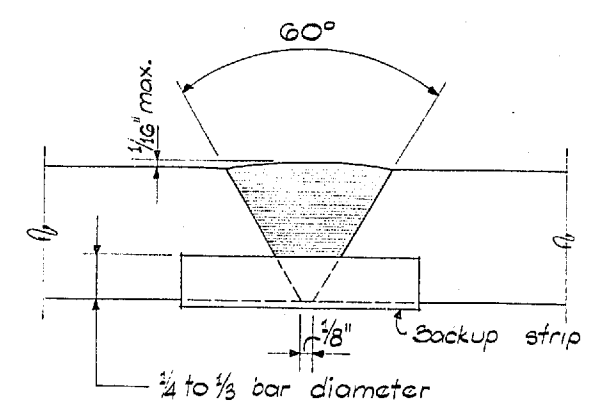


TYPICAL HORIZONTAL BAR WELD

If welding is necessary for fabrication or shipping considerations, it will be at the locations shown on the plans. Welds shall develop the ultimate strength of the bar.

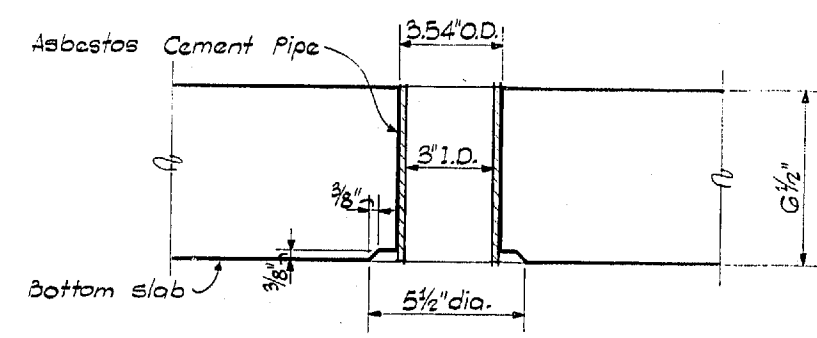

CELL DRAIN DETAIL

Place @ low corner of each cell. Typical all units.

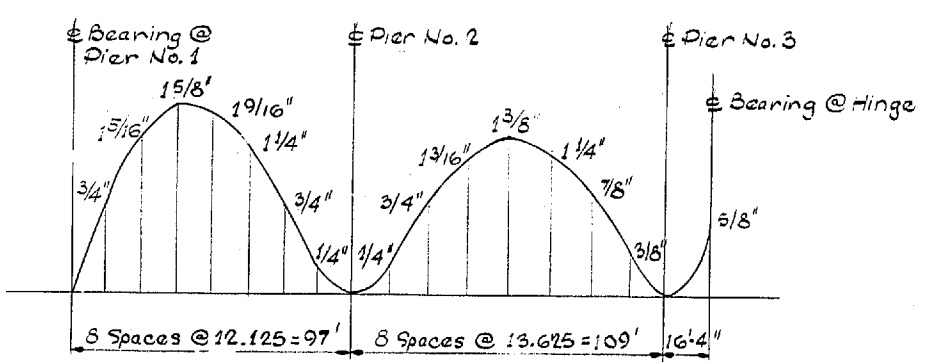

DEAD LOAD CAMBER CURVE FOR N-W & N-E RAMP

This curve shows D.L. Camber only and should be increased by the amount of take-up anticipated in the falsework.

DESIGNED	BY	DATE
CHECKED	BY	DATE
QUANTITIES FIGURED	BY	DATE
QUANTITIES CHECKED	BY	DATE

DRAWN	BY	DATE
TRACED	BY	DATE
CHECKED	BY	DATE
LOC. ENGR.	BY	DATE
DIST. ENGR.	BY	DATE

11-16-67
 PSH NO. 1-RE/PSH NO. 2-BO
 N-W & N-E STRUCTURE
 BOTTOM SLAB
 SHEET 234 OF 297

DATE	REVISION	BY

WORTHINGTON, SKILLING
 HELLE & JACKSON
 Consulting Civil and Structural Engineers
 SEATTLE WASHINGTON

SR 405
 MP 23.49 TO MP 23.76
 WOODINVILLE INTERCHANGE
 KING COUNTY
 N-W & N-E STRUCTURE
 N-W & N-E BOTTOM SLAB

WASHINGTON STATE HIGHWAY COMMISSION
 DEPARTMENT OF HIGHWAYS
 OLYMPIA, WASHINGTON

F. I. MYLSON
 H. WASH


GEORGE D. ZAHN, CHAIRMAN

BAKER FERGUSON
 JOHN H. RUPP


APPROVED December 7, 1967
 SHEET 234 OF 297 SHEETS
 CONTRACT NO. 8382

10/1995

FED. ROAD DIV. NO.	STATE	FED. AID PROJ. NO.	SHEET NO.	TOTAL SHEETS
8	WASH.	I-405-3(297)118	235	297

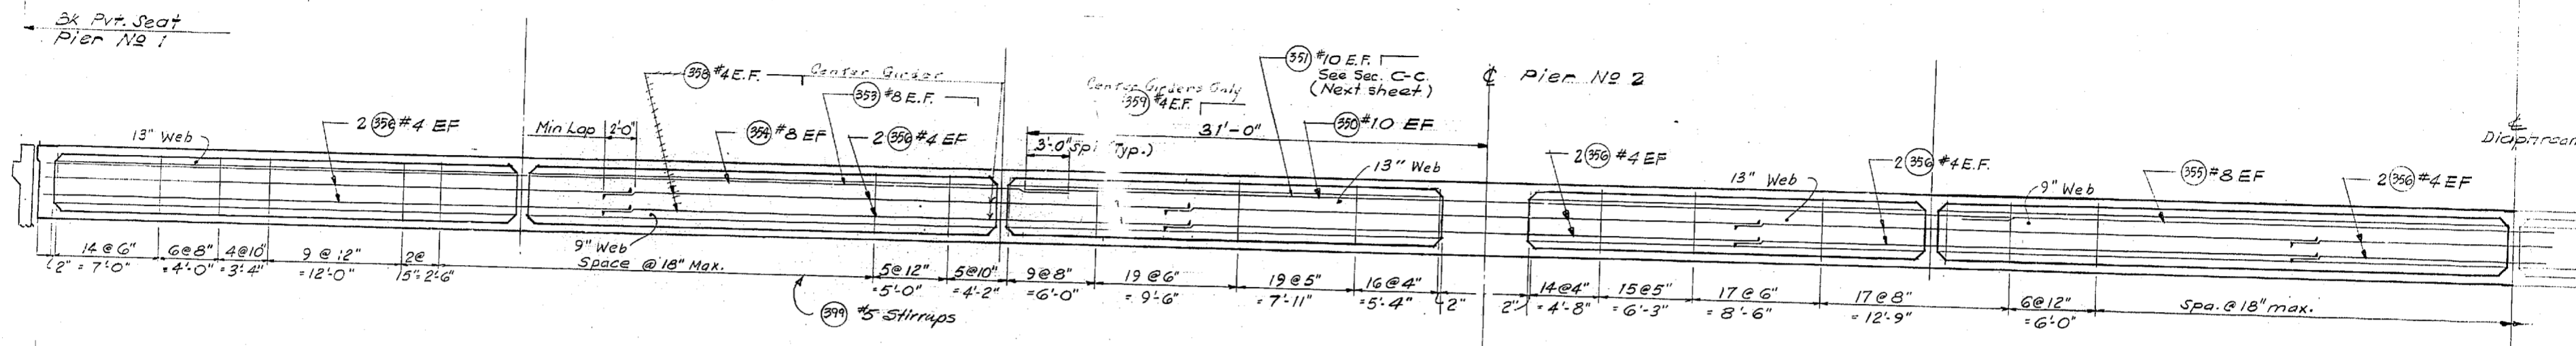


EXTERIOR & INTERIOR WEBS

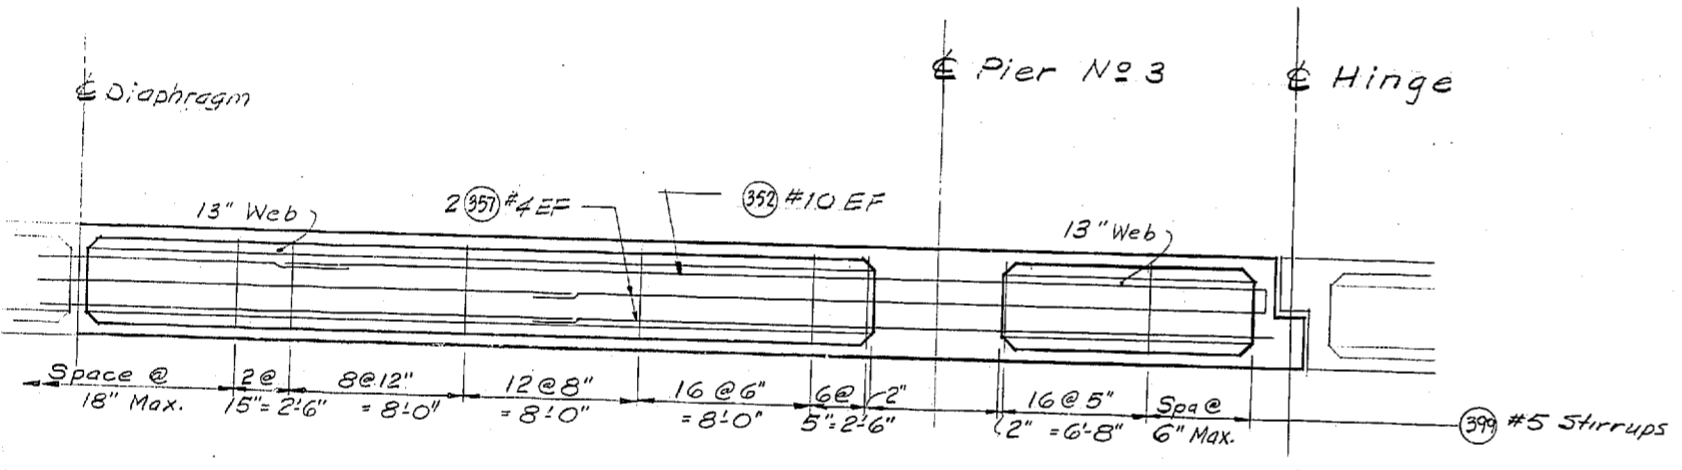

EXTERIOR & INTERIOR WEBS

LONGITUDINAL SECTIONS

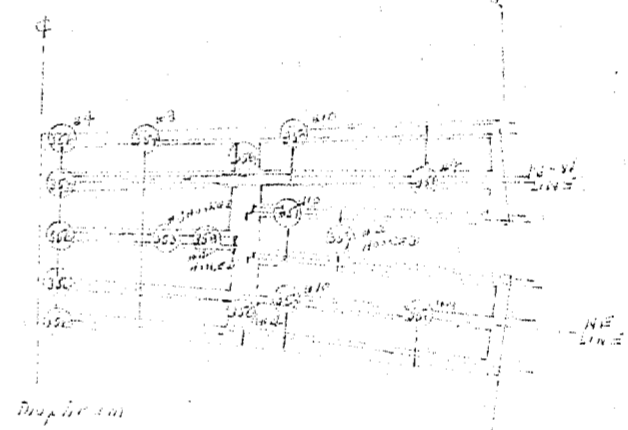

Diaphragm
 Check Spacing Placement
 See sheet 236 Stat C-5

DESIGNED	DATE
CHECKED	
QUANTITIES FIGURED	
QUANTITIES CHECKED	

DRAWN	DATE
CHECKED	
LOC. ENGR.	
DIST. ENGR.	

NEW STRUCTURE
 LONGITUDINAL SECTIONS
 SHEET 235 OF 297
 11-16-67

As Built Changes in Red 9-15-70

DATE	REVISION	BY

WORTHINGTON, SKILLING HELLE & JACKSON
 Consulting Civil and Structural Engineers
 SEATTLE WASHINGTON

SR 405
MP 23.49 TO MP 23.76
WOODINVILLE INTERCHANGE
 KING COUNTY
N-W & N-E STRUCTURE
LONGITUDINAL SECTIONS N-W & N-E

WASHINGTON STATE HIGHWAY COMMISSION
 DEPARTMENT OF HIGHWAYS
 OLYMPIA, WASHINGTON

F. L. MIFALSON
 H. WALSH

GEORGE D. ZAHN, CHAIRMAN



BAKER FERGUSON
 JOHN H. RUFF

APPROVED: December 7, 1967
 SHEET 235 OF 297 SHEETS
 CONTRACT NO. 8382




P/1996

DESIGNING ENGINEER	
DESIGNER	
DRAWN BY	
CHECKED	
QUANTITIES FIGURED	
QUANTITIES CHECKED	


DATE	
BY	
DRAWN	
CHECKED	
LOC. ENGR.	
DIST. ENGR.	

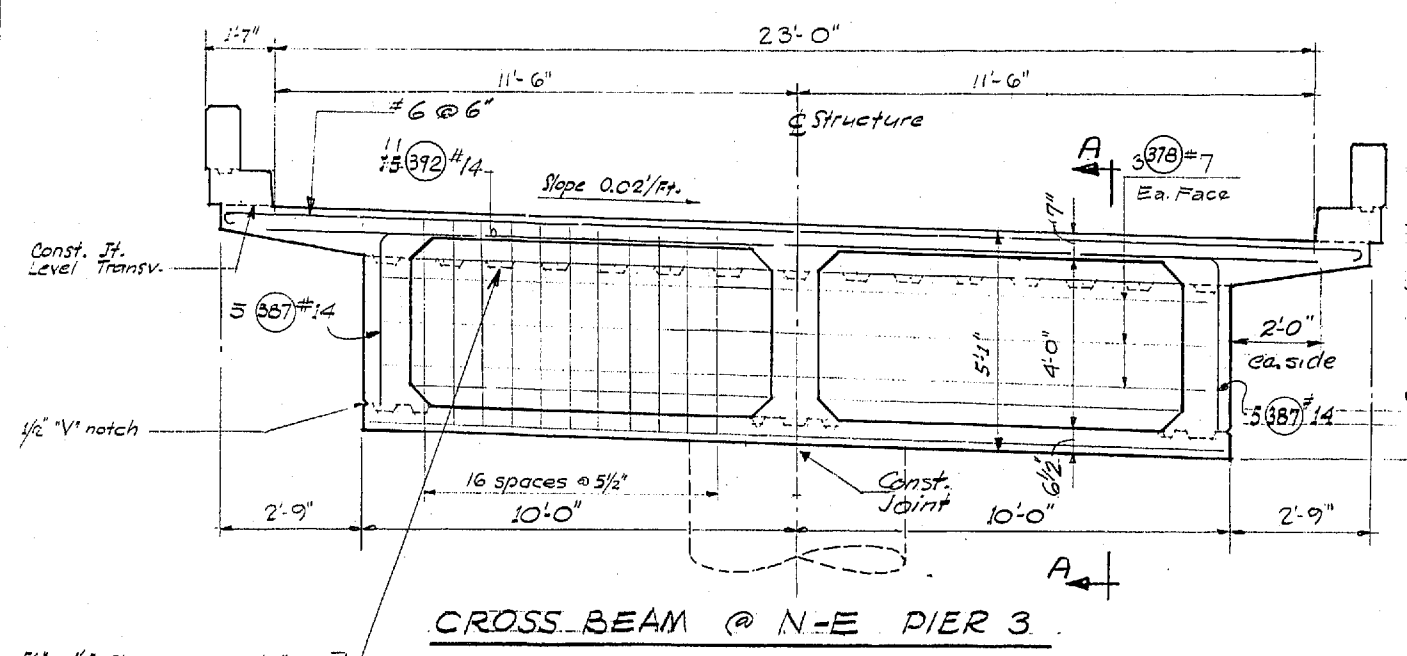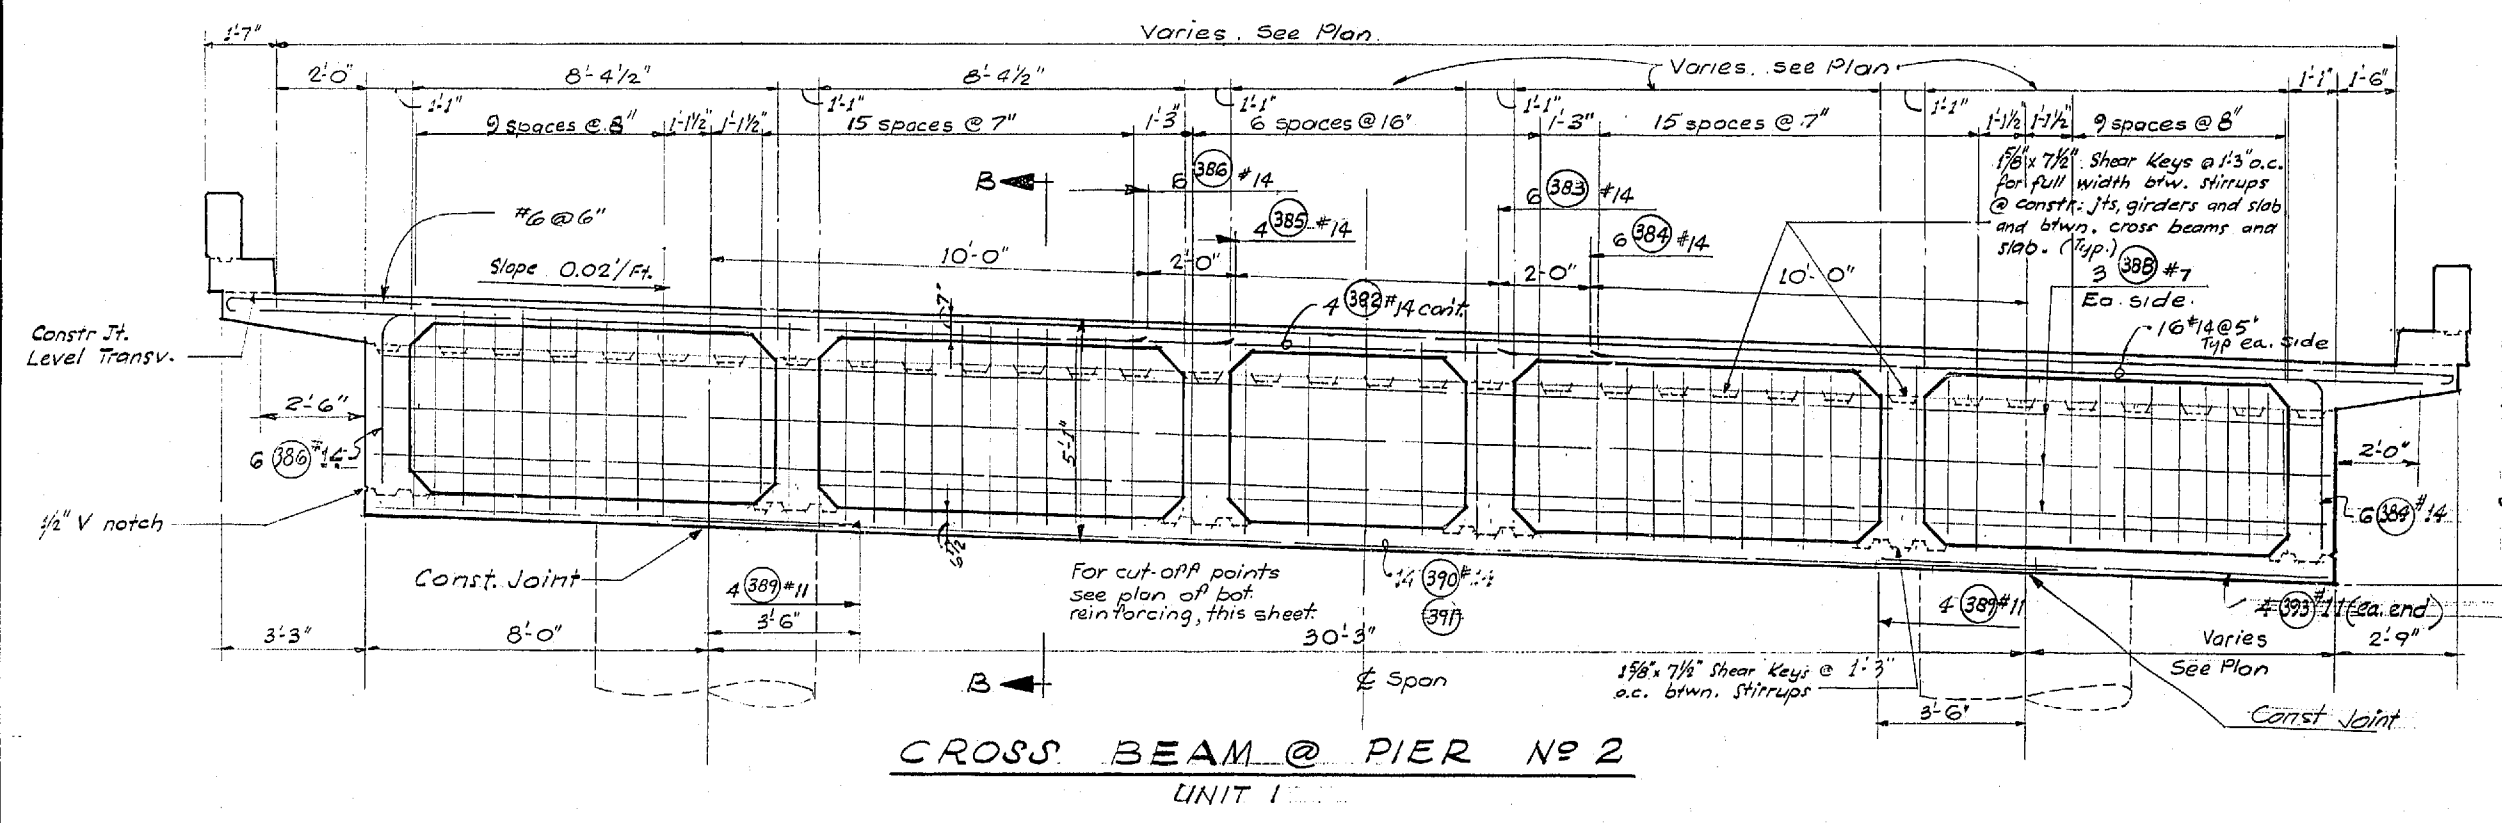

1/8" x 7/8" Shear Keys @ 1'3" o.c. for full width bwn. stirrups @ constr. jts, girders and slab, and bwn. cross beam & slab. (Top.)

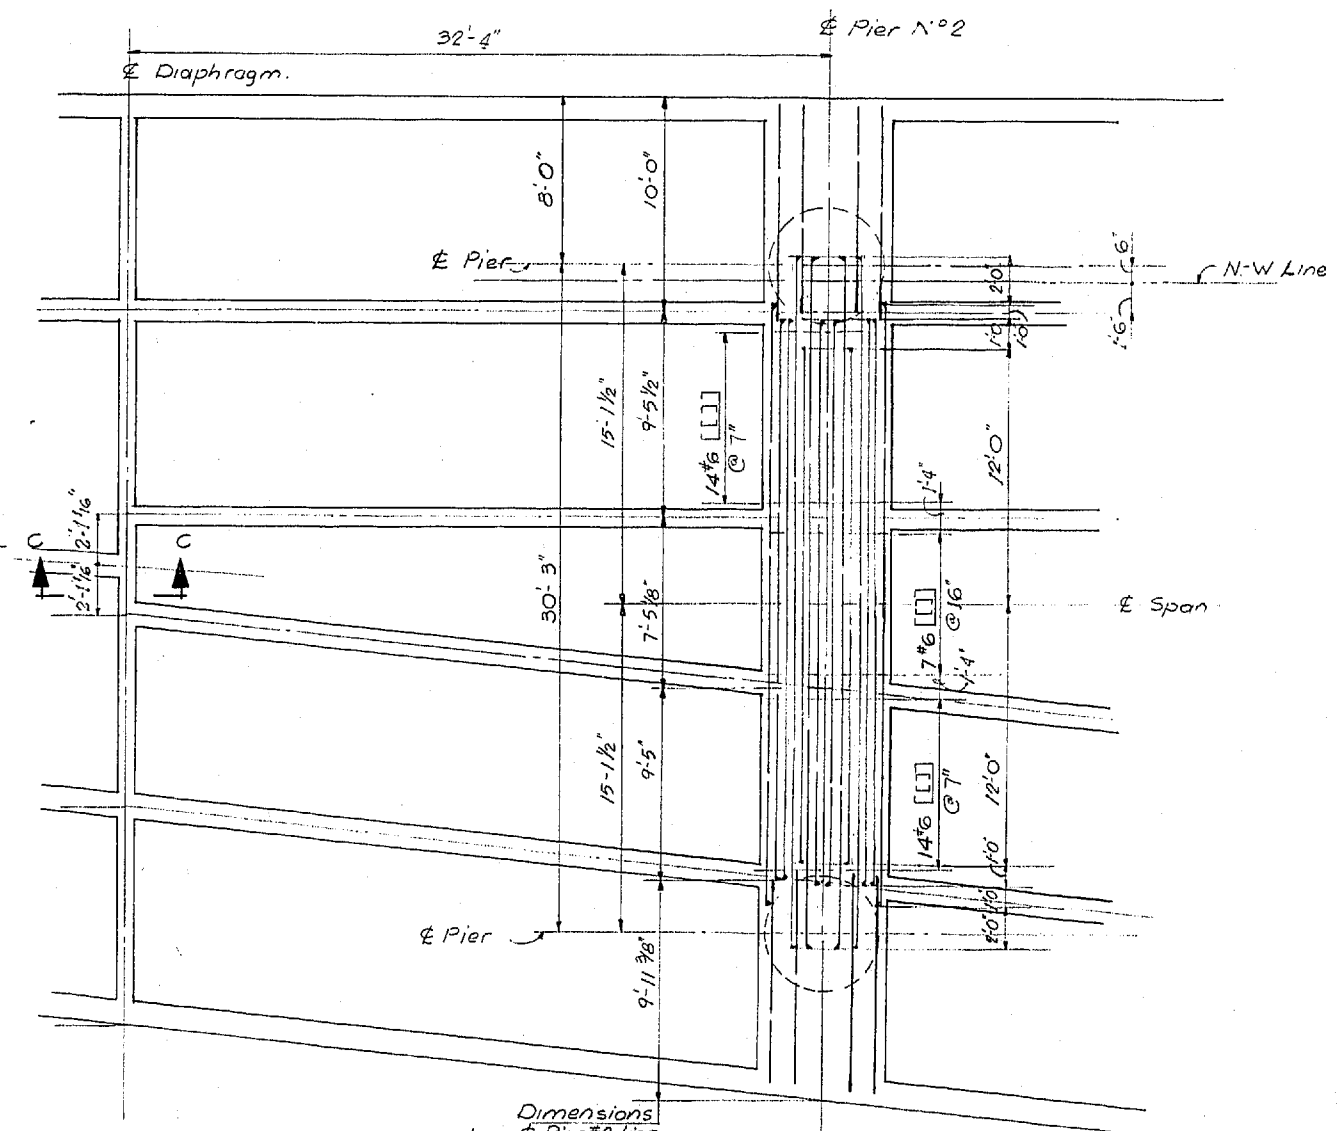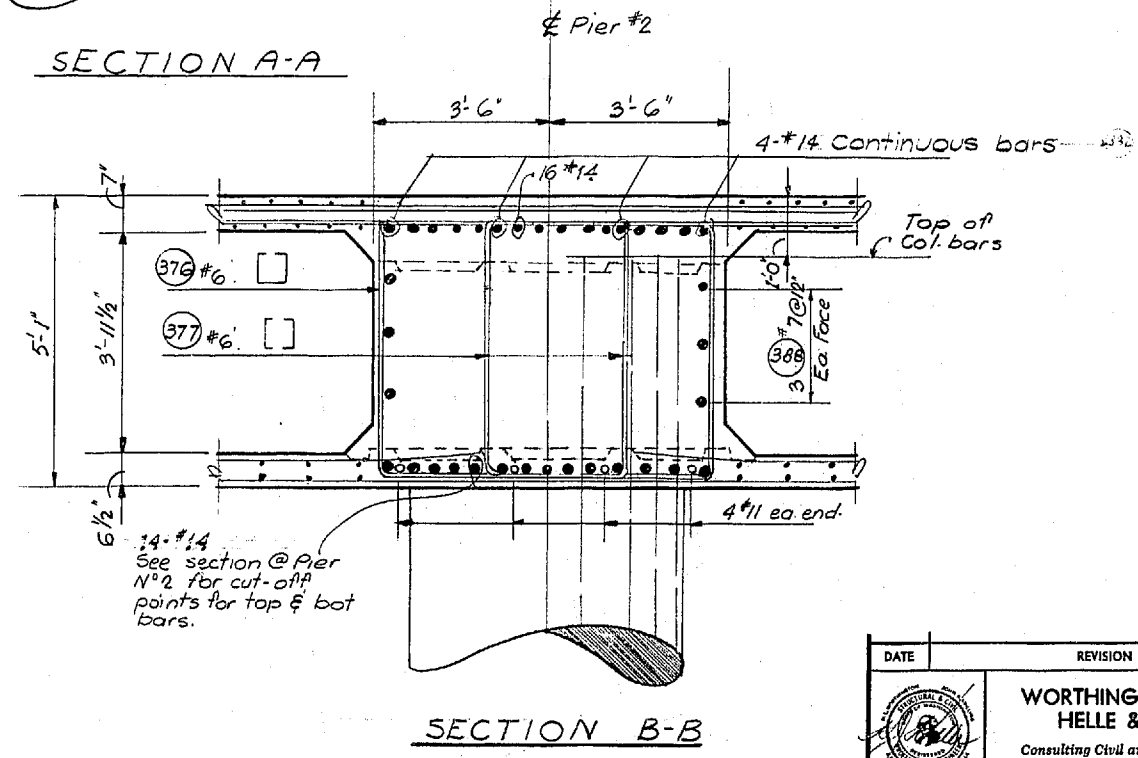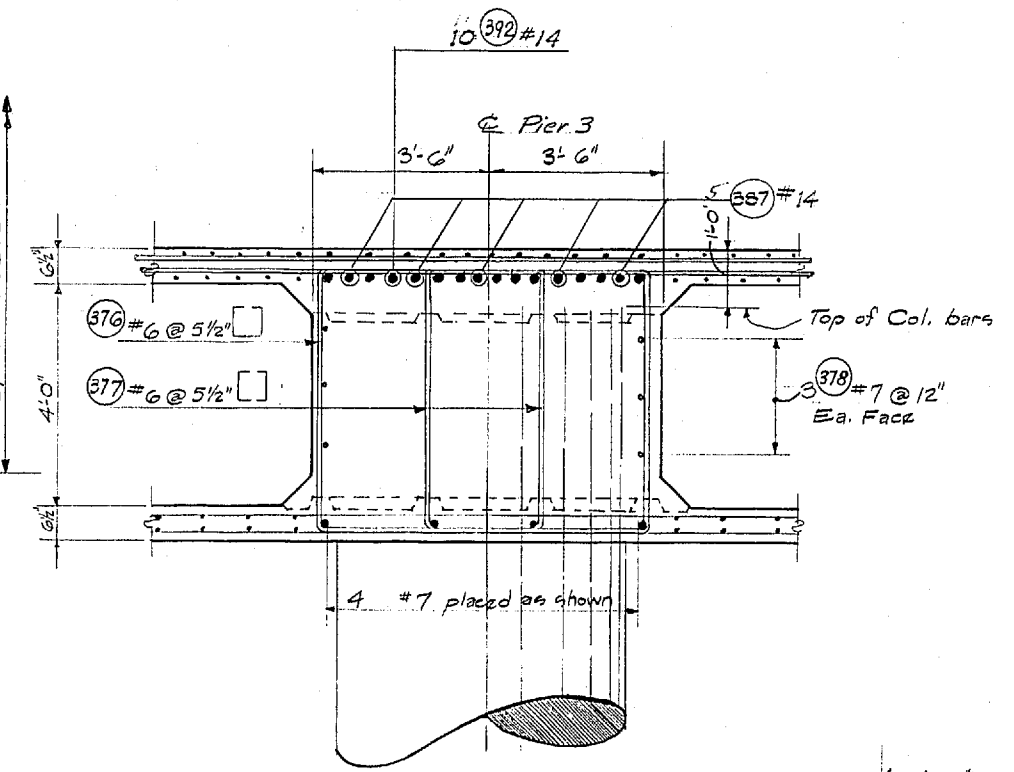

BOTTOM REINF.
Dimensions along Pier #2 line.

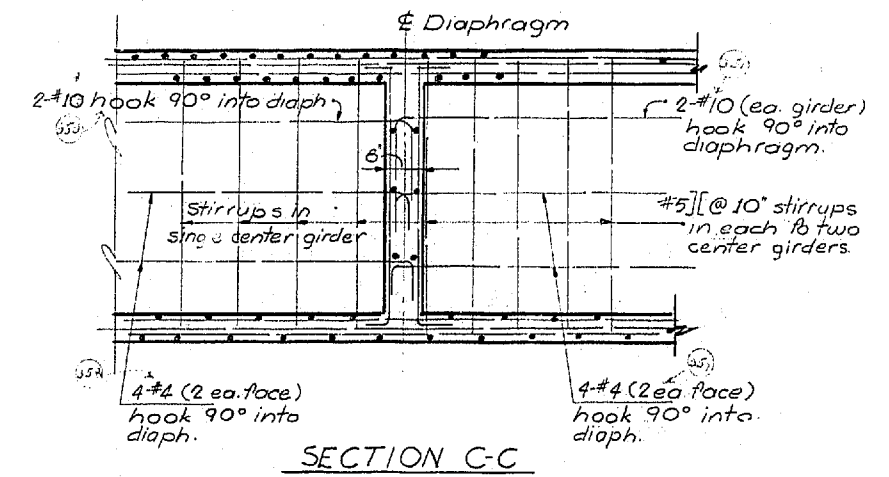

SR 405
MP 23.49 TO MP 23.76
WOODVILLE INTERCHANGE
KING COUNTY
N-W & N-E STRUCTURE
CROSSBEAM N-W & N-E PIER 2 AND N-E PIER 3

WASHINGTON STATE HIGHWAY COMMISSION
DEPARTMENT OF HIGHWAYS
OLYMPIA, WASHINGTON

F. L. MITALSON
H. WALSH

GEORGE D. ZAHN, CHAIRMAN

EAKER FERROUS
JOHN H. SUPP

APPROVED December 7, 1967
SHEET 236 OF 297 SHEETS
CONTRACT NO. 8382

BRIDGE ENGINEER


DATE _____ REVISION _____ BY _____

**WORTHINGTON, SKILLING
HELLE & JACKSON**
Consulting Civil and Structural Engineers
SEATTLE WASHINGTON


WOODVILLE INTERCHANGE
PSH NO. I-RE/PSH NO. 2-BO
N-W & N-E STRUCTURE
TRANSVERSE SECTIONS
SHEET 225 OF 289
11-16-67

As Built Changes in Red 9-15-70


P/1995

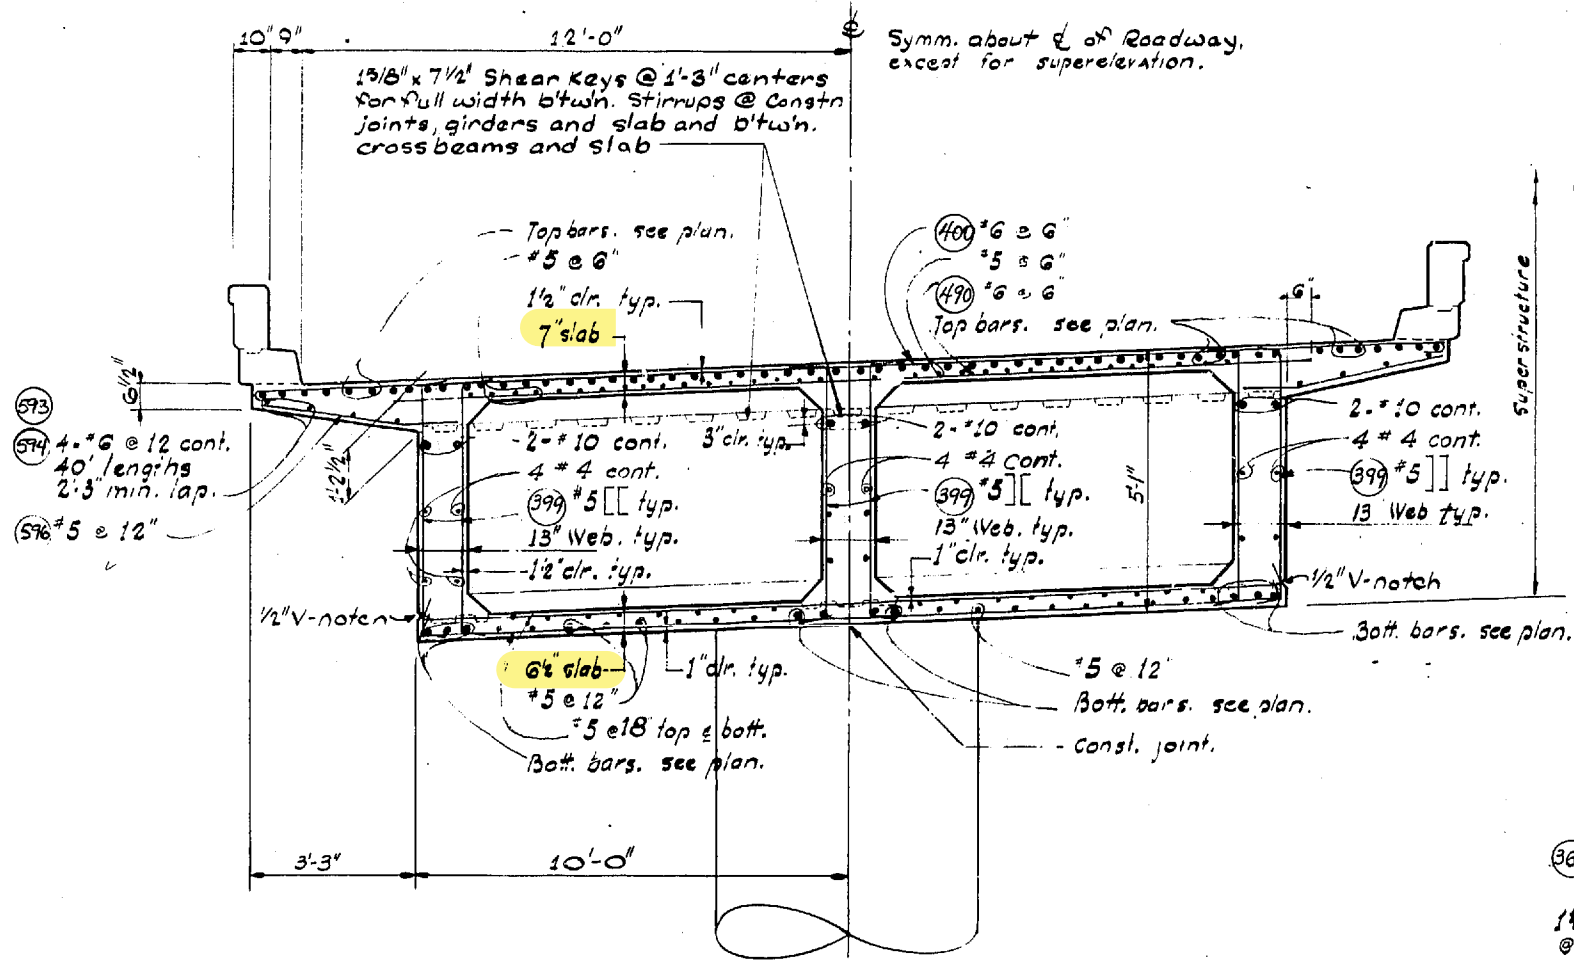


SECTION @ N-W PIER 3

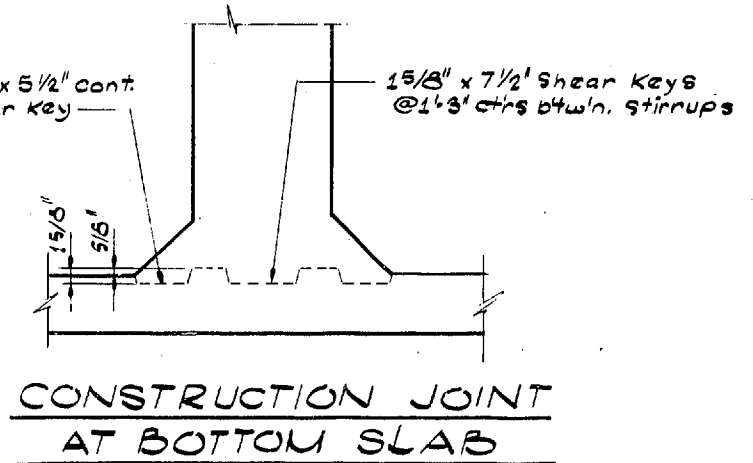


CONSTRUCTION JOINT AT BOTTOM SLAB

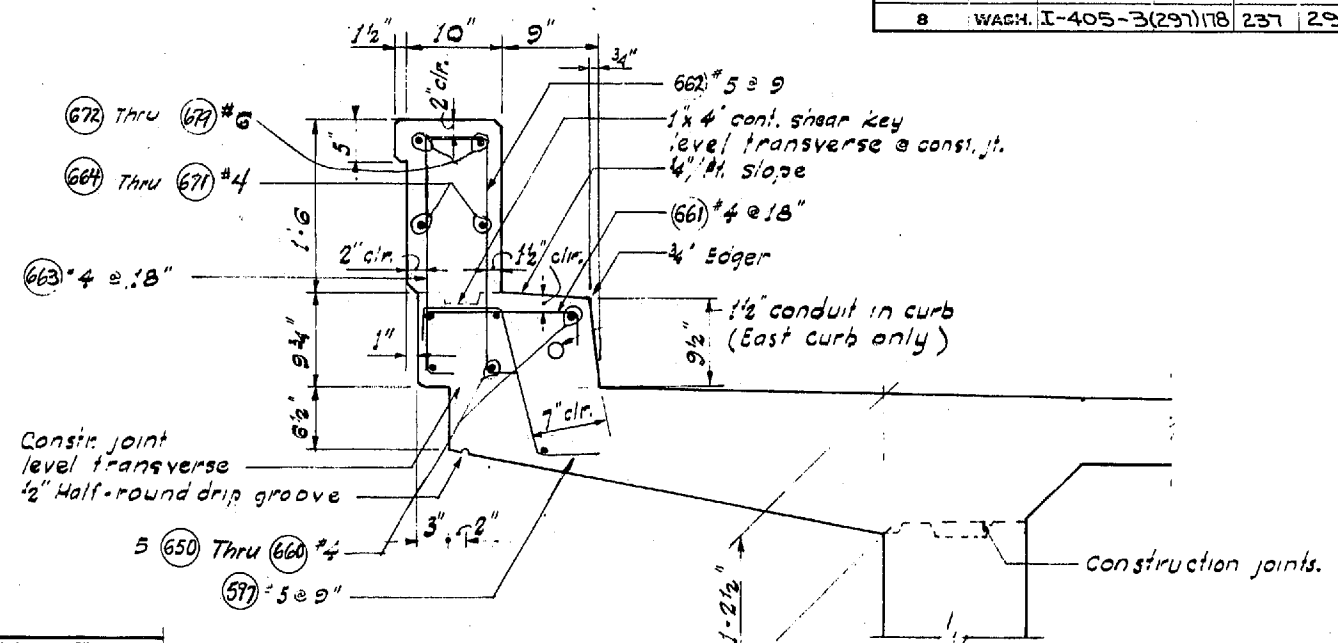


SECTION THRU CURB

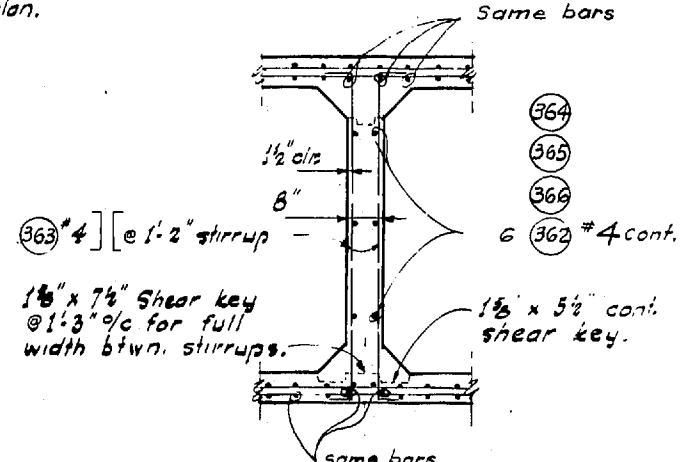


SECTION THRU DIAPHRAGM (TYPICAL ALL UNITS)

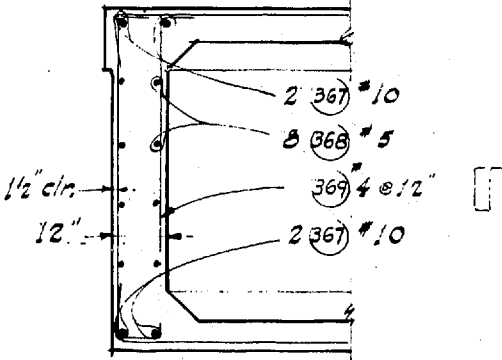


SECTION THRU END DIAPHR. @ PIER NO 1

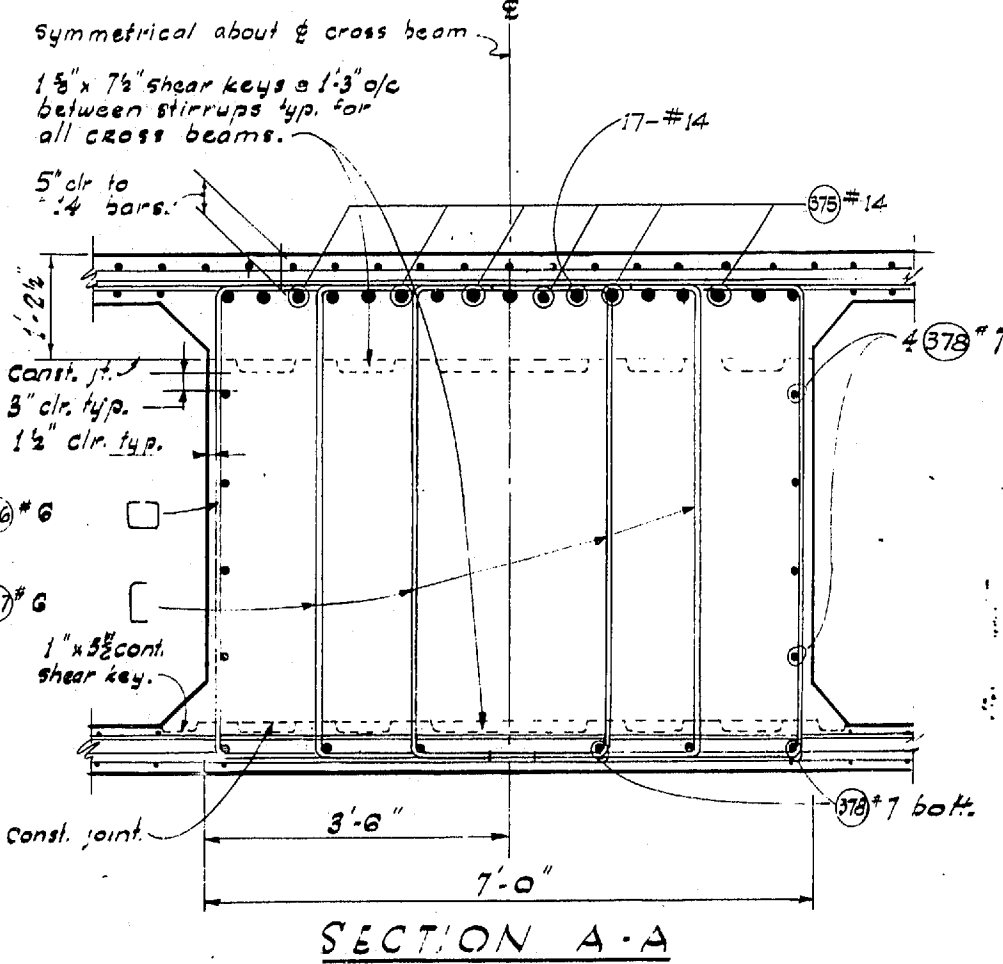

SECTION A-A

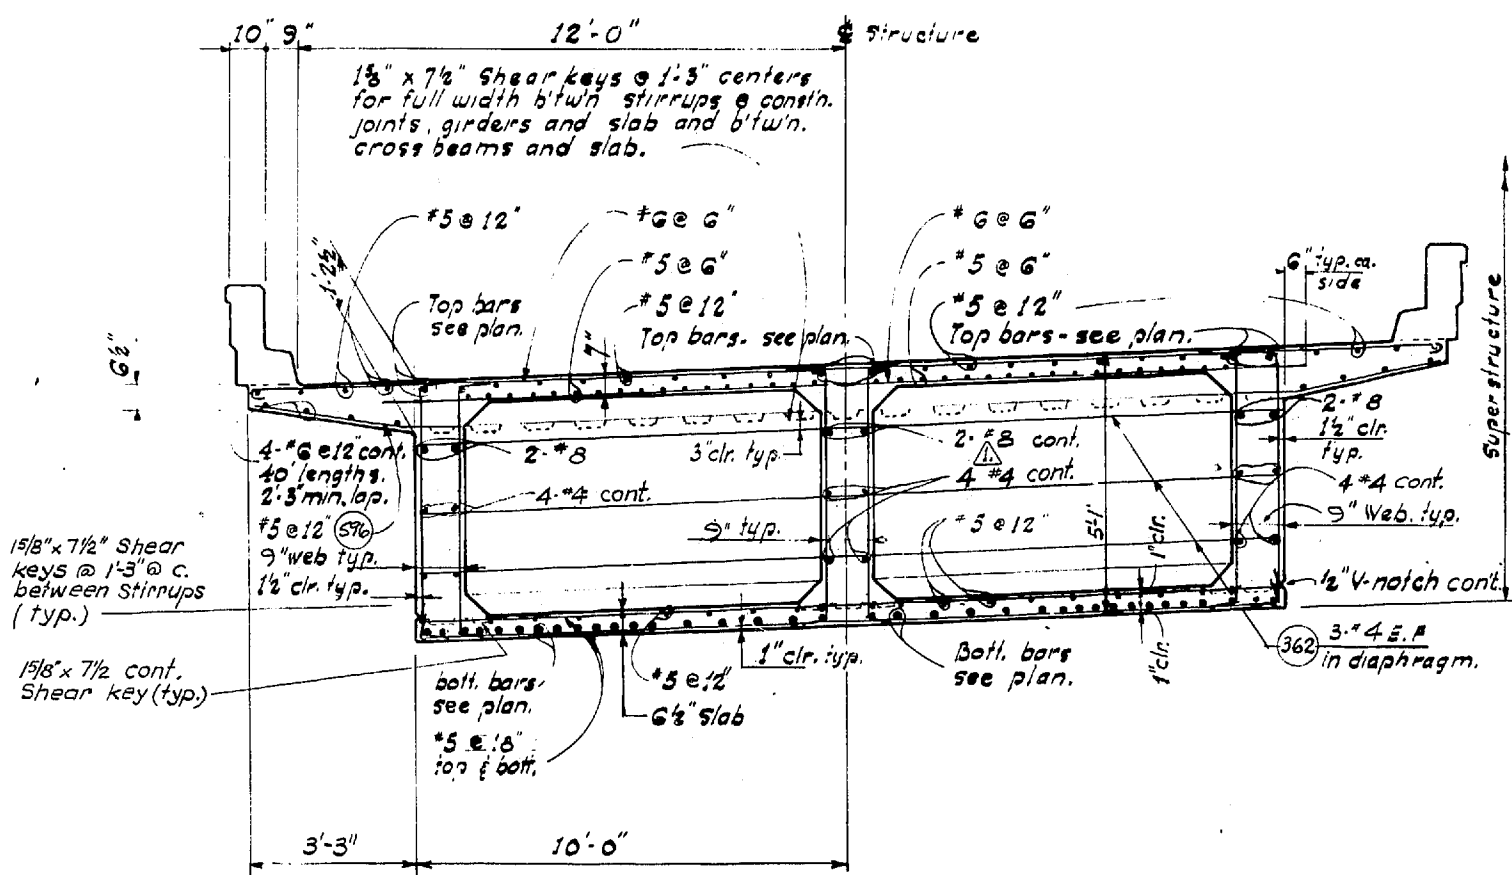

SECTION NEAR CENTER OF SPAN

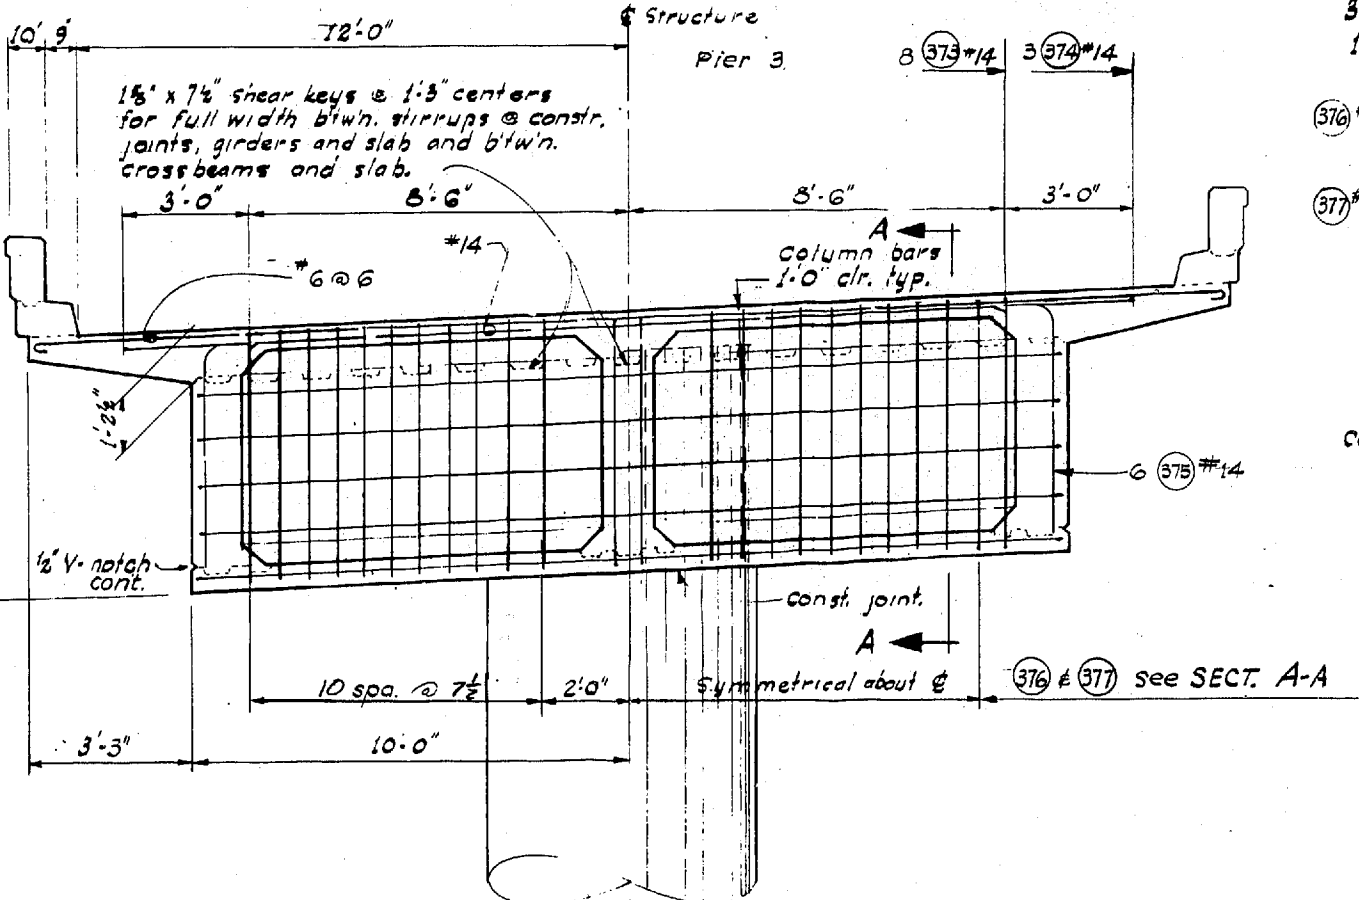

CROSS BEAM @ N-W PIER 3

REVISIONS	BY	DATE

ASPHALT CROSS BEAMS

DATE	
BY	

11-16-67

WOODVILLE INTERCHANGE
 PSH NO. 1-RE/PSH NO. 2-BO
 N-W STRUCTURE
 TRANSVERSE SECTIONS
 SHEET 229 OF 289

2-7-68 Revised Bar Size

DATE	REVISION	BY

WORTHINGTON, SKILLING
 HELLE & JACKSON
 Consulting Civil and Structural Engineers
 SEATTLE WASHINGTON

SR 405
 MP 23.49 TO MP 23.76
 WOODVILLE INTERCHANGE
 KING COUNTY
 N-W & N-E STRUCTURE

CROSSBEAM N-W PIER 3

WASHINGTON STATE HIGHWAY COMMISSION
 DEPARTMENT OF HIGHWAYS
 OLYMPIA, WASHINGTON

GEORGE D. ZAHM, CHAIRMAN




APPROVED December 7, 1967
 SHEET 237 OF 297 SHEETS
 CONTRACT NO. 8382

P/1995

FED. ROAD DIV. NO.	STATE	FED. AID PROJ. NO.	SHEET NO.	TOTAL SHEETS
8	WASH.	I-405-3(297)118	238	297

DESIGNER	ENGINEER	CHECKER	DATE

DATE	BY

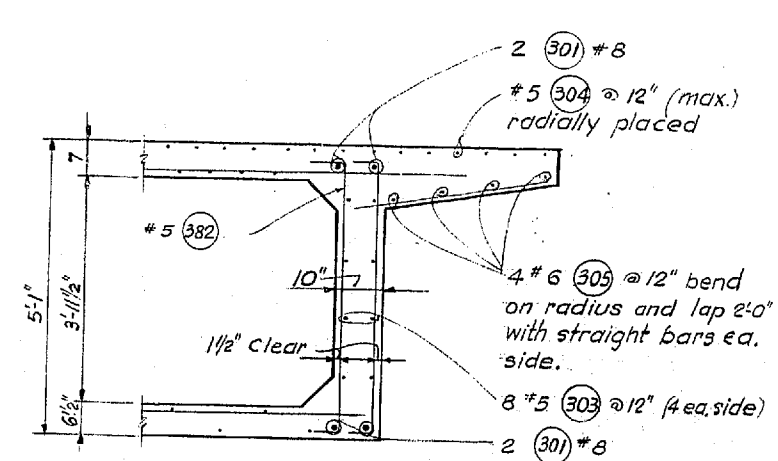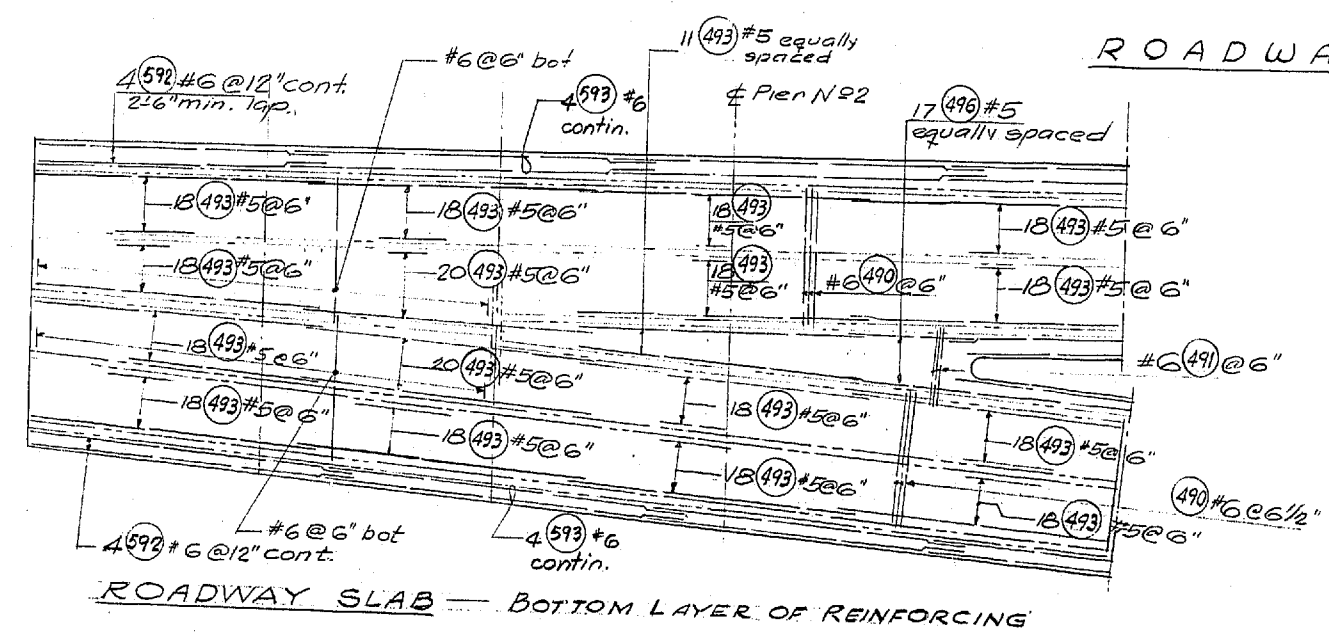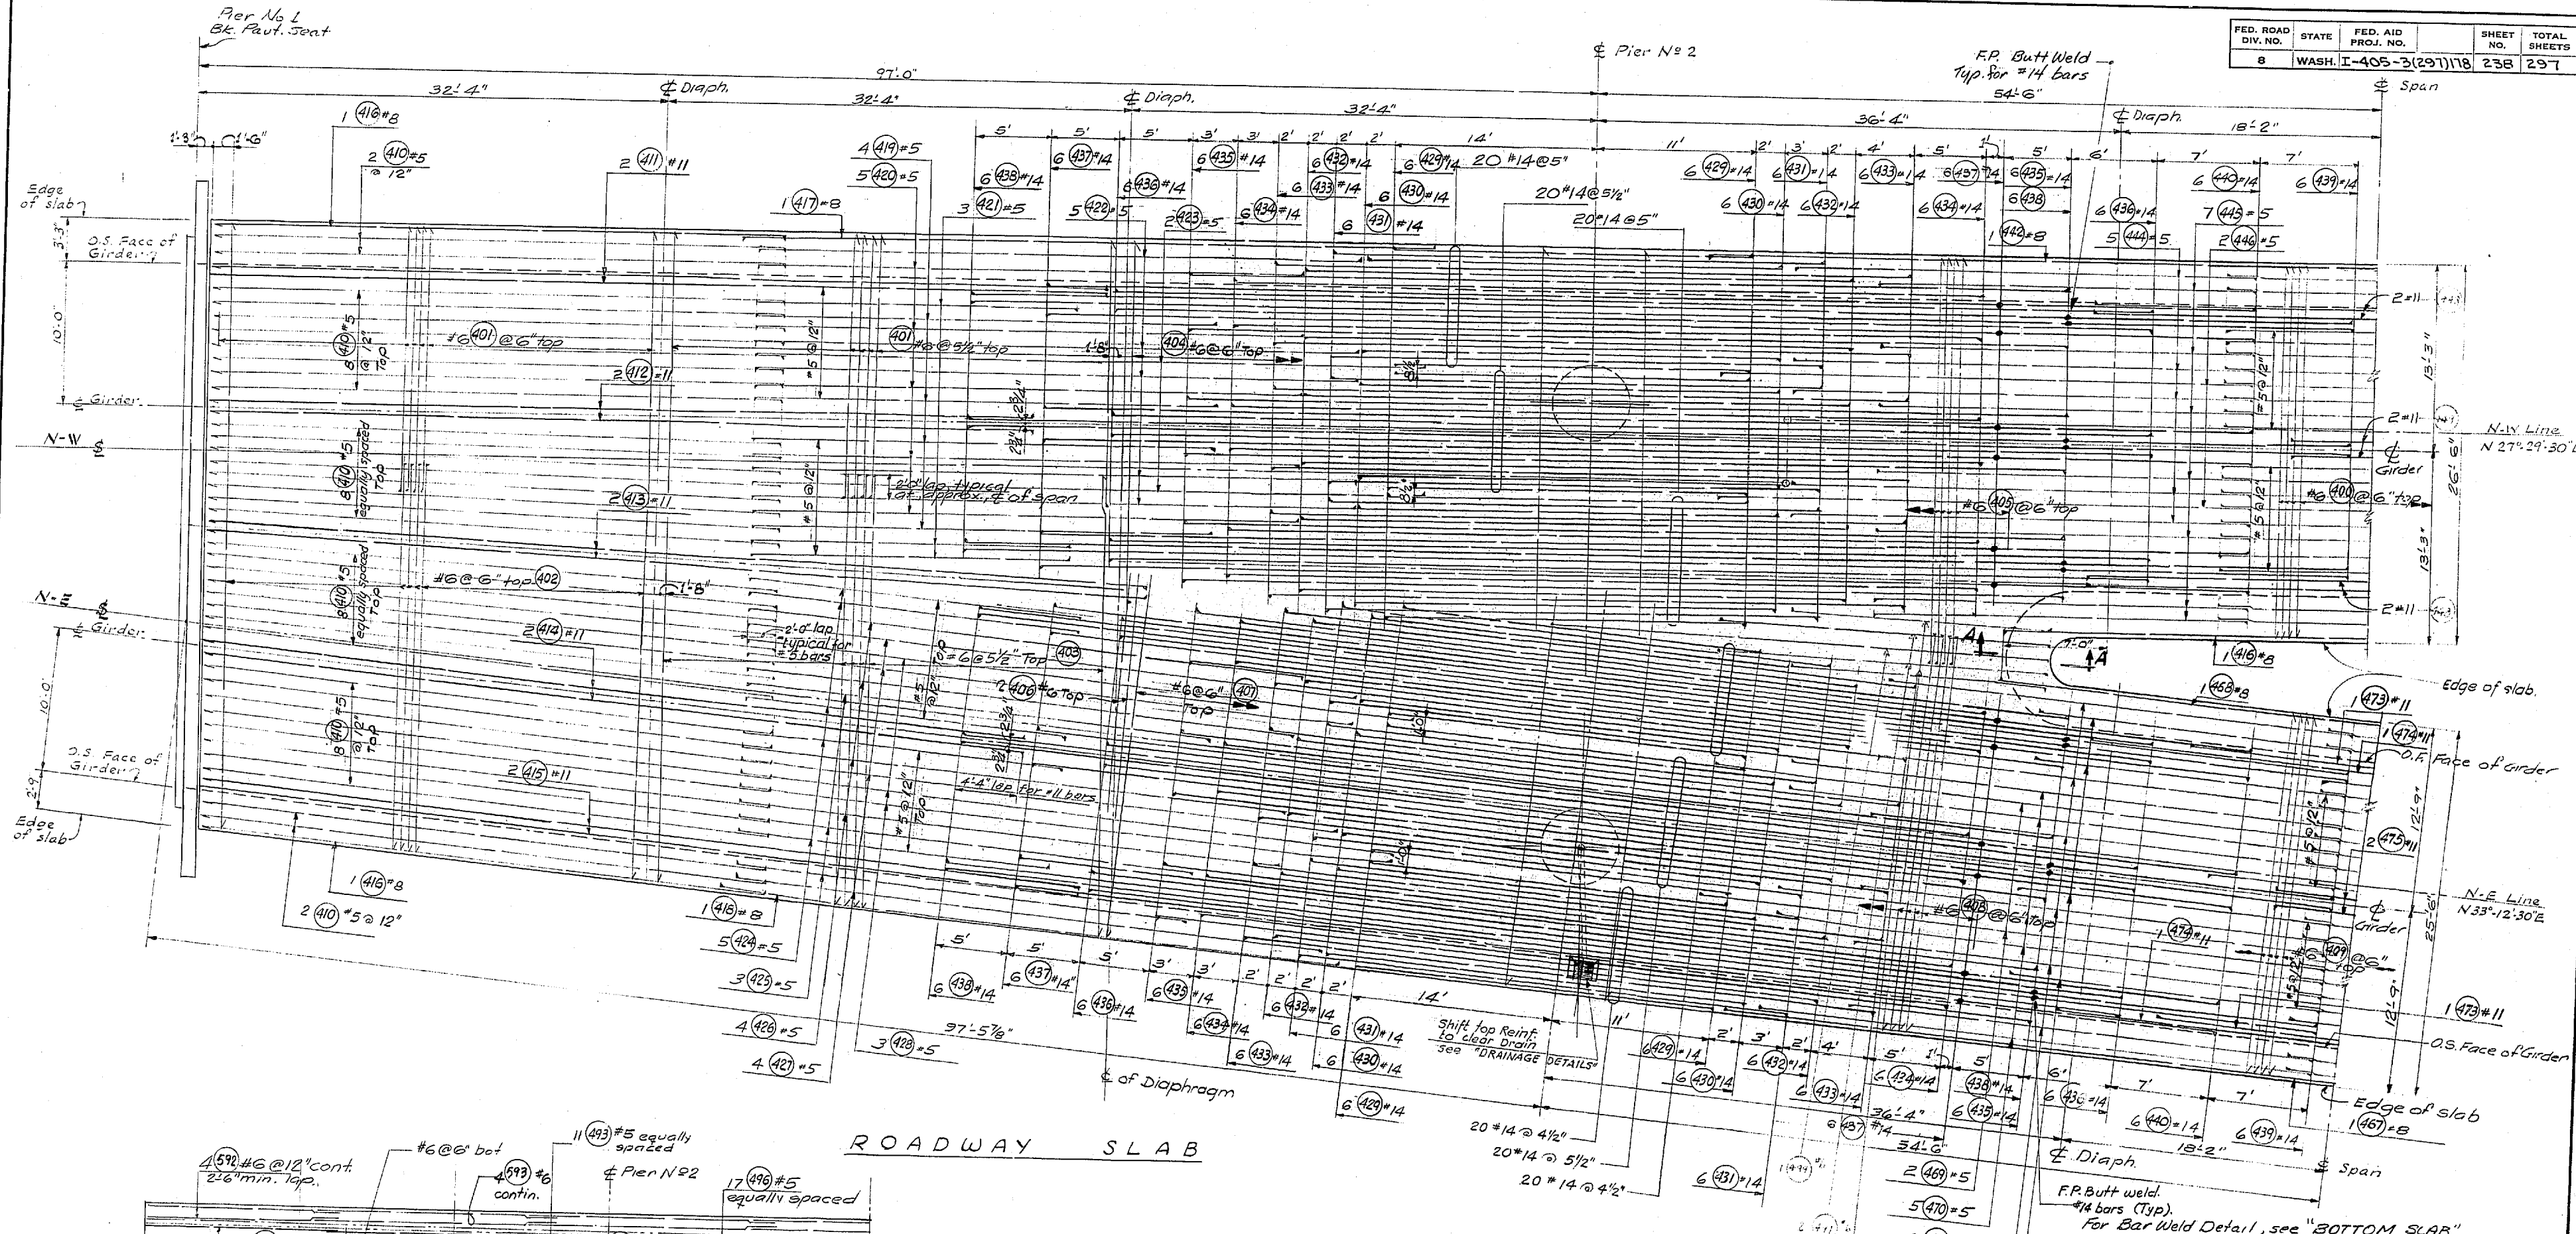

DATE	REVISION	BY

WORTHINGTON, SKILLING HELLE & JACKSON
 Consulting Civil and Structural Engineers
 SEATTLE WASHINGTON

SR 405
MP 23.49 TO MP 23.76
WOODINVILLE INTERCHANGE
 KING COUNTY
N-W & N-E STRUCTURE
N-W & N-E ROADWAY SLAB

WASHINGTON STATE HIGHWAY COMMISSION
 DEPARTMENT OF HIGHWAYS
 OLYMPIA, WASHINGTON


GEORGE D. ZANK, CHAIRMAN
 R. I. MITAISON
 H. WALSH
 JOHN M. RUPP
 BRIDGE ENGINEER

APPROVED December 7, 1967
 SHEET 238 of 297 SHEETS
 CONTRACT NO. 8382


WOODINVILLE INTERCHANGE
 PSH NO. 1 RE/FISH NO. 2-50
 N-W & N-E STRUCTURE
 ROADWAY SLAB
 SHEET 238 of 297
 11-16-67

DESIGNING ENGINEER	
DESIGNED	
DESIGN CHECKED	
DRAWN BY	
TRACED	
LOC. ENGR.	
DATE	

DATE	
BY	
DRAWN	
TRACED	
LOC. ENGR.	
DATE	

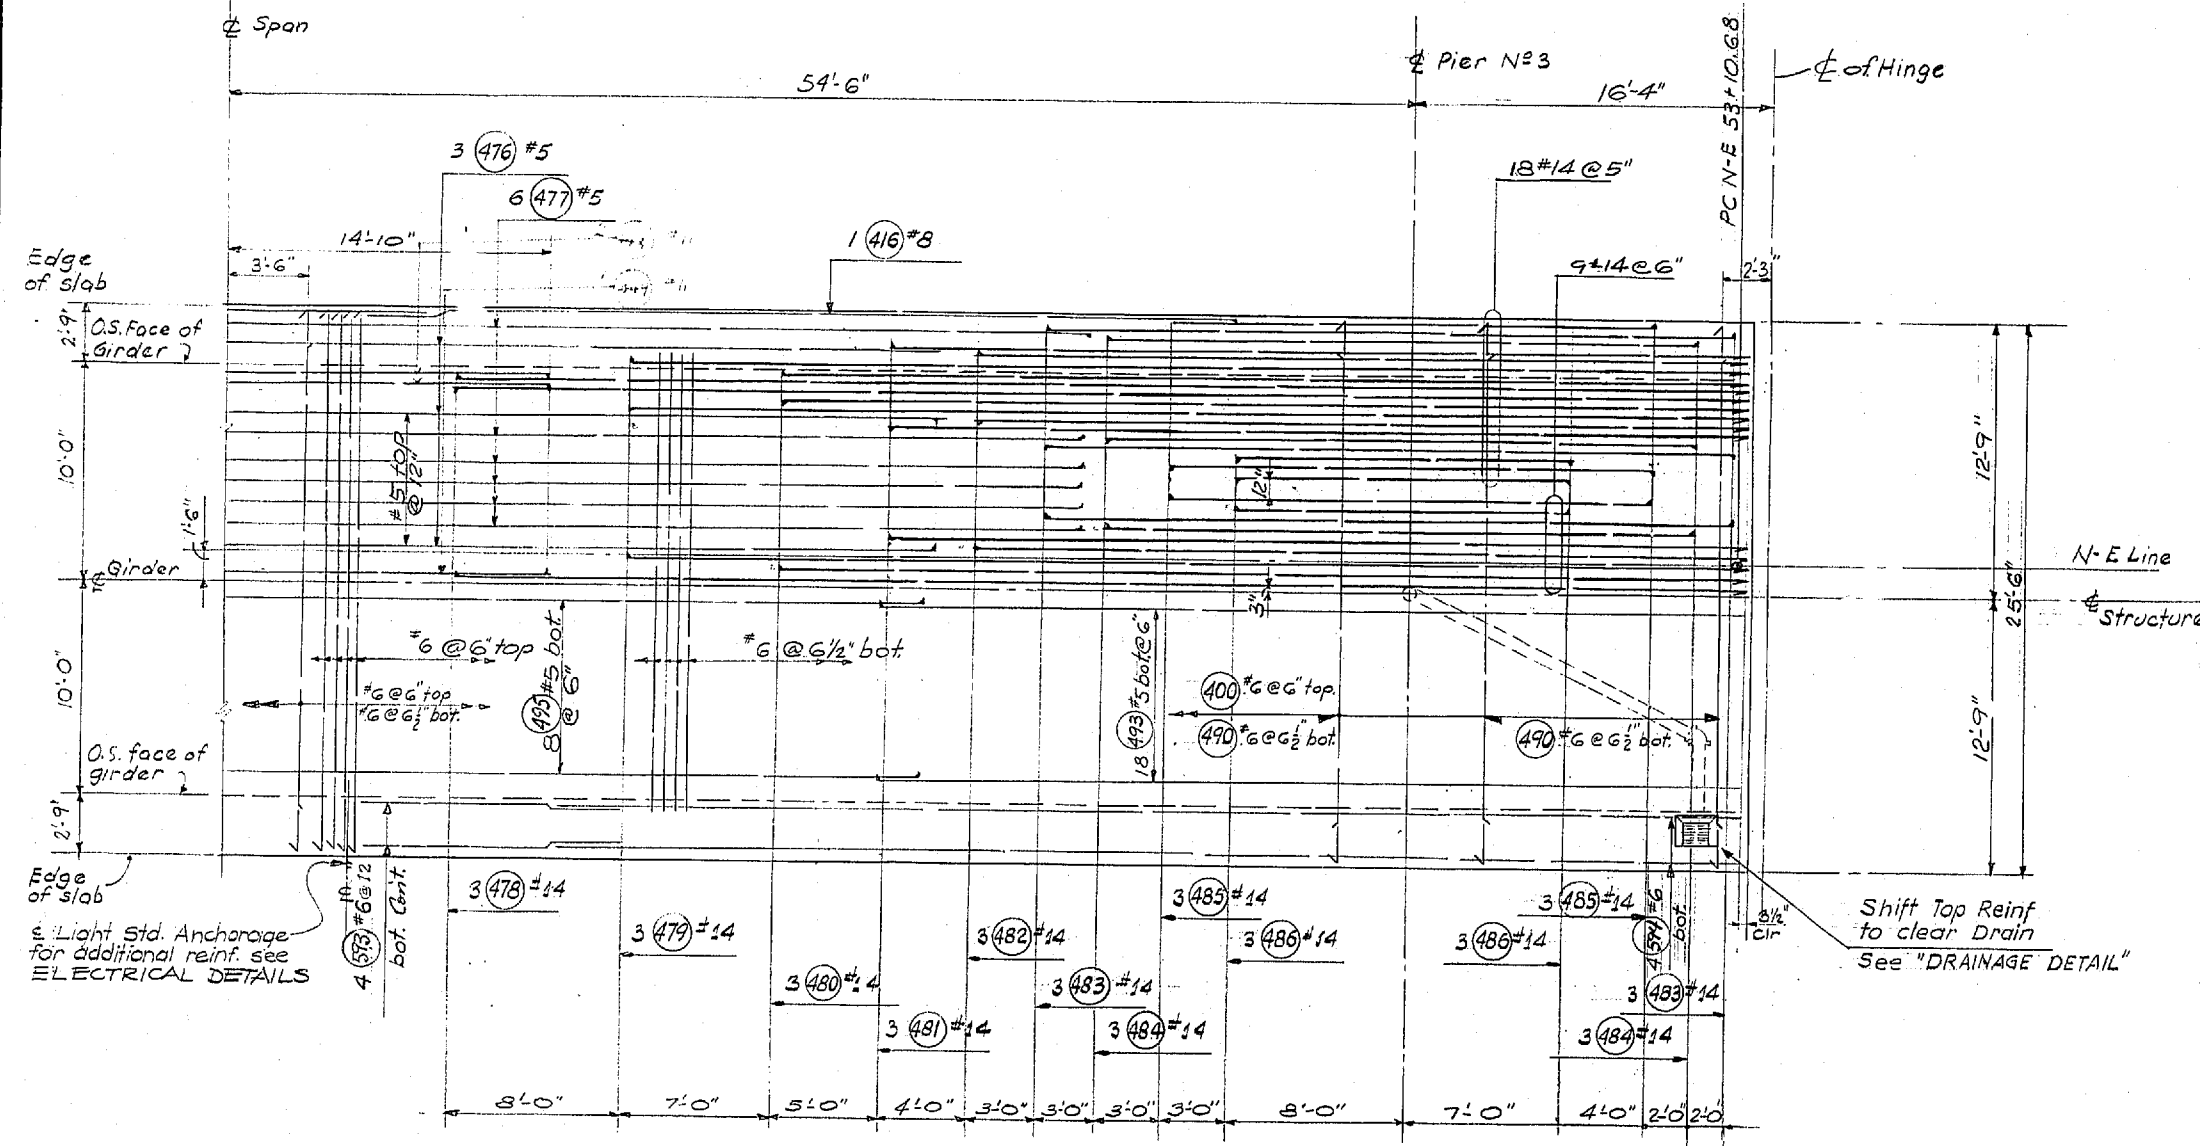

N-E ROADWAY SLAB

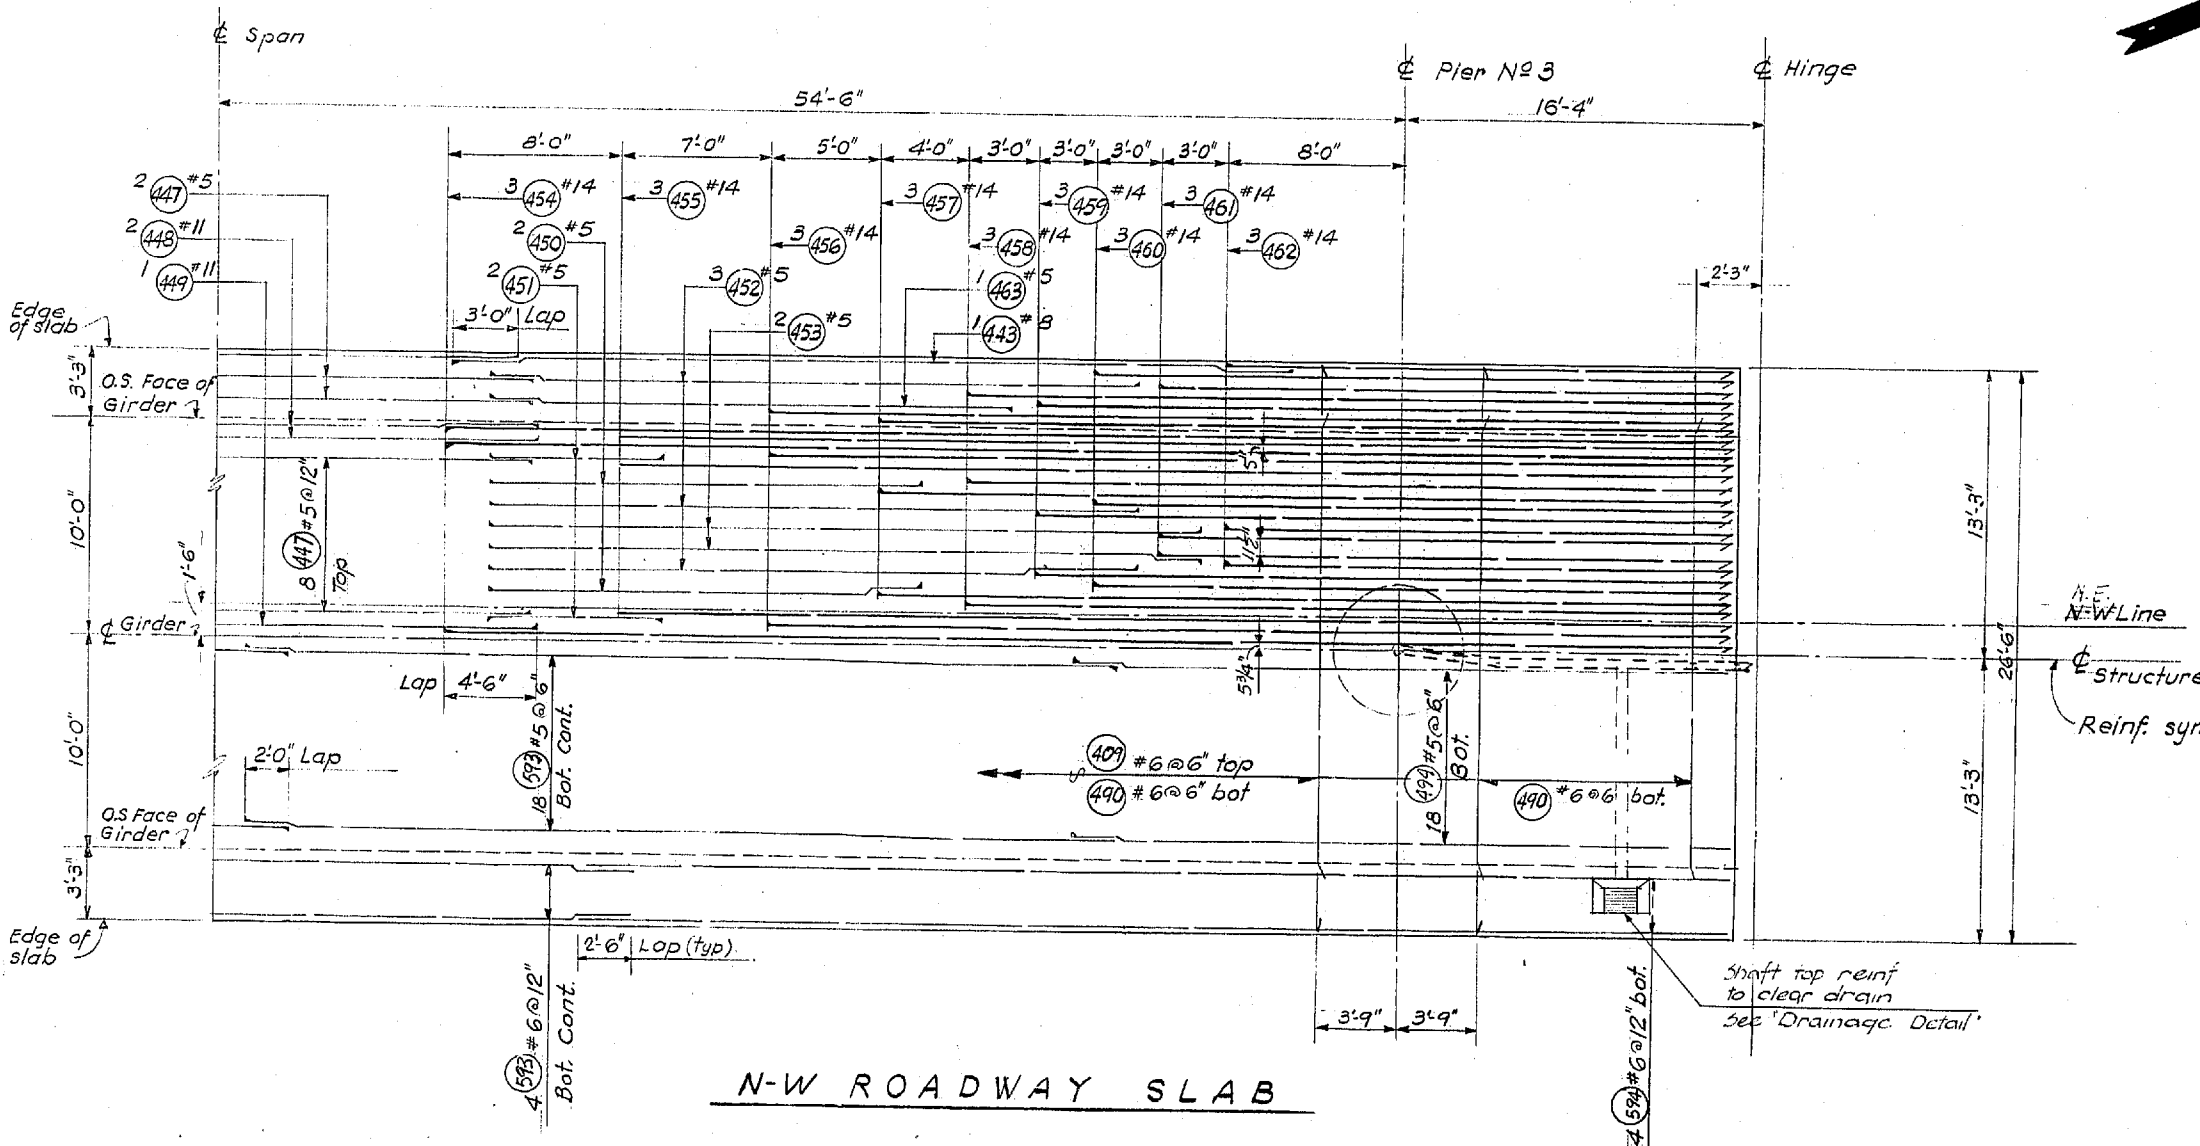

N-W ROADWAY SLAB



11-16-67

WOODVILLE INTERCHANGE
 PSH NO. 1-RE/PSH NO. 2-BO
 N-W & N-E ROADWAY SLAB
 SHEET 231 OF 297

SR 405
MP 23.49 TO MP 23.76
WOODVILLE INTERCHANGE
 KING COUNTY
N-W & N-E STRUCTURE
N-W & N-E ROADWAY SLAB

WASHINGTON STATE HIGHWAY COMMISSION
 DEPARTMENT OF HIGHWAYS
 OLYMPIA, WASHINGTON

GEORGE D. ZANN, CHAIRMAN

F. L. McFARLAN
 H. WALSH

BAKRY FERDOUN
 JOHN M. RUPP

APPROVED: December 7, 1967
 SHEET 239 OF 297 SHEETS
 CONTRACT NO. 8382





DATE	REVISION	BY

**WORTHINGTON, SKILLING
 HELLE & JACKSON**
 Consulting Civil and Structural Engineers
 SEATTLE WASHINGTON

As Built Changes in E-3 7-15-70

19/1995

FED. ROAD DIV. NO.	STATE	FED. AID PROJ. NO.	SHEET NO.	TOTAL SHEETS
8	WASH.	1-405-3(29)118	240	297

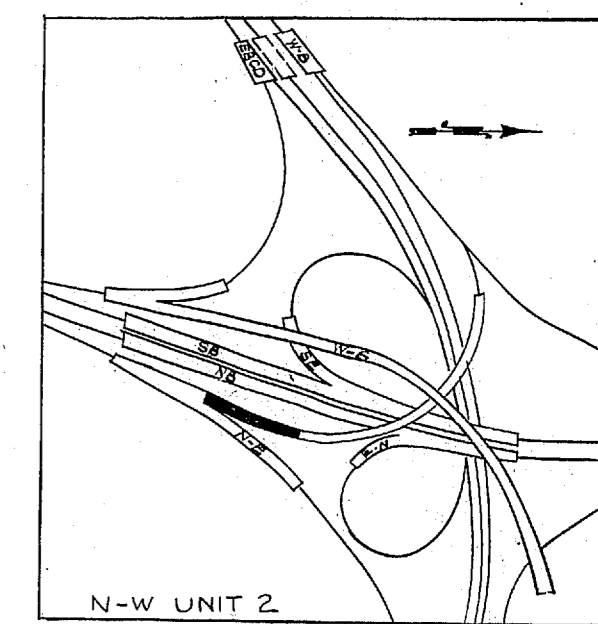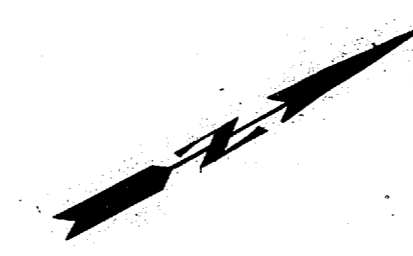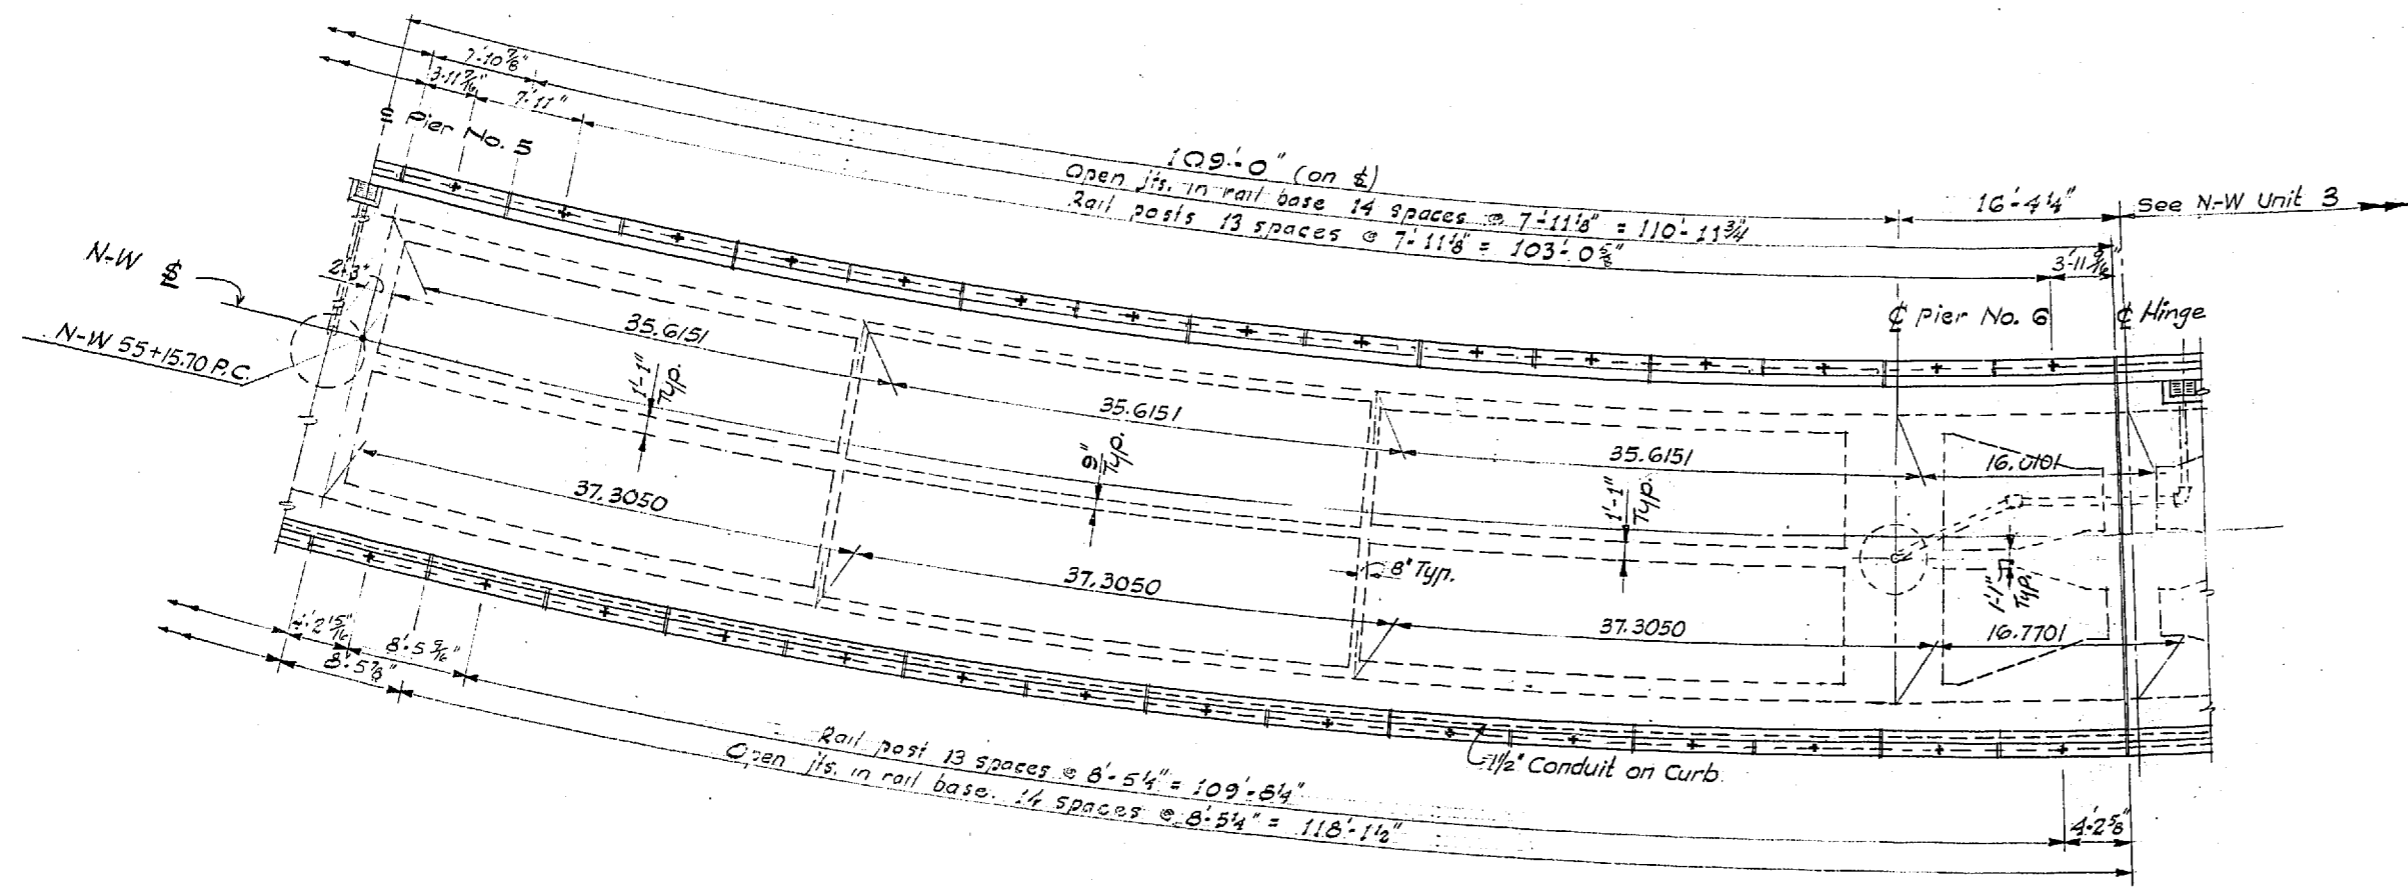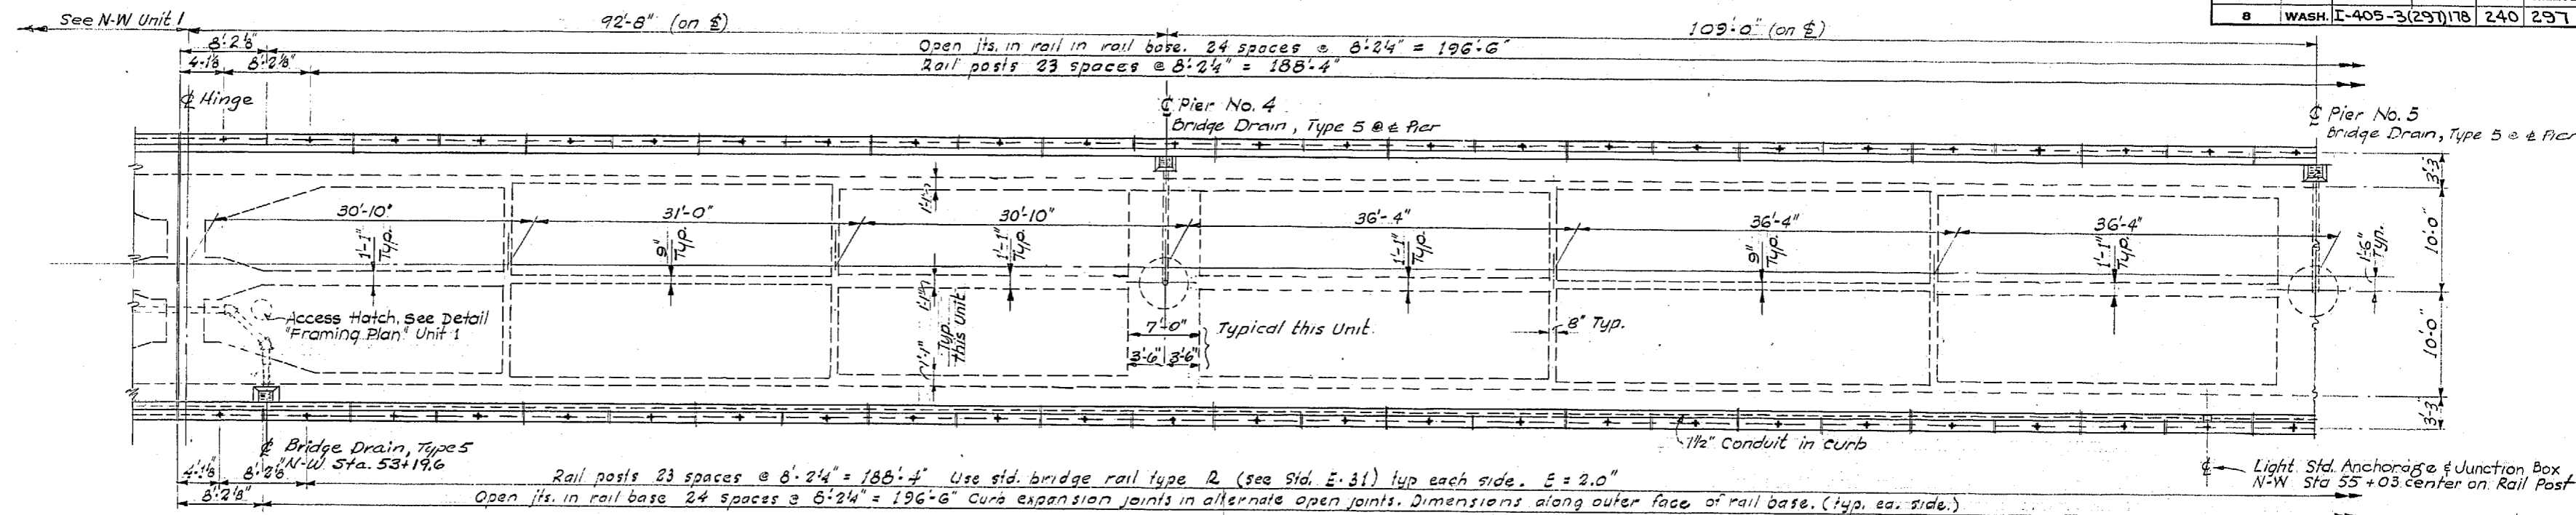

FRAMING PLAN

For General Notes See Unit 1 Framing Plan

DESIGNED	
CHECKED	
QUANTITIES CHECKED	

DATE	
BY	
DRAWN	
CHECKED	
LOC. ENGR.	
DATE	

11-16-67

WOODVILLE INTERCHANGE
FSH NO. 1-RE/FSH NO. 2-BO
STRUCTURE
SHEET OF 297

DATE	REVISION	BY

WORTHINGTON, SKILLING
HELLE & JACKSON
Consulting Civil and Structural Engineers
SEATTLE WASHINGTON

SR 405
MP 23.49 TO MP 23.76
WOODVILLE INTERCHANGE
KING COUNTY
N-W & N-E STRUCTURE

FRAMING PLAN

WASHINGTON STATE HIGHWAY COMMISSION
DEPARTMENT OF HIGHWAYS
OLYMPIA, WASHINGTON

GEORGE D. ZAHM, CHAIRMAN

F. I. McALPIN
N. WALSH

DAVE FERDINON
JOHN H. BOPP

APPROVED: December 7, 1967
SHEET 240 OF 297 SHEETS
CONTRACT NO. 8382



BRIDGE ENGINEER

P/1995

FED. ROAD DIV. NO.	STATE	FED. AID PROJ. NO.	SHEET NO.	TOTAL SHEETS
8	WASH.	I-405-3(29)118	241	297

DESIGNED	BY	DATE
CHECKED	BY	DATE
QUANTITIES CHECKED	BY	DATE

DESIGNED	BY	DATE
CHECKED	BY	DATE
QUANTITIES CHECKED	BY	DATE

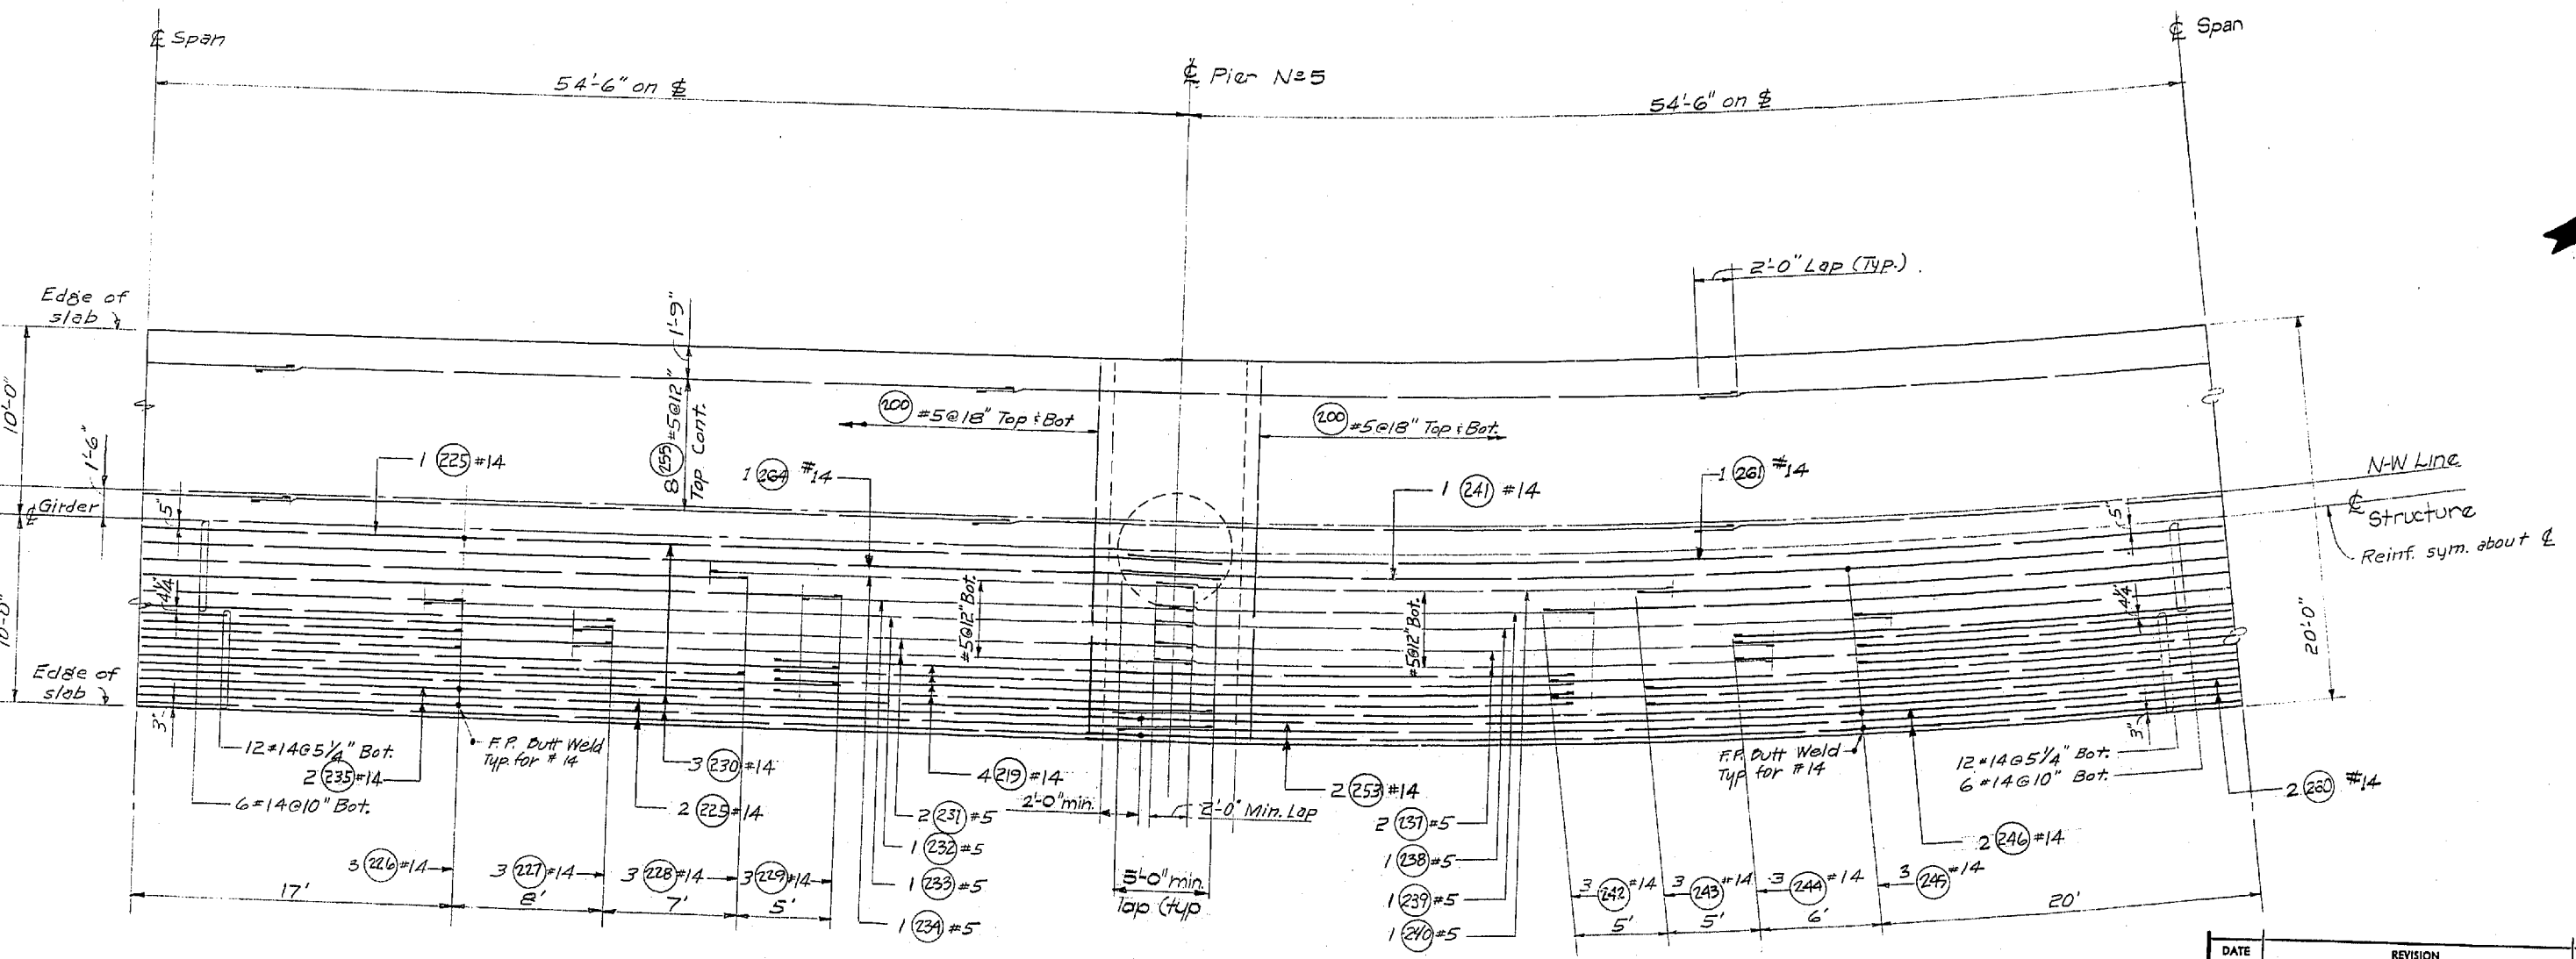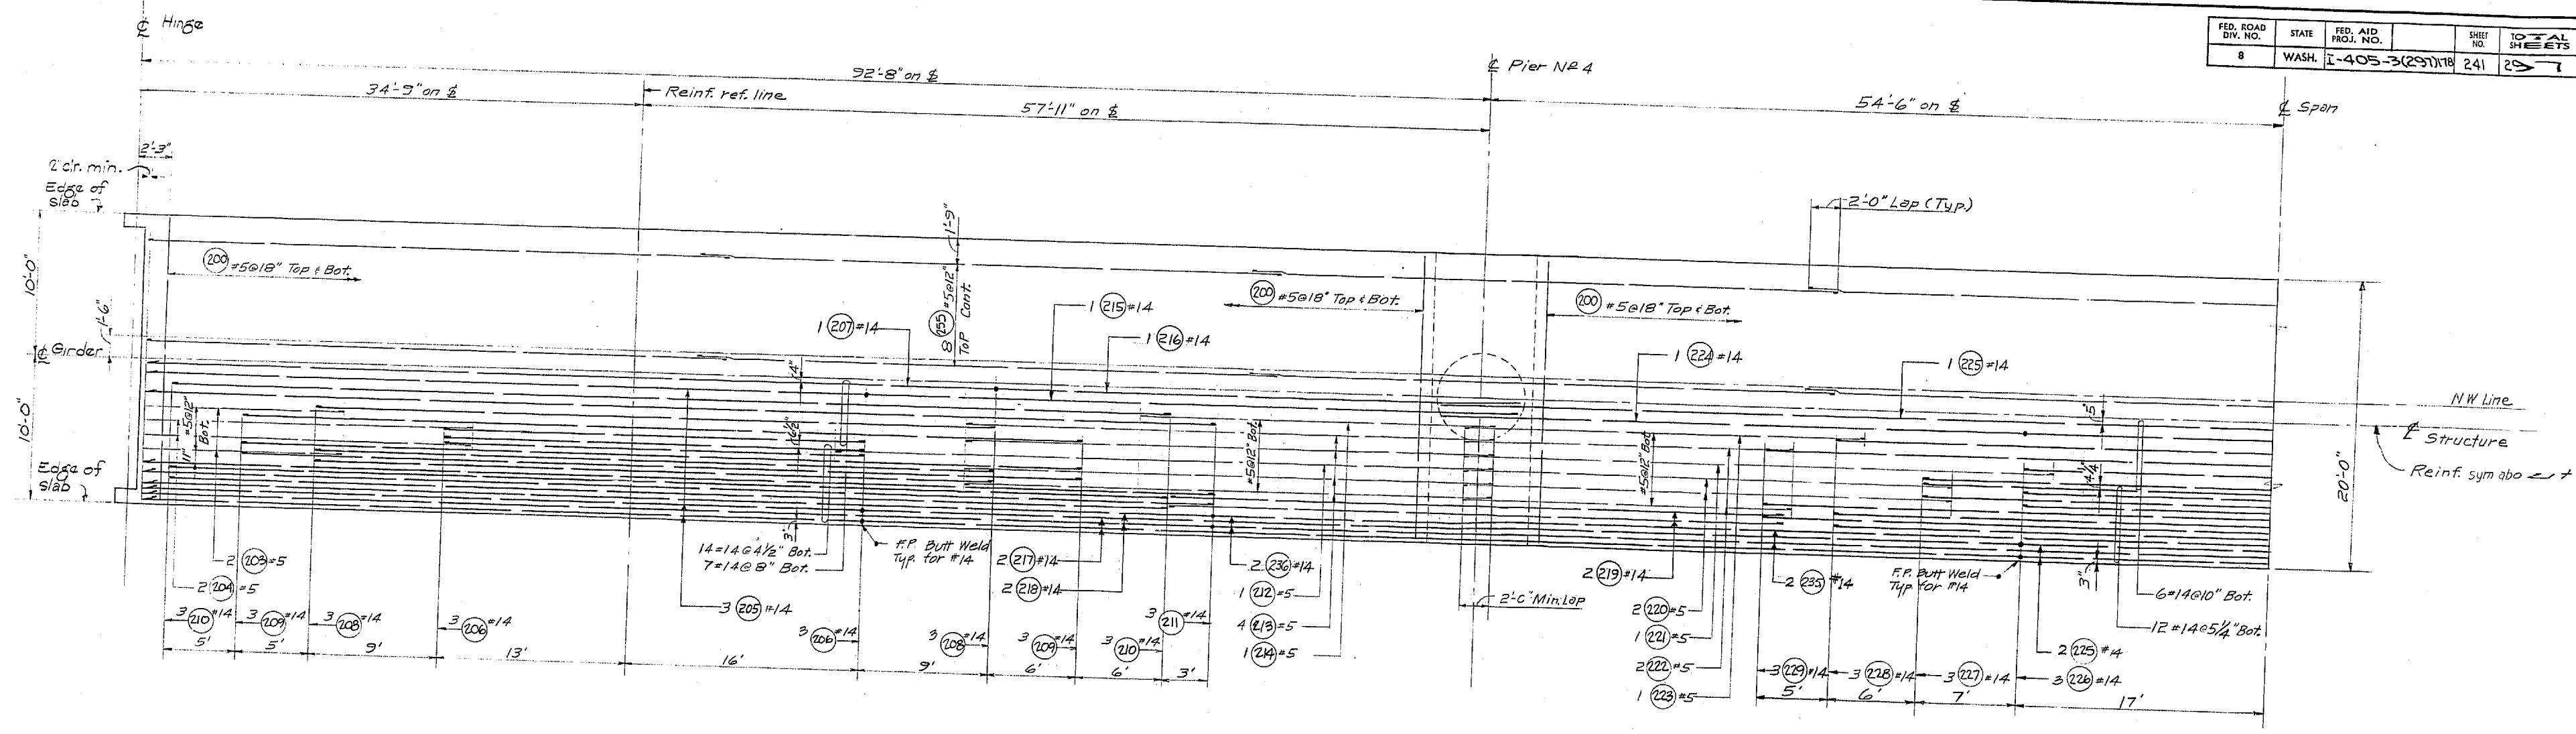

For Bar Weld and Call Drain Detail, see 'BOTTOM SLAB' UNIT 1.
For D.L. Camber Curve, see next sheet.

BOTTOM SLAB

DATE	REVISION	BY

WORTHINGTON, SKILLING HELLE & JACKSON
 Consulting Civil and Structural Engineers
 SEATTLE WASHINGTON

SR 405
MP 23.49 TO MP 23.76
WOODINVILLE INTERCHANGE
 KING COUNTY
N-W & N-E STRUCTURE
BOTTOM SLAB

WASHINGTON STATE HIGHWAY COMMISSION
 DEPARTMENT OF HIGHWAYS
 OLYMPIA, WASHINGTON

F. L. MYLSON
 H. WALSH

GEORGE D. ZANK, CHAIRMAN
 BAKER FERGUSON
 JOHN N. RUFF


APPROVED: December 7, 1967
 SHEET 241 OF 291 SHEETS
 CONTRACT NO. 8382

NW STRUCTURE BOTTOM SLAB
 SHEET 241 OF 291


11-10-67

DESIGNED BY
 CHECKED BY
 QUANTITIES FIGURED
 QUANTITIES CHECKED

DATE
 BY
 DRAWN
 CHECKED
 DATE REVISION

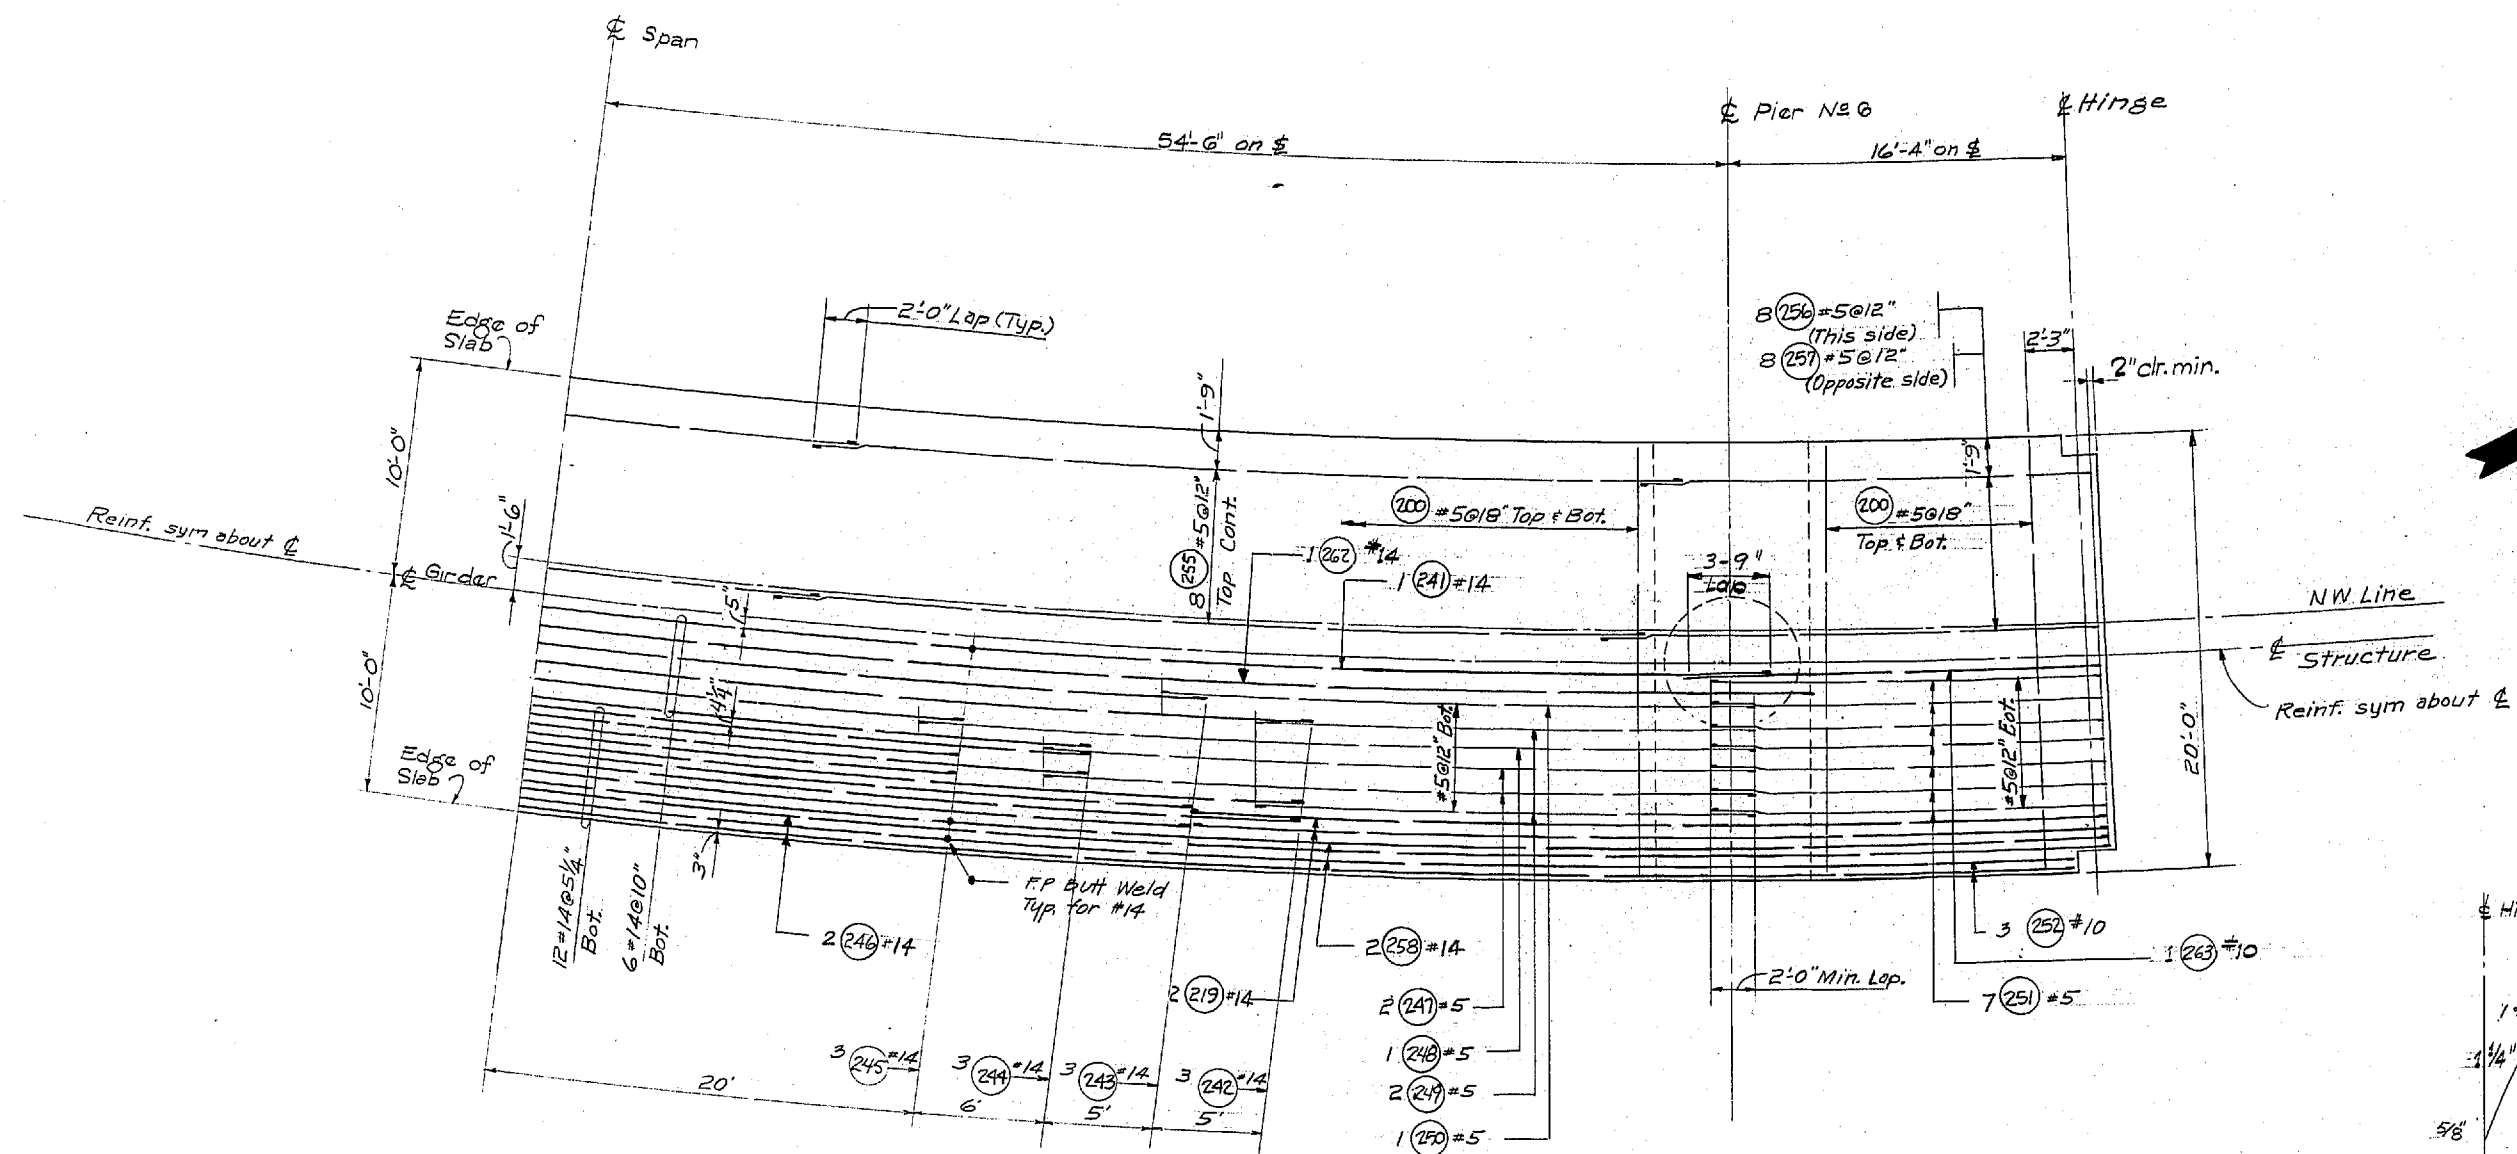

BOTTOM SLAB

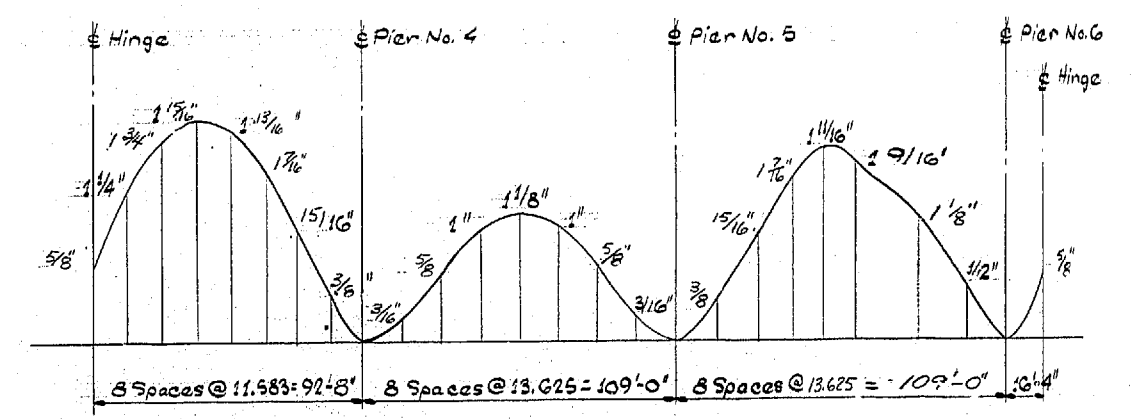

DEAD LOAD CAMBER CURVE FOR N-W RAMP

This curve shows D.L. Camber only and should be increased by the amount of take up anticipated in the falsework.

WOODVILLE INTERCHANGE
 PSH NO. 1-RE/PSH NO. 2-BO
 NW STRUCTURE
 BOTTOM SLAB
 SHEET 234 OF 289

11-16-67

DATE	REVISION	BY

WORTHINGTON, SKILLING HELLE & JACKSON
 Consulting Civil and Structural Engineers
 SEATTLE WASHINGTON

**SR 405
 MP 23.49 TO MP 23.76
 WOODVILLE INTERCHANGE
 KING COUNTY
 N-W & N-E STRUCTURE**

BOTTOM SLAB




WASHINGTON STATE HIGHWAY COMMISSION
 DEPARTMENT OF HIGHWAYS
 OLYMPIA, WASHINGTON

GEORGE D. ZANK, CHAIRMAN
 F. L. MITALSON
 H. WALSH
 BARRY THORNTON
 JOHN H. RUPP

APPROVED: December 7, 1967
 SHEET 242 OF 297 SHEETS
 CONTRACT NO. 8382

9/1996

FED. ROAD DIV. NO.	STATE	FED. AID PROJ. NO.	SHEET NO.	TOTAL SHEETS
8	WASH.	I-405-3(297)118	243	297

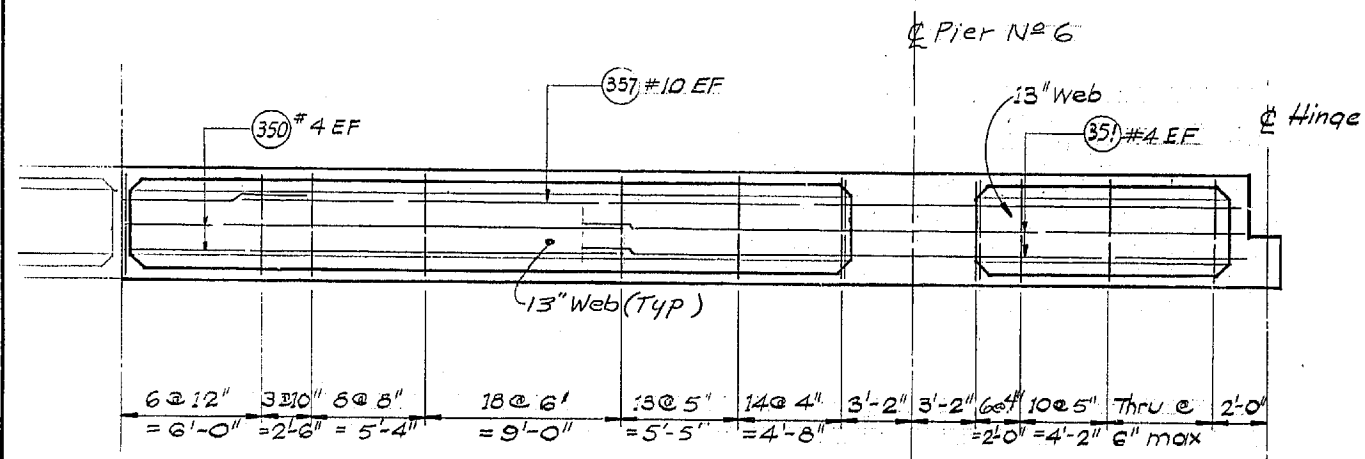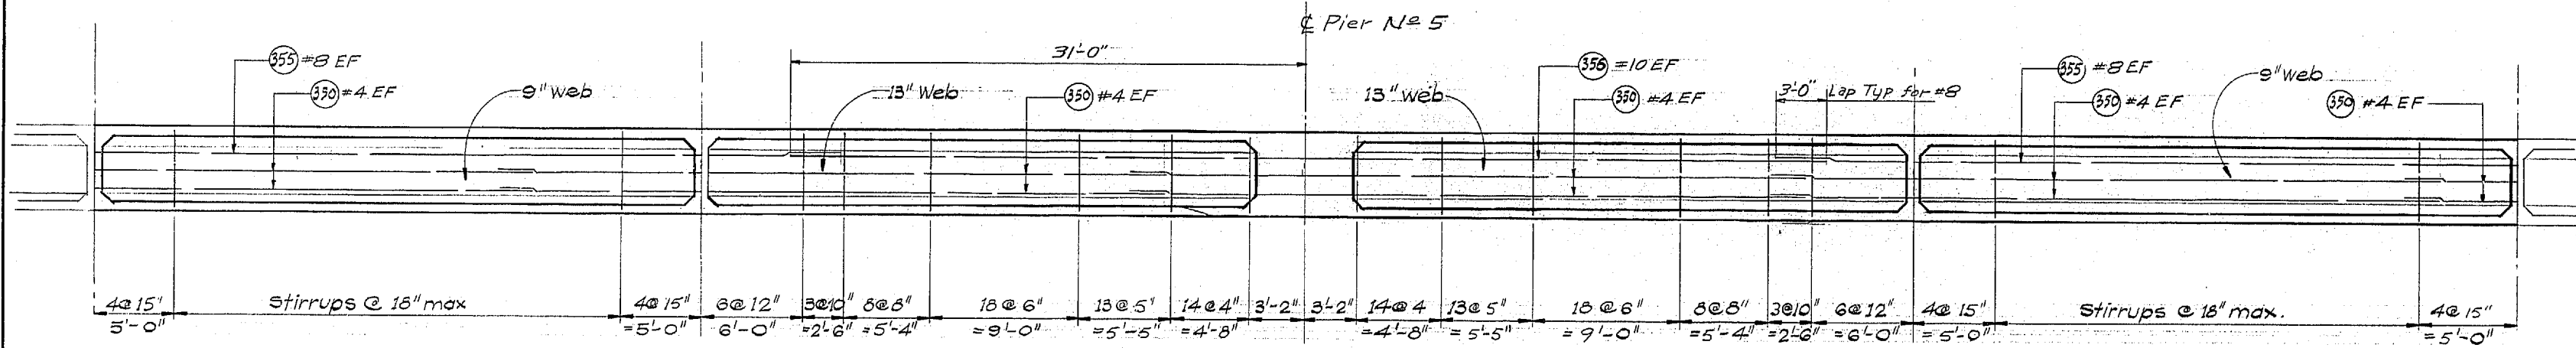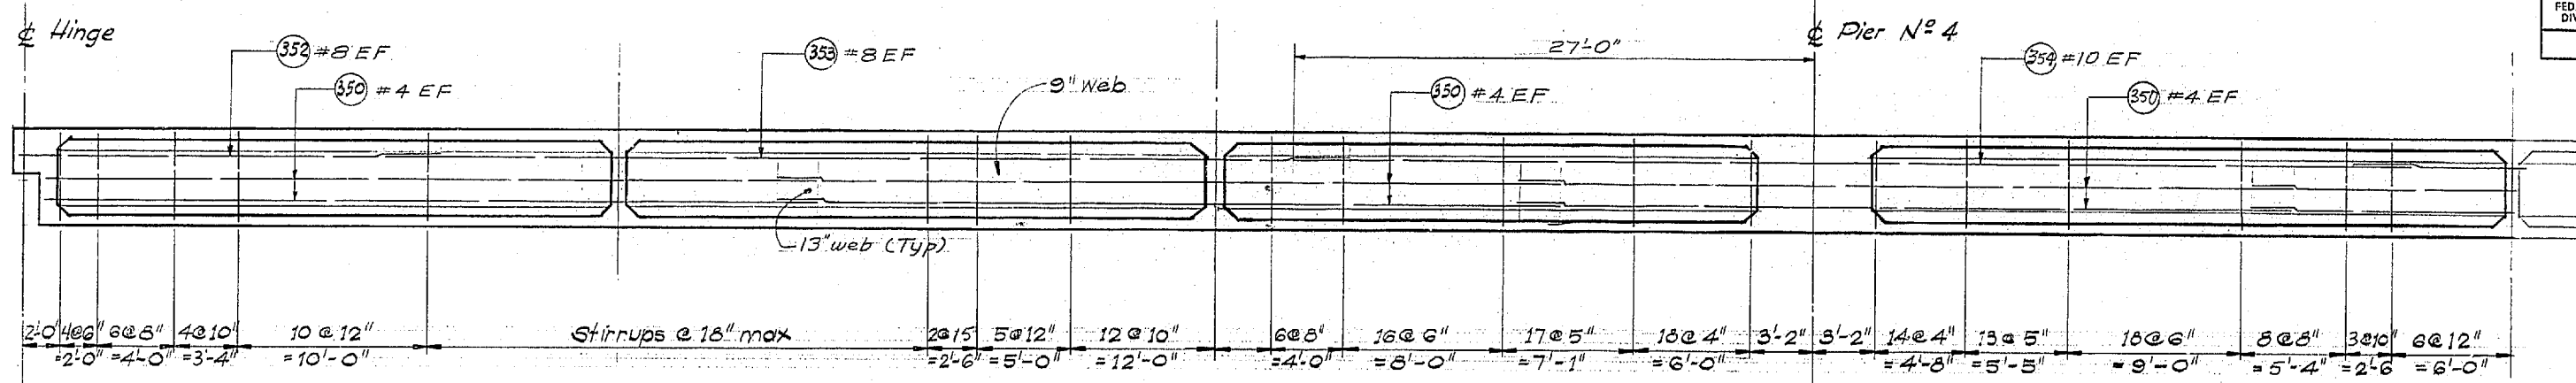

LONGITUDINAL SECTIONS

SR 405
MP 23.49 TO MP 23.76
WOODINVILLE INTERCHANGE
KING COUNTY
N-W&N-E STRUCTURE

LONGITUDINAL SECTIONS

WASHINGTON STATE HIGHWAY COMMISSION
DEPARTMENT OF HIGHWAYS
OLYMPIA, WASHINGTON

GEORGE D. ZANK, CHAIRMAN
E. L. MEYERSON
N. WALSH
BAKER FERGUSON
JOHN H. EUPP

APPROVED: December 7, 1967
SHEET 243 OF 297 SHEETS
BRIDGE ENGINEER

CONTRACT NO. 8382

DATE	REVISION	BY


WORTHINGTON, SKILLING HELLE & JACKSON
 Consulting Civil and Structural Engineers
 SEATTLE WASHINGTON

DESIGNED BY	
CHECKED BY	
DRAWN BY	
DATE	


DATE	
BY	
TRACED	
CHECKED	
DATE	

WOODINVILLE INTERCHANGE
FSH NO. 1-R/F/PSH NO. 2-BO
N-W STRUCTURE
LONGITUDINAL SECTIONS
SHEET 235 OF 297
11-16-67


9/1995

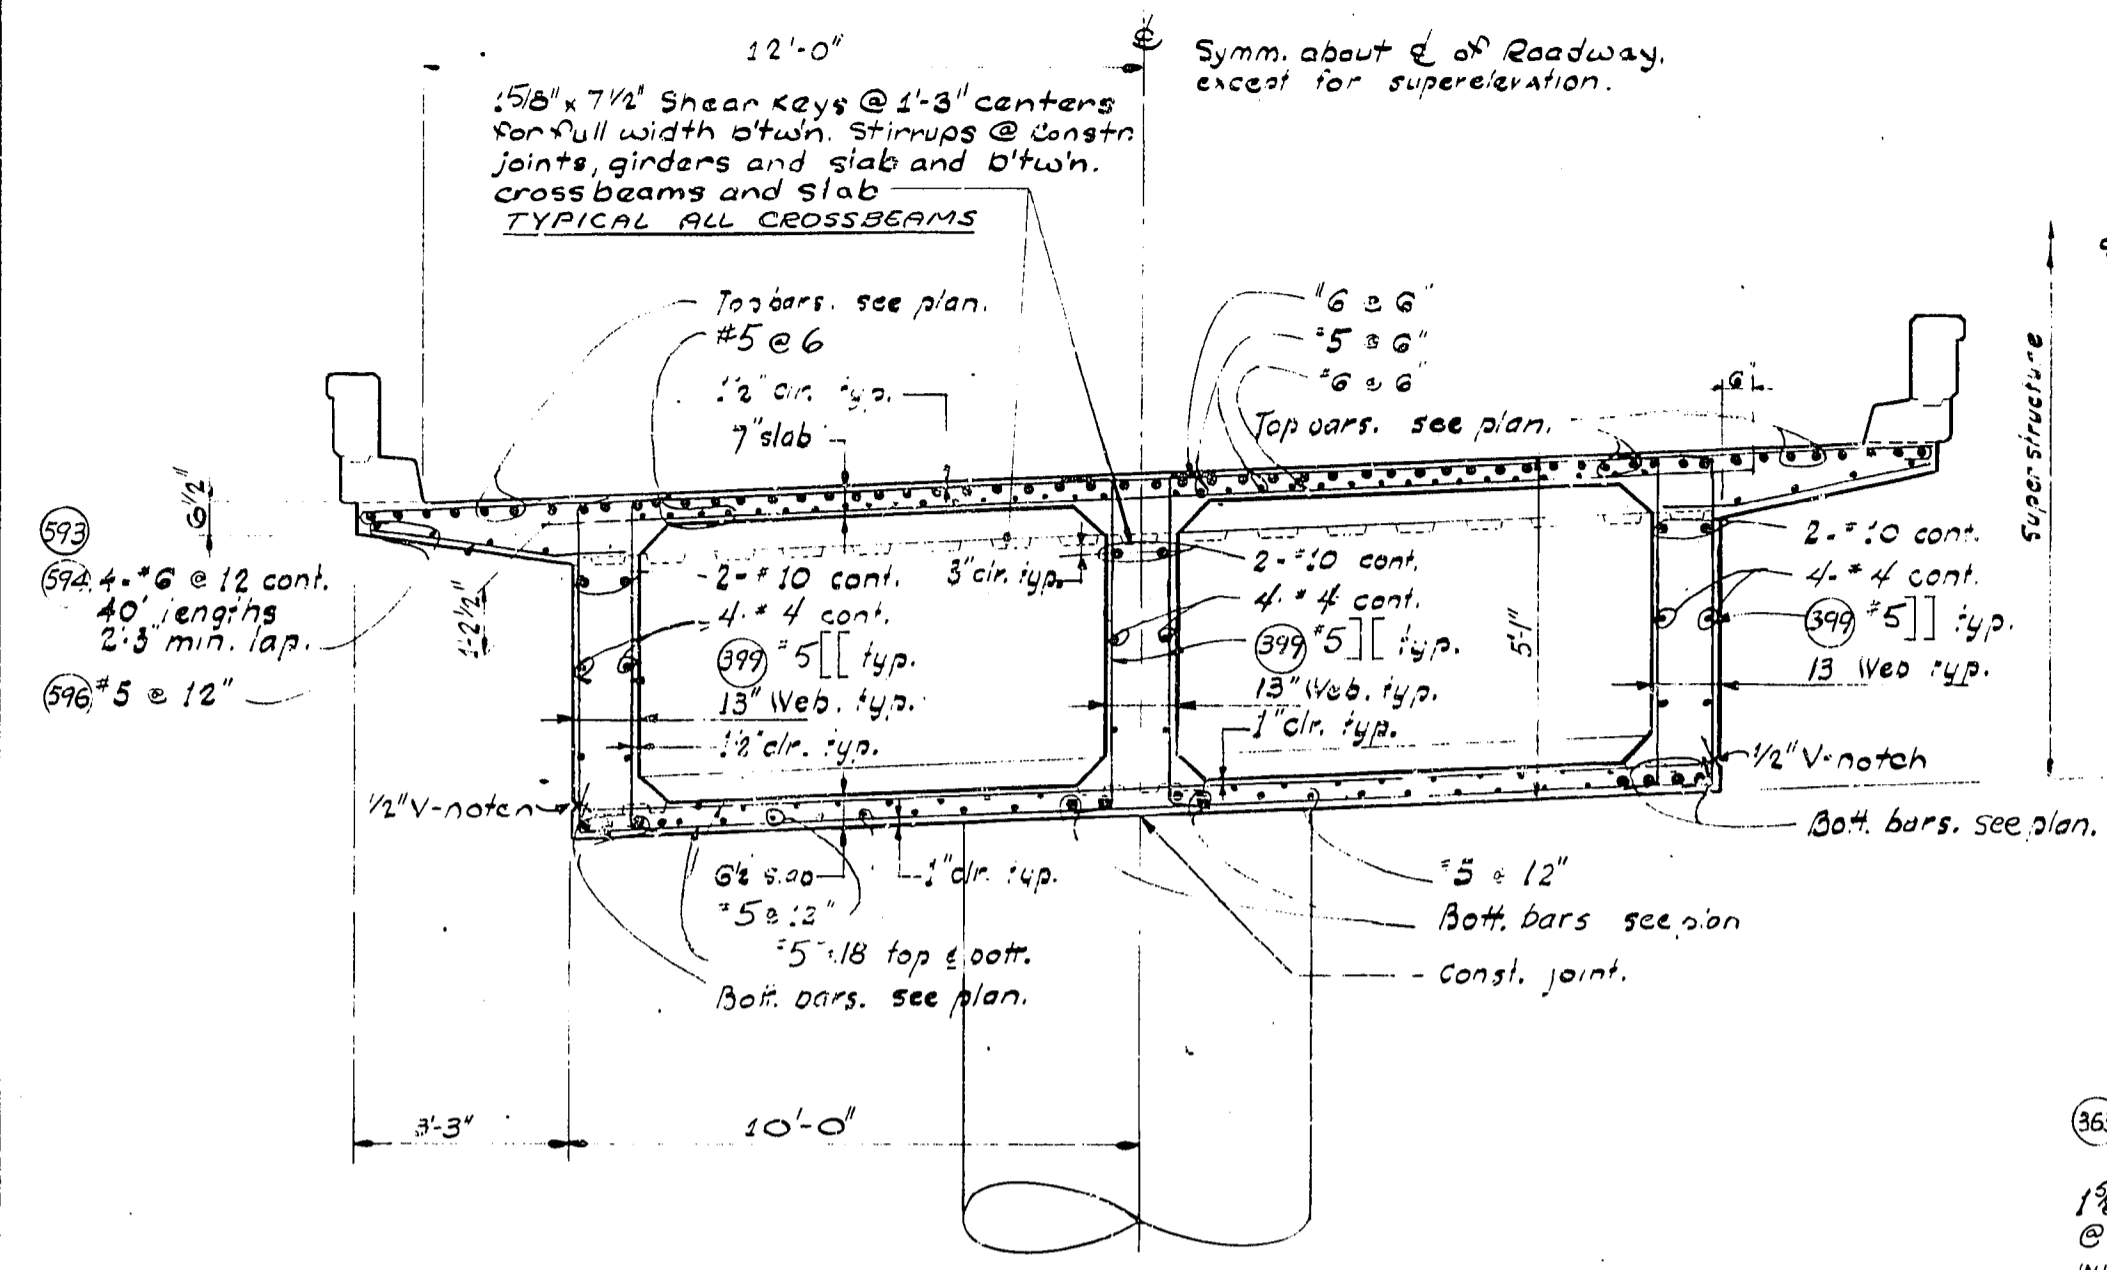


SECTION @ N-W PIERS 4 thru 6

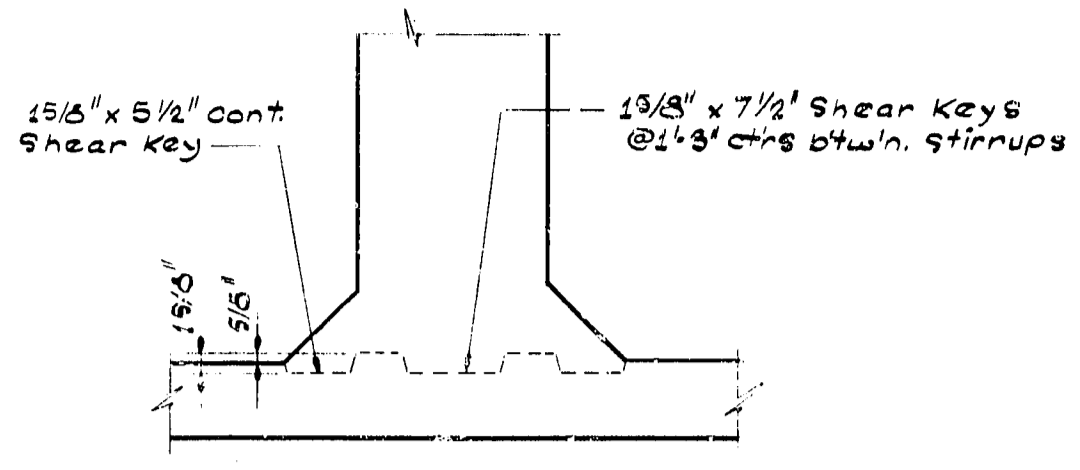


CONSTRUCTION JOINT AT BOTTOM SLAB

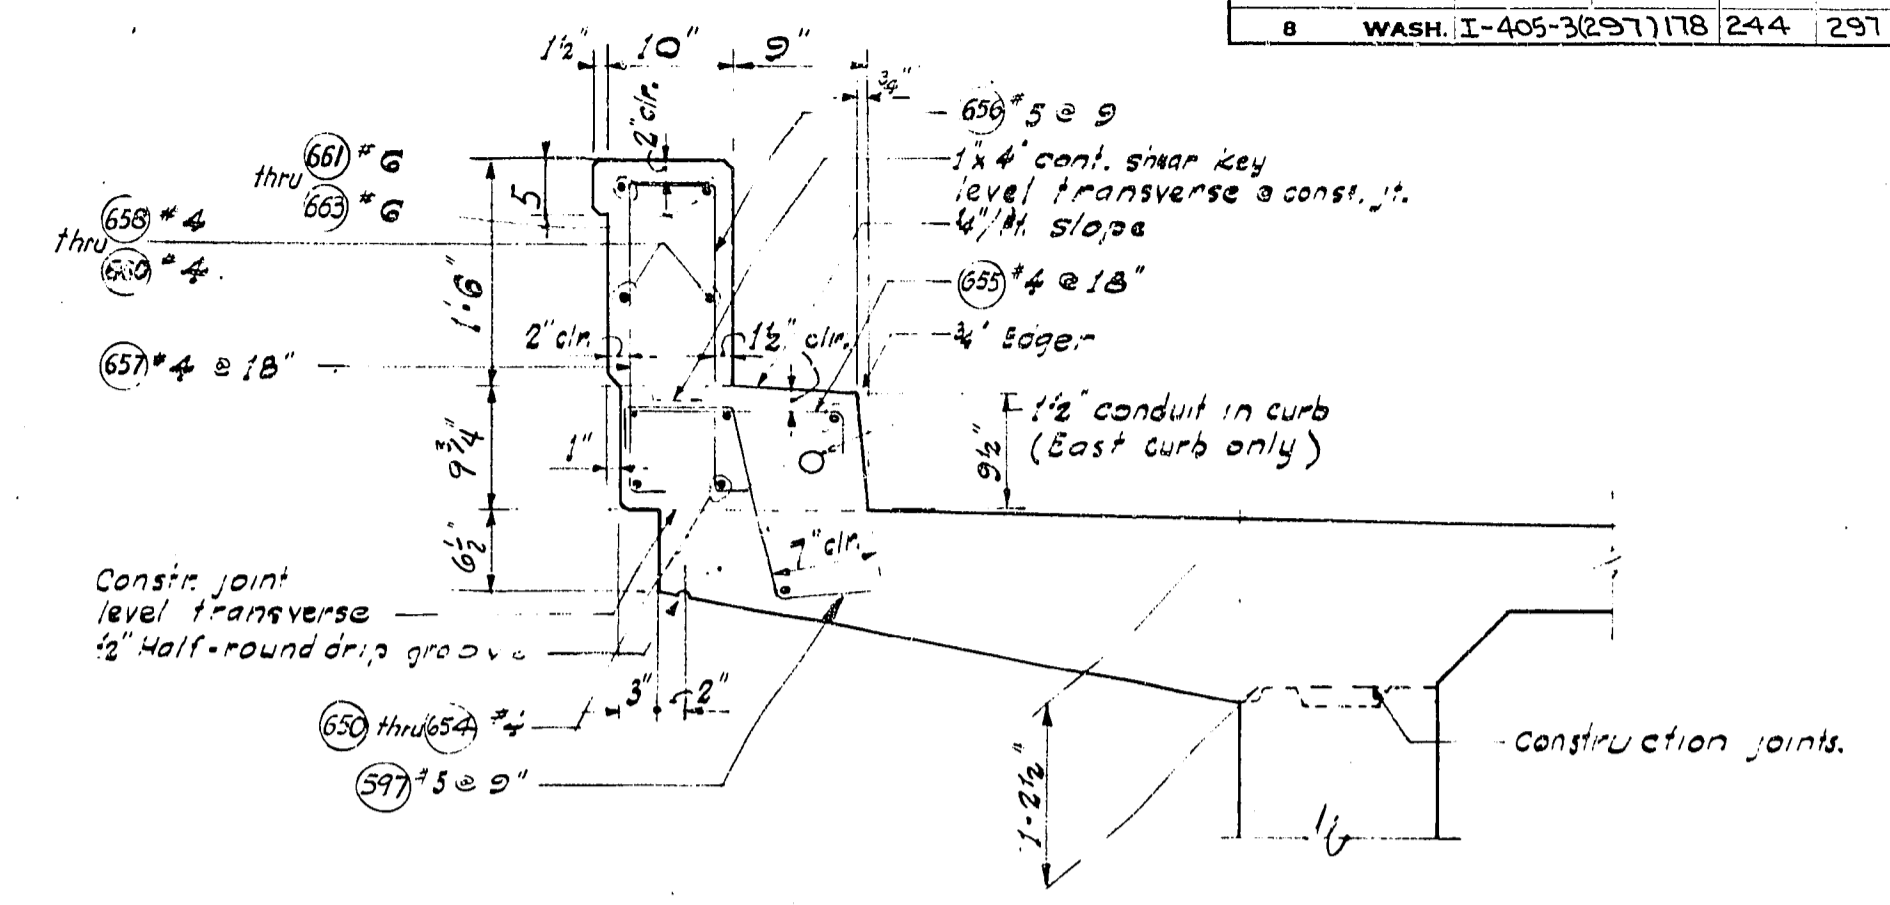


SECTION THRU CURB

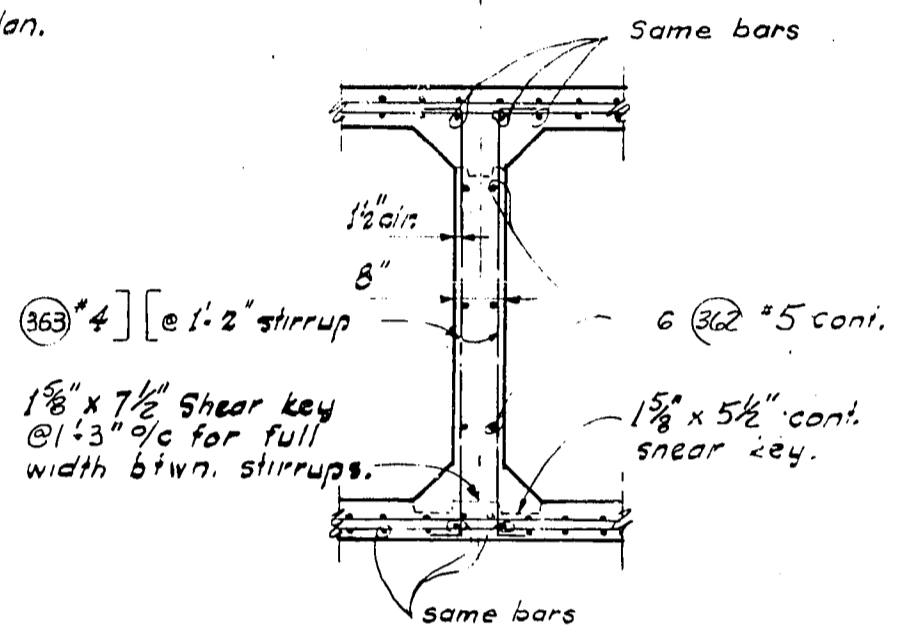


SECTION THRU DIAPHRAGM (TYPICAL ALL UNITS)

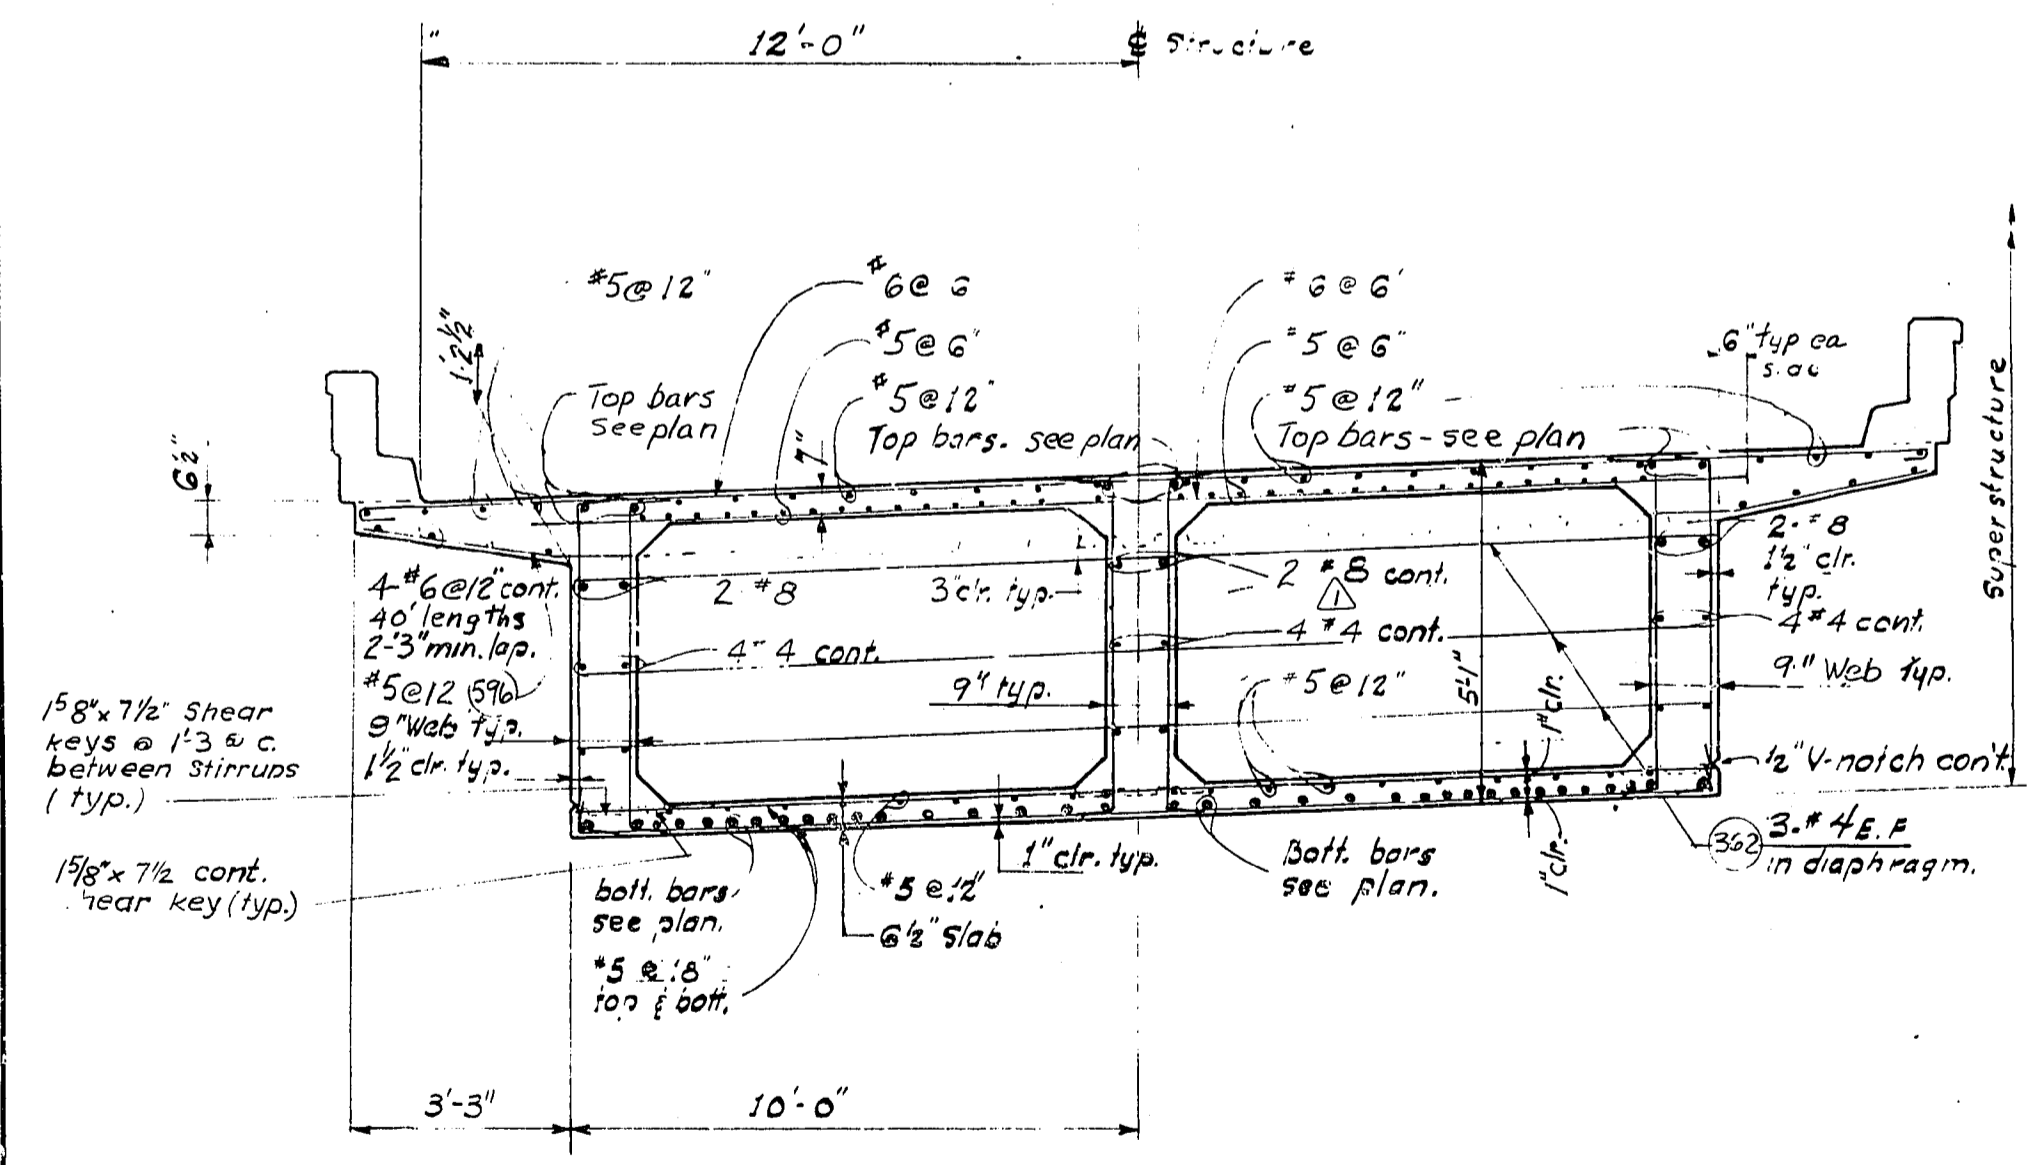

SECTION NEAR CENTER OF SPAN

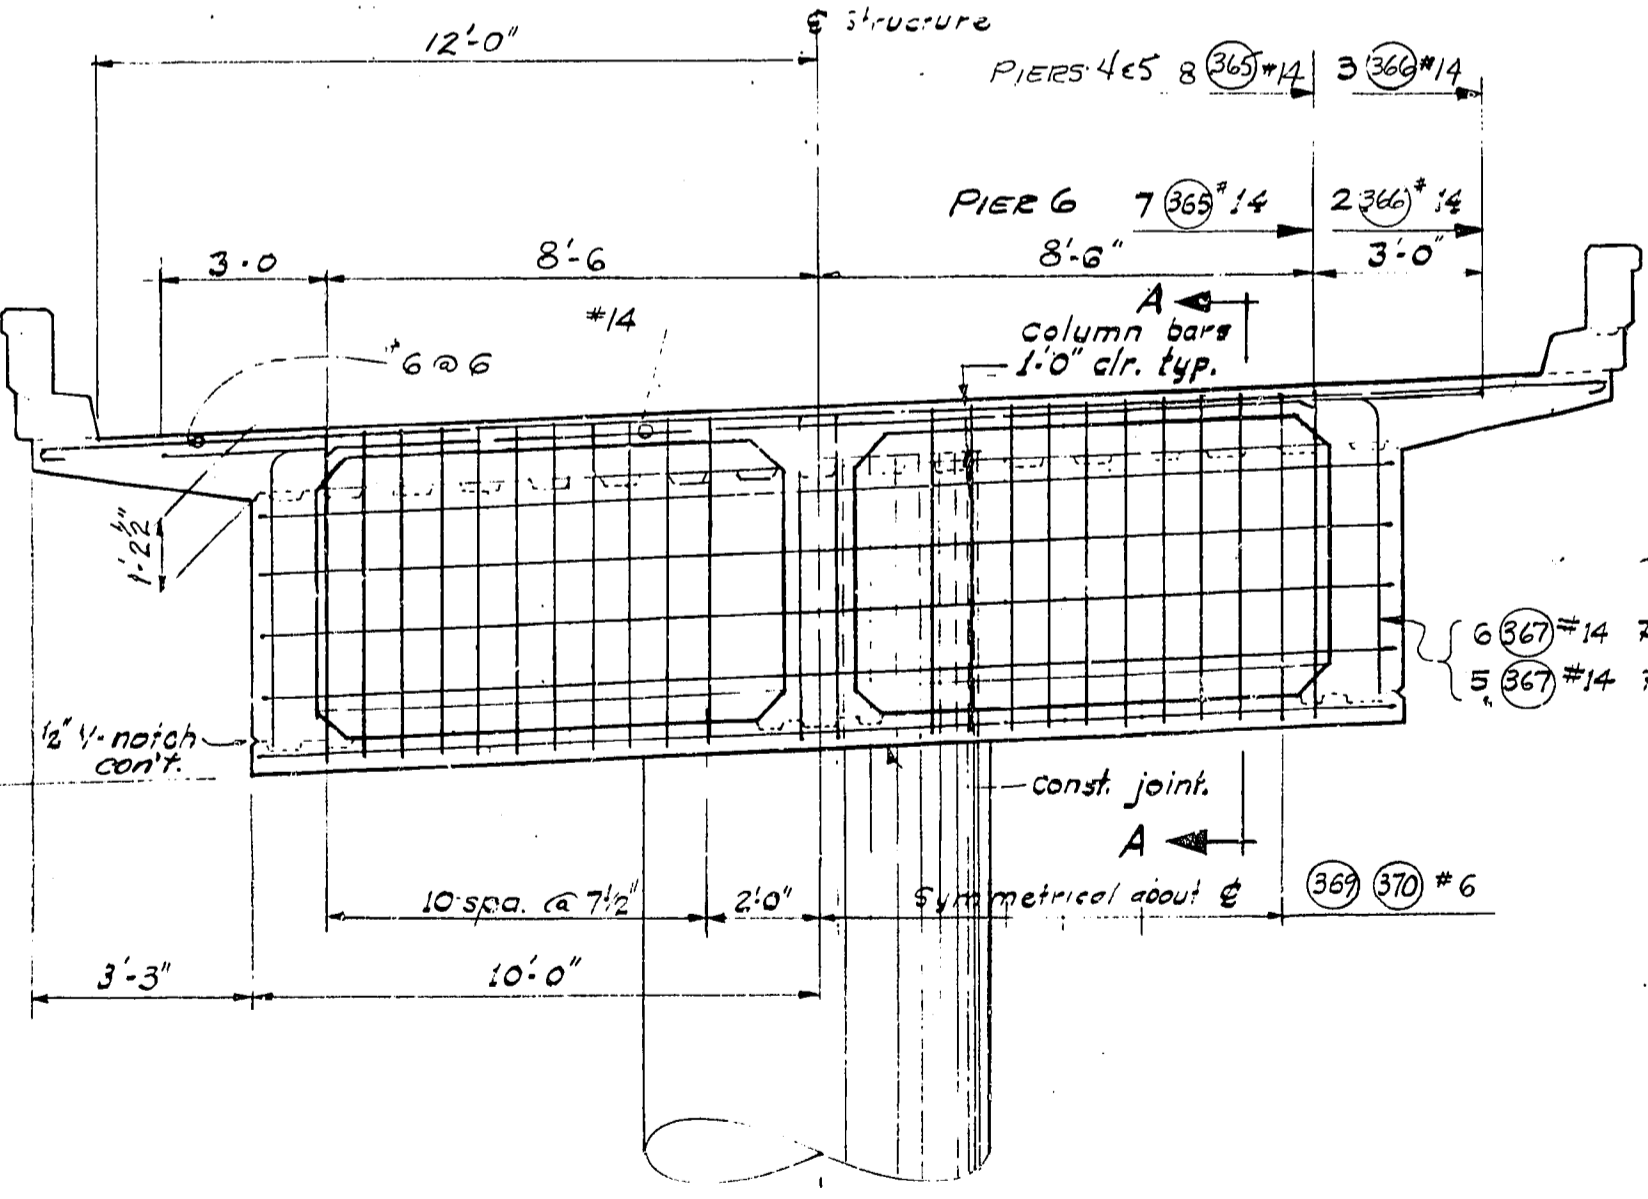

CROSS BEAM @ N-W PIER 4 thru 6

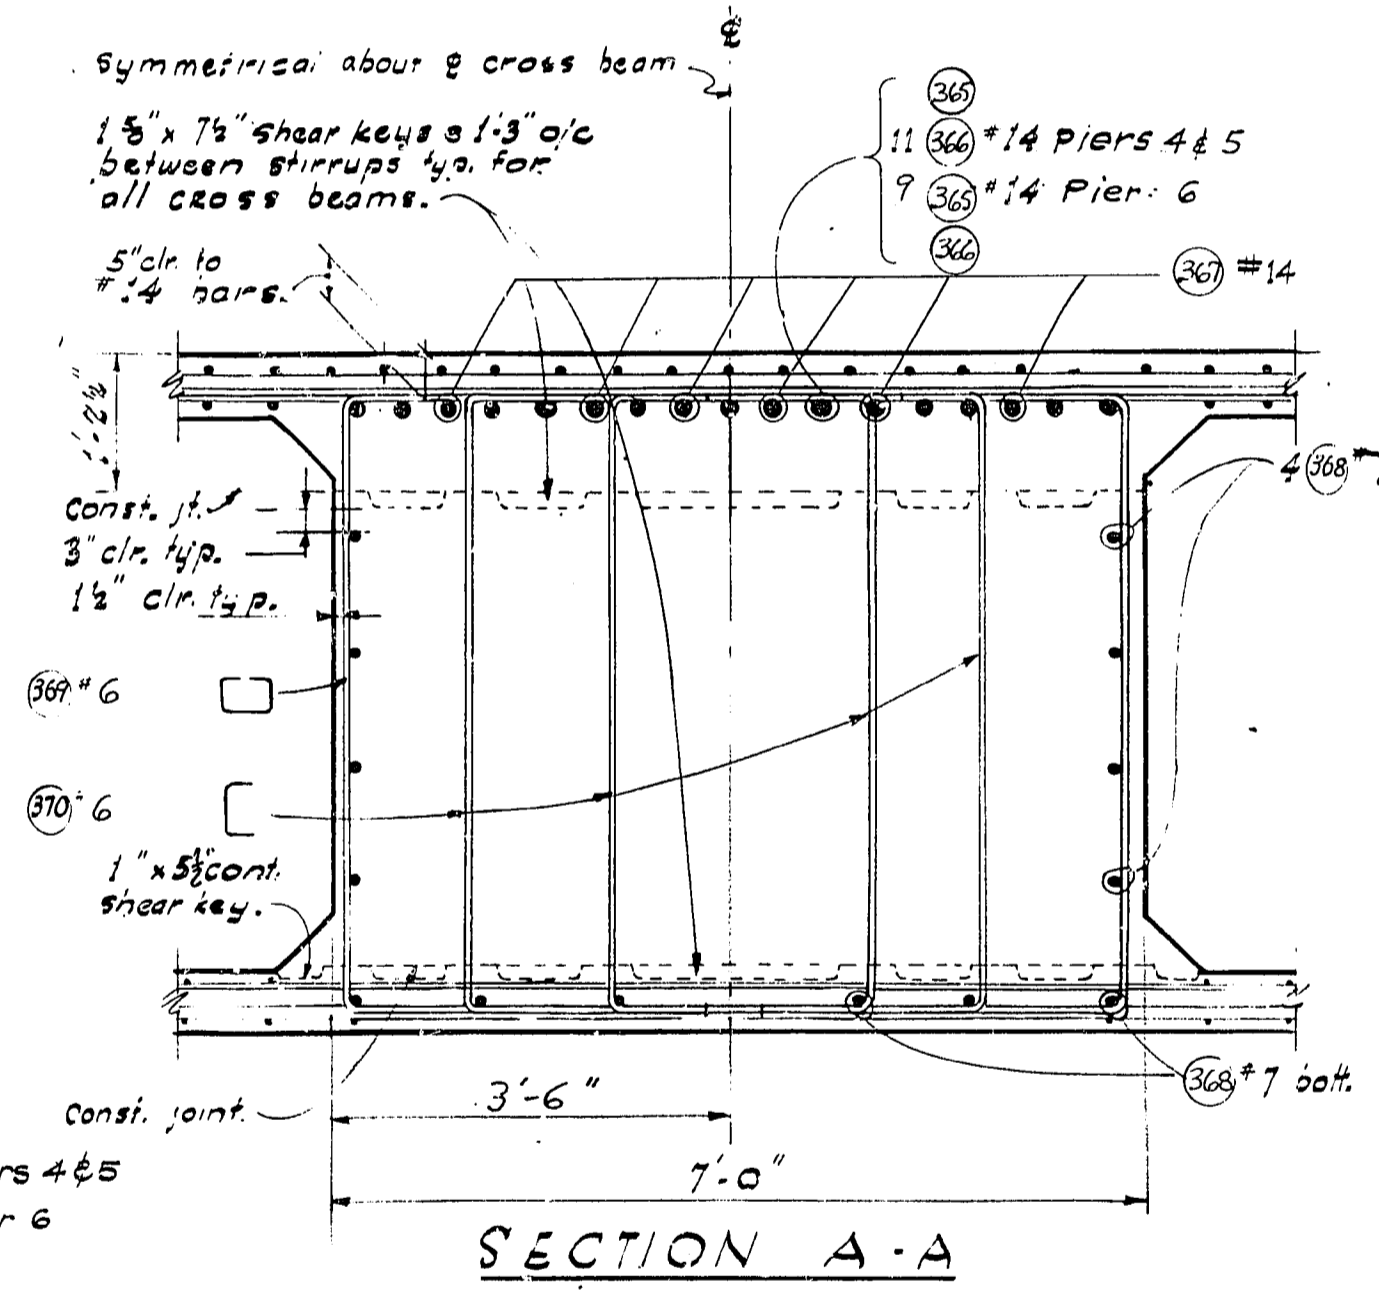

SECTION A-A

SR 405
MP 23.49 TO MP 23.76
WOODVILLE INTERCHANGE
KING COUNTY
N-W & N-E STRUCTURE
TRANSVERSE SECTIONS

WASHINGTON STATE HIGHWAY COMMISSION
DEPARTMENT OF HIGHWAYS
OLYMPIA, WASHINGTON

APPROVED December 7, 1967
SHEET 244 OF 297 SHEETS
CONTRACT NO. 8382

2-7-68 Revised Bar Size
DATE REVISION BY
**WORTHINGTON, SKILLING
HELLE & JACKSON**
Consulting Civil and Structural Engineers
SEATTLE WASHINGTON



DRAWING ENGINEER
DESIGN CHECKED
DRAWN BY
CHECKED
QUANTITIES FIGURED
QUANTITIES CHECKED

118
CROSS BEAMS

DATE
BY
CHECKED
TRACED
LOC. ENGR.
DIST. ENGR.

WOODVILLE INTERCHANGE
PSH NO. 1-RE/PSH NO. 2-DO
N-W STRUCTURE
TRANSVERSE SECTIONS
SHEET 244 OF 297 SHEETS
236 287
11-16-67

FED. ROAD DIV. NO.	STATE	FED. AID PROJ. NO.	SHEET NO.	TOTAL SHEETS
8	WASH.	I-405-3(297)178	245	297

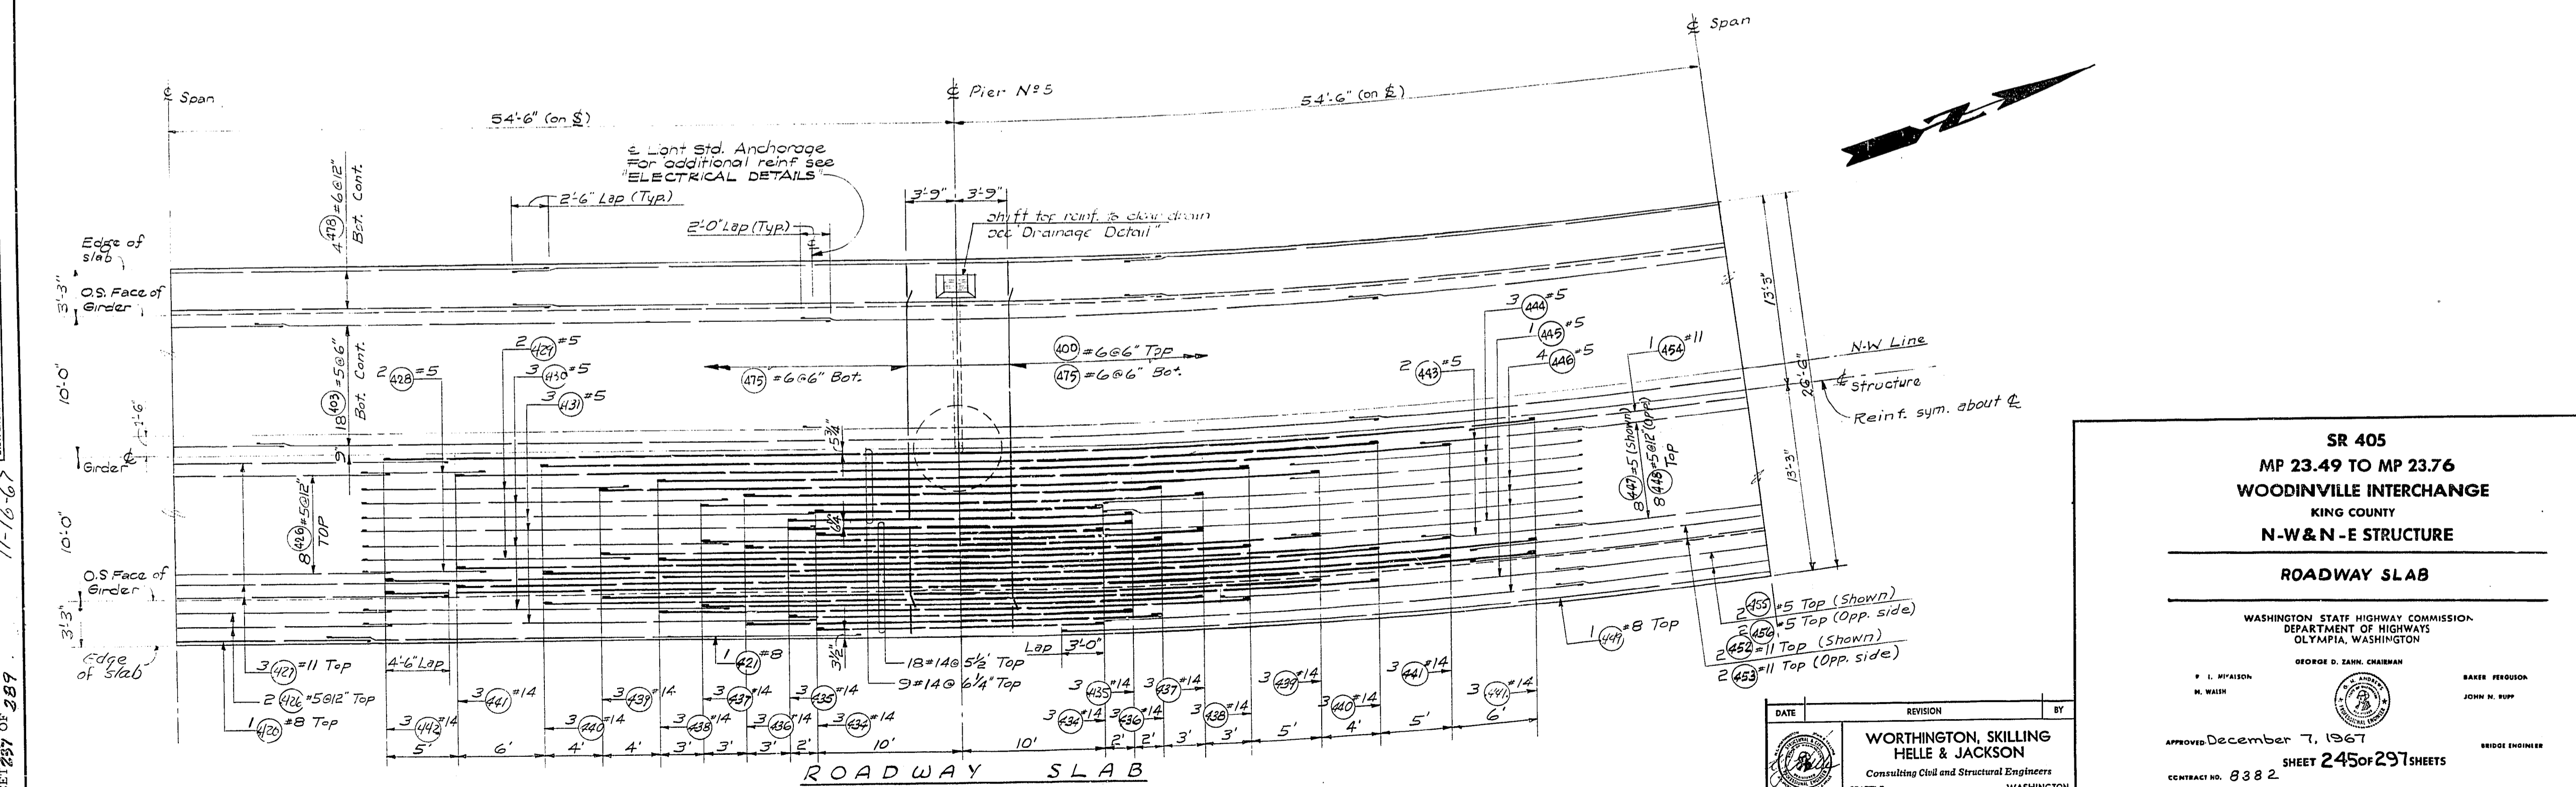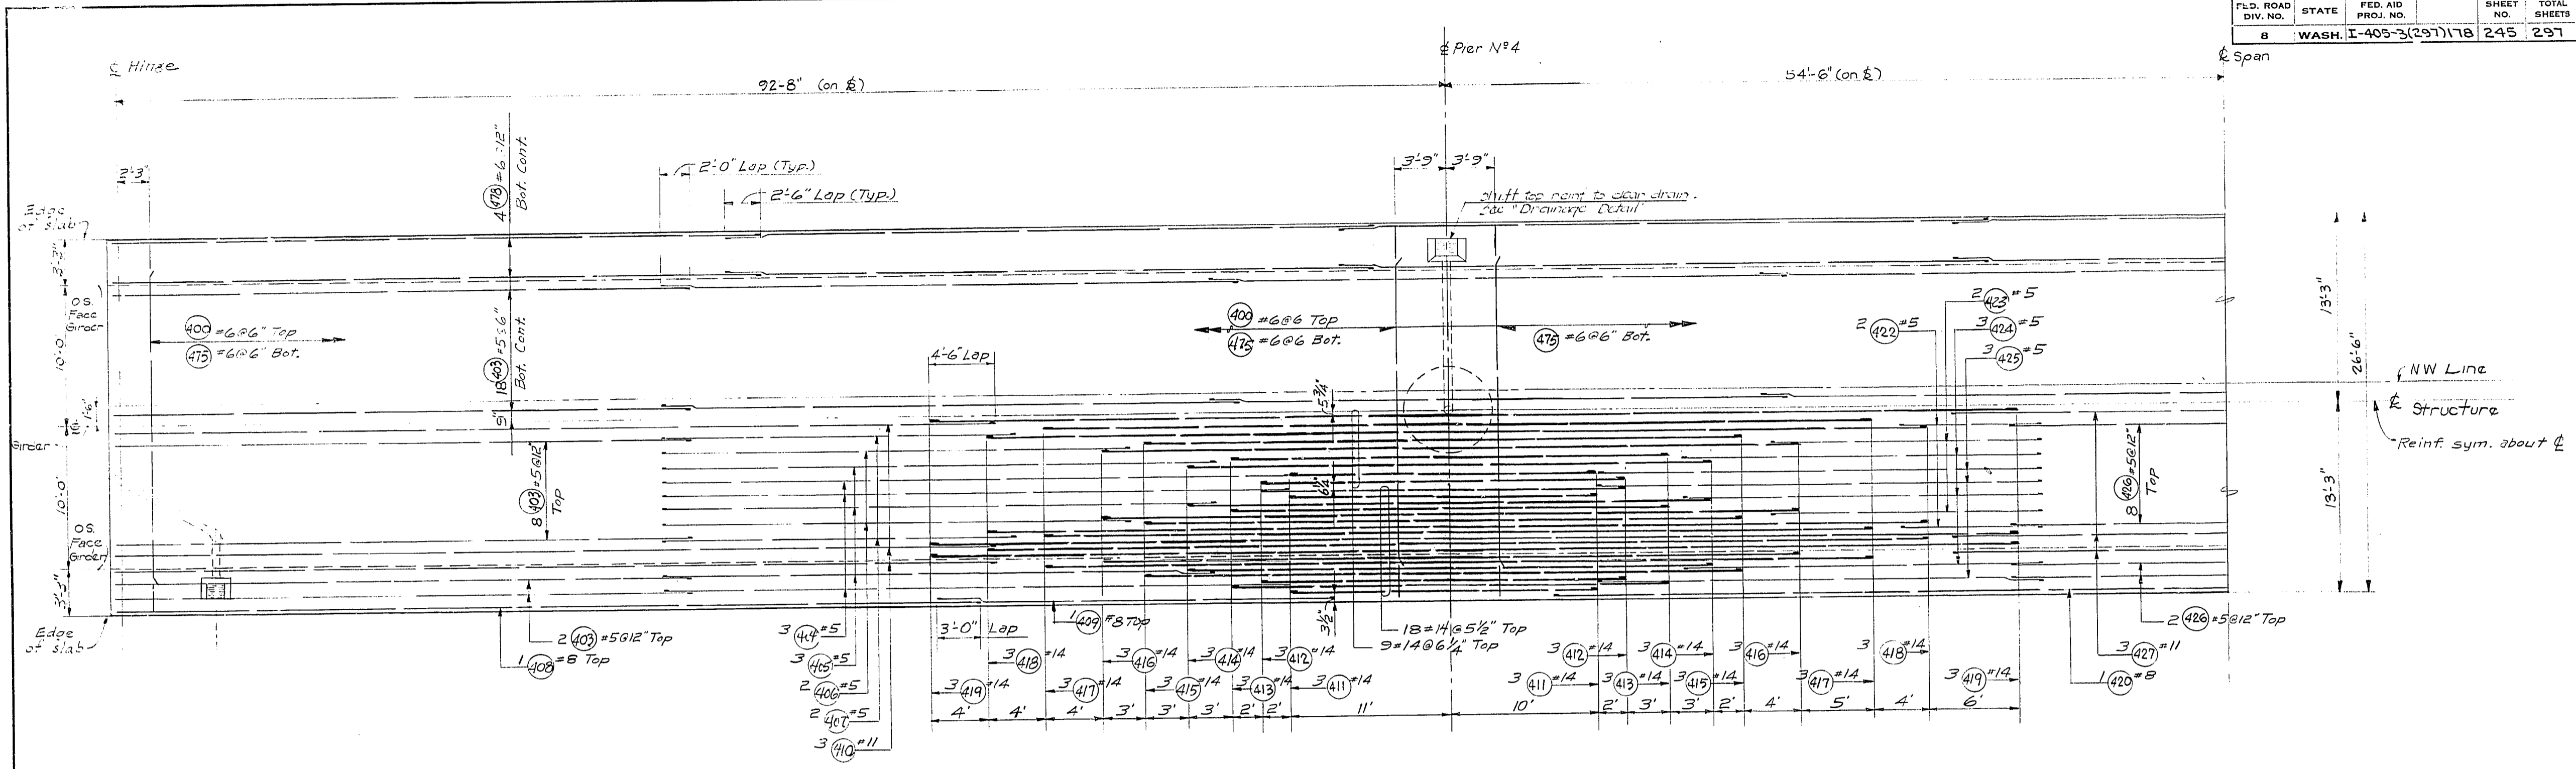

DESIGNED BY	
CHECKED BY	
DATE	
BY	
DATE	
BY	
DATE	
BY	
DATE	

DESIGNED BY	
CHECKED BY	
DATE	
BY	
DATE	
BY	
DATE	
BY	
DATE	

WOODVILLE INTERCHANGE
 PSH NO. 1-RE/PSH NO. 2-BO
 N-W STRUCTURE
 ROADWAY SLAB
 SHEET 245 OF 297
 11-16-67

SR 405
MP 23.49 TO MP 23.76
WOODVILLE INTERCHANGE
 KING COUNTY
N-W & N-E STRUCTURE

ROADWAY SLAB

WASHINGTON STATE HIGHWAY COMMISSION
 DEPARTMENT OF HIGHWAYS
 OLYMPIA, WASHINGTON

GEORGE D. ZAHN, CHAIRMAN

N. WAISH
 BAKER PEROUSS
 JOHN H. RUPP


APPROVED December 7, 1967
 SHEET 245 OF 297 SHEETS
 CONTRACT NO. 8382

BRIDGE ENGINEER

DATE	REVISION	BY

**WORTHINGTON, SKILLING
 HELLE & JACKSON**
 Consulting Civil and Structural Engineers
 SEATTLE WASHINGTON

P/1995

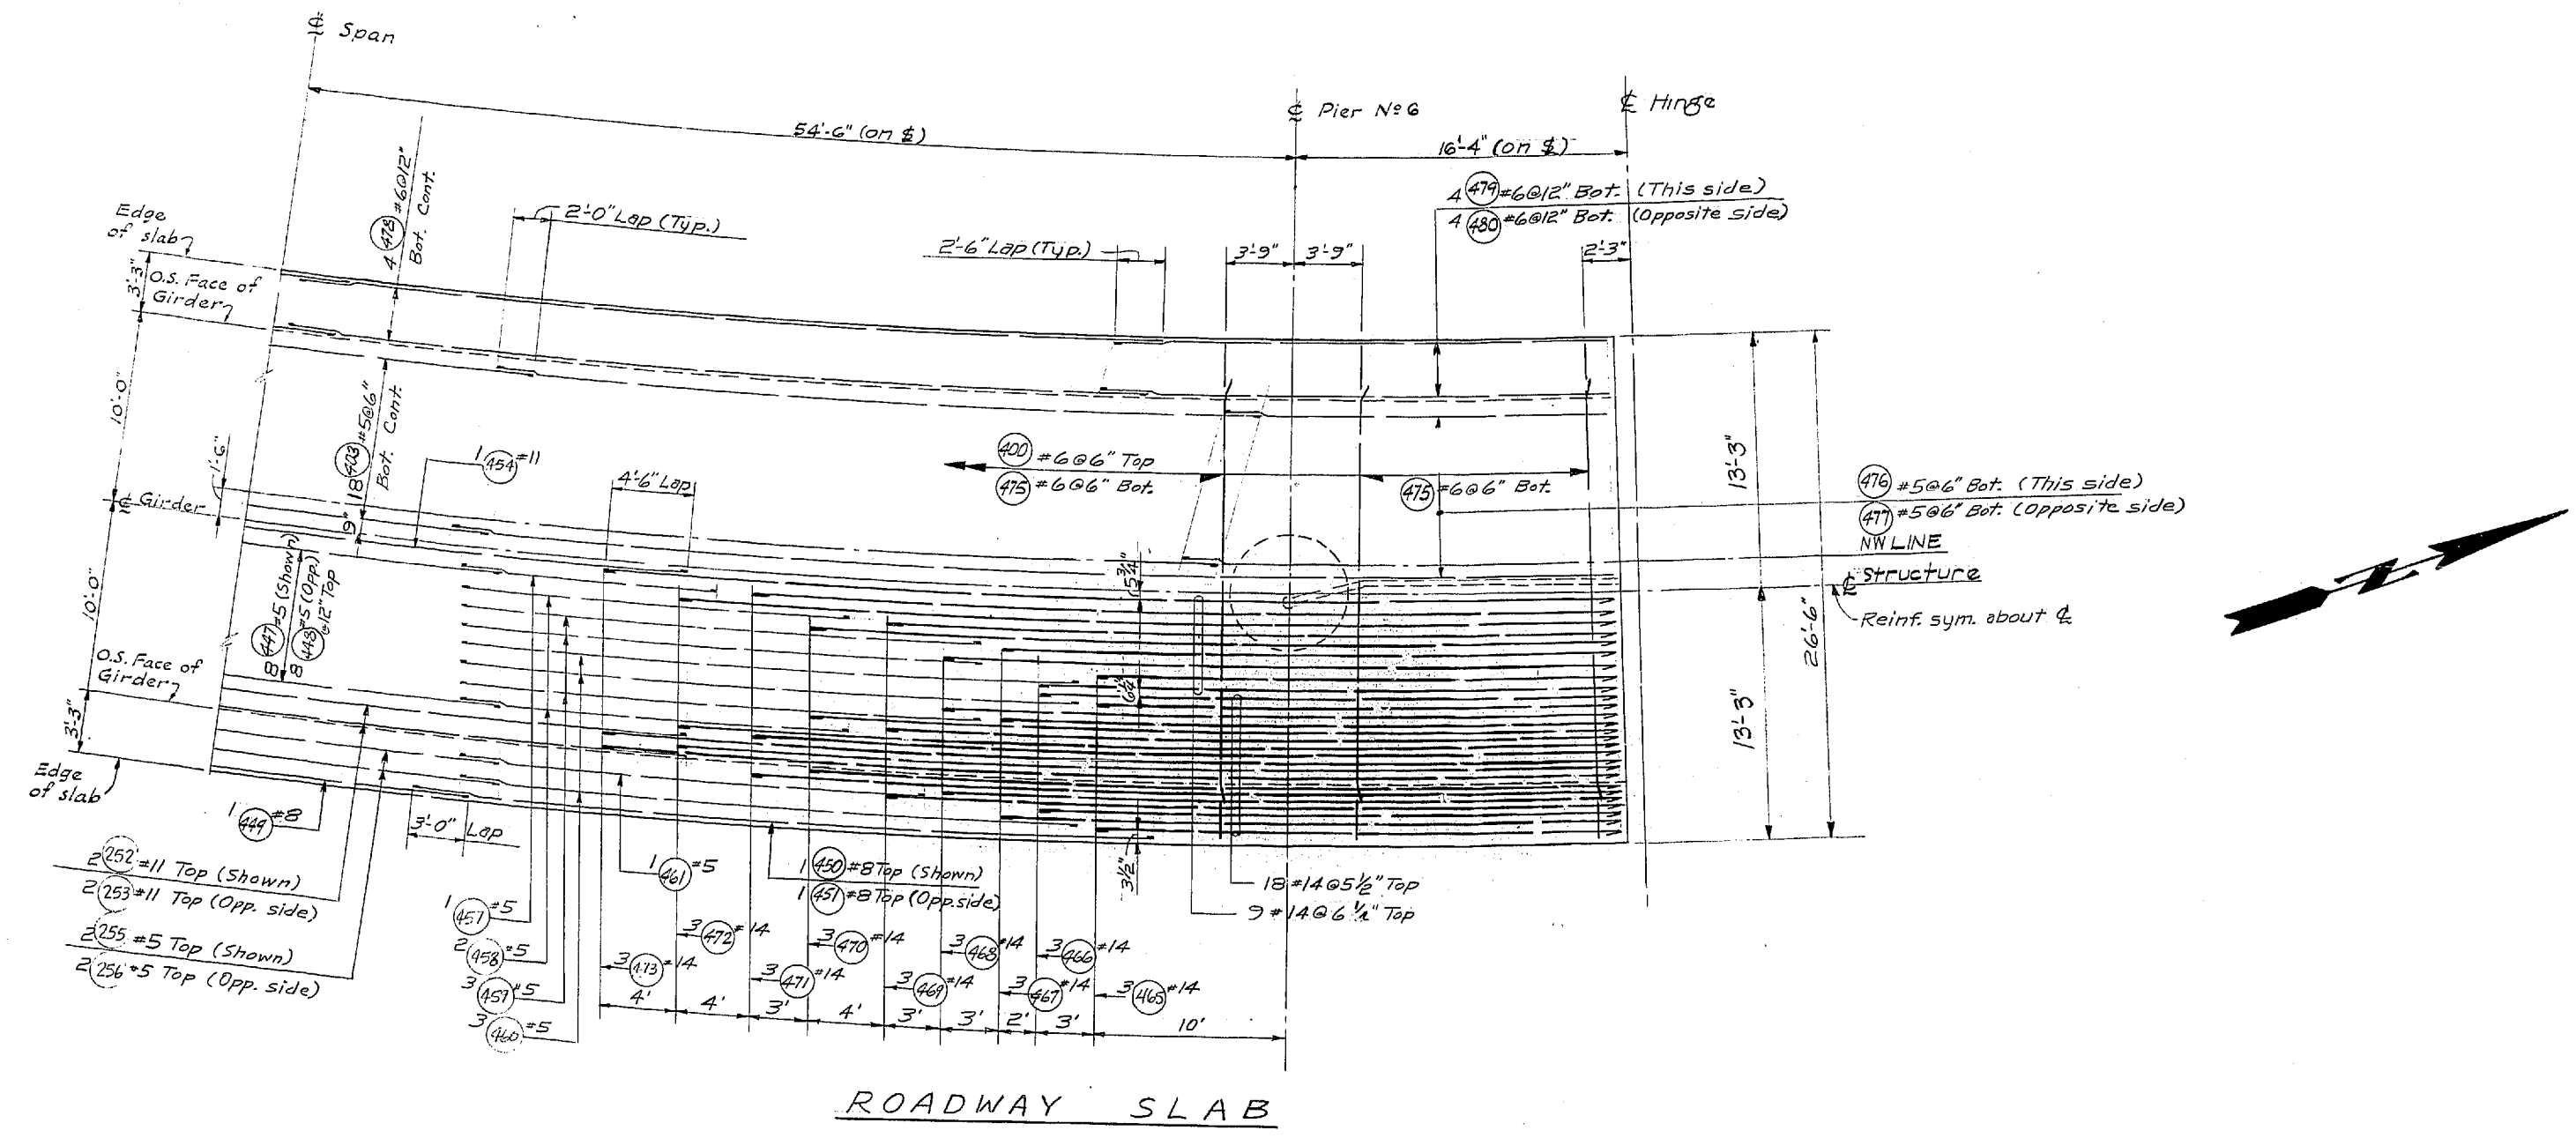

DESIGNED	BY
CHECKED	BY
QUANTITIES FIGURED	BY
QUANTITIES CHECKED	BY

DATE	BY

WOODVILLE INTERCHANGE
 PSH NO. 1-RE/PSH NO. 2-BO
 N-W STRUCTURE
 ROADWAY SLAB
 SHEET 246 OF 297
 11-16-67



SR 405
 MP 23.49 TO MP 23.76
 WOODVILLE INTERCHANGE
 KING COUNTY
 N-W&N-E STRUCTURE

ROADWAY SLAB

WASHINGTON STATE HIGHWAY COMMISSION
 DEPARTMENT OF HIGHWAYS
 OLYMPIA, WASHINGTON

GEORGE D. ZANK, CHAIRMAN
 P. L. MIVALEN, H. WALSH, BAKER FERGUSON, JOHN N. RUPP

APPROVED December 7, 1967



SHEET 246 OF 297 SHEETS

CONTRACT NO. 8382

DATE	REVISION	BY
 WORTHINGTON, SKILLING HELLE & JACKSON Consulting Civil and Structural Engineers SEATTLE WASHINGTON		

P/1990

FED. ROAD DIV. NO.	STATE	FED. AID PROJ. NO.	SHEET NO.	TOTAL SHEETS
B	WASH.	I-405-3(291)118	247	291

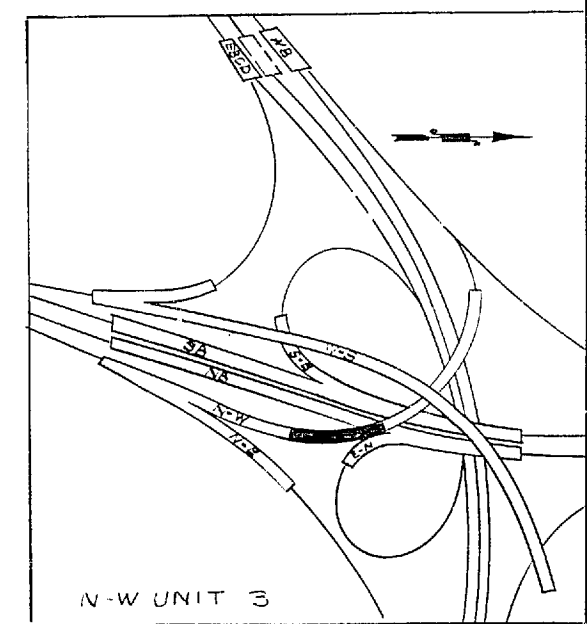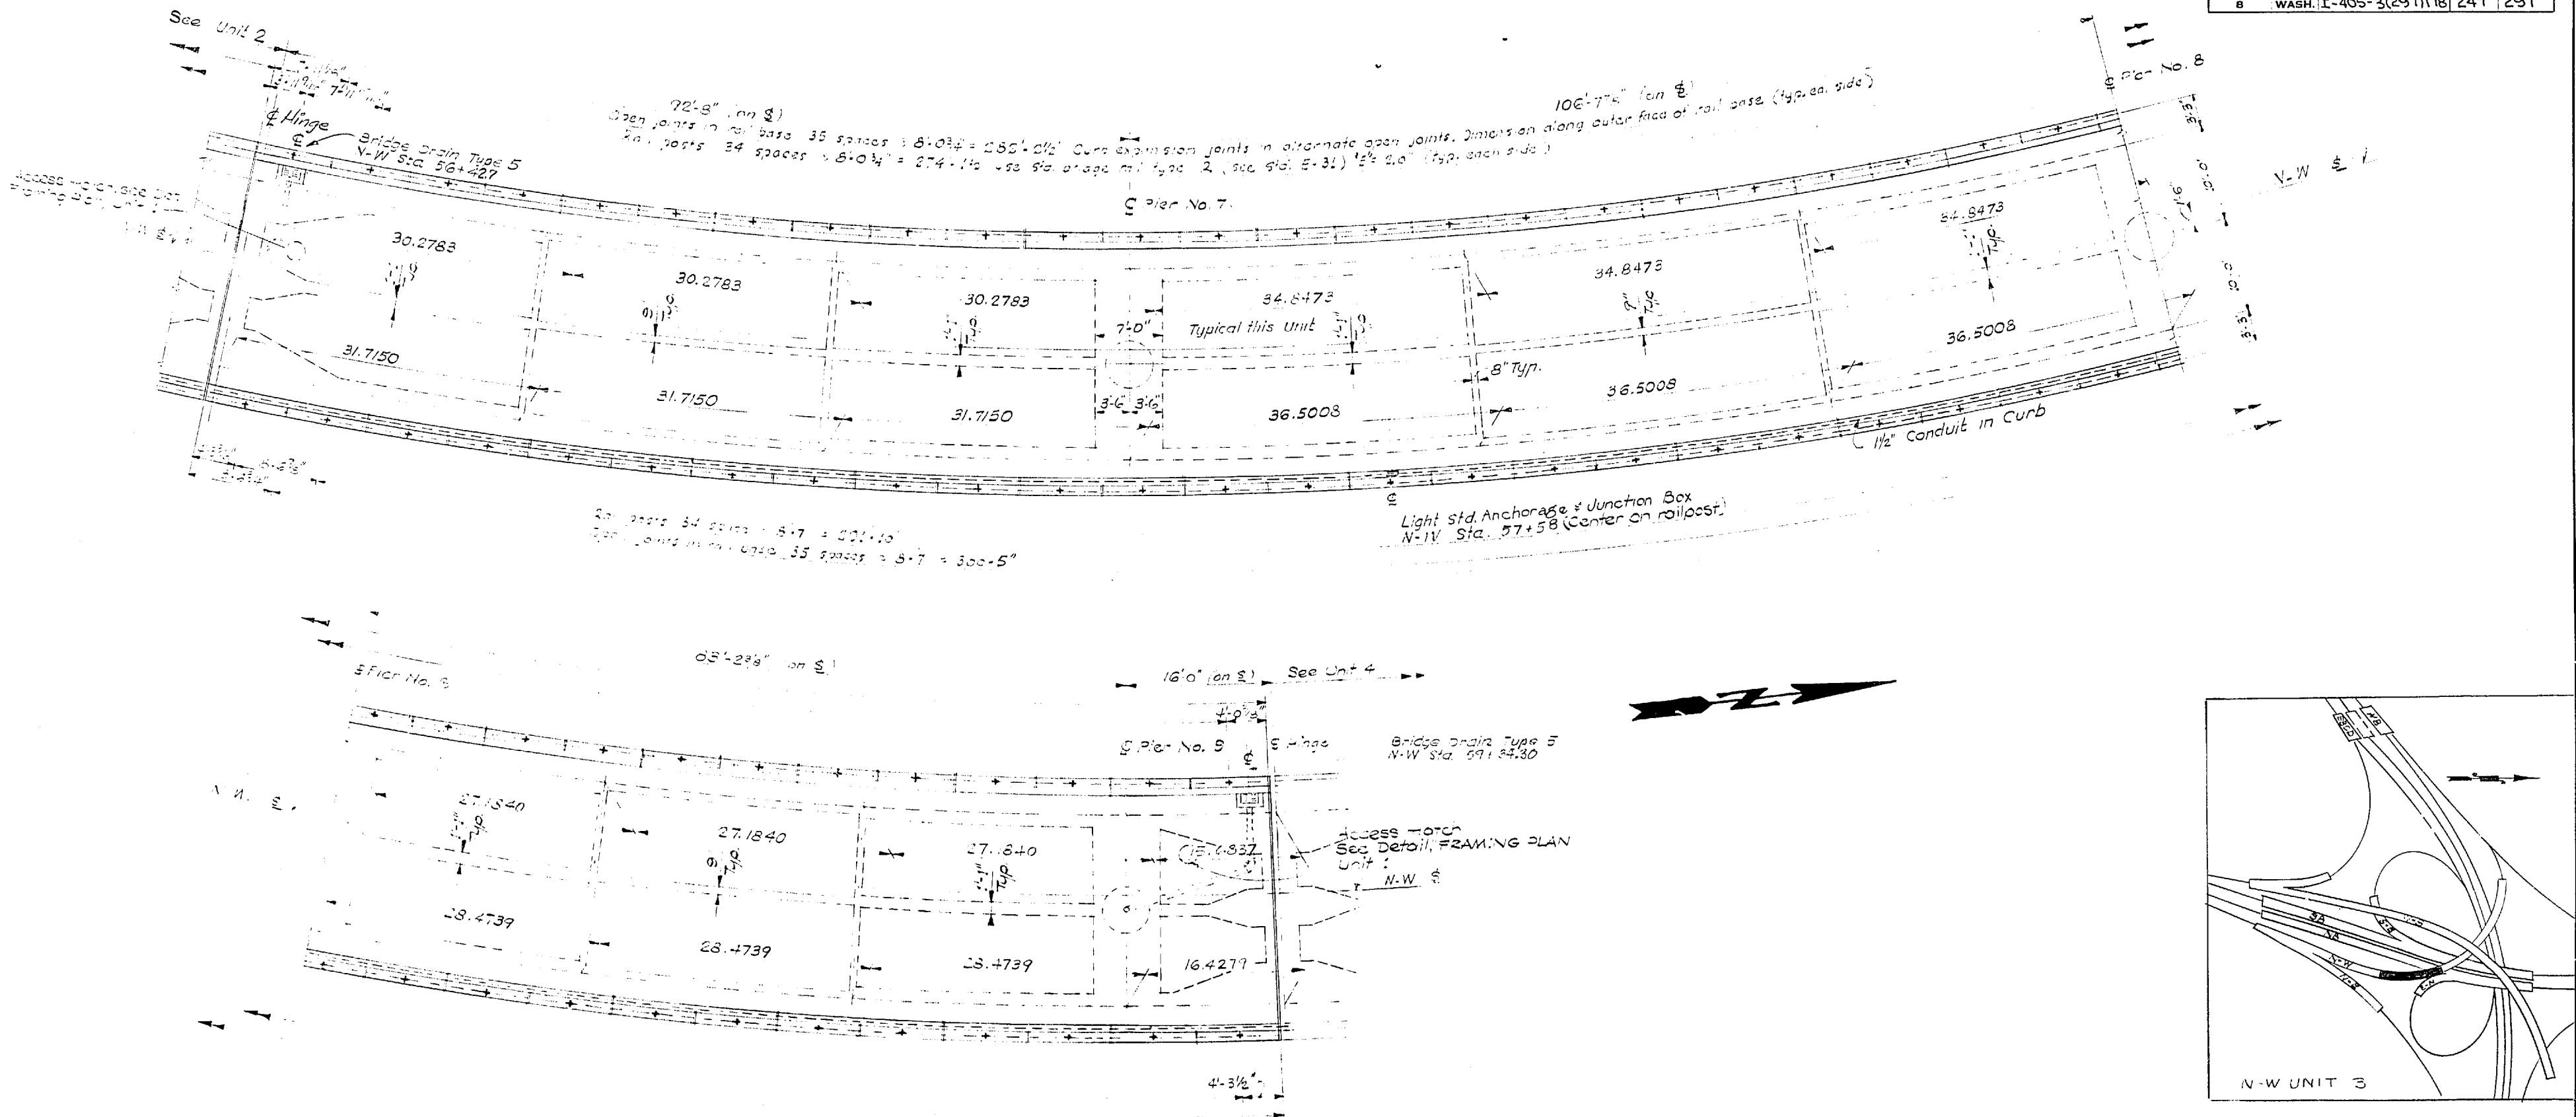

FRAMING PLAN

See Unit 1 Framing Plan for General Notes.

SR 405
MP 23.49 TO MP 23.76
WOODINVILLE INTERCHANGE
KING COUNTY
N-W & N-E STRUCTURE

FRAMING PLAN

WASHINGTON STATE HIGHWAY COMMISSION
DEPARTMENT OF HIGHWAYS
OLYMPIA, WASHINGTON

GEORGE D. ZAHN, CHAIRMAN
F. L. HAYSON
N. WALSH
BAKER FERGUSON
JOHN M. RUPP

APPROVED December 7, 1967
SHEET 247 OF 291 SHEETS
CONTRACT NO. 8382

DATE	REVISION	BY

WORTHINGTON, SKILLING
HELLE & JACKSON
Consulting Civil and Structural Engineers
SEATTLE WASHINGTON

DESIGNED BY
CHECKED BY
DRAWN BY
QUANTITIES FIGURED
QUANTITIES CHECKED

DATE
BY
CHECKED BY
DRAWN BY
QUANTITIES FIGURED
QUANTITIES CHECKED


WOODINVILLE INTERCHANGE
PSH NO. 1-RE/PSH NO. 2-BO
STRUCTURE
SHEET OF

P/1795

FED. ROAD DIV. NO.	STATE	FED. AID PROJ. NO.	SHEET NO.	TOTAL SHEETS
8	WASH.	I-405-3(297)118	248	297

DESIGNED BY	DATE
CHECKED BY	
QUANTITIES CHECKED	

DATE	
BY	
CHECKED	
LOC. ENGR.	
DIRT. ENGR.	

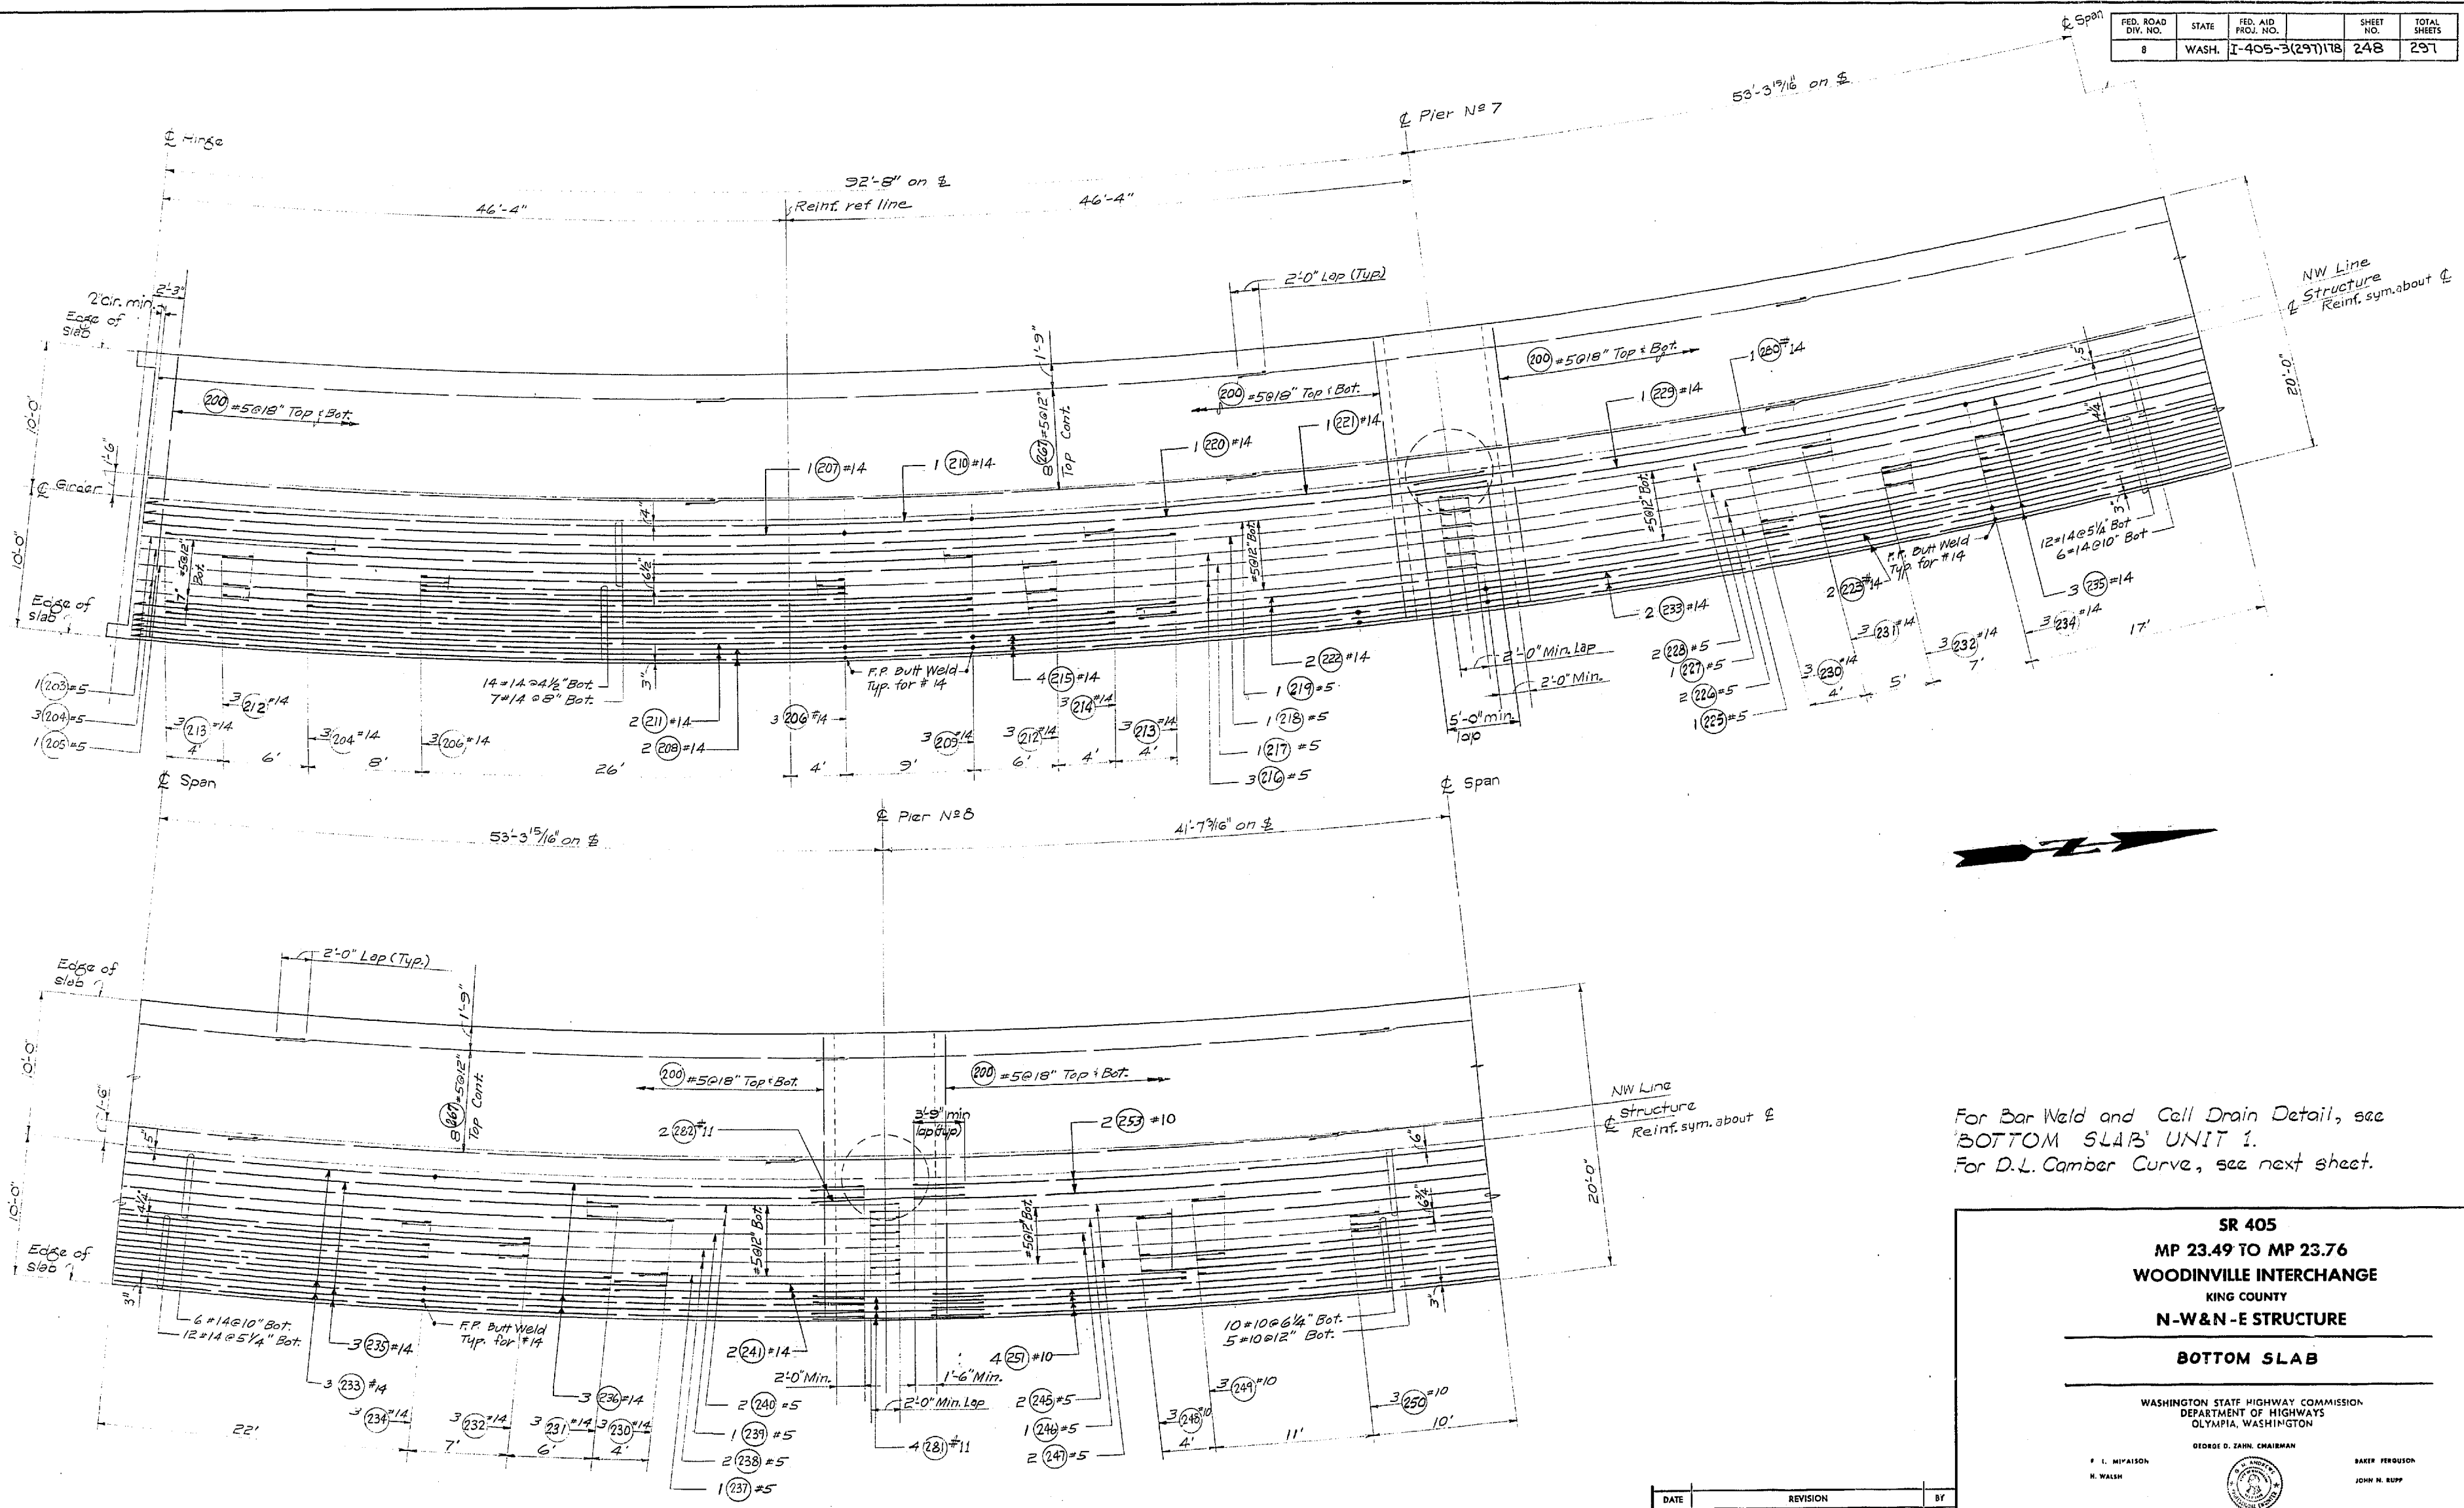

For Bar Weld and Cell Drain Detail, see BOTTOM SLAB UNIT 1.
For D.L. Camber Curve, see next sheet.

BOTTOM SLAB

DATE	REVISION	BY

WORTHINGTON, SKILLING HELLE & JACKSON
Consulting Civil and Structural Engineers
SEATTLE WASHINGTON

SR 405
MP 23.49 TO MP 23.76
WOODVILLE INTERCHANGE
KING COUNTY
N-W & N-E STRUCTURE
BOTTOM SLAB

WASHINGTON STATE HIGHWAY COMMISSION
DEPARTMENT OF HIGHWAYS
OLYMPIA, WASHINGTON

GEORGE D. ZAHL, CHAIRMAN
F. L. M'PATION, H. WALSH
BAKER PERGUSON, JOHN H. RUPP
BRIDGE ENGINEER


APPROVED December 7, 1967
SHEET 248 OF 297 SHEETS
CONTRACT NO. 8382

11-16-67


WOODVILLE INTERCHANGE
PSH NO. 1-RE/PSH NO. 2-BO
N-W STRUCTURE
BOTTOM SLAB
SHEET 248 OF 297

P/1995

FED. ROAD DIV. NO.	STATE	FED. AID PROJ. NO.	SHEET NO.	TOTAL SHEETS
8	WASH.	I-405-3(291)118	249	297

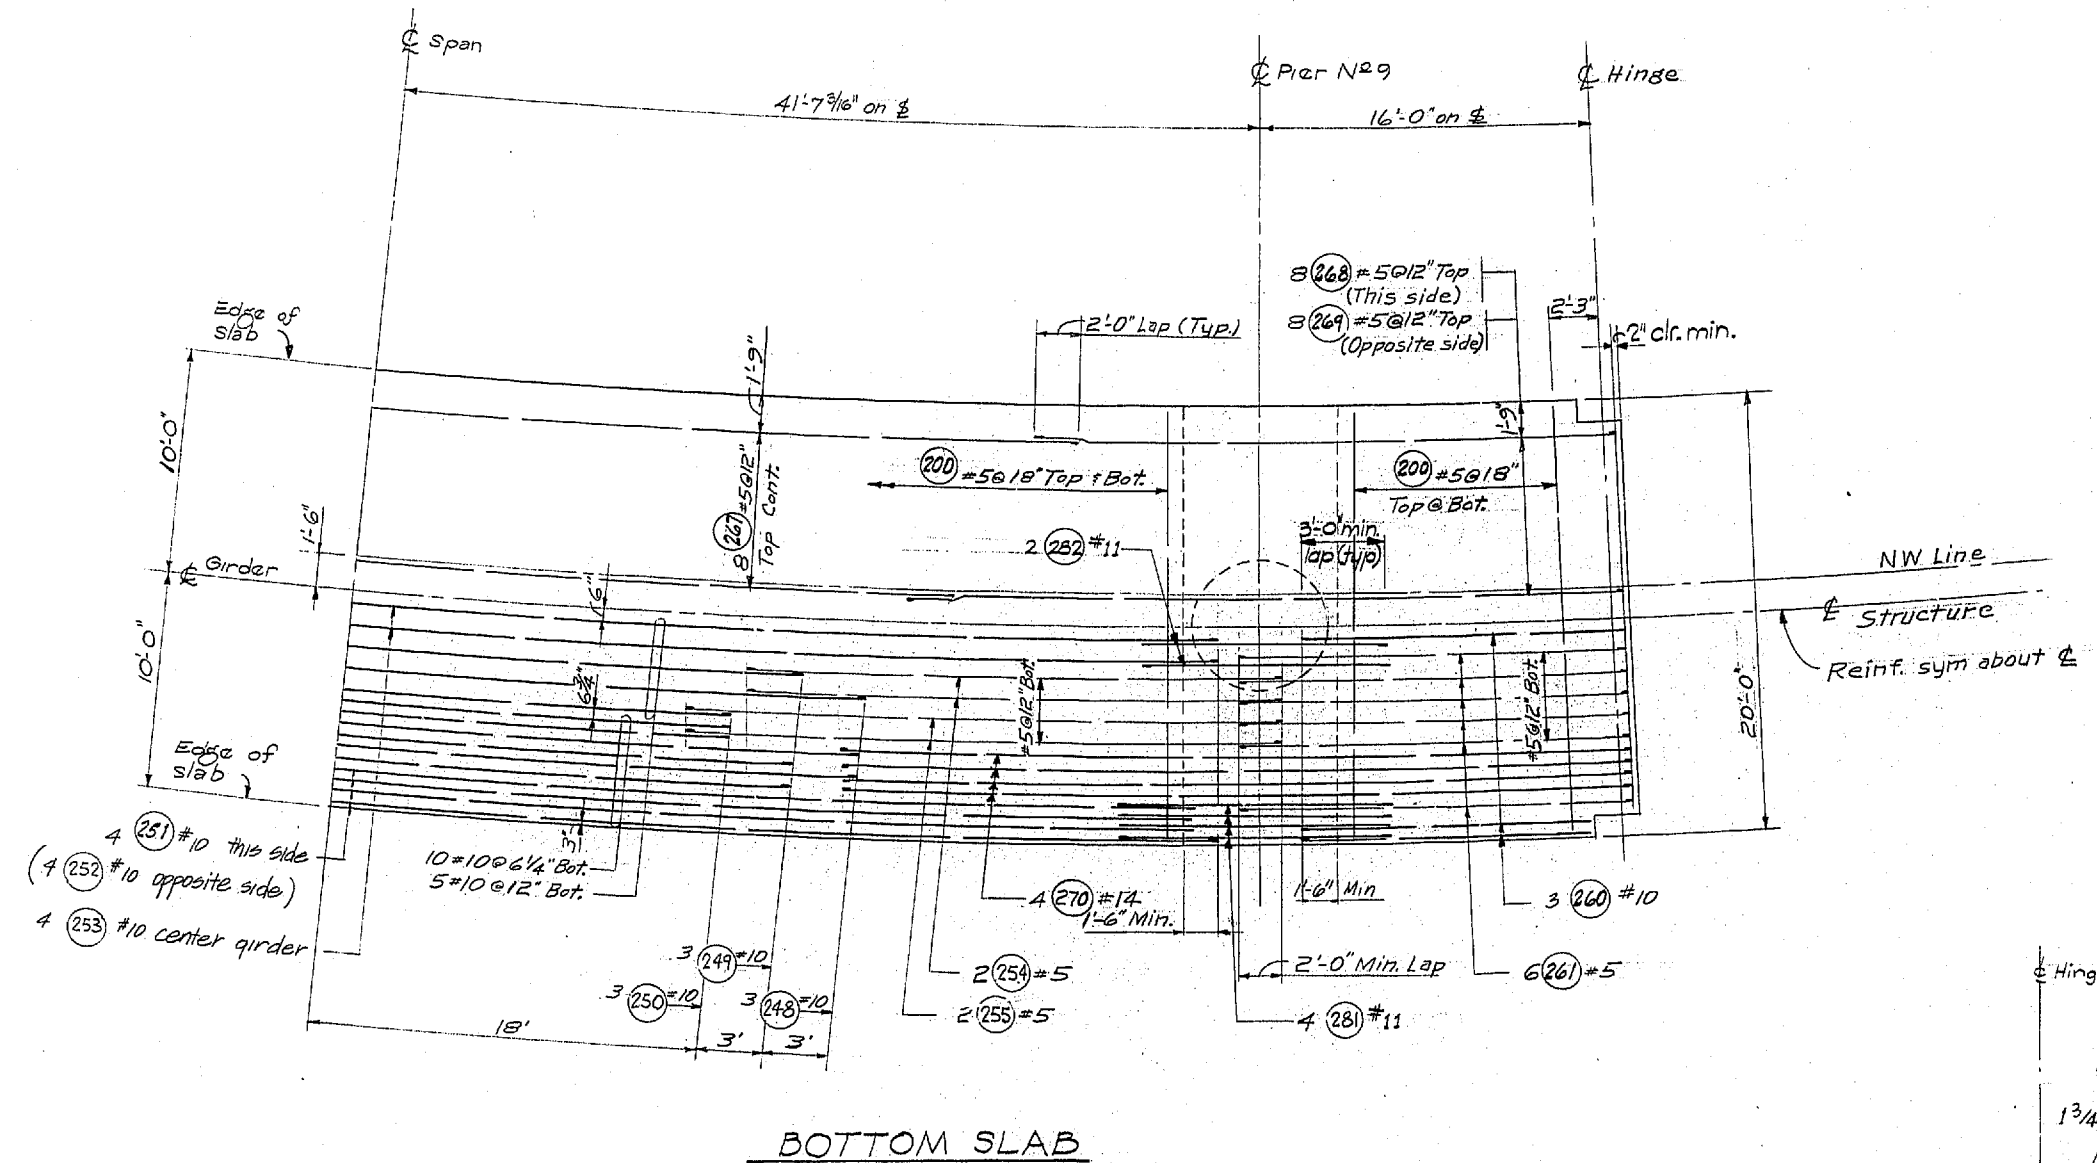

BOTTOM SLAB

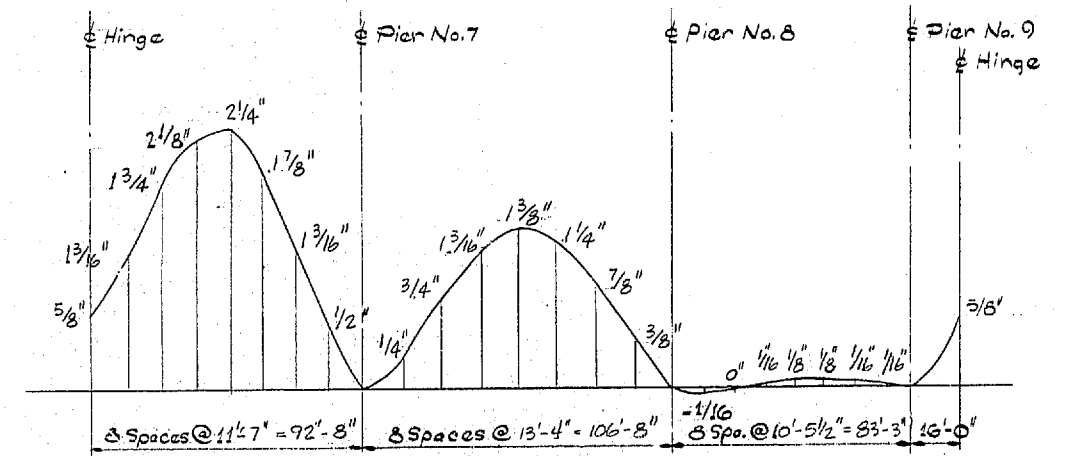

DEAD LOAD CAMBER CURVE FOR N-W RAMP

This curve shows D. L. Camber only and should be increased by the amount of take-up anticipated in the falsework.

DESIGNING ENGINEER	
DESIGN CHECKED	
DRAWN BY	
QUANTITIES CHECKED	

DATE	
BY	
CHECKED	
LOG. ENGR.	
DIST. ENGR.	

WOODINVILLE INTERCHANGE
 FISH NO. 1-RE/FISH NO. 2-BO
 N-W STRUCTURE
 SHEET 241 OF 257

11-16-67

DATE	REVISION	BY

**WORTHINGTON, SKILLING
 HELLE & JACKSON**
 Consulting Civil and Structural Engineers
 SEATTLE WASHINGTON

**SR 405
 MP 23.49 TO MP 23.76
 WOODINVILLE INTERCHANGE
 KING COUNTY
 N-W & N-E STRUCTURE**

BOTTOM SLAB

WASHINGTON STATE HIGHWAY COMMISSION
 DEPARTMENT OF HIGHWAYS
 OLYMPIA, WASHINGTON

GEORGE D. ZAHN, CHAIRMAN

H. WALSH
 JOHN N. RUPP

APPROVED December 7, 1967
 SHEET 249 OF 297 SHEETS
 CONTRACT NO. 8382



P/1995

DESIGNING ENGINEER	
DESIGNED	
DESIGN CHECKED	
QUANTITIES PREPARED	
QUANTITIES CHECKED	

24

DATE	
BY	
DRAWN	
TRACED	
CHECKED	
DATE	

WOODINVILLE INTERCHANGE
 PSH NO. 1-RE/PSH NO. 2-BO
 N-W STRUCTURE
 SHEET 250 OF 297
 11-16-67

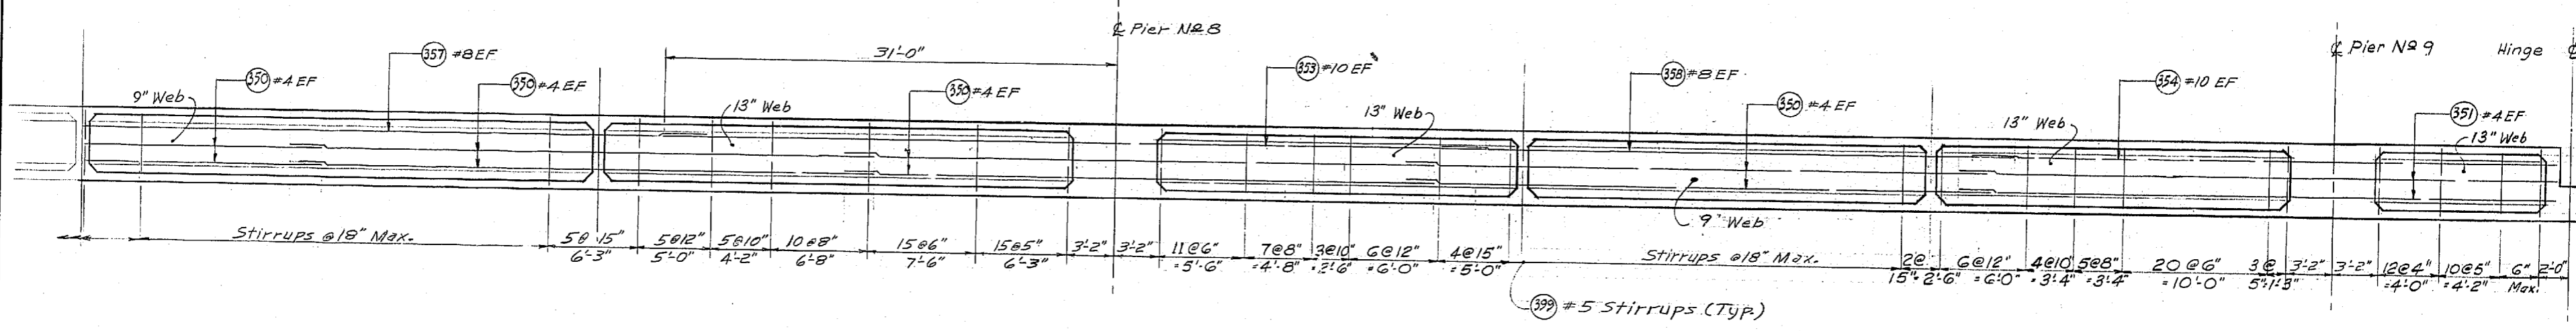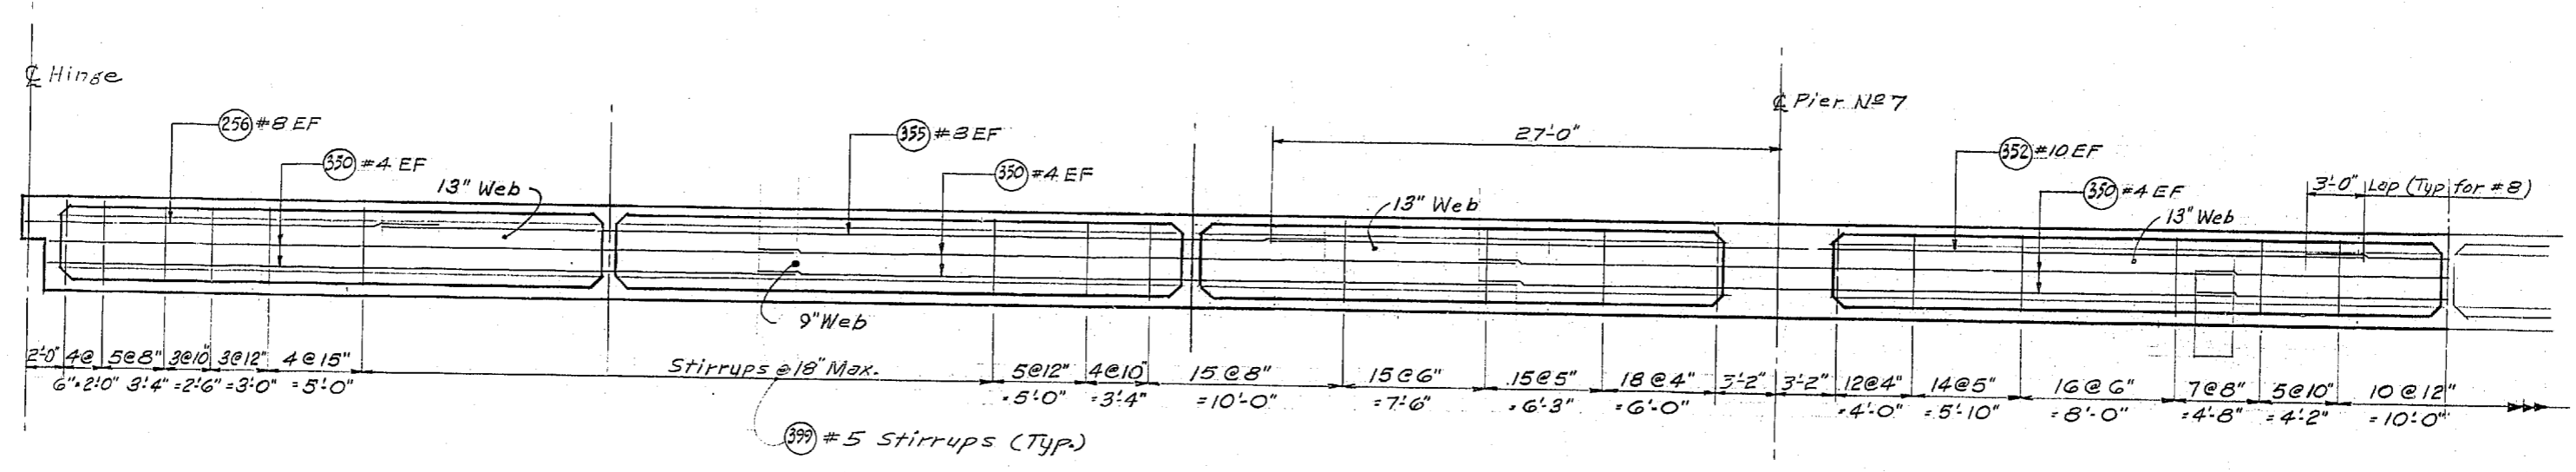

LONGITUDINAL SECTIONS

DATE	REVISION	BY

WORTHINGTON, SKILLING
 HELLE & JACKSON
 Consulting Civil and Structural Engineers
 SEATTLE WASHINGTON

SR 405
 MP 23.49 TO MP 23.76
 WOODINVILLE INTERCHANGE
 KING COUNTY
 N-W&N - E STRUCTURE

LONGITUDINAL SECTIONS

WASHINGTON STATE HIGHWAY COMMISSION
 DEPARTMENT OF HIGHWAYS
 OLYMPIA, WASHINGTON

GEORGE D. ZANN, CHAIRMAN


F. L. MIKALSON
 H. WALSH

BRUCE FERGUSON
 JOHN H. RUPP


APPROVED December 7, 1967
 SHEET 250 of 297 SHEETS
 BRIDGE ENGINEER

CONTRACT NO. 8382


P/1995

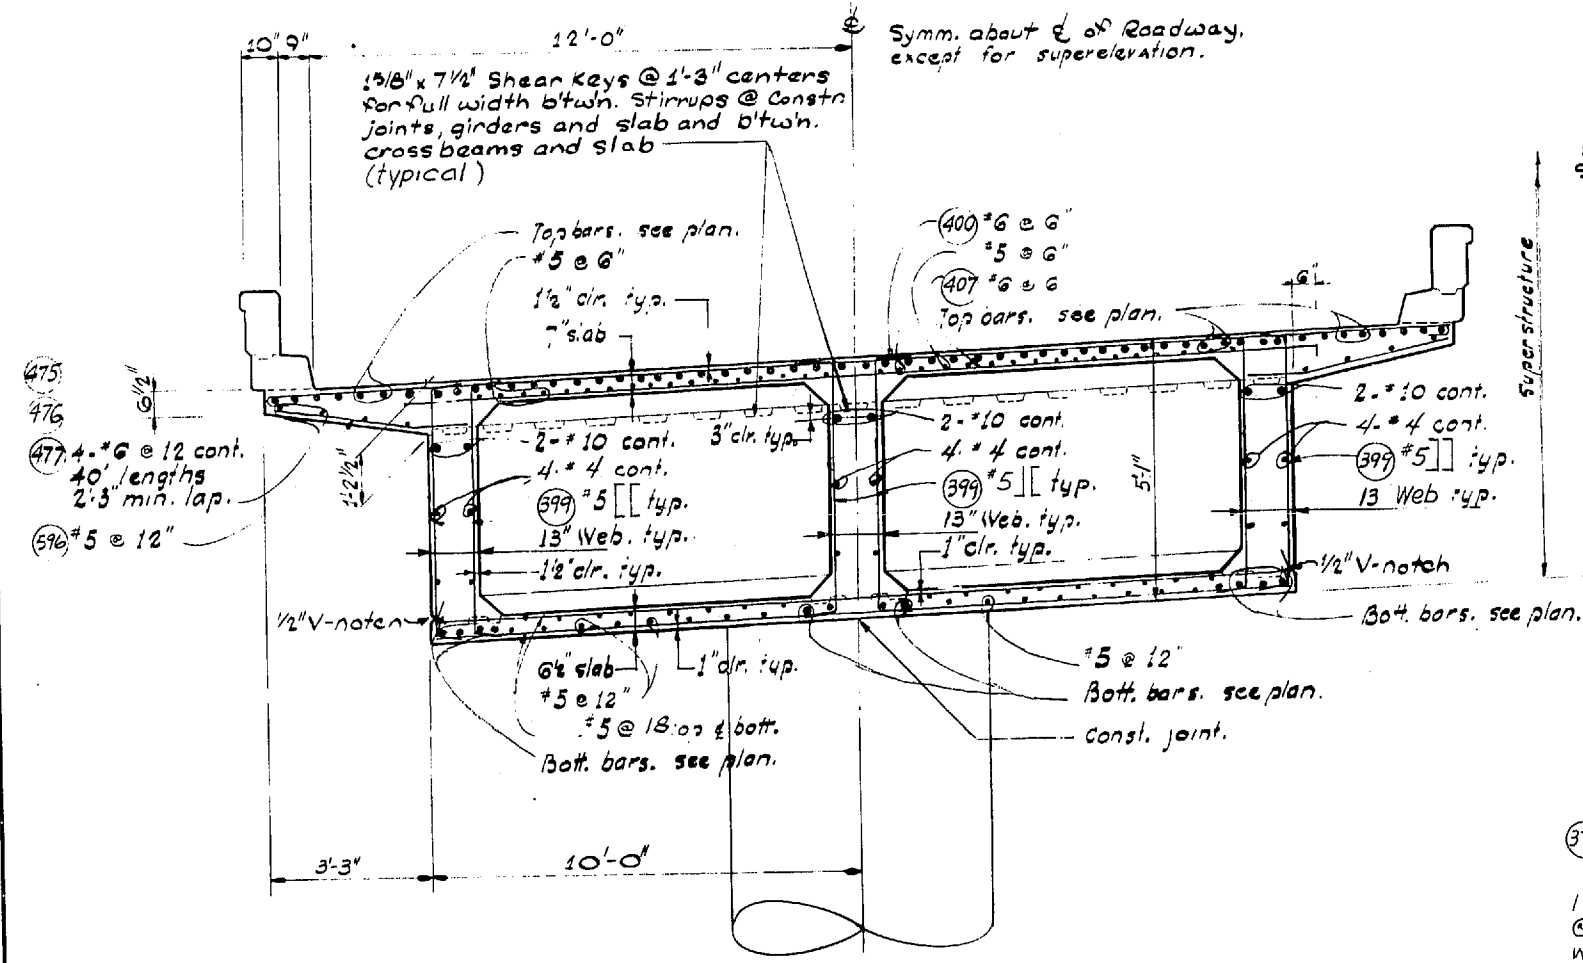


SECTION @ N-W PIERS 7 thru 9

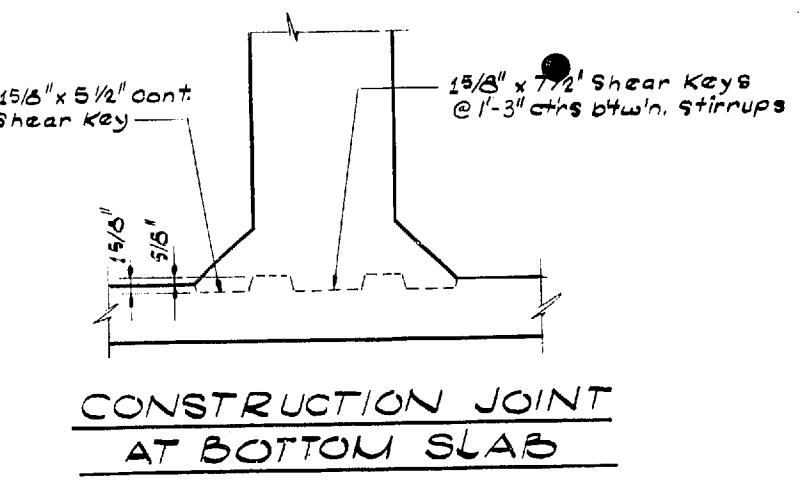


CONSTRUCTION JOINT AT BOTTOM SLAB

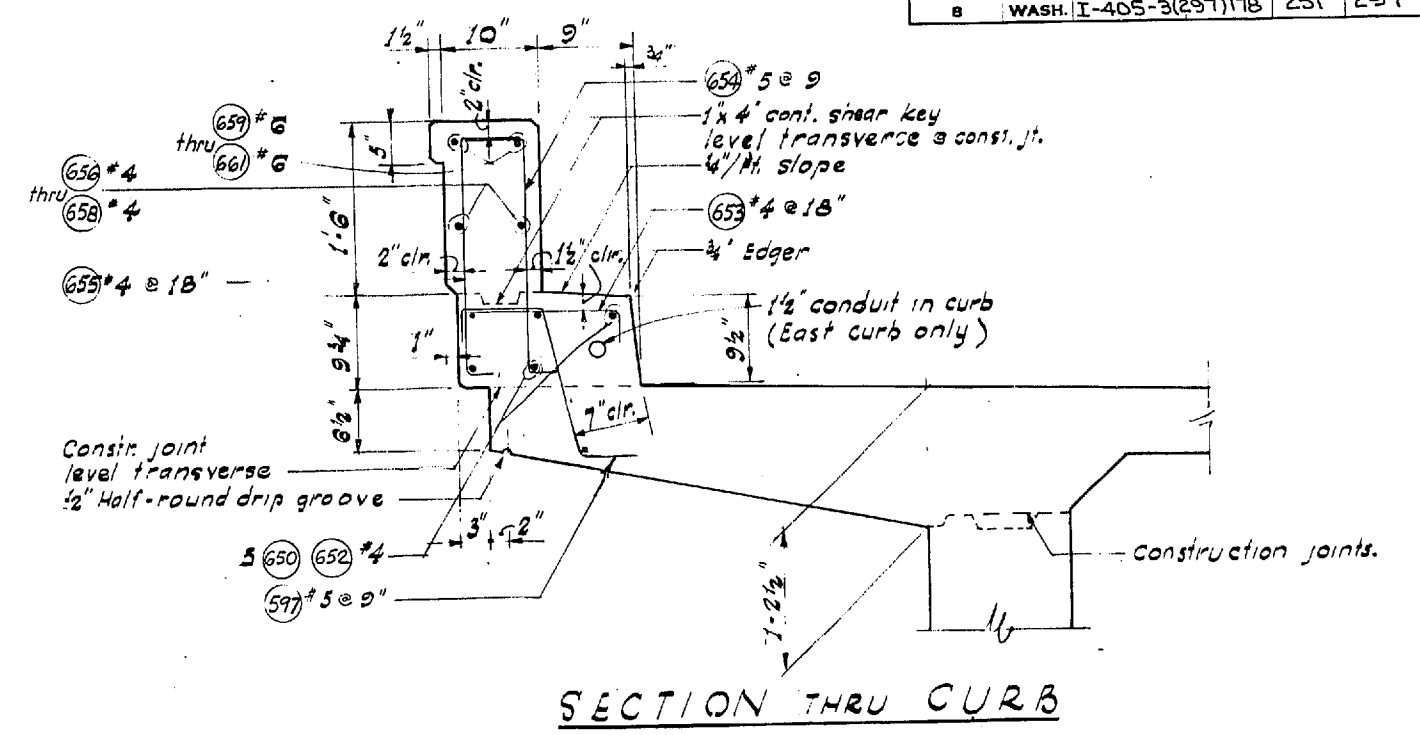


SECTION THRU CURB

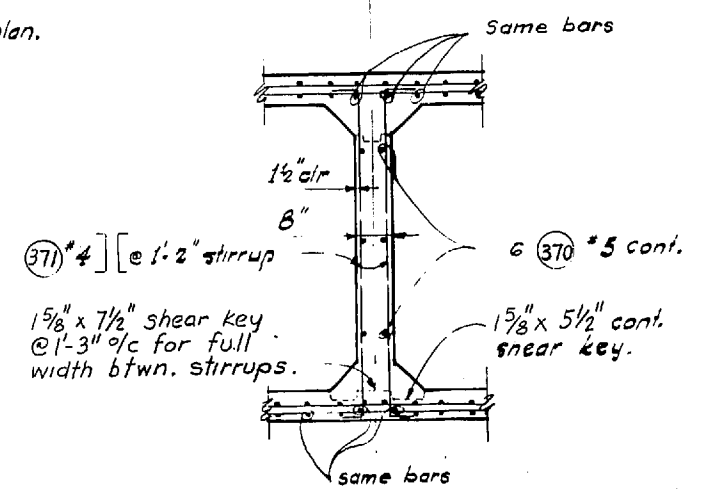


SECTION THRU DIAPHRAGM (TYPICAL ALL UNITS)

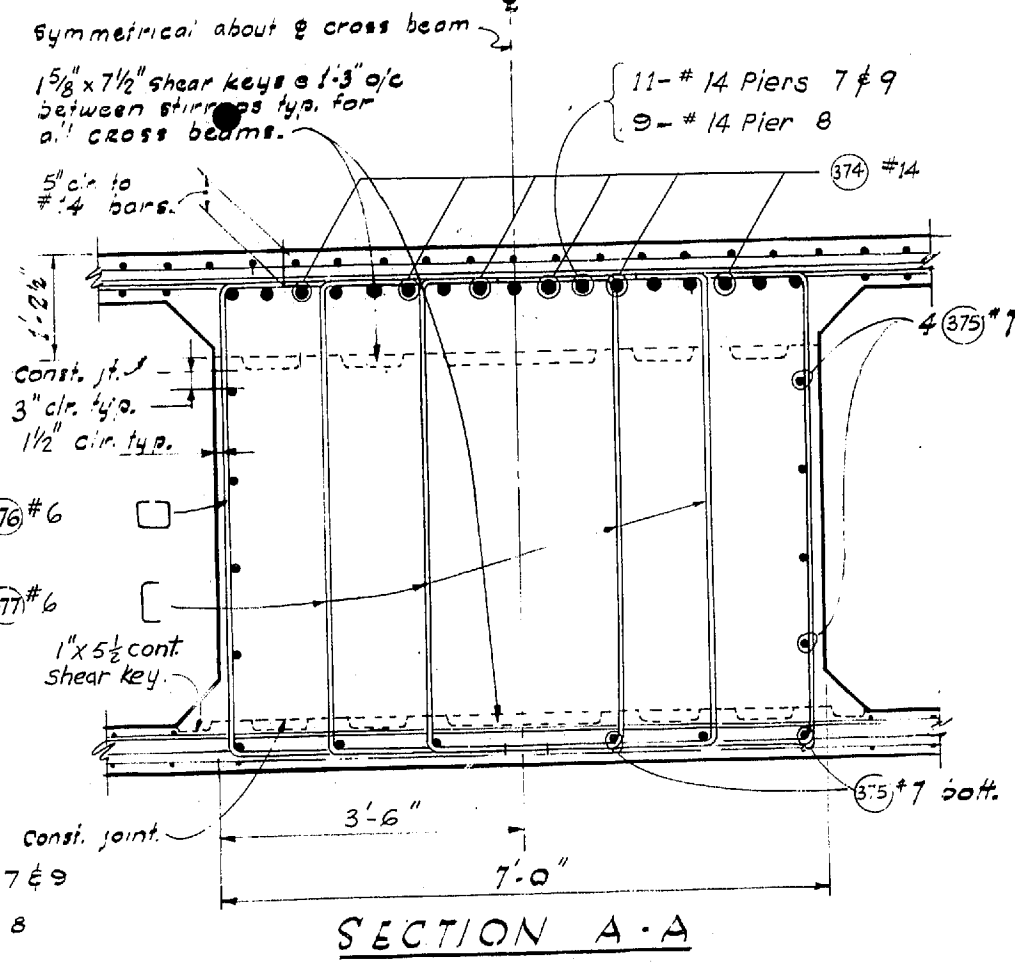

SECTION A-A

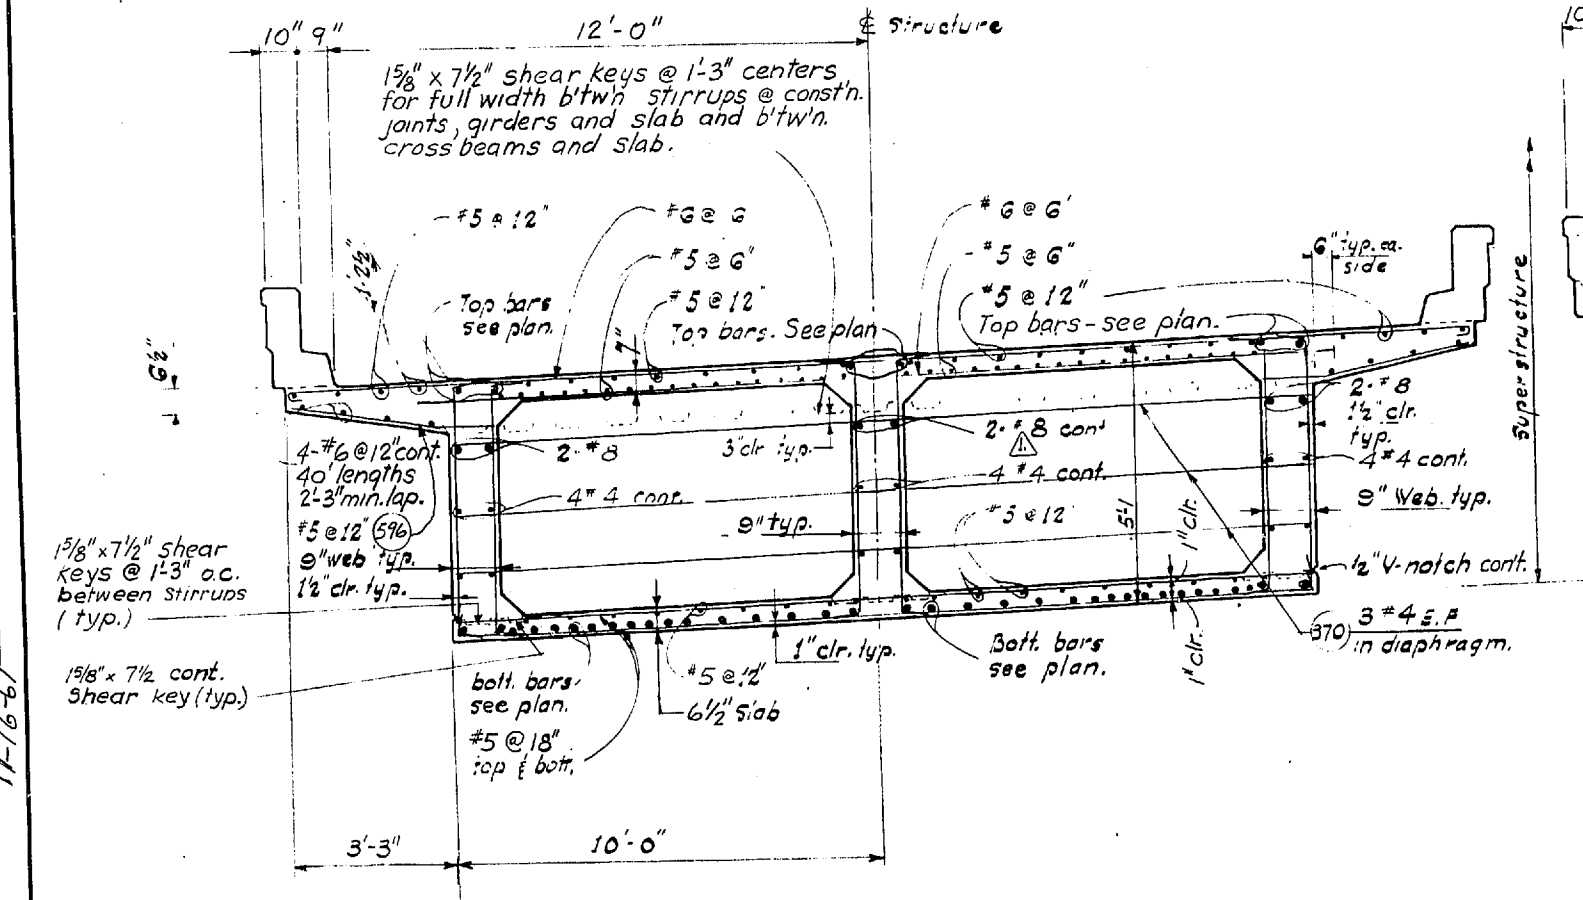

SECTION NEAR CENTER OF SPAN

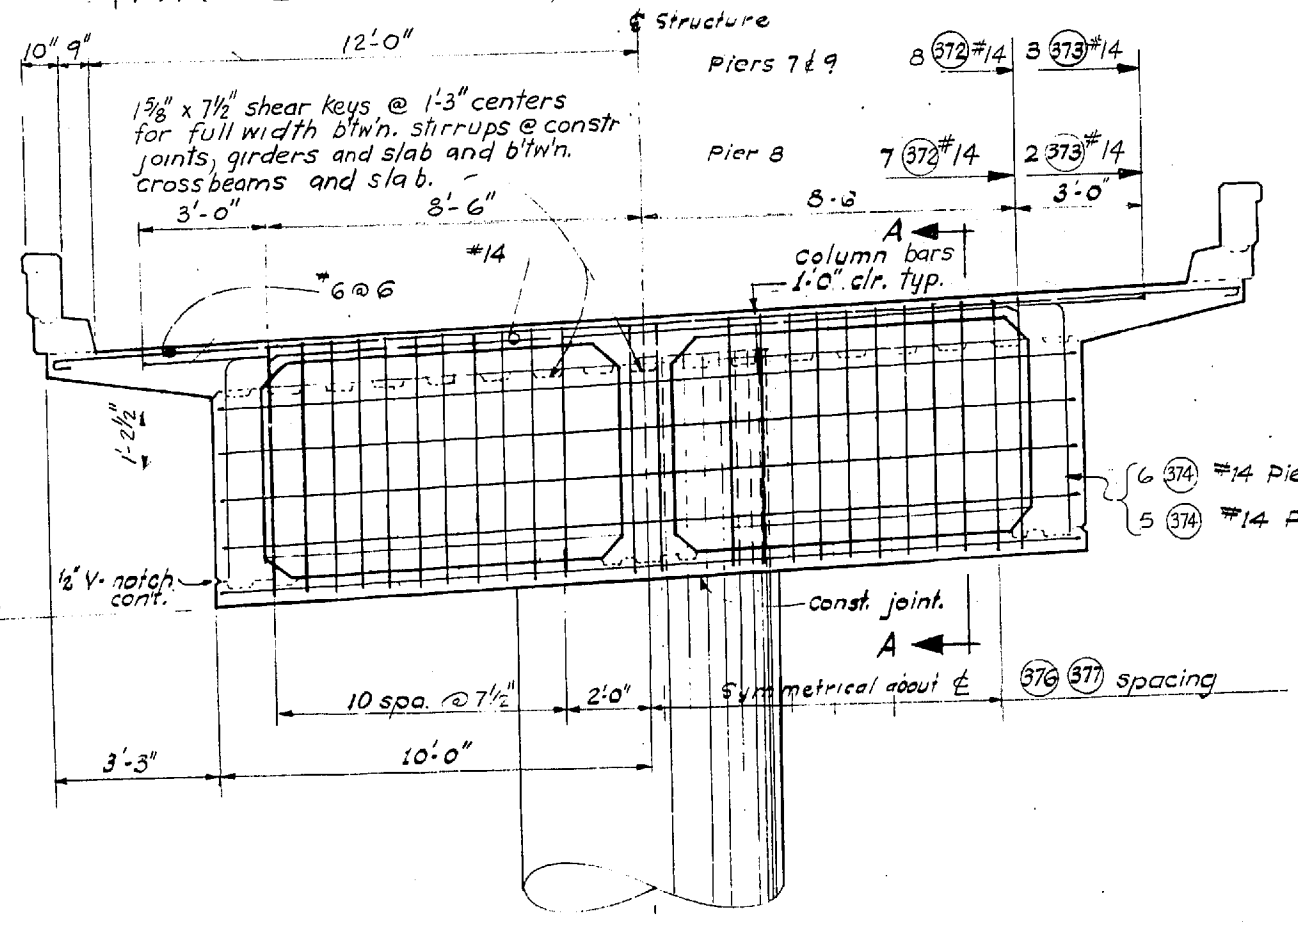

CROSS BEAM @ PIERS 7 thru 9

DATE	REVISION	BY
2-7-68	Revised Bar Size	NWS
WORTHINGTON, SKILLING HELLE & JACKSON Consulting Civil and Structural Engineers SEATTLE WASHINGTON		

SR 405
MP 23.49 TO MP 23.76
WOODINVILLE INTERCHANGE
 KING COUNTY
N-W & N-E STRUCTURE
TRANSVERSE SECTIONS

WASHINGTON STATE HIGHWAY COMMISSION
 DEPARTMENT OF HIGHWAYS
 OLYMPIA, WASHINGTON
 GEORGE D. ZAMM, CHAIRMAN
 H. I. MIVATSON, H. WALSH
 BARRY FERBISON, JOHN H. RUFF
 APPROVED December 7, 1967
 SHEET 251 of 297 SHEETS
 CONTRACT NO. 8982

BRIDGE ENGINEER


DRAWN BY: [blank]
 CHECKED BY: [blank]
 QUANTITIES CHECKED: [blank]
 REVISION NO. 1-16-67
 N-W TRANSVERSE SECTIONS
 SHEET 24 OF 25

FED. ROAD DIV. NO.	STATE	FED. AID PROJ. NO.	SHEET NO.	TOTAL SHEETS
8	WASH.	I-405-3(291)178	252	297

DESIGNED	CHECKED	QUANTITIES FIGURED	QUANTITIES CHECKED

DATE	BY

WOODVILLE INTERCHANGE
 PSH NO. 1-RE/PSH NO. 2-BO
 N-W STRUCTURE
 ROADWAY SLAB
 SHEET 244 OF 289
 1-16-67

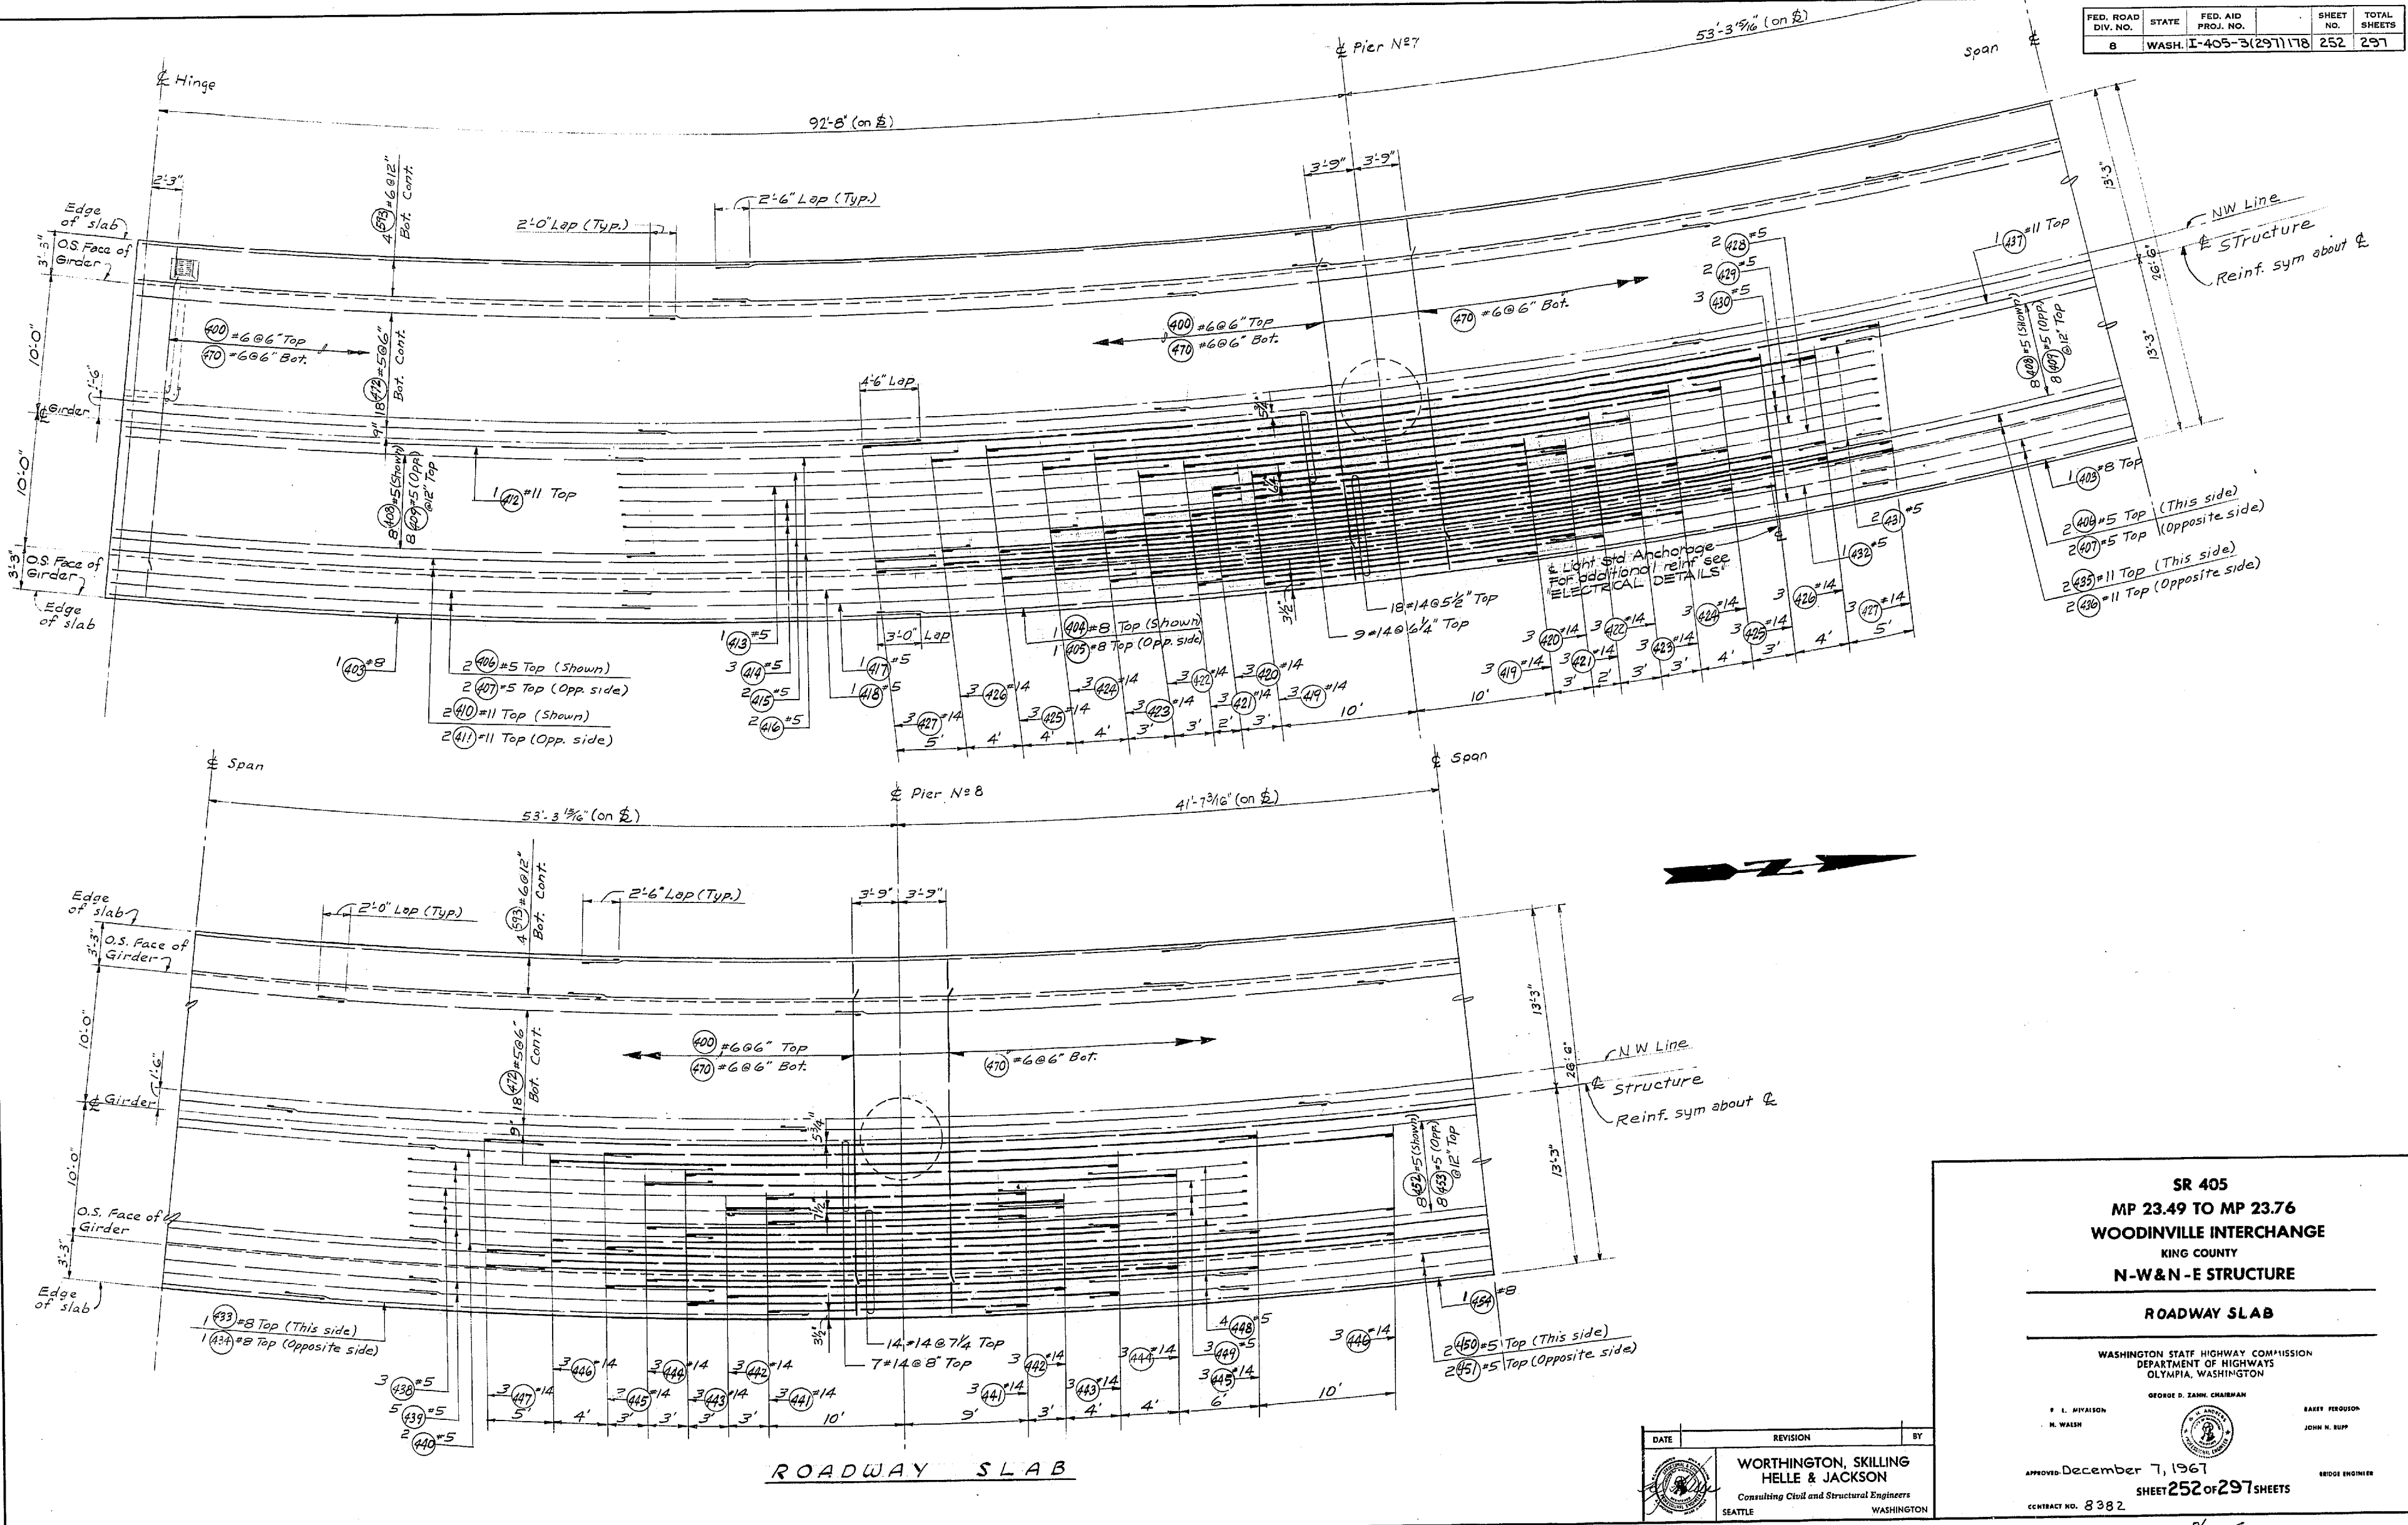

ROADWAY SLAB

DATE	REVISION	BY

WORTHINGTON, SKILLING
 HELLE & JACKSON
 Consulting Civil and Structural Engineers
 SEATTLE WASHINGTON

SR 405
 MP 23.49 TO MP 23.76
 WOODVILLE INTERCHANGE
 KING COUNTY
 N-W & N-E STRUCTURE

ROADWAY SLAB

WASHINGTON STATE HIGHWAY COMMISSION
 DEPARTMENT OF HIGHWAYS
 OLYMPIA, WASHINGTON

GEORGE D. ZAHM, CHAIRMAN

H. MIYASON
 N. WALSH

BAKER PERGUSON
 JOHN H. RUPP

APPROVED December 7, 1967

SHEET 252 OF 297 SHEETS

CONTRACT NO. 8382


1995

FED. ROAD DIV. NO.	STATE	FED. AID PROJ. NO.	SHEET NO.	TOTAL SHEETS
8	WASH.	I-405-3(297)178	253	297

DESIGNING ENGINEER	
DESIGN CHECKED	
DRAWN BY	
QUANTITIES FIGURED	
QUANTITIES CHECKED	

DATE	
BY	
TRACED	
CHECKED	
SCALE	
REVISION	

WOODVILLE INTERCHANGE
 PSH NO. 1-RETPSH NO. 2-BO
 N-W STRUCTURE
 ROADWAY SLAB
 SHEET 245 OF 259
 11-16-67

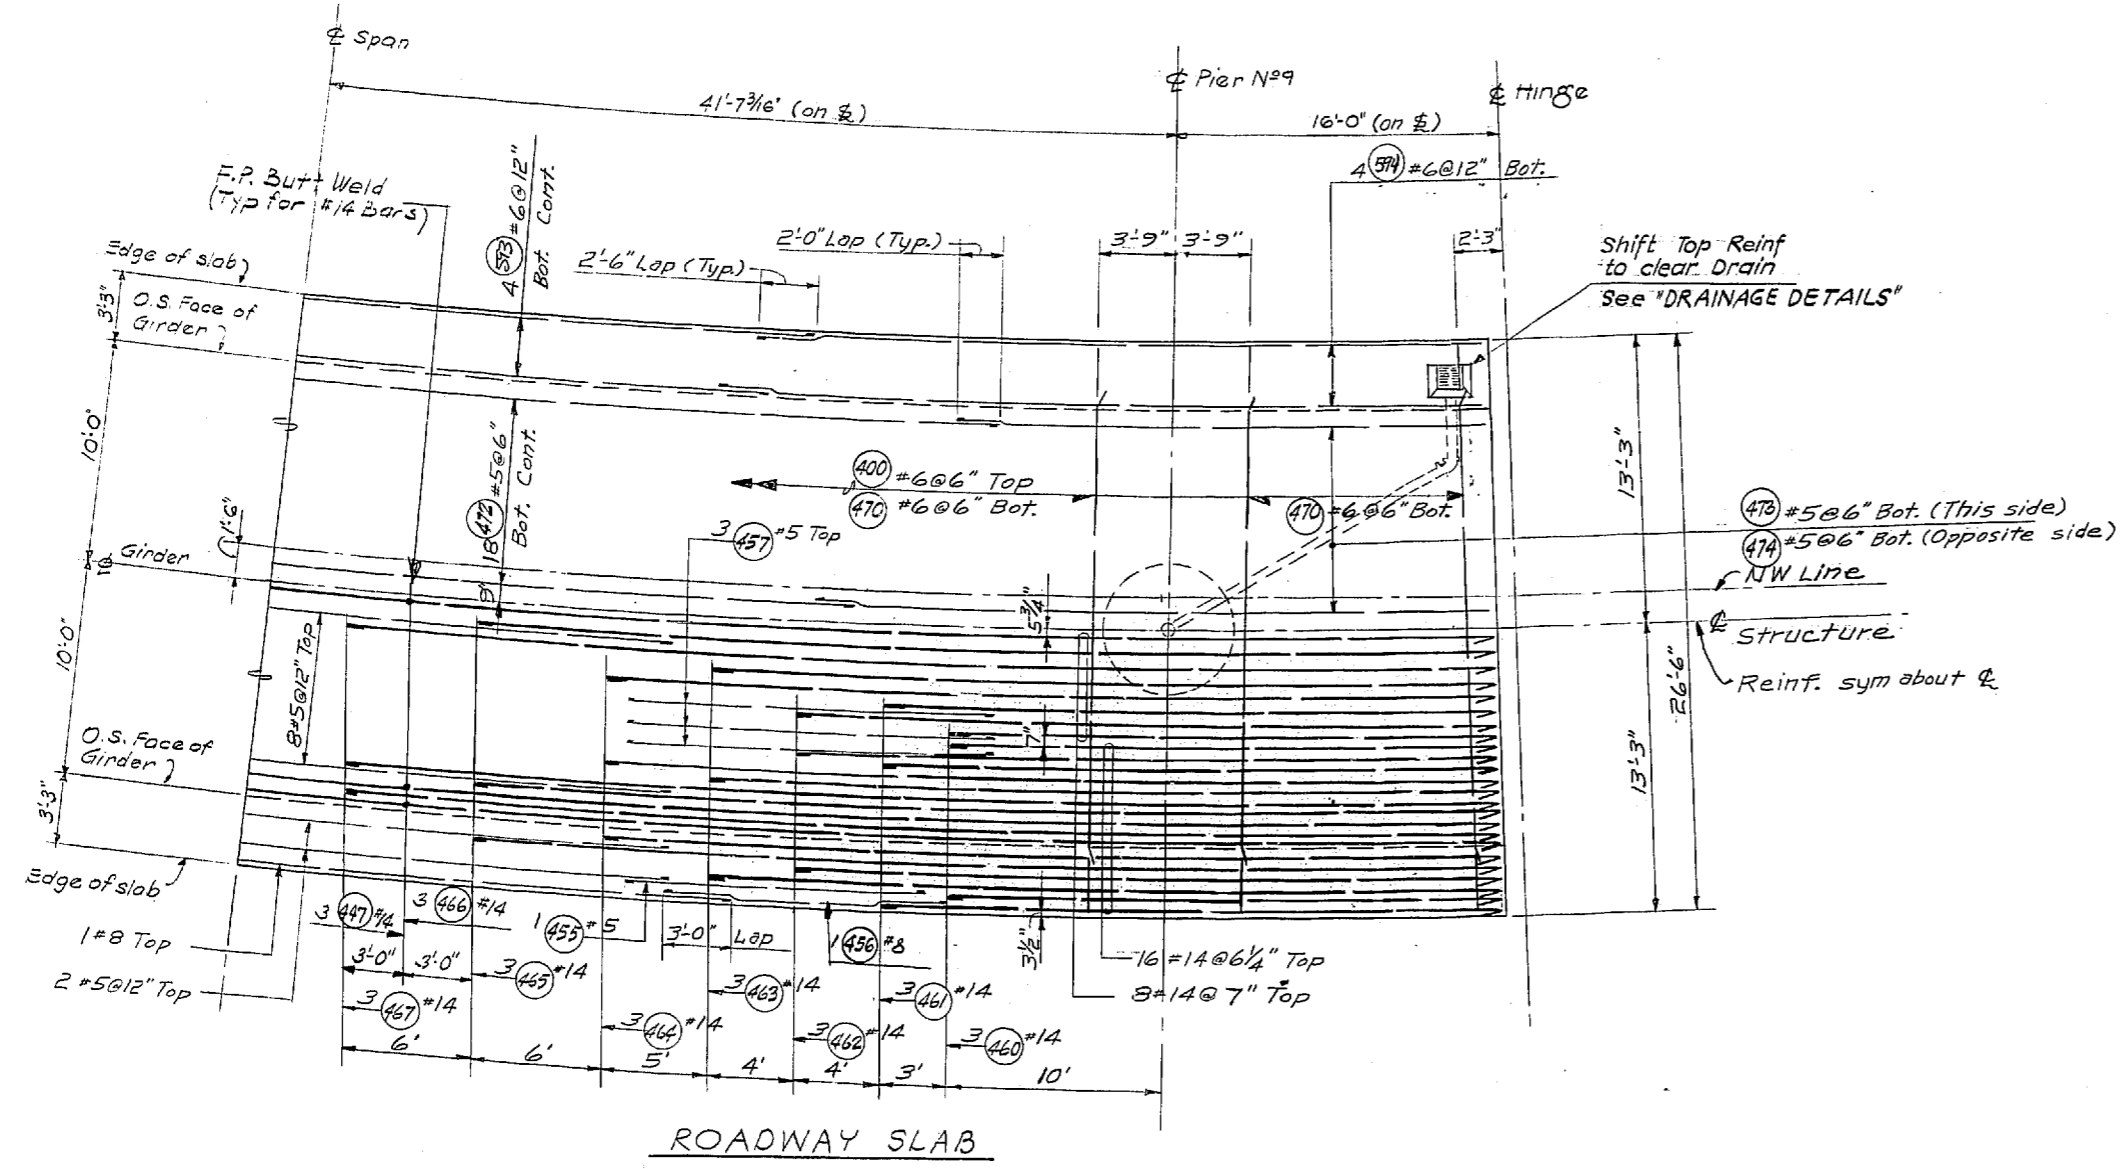

For Bar Weld Detail see "BOTTOM SLAB", UNIT 1

SR 405
MP 23.49 TO MP 23.76
WOODVILLE INTERCHANGE
 KING COUNTY
N-W & N-E STRUCTURE

ROADWAY SLAB

WASHINGTON STATE HIGHWAY COMMISSION
 DEPARTMENT OF HIGHWAYS
 OLYMPIA, WASHINGTON


GEORGE D. ZAHM, CHAIRMAN
 F. I. MYLAIKON, H. WALSH, BAKER FERGUSON, JOHN H. RUFF

APPROVED December 7, 1967
 SHEET 253 OF 297 SHEETS
 CONTRACT NO. 8382

DATE	REVISION	BY

WORTHINGTON, SKILLING HELLE & JACKSON
 Consulting Civil and Structural Engineers
 SEATTLE WASHINGTON



FED. ROAD DIV. NO.	STATE	FED. AID PROJ. NO.	SHEET NO.	TOTAL SHEETS
8	WASH.	I-405-3(297)178	254	297

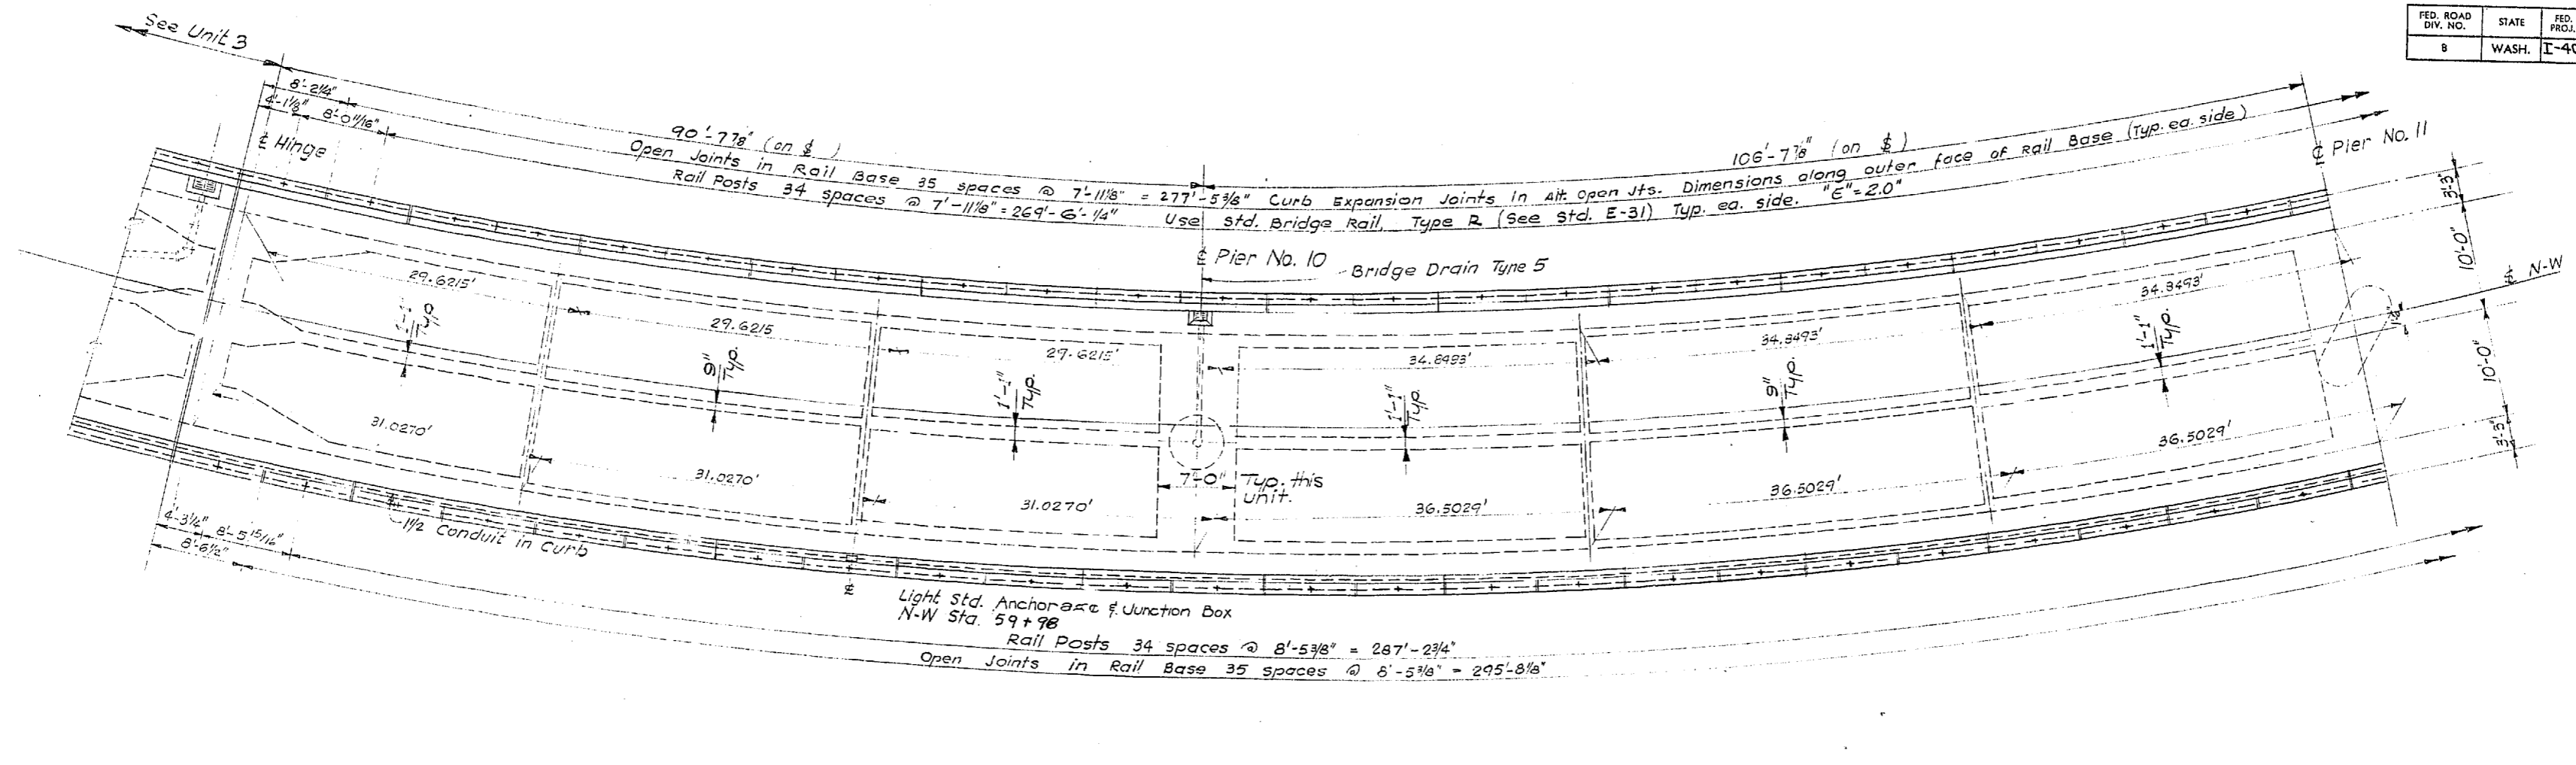

DESIGNING ENGINEER
CHECKED
DESIGN CHECKED
DRAWN BY
QUANTITIES FIGURED
QUANTITIES CHECKED

DATE
BY
DRAWN
CHECKED
LOC. ENGR.
DIET. ENGR.


WOODVILLE INTERCHANGE
 PSH NO. 1-REPAIR NO. 2-BO
 N-W STRUCTURE
 SHEET 254 OF 297

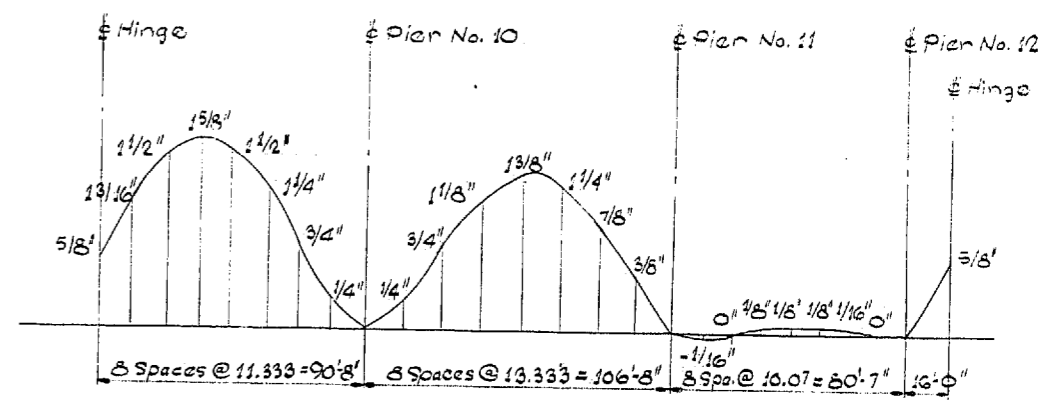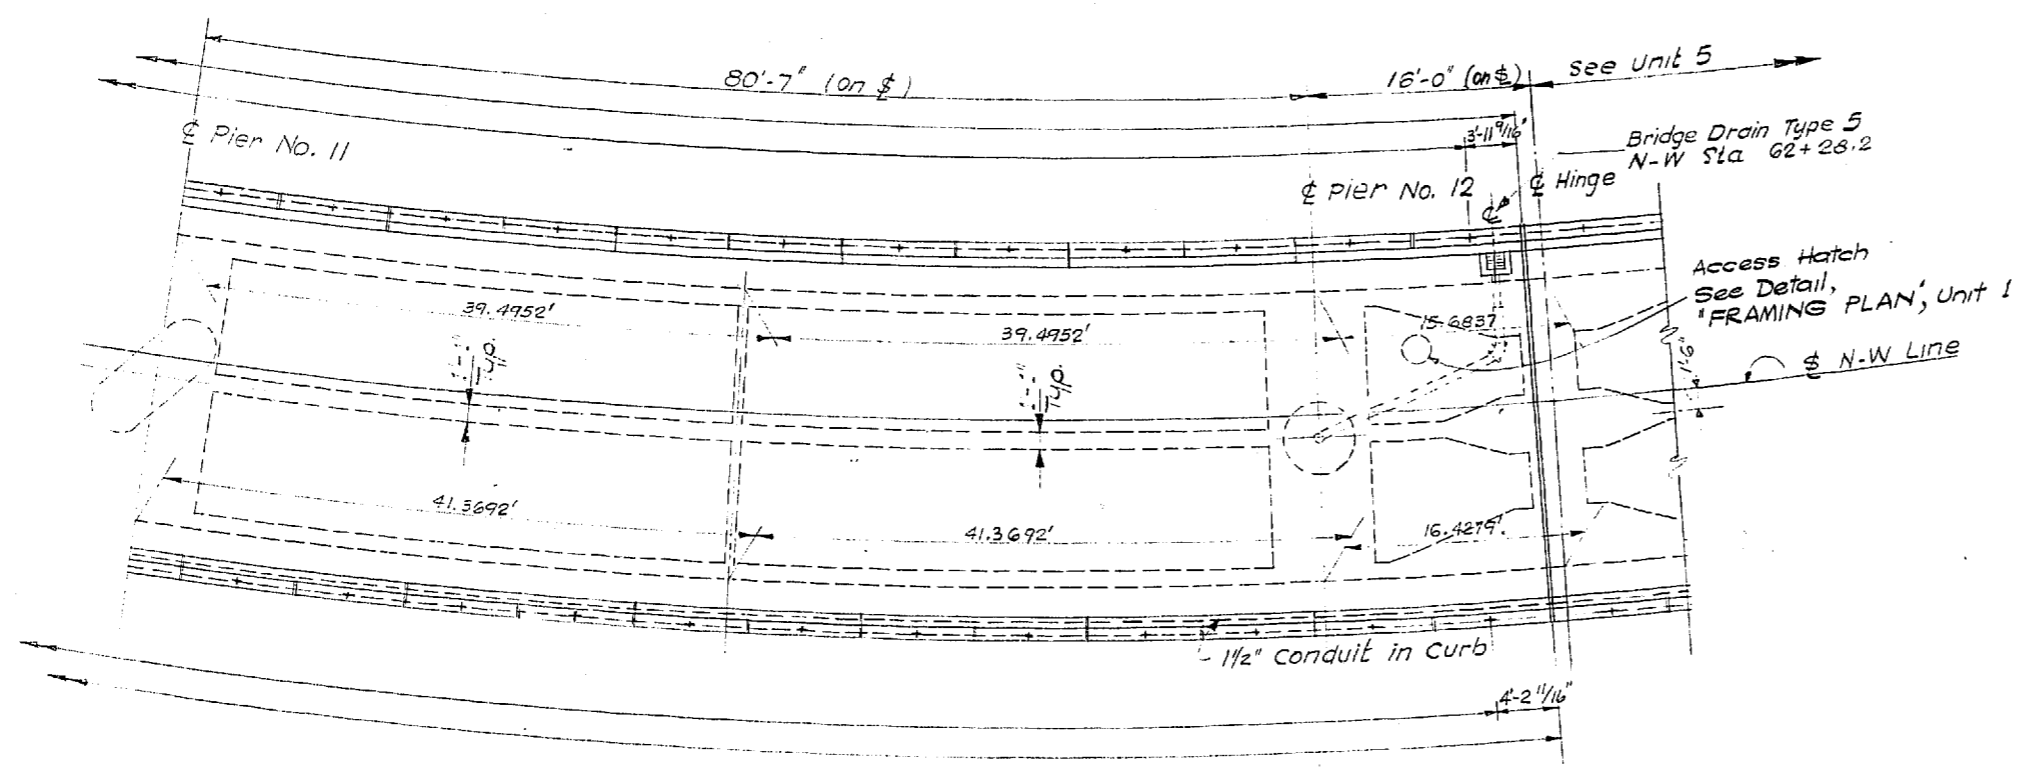

DEAD LOAD CAMBER CURVE FOR N-W RAMP
 This curve shows D.L. Camber only and should be increased by the amount of take-up anticipated in the falsework.

For General Notes See Unit 1 Framing Plan.

FRAMING PLAN

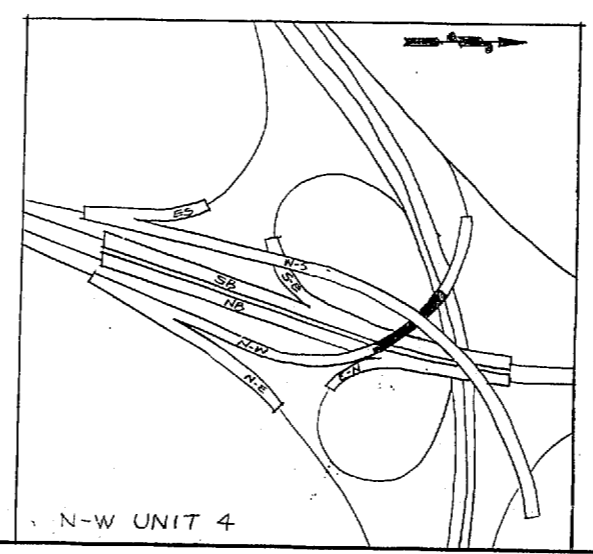

DATE	REVISION	BY

**WORTHINGTON, SKILLING
 HELLE & JACKSON**
 Consulting Civil and Structural Engineers
 SEATTLE WASHINGTON

**SR 405
 MP 23.49 TO MP 23.76
 WOODVILLE INTERCHANGE
 KING COUNTY
 N-W & N-E STRUCTURE**

FRAMING PLAN

WASHINGTON STATE HIGHWAY COMMISSION
 DEPARTMENT OF HIGHWAYS
 OLYMPIA, WASHINGTON

GEORGE D. ZAHN, CHAIRMAN

F. L. MITCHELL
 H. WALSH

BAKIR FERUGSON
 JOHN N. RUFF

APPROVED December 7, 1967
 SHEET 254 OF 297 SHEETS
 CONTRACT NO. 8302


9/1995

FED. ROAD DIV. NO.	STATE	FED. AID PROJ. NO.	SHEET NO.	TOTAL SHEETS
8	WASH.	405-3(297)178	255	297

DESIGNED BY	DATE
CHECKED BY	
DRAWN BY	
TRACED BY	
SCALE	
QUANTITIES CHECKED	

DATE	BY

WOODVILLE INTERCHANGE
 PSH NO. 1-RE/PSH NO. 2-BO
 N-W & N-E STRUCTURE
 SHEET 255 OF 297

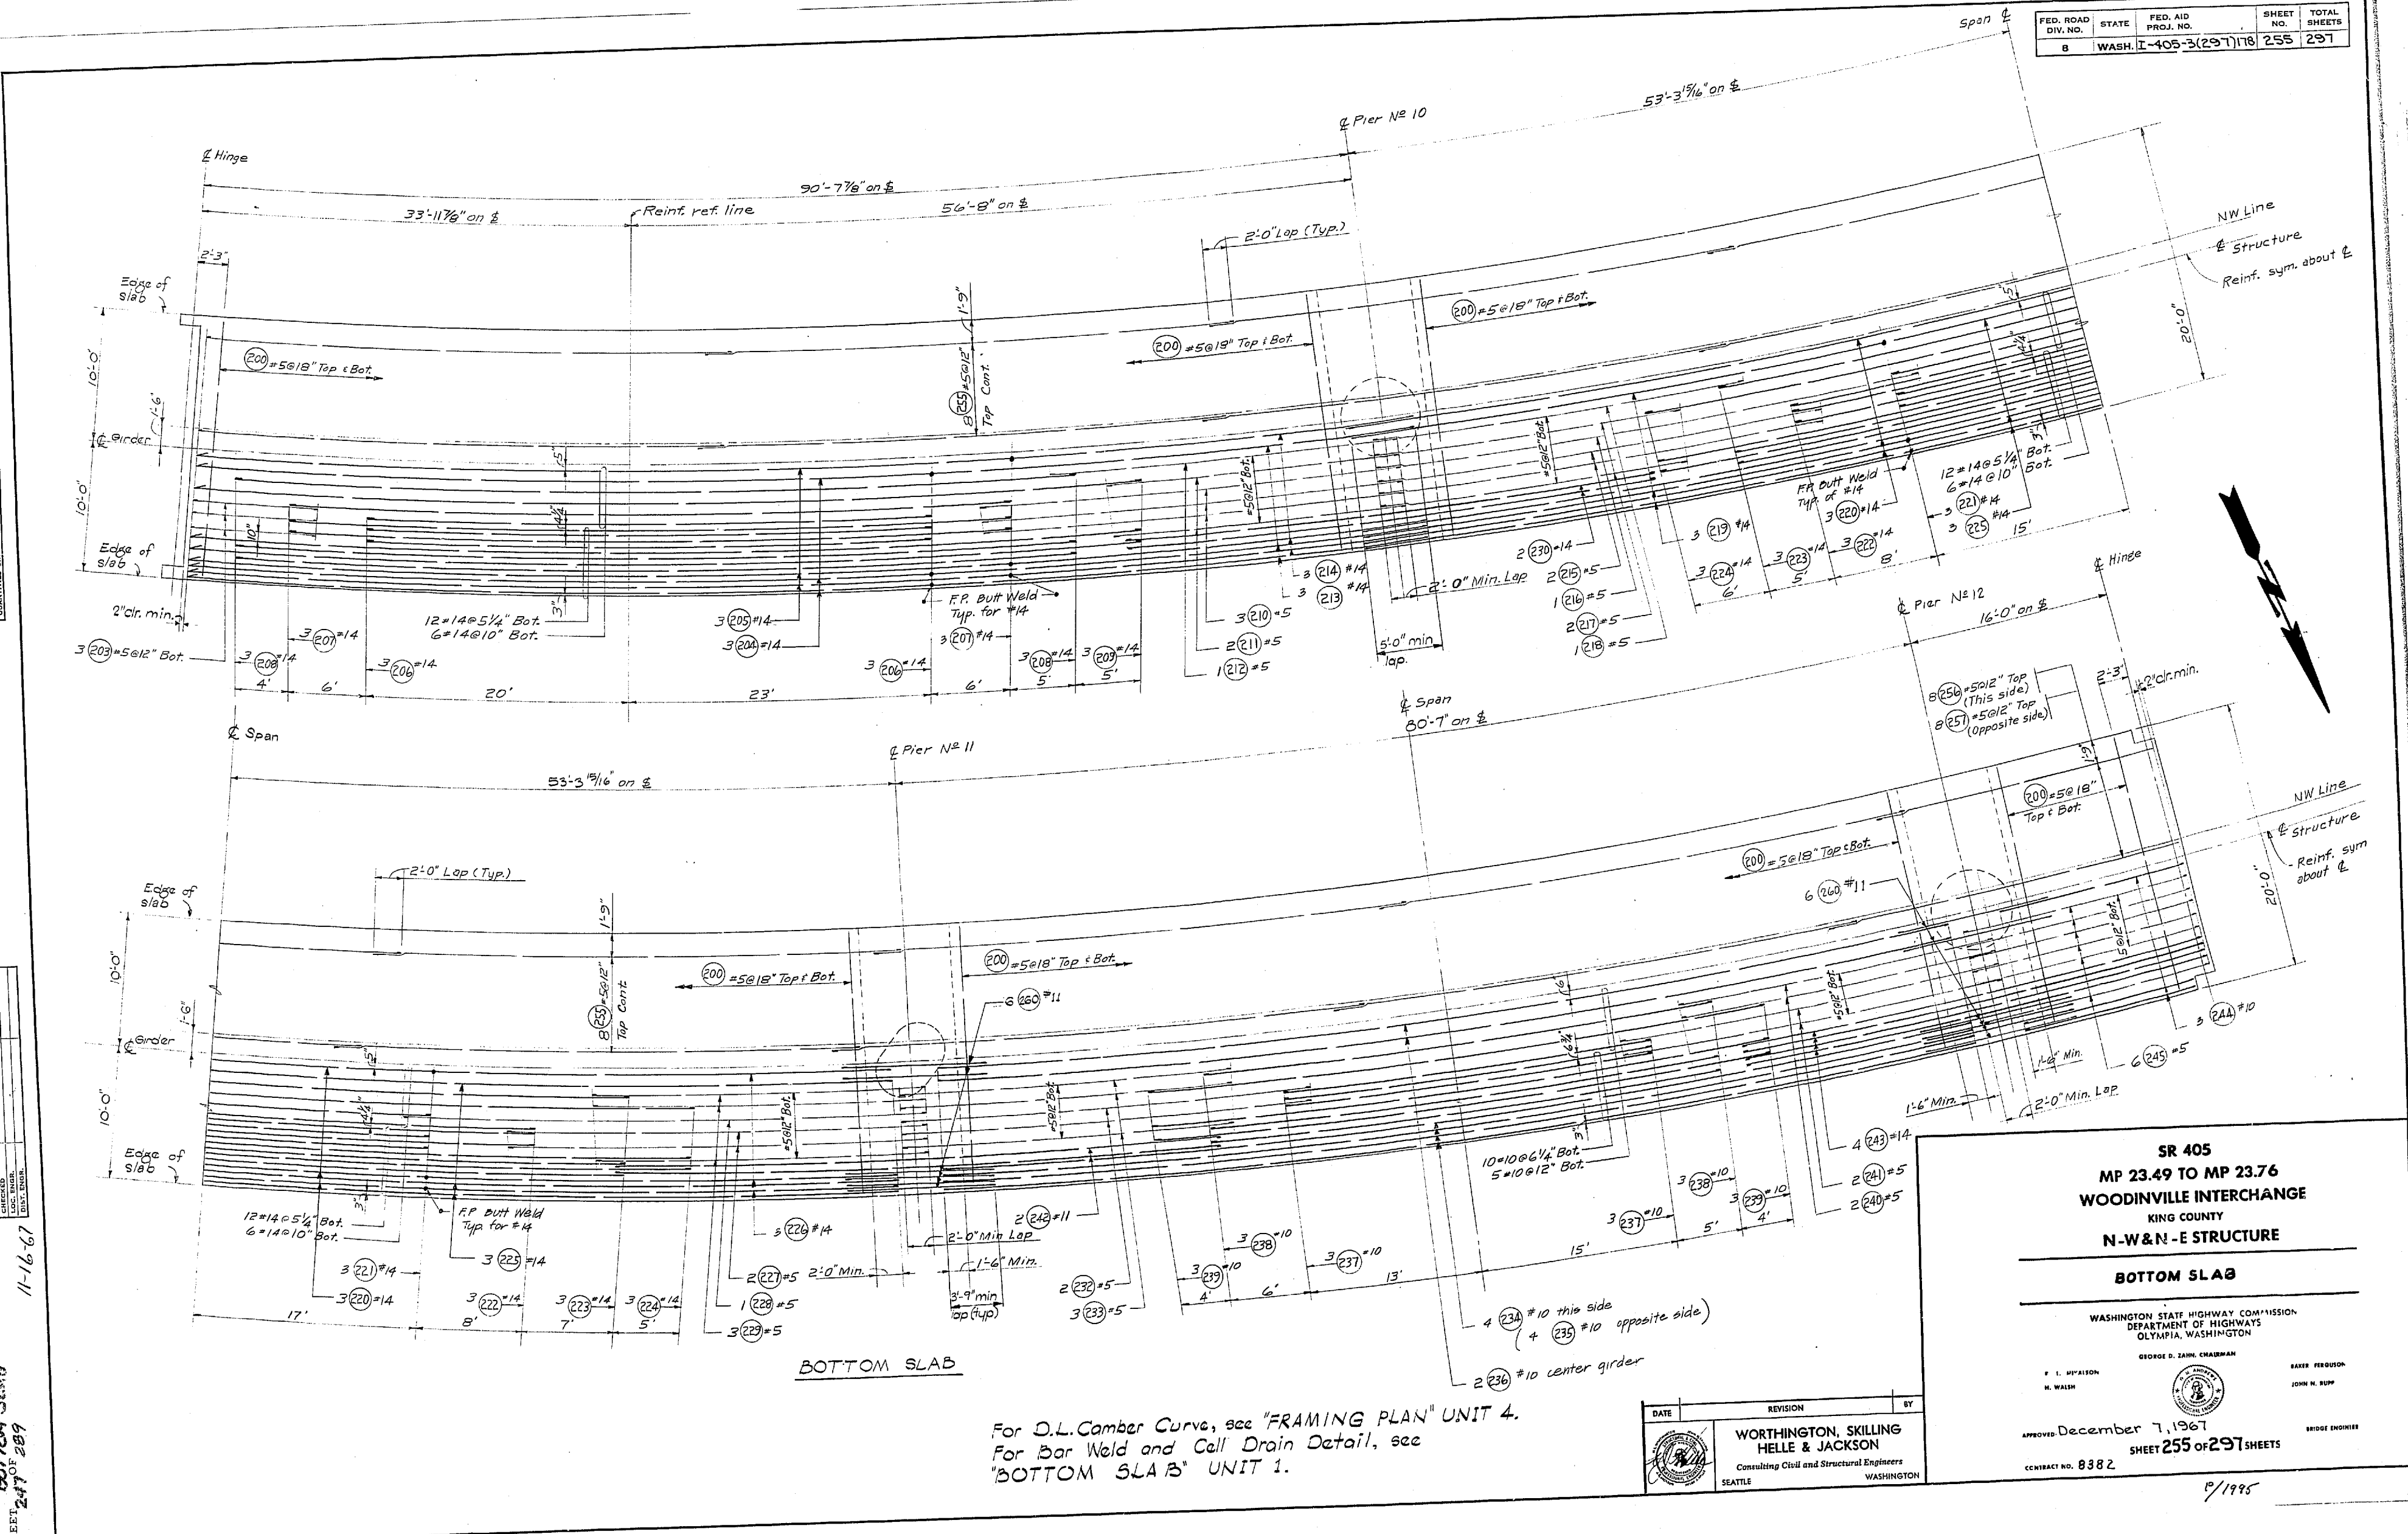

BOTTOM SLAB

For D.L. Camber Curve, see "FRAMING PLAN" UNIT 4.
 For Bar Weld and Call Drain Detail, see "BOTTOM SLAB" UNIT 1.

DATE	REVISION	BY

WORTHINGTON, SKILLING
 HELLE & JACKSON
 Consulting Civil and Structural Engineers
 SEATTLE WASHINGTON

SR 405
MP 23.49 TO MP 23.76
WOODVILLE INTERCHANGE
 KING COUNTY
N-W & N-E STRUCTURE

BOTTOM SLAB

WASHINGTON STATE HIGHWAY COMMISSION
 DEPARTMENT OF HIGHWAYS
 OLYMPIA, WASHINGTON

GEORGE D. ZAHM, CHAIRMAN

F. E. McALISON
 H. WALSH

BAKER FERDINON
 JOHN H. RUPP



APPROVED: December 7, 1967
 SHEET 255 OF 297 SHEETS
 CONTRACT NO. 8382

11/16-67

1/1965

FED. ROAD DIV. NO.	STATE	FED. AID PROJ. NO.	SHEET NO.	TOTAL SHEETS
8	WASH.	I-405-3(297)118	256	297

DESIGNED	
CHECKED	
QUANTITIES CHECKED	

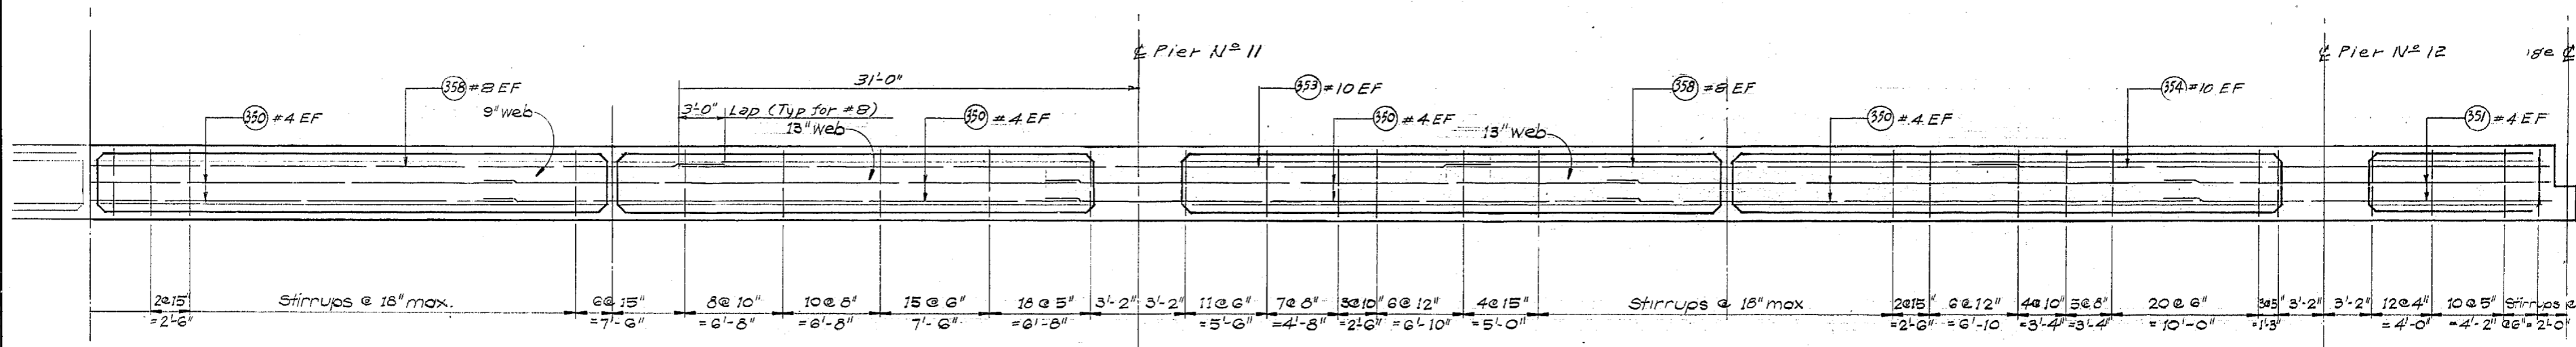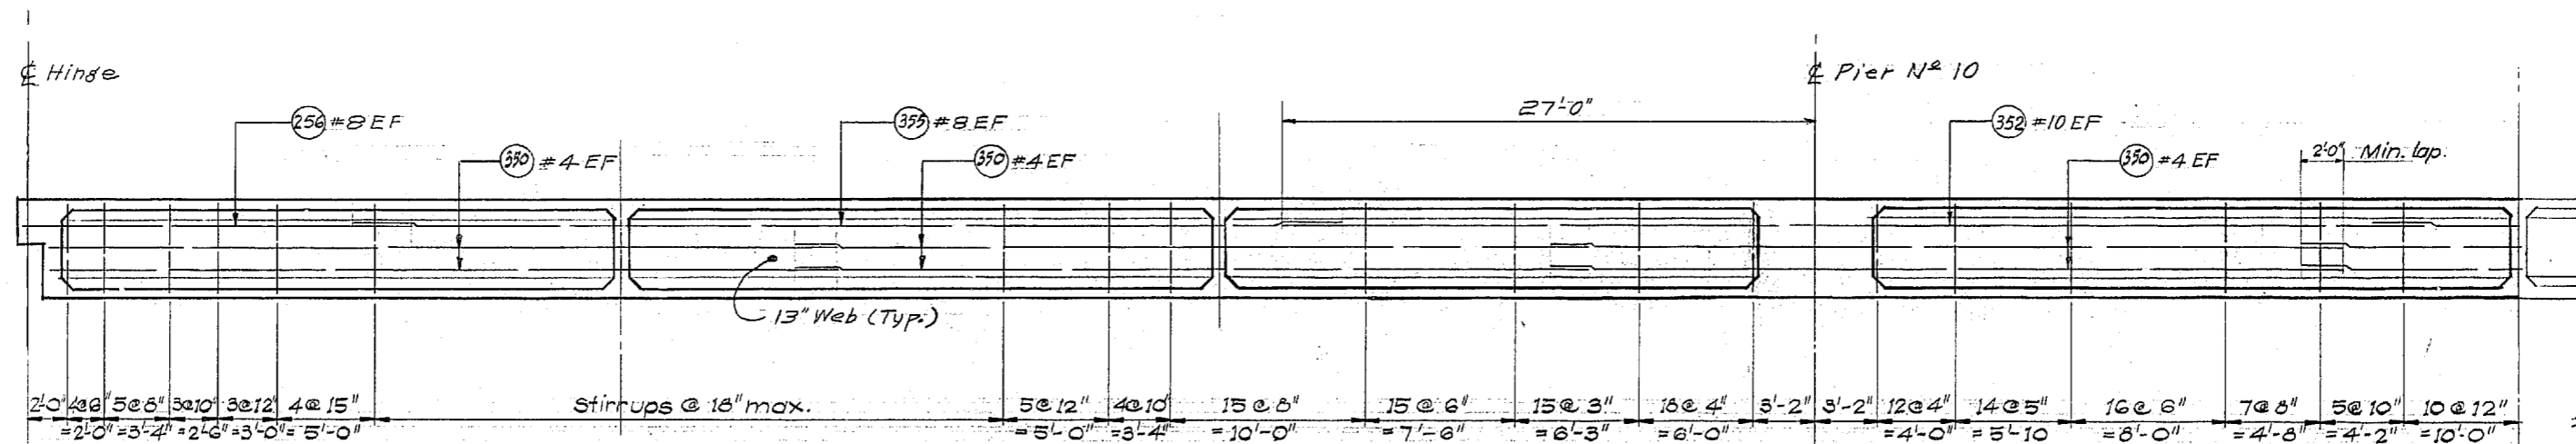

LONGITUDINAL SECTIONS

DATE	
BY	
DRAWN	
TRACED	
CHECKED	
DATE	

WOODINVILLE INTERCHANGE
 PSH NO. 1-RE (PSH NO. 2-80)
 N-W STRUCTURE
 LONGITUDINAL SECTIONS
 SHEET 245 OF 289
 11-16-67

DATE	REVISION	BY

WORTHINGTON, SKILLING HELLE & JACKSON
 Consulting Civil and Structural Engineers
 SEATTLE WASHINGTON

SR 405
MP 23.49 TO MP 23.76
WOODINVILLE INTERCHANGE
 KING COUNTY
N-W&N-E STRUCTURE

LONGITUDINAL SECTIONS

WASHINGTON STATE HIGHWAY COMMISSION
 DEPARTMENT OF HIGHWAYS
 OLYMPIA, WASHINGTON


GEORGE D. ZAHM, CHAIRMAN
 F. I. MITALSON
 H. WALSH

 BARRY FERGUSON
 JOHN H. SUPP
 BRIDGE ENGINEER


APPROVED December 7, 1967
 SHEET 256 OF 297 SHEETS
 CONTRACT NO. 8382

P/1995


FED. ROAD DIV. NO.	STATE	FED. AID PROJ. NO.	SHEET NO.	TOTAL SHEETS
8	WASH.	I-405-3(297) 178	257	297

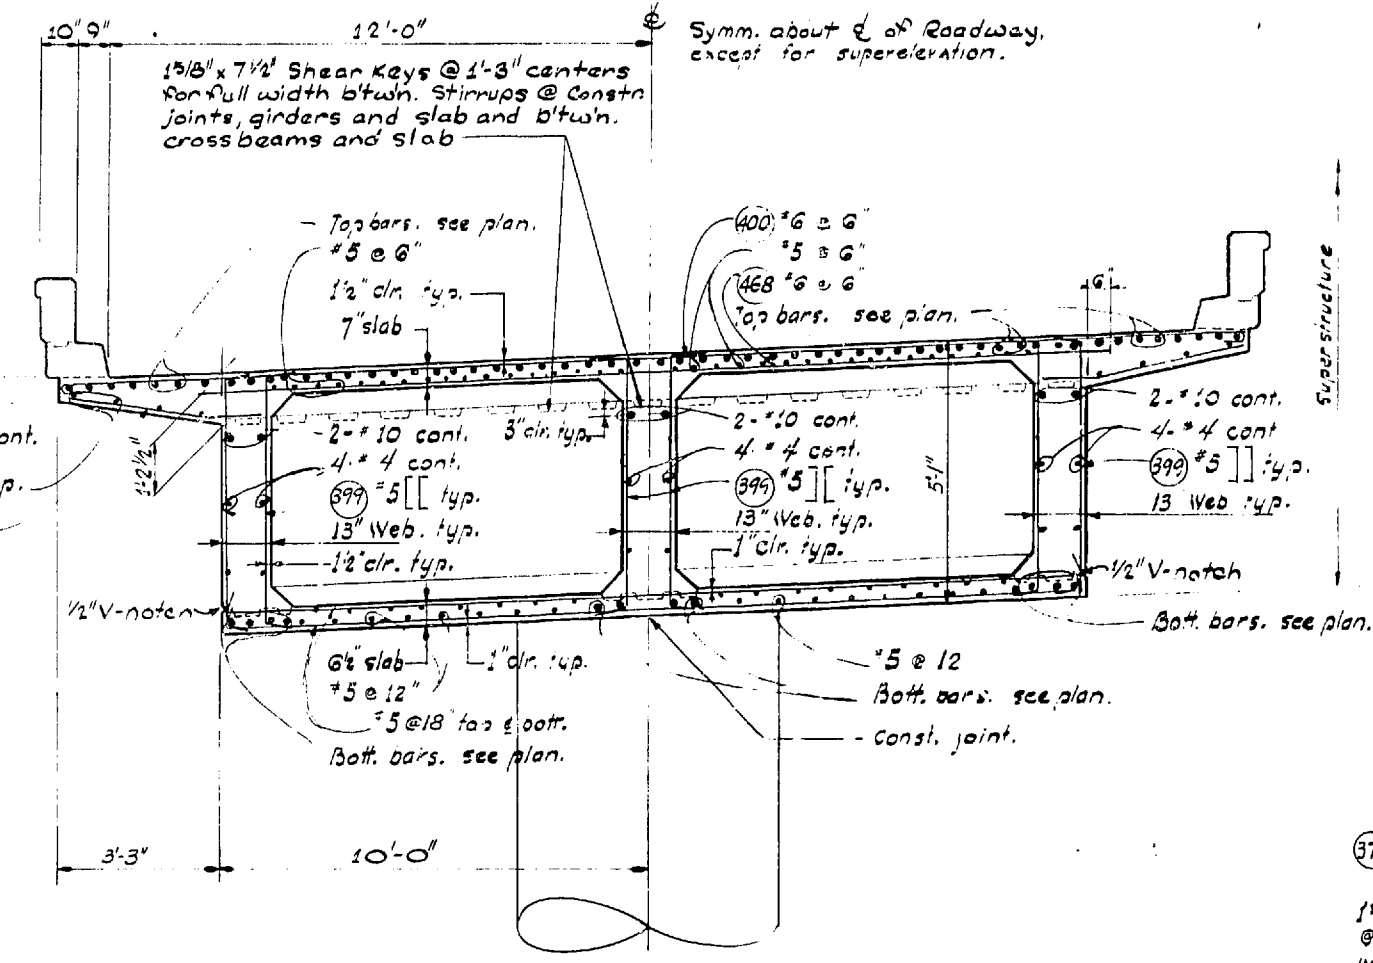


SECTION @ N-W PIERS 10 thru 12

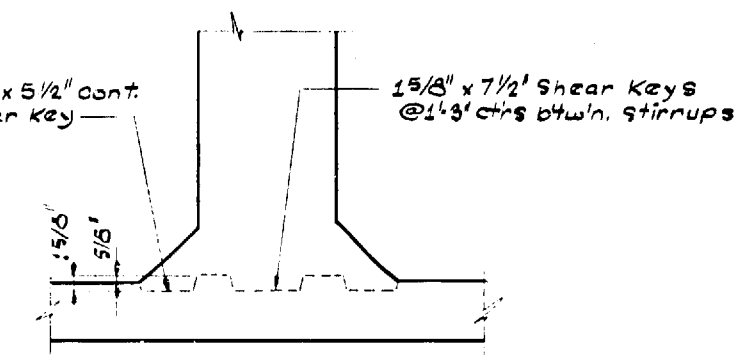


CONSTRUCTION JOINT AT BOTTOM SLAB

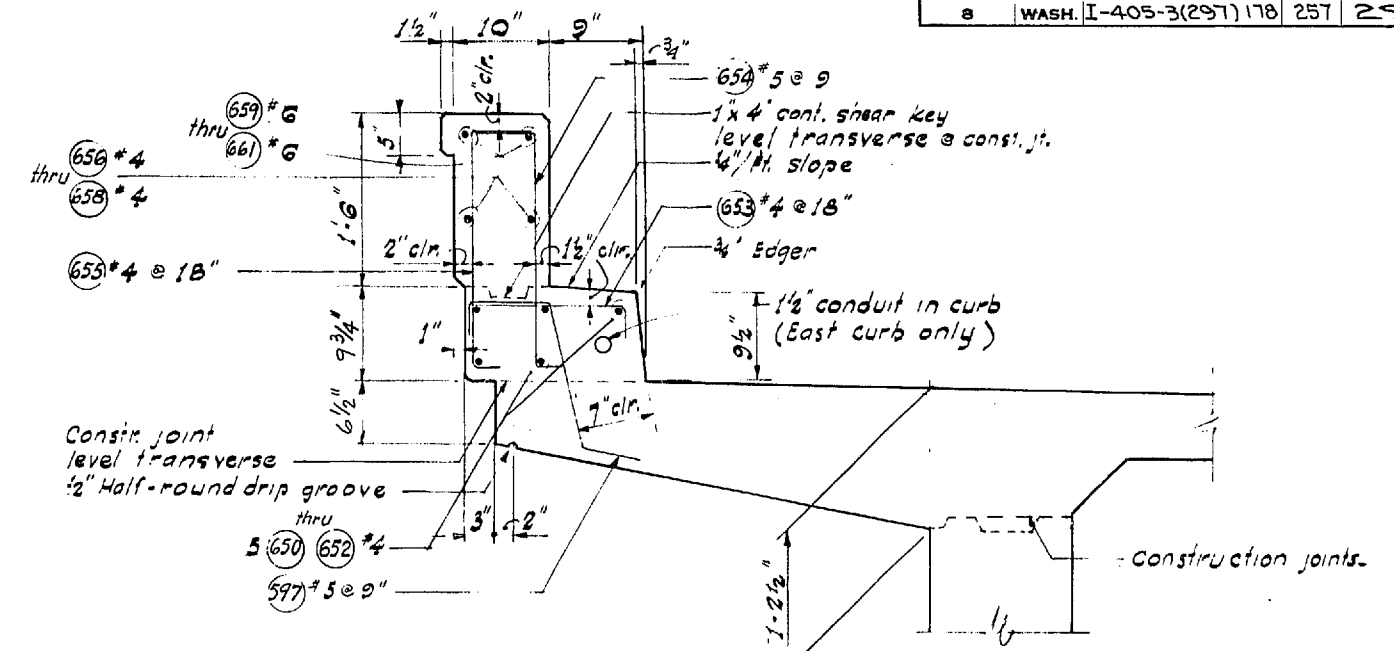


SECTION THRU CURB

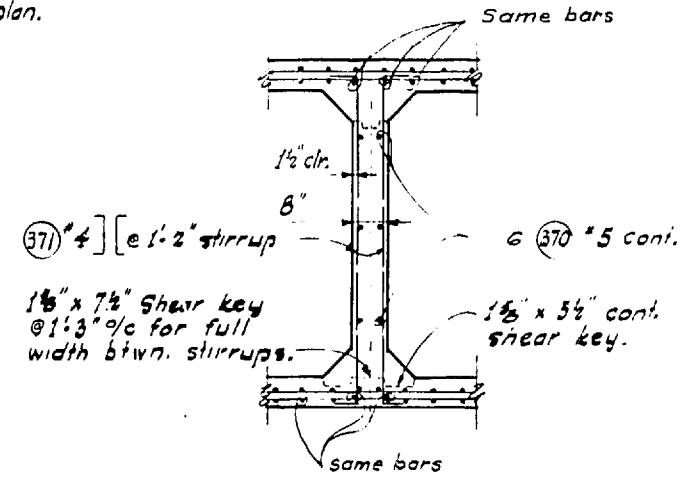


SECTION THRU DIAPHRAGM (TYPICAL ALL UNITS)

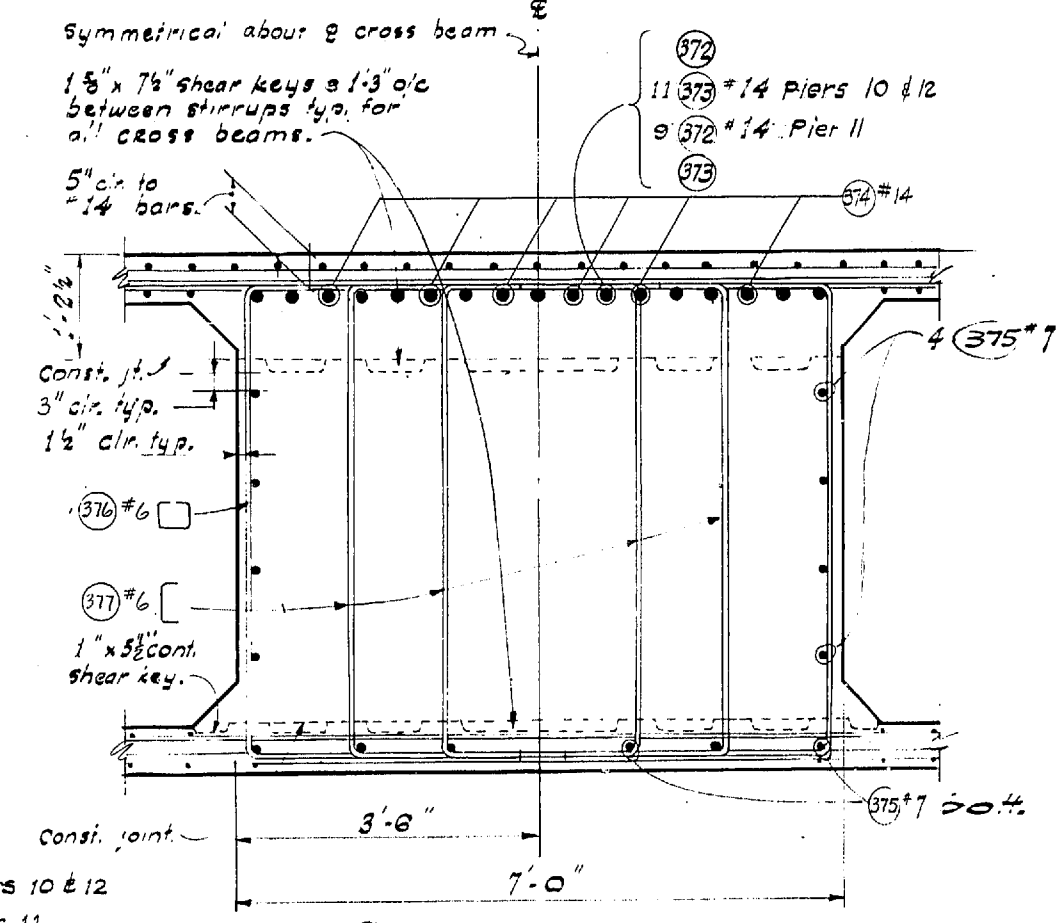

SECTION A-A

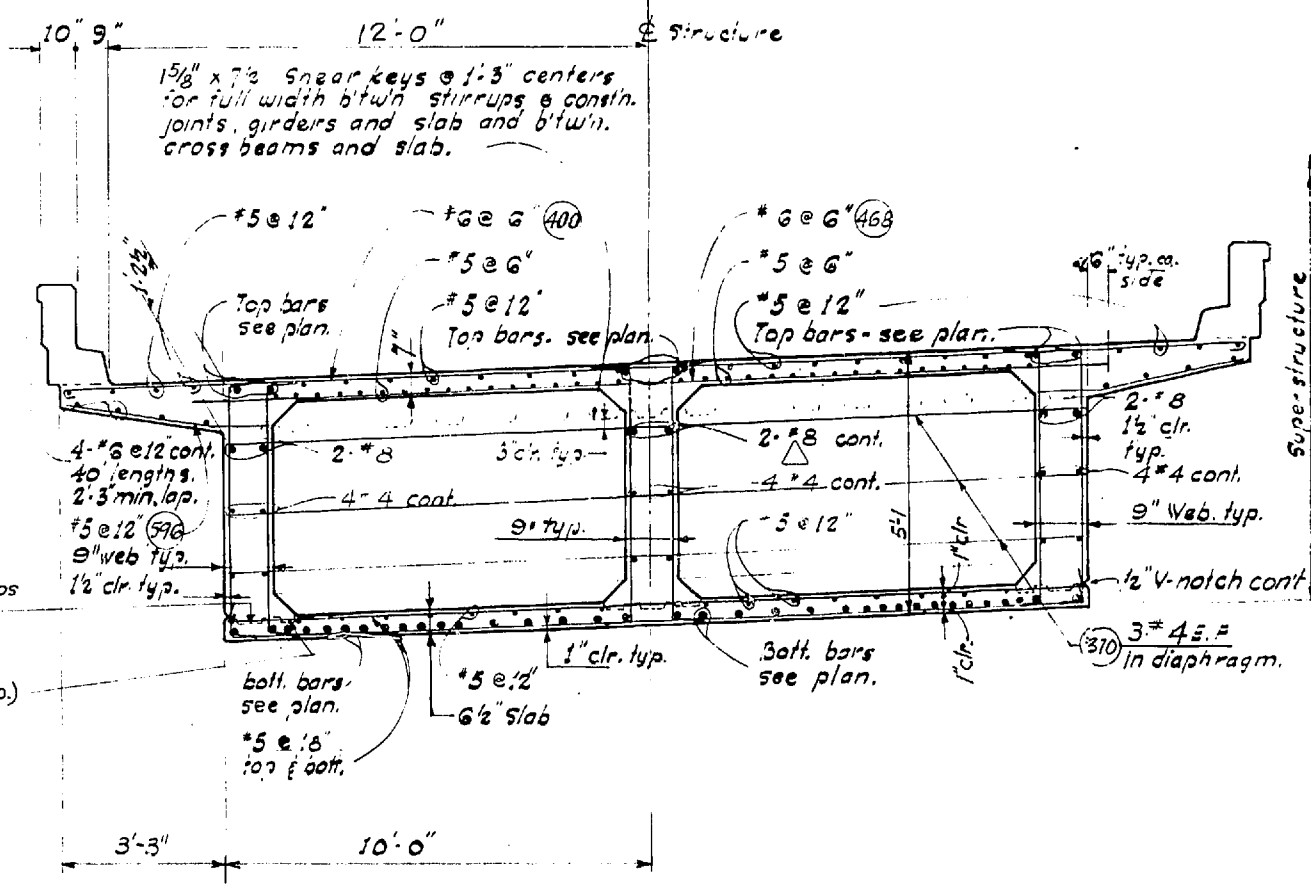

SECTION NEAR 2/3 OF SPAN

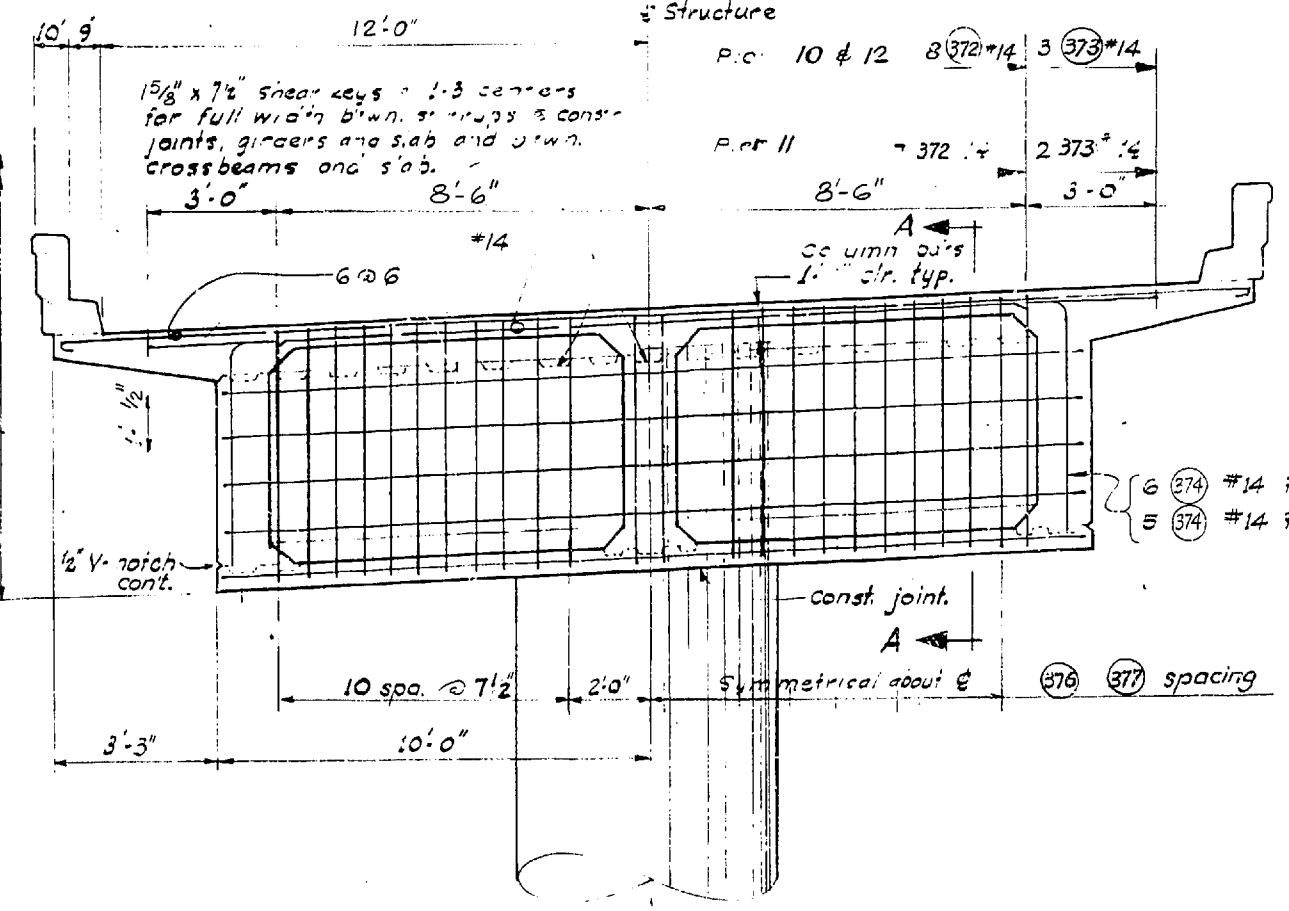

CROSS BEAM @ PIERS 10 thru 12

DESIGNED BY	
CHECKED BY	
QUANTITIES CHECKED	

81

TRANSVERSE CROSS SECTIONS

DATE	
BY	
CHECKED	
DATE	

WOODVILLE INTERCHANGE
 PSH NO. 1-RE/PSH NO. 2-BO
 N-W STRUCTURE
 TRANSVERSE SECTIONS
 SHEET 249 OF 257
 11-16-67

2-7-68 Revised bar size

DATE	REVISION	BY

WORTHINGTON, SKILLING
 HELLE & JACKSON
 Consulting Civil and Structural Engineers
 SEATTLE WASHINGTON

SR 405
 MP 23.49 TO MP 23.76
 WOODVILLE INTERCHANGE
 KING COUNTY
 N-W & N-E STRUCTURE
 TRANSVERSE SECTIONS

WASHINGTON STATE HIGHWAY COMMISSION
 DEPARTMENT OF HIGHWAYS
 OLYMPIA, WASHINGTON

GEORGE D. ZAMM, CHAIRMAN

F. E. HIFALSON
 N. WALSH

BAKER PERSSON
 JOHN H. RUFF


APPROVED December 7, 1967
 SHEET 257 OF 297 SHEETS
 CONTRACT NO. 8382

9/1996

DESIGNED	ENGINEER
CHECKED	DESIGNER
QUANTITIES CHECKED	QUANTITIES ENGINEER

DATE	
BY	
CHECKED	
LOC. ENGR.	
DIST. ENGR.	

WOODVILLE INTERCHANGE
 PSH NO. 1-RE/PSH NO. 2-BO
 N-W STRUCTURE
 ROADWAY SLAB
 SHEET 250 OF 289
 11-16-67

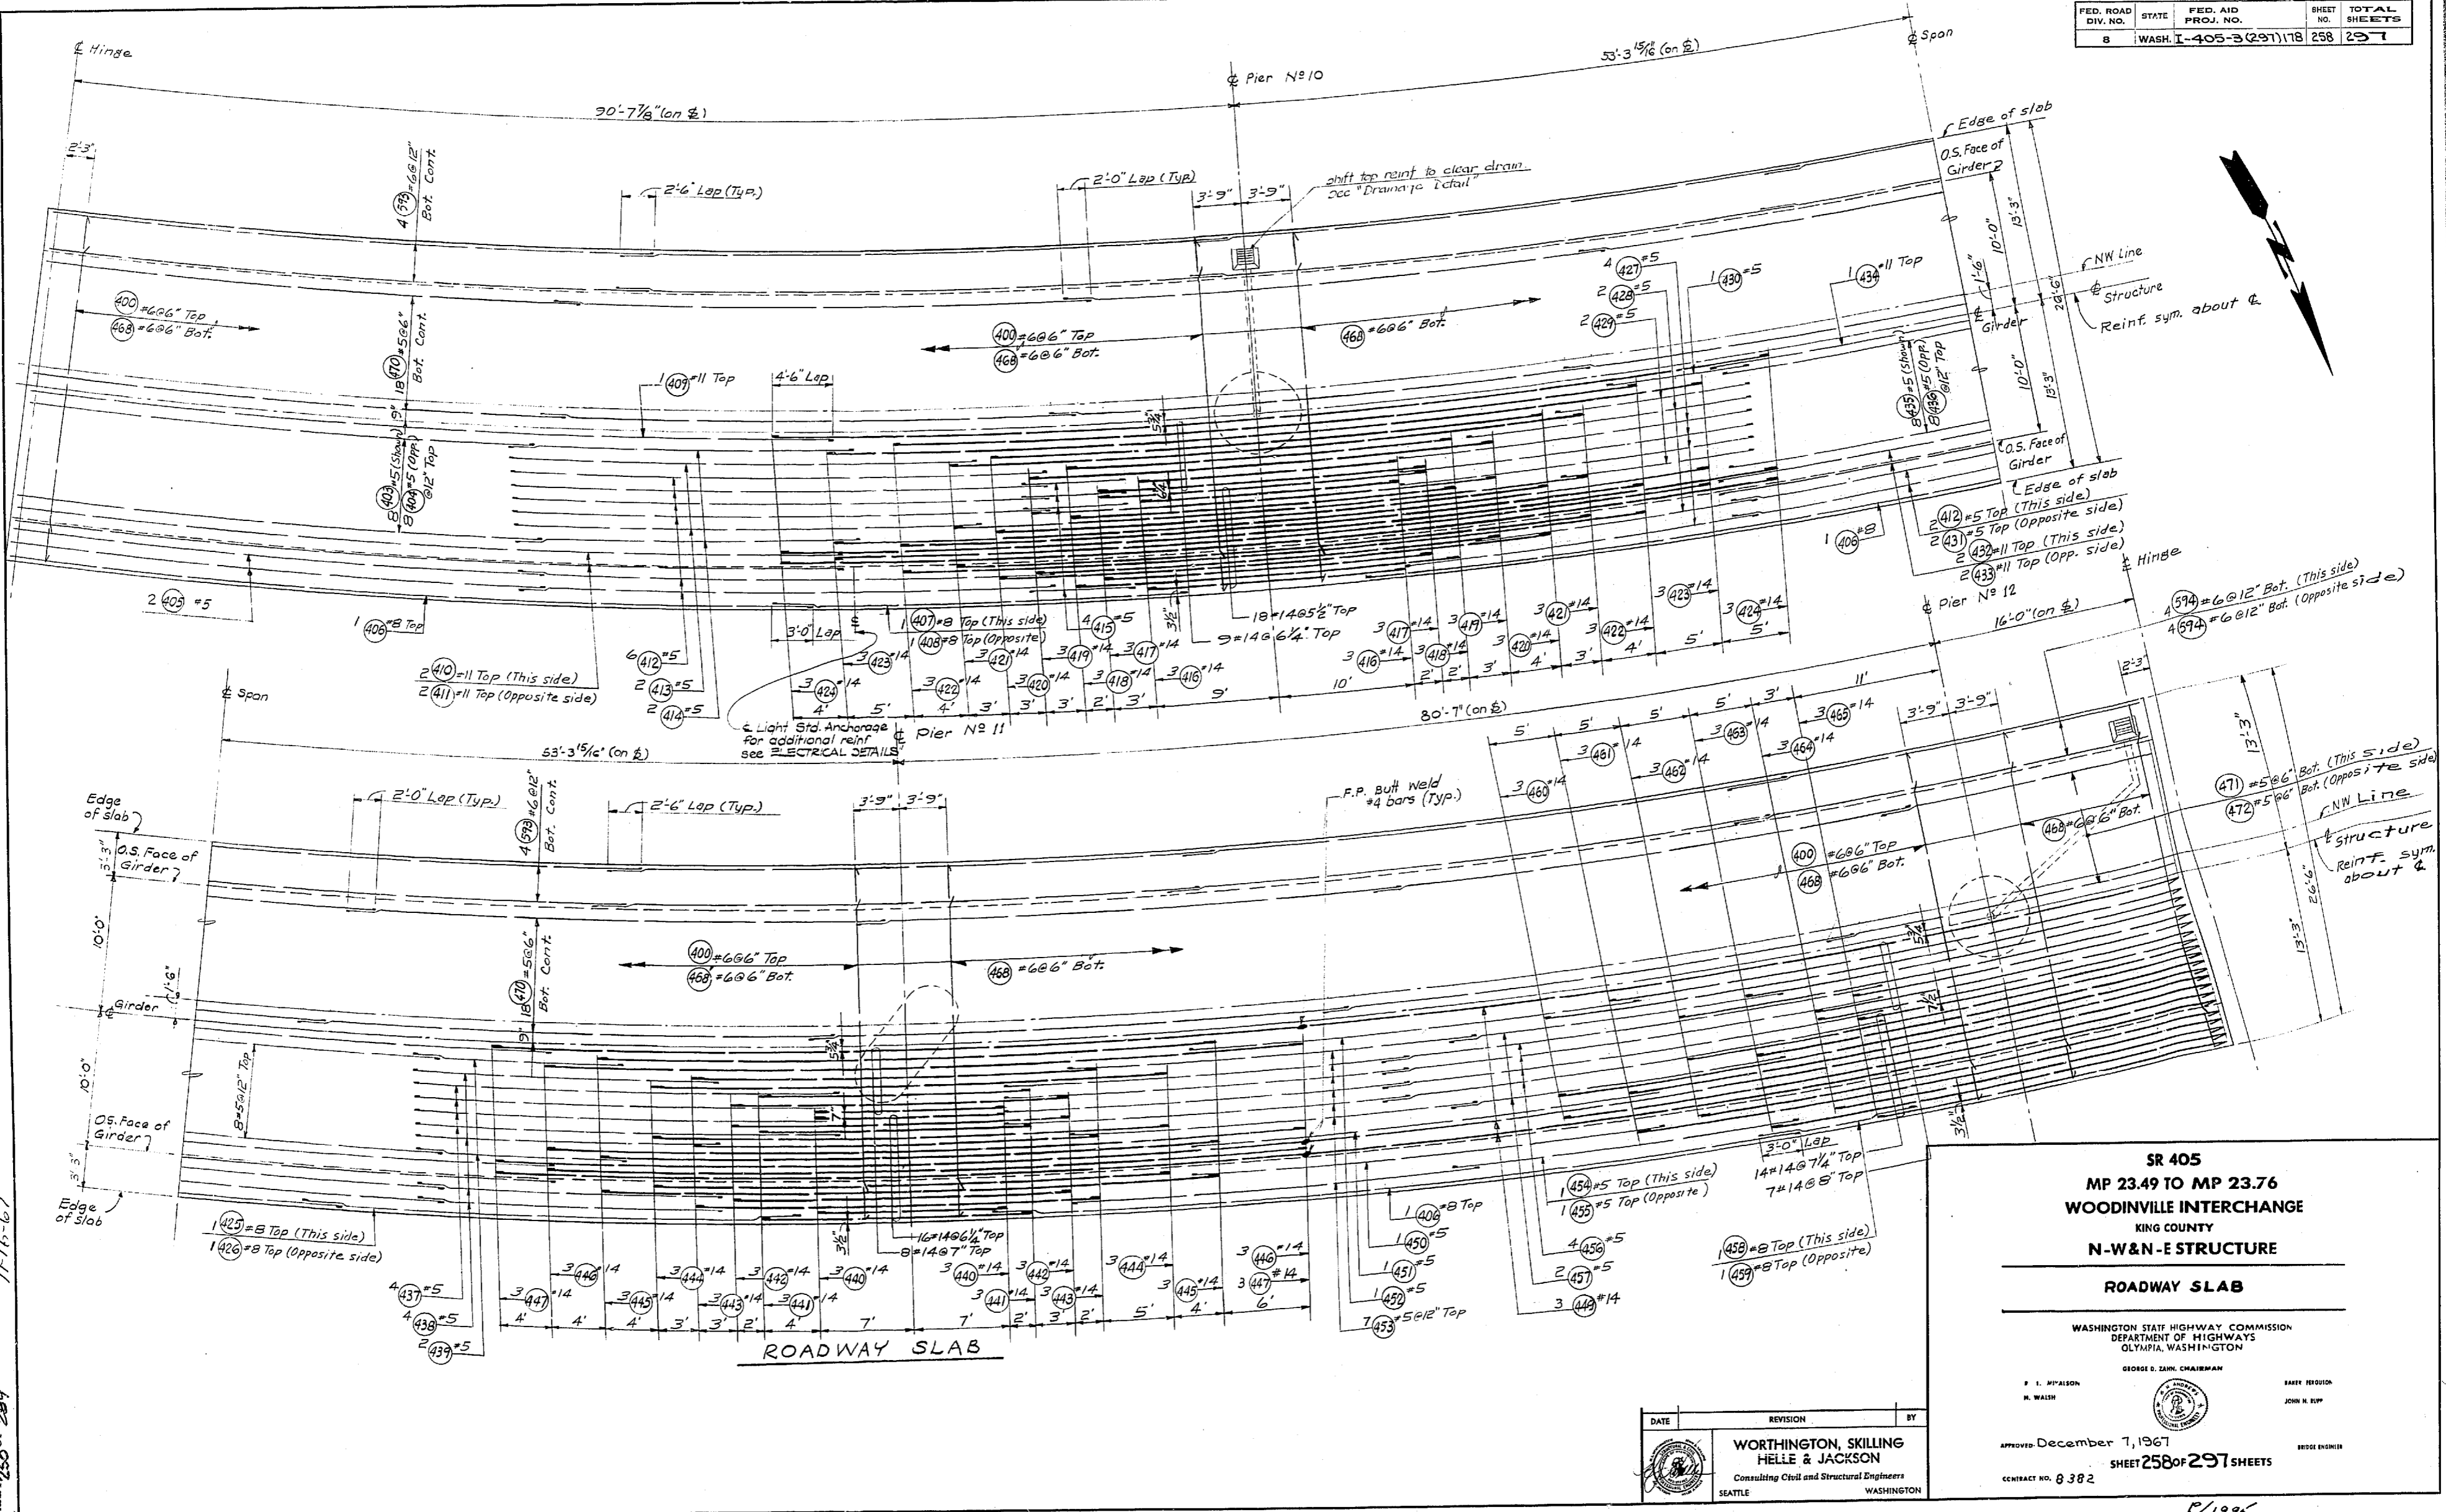

SR 405
MP 23.49 TO MP 23.76
WOODVILLE INTERCHANGE
 KING COUNTY
N-W & N-E STRUCTURE

ROADWAY SLAB

WASHINGTON STATE HIGHWAY COMMISSION
 DEPARTMENT OF HIGHWAYS
 OLYMPIA, WASHINGTON



GEORGE D. ZANK, CHAIRMAN
 F. I. M'ALSON, H. WALSH
 EARLE FERGUSON, JOHN H. RUFF

APPROVED December 7, 1967
 SHEET 258 OF 297 SHEETS
 CONTRACT NO. 8 382

DATE	REVISION	BY

**WORTHINGTON, SKILLING
 HELLE & JACKSON**
 Consulting Civil and Structural Engineers
 SEATTLE WASHINGTON

P/1995

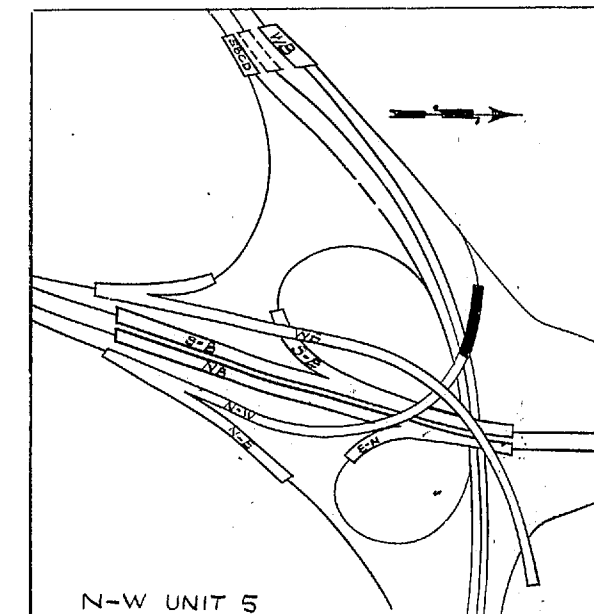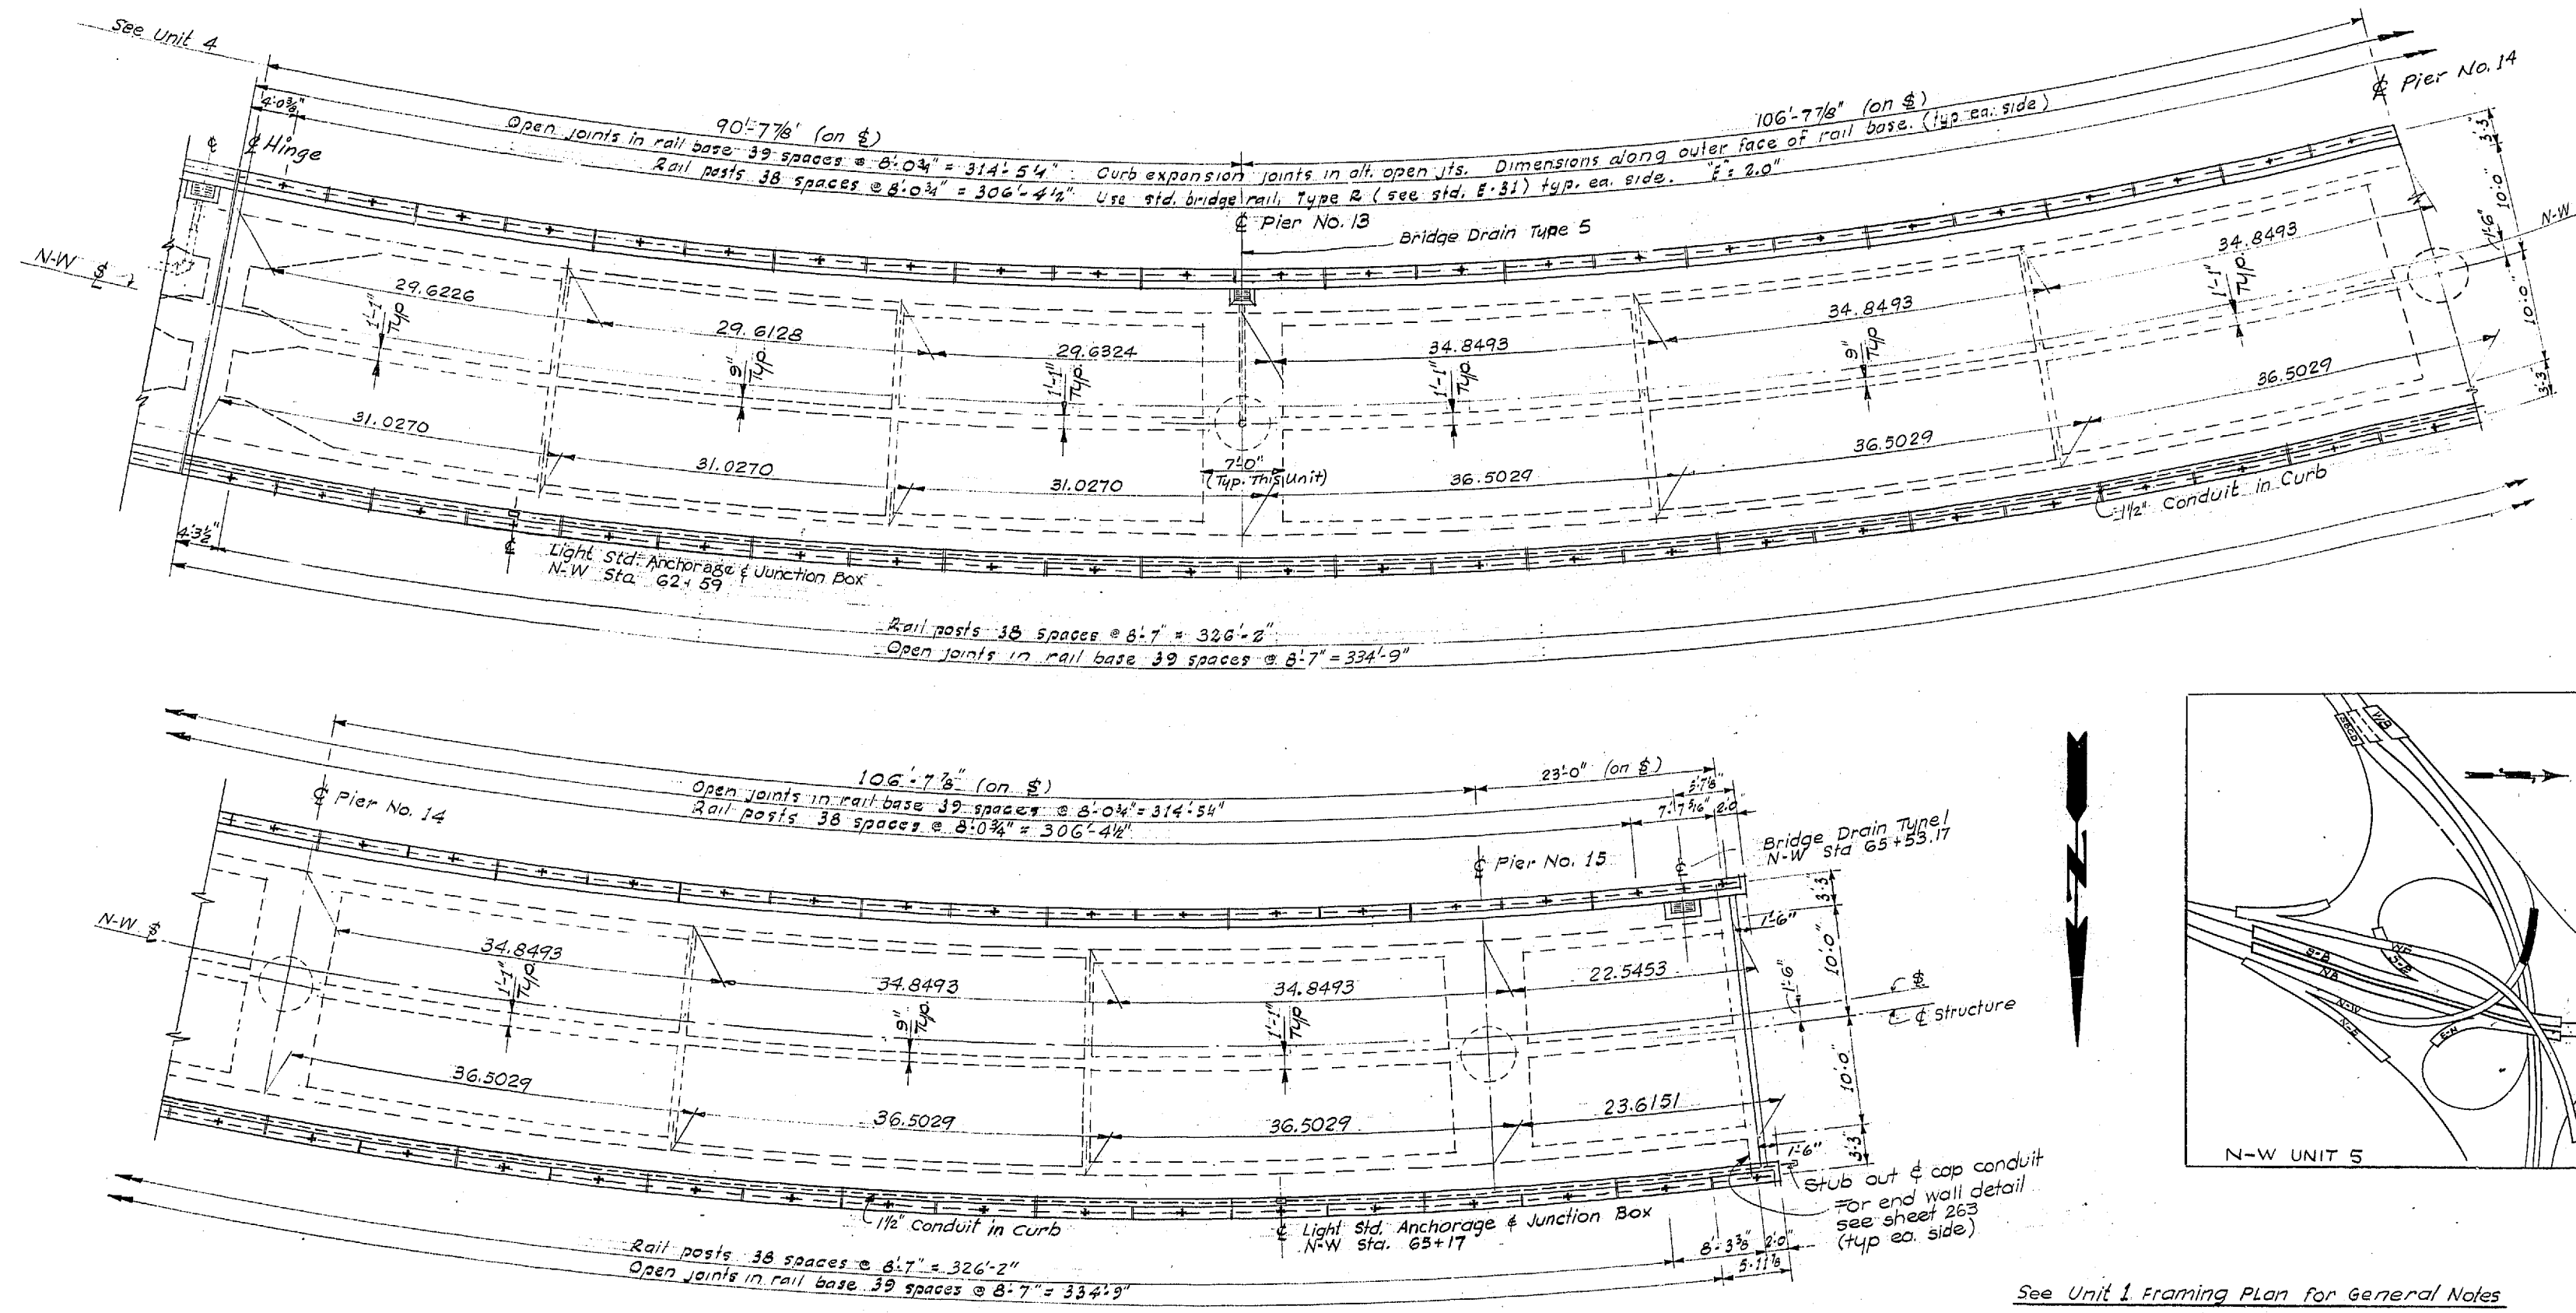

FRAMING PLAN

See Unit 1 Framing Plan for General Notes

SR 405
 MP 23.49 TO MP 23.76
 WOODINVILLE INTERCHANGE
 KING COUNTY
 N-W&N-E STRUCTURE

FRAMING PLAN

WASHINGTON STATE HIGHWAY COMMISSION
 DEPARTMENT OF HIGHWAYS
 OLYMPIA, WASHINGTON

GEORGE D. ZAHN, CHAIRMAN

F. L. McALISON
 H. WALSH



BAKER FERDINON
 JOHN H. RUPP

APPROVED December 7, 1967

SHEET 259 OF 297 SHEETS

CONTRACT NO. 8382

BRIDGE ENGINEER

DATE	REVISION	BY

WORTHINGTON, SKILLING
 HELLE & JACKSON
 Consulting Civil and Structural Engineers
 SEATTLE WASHINGTON

DESIGNED	
CHECKED	
QUANTITIES CHECKED	

DATE	
BY	
DRIVEN	
TRACED	
LOC. CORR.	
DIST. ENGR.	

WOODINVILLE INTERCHANGE
 SR 405
 N-W STRUTTING
 FRAMING PLAN
 SHEET 251 OF 289
 11-16-67



P/1995

FED. ROAD DIV. NO.	STATE	FED. AID PROJ. NO.	SHEET NO.	TOTAL SHEETS
8	WASH.	I-405-3(291)18	260	297

DESIGNING ENGINEER	
DESIGN CHECKED	
DRAWN BY	
QUANTITIES FIGURED	
QUANTITIES CHECKED	

DATE	
BY	
DRAWN	
TRACED	
CHECKED	
DATE	

WOODVILLE INTERCHANGE
 PSH NO. 1-RE/PSH NO. 2-BO
 N-W STRUCTURE
 BOTTOM SLAB
 SHEET 25 OF 289
 11-16-67

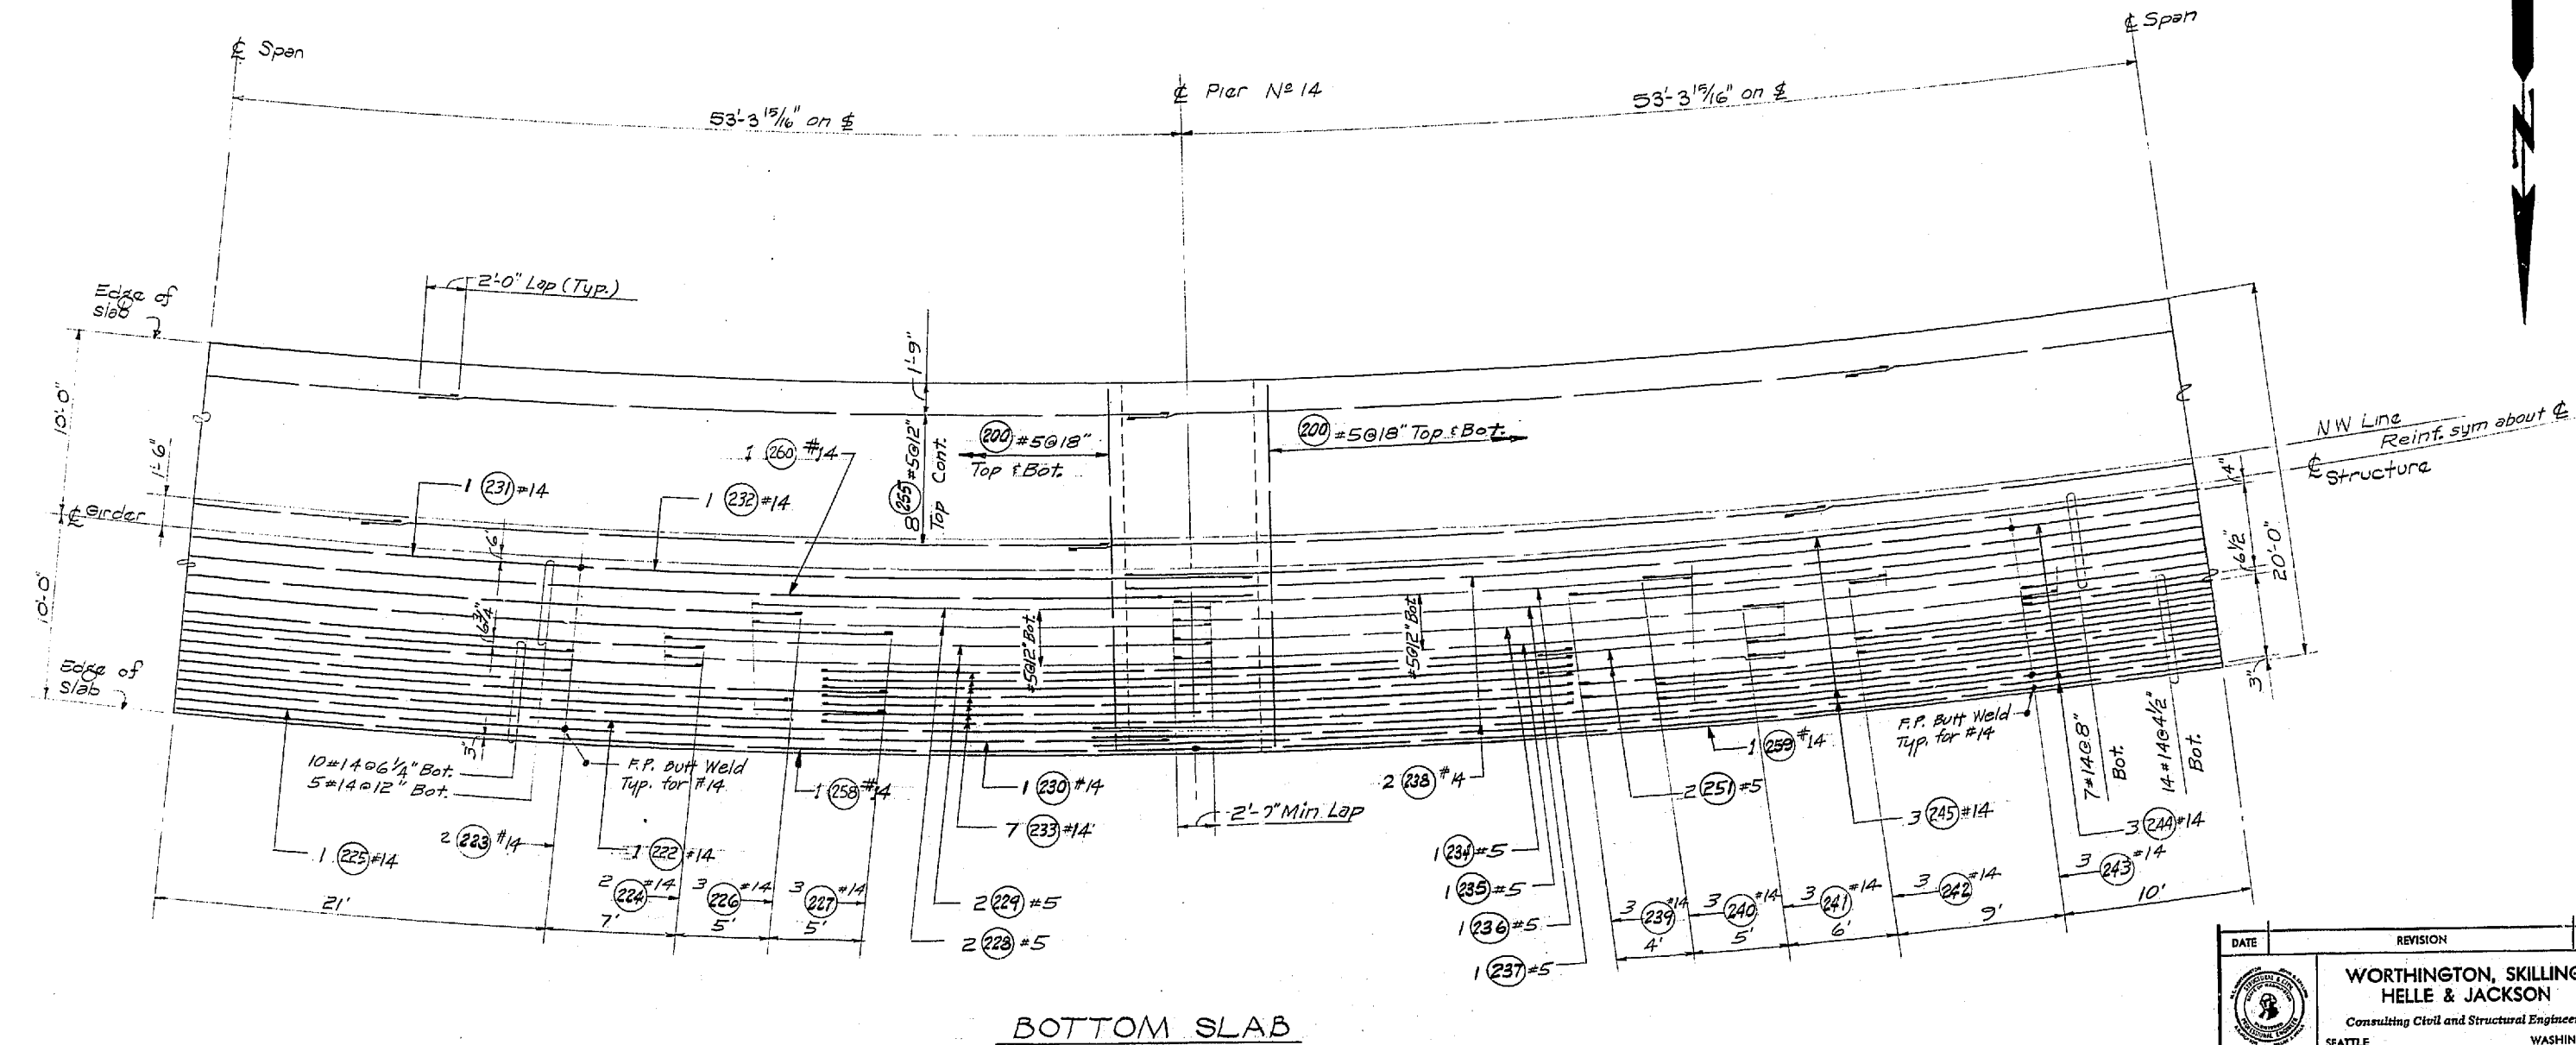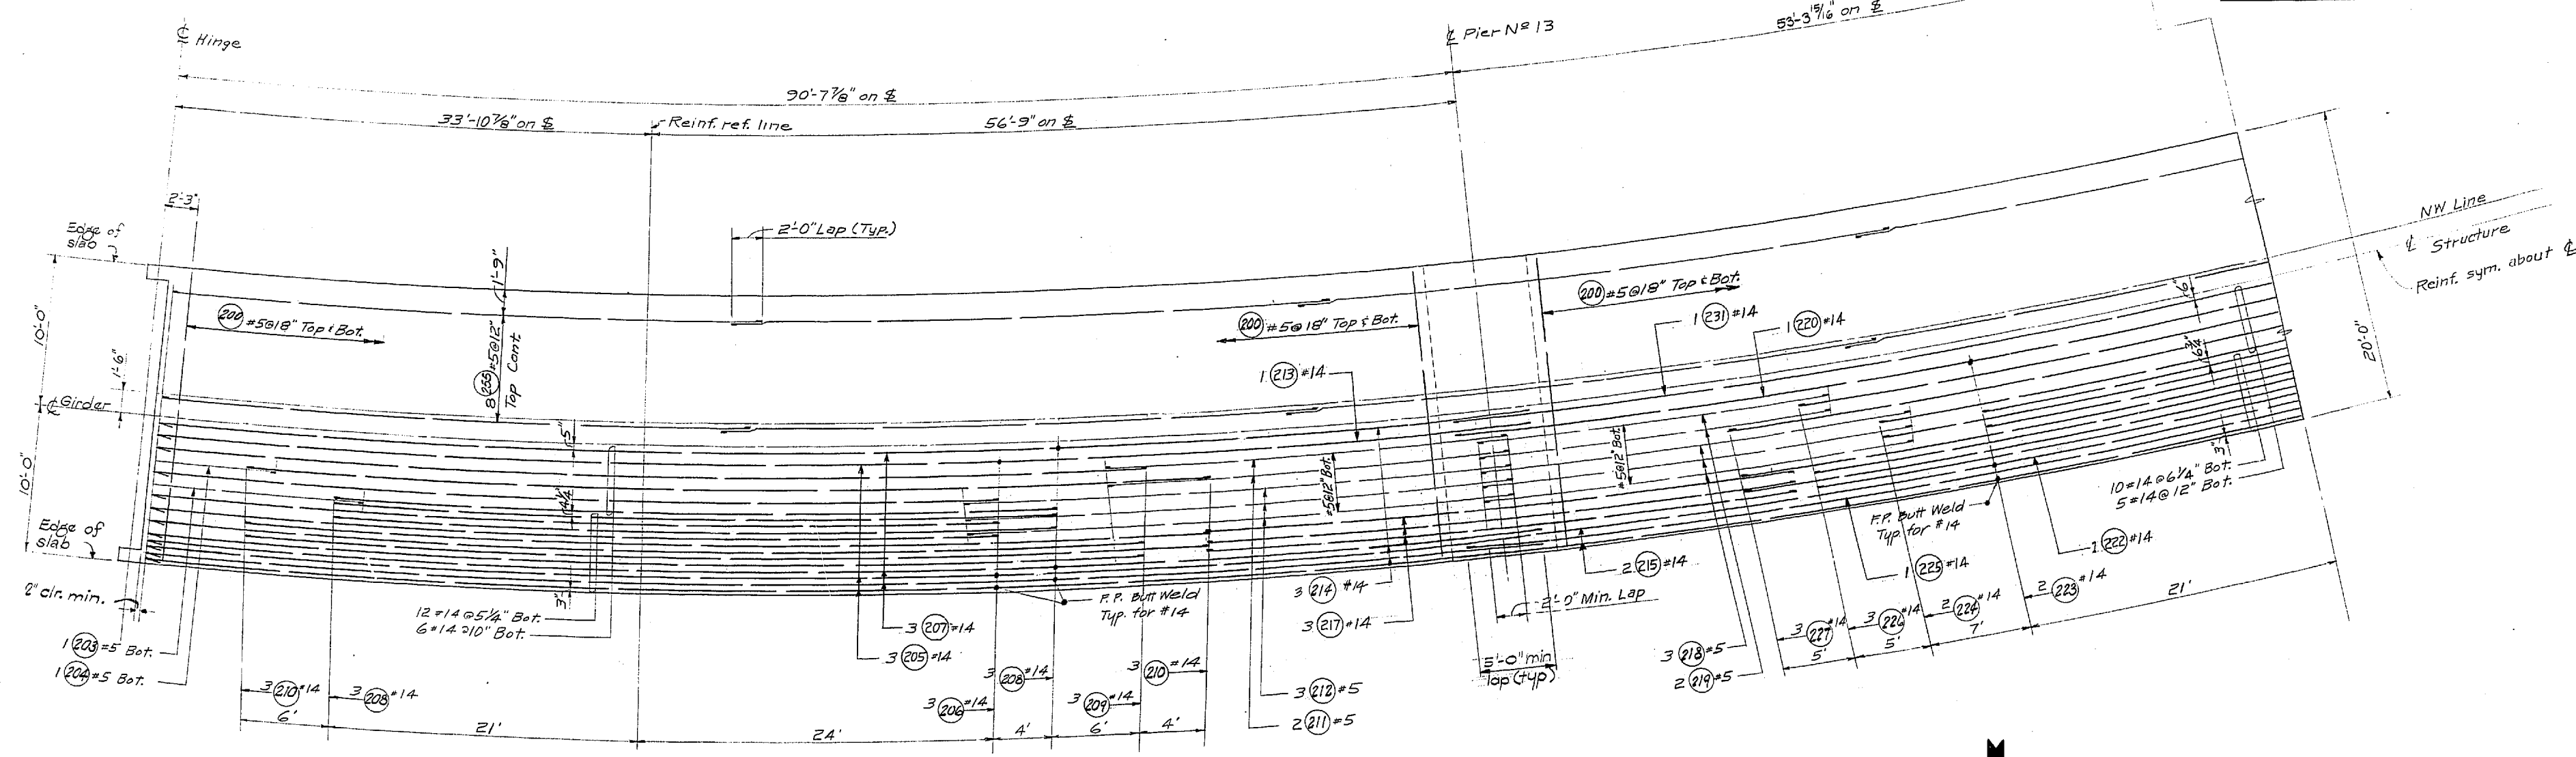

For Bar Weld and Cell Drain Detail, see "BOTTOM SLAB" UNIT 1. For D.L. Camber Curve, see next sheet.

DATE	REVISION	BY

WORTHINGTON, SKILLING
 HELLE & JACKSON
 Consulting Civil and Structural Engineers
 SEATTLE WASHINGTON

SR 405
 MP 23.49 TO MP 23.76
 WOODVILLE INTERCHANGE
 KING COUNTY
 N-W & N-E STRUCTURE

BOTTOM SLAB

WASHINGTON STATE HIGHWAY COMMISSION
 DEPARTMENT OF HIGHWAYS
 OLYMPIA, WASHINGTON

GEORGE D. ZAHN, CHAIRMAN
 BAKER FERGUSON
 JOHN N. RUPP
 BRIDGE ENGINEER



APPROVED: December 7, 1967
 SHEET 260 OF 297 SHEETS
 CONTRACT NO. 8382

9/1995

FED. ROAD DIV. NO.	STATE	FED. AID PROJ. NO.	SHEET NO.	TOTAL SHEETS
8	WASH.	I-405-3(297)178	261	297

DESIGNING ENGINEER	
DESIGN CHECKED	
DRAWN BY	
CHECKED	
QUANTITIES CHECKED	

DATE	
BY	
DRAWN	
CHECKED	
DESIGN	

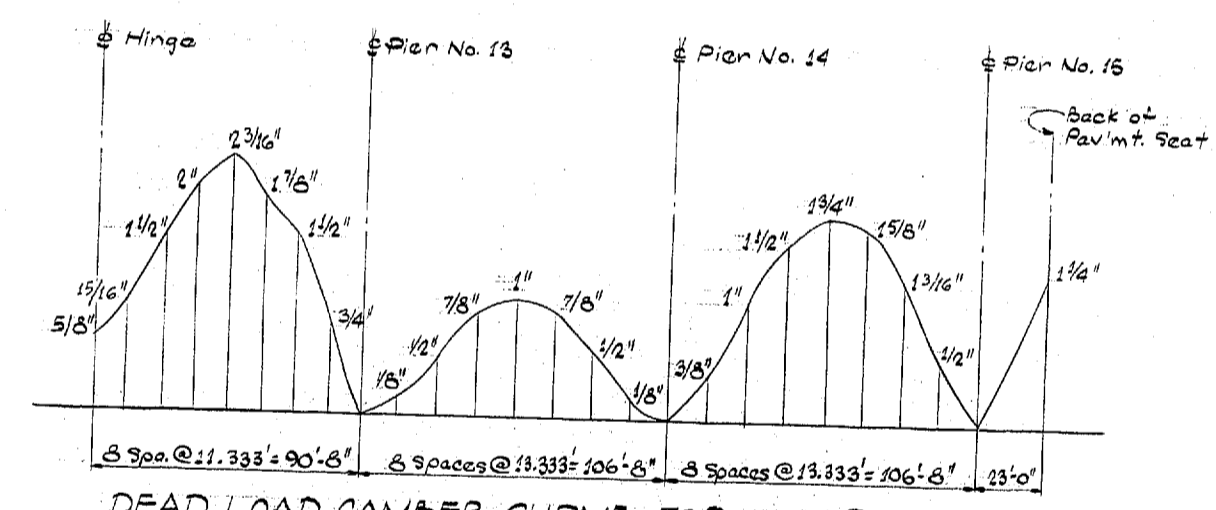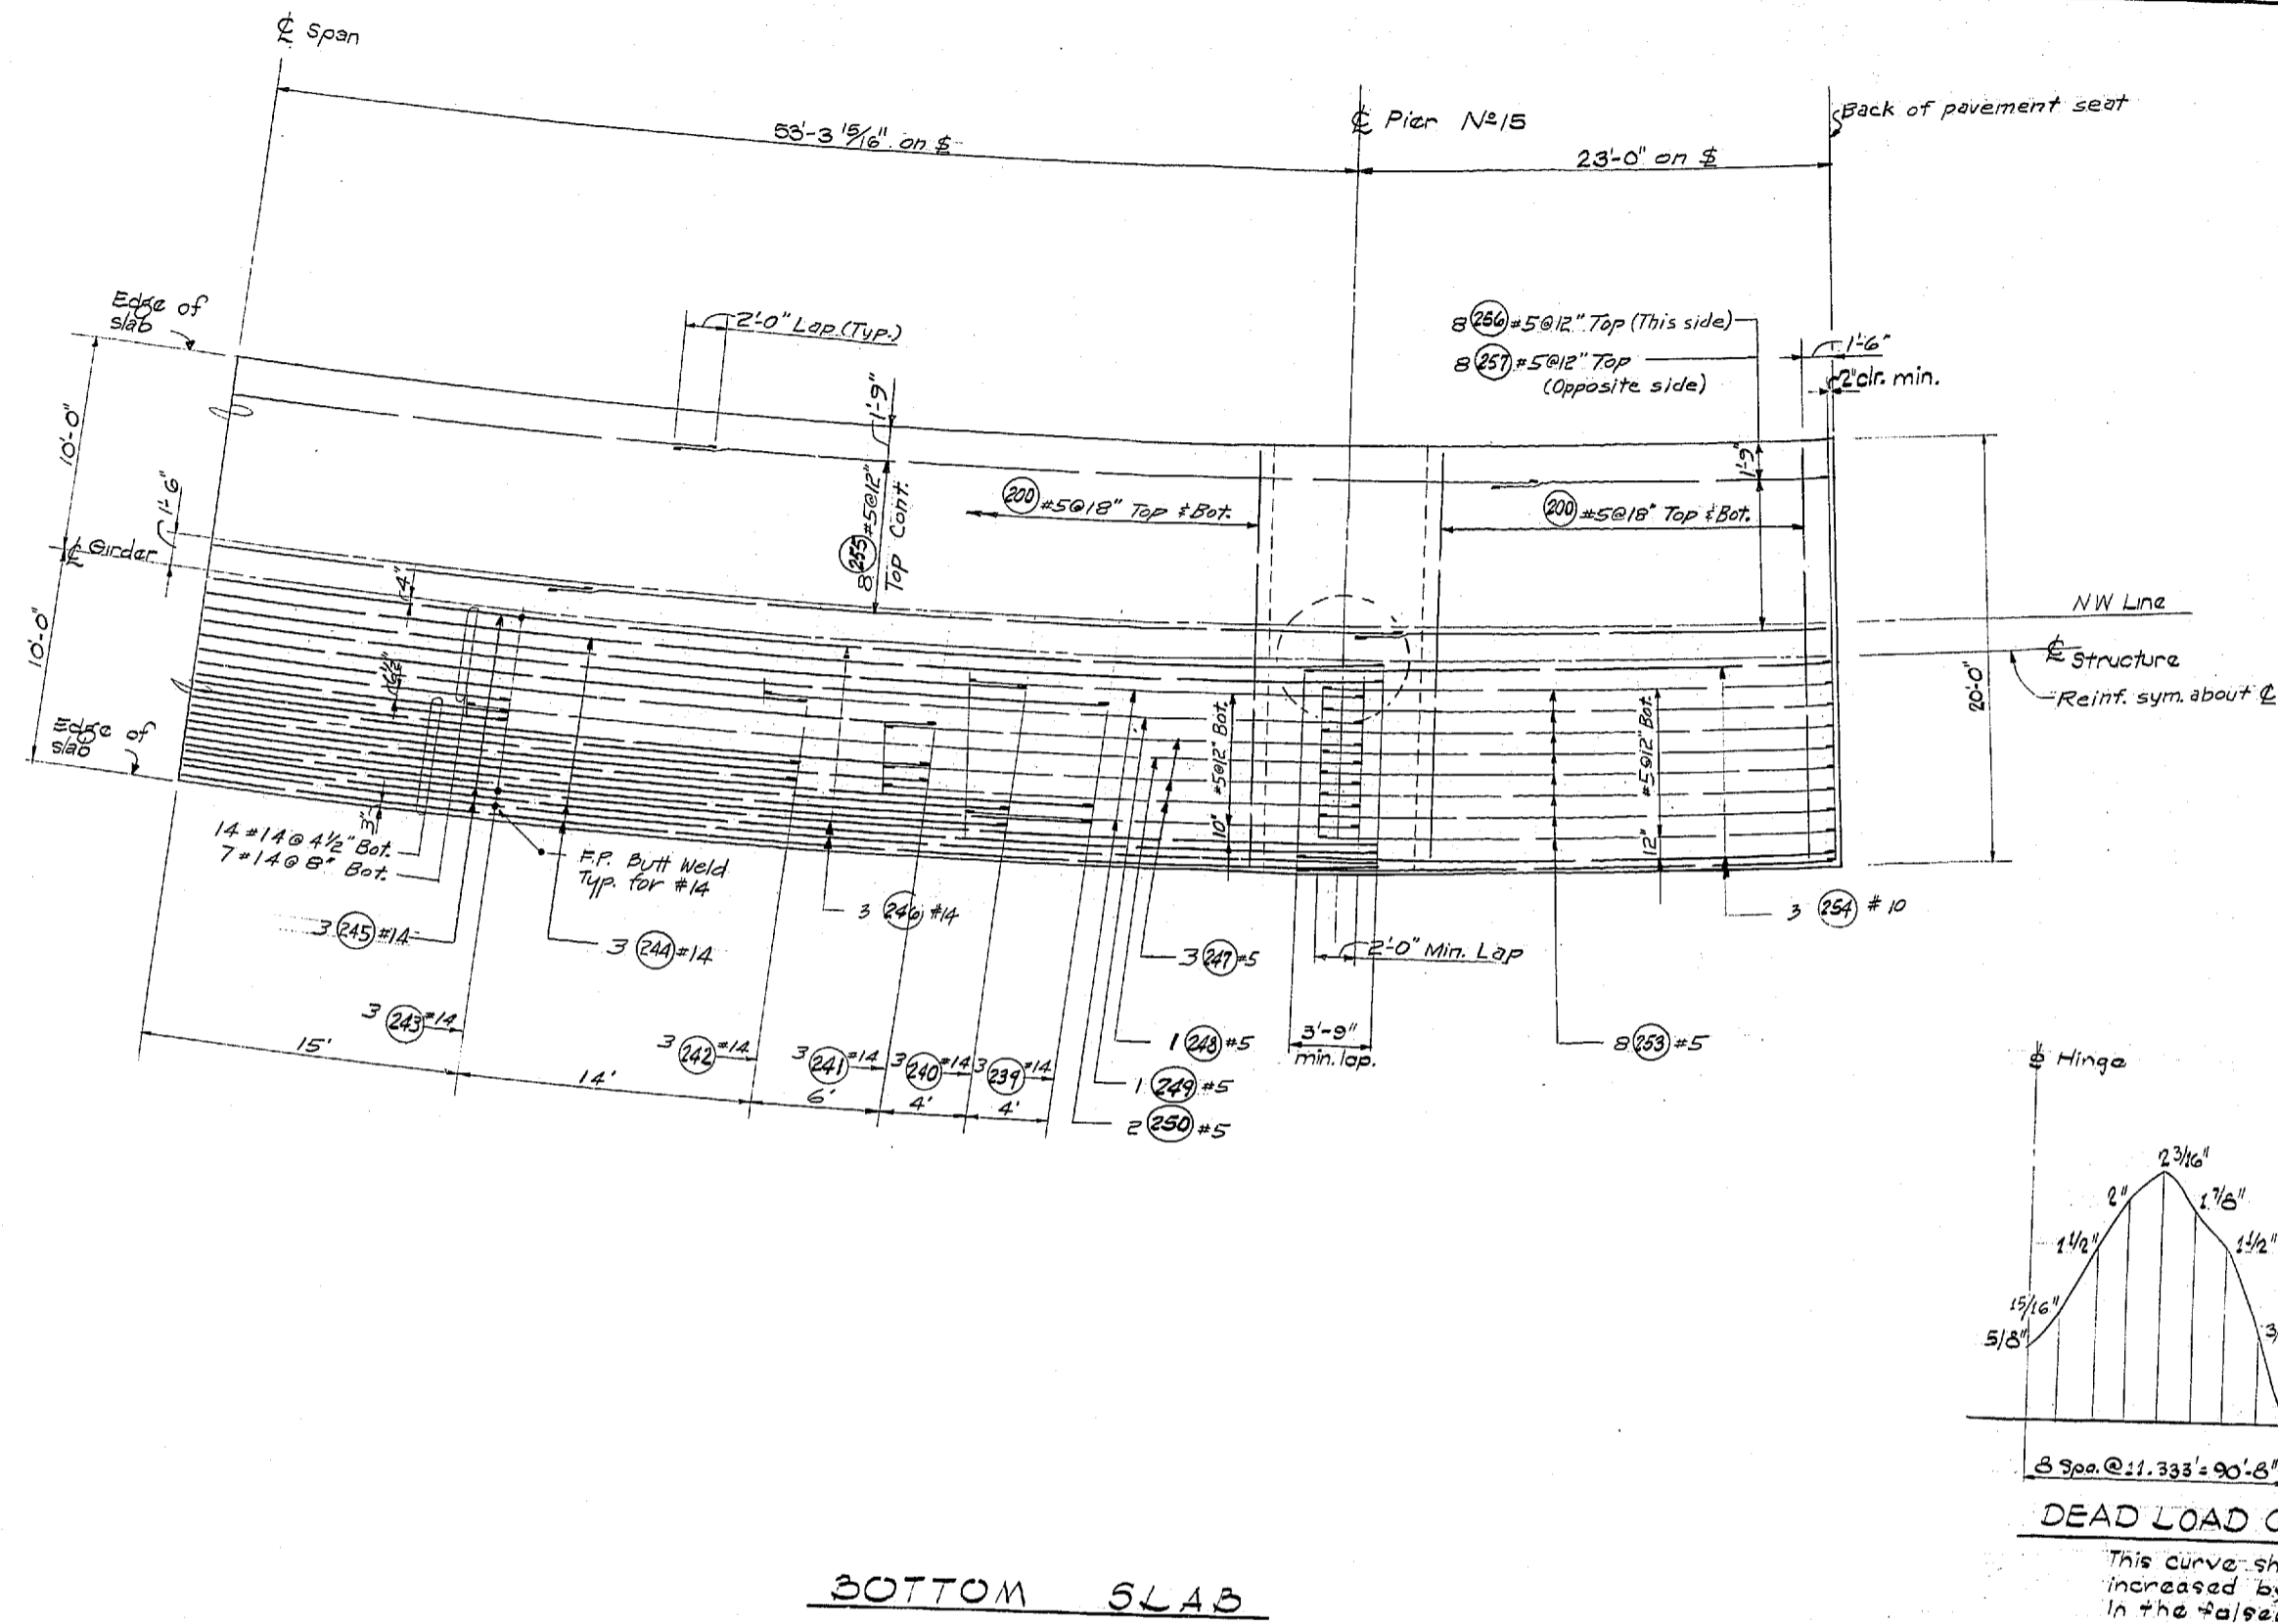

DEAD LOAD CAMBER CURVE FOR N-W RAMP
 This curve shows D.L. Camber only and should be increased by the amount of take-up anticipated in the falsework.

BOTTOM SLAB

WOODVILLE INTERCHANGE
 PSR NO. 1-RE/ESH NO. 2-BO
 N-W STRUCTURE 32-AB
 SHEET 253 OF 289
 11-1667

DATE	REVISION	BY

**WORTHINGTON, SKILLING
 HELLE & JACKSON**
 Consulting Civil and Structural Engineers
 SEATTLE WASHINGTON

**SR 405
 MP 23.49 TO MP 23.76
 WOODVILLE INTERCHANGE
 KING COUNTY
 N-W & N-E STRUCTURE**

BOTTOM SLAB




WASHINGTON STATE HIGHWAY COMMISSION
 DEPARTMENT OF HIGHWAYS
 OLYMPIA, WASHINGTON

GEORGE O. ZAHN, CHAIRMAN
 F. I. MITALSON, N. WALSH
 BAKER PERGUSON, JOHN H. RUFF

APPROVED: December 7, 1967
 SHEET 261 OF 297 SHEETS
 BRIDGE ENGINEER
 CONTRACT NO. 8382

1/19/95

FED. ROAD DIV. NO.	STATE	FED. AID PROJ. NO.	SHEET NO.	TOTAL SHEETS
8	WASH.	I-405-3(297)178	262	297

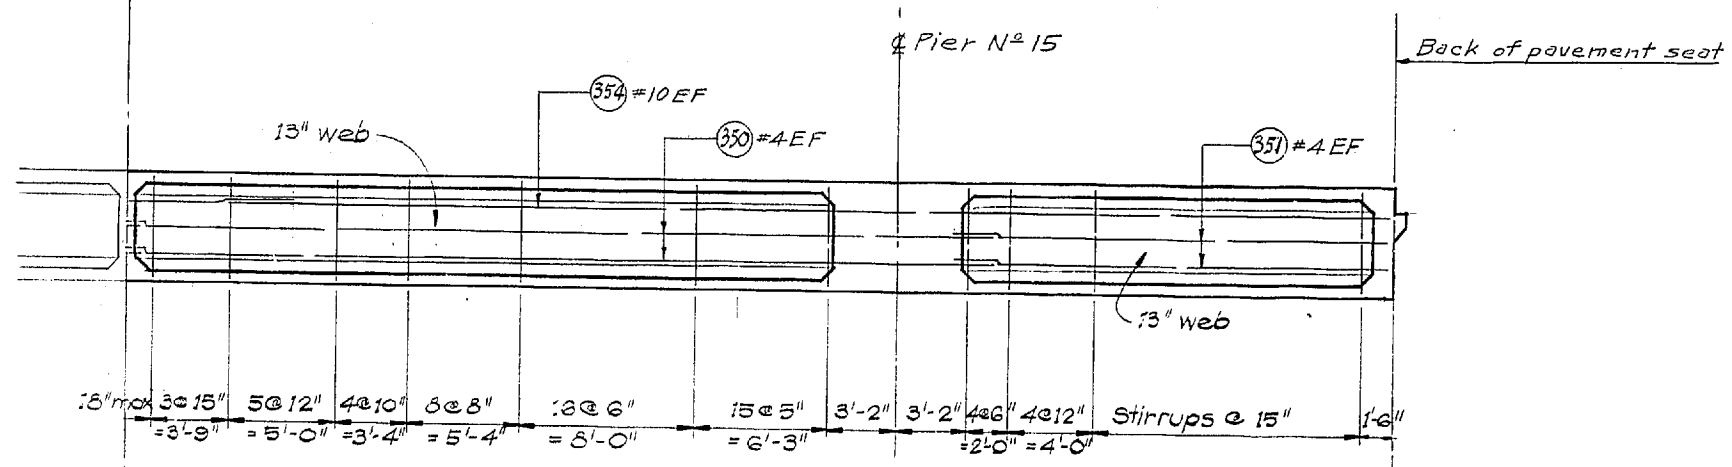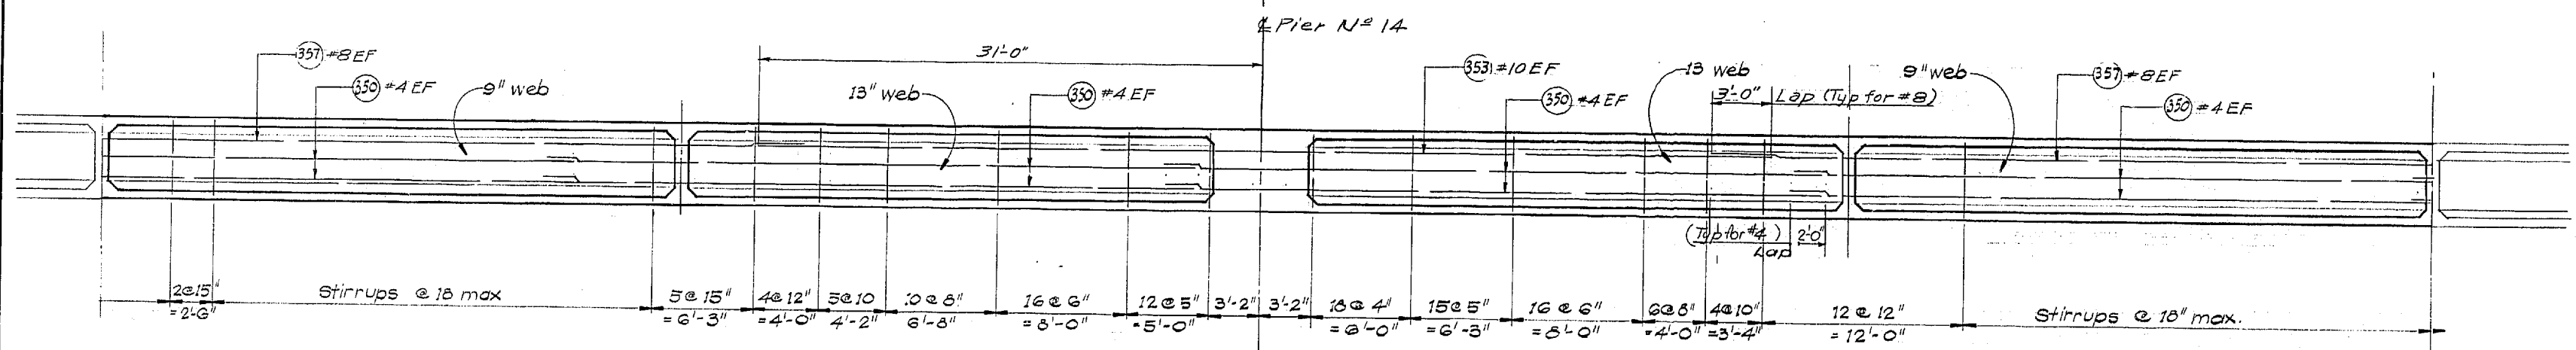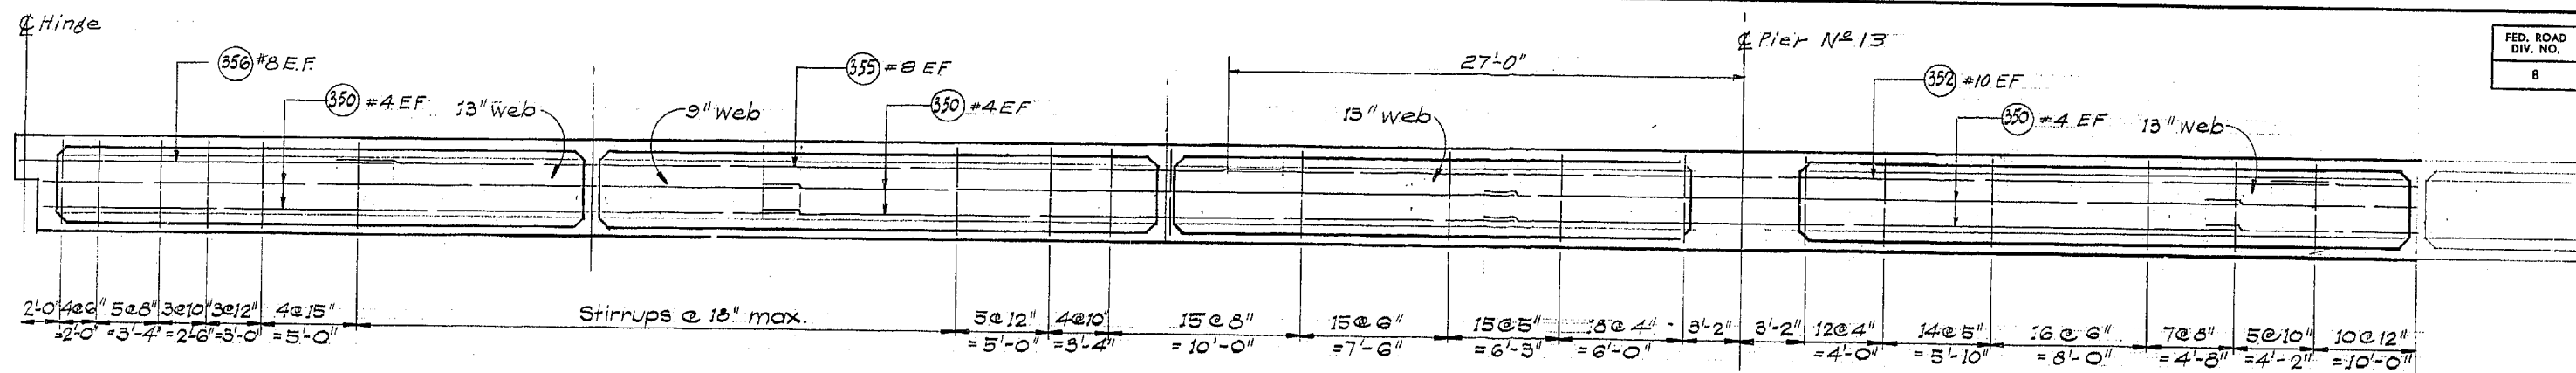

LONGITUDINAL SECTIONS

SR 405
MP 23.49 TO MP 23.76
WOODVILLE INTERCHANGE
KING COUNTY
N-W&N-E STRUCTURE

LONGITUDINAL SECTIONS

WASHINGTON STATE HIGHWAY COMMISSION
DEPARTMENT OF HIGHWAYS
OLYMPIA, WASHINGTON

GEORGE D. ZAHN, CHAIRMAN

F. L. MITALSON
H. WALSH

BAKER FERGUSON
JOHN N. RUPP

APPROVED: December 7, 1967

SHEET 262 OF 297 SHEETS

BRIDGE ENGINEER

CONTRACT NO. 8382

DATE	REVISION	BY

**WORTHINGTON, SKILLING
HELLE & JACKSON**
Consulting Civil and Structural Engineers
SEATTLE WASHINGTON

DESIGNED	
CHECKED	
QUANTITIES FIGURED	
QUANTITIES CHECKED	

DRAWN	
CHECKED	
DATE	

WOODVILLE INTERCHANGE
PSH NO. 1 RE/PSH NO. 2-BO
N-W & N-E STRUCTURE
SHEET 262 OF 297 SHEETS
11-16-67

9/1995

DESIGNED BY	
CHECKED BY	
QUANTITIES CHECKED	
DATE	



UNITS

TRANSVERSE CROSS SECTIONS


DATE	
BY	
CHECKED	
LOC. INCH.	
DATE	

SECTIONS 11-16-67


WOODVILLE INTERCHANGE
PSH NO. 1-R/PSH NO. 2-B0
STRUCTURE
SHEET 263 OF 297

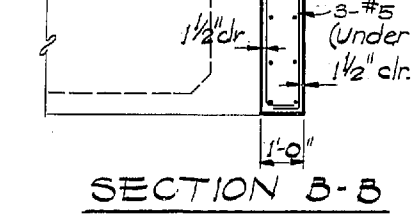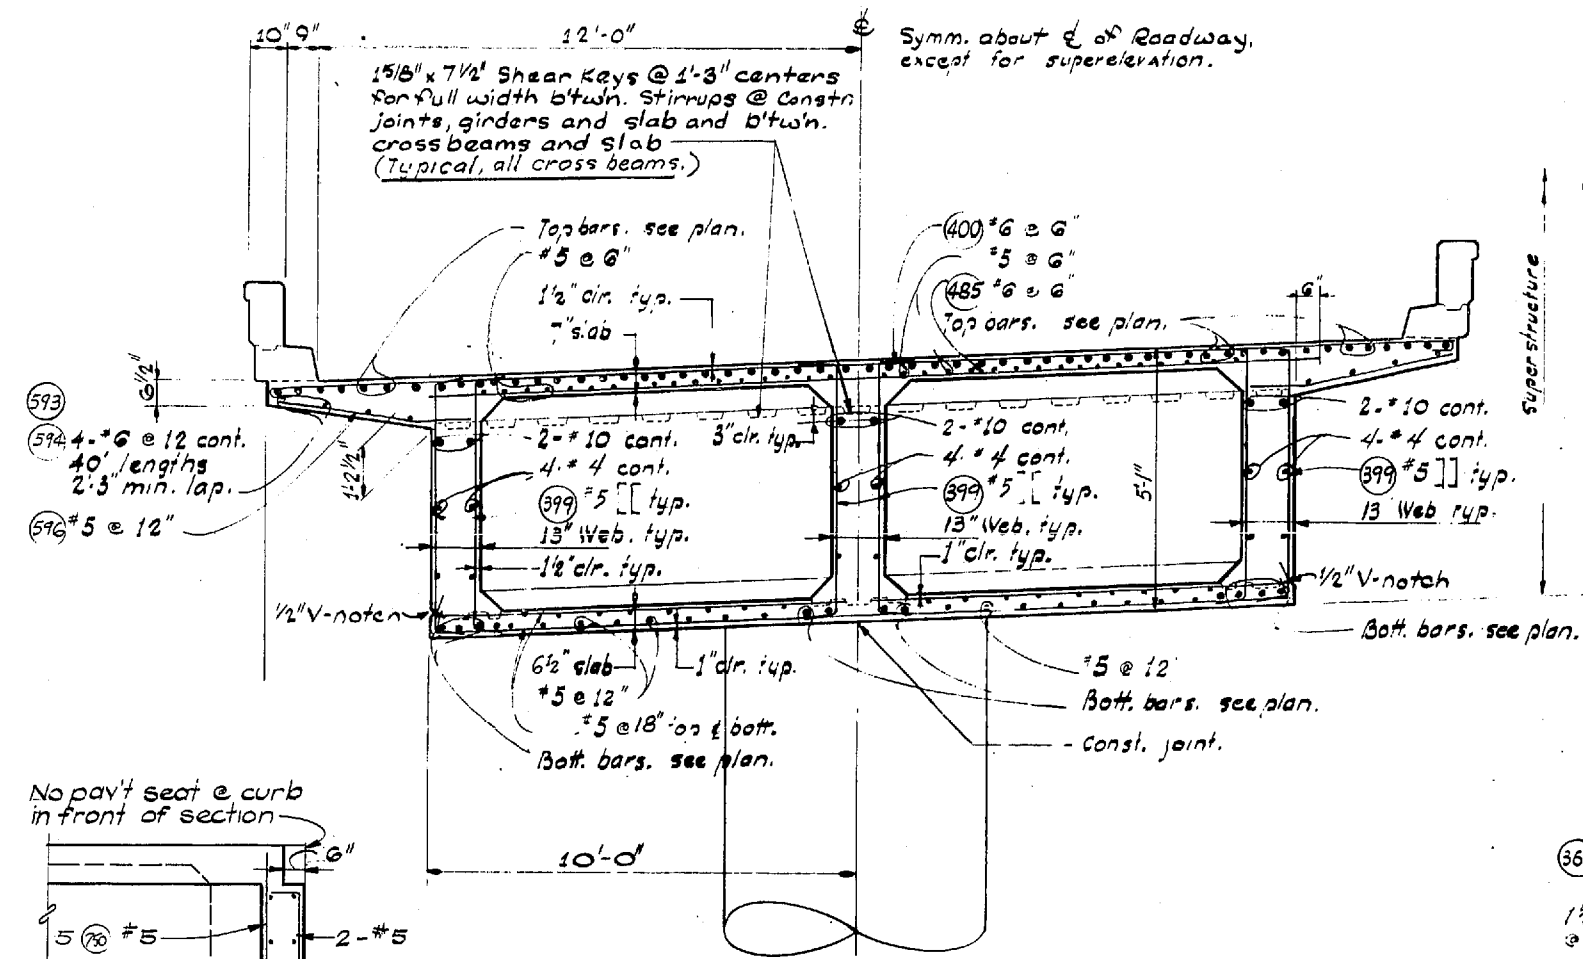


SECTION @ N-W PIERS 13 thru 15

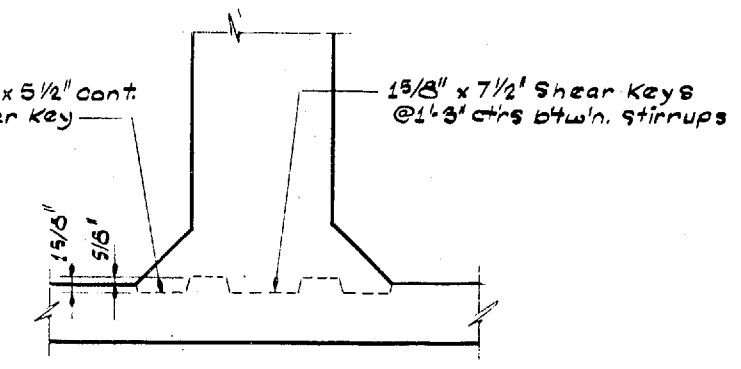


CONSTRUCTION JOINT AT BOTTOM SLAB

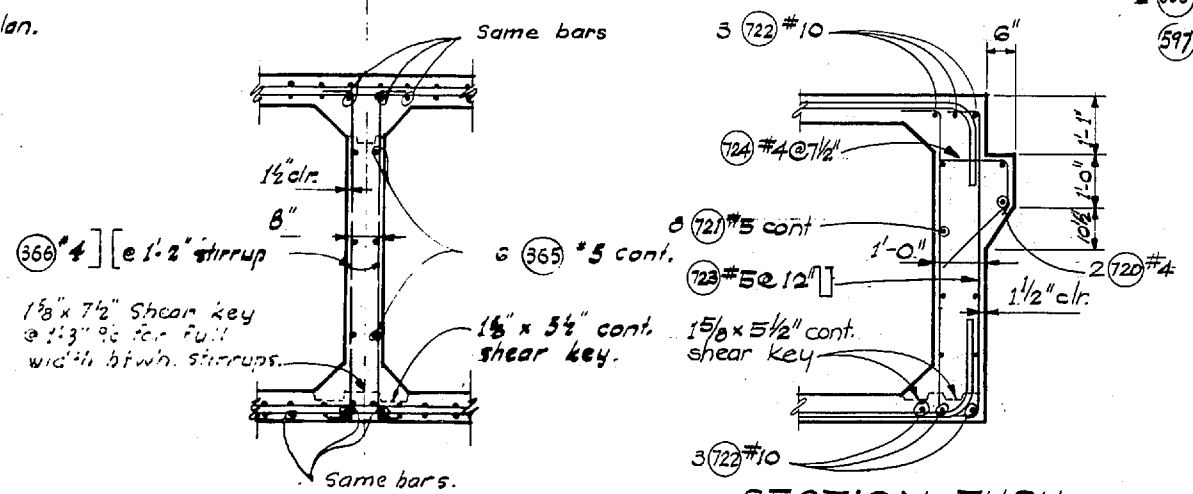


SECTION THRU DIAPHRAGM (TYPICAL ALL UNITS)

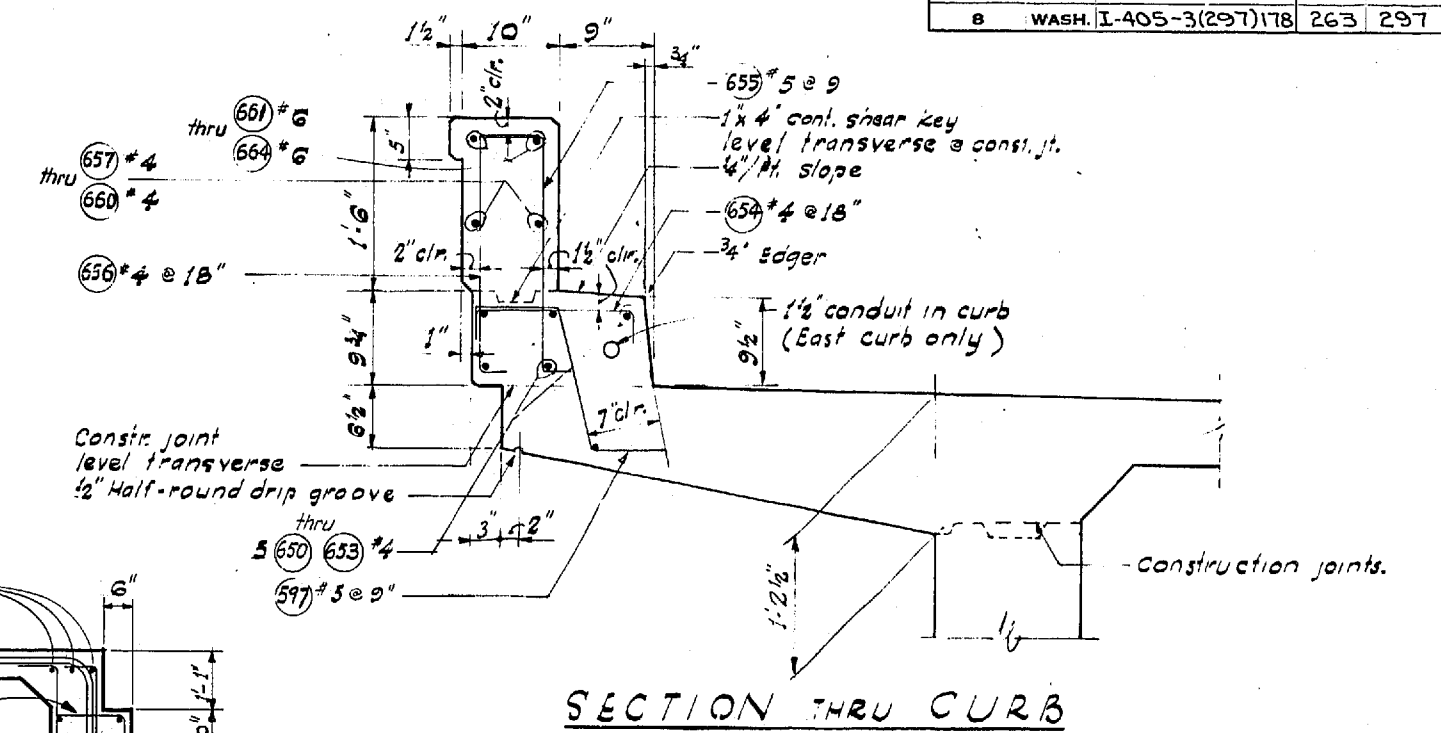


SECTION THRU CURB

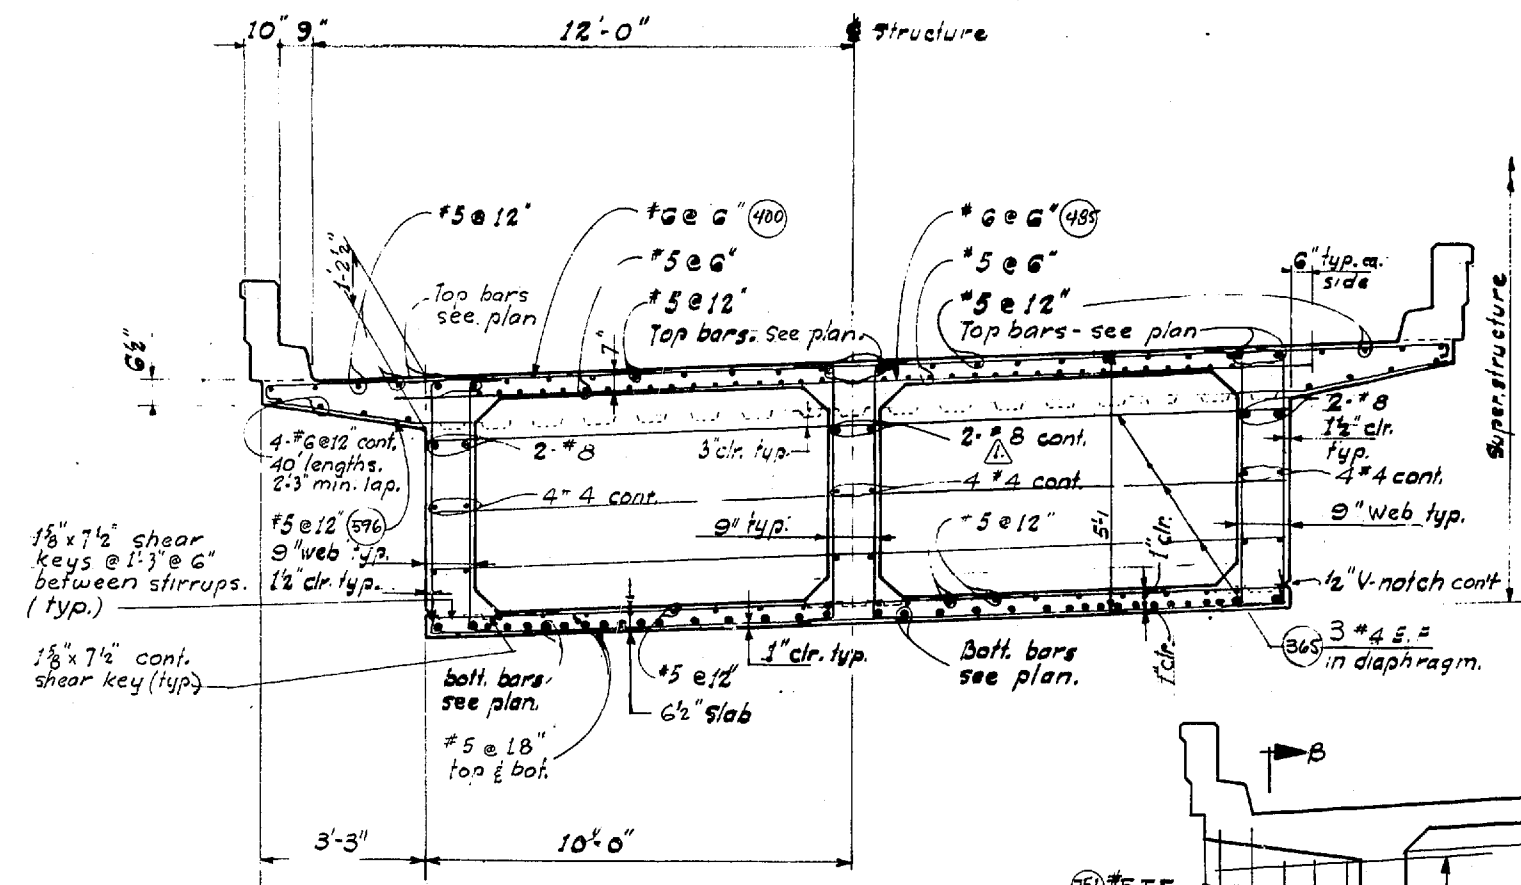


SECTION NEAR C OF SPAN

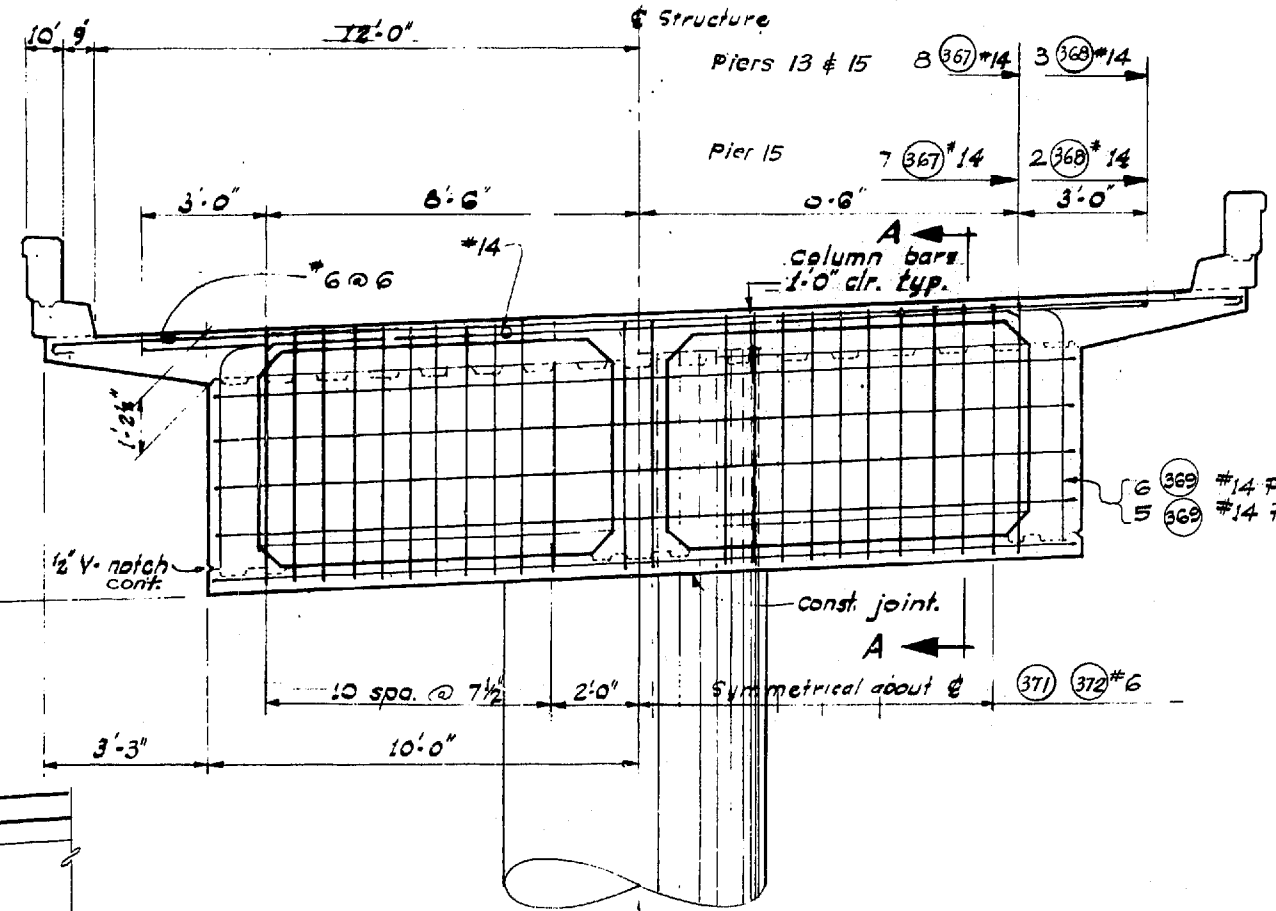

CROSS BEAM @ PIERS 13 thru 15

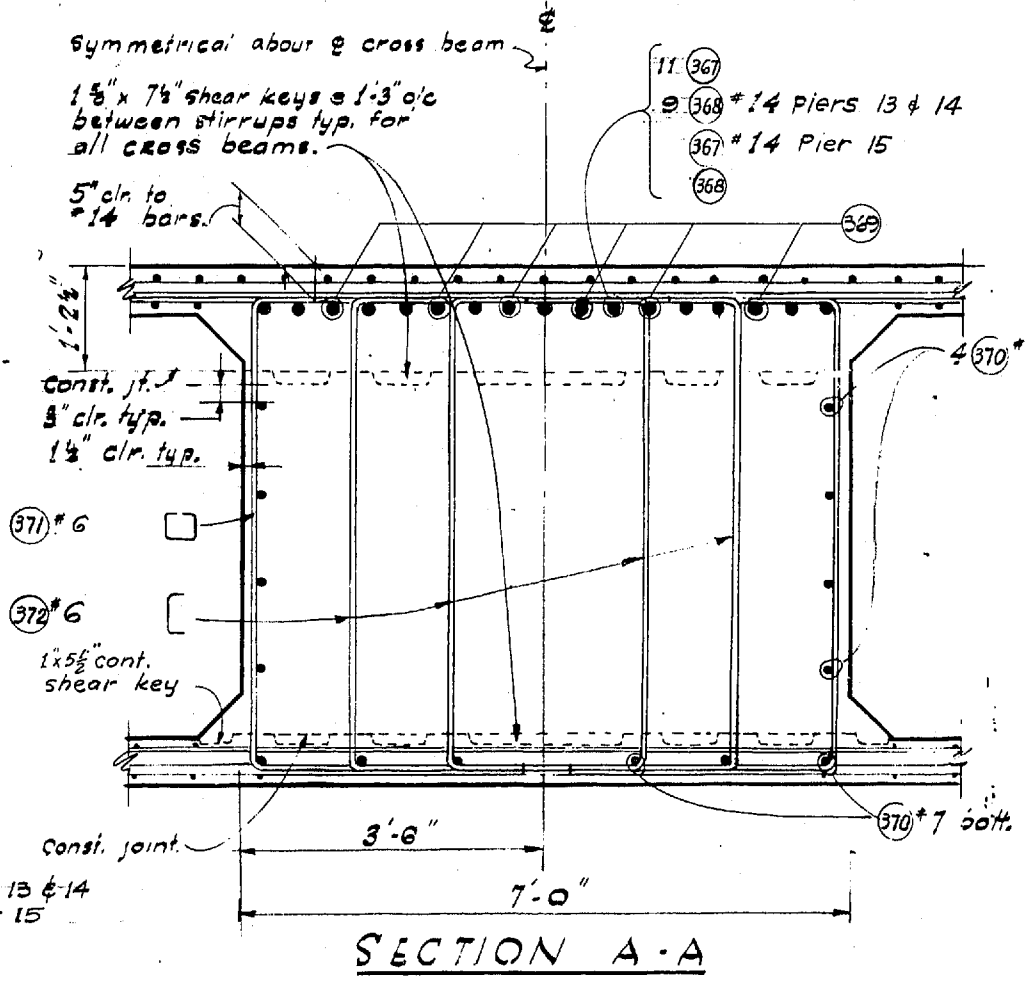

SECTION A-A

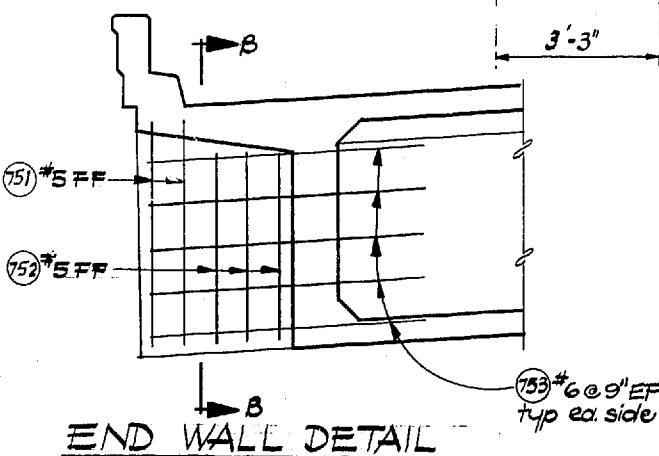

END WALL DETAIL

DATE	2-1-68	Revised Bar Size	BY	WMS
REVISION				



**WORTHINGTON, SKILLING
HELLE & JACKSON**
Consulting Civil and Structural Engineers
SEATTLE WASHINGTON

SR 405
MP 23.49 TO MP 23.76
WOODVILLE INTERCHANGE
KING COUNTY
N-W & N-E STRUCTURE

TRANSVERSE SECTIONS


WASHINGTON STATE HIGHWAY COMMISSION
DEPARTMENT OF HIGHWAYS
OLYMPIA, WASHINGTON

APPROVED December 7, 1967
SHEET 263 OF 297 SHEETS
CONTRACT NO. 8382

DESIGNED BY	
CHECKED BY	
DRAWN BY	
QUANTITIES FOUND	
QUANTITIES ORDERED	

DATE	
BY	
CHECKED	
LOC. ENGR.	
DIST. ENGR.	

WOODVILLE INTERCHANGE
 PSH NO. 1-RE/PSH NO. 2-BO
 N-W STRUCTURE
 ROADWAY SLABS
 SHEET 264 OF 297

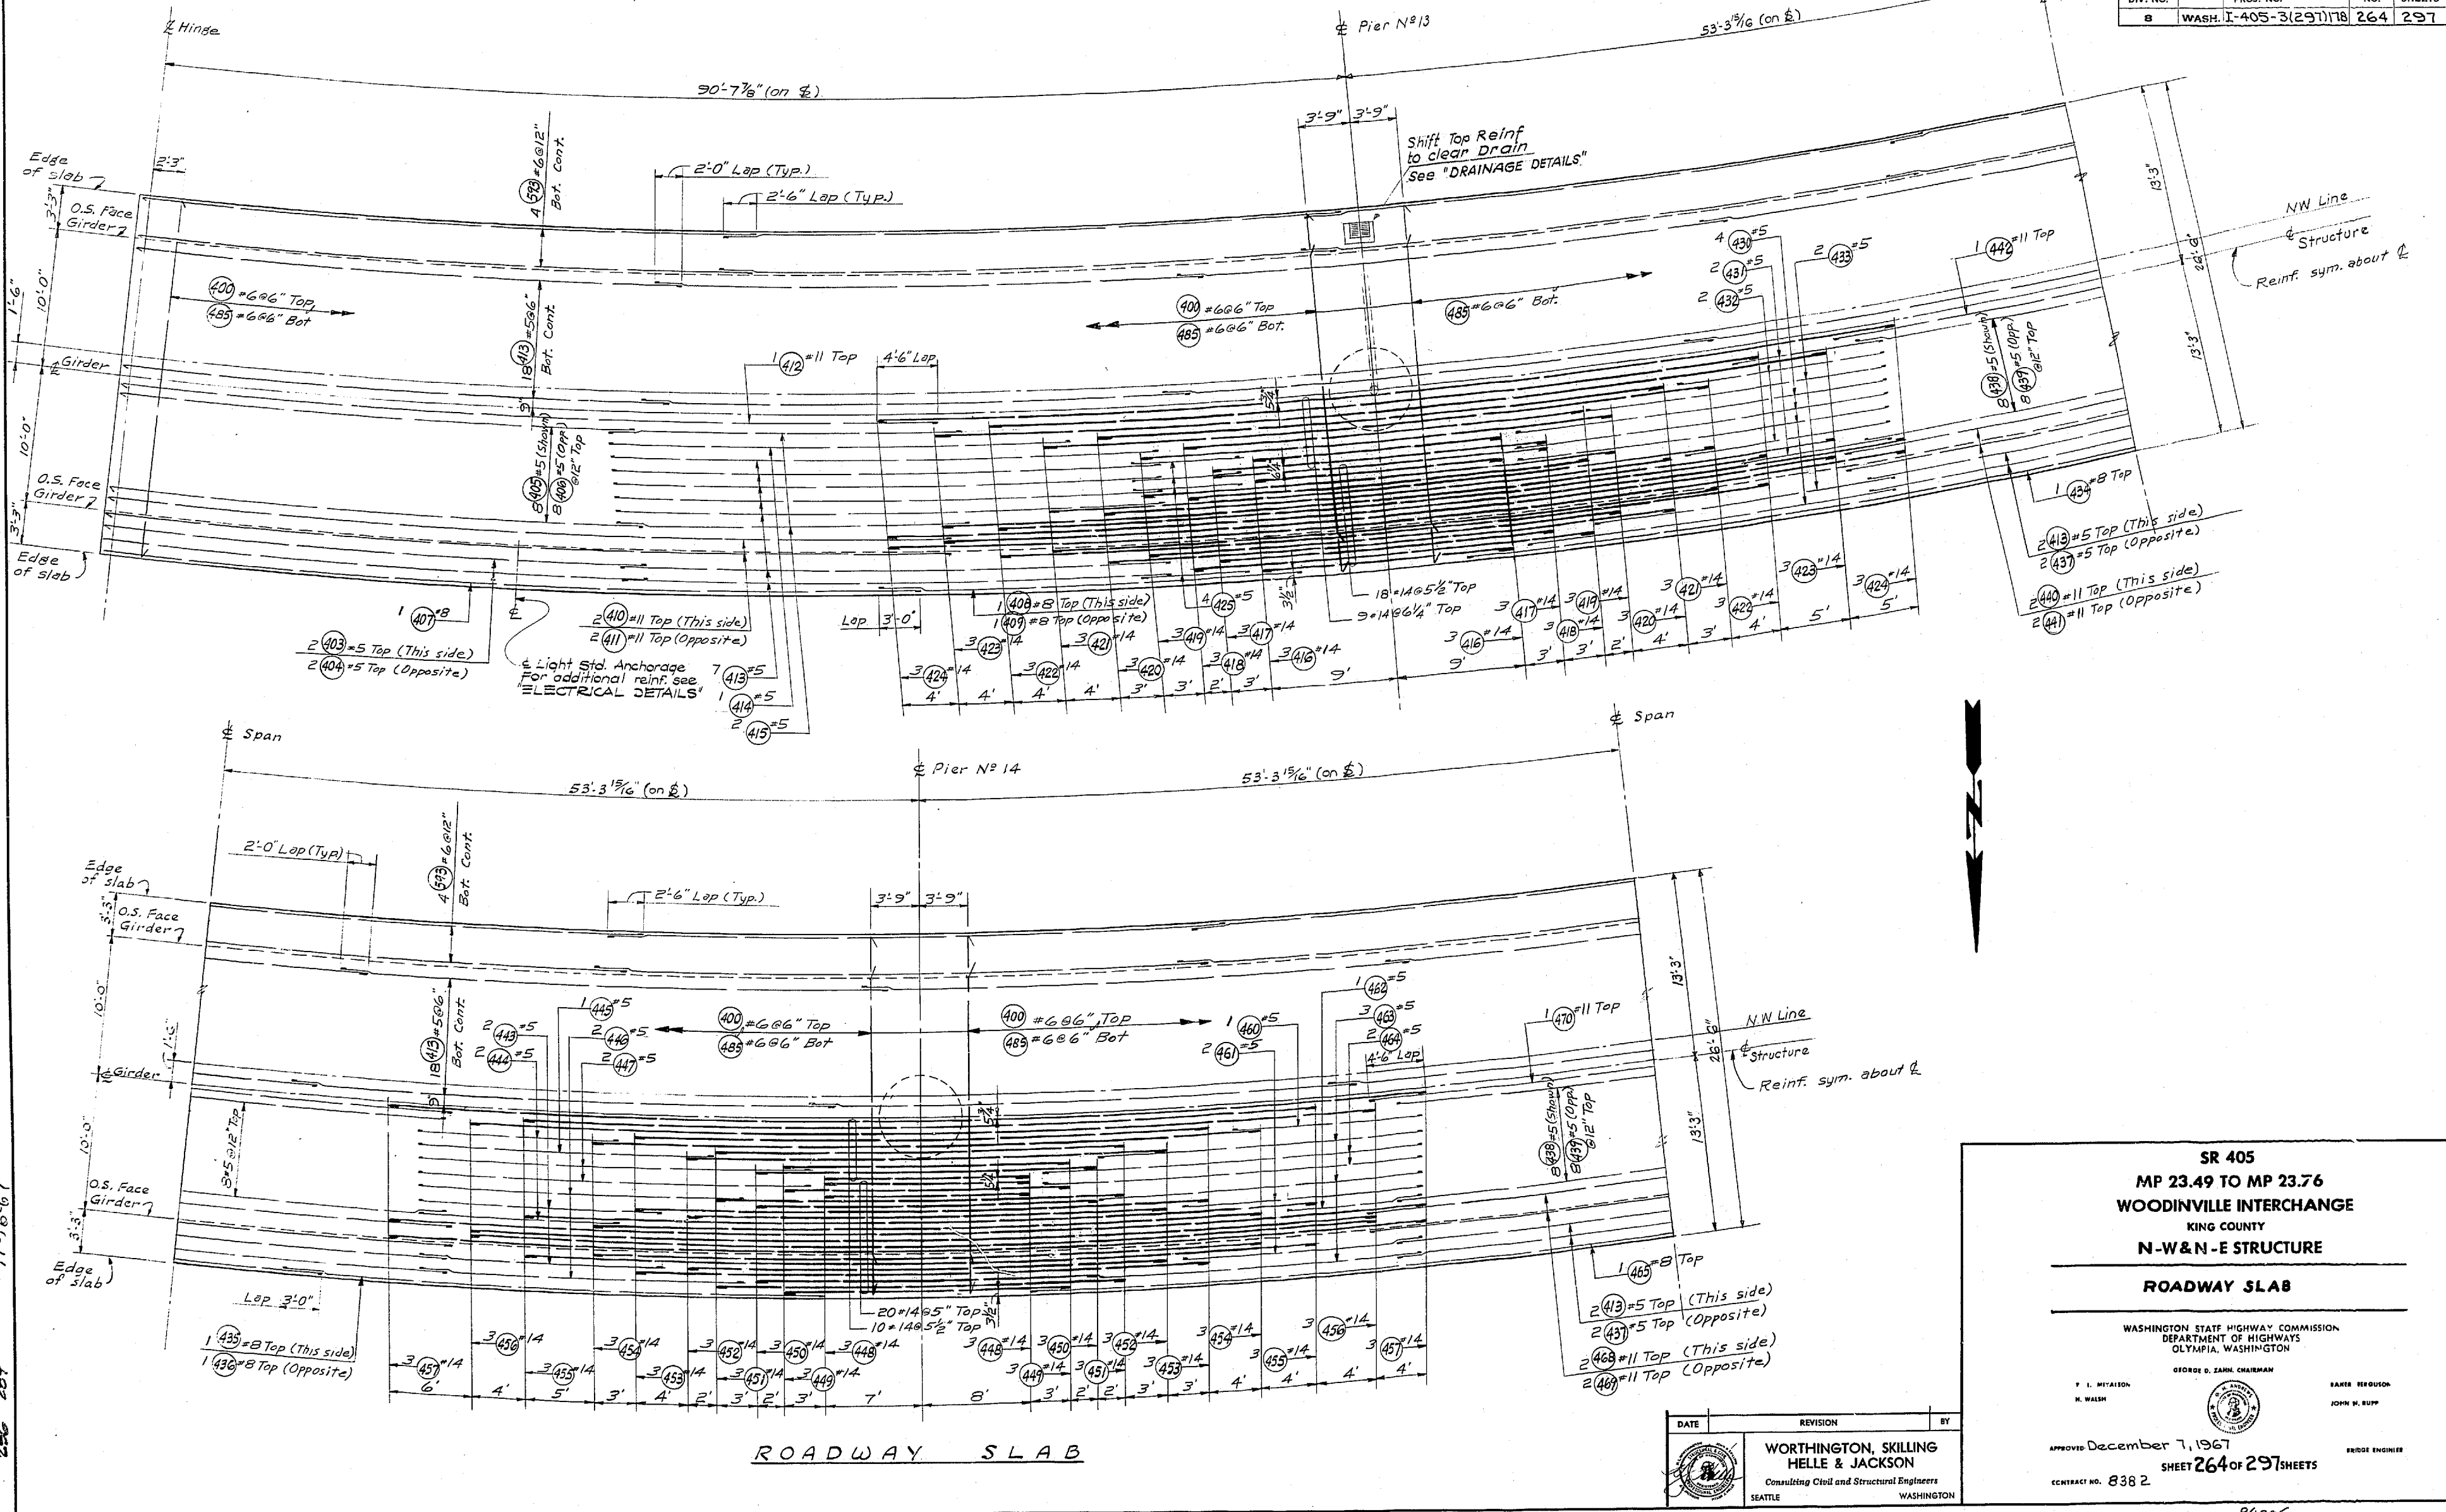

SR 405
MP 23.49 TO MP 23.76
WOODVILLE INTERCHANGE
 KING COUNTY
N-W & N-E STRUCTURE

ROADWAY SLAB

WASHINGTON STATE HIGHWAY COMMISSION
 DEPARTMENT OF HIGHWAYS
 OLYMPIA, WASHINGTON

GEORGE D. ZAHM, CHAIRMAN

Y. I. MITALSON
 H. WALSH


PAUL H. ROUSON
 JOHN H. RUPP

APPROVED: December 7, 1967
 SHEET 264 OF 297 SHEETS
 CONTRACT NO. 838 2

DATE	REVISION	BY

**WORTHINGTON, SKILLING
 HELLE & JACKSON**
 Consulting Civil and Structural Engineers
 SEATTLE WASHINGTON

DESIGNING ENGINEER	
DESIGNED	
CHECKED	
DRAWN BY	
QUANTITIES FIGURED	
QUANTITIES CHECKED	

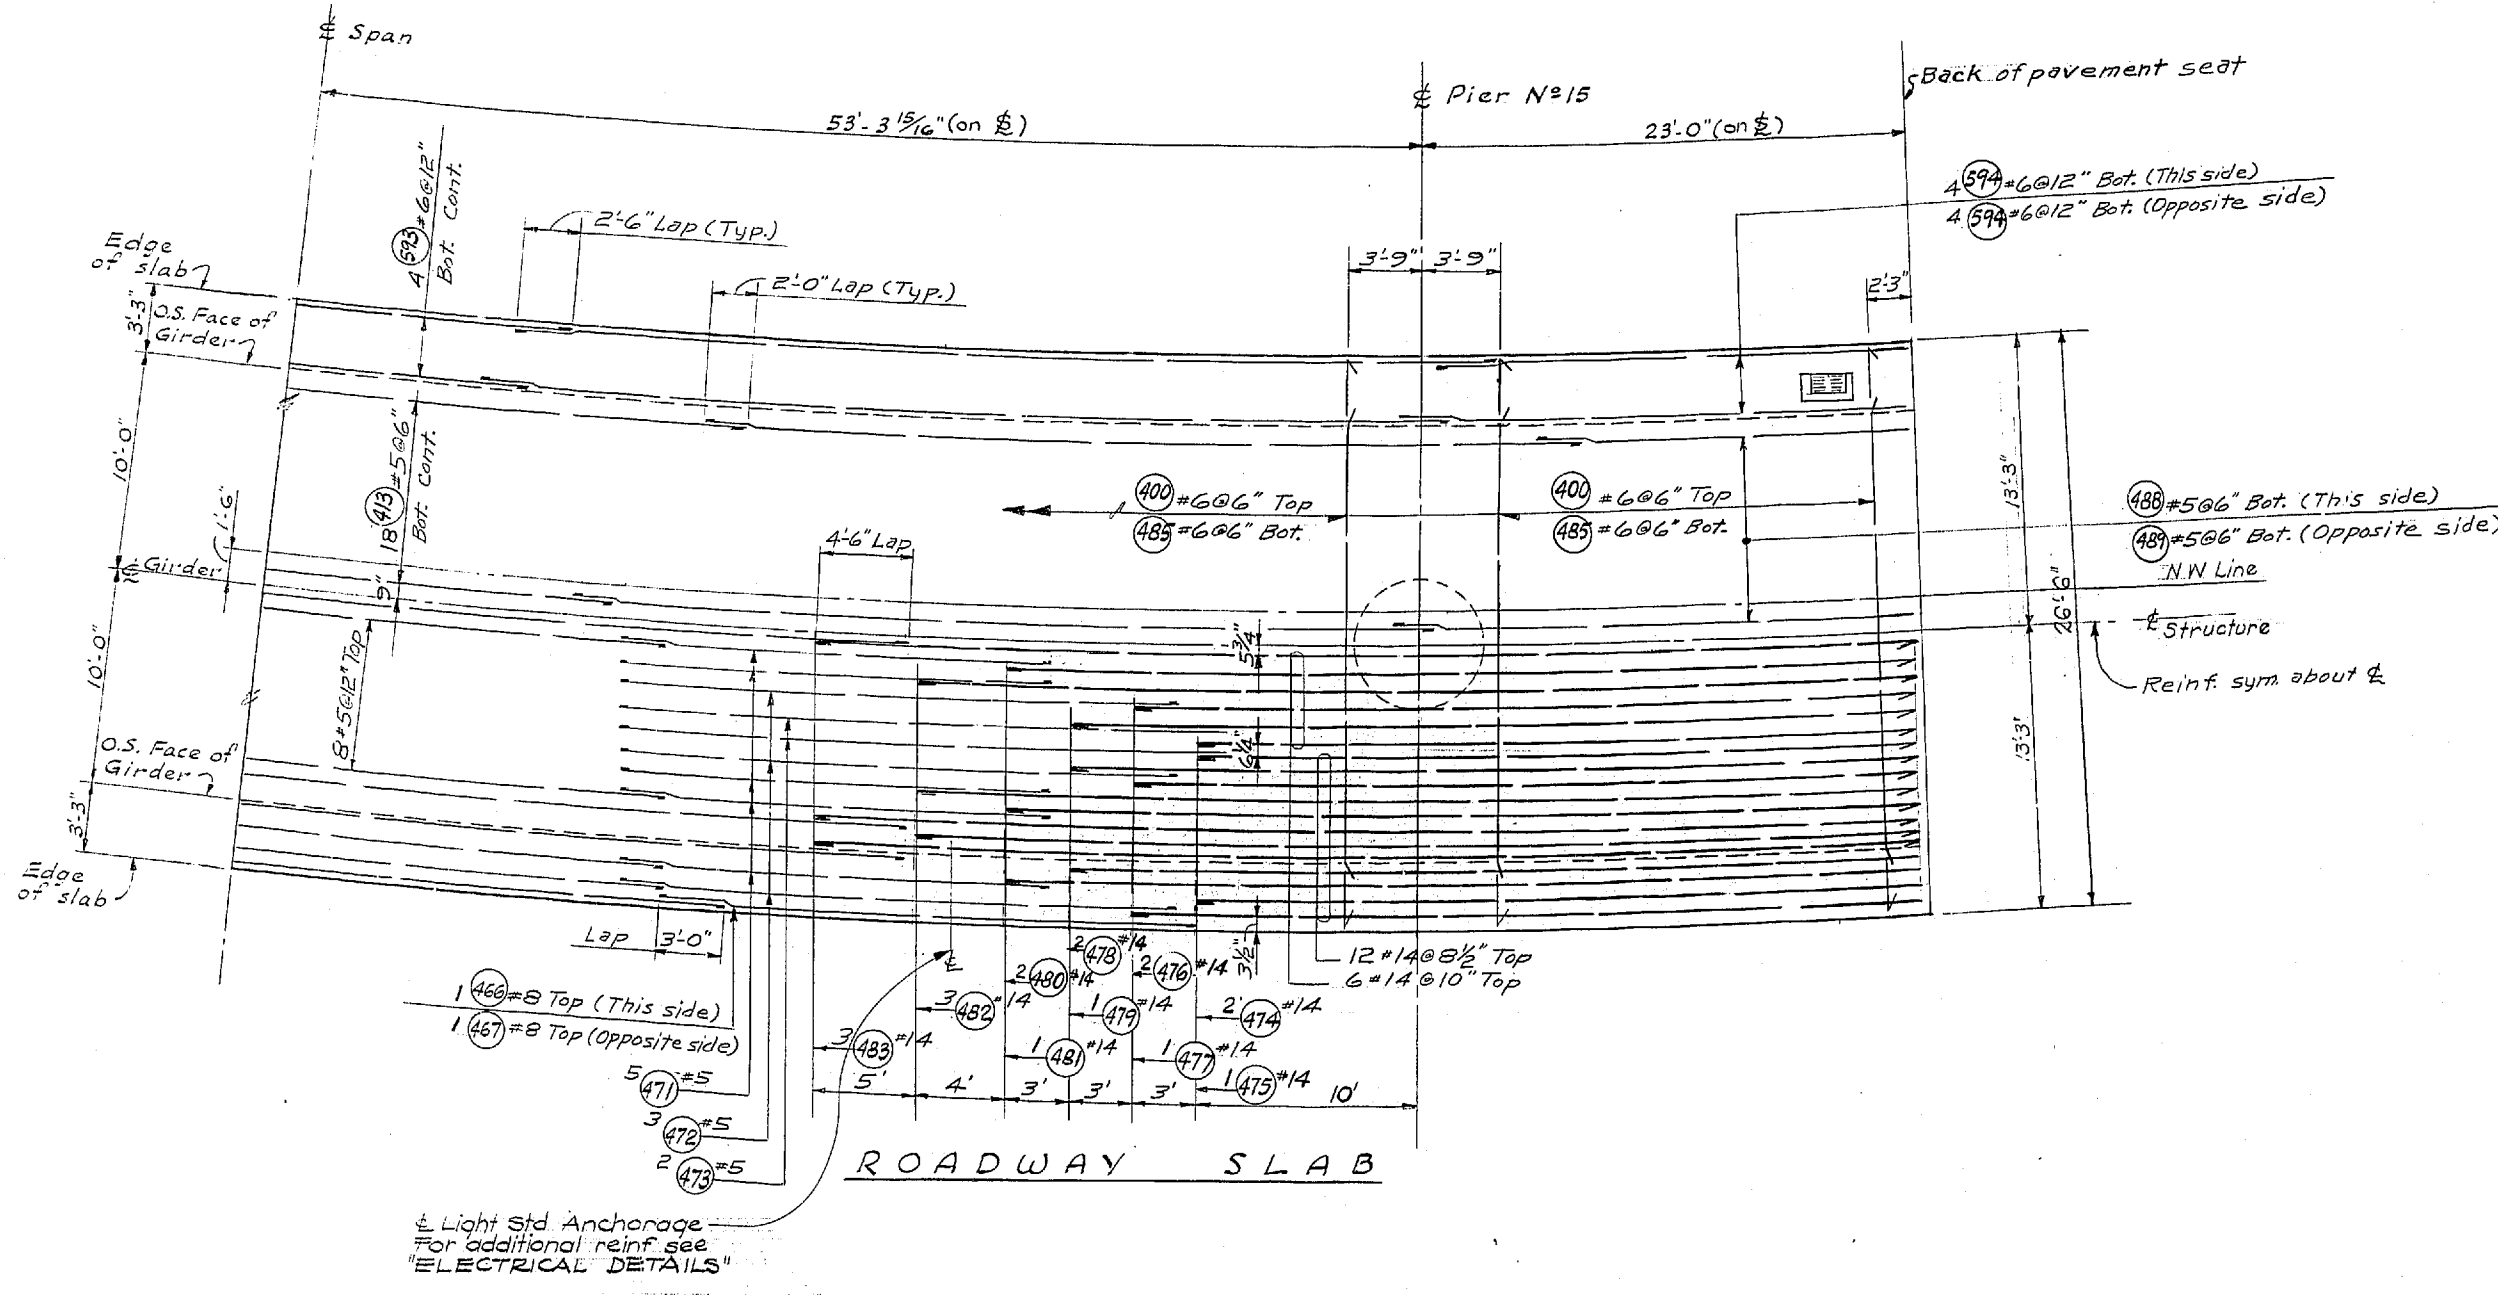

DATE	
BY	
DRAWN	
CHECKED	
LOC. ENGR.	
DIR. ENGR.	

WOODVILLE INTERCHANGE
 PSH NO. 1-RE/PSH NO. 2-BO
 N-W STRUCTURE
 ROADWAY SLAB
 SHEET 265 OF 297
 11-16-67

DATE	REVISION	BY

**WORTHINGTON, SKILLING
 HELLE & JACKSON**
 Consulting Civil and Structural Engineers
 SEATTLE WASHINGTON


SR 405
 MP 23.49 TO MP 23.76
WOODVILLE INTERCHANGE
 KING COUNTY
N-W&N-E STRUCTURE
ROADWAY SLAB

WASHINGTON STATE HIGHWAY COMMISSION
 DEPARTMENT OF HIGHWAYS
 OLYMPIA, WASHINGTON


GEORGE D. ZAHN, CHAIRMAN
 F. I. WILSON, N. WASH.
 BAKER FERDOSH, JOHN M. BUP

APPROVED December 7, 1967
 SHEET 265 OF 297 SHEETS
 CONTRACT NO. 8382

1/1996

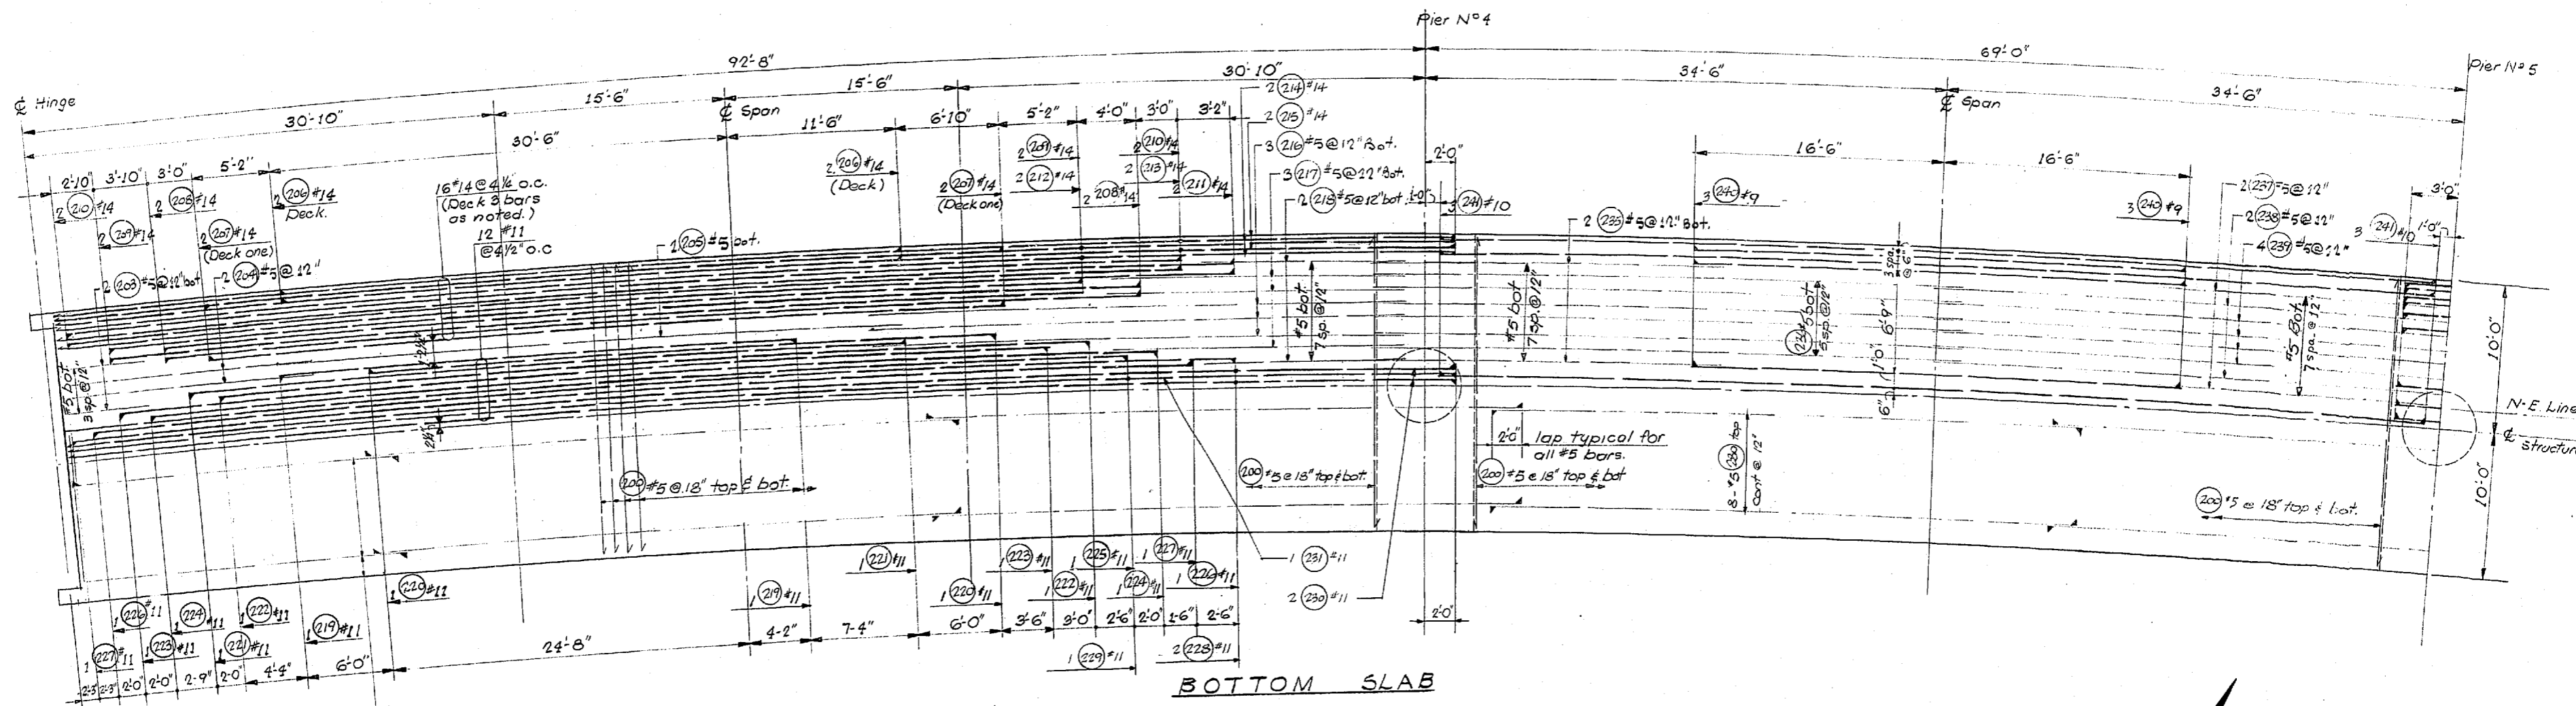


BOTTOM SLAB

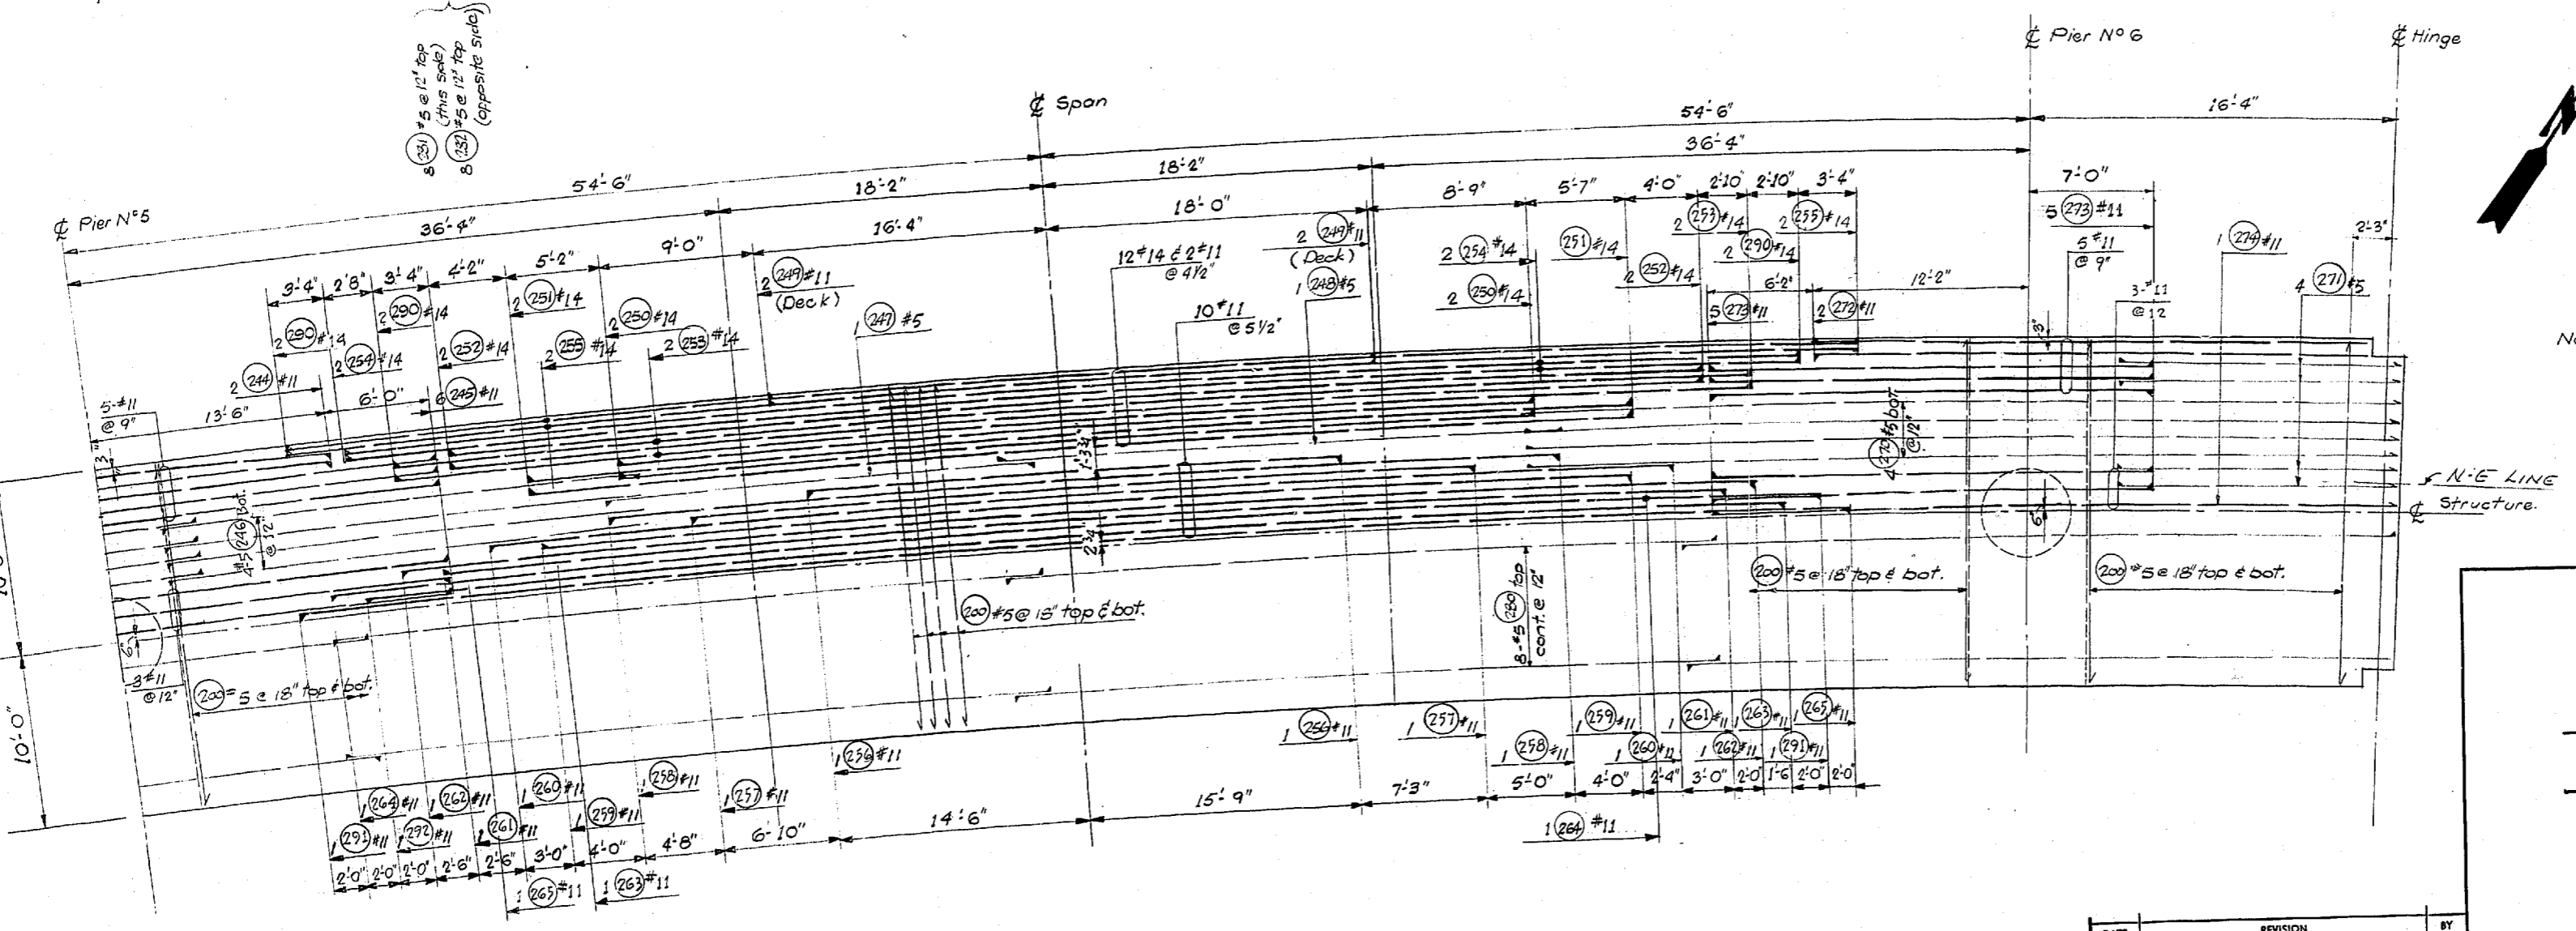

BOTTOM SLAB

Note: For Dead Load Camber Curve see "Framing Plan".

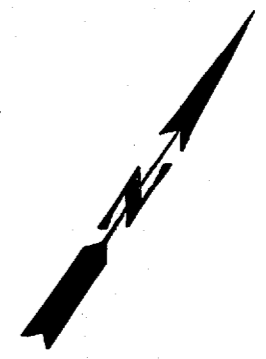

DESIGNED ENGINEER
DESIGN CHECKED
DRAWN BY
CHECKED
LOC. INSP.
QUANTITIES CHECKED
DIST. ENGR.

DATE
BY
TRACED
CHECKED
LOC. INSP.
DIST. ENGR.

WOODVILLE INTERCHANGE
 PSH NO. 1-RE/PSH NO. 2-BO
 STRUCTURE
 N-W & N-E
 BOTTOM SLAB
 SHEET 267 OF 297

11-16-67

DATE	REVISION	BY

**WORTHINGTON, SKILLING
 HELLE & JACKSON**
 Consulting Civil and Structural Engineers
 SEATTLE WASHINGTON



**SR 405
 MP 23.49 TO MP 23.76
 WOODVILLE INTERCHANGE
 KING COUNTY
 N-W & N-E STRUCTURE
 BOTTOM SLAB**

WASHINGTON STATE HIGHWAY COMMISSION
 DEPARTMENT OF HIGHWAYS
 OLYMPIA, WASHINGTON

GEORGE D. ZANK, CHAIRMAN
 BAKER FERGUSON
 JOHN N. RUPP

APPROVED: December 7, 1967
 SHEET 267 OF 297 SHEETS
 CONTRACT NO. 8382

FED. ROAD DIV. NO.	STATE	FED. AID PROJ. NO.	SHEET NO.	TOTAL SHEETS
8	WASH.	I-405-3(297)178	268	297

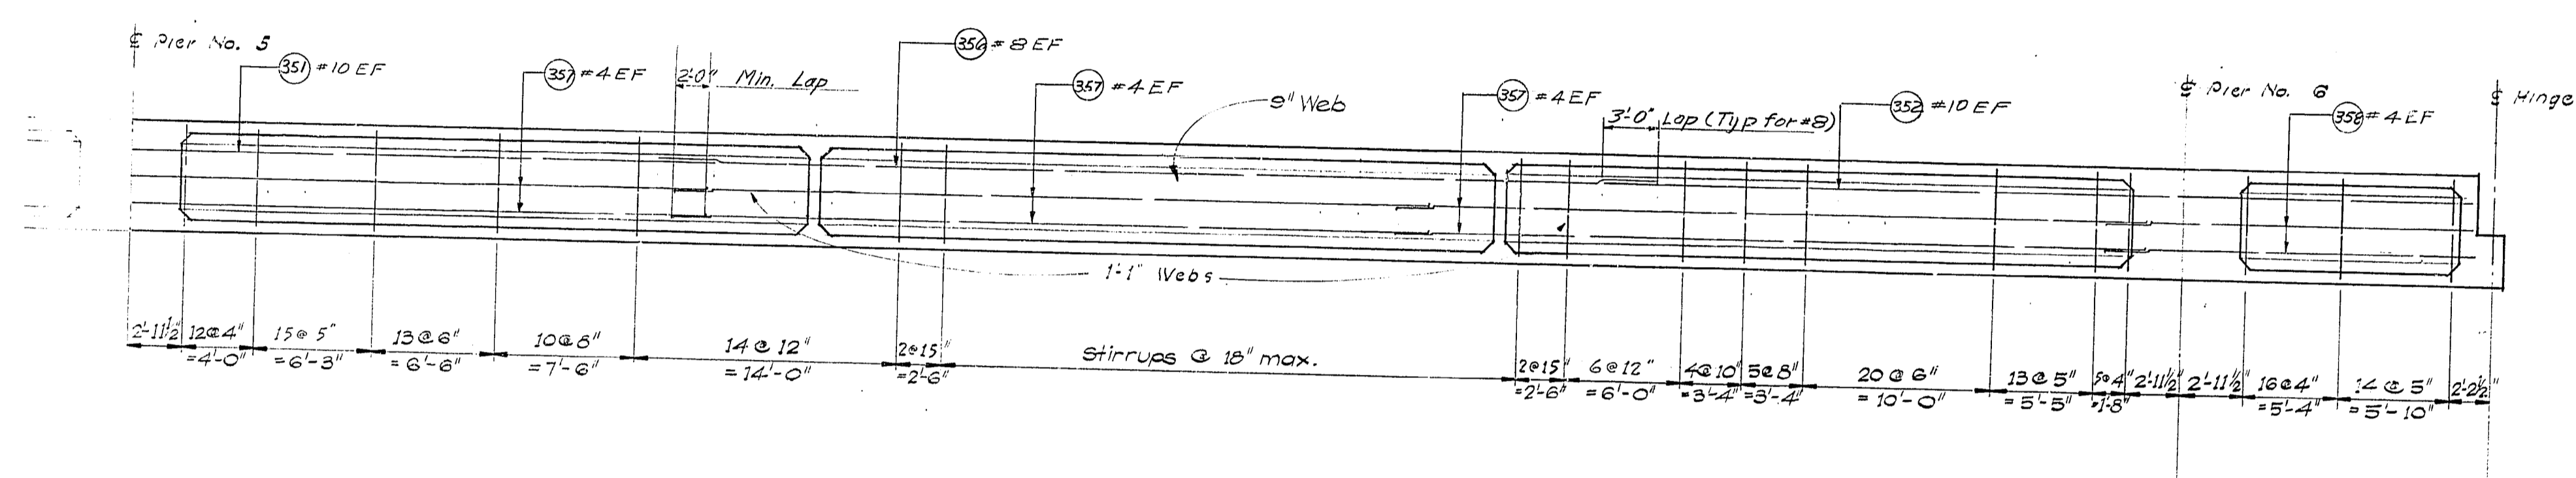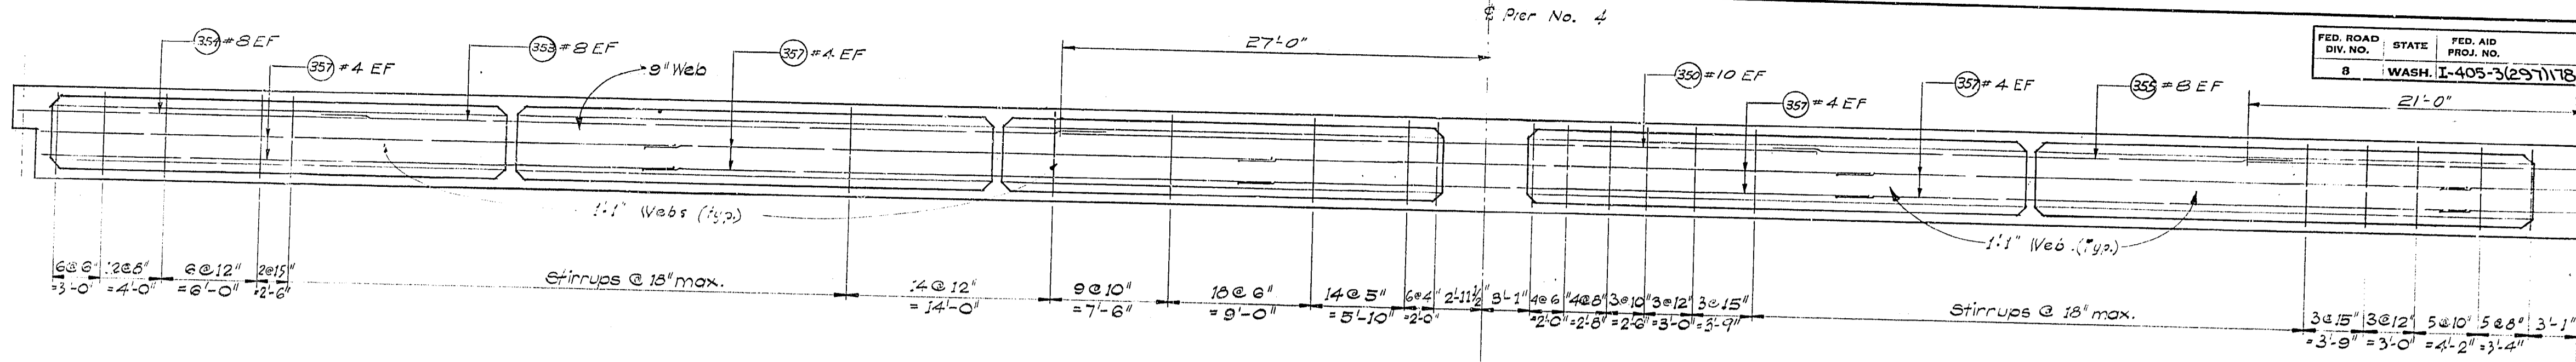

LONGITUDINAL SECTIONS

DATE	REVISION	BY

WORTHINGTON, SKILLING
 HELLE & JACKSON
 Consulting Civil and Structural Engineers
 SEATTLE WASHINGTON

SR 405
MP 23.49 TO MP 23.76
WOODINVILLE INTERCHANGE
 KING COUNTY
N-W&N - E STRUCTURE
LONGITUDINAL SECTIONS

WASHINGTON STATE HIGHWAY COMMISSION
 DEPARTMENT OF HIGHWAYS
 OLYMPIA, WASHINGTON

GEORGE O. ZAHN, CHAIRMAN
 F. L. MITCHELL, H. WALSH
 BAKER FERGUSON, JOHN W. RUPP

APPROVED: December 7, 1967
 SHEET 268 OF 297 SHEETS
 CONTRACT NO. 8382

DESIGNING ENGINEER
 CHECKED
 DRAWN BY
 QUANTITIES FIGURED
 QUANTITIES CHECKED

DATE	BY

PSH NO. 1-RE/PSH NO. 2-BO
 N-E STRUCTURE
 LONGIT. SECTIONS
 SHEET 268 OF 297

11-16-67


9/1995

FED. ROAD DIV. NO.	STATE	FED. AID PROJ. NO.	SHEET NO.	TOTAL SHEETS
8	WASH.	I-405-3(297)TR	270	297

DESIGNED BY	DATE
CHECKED BY	
QUANTITIES PROVIDED	
QUANTITIES CHECKED	

DATE	
BY	
DRAWN	
CHECKED	
LOC. INCH.	
DATE	

WOODVILLE INTERCHANGE
 PSH NO. 1-RE/PSH NO. 2-BO
 N-E STRUCTURE
 ROADWAY SLAB
 SHEET 262 OF 287

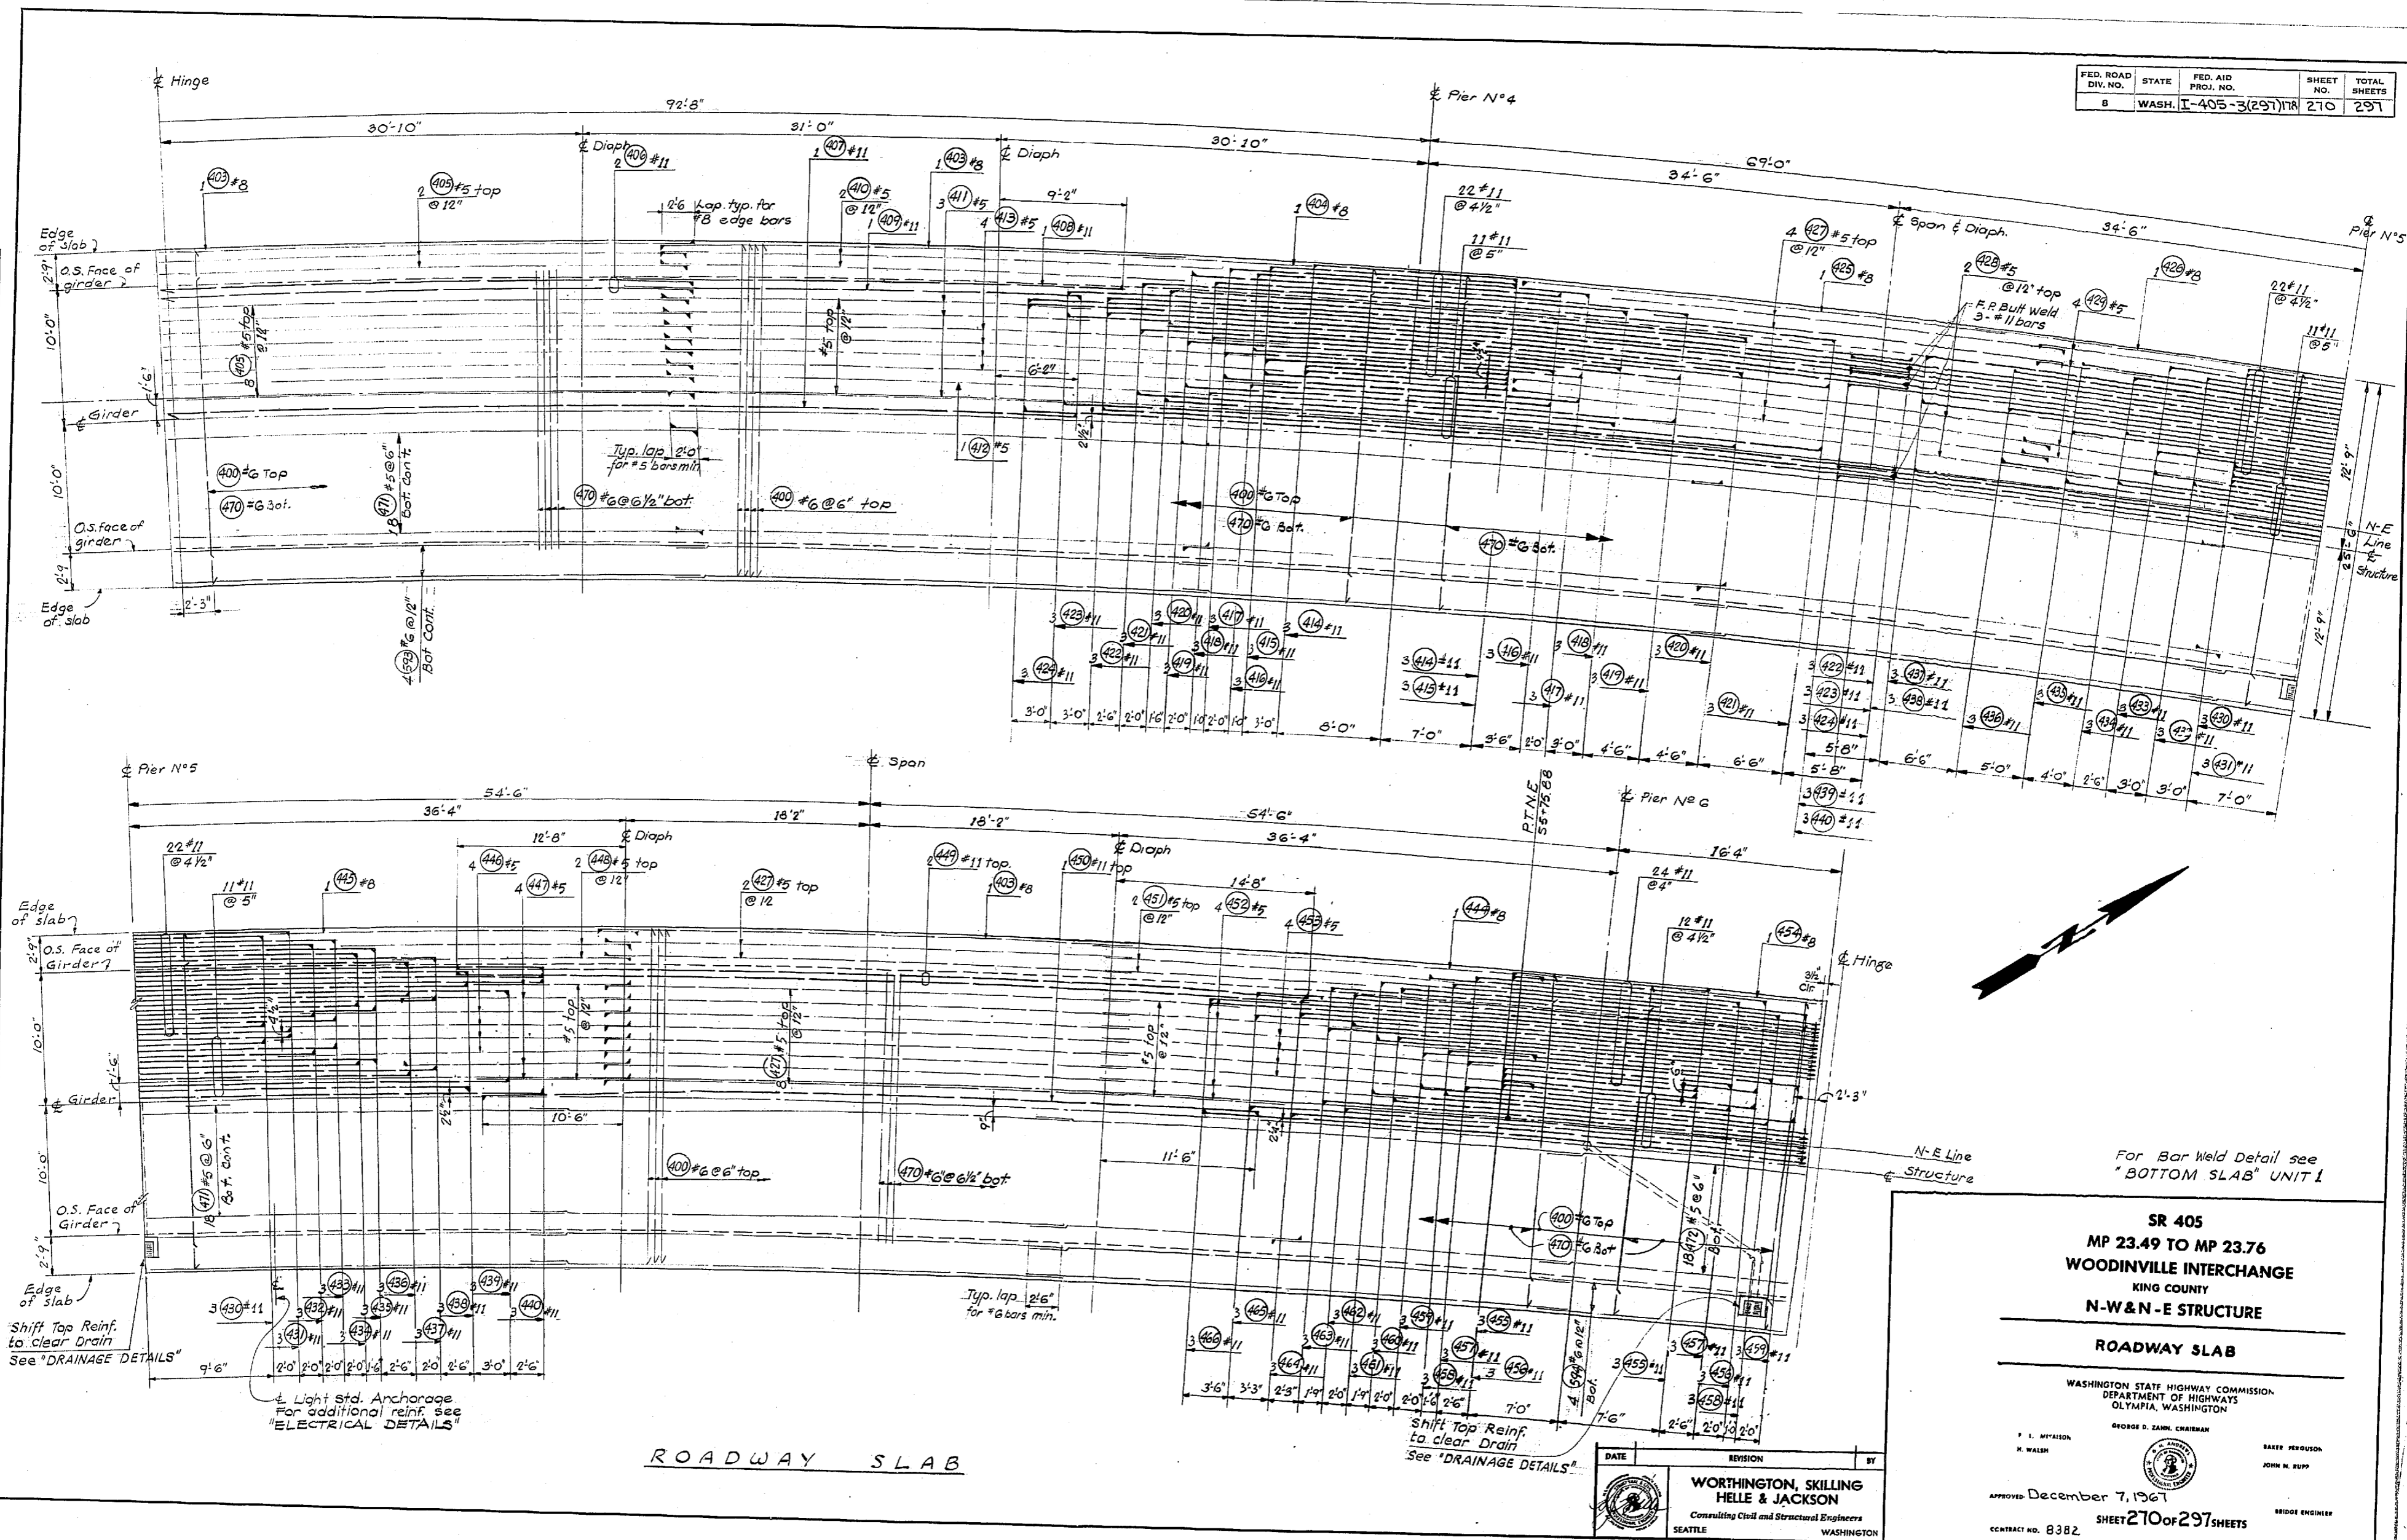

ROADWAY SLAB

SR 405
 MP 23.49 TO MP 23.76
 WOODVILLE INTERCHANGE
 KING COUNTY
 N-W & N-E STRUCTURE
 ROADWAY SLAB


WASHINGTON STATE HIGHWAY COMMISSION
 DEPARTMENT OF HIGHWAYS
 OLYMPIA, WASHINGTON

APPROVED December 7, 1967
 SHEET 270 OF 297 SHEETS
 CONTRACT NO. 8382



DATE	REVISION	BY

WORTHINGTON, SKILLING
 HELLE & JACKSON
 Consulting Civil and Structural Engineers
 SEATTLE WASHINGTON

FED. ROAD DIV. NO.	STATE	FED. AID PROJ. NO.	SHEET NO.	TOTAL SHEETS
8	WASH.	I-405-3(297)118	271	297

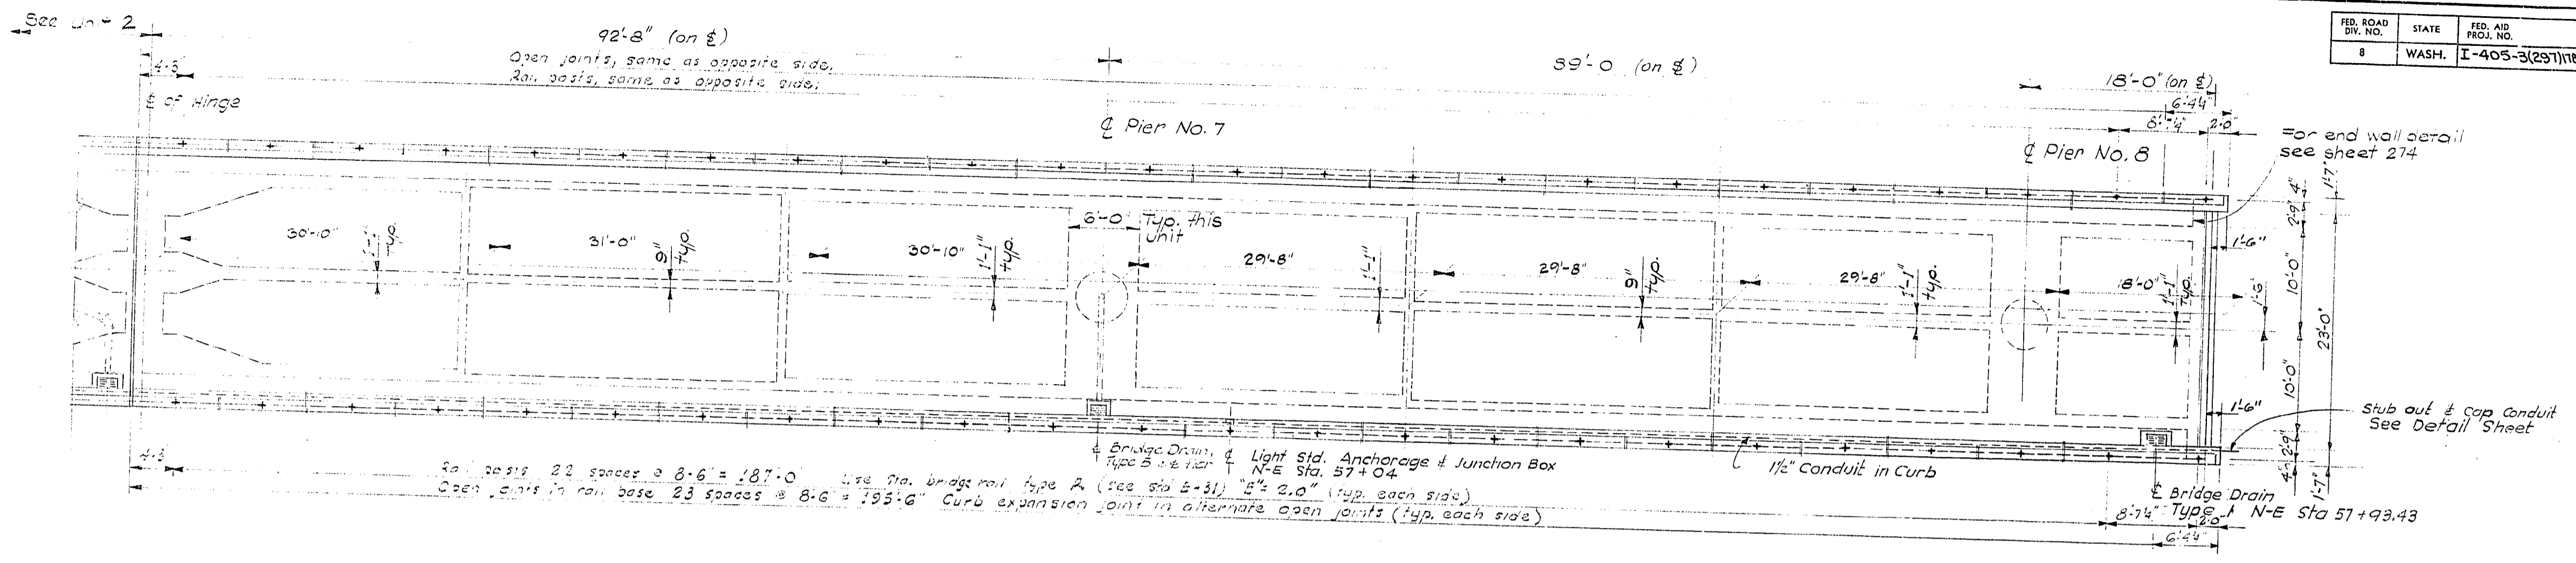

FRAMING PLAN

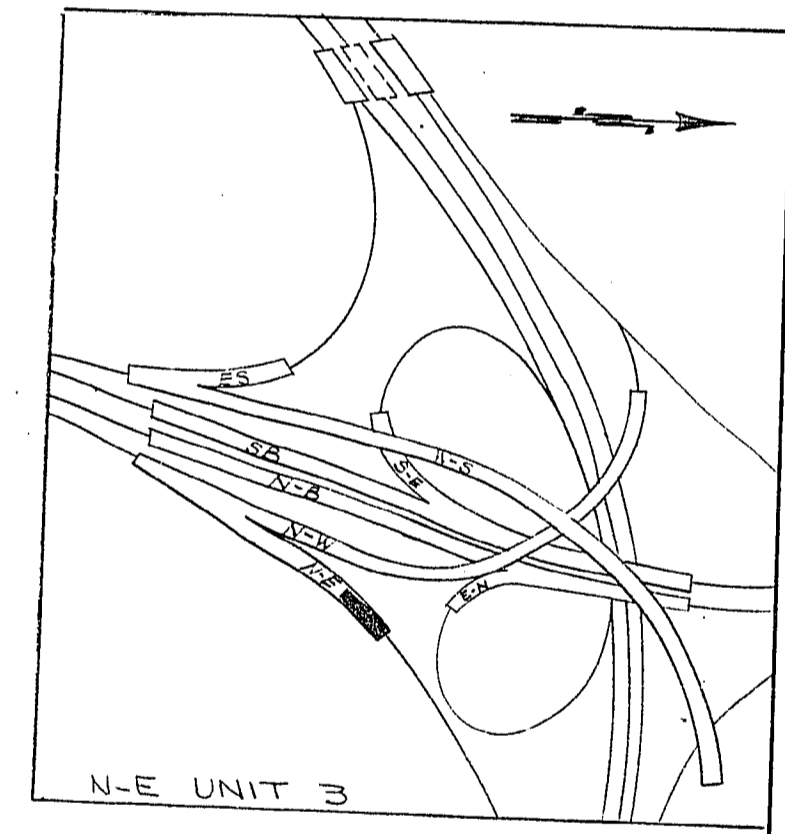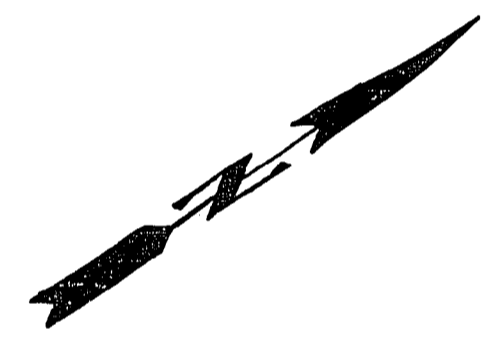

For General Notes See Unit 1 Framing Plan.

SR 405
MP 23.49 TO MP 23.76
WOODINVILLE INTERCHANGE
 KING COUNTY
N-W&N-E STRUCTURE

FRAMING PLAN

WASHINGTON STATE HIGHWAY COMMISSION
 DEPARTMENT OF HIGHWAYS
 OLYMPIA, WASHINGTON

GEORGE D. ZAHN, CHAIRMAN

F. I. MIVALSON
 H. WALSH

BAKER FERGUSON
 JOHN H. RUPP

APPROVED December 7, 1967
 SHEET 271 of 297 SHEETS
 CONTRACT NO. 8382

DATE	REVISION	BY

WORTHINGTON, SKILLING
HELLE & JACKSON
 Consulting Civil and Structural Engineers
 SEATTLE WASHINGTON


DESIGNED	CHECKED	QUANTITIES CHECKED

LOC. ENGR.	DIST. ENGR.

SHEET 271 OF 297
 11/16/67


9/1995

FED. ROAD DIV. NO.	STATE	FED. AID PROJ. NO.	SHEET NO.	TOTAL SHEETS
8	WASH.	I-405-3(297)178	272	297

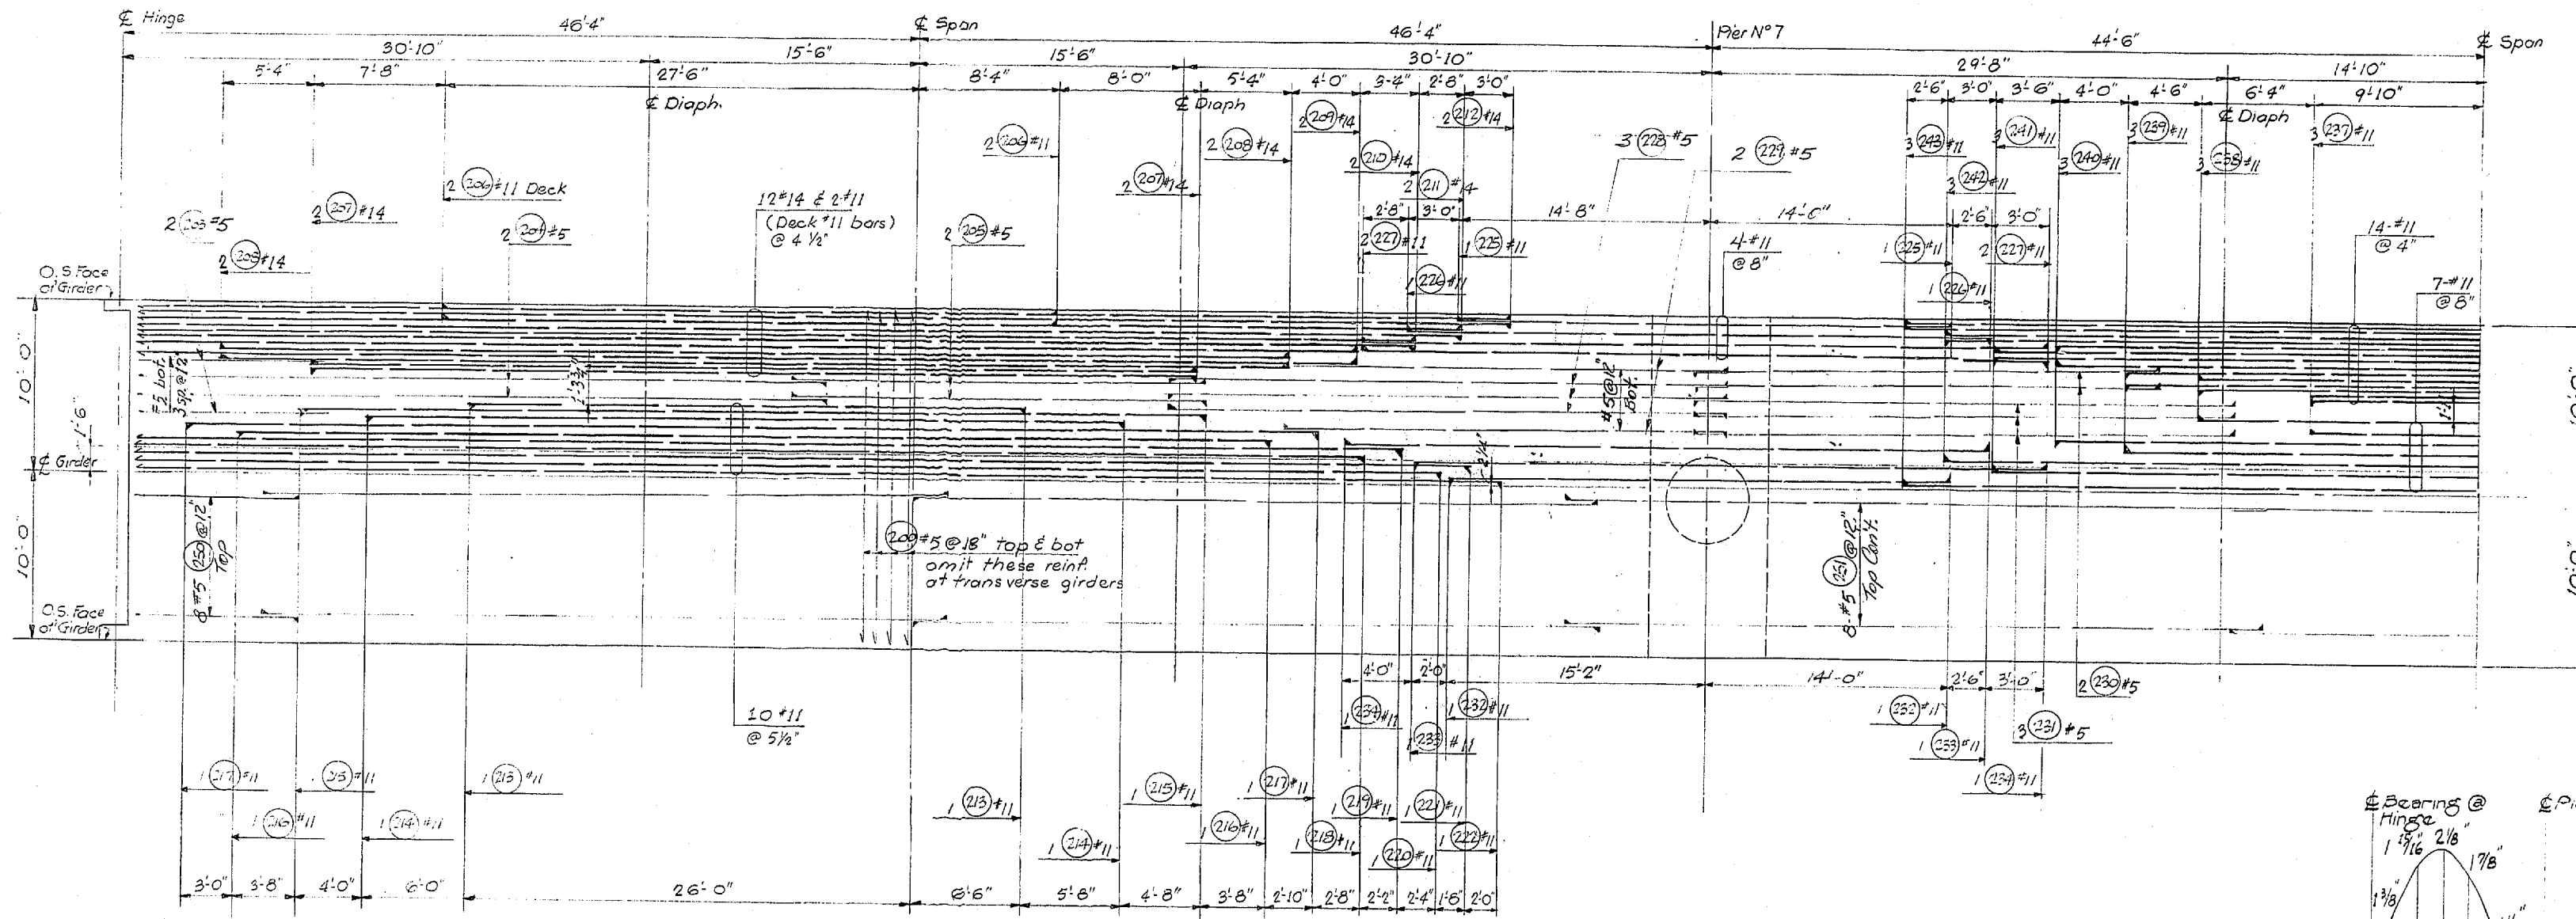


N-E Line
of Structure.

BOTTOM SLAB

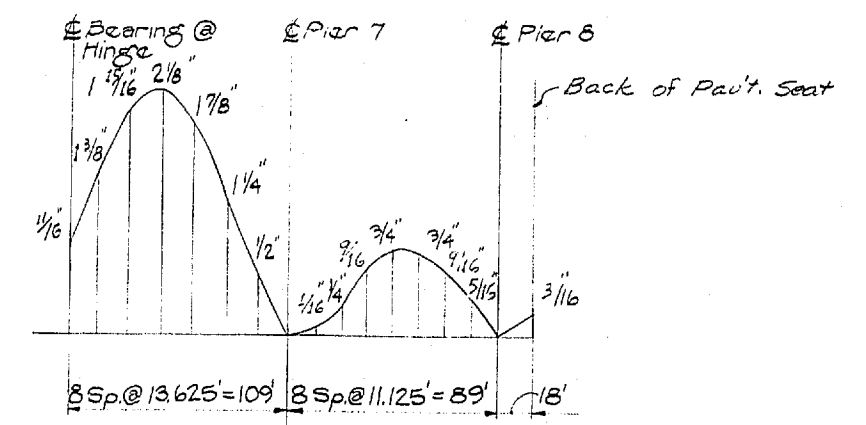

DEAD LOAD CAMBER CURVE FOR N-E RAMP
THIS CURVE SHOWS D.L. CAMBER ONLY AND SHOULD BE INCREASED BY THE AMOUNT OF TAKE-UP ANTICIPATED IN THE FALSEWORK.

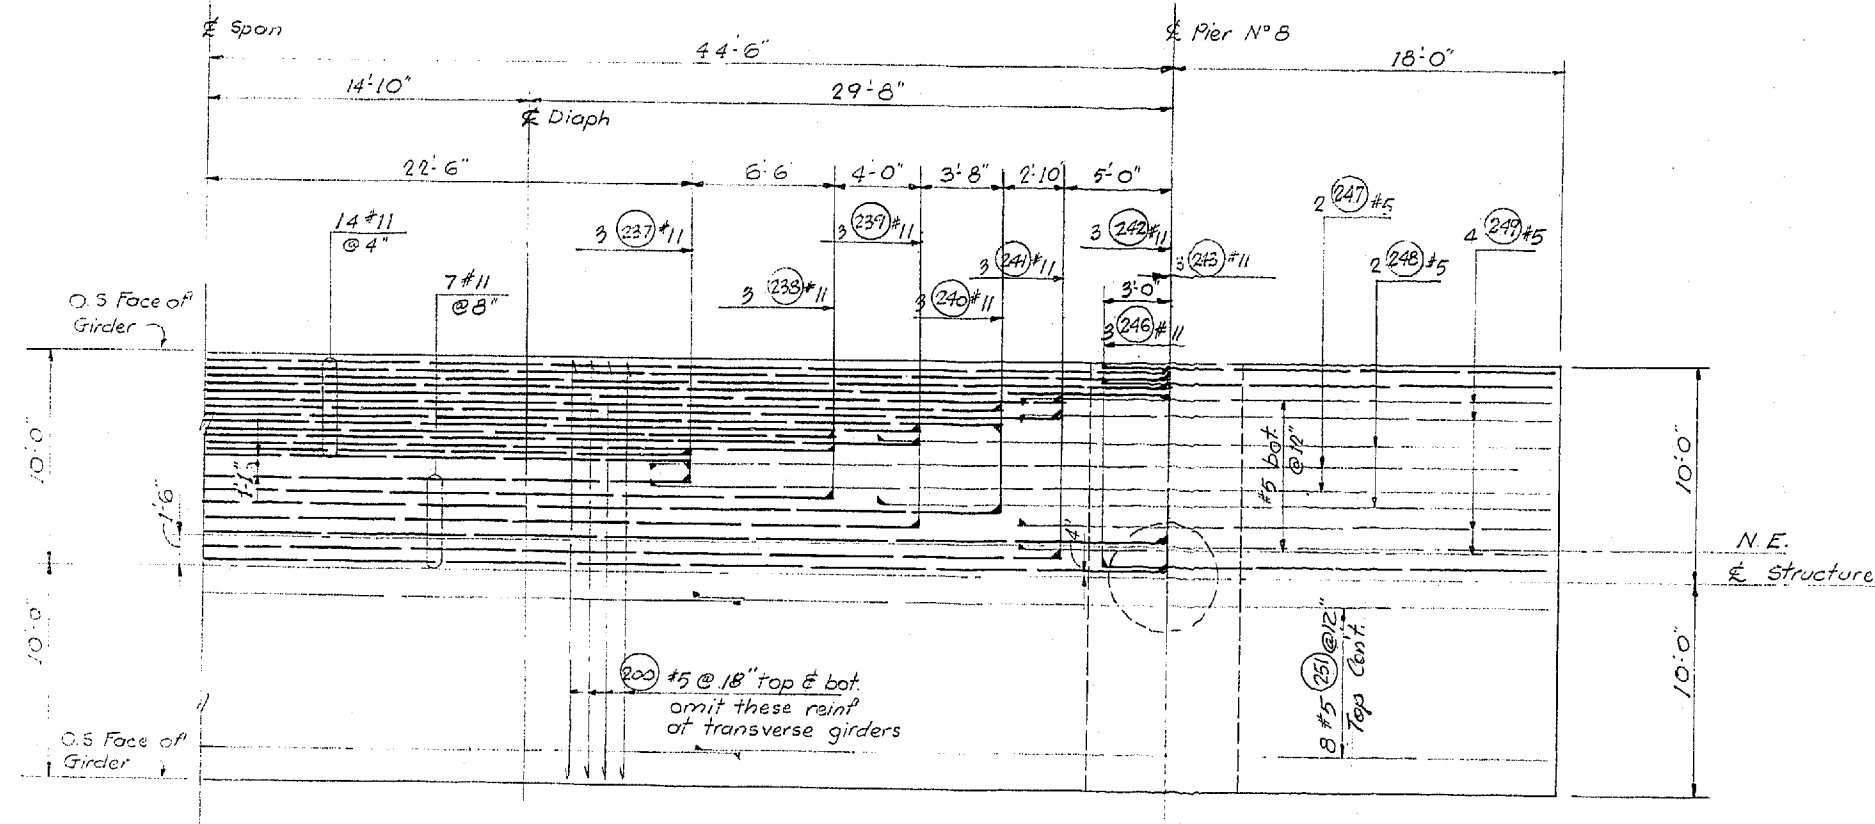

N-E
of Structure.

BOTTOM SLAB
3/16" x 14"0"

DESIGNING ENGINEER	
ENGINEER	
DESIGN CHECKED	
CHECKED	
QUANTITIES FIGURED	
QUANTITIES CHECKED	

DATE	
BY	
TRAINING	
CHECKED	
LOC. ENGR.	
DIST. ENGR.	

WOODVILLE INTERCHANGE
PSH NO. 1-RE/PSH NO. 2-BO
AVENUE STRUCTURE
SHEET 272 OF 297 SHEETS
11-16-67

DATE	REVISION	BY

WORTHINGTON, SKILLING
HELLE & JACKSON
Consulting Civil and Structural Engineers
SEATTLE WASHINGTON

SR 405
MP 23.49 TO MP 23.76
WOODVILLE INTERCHANGE
KING COUNTY
N-W & N-E STRUCTURE

BOTTOM SLAB

WASHINGTON STATE HIGHWAY COMMISSION
DEPARTMENT OF HIGHWAYS
OLYMPIA, WASHINGTON

GEORGE D. ZAHN, CHAIRMAN

F. L. MYRASON
H. WASH





BAKER FERGOUSON
JOHN N. RUFF

APPROVED December 7, 1967
SHEET 272 OF 297 SHEETS
CONTRACT NO. 8382

BRIDGE ENGINEER

8/1995

FED. ROAD DIV. NO.	STATE	FED. AID PROJ. NO.	SHEET NO.	TOTAL SHEETS
8	WASH.	I-405-3(297)118	273	297

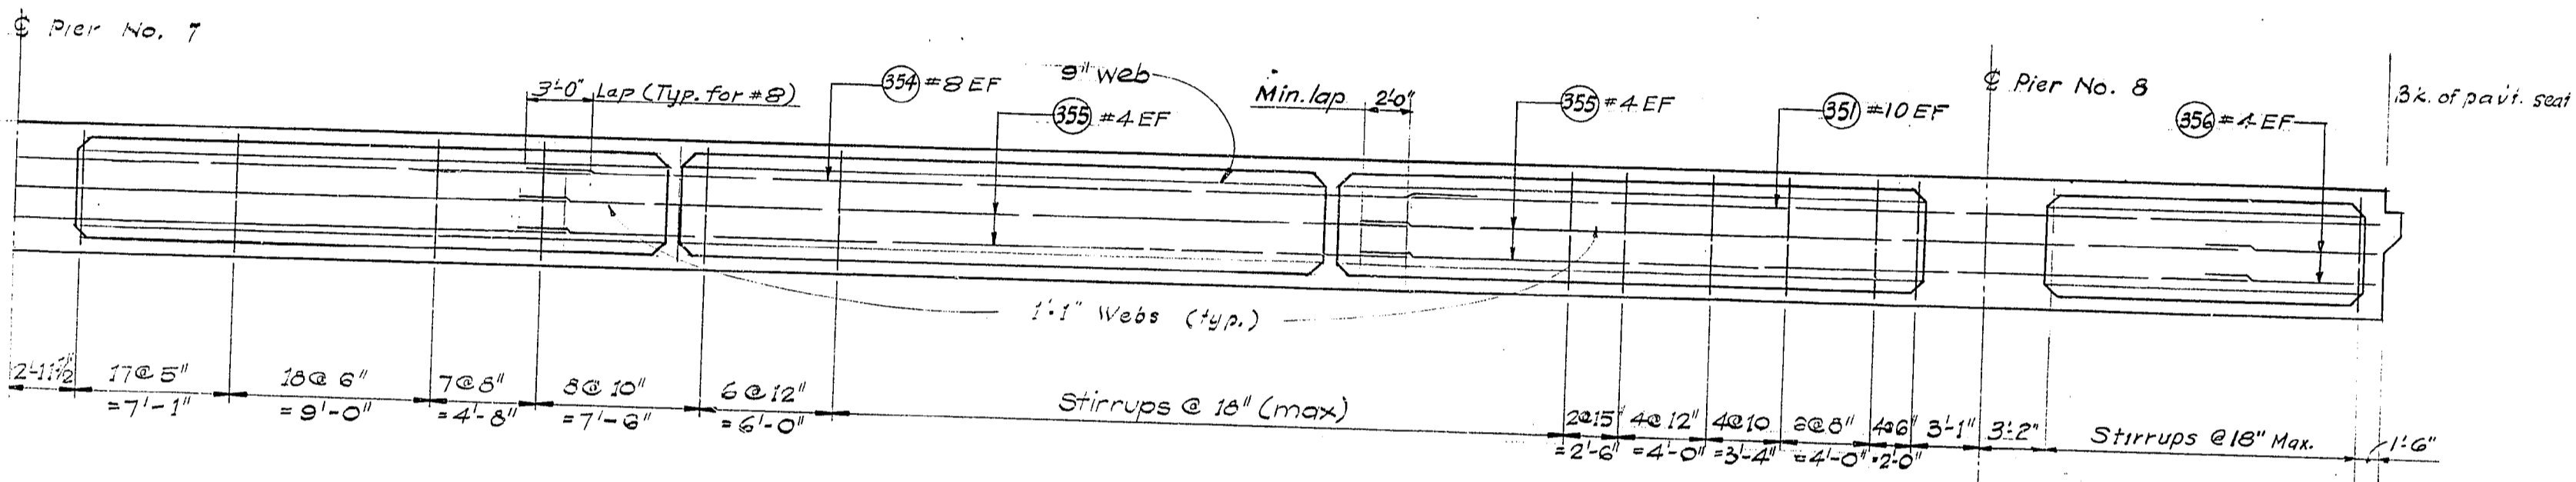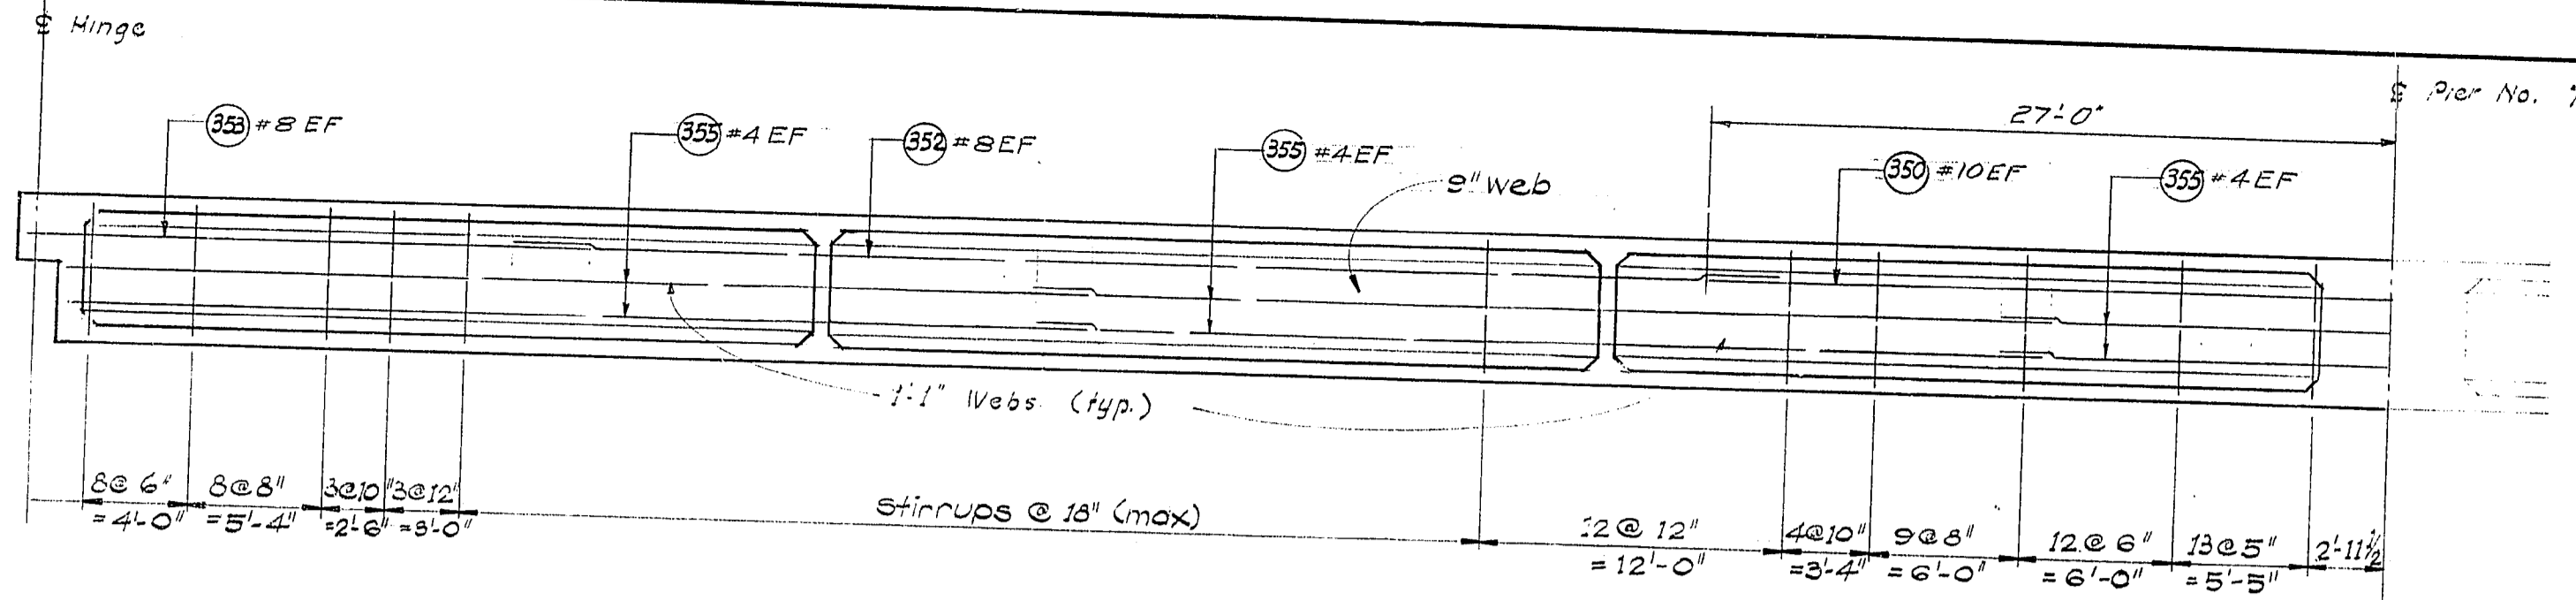

LONGITUDINAL SECTIONS

DATE	REVISION	BY

WORTHINGTON, SKILLING HELLE & JACKSON
 Consulting Civil and Structural Engineers
 SEATTLE WASHINGTON

SR 405
MP 23.49 TO MP 23.76
WOODINVILLE INTERCHANGE
 KING COUNTY
N-W&N-E STRUCTURE

LONGITUDINAL SECTIONS

WASHINGTON STATE HIGHWAY COMMISSION
 DEPARTMENT OF HIGHWAYS
 OLYMPIA, WASHINGTON

GEORGE D. ZAHN, CHAIRMAN
 F. I. MITALSON
 H. WALSH

BAKER PEGUSON
 JOHN H. BUYP

APPROVED December 7, 1967
 SHEET 273 OF 297 SHEETS
 CONTRACT NO. 8382



DESIGNED BY	
CHECKED BY	
DRAWN BY	
QUANTITIES CHECKED	

DESIGNED BY	
CHECKED BY	
DRAWN BY	
QUANTITIES CHECKED	

11-16-67

9/1996

DESIGNED BY
 CHECKED BY
 DRAWN BY
 QUANTITIES CHECKED

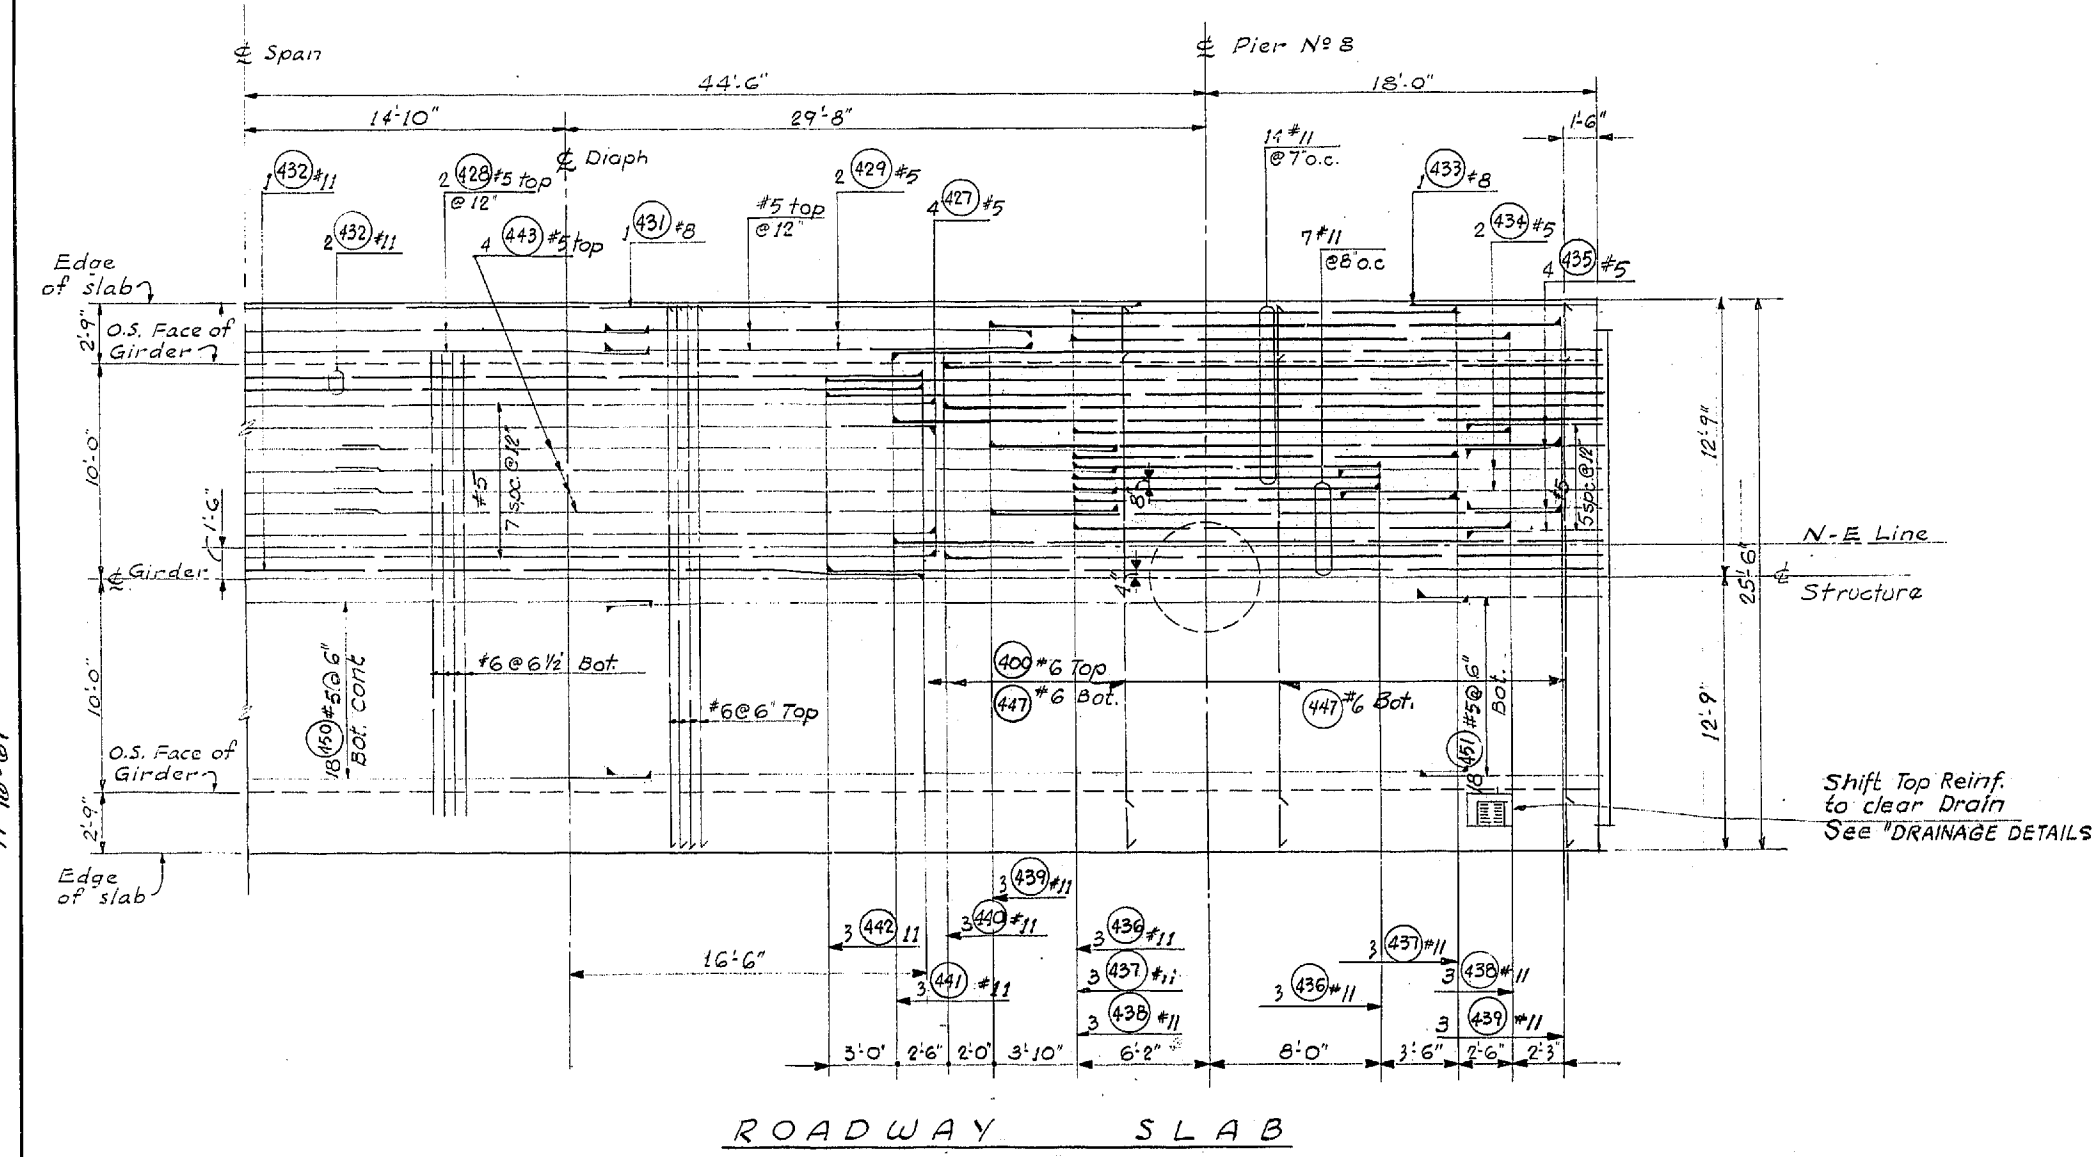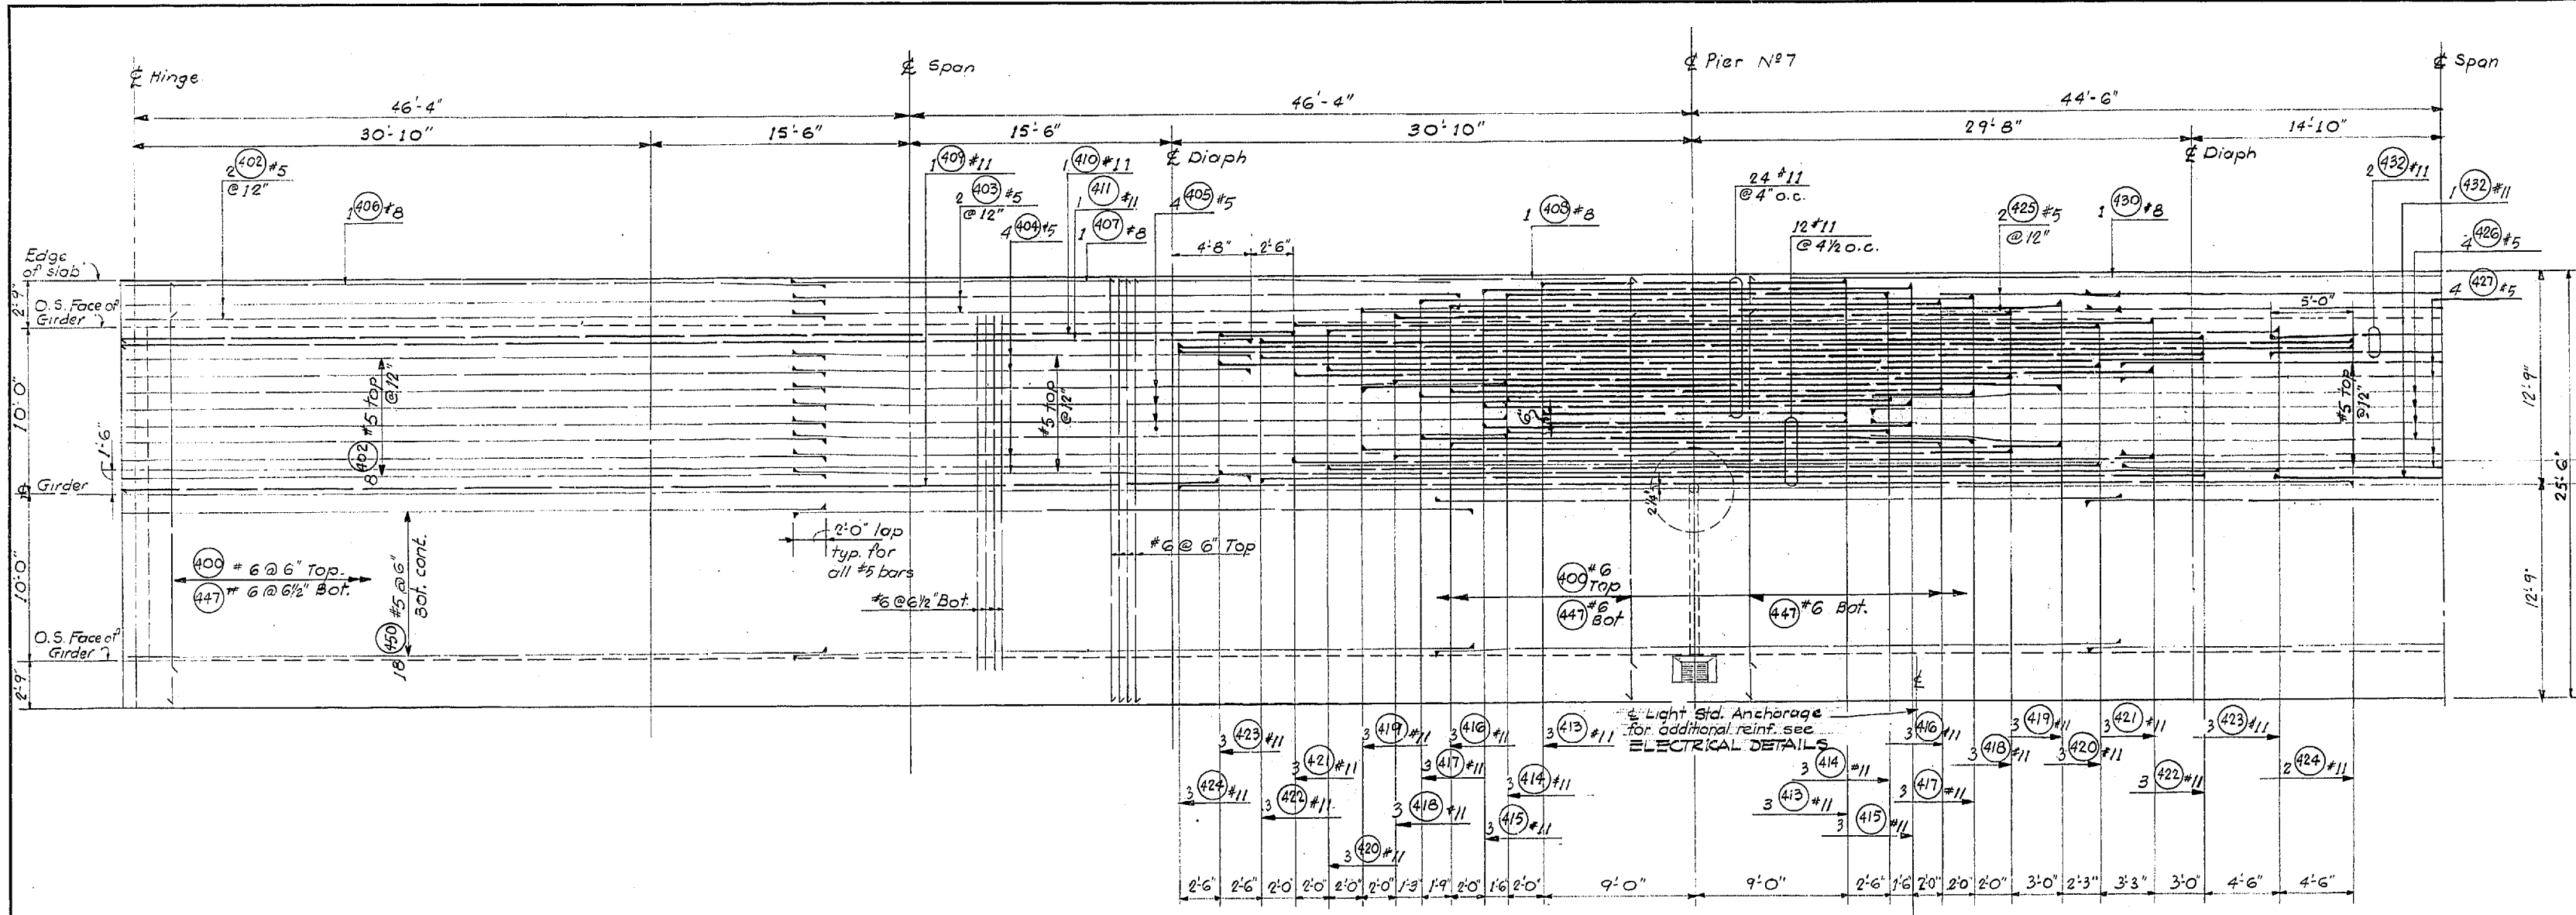


ROADWAY SLAB

DATE
 BY
 CHECKED BY
 LOG. ENGR.
 DIST. ENGR.

WOODVILLE INTERCHANGE
 PSH NO. 1-RE/PSH NO. 2-BO
 STRUCTURE
 ROADWAY SLAB
 SHEET 267 OF 289

11-16-67

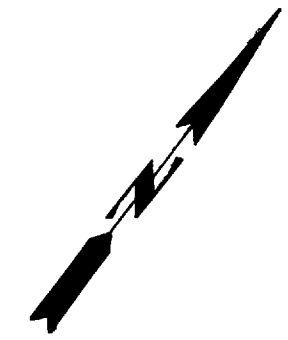

DATE	REVISION	BY

**WORTHINGTON, SKILLING
 HELLE & JACKSON**
 Consulting Civil and Structural Engineers
 SEATTLE WASHINGTON

SR 405
MP 23.49 TO MP 23.76
WOODVILLE INTERCHANGE
 KING COUNTY
N-W&N-E STRUCTURE

ROADWAY SLAB

WASHINGTON STATE HIGHWAY COMMISSION
 DEPARTMENT OF HIGHWAYS
 OLYMPIA, WASHINGTON
 GEORGE D. ZAMM, CHAIRMAN
 F. I. M'PAILSON, H. WALSH
 BARRY FERGUSON, JOHN M. BLUP
 BRIDGE ENGINEER

APPROVED: December 7, 1967
 SHEET 275 OF 297 SHEETS
 CONTRACT NO. 8382



8/1997

FED. ROAD DIV. NO.	STATE	FED. AID PROJ. NO.	SHEET NO.	TOTAL SHEETS
8	WASH.	I-405-3(297)178	276	297

DESIGNING ENGINEER	
DESIGN CHECKER	
DRAWN BY	
CHECKED BY	
QUANTITIES CHECKED	


DATE	
BY	
DRAWN	
TRACED	
CHECKED	
BY	
DATE	

WOODINVILLE INTERCHANGE
 PSH NO. 2-BO
 STRUCTURE
 SHEET 276 OF 297

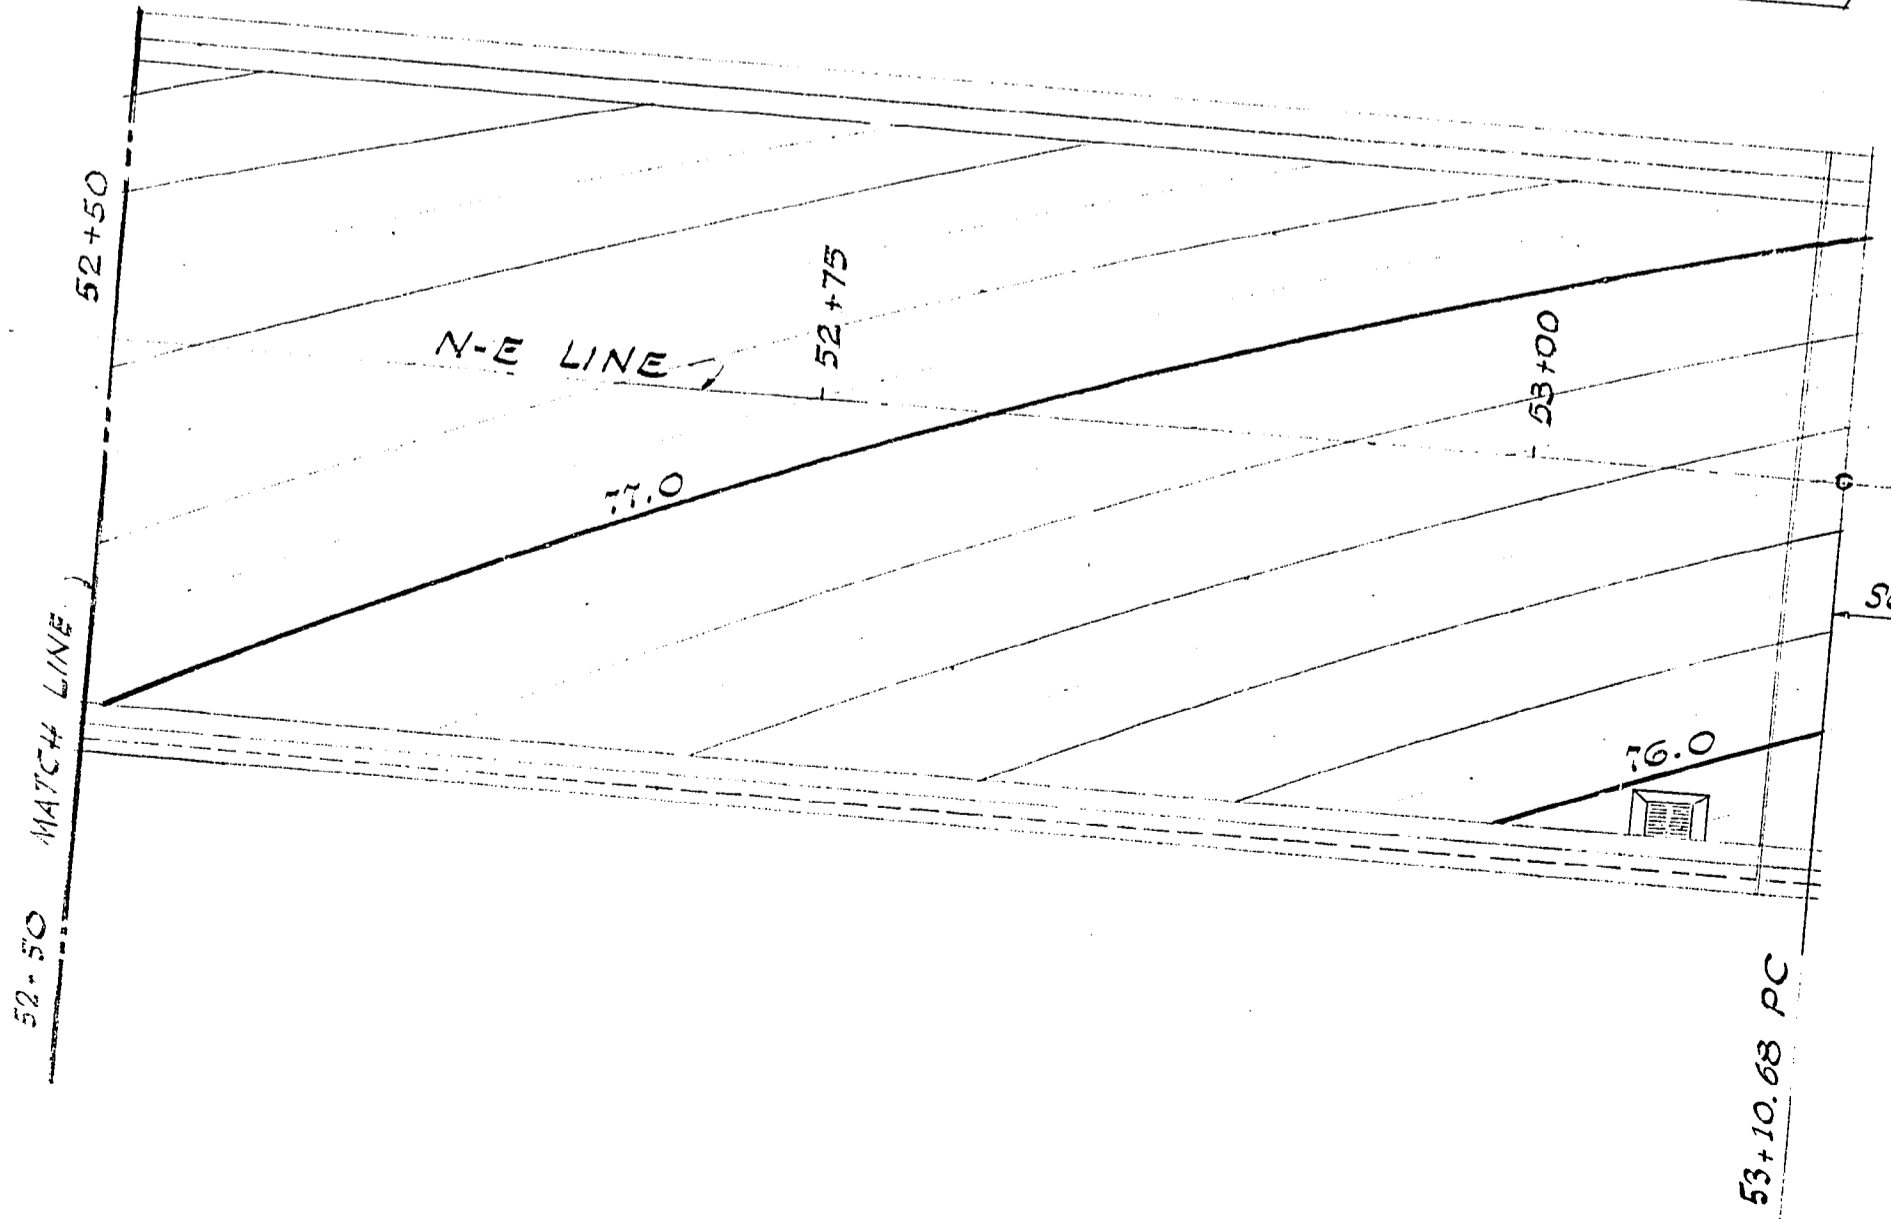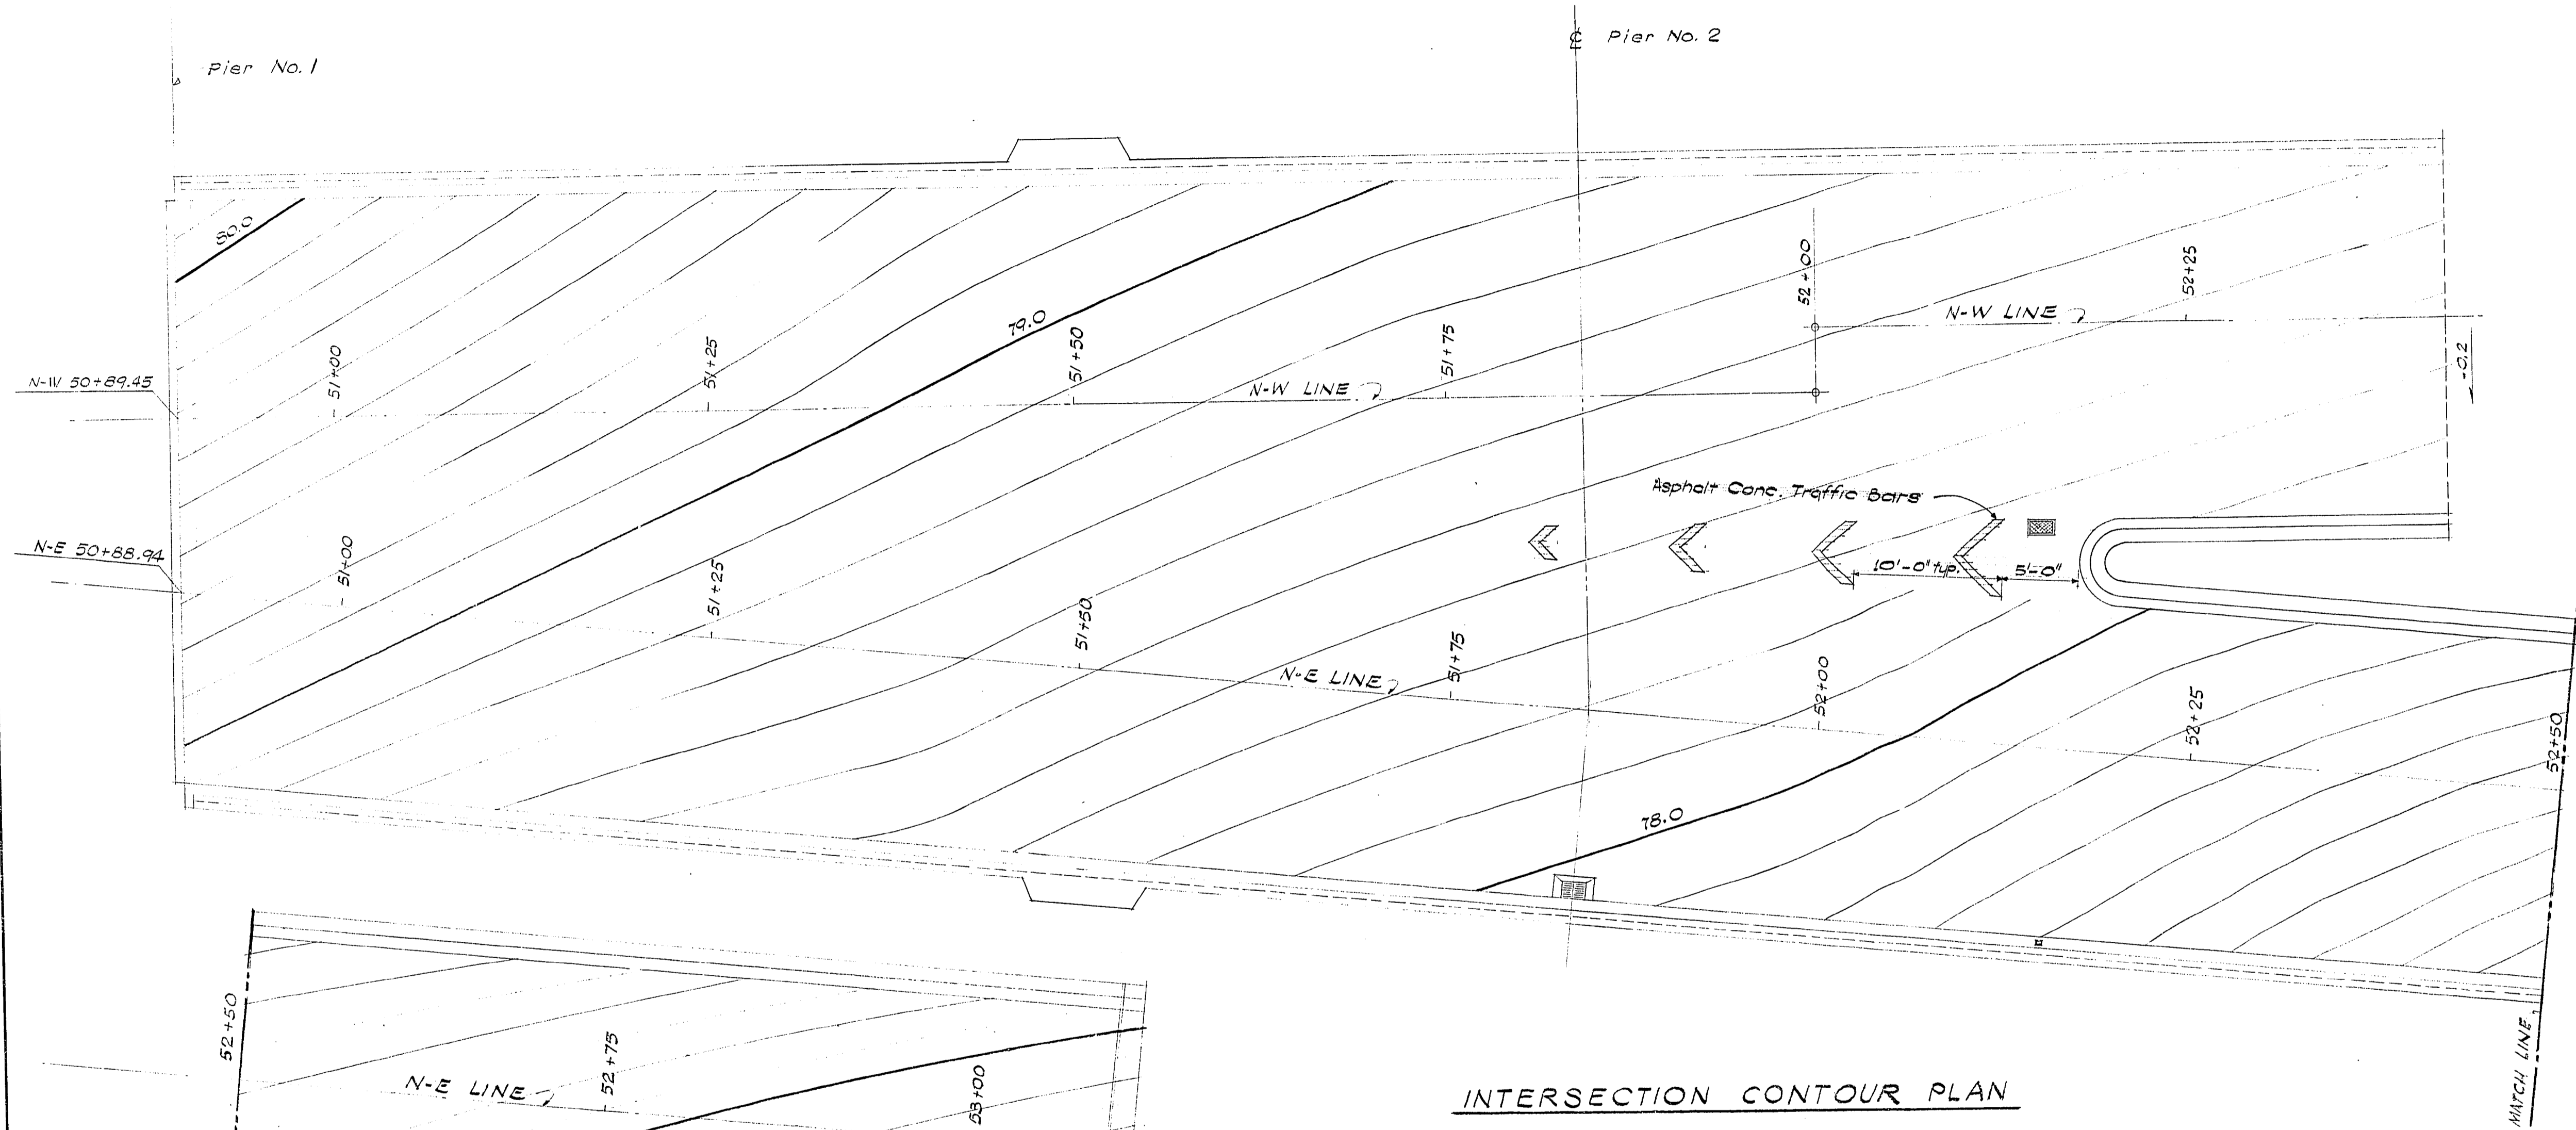

INTERSECTION CONTOUR PLAN

See Superelevation Profile
 N-E Line

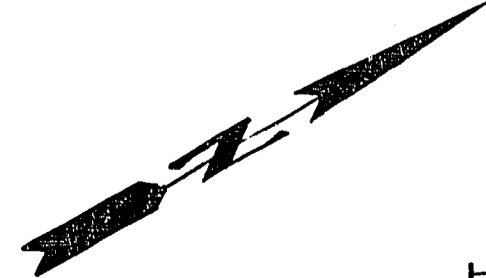

DATE	REVISION	BY
WORTHINGTON, SKILLING HELLE & JACKSON Consulting Civil and Structural Engineers SEATTLE WASHINGTON		

As Built Changes in Red 7-15-76

SR 405
MP 23.49 TO MP 23.76
WOODINVILLE INTERCHANGE
 KING COUNTY
N-W & N-E STRUCTURE
INTERSECTION CONTOUR PLAN








WASHINGTON STATE HIGHWAY COMMISSION
 DEPARTMENT OF HIGHWAYS
 OLYMPIA, WASHINGTON

GEORGE D. ZAHN, CHAIRMAN
 F. L. MYRASON
 K. WALSH
 BAKER FERGUSON
 JOHN N. RUPP

APPROVED: December 7, 1967
SHEET 276 OF 297 SHEETS
 CONTRACT NO. 8382

BRIDGE ENGINEER

FED. ROAD DIV. NO.	STATE	FED. AID PROJ. NO.	SHEET NO.	TOTAL SHEETS
8	WASH.	I-405-3(297)178	277	297

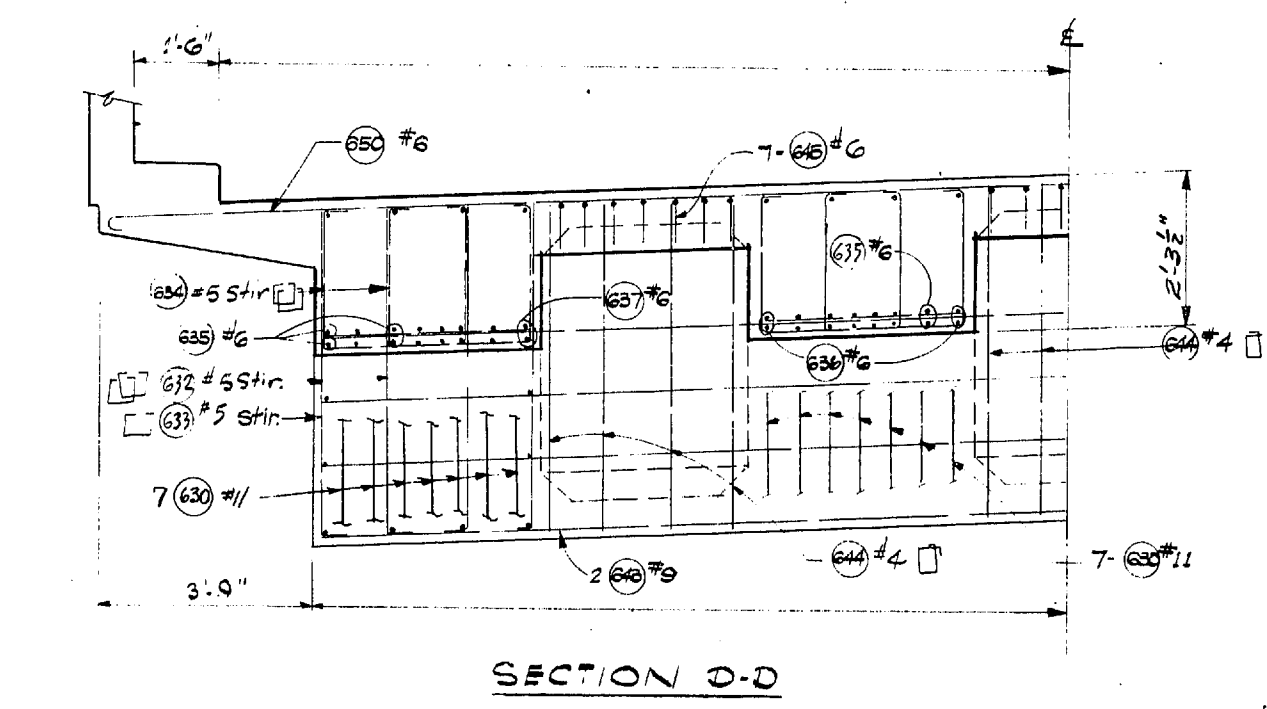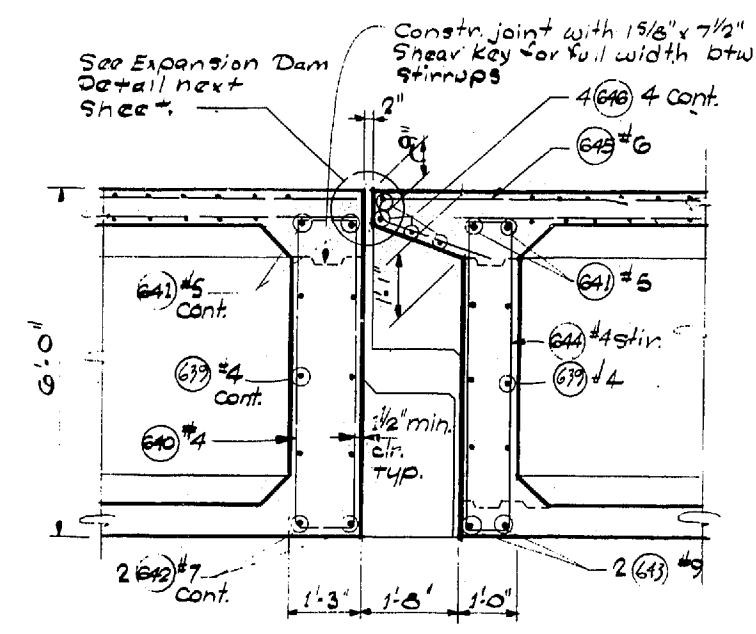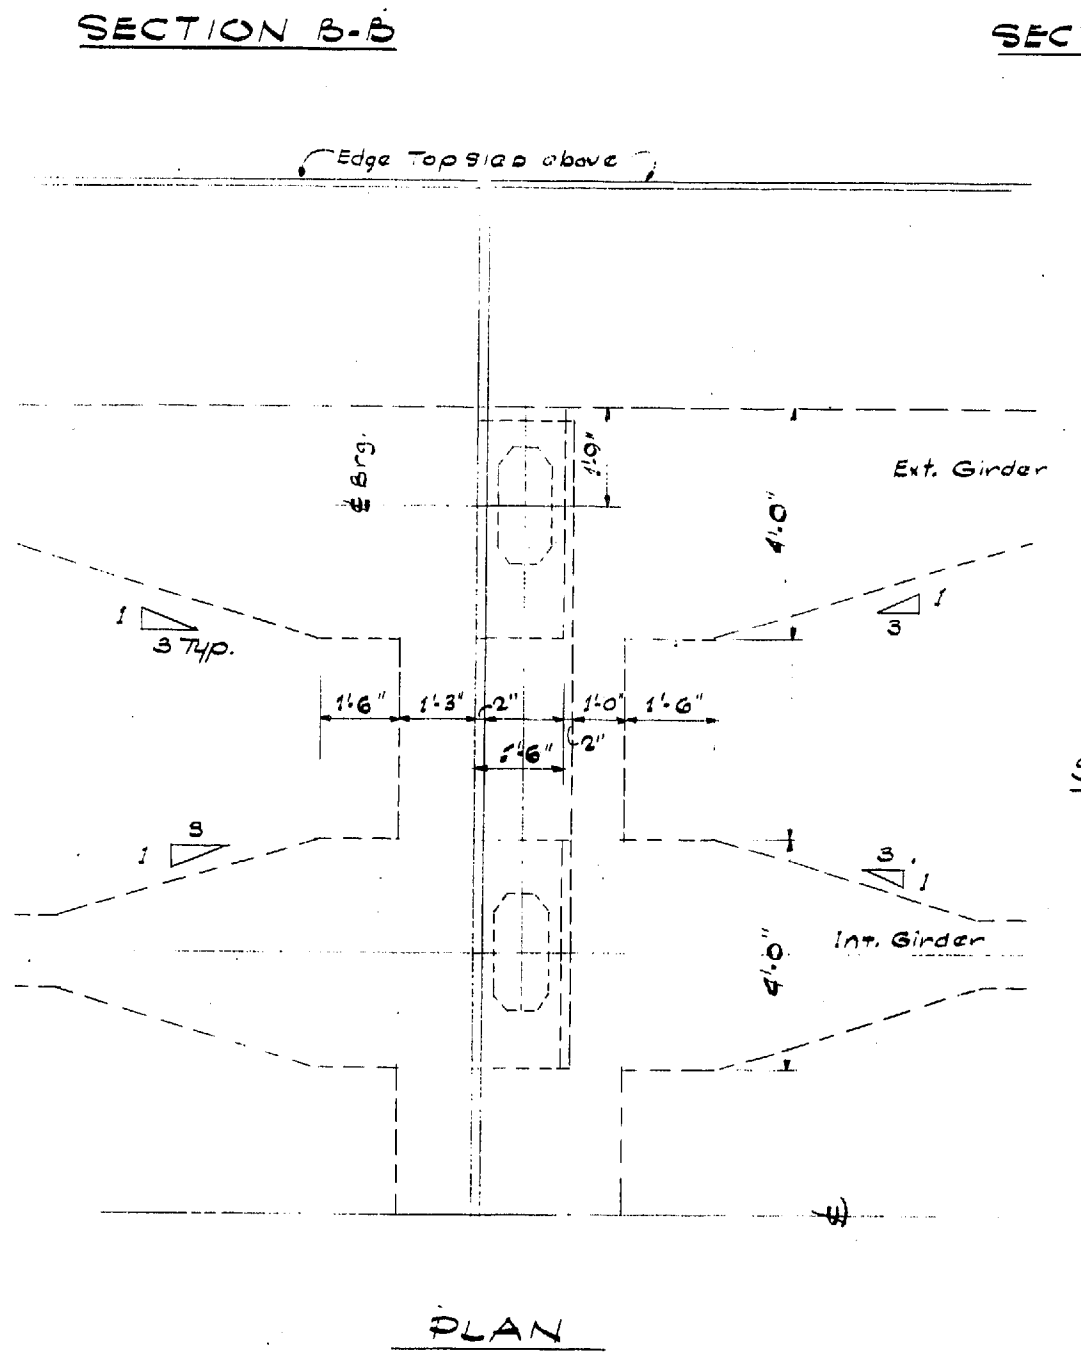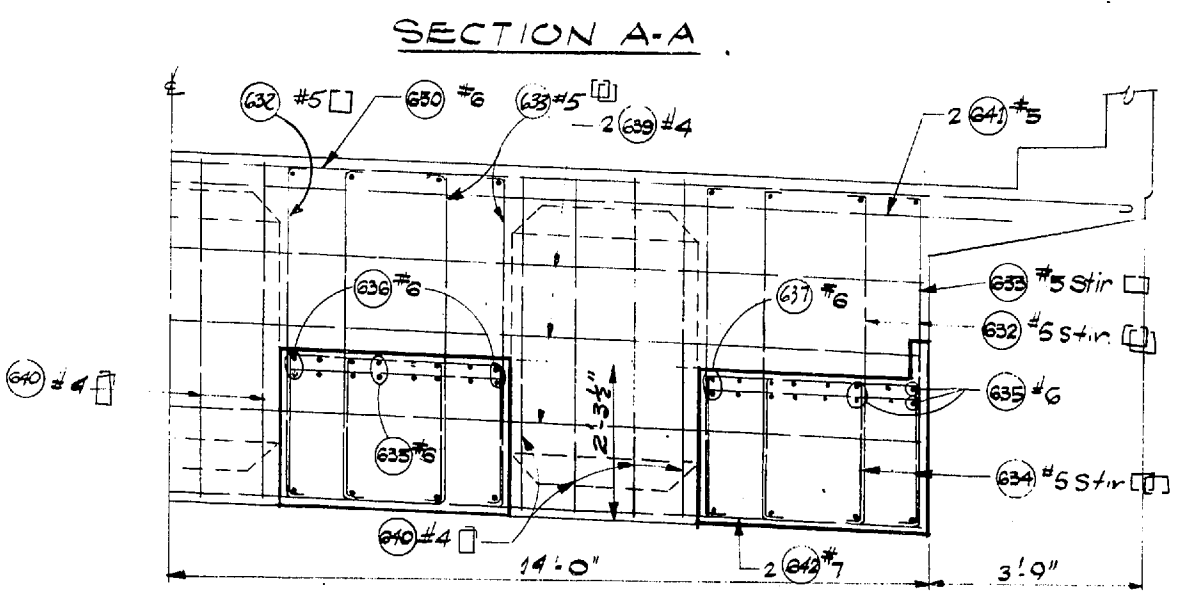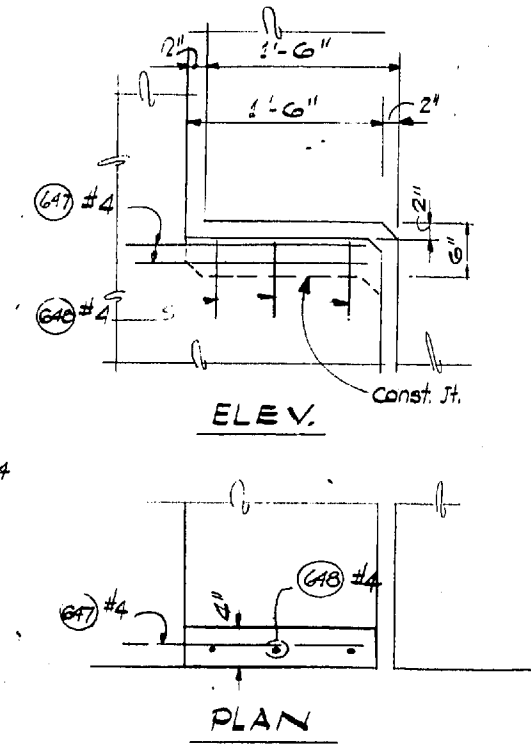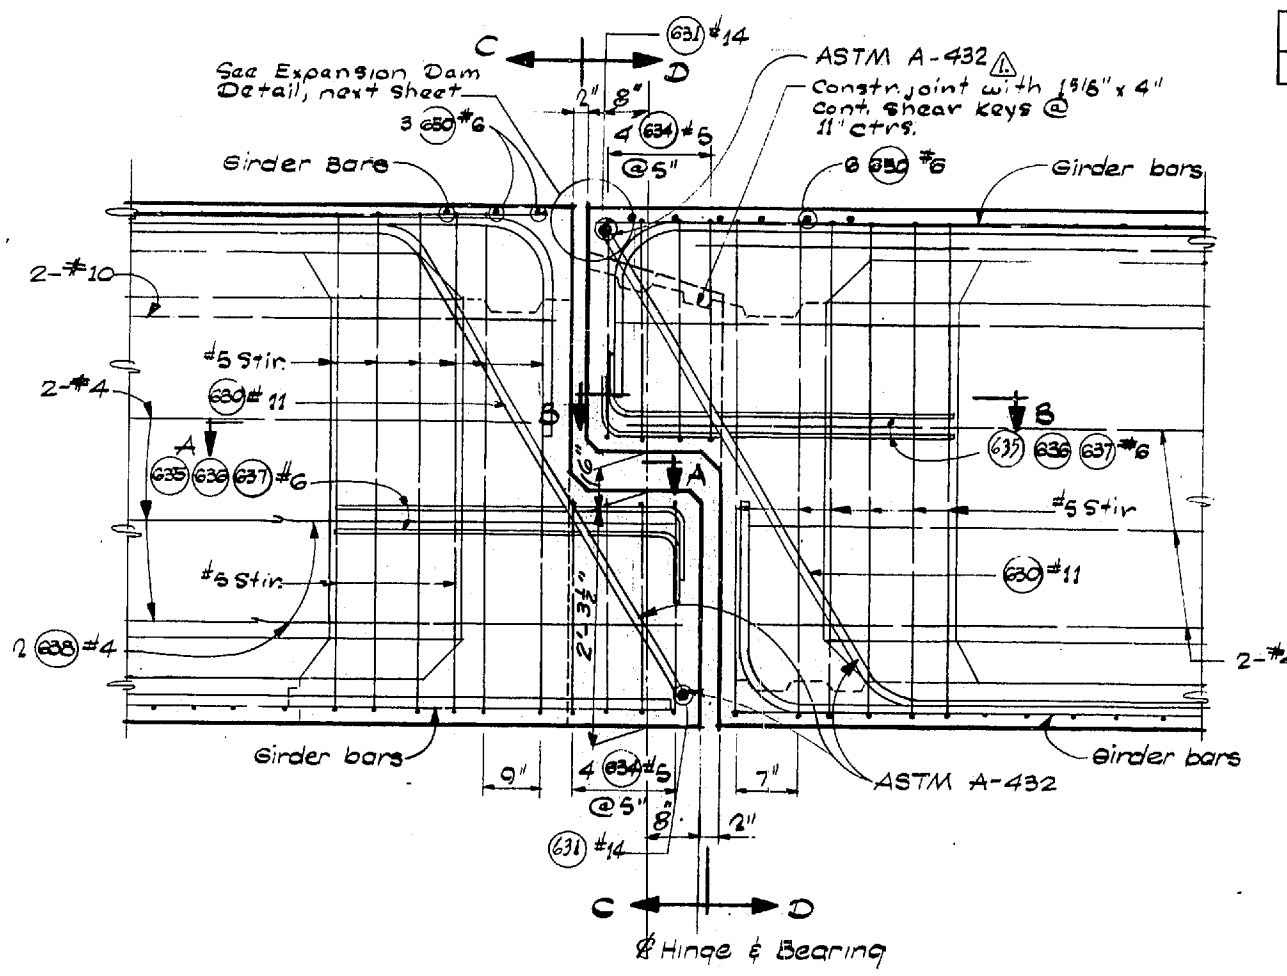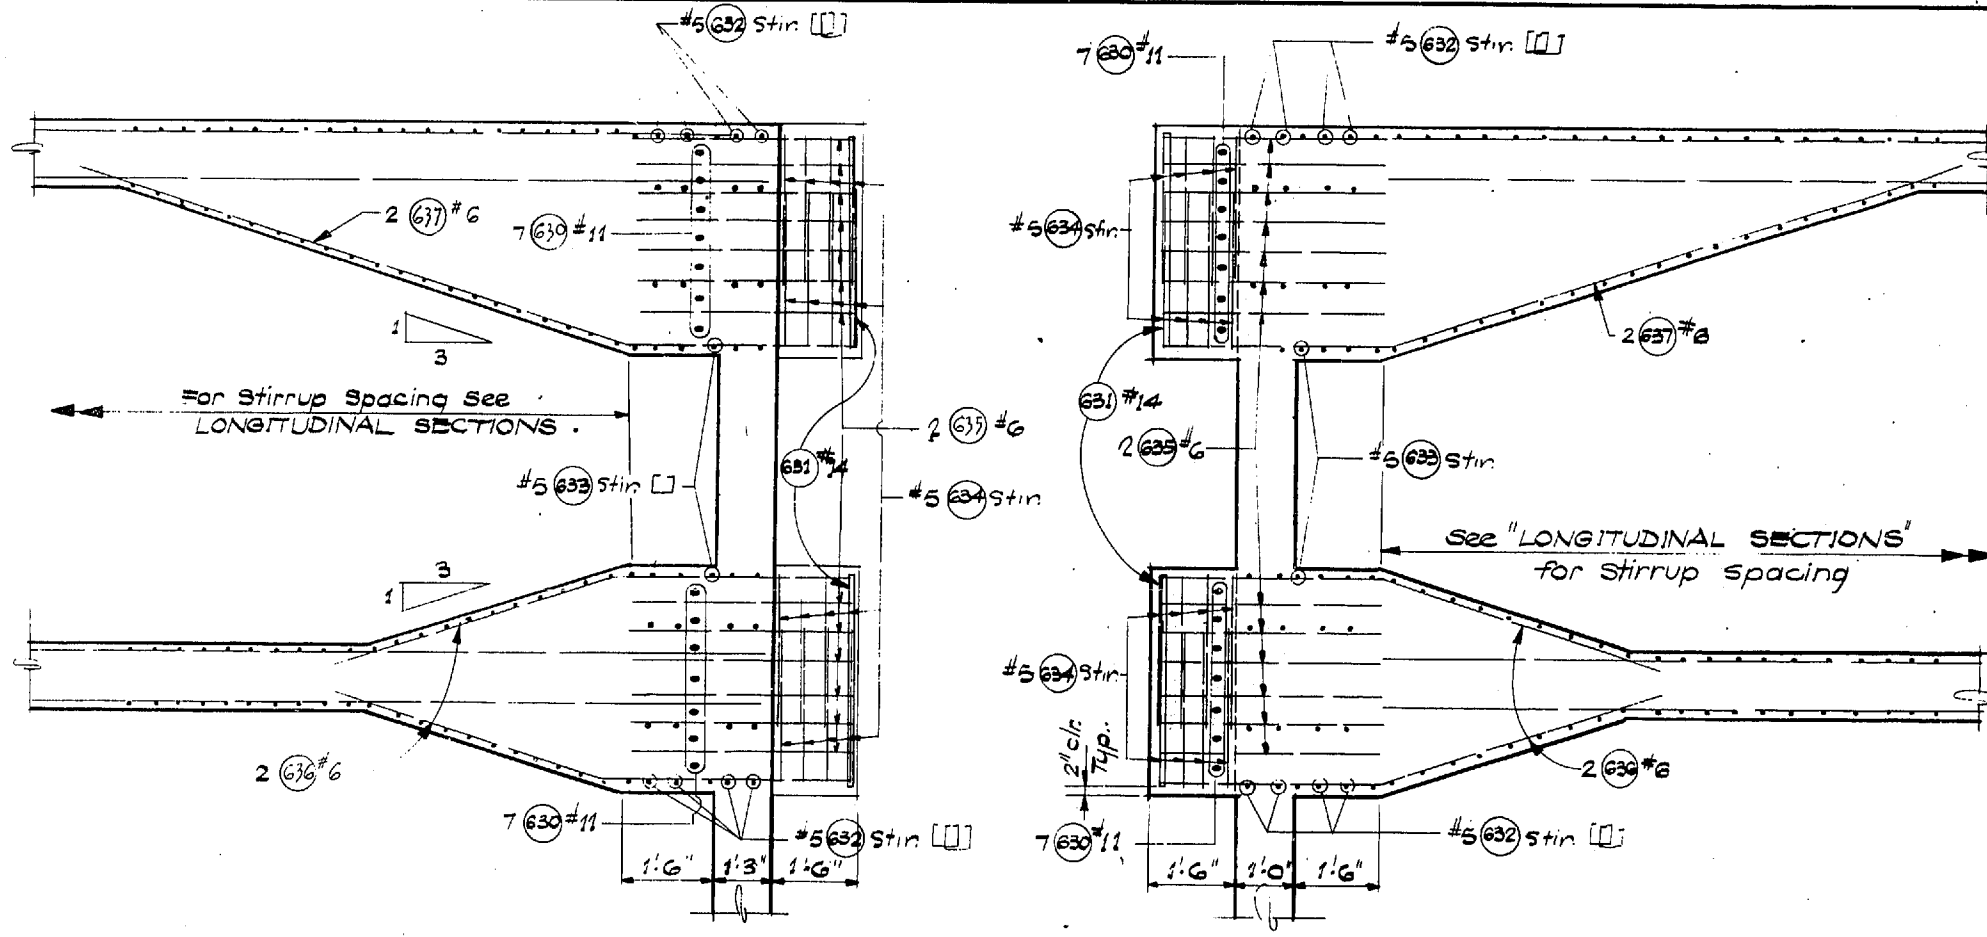

SECTION BETWEEN BEARING SUPPORTS

DESIGNED BY
CHECKED BY
DRAWN BY
QUANTITIES FIGURED
QUANTITIES CHECKED

DATE
BY
CHECKED
LOC. INCH.
DWT. INCH.

PSH 401-167/ASH 2-80
N-GAIN STRUCTURES
-HINGE DETAILS-
SHEET 219 OF 289 11-16-67

2-7-68 Added Steel Designation WWS

DATE	REVISION	BY

WORTHINGTON, SKILLING
HELLE & JACKSON
Consulting Civil and Structural Engineers
SEATTLE WASHINGTON

SR 405
MP 23.49 TO MP 23.76
WOODINVILLE INTERCHANGE
KING COUNTY
N-W & N-E STRUCTURE
HINGE DETAILS

WASHINGTON STATE HIGHWAY COMMISSION
DEPARTMENT OF HIGHWAYS
OLYMPIA, WASHINGTON

GEORGE D. ZAHN, CHAIRMAN

R. L. MITCHELL
H. WALSH


BAKER PEROUX
JOHN N. RUPP

APPROVED: December 7, 1967
SHEET 277 OF 297 SHEETS
CONTRACT NO. 8382


BRIDGE ENGINEER

9/1996


FED. ROAD DIV. NO.	STATE	FED. AID PROJ. NO.	SHEET NO.	TOTAL SHEETS
8	WASH.	I-405-3(297)178	278	297

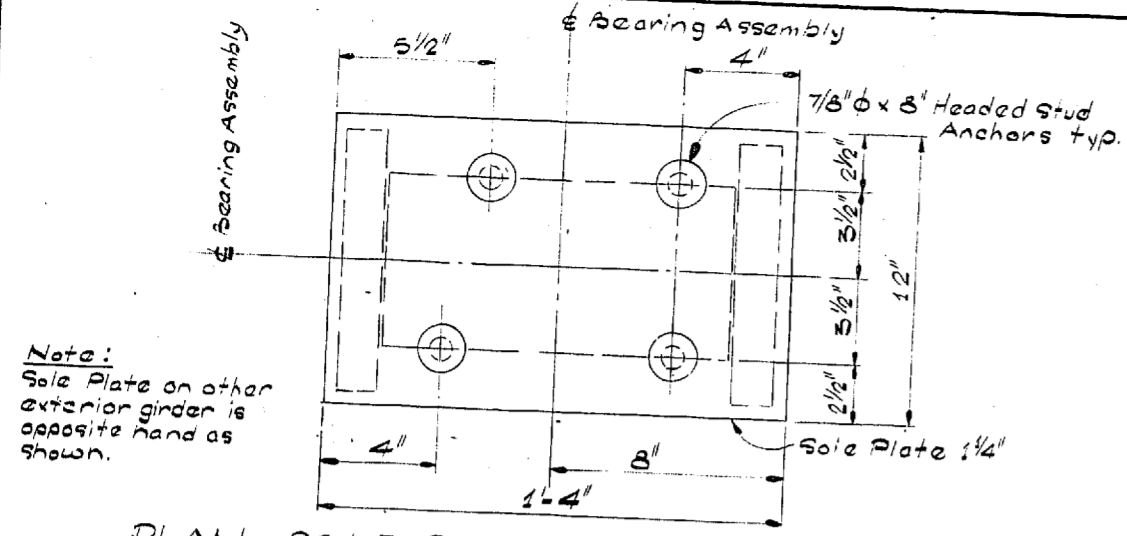


PLAN - SOLE PLATE - EXTERIOR GIRDER

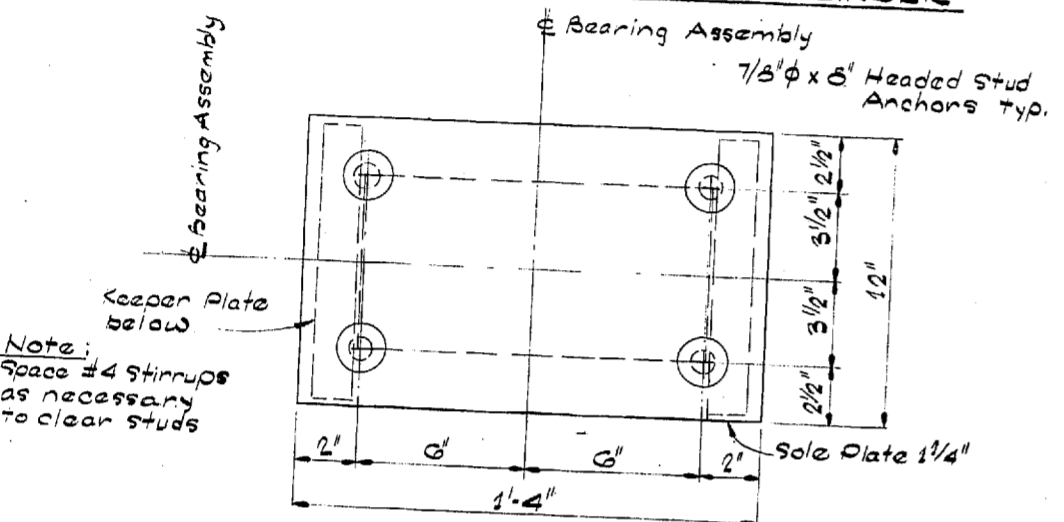


PLAN - SOLE PLATE - INTERIOR GIRDER

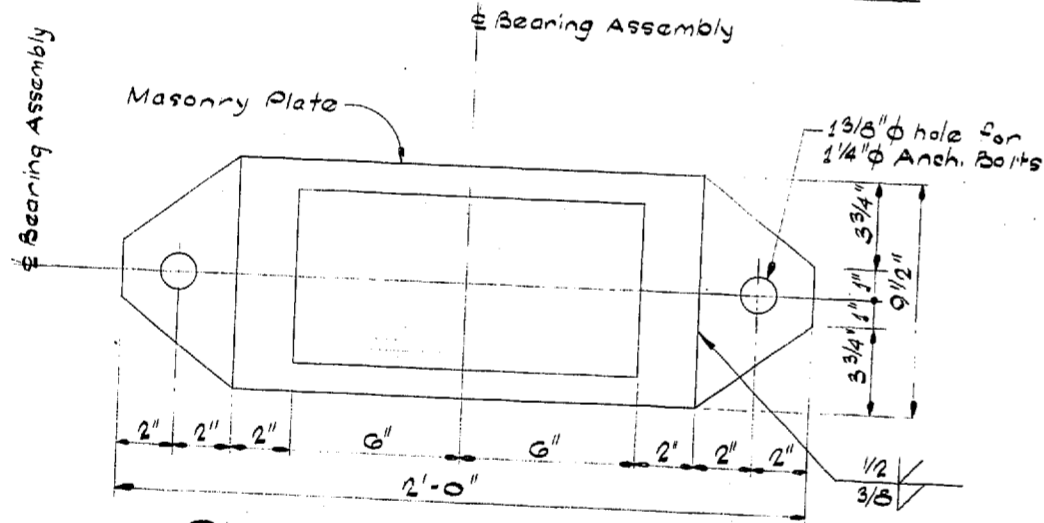


PLAN - MASONRY PLATE

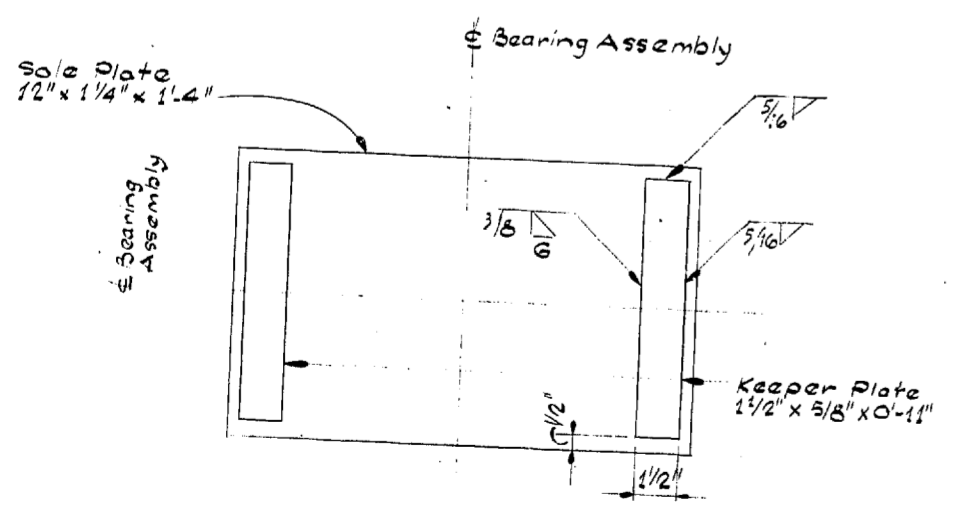


PLAN - KEEPER PLATE

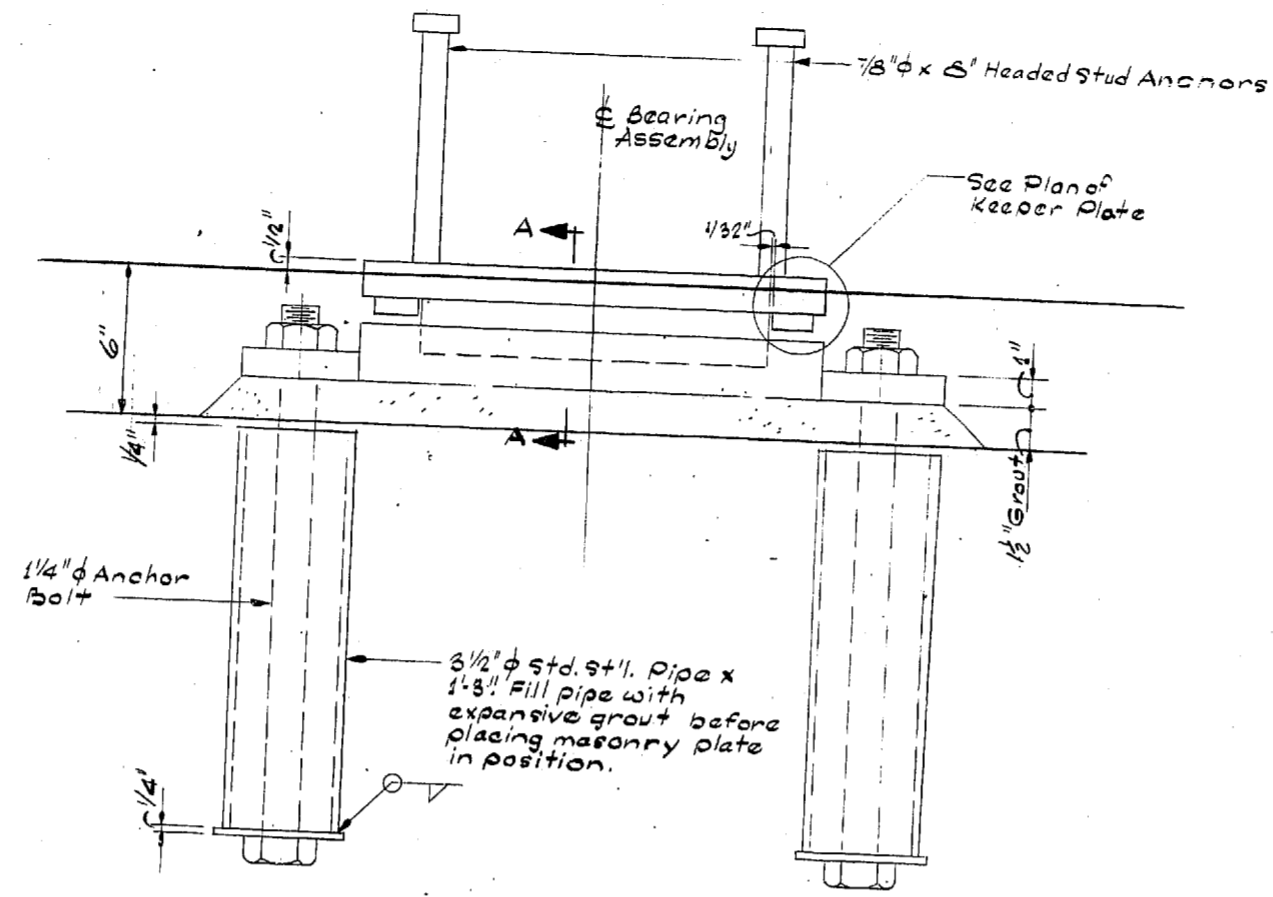


ELEVATION - BEARING ASSEMBLY

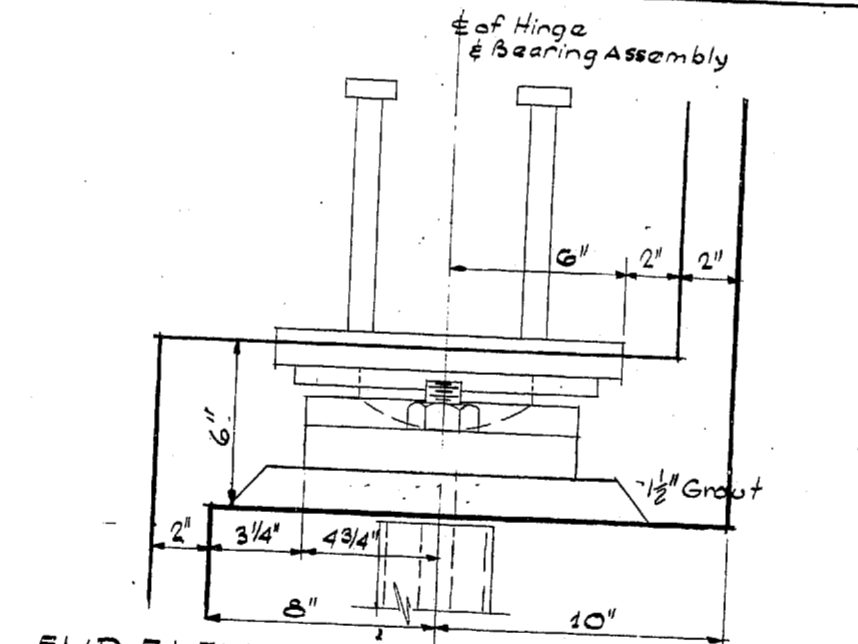


END ELEVATION - BEARING ASSEMBLY

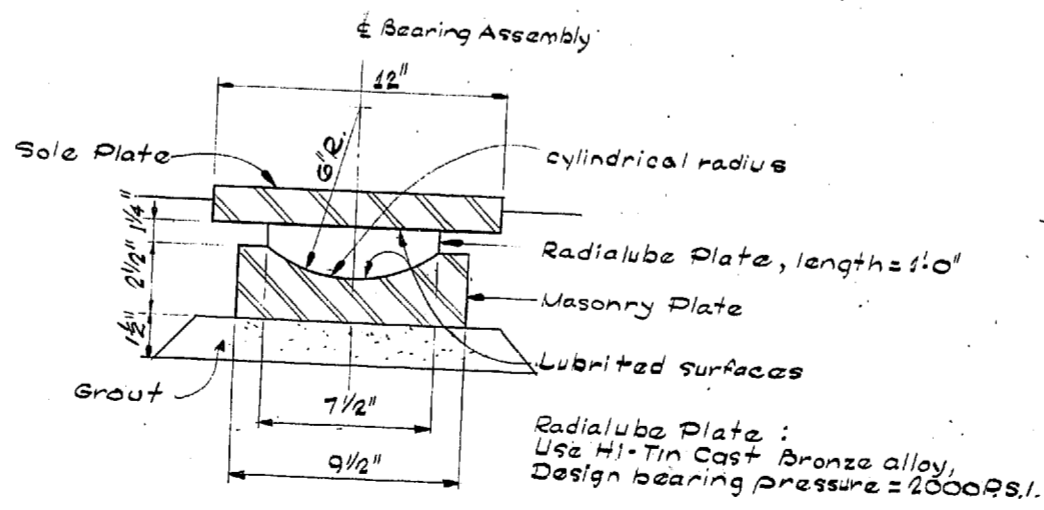

SECTION A-A

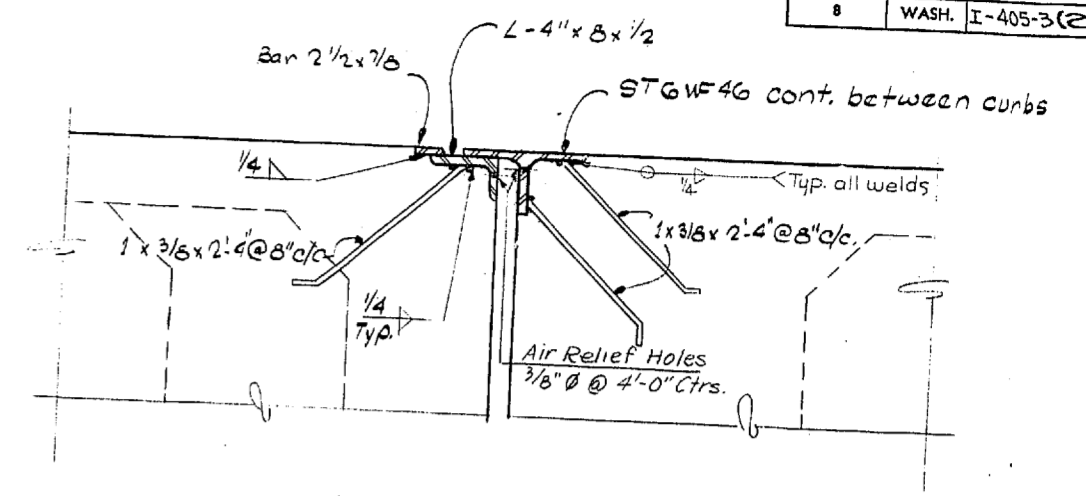

SECTION AT BEARING SUPPORT

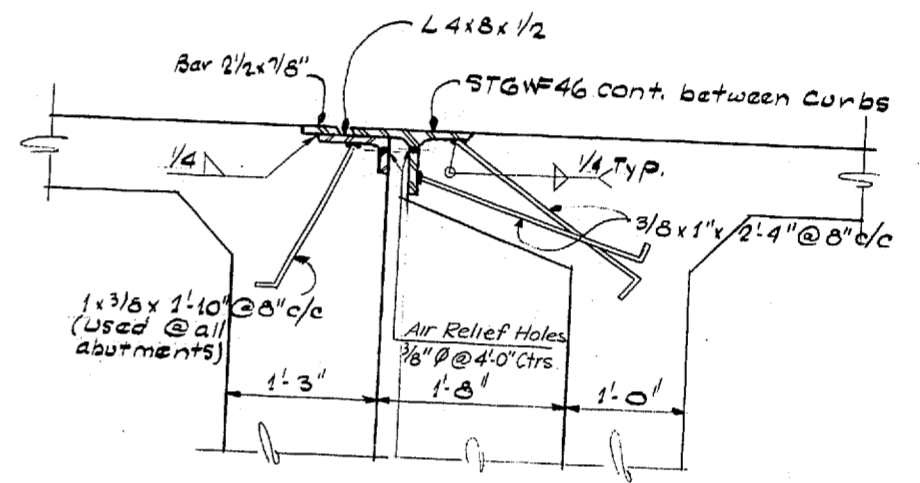

SECTION BETWEEN BEARING SUPPORTS
SIMILAR @ ABUTMENTS
EXPANSION JOINT DETAIL

DESIGNING ENGINEER	
DRAWN	
CHECKED	
QUANTITIES FIGURED	
QUANTITIES CHECKED	

DATE	
BY	
DATE	
BY	
DATE	
BY	

WOODVILLE INTERCHANGE
PSH NO. 1-RE, PSH NO. 2-BO
N-W & N-E STRUCTURE
BEARING ASSEMBLY & EXP. JT DETAIL
SHEET 278 OF 297

11-16-67

DATE	REVISION	BY
WORTHINGTON, SKILLING HELLE & JACKSON Consulting Civil and Structural Engineers SEATTLE WASHINGTON		

SR 405
MP 23.49 TO MP 23.76
WOODVILLE INTERCHANGE
 KING COUNTY
N-W & N-E STRUCTURE
**BEARING ASSEMBLY & EXPANSION
JOINT DETAILS**

WASHINGTON STATE HIGHWAY COMMISSION
 DEPARTMENT OF HIGHWAYS
 OLYMPIA, WASHINGTON

GEORGE D. ZAHN, CHAIRMAN
 F. L. MYRASON
 H. WALSH
 MEE FERGUSON
 JOHN H. WELBY

APPROVED December 7, 1967
 SHEET 278 OF 297 SHEETS
 CONTRACT NO. 8382


MADE IN WASHINGTON
 ENGINEER

9/1996


SCHEDULE OF BRIDGE DRAINS

DRAIN TYPE	STATION & LOCATION	PIER	DIM. "L"	TYPE DRAINAGE	DRAIN PIPE LENGTH
N-W STRUCTURE					
5	53+05.45 RT	Exp. Jt.	3'-3"	S.B.	-
5	53+19.6 RT	Exp. Jt.	3'-3"	S.B.	-
5	54+04.45 LT	1	3'-3"	S.B.	-
5	55+19.45 LT	5	3'-3"	S.B.	-
5	56+42.75 LT	Exp. Jt.	3'-3"	S.B.	-
5	59+34.30 LT	Exp. Jt.	3'-3"	S.B.	-
5	60+27.96 LT	10	3'-3"	S.B.	-
5	62+28.2 LT	Exp. Jt.	3'-3"	S.B.	-
5	63+21.86 LT	13	3'-3"	D.P.#	-
1	65+53.17 LT	15	5'-6"	D.P.	30'


DRAIN TYPE	STATION & LOCATION	PIER	DIM. "L"	TYPE DRAINAGE	DRAIN PIPE LENGTH
N-E STRUCTURE					
5	51+88.23 RT	2	2'-9"	D.P.#	25'
5	53+07.76 RT	Exp. Jt.	2'-9"	D.P.#	35'
5	54+73.43 RT	5	2'-9"	All "A"	-
5	55+94.76 RT	Exp. Jt.	2'-9"	All "A"	-
5	56+91.45 RT	7	2'-9"	S.B.	-
1	57+98.23 RT	8	5'-6"	D.P.	90'

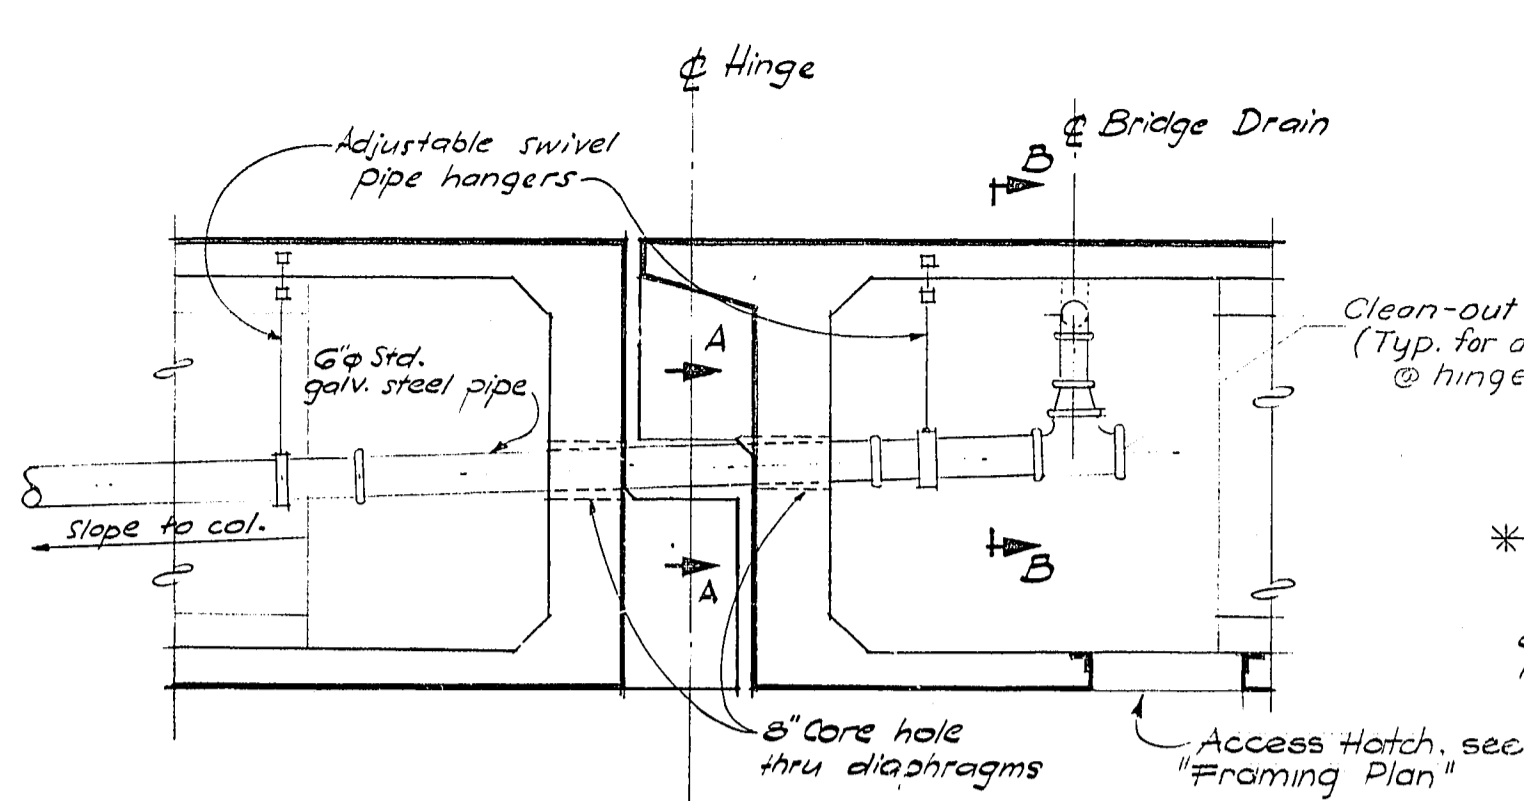


DOWNSPOUT DETAIL @ HINGE

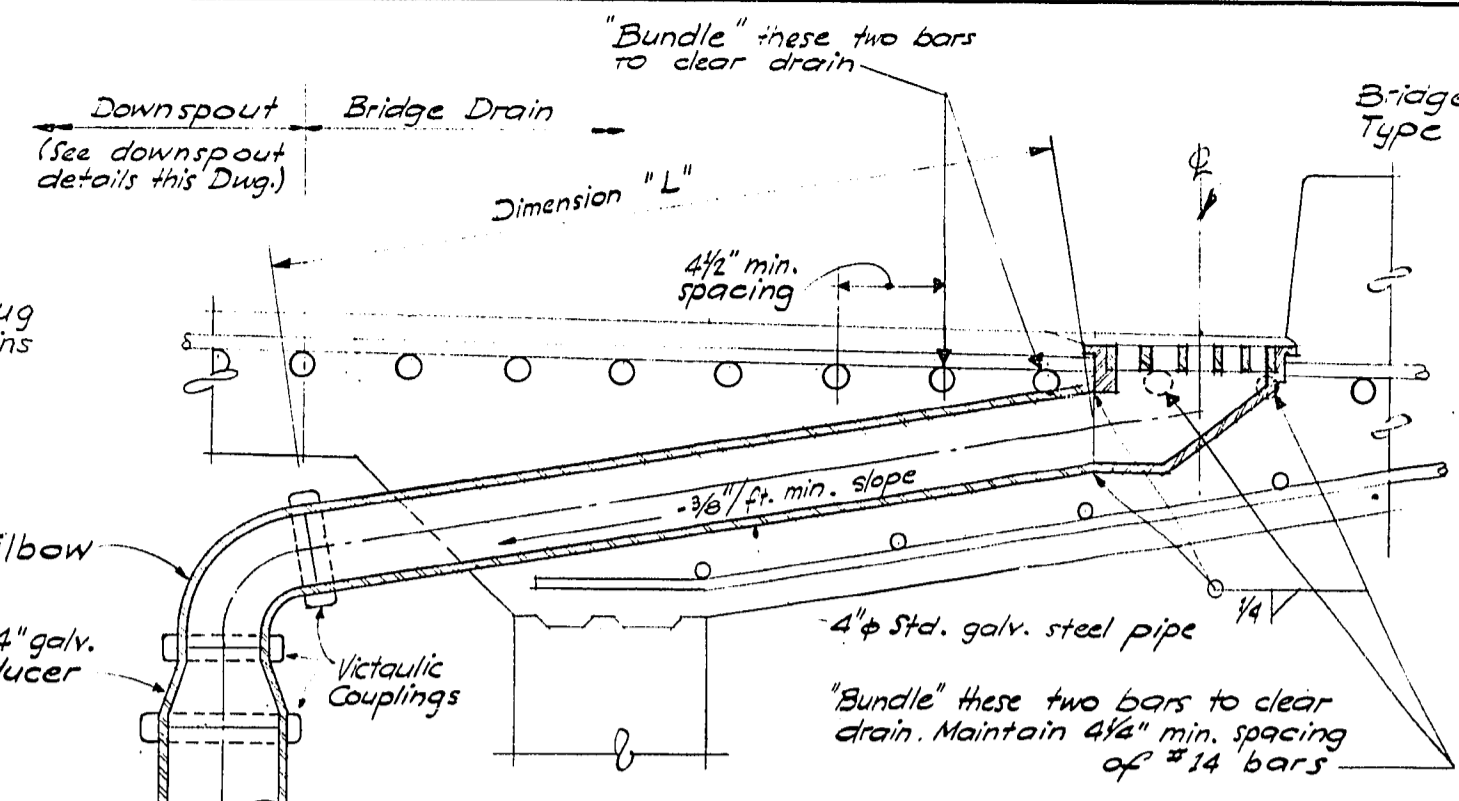


TYPE 5 BRIDGE DRAIN DETAIL

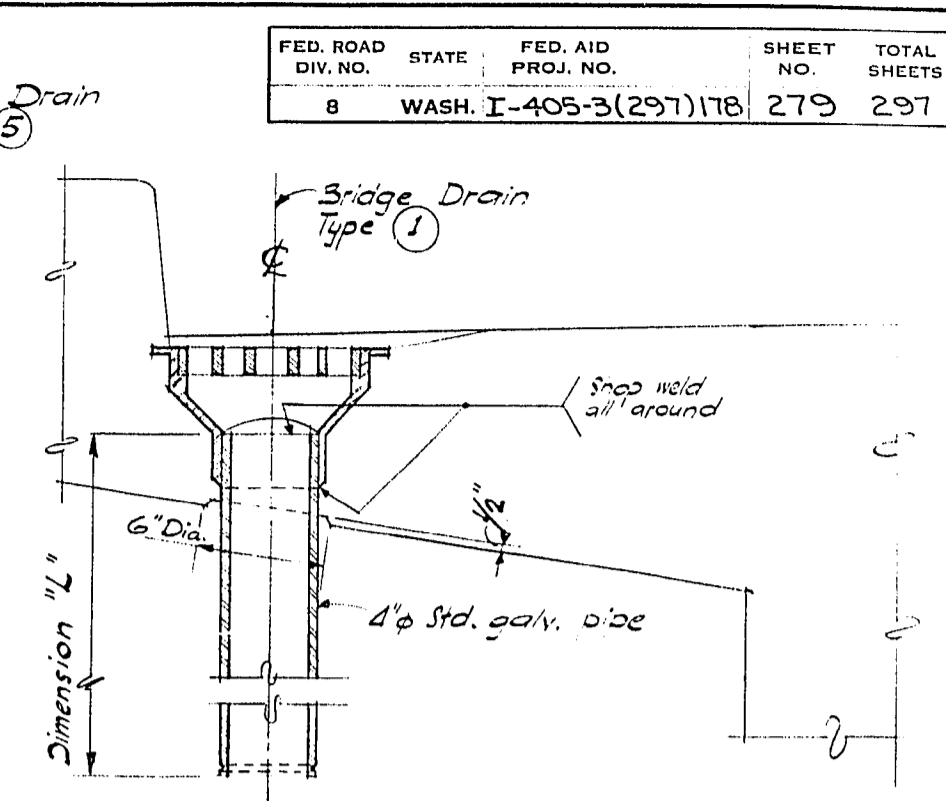


TYPE 1 BRIDGE DRAIN DETAIL

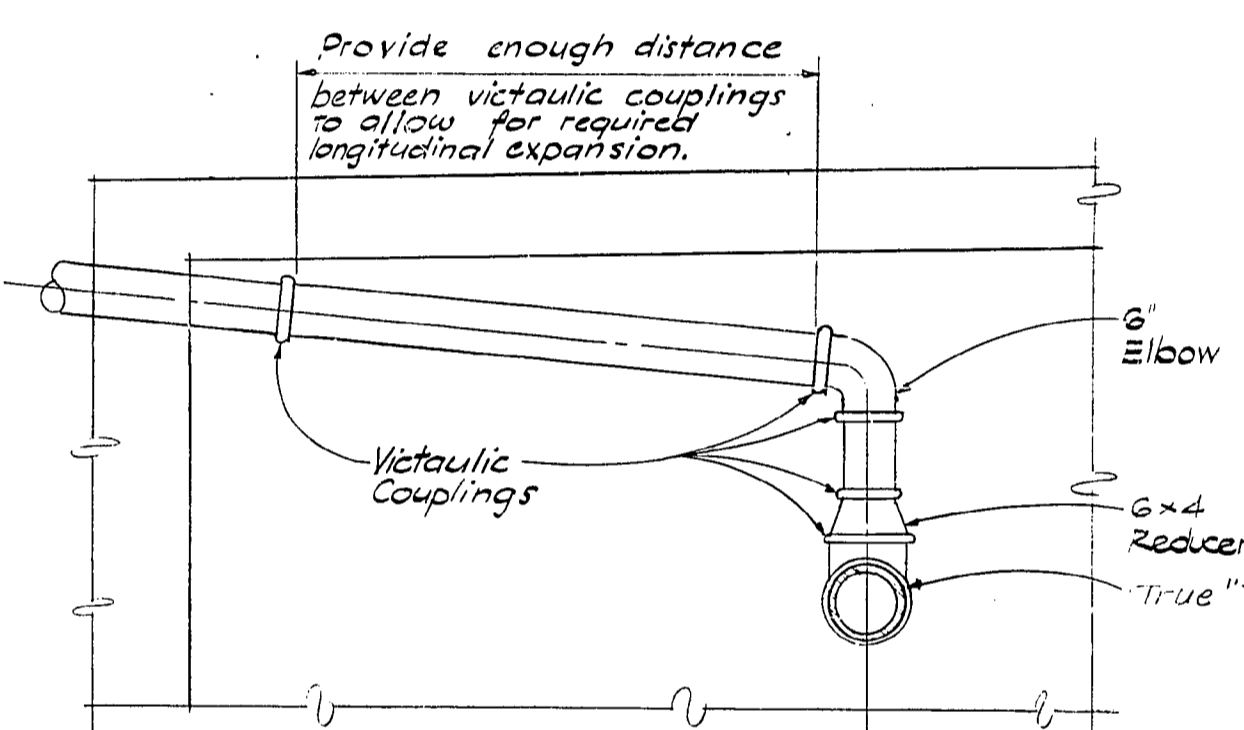


SECTION B-B

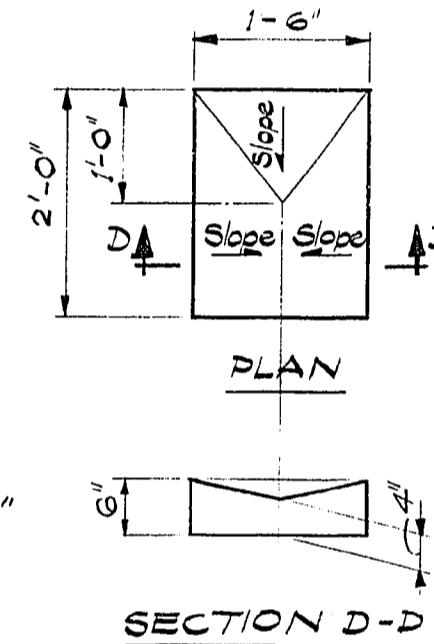

SPLASH BLOCK DETAILS

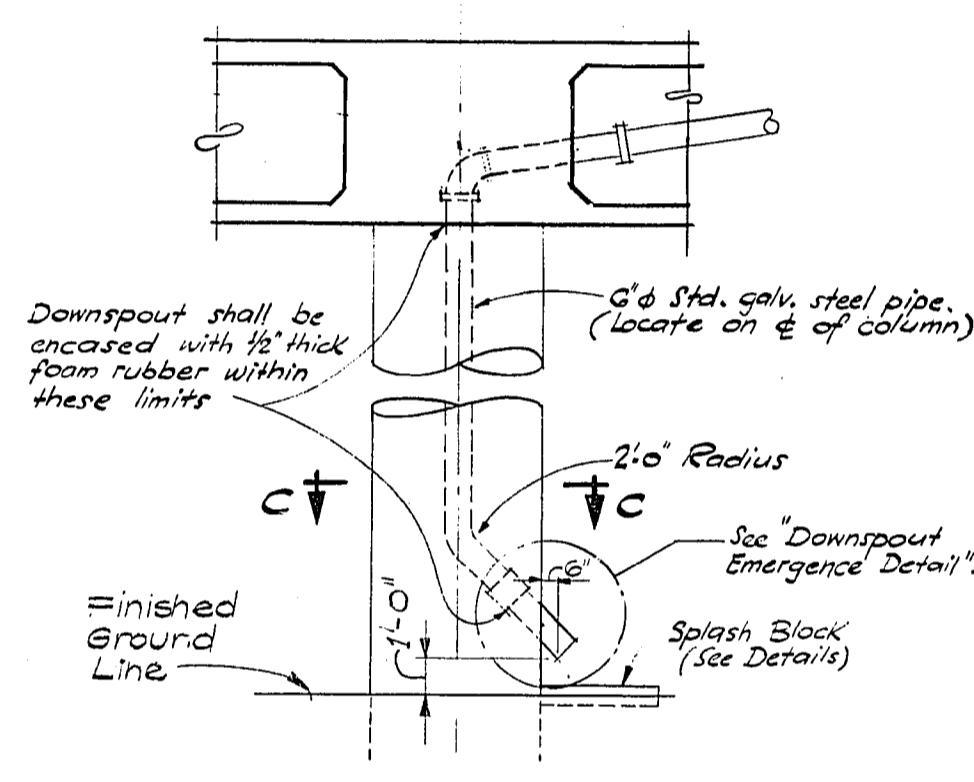


ELEVATION DOWNSPOUT DETAILS

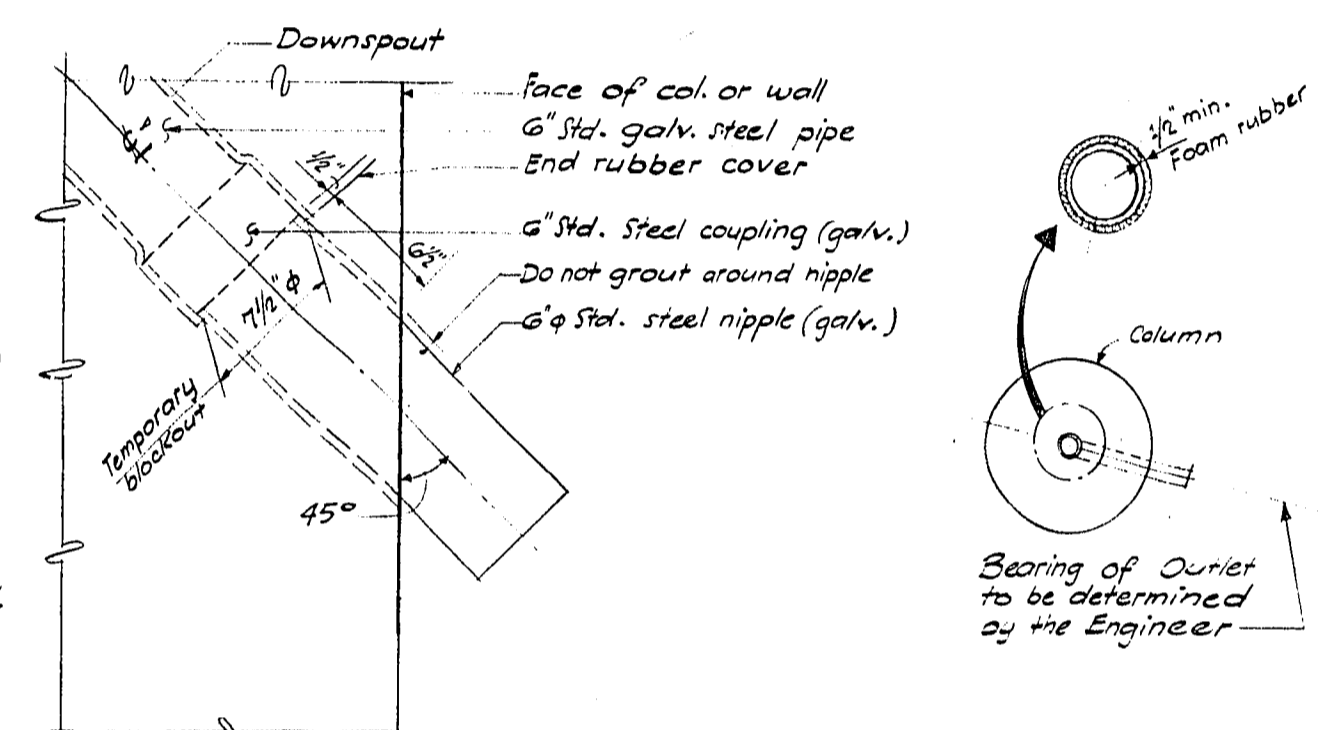


DOWNSPOUT EMERGENCE DETAIL

SECTION C-C

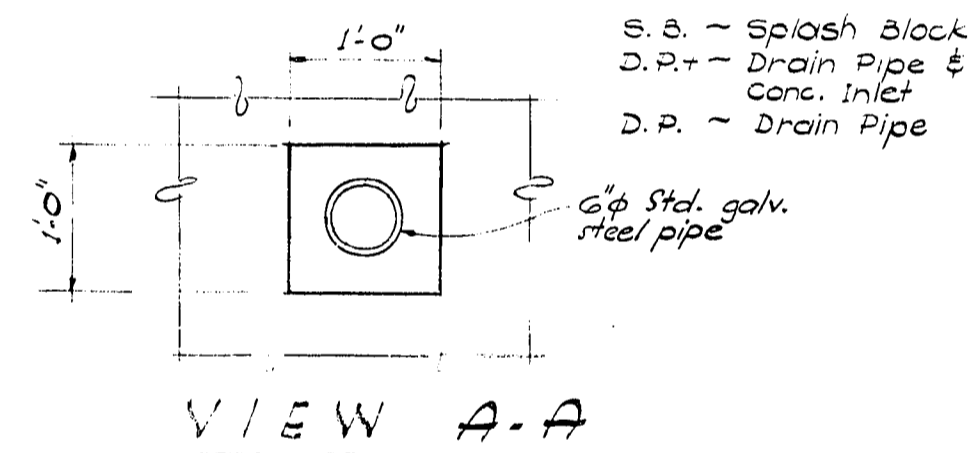


VIEW A-A

S.B. - Splash Block
D.P.# - Drain Pipe & Conc. Inlet
D.P. - Drain Pipe

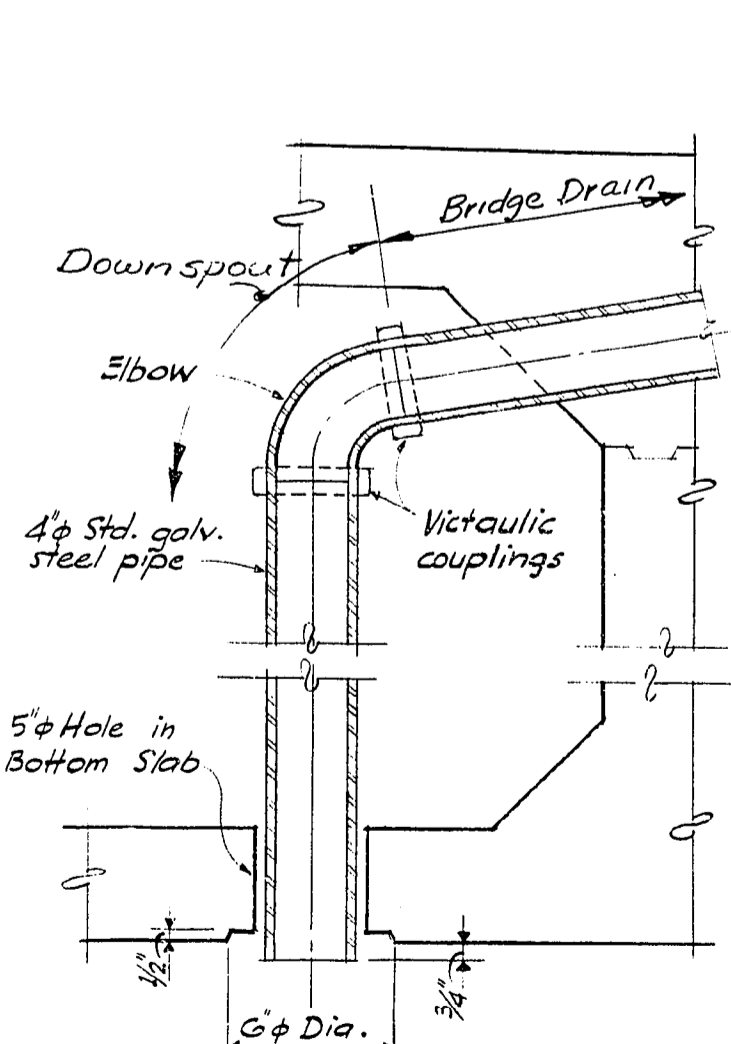

DOWNSPOUT ALTERNATE "A" TYPICAL OVER RIVER

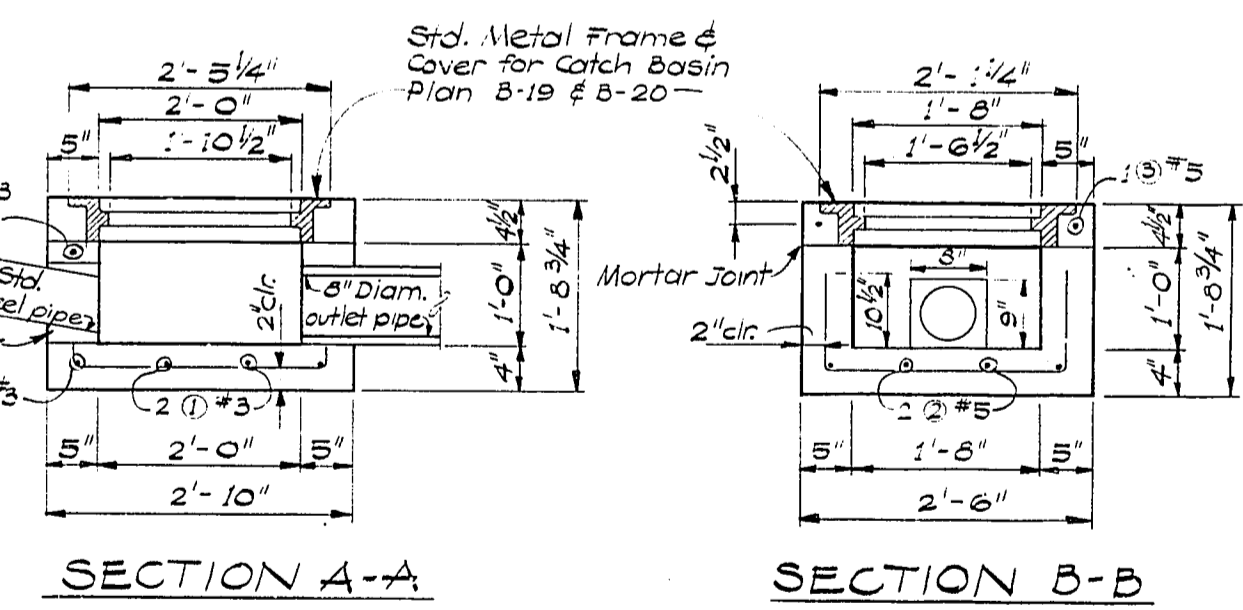

BAR LIST
ALL DIMENSIONS ARE OUT TO OUT

MARK	LOCATION	NO.	SIZE	LENGTH	BENDING DIAGRAM
1	Bottom Slab & Side Walls	2	3	4'-3"	[Diagram]
2	Bottom Slab & Side Walls	2	3	4'-7"	[Diagram]
3	Side Walls & Top Ring	3	3	9'-8"	[Diagram]



NOTES

The contractor shall have the option of furnishing the special concrete inlet precast or cast in place. When cast in place, the first 12 inches above the base may be constructed of cement concrete brick, the top ring shall be precast. When precast, concrete shall be Class A; otherwise, all concrete shall be Class C.


Steel reinforcing bars shall conform to ASTM Spec. A-305. When cast in place, steel reinforcing bars are omitted except for top ring.

The standard Metal Frame and Cover shall be furnished and installed as indicated hereon and shall conform to the requirements of standard plan 5-19 Solid Metal Frame and grate for catch basin, even though standard plans B-19 and B-20 are not included hereon. Prints of these plans are available from the Director of Highways, Olympia. See the Standard Specifications for further requirements. See Special Provisions.

Payment: "Special Concrete Inlet" Per each.

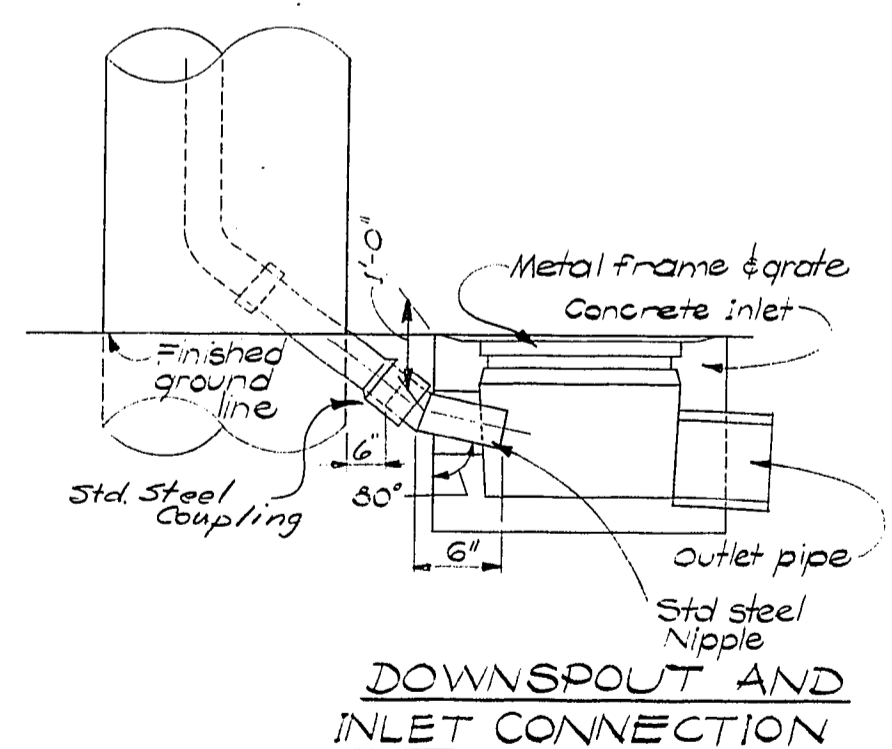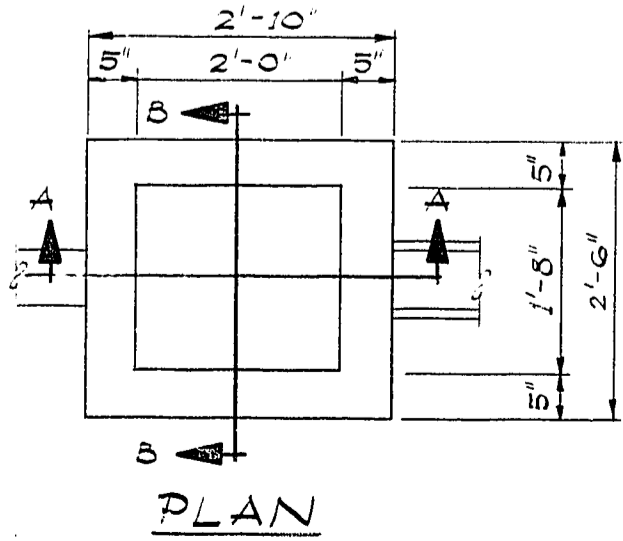

DOWNSPOUT AND INLET CONNECTION

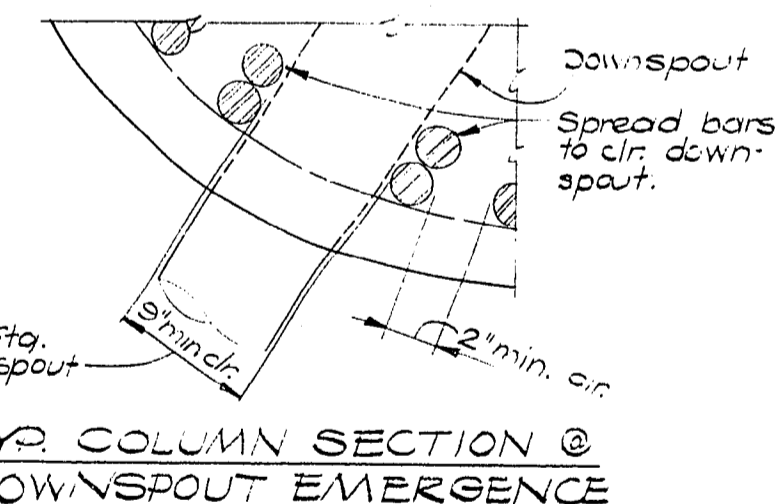

TYP. COLUMN SECTION @ DOWNSPOUT EMERGENCE

DATE: _____ REVISION: _____ BY: _____

WORTHINGTON, SKILLING HELLE & JACKSON
Consulting Civil and Structural Engineers
SEATTLE WASHINGTON

SR 405
MP 23.49 TO MP 23.76
WOODINVILLE INTERCHANGE
KING COUNTY
N-W & N-E STRUCTURE


DRAINAGE DETAILS

WASHINGTON STATE HIGHWAY COMMISSION
DEPARTMENT OF HIGHWAYS
OLYMPIA, WASHINGTON


APPROVED December 7, 1967
SHEET 279 of 297 SHEETS
CONTRACT NO. 8382

B/1995


DRAWING ENGINEER
 DESIGN CHECKED
 DRAWN BY
 QUANTITIES FIGURED
 QUANTITIES CHECKED

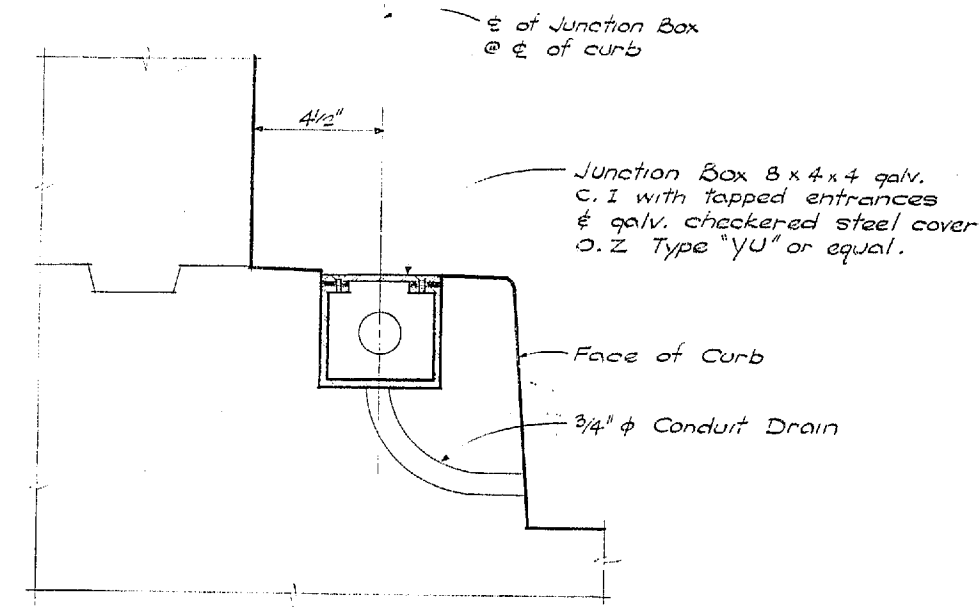


JUNCTION BOX IN CURB

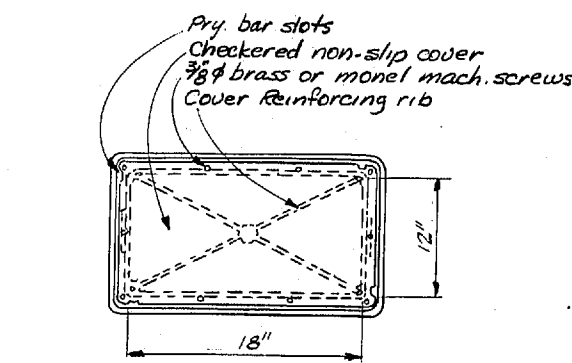

Notes: Box & Cover to be hot dip galvanized. Conduits to be attached to junction box with slip fitters


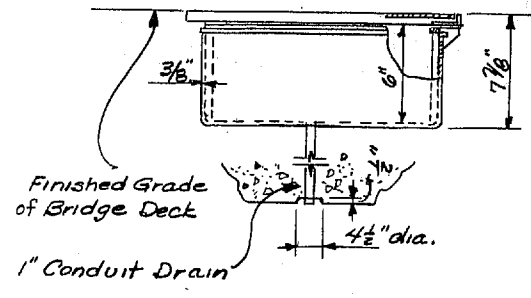


JUNCTION BOX FOR BRIDGE DECK INSTALLATION
(Typical @ nosing locations)

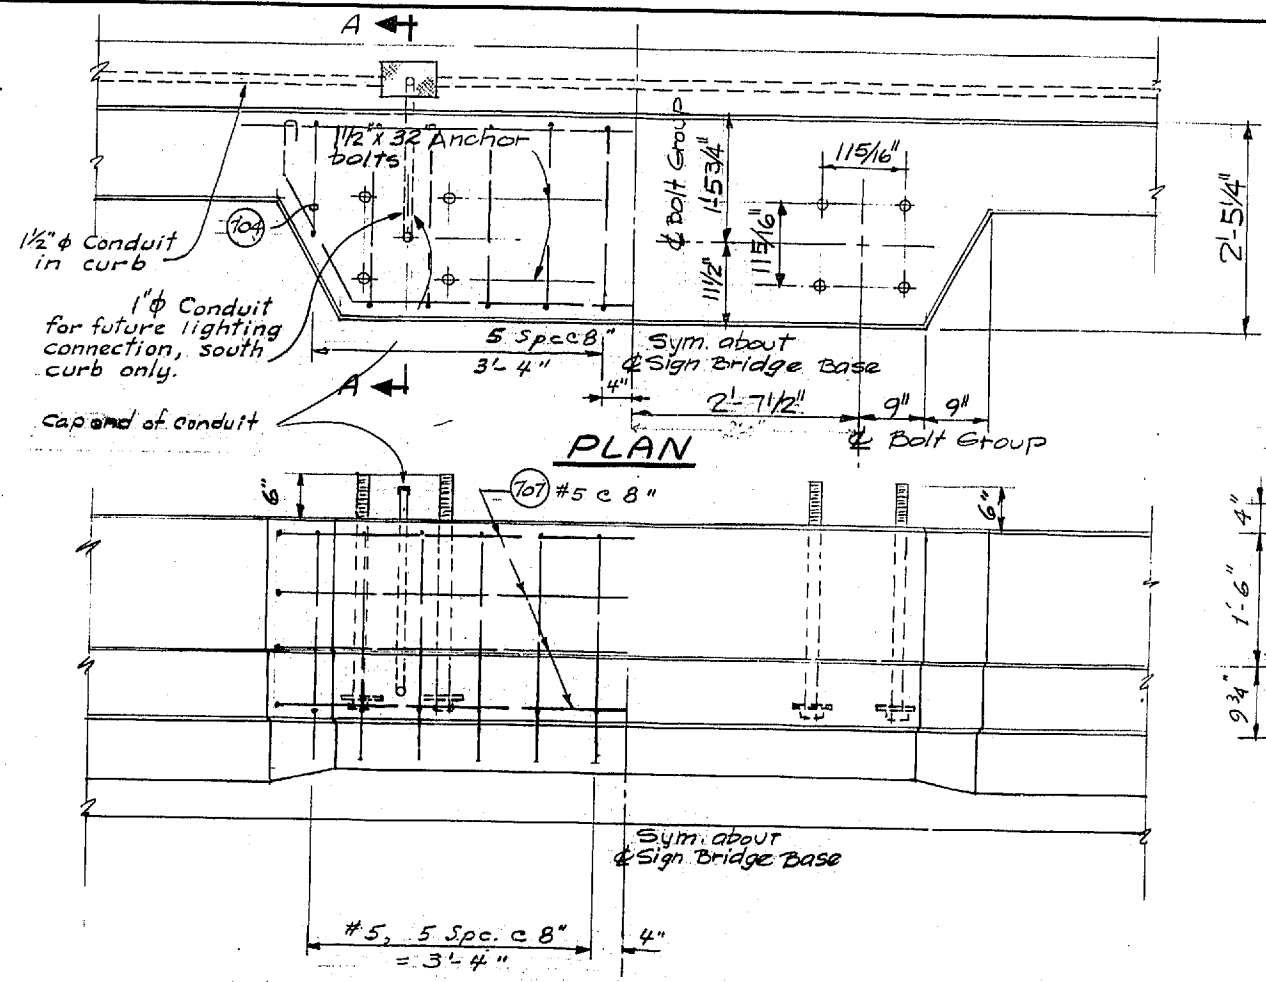


SIGN BRIDGE BASE DETAIL


Bolts 1 1/2" x 32" with square heads ASTM A-307 Grade A. Two heavy hex. nuts with 5/8" x 5/8" fl. washer ea. bolt. Reinforcing shown is in addition to curb and rail base reinforcement. East sign Bridge Base shown. West sign Bridge Base is opposite hand.

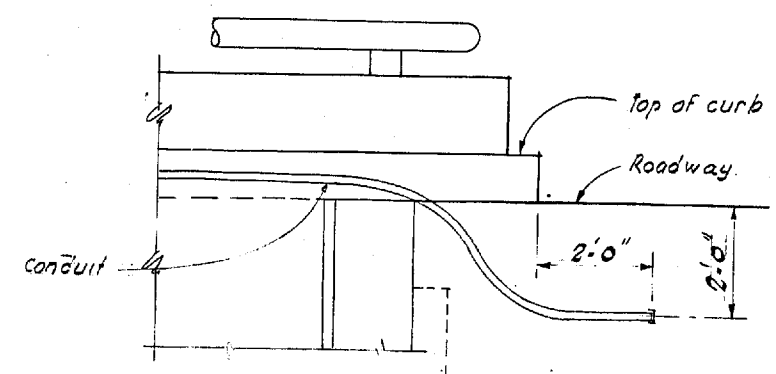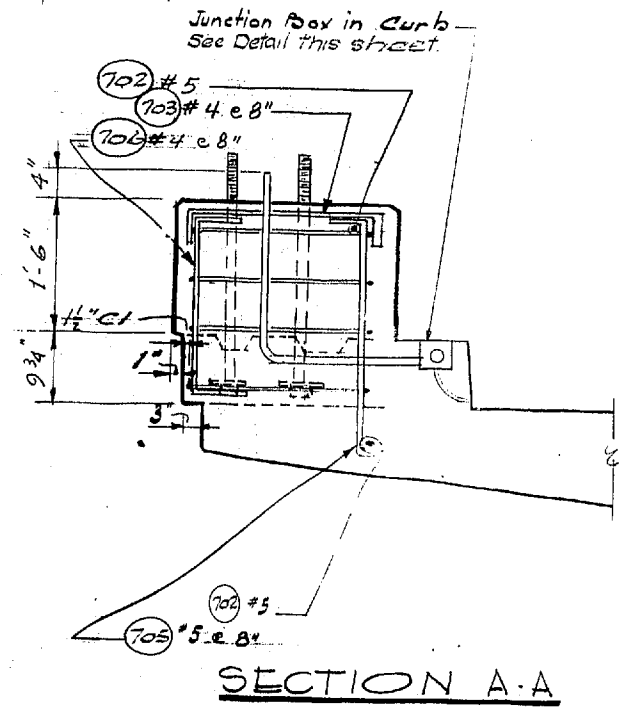

CONDUIT STUB-OUT DETAIL

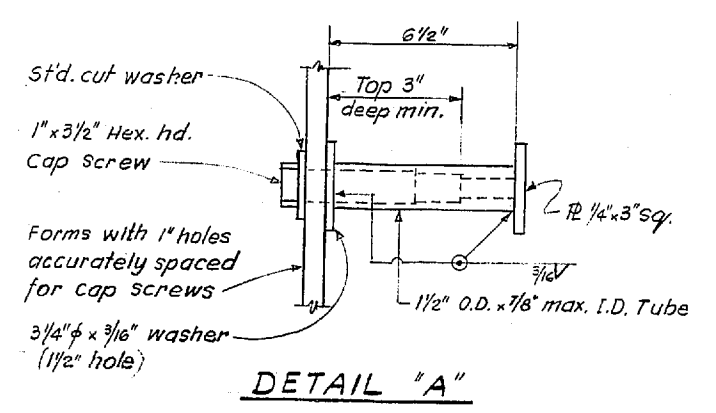


DETAIL "A"

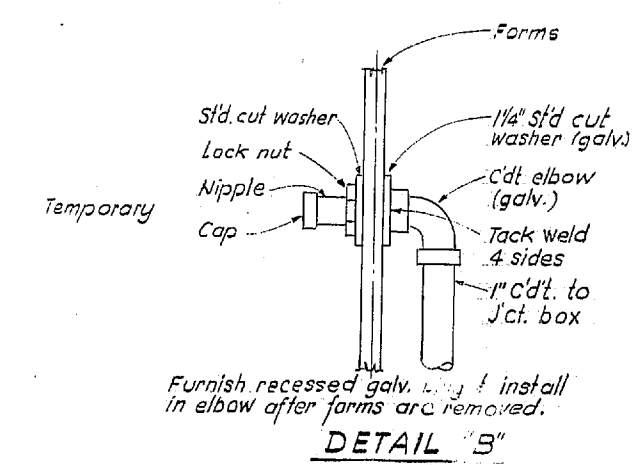


DETAIL "B"

Furnish recessed galv. plug & install in elbow after forms are removed.

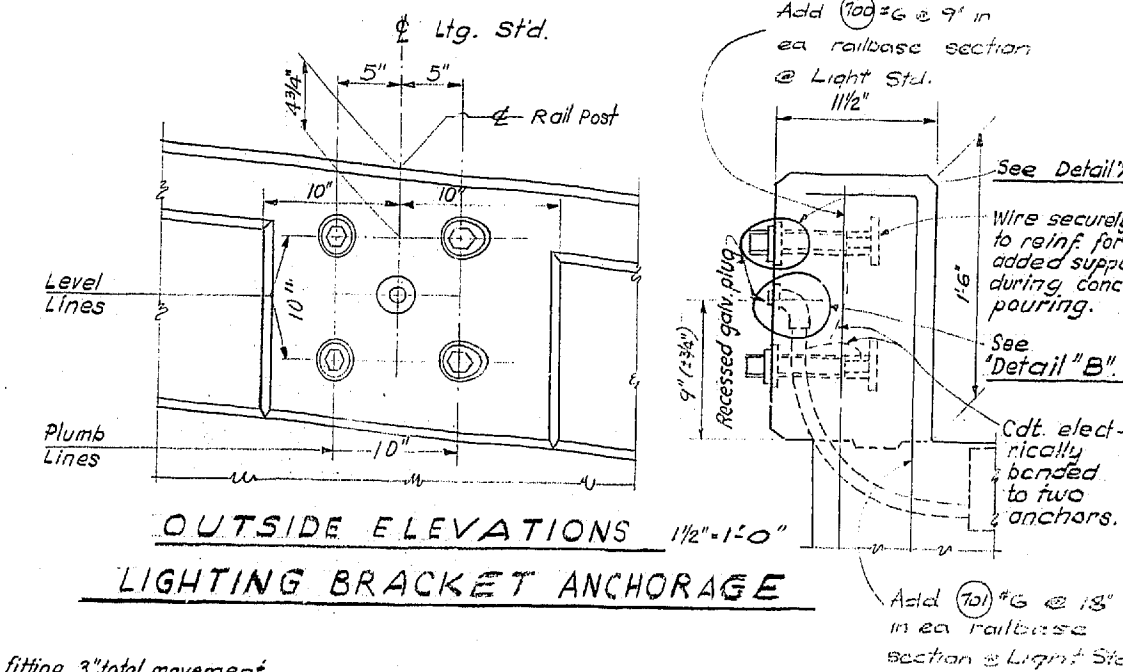


OUTSIDE ELEVATIONS 1 1/2" - 1'-0"
LIGHTING BRACKET ANCHORAGE

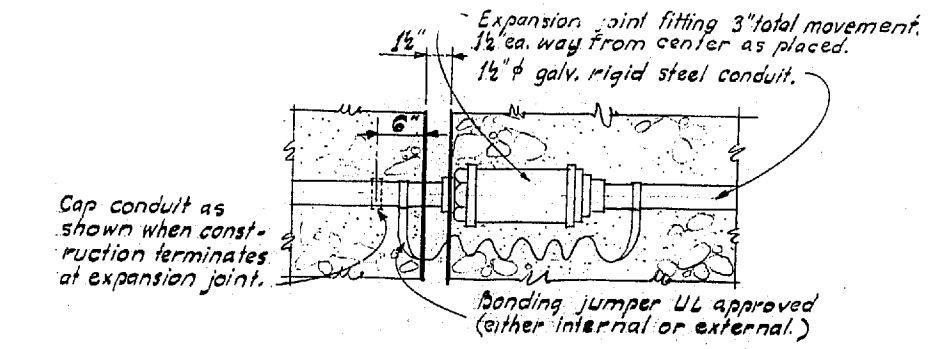

CONDUIT EXPANSION JOINT
Use at all bridge expansion joints.

54
 WOODVILLE INTERCHANGE
 N-E (N-W) STRUCTURE
 ELECTRICAL DETAILS
 SHEET 272 OF 287
 11-18-67

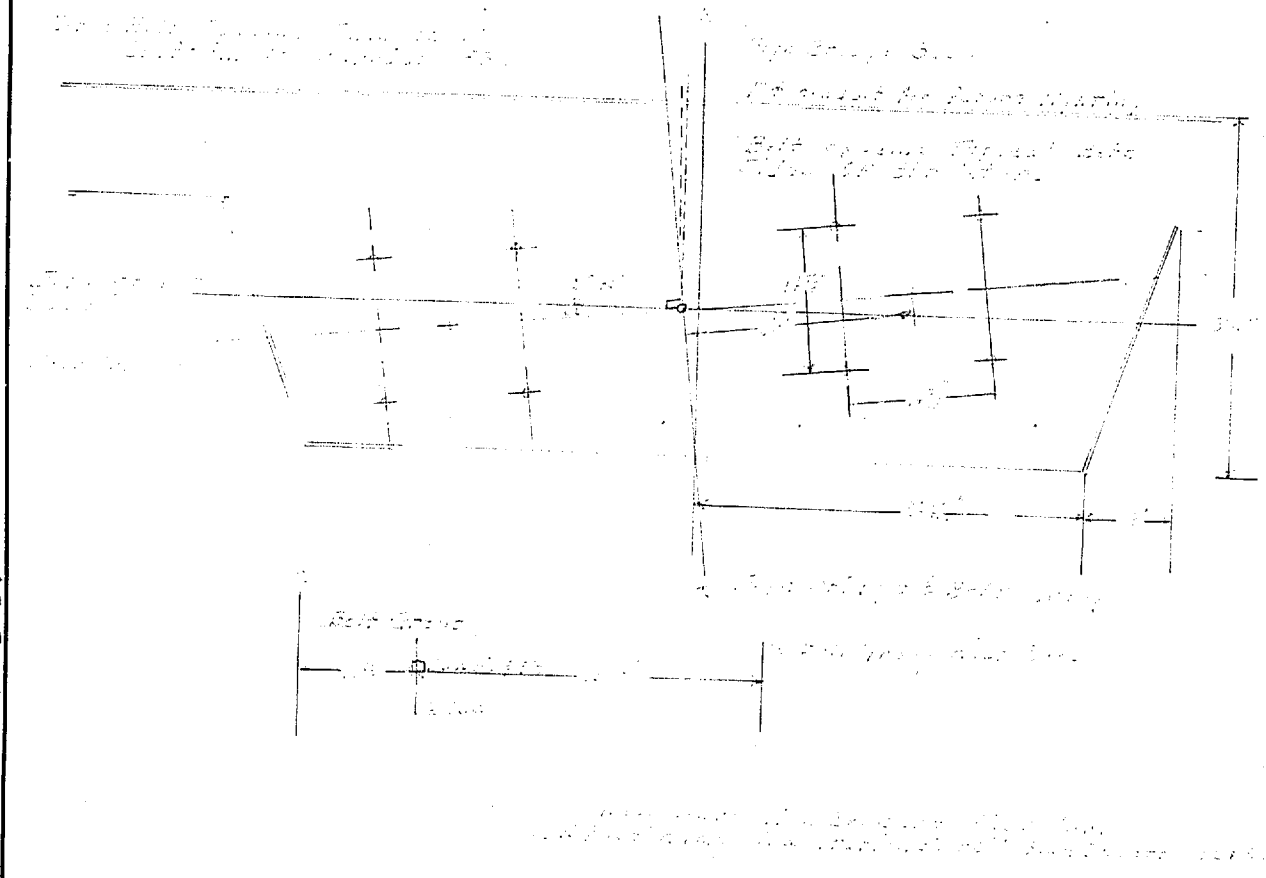

DATE	REVISION	BY

**WORTHINGTON, SKILLING
 HELLE & JACKSON**
 Consulting Civil and Structural Engineers
 SEATTLE WASHINGTON

**SR 405
 MP 23.49 TO MP 23.76
 WOODVILLE INTERCHANGE
 KING COUNTY
 N-W & N-E STRUCTURE**

ELECTRICAL DETAILS

WASHINGTON STATE HIGHWAY COMMISSION
 DEPARTMENT OF HIGHWAYS
 OLYMPIA, WASHINGTON

GEORGE D. ZAHN, CHAIRMAN
 F. L. MYALSON
 H. WALSH
 BARRY FERGUSON
 JOHN H. RUFF


APPROVED: December 7, 1967
 SHEET 280 OF 297 SHEETS
 CONTRACT NO. 8382

As Built Changes in Red 9-16-70


DESIGNING ENGINEER	
DESIGNED	
DRAWN BY	
CHECKED	
QUANTITIES CHECKED	

DATE	
BY	
DRAWN	
CHECKED	
LOC. ENGR.	
DIST. ENGR.	


WOODVILLE INTERCHANGE
 PSH NO. 1-BE (PSH NO. 2-BO)
 N-W STRUCTURE
 TEST HOLE DATA
 SHEET 281 OF 289
 11-16-67

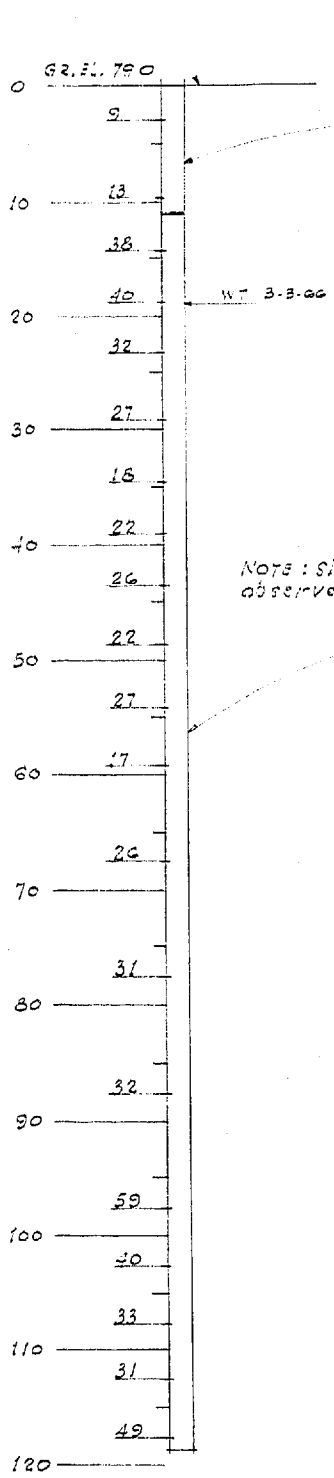


TEST HOLE H-3-8
 Sta. N-W 50 + 79.0 11'-0" RT. ☿

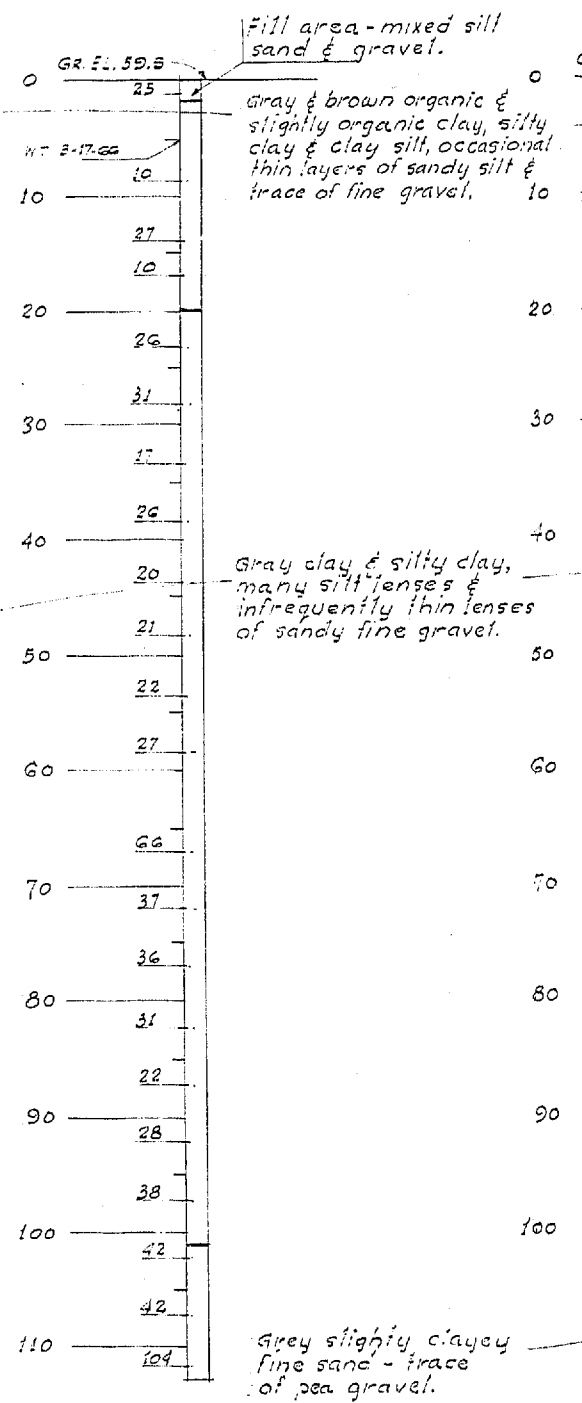


TEST HOLE H-3-7
 Sta. N-W 51 + 65.0 12'-0" LT. ☿

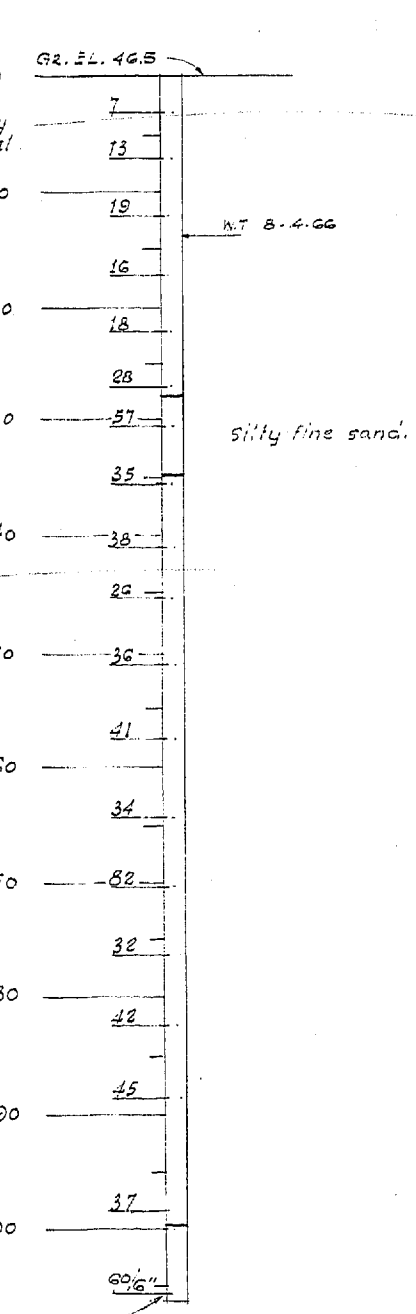


TEST HOLE H-3-6
 Sta. N-W 52 + 78.0 2'-0" RT. ☿

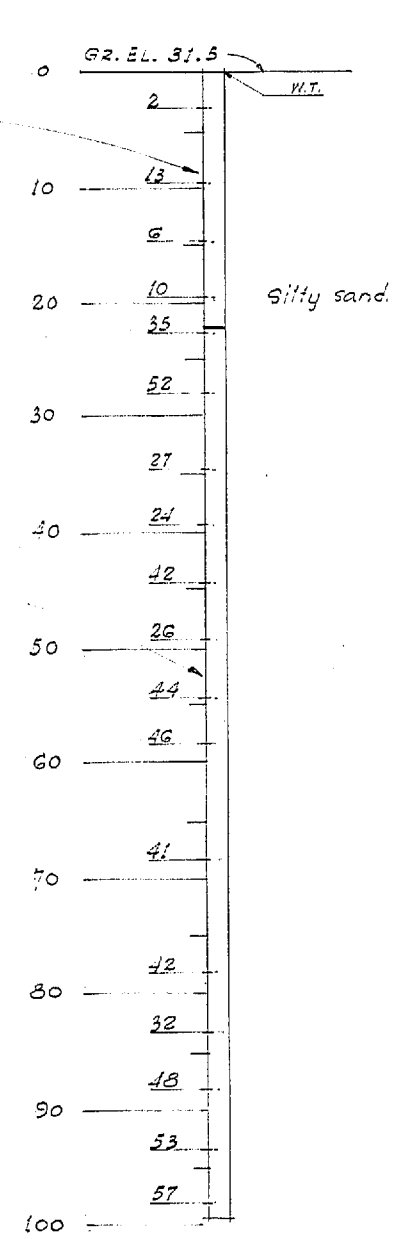


TEST HOLE H-3-9
 Sta. N-W 53 + 93.0 53'-0" RT. ☿

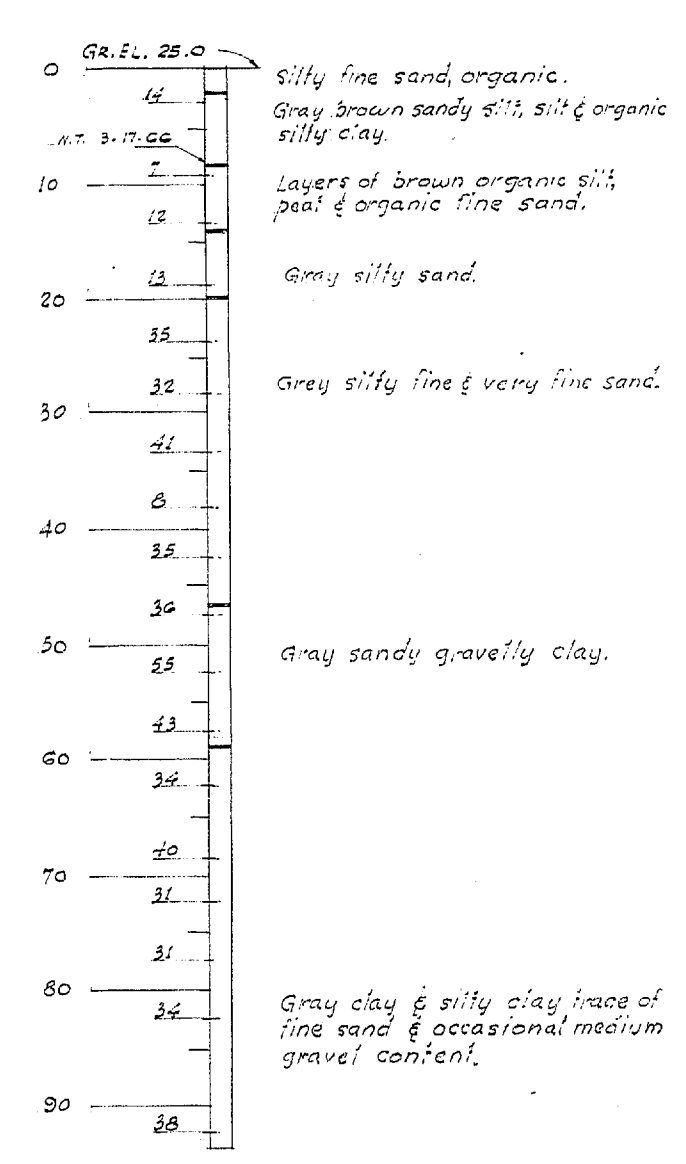


TEST HOLE H-3-5
 Sta. N-W 55 + 39 2'-0" LT. ☿

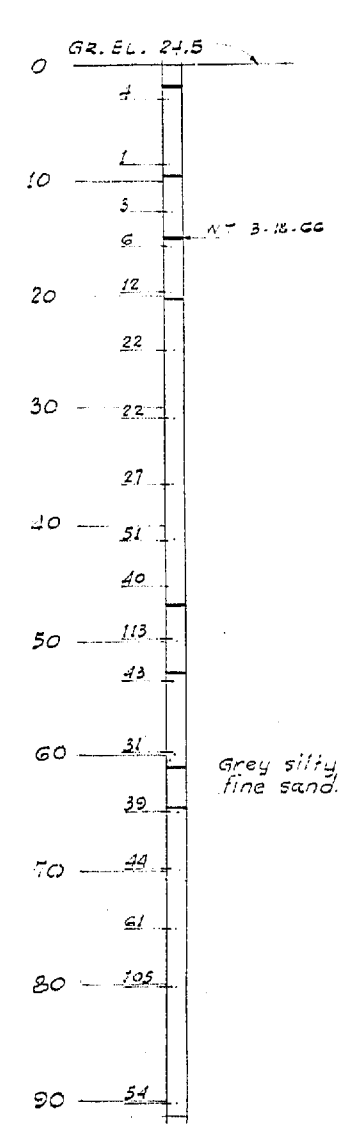

TEST HOLE H-3-4
 Sta. N-W 56 + 99.0 on ☿

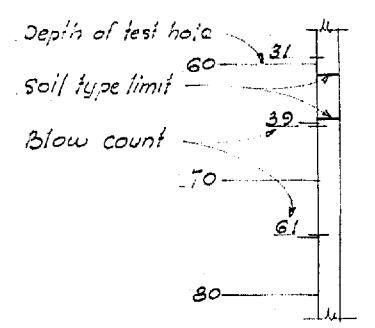

TEST HOLE LEGEND

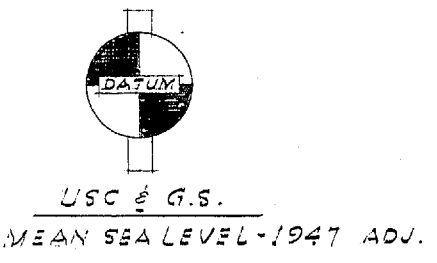

DATE	REVISION	BY

WORTHINGTON, SKILLING HELLE & JACKSON
 Consulting Civil and Structural Engineers
 SEATTLE WASHINGTON

SR 405
MP 23.49 TO MP 23.76
WOODINVILLE INTERCHANGE
 KING COUNTY
N-W & N-E STRUCTURE


N-W TEST HOLE DATA

WASHINGTON STATE HIGHWAY COMMISSION
 DEPARTMENT OF HIGHWAYS
 OLYMPIA, WASHINGTON


GEORGE D. ZAHN, CHAIRMAN
 E. I. MYLAISSON, H. WALSH
 BAKER FERGUSON, JOHN M. RUPP

APPROVED December 7, 1967
 SHEET 281 OF 297 SHEETS
 CONTRACT NO. 8382


BRIDGE ENGINEER

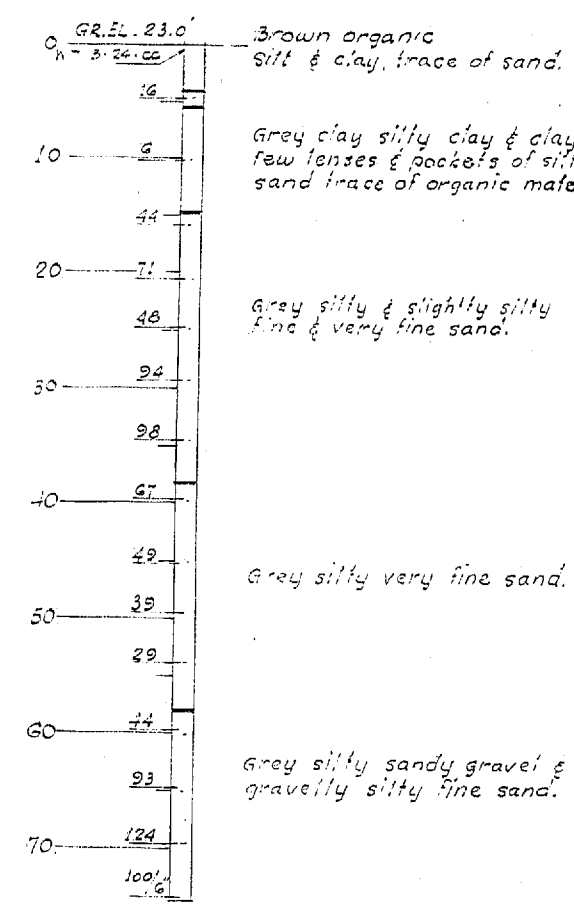


TEST HOLE H-3-3
Sta. N-W. 59+30.0 on E

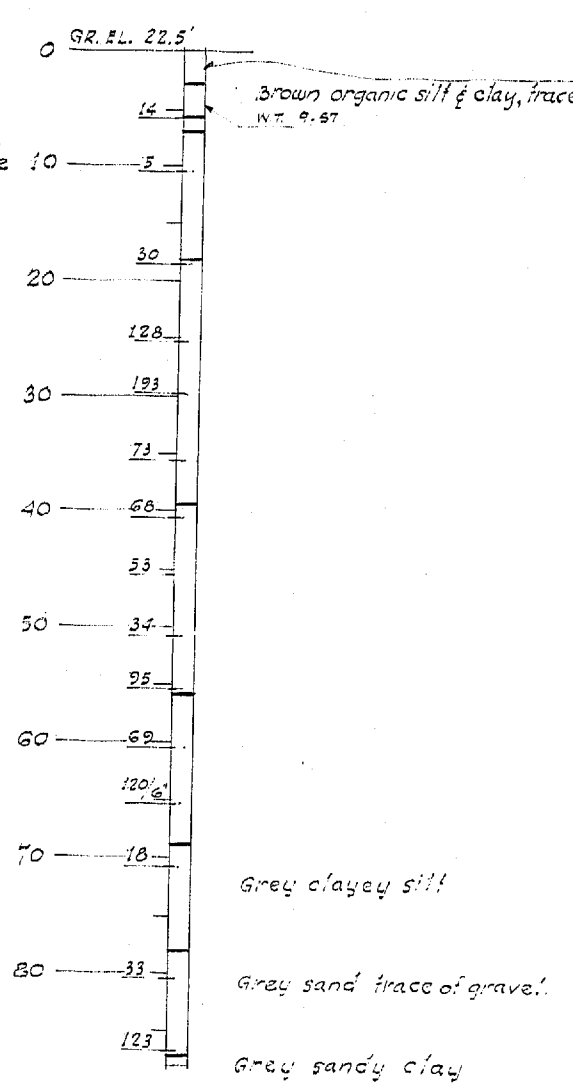


TEST HOLE H-4-4
Sta. N-W. 60+97 30' on E

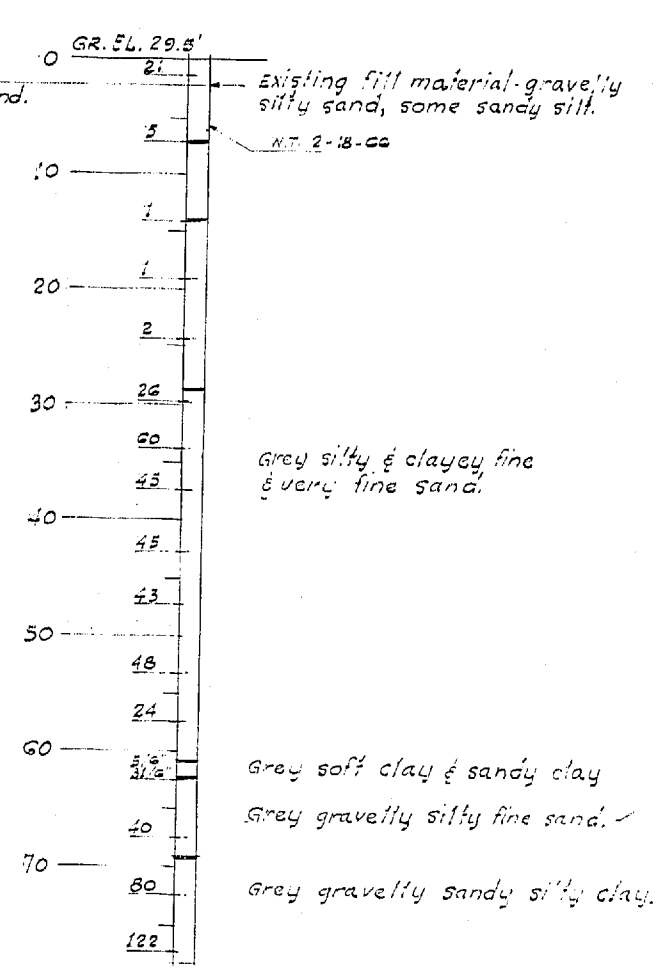


TEST HOLE H-3-2
Sta. N-W. 62+12.0 4' on E

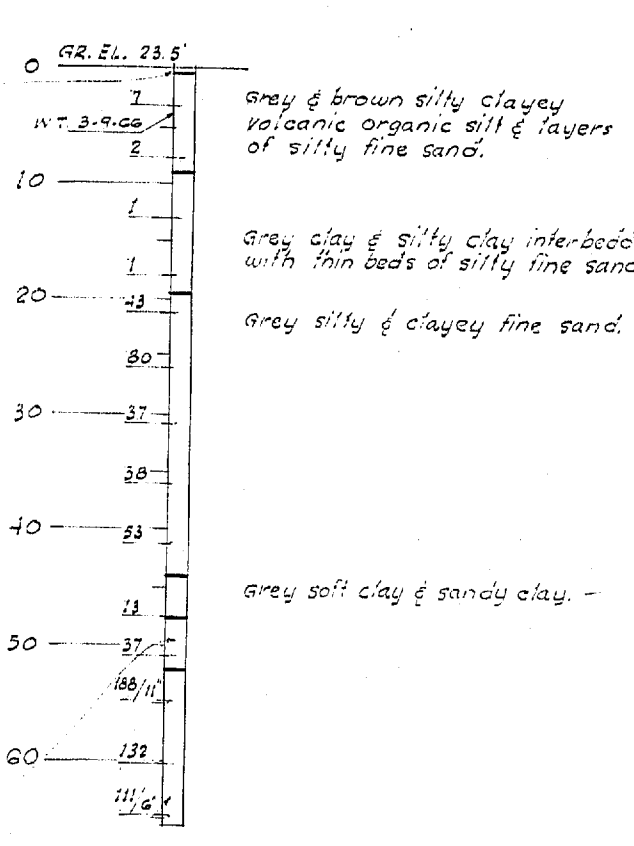

TEST HOLE H-3-1
Sta. N-W. 63+52.0 on E

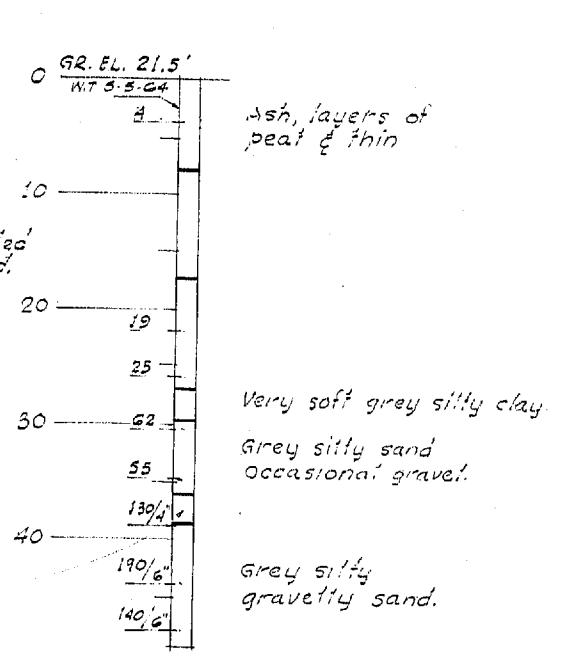

TEST HOLE H-10
Sta. N-W. 65+51.0 25' on E

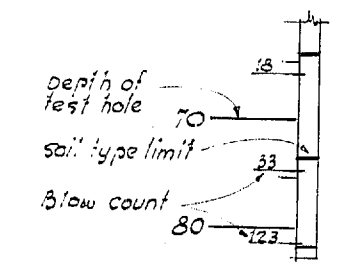

TEST HOLE LEGEND

DATE	REVISION	BY

WORTHINGTON, SKILLING
HELLE & JACKSON
Consulting Civil and Structural Engineers
SEATTLE WASHINGTON

**SR 405
MP 23.49 TO MP 23.76
WOODINWAY INTERCHANGE
KING COUNTY
N-W&N-E STRUCTURE**

N-W TEST HOLE DATA

WASHINGTON STATE HIGHWAY COMMISSION
DEPARTMENT OF HIGHWAYS
OLYMPIA, WASHINGTON

GEORGE D. ZANK, CHAIRMAN
F. E. MIVASSON, H. WALSH
BARTER PERGUSON, JOHN H. RUPP


APPROVED December 7, 1967
SHEET 282 OF 297 SHEETS
BRIDGE ENGINEER

CONTRACT NO. 8382

DESIGNED	BY	DATE
CHECKED	BY	DATE
DRAWN	BY	DATE
QUANTITIES FIGURED	BY	DATE
QUANTITIES CHECKED	BY	DATE

DATE	
BY	
DRAWN	
CHECKED	
BY	
DATE	

CONTRACT NO. 8382
STRUCTURE NO. 2-80
TEST HOLE DATA
SHEET 282 OF 297
11-16-67

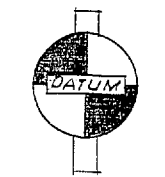


USC & G.S.
MEAN SEA LEVEL-1947 ADJ.

DESIGNING ENGINEER	
DESIGN CHECKED	
DRAWN BY	
QUANTITIES FIGURED	
QUANTITIES CHECKED	


DATE	
BY	
DRAWN	
CHECKED	
LOC. ENGR.	
DIRT. ENGR.	

11-16-17


WOODVILLE INTERCHANGE
 PSH NO. 1-RE/PSH NO. 2-DO
 M-C STRUCTURE
 SHEET NO. OF 297

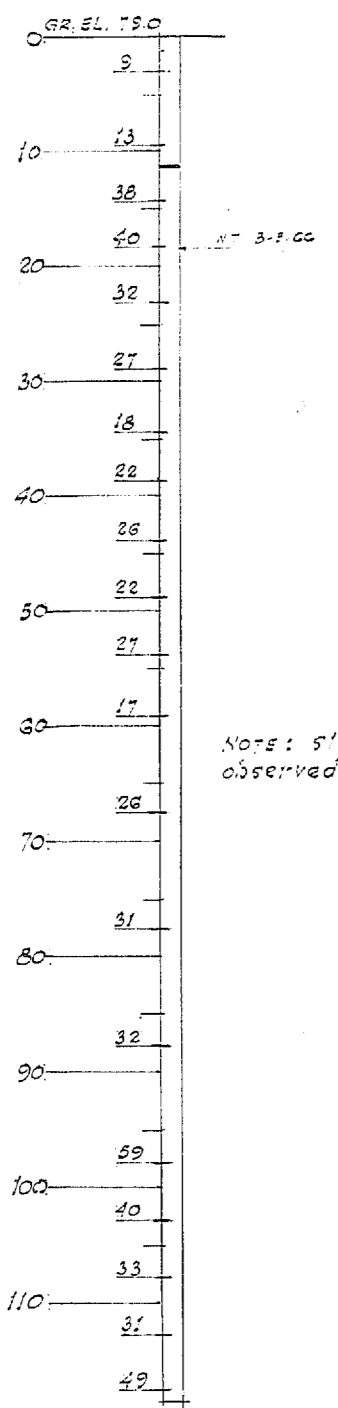


TEST HOLE H-3-8
 Sta. N-E. 50+790 on ϕ

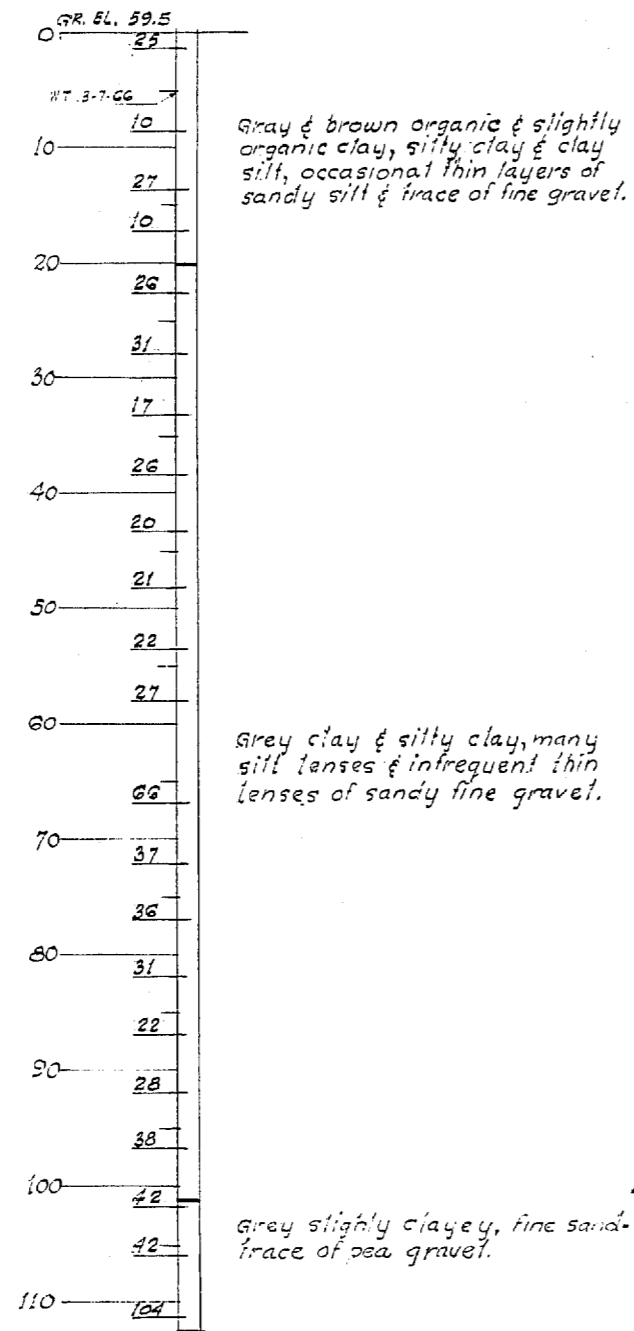


TEST HOLE H-3-7
 Sta. N-E 51+66.5 31'0" LT.

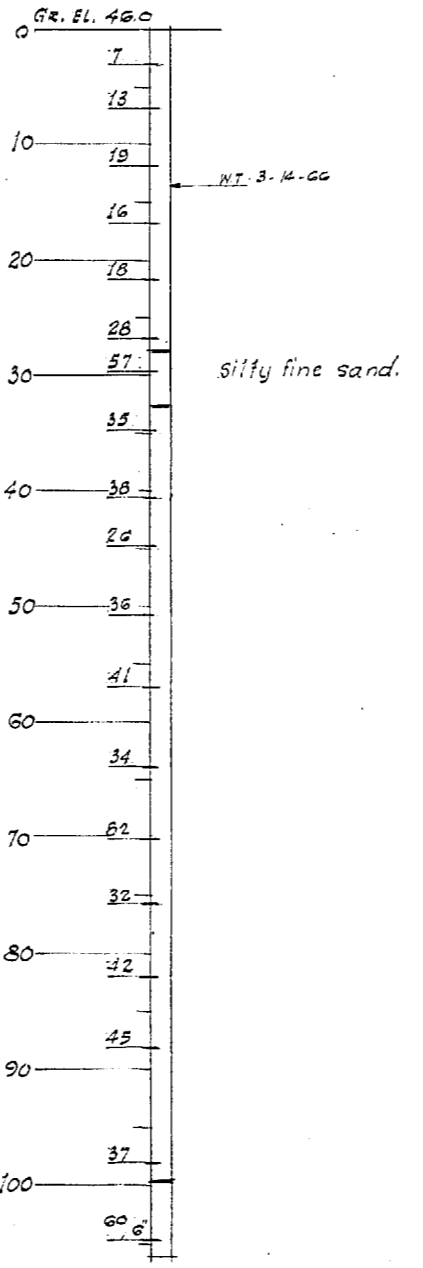


TEST HOLE H-3-6
 Sta. N-E. 52+85.0 33'0" LT. ϕ

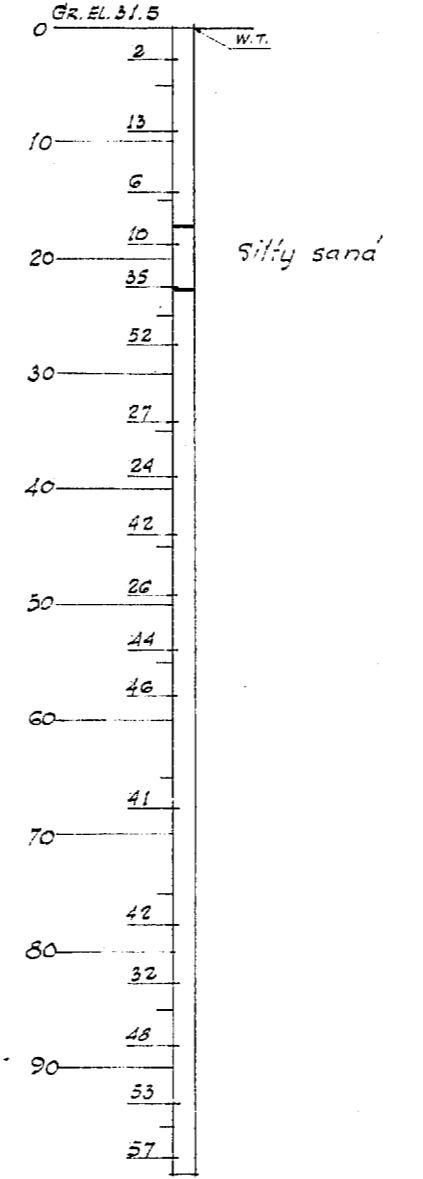


TEST HOLE H-3-9
 Sta. N-E. 53+97.0 3'0" RT. ϕ

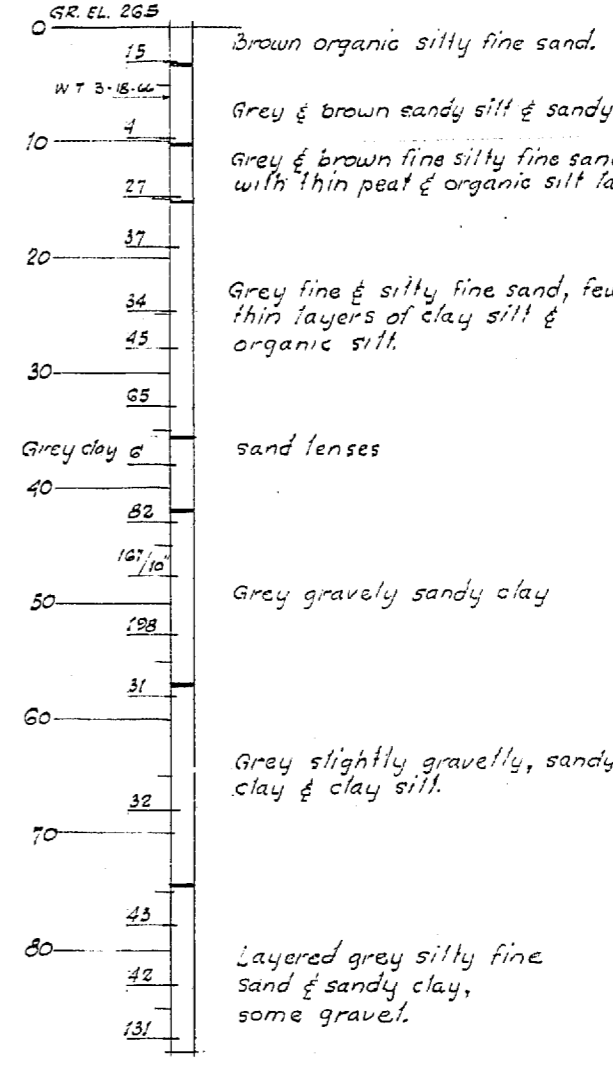

TEST HOLE H-3-10
 Sta. N-E. 57+460 on ϕ

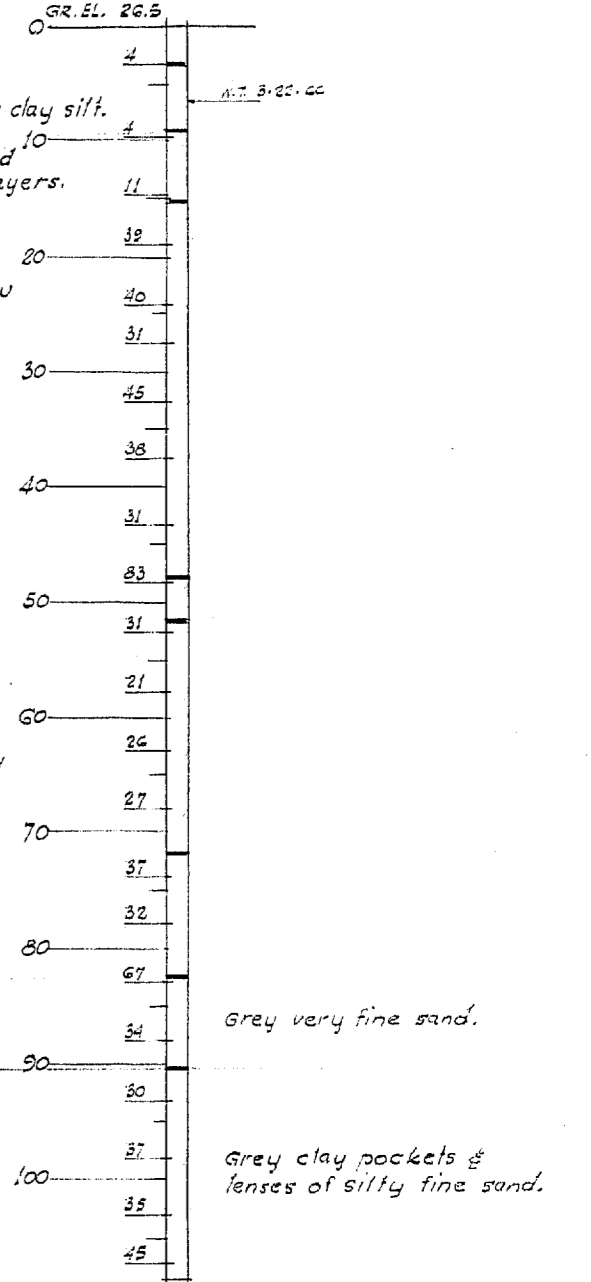


TEST HOLE H-3-11
 Sta. N-E. 57+800 on ϕ

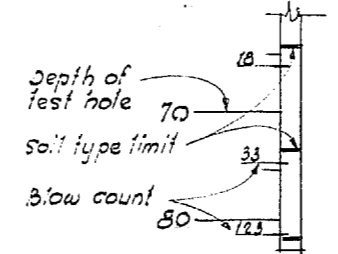

DATE	REVISION	BY

WORTHINGTON, SKILLING
 HELLE & JACKSON
 Consulting Civil and Structural Engineers
 SEATTLE WASHINGTON

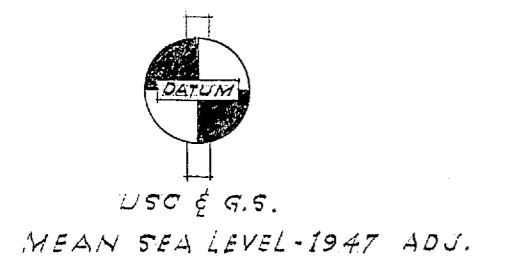

SR 405
 MP 23.49 TO MP 23.76
 WOODVILLE INTERCHANGE
 KING COUNTY
 N-W&N - E STRUCTURE

N-W TEST HOLE DATA

WASHINGTON STATE HIGHWAY COMMISSION
 DEPARTMENT OF HIGHWAYS
 OLYMPIA, WASHINGTON

GEORGE D. ZAHN, CHAIRMAN

F. E. HOFFMAN
 H. WALSH

BAKER VERGISON
 JOHN M. RUFF

APPROVED December 7, 1967
 SHEET 283 of 297 SHEETS

CONTRACT NO. 8382

BRIDGE ENGINEER

8/1996

S- Bar is included in substructure quantities.
 F- Bar to be field welded.
 T- Tie or Stirrup.
 H= A.S.T.M. A-432.
 V- Bar dimensions vary between dimensions shown on this line and the following line.

S- Bar is included in substructure quantities.
 F- Bar to be field welded.
 T- Tie or Stirrup.
 H= A.S.T.M. A-432.
 V- Bar dimensions vary between dimensions shown on this line and the following line.

MARK NO.	LOCATION	SIZE	NO. REQD.	BEND TYPE	FIELD WELD	SUBSTR.	VARIES	DIMENSIONS (Out to out)										LENGTH	WEIGHT		
								U		W		X		Y		Z				θ ₁	θ ₂
								Ft.	In.	Ft.	In.	Ft.	In.	Ft.	In.	Ft.	In.				
1	NW PIER 1 CAISSON VERT	18	54	50				31	1.0							31	1.7	22828			
2	NW PIER 1 CAISSON TIES	4	42	66				4	4.0	3	6.0	3	3.0			15	0.	420			
3	NW PIER 1 CAISSON CAP TIE	5	24	61				6	8.0	3	3.0	3	3.0			12	9.	319			
4	NW PIER 1 CAISSON CAP VER	4	36	50				5	2.0							5	2.	124			
5	NW PIER 1 ABUT TIES	4	82	66				2	7.5							2	7.5	180			
6	NW PIER 1 ABUT ROT	11	8	50				26	0.0							26	0.	829			
7	NW PIER 1 ABUT ROT	13	0	0				13	0.0	2	4.0	2	7.0	6.1	6.1	135	135	20	6.	84	
8	NW PIER 1 ABUT ROT	7	2	80				13	0.0	2	4.0	2	7.0	6.1	6.1	135	135	21	0.	86	
9	NW PIER 1 ABUT TIES	4	70	50				4	7.0							4	7.	64			
10	NW PIER 1 ABUT HORIZ EF C	5	12	50				23	0.0							23	0.	240			
11	NW PIER 1 ABUT HORIZ EF E	5	12	50				4	2	9.0						3	9.	47			
12	NW PIER 1 ABUT HORIZ EF E	5	8	50				4	9.0							4	9.	40			
13	NW PIER 1 ABUT HORIZ TOP	11	8	50				38	6.0							38	6.	1636			
14	NW PIER 1 ABUT HORIZ AF	7	5	50				45	0.0							45	0.	480			
15	NW PIER 1 ABUT HORIZ AF	7	3	50				49	0.0							49	0.	307			
16	NW PIER 1 ABUT HORIZ FF	5	3	50				49	0.0							49	0.	147			
17	NW PIER 1 ABUT HORIZ FF	5	1	50				50	0.0							50	0.	52			
18	NW PIER 1 PAVT SEAT HOR	5	3	50				39	8.0							39	8.	124			
19	NW PIER 1 PAVT SEAT TIE	4	67	91				4	4.0							4	4.	194			
20	NW PIER 1 ABUT HORIZ TOP	7	2	50				5	7.0	1	3.0	4.0	0.0	5	7.0	5	7.	209			
21	NW PIER 1 ABUT VERT	4	16	50				3	0.0							3	0.	69			
22	NW PIER 1 ABUT VERT	4	16	50				10	0.0							8	0.	86			
23	NW PIER 1 ABUT VERT	7	20	50				11	6.0							11	6.	479			
24	NW PIER 1 ABUT VERT	4	20	50				5	3.0							5	3.	72			
25	NW PIER 1 ABUT VERT	4	34	50				8	0.0							8	0.	182			
26	NW PIER 1 ABUT VERT	4	21	50				11	7.0							12	0.	168			
27	NW PIER 1 ABUT HOR	5	11	50				4	8.0							3	3.	10			
28	NW PIER 1 ABUT VERT	5	3	50				3	3.0							3	3.	16			
29	NW PIER 1 ABUT VERT	5	3	50				5	0.0							5	0.	26			
30	NW PIER 1 ABUT END	5	2	80				4	6.0	2	6.0	3	6.0	4.4	4.4	135	135	12	4.	26	
31	NW PIER 1 ABUT END	5	2	80				4	6.0	3	6.0	3	6.0	4.4	4.4	135	135	14	2.	29	
32	ABUT HORIZ FF	5	2	50				51	0.0							51	0.	108			
35	NW/NE STR. PIER 2F TIES	4	52	66				6	4.0	1	6.0					21	3.	739			
36	NW/NE STR. PIER 2E VERT	14	17	50				10	0.0							10	0.	1722			
37	NW/NE STR. PIER 2E DOWEL	14	17	50				12	0.0							12	0.	1561			
38	NW/NE STR. PIER 2E DOWEL	14	17	50				17	0.0							17	0.	2213			
39	NW/NE STR. PIER 2W TIES	4	34	66				6	4.0	1	6.0					21	3.	767			
40	NW/NE STR. PIER 2W VERT	14	17	50				51	6.0							46	6.	1786			
41	NW/NE STR. PIER 2W DOWEL	14	17	50				12	0.0							12	0.	1561			
42	NW/NE STR. PIER 2W DOWEL	14	17	50				17	0.0							17	0.	2211			
43	NW STRUCT PIER 3	18	23	50				79	6.0							79	6.	2311			
44	NW STRUCT PIER 3 DOWELS	18	21	50				13	8.0							13	8.	3903			
45	NW STRUCT PIER 3 TIES	4	49	66				20	4.0							20	4.	5807			
46	NW STRUCT PIER 3 TIES	4	49	66				7	3.0	1	6.0					24	2.	790			
47	NW STRUCT PIER 3 TIES	4	49	66				7	3.0	1	6.0					24	2.	790			
48	NW STRUCT PIER 3 VERT	14	38	50				79	6.0							79	6.	2311			
49	NE STRUCT PIER 3 DOWELS	18	23	50				13	8.0							13	8.	4275			
50	NE STRUCT PIER 3 DOWELS	18	23	50				20	4.0							20	4.	6360			
111	NW/NE STRUCT COL 2E TIES	4	28	66				5	9.0	1	6.0					19	5.	363			
112	NW/NE STRUCT COL 2E VERT	14	17	50				12	3.0							12	3.	1593			
113	NW/NE STRUCT COL 2E VERT	14	17	50				19	0.0							19	0.	2471			
114	NW/NE STRUCT COL 2W TIES	4	28	66				5	9.0	1	6.0					19	5.	363			
115	NW/NE STRUCT COL 2W VERT	14	17	50				11	10.0							11	10.	1339			
116	NW/NE STRUCT COL 2W VERT	14	17	50				18	6.0							18	6.	2406			
117	NW STRUCT COL 3 TIES	4	38	66				19	5.0	1	6.0					19	5.	493			
118	NW STRUCT COL 3 VERT	18	23	50				23	3.0							23	3.	7273			
119	NW STRUCT COL 3 VERT	18	23	50				29	11.0							29	11.	9358			
120	NE STRUCT COL 3 TIES	4	29	66				19	5.0	1	6.0					19	5.	376			
141	NE STRUCT COL 3 VERT	18	23	50				14	0.0							14	0.	4379			
142	NE STRUCT COL 3 VERT	18	23	50				20	8.0							20	8.	6465			
200	BOTTOM SLAB ROT TRANSV	5	126	65				24	3.0	1	0.0					22	0.	2891			
201	BOTTOM SLAB ROT TRANSV	5	165	61				19	8.0	1	0.0	1	0.0			21	2.	3643			
202	BOTTOM SLAB ROT TRANSV	5	18	50				11	0.0							11	0.	213			
203	BOTTOM SLAB ROT LONG P1-P3	5	1	50				14	0.0							12	6.	235			
204	BOTTOM SLAB ROT LONG P1-P3	5	5	50				6	0.0							6	0.	6			
205	BOTTOM SLAB ROT LONG P1-P3	5	3	50				10	0.0							10	0.	52			
206	BOTTOM SLAB ROT LONG P1-P3	5	2	50				20	9.0							20	9.	65			
207	BOTTOM SLAB ROT LONG P1-P3	5	2	50				14	0.0							14	0.	29			
208	BOTTOM SLAB ROT LONG P1-P3	5	3	50				3	6.0							3	6.	30			
209	BOTTOM SLAB ROT LONG P1-P3	14	6	50				37	0.0							37	0.	1698			
210	BOTTOM SLAB ROT LONG P1-P3	14	6	50				53	0.0							53	0.	2433			
211	BOTTOM SLAB ROT LONG P1-P3	14	6	50				59	3.0							59	3.	2720			
212	BOTTOM SLAB ROT LONG P1-P3	14	6	50				67	3.0							67	3.	3087			
213	BOTTOM SLAB ROT LONG P1-P3	14	6	50				76	1.							76	1.	3492			
214	BOTTOM SLAB ROT LONG P1-P3	14	6	50				77	0.0							77	0.	3640			
215	BOTTOM SLAB ROT LONG P1-P3	14	6	50				75	1.							75	1.	3444			
216	BOTTOM SLAB ROT LONG P1-P3	14	6	50				59	3.0							59	3.	3676			
217	BOTTOM SLAB ROT LONG P1-P3	14	6	50				21	3.							21	3.	975			
218	BOTTOM SLAB ROT LONG P1-P3	14	6	50				25	3.							25	3.	1159			
219	BOTTOM SLAB ROT LONG P1-P3	5	4	50				32	6.0							32	6.	475			
220	BOTTOM SLAB ROT LONG P1-P3	5	4	50				25	0.0							25	0.	104			
221	BOTTOM SLAB ROT LONG P1-P3	5	3	50				25	6.0							25	6.	106			
222	BOTTOM SLAB ROT LONG P1-P3	5	1	50				22	6.0							22	6.	70			
223	BOTTOM SLAB ROT LONG P1-P3	5	1	50				42	0.0							42	0.	44			
224	BOTTOM SLAB ROT LONG P1-P3	5	1	50				31	0.0							31	0.	32			
225	BOTTOM SLAB ROT LONG P1-P3	5	1	50				24	6.0							24	6.	26			
226	BOTTOM SLAB ROT LONG P1-P3	14	4	50				43	0.0							43	0.	45			
								38	0.0							38	0.	1163			

MARK NO.	LOCATION	SIZE	NO. REQD.	BEND TYPE	FIELD WELD	SUBSTR.	VARIES	DIMENSIONS (Out to out)										LENGTH	WEIGHT		
								U		W		X		Y		Z				θ ₁	θ ₂
								Ft.	In.	Ft.	In.	Ft.	In.	Ft.	In.	Ft.	In.				
227	BOTTOM SLAB ROT LONG P1-P3	14	4	50				54	0.0							54	0.	1652			
228	BOTTOM SLAB ROT LONG P1-P2	14	4	50				60	0.0							60	0.	1836			
229	BOTTOM SLAB ROT LONG P1-P2	14	4	50				68	0.0							68	0.	2081			
230	BOTTOM SLAB ROT LONG P1-P2	14	4	54				74	3.0							74	3.	2355			
231	BOTTOM SLAB ROT LONG P1-P2	14	4	54				77	3.0							77	3.	2400			
232	BOTTOM SLAB ROT LONG P1-P2	14	4	54				71	6.0												

S- Bar is included in substructure quantities.
 F- Bar to be field welded.
 T- Tie or Stirrup.
 H- A.S.T.M. A-432.
 V- Bar dimensions vary between dimensions shown on this line and the following line.
 F- Bar to be field welded.
 T- Tie or Stirrup.
 H- A.S.T.M. A-432.
 V- Bar dimensions vary between dimensions shown on this line and the following line.

MARK NO.	LOCATION	SIZE	NO. REQD.	BEND TYPE	FIELD WELD	SUBSTR.	VARIES	DIMENSIONS (Out to out)										LENGTH		WEIGHT Lbs.		
								U		W		X		Y		Z		θ ₁	θ ₂		Ft.	In.
								Ft.	In.	Ft.	In.	Ft.	In.	Ft.	In.	Ft.	In.					
399	INT & EXT WEB STIRRUPS	5	3412	64	T													19797				
362	INT DIAPH HORIZ NEAR P3	5	12	50				19	6.0	4	10.5	6.0						158				
363	INT DIAPH STIRRUPS	4	290	64	T			20	6.0	4	8.0	6.0						104.9				
364	INT DIAPH HORIZ P1 TO P2	4	12	50				20	6.0									166				
365	INT DIAPH HORIZ P1 TO P2	4	12	50				22	3.0									178				
366	INT DIAPH HORIZ P2 TO P3	4	12	50				25	3.0									202				
367	END DIAPH HORIZ	4	4	50				36	3.0									624				
368	END DIAPH HORIZ	4	37	62	T			36	3.0	4	9.0	4	9.0	6.0	6.0			302				
369	END DIAPH STIRRUPS	4	37	62	T			17	0.0									270				
373	CROSS BEAM NW P2 HORIZ	14	8	50				23	0.0									1040				
374	CROSS BEAM NW P3 HORIZ	14	3	50				25	0.0									528				
375	CROSS BEAM NW P3 HORIZ	14	6	61				19	4.0	4	1.0	4	1.0					1170				
376	CROSS BEAM P2 AND 3 STIRU	6	120	61				6	9.0	4	7.0	4	7.0	1	3.0	1	3.0	3199				
377	CROSS BEAM P2 AND 3 STIRU	6	240	64				1	3.0	4	7.0	1	3.0					2373				
378	CROSS BEAM P2 AND 3 HORIZ	7	24	50				19	8.0									965				
382	CROSS BEAM PIER 2 HORIZ T	14	4	50				50	9.0									1553				
383	CROSS BEAM PIER 2 HORIZ T	14	4	50				21	0.5									966				
384	CROSS BEAM PIER 2 HORIZ T	14	4	50				22	2.0									1017				
385	CROSS BEAM PIER 2 HORIZ T	14	4	50				22	6.0									688				
386	CROSS BEAM PIER 2 HORIZ T	14	4	50				23	10.0									1092				
387	CROSS BEAM PIER 2 HORIZ T	14	5	51				19	4.0	4	1.0	4	1.0					975				
388	CROSS BEAM PIER 2 HORIZ T	14	6	50				45	6.5									563				
389	CROSS BEAM PIER 2 HORIZ H	11	8	50				46	2.5									1092				
390	CROSS BEAM PIER 2 HORIZ B	18	4	50				11	4.0									524				
391	CROSS BEAM PIER 2 HORIZ B	14	8	50				24	0.0									1414				
392	CROSS BEAM PIER 3 HORIZ T	14	10	50				28	0.0									1775				
630	HINGE DIAGONAL	11	21	96	F	H		32	0.0									1836				
631	BRG SUPPORT HORIZ	14	2	50				10	1.0									1126				
632	BRG SUPPORT STIRRUPS	5	24	61	T			3	0.0									84				
633	BRG SUPPORT STIRRUPS	5	24	61	T			2	9.0	4	10.0	4	10.0	6.0	6.0			325				
634	BRG SUPPORT STIRRUPS	5	24	61	T			3	9.0	2	0.5	2	0.5	6.0	6.0			444				
635	BRG SUPPORT HORIZ	6	40	50				4	0.0									211				
636	BRG SUPPORT HORIZ	6	4	50				9	0.0									240				
637	BRG SUPPORT HORIZ	6	4	50				13	9.0									54				
638	WEB HORIZ ROT	4	12	50				5	0.0	1	8.0							82				
639	WEB HORIZ ROT	4	6	50				3	10.0	9	6.0	3	2.0					40				
640	DIAPHRAM STIRRUPS	4	8	60	T			19	9.0									79				
641	DIAPHRAM HORIZ TOP	5	2	50				11	8.0									62				
642	DIAPHRAM HORIZ BOT	7	2	50				23	0.0									48				
643	HINGE WALL HORIZ	4	4	50				19	9.0	4	6.6	6.0						81				
644	HINGE WALL VERT	4	6	50				2	0.0									8				
645	TOP TRANSV	6	3	52				26	7.0									120				
646	HINGE DIAGONAL	11	21	96	F	H		10	1.0									1126				
647	BRG SUPPORT HORIZ	14	2	50				3	0.0									84				
648	BRG SUPPORT STIRRUPS	5	24	61	T			0	5.0									325				
649	BRG SUPPORT STIRRUPS	5	24	61	T			4	10.0	4	10.0	6.0	6.0					44				
650	BRG SUPPORT HORIZ	6	40	50				3	9.0	2	0.5	2	0.5	6.0	6.0			211				
651	BRG SUPPORT HORIZ	6	4	50				4	0.0									240				
652	BRG SUPPORT HORIZ	6	4	50				9	0.0	1	8.0							54				
653	BRG SUPPORT HORIZ	6	4	50				13	9.0									82				
654	WEB HORIZ ROT	4	12	50				5	0.0									40				
655	WEB HORIZ ROT	4	6	50				19	9.0									79				
656	DIAPHRAM STIRRUPS	4	8	60	T			11	8.0									62				
657	DIAPHRAM HORIZ TOP	5	2	50				23	0.0									48				
658	DIAPHRAM HORIZ BOT	7	2	50				19	9.0									81				
659	HINGE WALL HORIZ	4	4	50				2	0.0									8				
660	HINGE WALL VERT	4	6	50				26	7.0									120				
661	TOP TRANSV	6	3	52				27	0.0									8679				
662	ROADWAY SLAB TOP TRANSV	6	234	56				19	5.0									3733				
663	ROADWAY SLAB TOP TRANSV	6	128	54				18	6.0													
664	ROADWAY SLAB TOP TRANSV	6	60	54				26	3.0									2572				
665	ROADWAY SLAB TOP TRANSV	6	69	54				3	29	6.0								3282				
666	ROADWAY SLAB TOP TRANSV	6	58	54				2	25	3.0								2345				
667	ROADWAY SLAB TOP TRANSV	6	54	54				3	26	10.0								2318				
668	ROADWAY SLAB TOP TRANSV	6	2	50				28	6.0									51				
669	ROADWAY SLAB TOP TRANSV	6	57	54				17	0.0													
670	ROADWAY SLAB TOP TRANSV	6	54	54				27	5.0									2347				
671	ROADWAY SLAB TOP TRANSV	6	190	56				28	11.0									2345				
672	ROADWAY SLAB TOP TRANSV	6	36	54				28	2.0									7991				
673	ROADWAY SLAB TOP LONG P1-2	11	2	54				40	0.0									1932				
674	ROADWAY SLAB TOP LONG P1-2	11	2	54				62	3.0									880				
675	ROADWAY SLAB TOP LONG P1-2	11	2	54				57	3.0									827				
676	ROADWAY SLAB TOP LONG P1-2	11	2	54				66	0.0									720				
677	ROADWAY SLAB TOP LONG P1-2	11	2	54				59	3.0									630				
678	ROADWAY SLAB TOP LONG P1-2	11	2	54				57	6.0									572				
679	ROADWAY SLAB TOP LONG P1-2	11	2	54				61	6.0									220				
680	ROADWAY SLAB TOP LONG P1-2	8	2	54				40	0.0									128				
681	ROADWAY SLAB TOP LONG P1-2	4	1	50				48	0.0									116				
682	ROADWAY SLAB TOP LONG P1-2	4	1	50				43	6.0									134				
683	ROADWAY SLAB TOP LONG P1-2	5	4	50				32	0.0									198				
684	ROADWAY SLAB TOP LONG P1-2	5	3	50				38	0.0									198				
685	ROADWAY SLAB TOP LONG P1-2	5	3	50				22	0.0									69				
686	ROADWAY SLAB TOP LONG P1-2	5	1	50				41	9.0									218				
687	ROADWAY SLAB TOP LONG P1-2	5	2	50				46	6.0									97				
688	ROADWAY SLAB TOP LONG P1-2	5	2	50				22	0.0									115				
689	ROADWAY SLAB TOP LONG P1-2	5	3	50				31	9.0									99				
690	ROADWAY SLAB TOP LONG P1-2																					

S- Bar is included in substructure quantities.
 F- Bar to be field welded.
 T- Tie or Stirrup.
 H- A.S.T.M. A-432.
 V- Bar dimensions vary between dimensions shown on this line and the following line.


S- Bar is included in substructure quantities.
 F- Bar to be field welded.
 T- Tie or Stirrup.
 H- A.S.T.M. A-432.
 V- Bar dimensions vary between dimensions shown on this line and the following line.

MARK NO.	LOCATION	SIZE	NO.	REQ'D.	BEND TYPE	TIE OR STIR	FLD. WELD.	SUBSTR.	VARIES	NO. EACH	DIMENSIONS (Out to out)										LENGTH		WEIGHT				
											U		W		X		Y		Z		θ ₁		θ ₂		Ft.	In.	Lbs.
											Ft.	In.	Ft.	In.	Ft.	In.	Ft.	In.	Ft.	In.	Deg.	Deg.	Ft.	In.	Lbs.		
673	RAIL BASE LONG E-W ON NW	6	4	50						8	2.0								8	2.	49						
674	RAIL BASE LONG E-W AT P1	6	4	50						3	0.5								3	10.	23						
675	RAIL BASE LONG WEST P1-P2	6	16	50						6	5.5								6	5.	155						
676	RAIL BASE LONG WEST ON NE	6	1	90						7	1.0								7	1.	11						
677	RAIL BASE LONG WEST ON NE	6	1	90						7	1.0								7	1.	11						
678	RAIL BASE LONG EAST ON NW	6	4	190						6	6.5								6	6.	4						
679	RAIL BASE LONG EAST ON NW	6	4	190						6	6.5								6	6.	4						
702	SIGN BRIDGE BASE	4	5	10						9	0.0								2	10.	38						
703	SIGN BRIDGE BASE	4	4	20						2	2.0								1	11.	5						
704	SIGN BRIDGE BASE	4	4	4						1	3.0								0	4.	7						
705	SIGN BRIDGE BASE	4	5	24						2	0.0								2	8.	43						
706	SIGN BRIDGE BASE	4	4	24						13	3.0								13	3.	111						
707	SIGN BRIDGE BASE	4	5	8						0	5.0								2	4.	43						
700	LIGHT STD ANCHORAGE	6	6	12						0	8.5	2	0.5	0	5.0				3	1.	28						
701	LIGHT STD ANCHORAGE	6	6	6						0	8.5	2	0.5	0	8.5				3	1.	28						
710	ACCESS HATCH	6	8	50						5	0.0								5	0.0	60						

N-W-N-E UNIT

BAR LIST TOTALS	SUBSTRUCTURE A-432	GRAND TOTAL	0.
	SUBSTRUCTURE A-15/A-40B	GRAND TOTAL	178982.
	SUPERSTRUCTURE A-432	GRAND TOTAL	2251.
	SUPERSTRUCTURE A-15/A-40B	GRAND TOTAL	845781.

MARK NO.	LOCATION	SIZE	NO.	REQ'D.	BEND TYPE	TIE OR STIR	FLD. WELD.	SUBSTR.	VARIES	NO. EACH	DIMENSIONS (Out to out)										LENGTH		WEIGHT				
											U		W		X		Y		Z		θ ₁		θ ₂		Ft.	In.	Lbs.
											Ft.	In.	Ft.	In.	Ft.	In.	Ft.	In.	Ft.	In.	Deg.	Deg.	Ft.	In.	Lbs.		

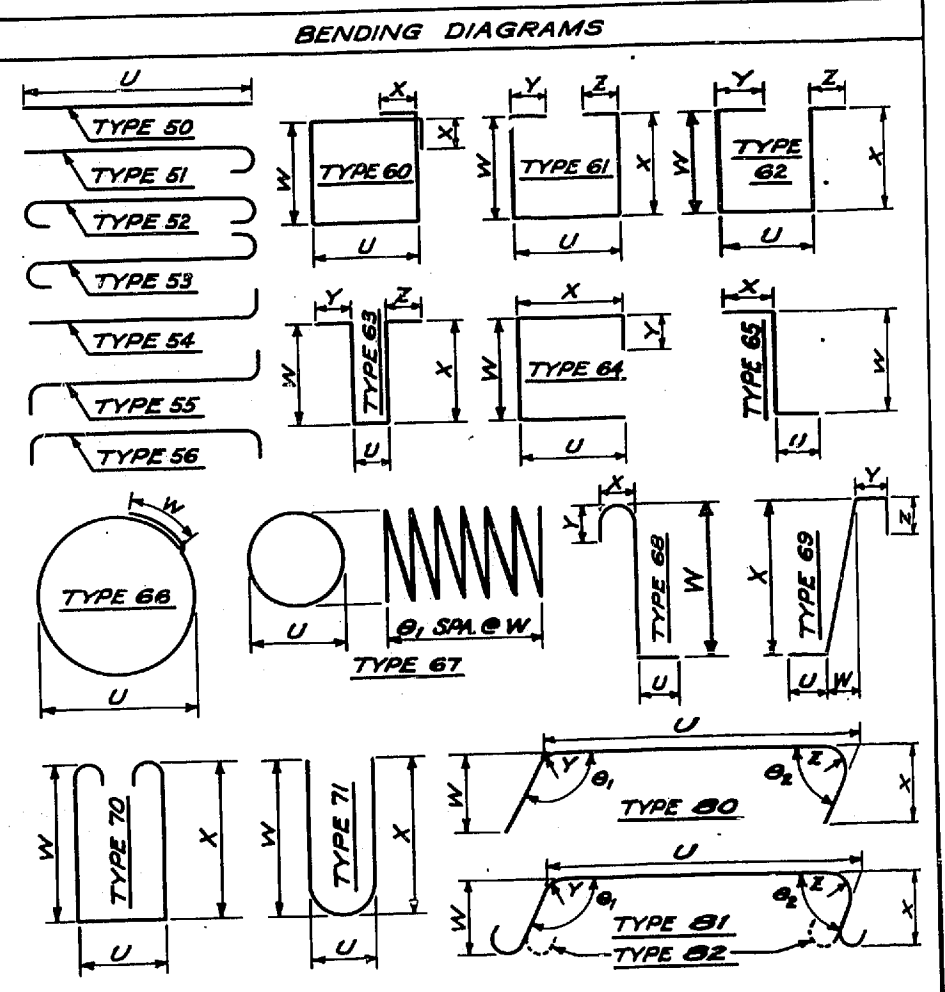

SR 405
 MP 23.49 TO MP 23.76
 WOODINVILLE INTERCHANGE
 KING COUNTY
 N-W&N-E STRUCTURE
 BAR LIST N-W&N-E UNIT I

WASHINGTON STATE HIGHWAY COMMISSION
 DEPARTMENT OF HIGHWAYS
 OLYMPIA, WASHINGTON

GEORGE D. ZAHN, CHAIRMAN
 I. L. MIFALSON, N. WALSH
 BAKER PERDUE, JOHN N. RUPP

APPROVED December 7, 1967
 SHEET 286 of 297 SHEETS
 CONTRACT NO. 8382

FILE NO. 1-RE/SH NO. 2-30
 N-W-N-E STRUCTURE
 BAR LIST - UNIT I
 SHEET 286 OF 297

1/1995

S=Bar is included in substructure quantities.

H=A.S.T.M. A-432.

F=Bar to be field welded.

V=Bar dimensions vary between dimensions shown on this line and the following line.

T= Tie or Stirrup.

Table with columns: MARK NO., LOCATION, SIZE, NO. REQ'D., BEND TYPE, FIELD WELD, TIE OR STIRRUP, VARIES, NO. EACH, DIMENSIONS (Out to out) U, W, X, Y, Z, theta1, theta2, LENGTH, WEIGHT. Rows 446-700.

Summary table for BAR LIST TOTALS. Includes columns for SUBSTRUCTURE A-432, SUBSTRUCTURE A-57A-08, SUPERSTRUCTURE A-432, SUPERSTRUCTURE A-57A-08. Grand totals for length and weight.

S=Bar is included in substructure quantities.

H=A.S.T.M. A-432.


F=Bar to be field welded.

V=Bar dimensions vary between dimensions shown on this line and the following line.

T= Tie or Stirrup.

Table with columns: MARK NO., LOCATION, SIZE, NO. REQ'D., BEND TYPE, FIELD WELD, TIE OR STIRRUP, VARIES, NO. EACH, DIMENSIONS (Out to out) U, W, X, Y, Z, theta1, theta2, LENGTH, WEIGHT. Rows 446-700.

Project information table: FED. ROAD DIV. NO., STATE, FED. AID PROJ. NO., SHEET NO., TOTAL SHEETS. Values: 0, WASH., I-405-3(297)18, 288, 297.

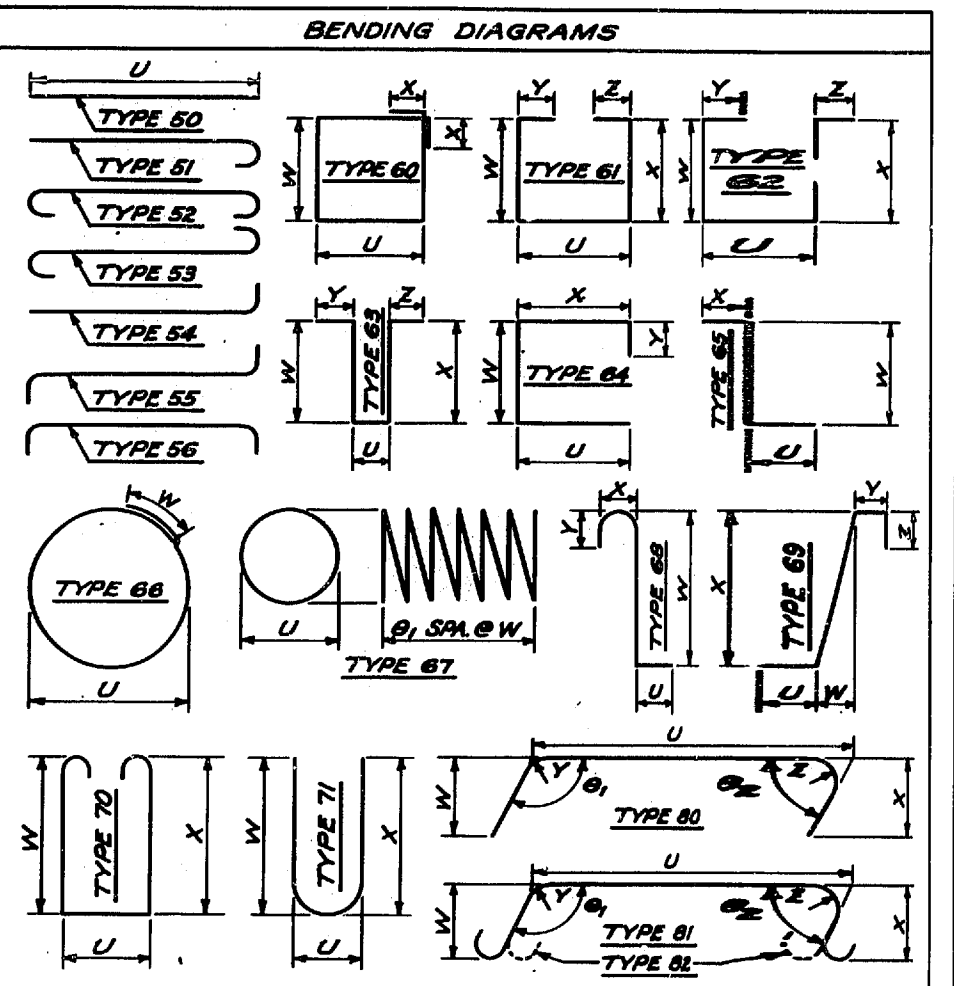

SR 405
MP 23.49 TO MP 23.76
WOODINVILLE INTERCHANGE
KING COUNTY
N-W&N-E STRUCTURE
BAR LIST N-W UNIT 2

WASHINGTON STATE HIGHWAY COMMISSION
DEPARTMENT OF HIGHWAYS
OLYMPIA, WASHINGTON

GEORGE D. ZAHN, CHIEF ENGINEER
I. M. ALSON, H. WALSH, BAKER FERDINAND, JOHN N. RUFF

APPROVED December 7, 1967

As Built Changes in Original SHEET 288 OF 297 SHEETS
CONTRACT NO. 8382

1/198

S- Bar is included in substructure quantities.
 F- Bar to be field welded.
 T- Tie or StIRRUP.

H- A.S.T.M. A-432.
 V- Bar dimensions vary between dimensions shown on this line and the following line.

MARK NO.	LOCATION	SIZE	NO. REQ'D	BEND TYPE	TIE OR STIRRUP	FIELD WELD	SUBSTR.	VARIES	NO. EACH	DIMENSIONS (Out to out)										LENGTH	WEIGHT		
										U		W		X		Y		Z				θ ₁	θ ₂
										Ft.	In.	Ft.	In.	Ft.	In.	Ft.	In.	Ft.	In.				
N-W UNIT 3																							
61	NW STRUCT PIER 7 FTG LONG	11	39	50					20	6.0							4030						
62	NW STRUCT PIER 7 FTG TRAN	11	39	50					20	6.0							4030						
63	NW STRUCT PIER 7 FTG DOWL	14	18	50					20	6.0							1790						
64	NW STRUCT PIER 7 FTG DOWL	14	18	50					20	6.0							2474						
65	NW STRUCT PIER 8 FTG LONG	11	14	50					26	0.0							1932						
66	NW STRUCT PIER 8 FTG TRAN	11	14	50					26	0.0							3835						
67	NW STRUCT PIER 8 FTG DOWL	14	16	54					10	11.0							1991						
68	NW STRUCT PIER 8 FTG DOWL	14	16	54					15	11.0							2203						
69	NW STRUCT PIER 9 FTG LONG	11	26	50					17	0.0							2348						
70	NW STRUCT PIER 9 FTG TRAN	11	34	50					20	6.0							3700						
71	NW STRUCT PIER 9 FTG DOWL	14	17	54					10	11.0							1193						
72	NW STRUCT PIER 9 FTG DOWL	14	17	54					15	11.0							1652						
111	NW STRUCT COL 7 TIES	4	67	66					5	9.0	1	6.0					870						
122	NW STRUCT COL 7 VERT	14	18	50					52	7.0							7241						
123	NW STRUCT COL 7 VERT	14	18	50					57	7.0							7929						
111	NW STRUCT COL 8 TIES	4	68	66					5	9.0	1	6.0					883						
124	NW STRUCT COL 8 VERT	14	16	50					53	9.0							6379						
125	NW STRUCT COL 8 VERT	14	16	50					58	9.0							7191						
111	NW STRUCT COL 9 TIES	4	66	66					19	9.0	1	6.0					853						
126	NW STRUCT COL 9 VERT	14	12	50					51	4.0							4712						
127	NW STRUCT COL 9 VERT	14	12	50					56	4.0							5171						
200	BOTTOM SLAB BOT TRANSV	14	195	61					19	8.0	1	0.0	1	0.0			4305						
203	BOT SLAB BOT LONG HING-P7	5	4	50					14	9.0							31						
204	BOT SLAB BOT LONG HING-P7	5	2	50					8	0.0							50						
205	BOT SLAB BOT LONG HING-P7	5	2	50					22	0.0							46						
206	BOT SLAB BOT LONG HING-P7	14	2	54					30	0.0							1377						
207	BOT SLAB BOT LONG HING-P7	14	2	54					49	9.0							793						
208	BOT SLAB BOT LONG HING-P7	14	4	54					51	10.0							1510						
209	BOT SLAB BOT LONG HING-P7	14	4	54					47	0.0							2157						
211	BOT SLAB BOT LONG HING-P7	14	4	54					59	6.0							1816						
212	BOT SLAB BOT LONG HING-P7	14	2	54					55	0.0							931						
213	BOT SLAB BOT LONG HING-P7	14	2	54					59	3.0							2720						
214	BOT SLAB BOT LONG HING-P7	14	6	54					71	3.0							3270						
215	BOT SLAB BOT LONG HING-P7	5	8	50					67	6.0							3240						
216	BOT SLAB BOT LONG HING-P7	5	6	50					36	0.0							300						
217	BOT SLAB BOT LONG HING-P7	5	2	50					31	6.0							197						
218	BOT SLAB BOT LONG HING-P7	5	2	50					46	0.0							96						
219	BOT SLAB BOT LONG HING-P7	5	2	50					37	0.0							77						
220	BOT SLAB BOT LONG HING-P7	14	2	50					27	0.0							56						
221	BOT SLAB BOT LONG HING-P7	14	2	50					44	9.0							685						
222	BOT SLAB BOT LONG HING-P7	14	4	50					35	9.0							547						
223	BOT SLAB BOT LONG HING-P7	14	4	50					46	0.0							1408						
225	BOTTOM SLAB ROT LONG P7-P8	5	2	50					45	6.0							1392						
226	BOTTOM SLAB ROT LONG P7-P8	5	4	50					24	6.0							51						
227	BOTTOM SLAB ROT LONG P7-P8	5	4	50					33	6.0							140						
228	BOTTOM SLAB ROT LONG P7-P8	5	4	50					40	0.0							116						
229	BOTTOM SLAB ROT LONG P7-P8	5	4	50					27	9.0							511						
230	BOTTOM SLAB ROT LONG P7-P8	14	2	50					79	3.0							3328						
231	BOTTOM SLAB ROT LONG P7-P8	14	6	50					72	6.0							3328						
232	BOTTOM SLAB ROT LONG P7-P8	14	6	50					64	6.0							2961						
233	BOTTOM SLAB ROT LONG P7-P8	14	4	50					53	4.0							2448						
234	BOTTOM SLAB ROT LONG P7-P8	14	6	50					74	10.0							2291						
84	NW STRUCT FTG TRANS BOT	11	57	50					39	3.0							1802						
88	NW STRUCT FTG LONGIT TOP	14	23	50					27	6.0							8330						
89	NW STRUCT TRANS BOT	6	34	50					33	0.0							5808						
									27	6.0							1404						
235	BOTTOM SLAB HOT LONG P7-P8	14	6	50					70	3.0							3179						
236	BOTTOM SLAB HOT LONG P7-P8	14	6	50					68	3.0							3179						
237	BOTTOM SLAB HOT LONG P7-P8	5	4	50					31	6.0							1400						
238	BOTTOM SLAB HOT LONG P7-P8	5	4	50					18	6.0							77						
239	BOTTOM SLAB HOT LONG P7-P8	5	2	50					28	6.0							119						
240	BOTTOM SLAB HOT LONG P7-P8	5	4	50					35	6.0							94						
241	BOTTOM SLAB HOT LONG P7-P8	14	4	50					22	0.0							72						
242	BOTTOM SLAB HOT LONG P7-P8	14	2	50					40	0.0							1224						
243	BOTTOM SLAB HOT LONG P7-P8	14	2	50					78	0.0							1193						
244	BOTTOM SLAB HOT LONG P8-P	5	4	50					35	9.0							382						
245	BOTTOM SLAB HOT LONG P8-P	5	4	50					21	0.0							88						
246	BOTTOM SLAB HOT LONG P8-P	5	4	50					25	0.0							104						
247	BOTTOM SLAB HOT LONG P8-P	10	6	50					49	3.0							1272						
248	BOTTOM SLAB HOT LONG P8-P	10	6	50					42	3.0							1091						
249	BOTTOM SLAB HOT LONG P8-P	10	6	50					28	3.0							729						
250	BOTTOM SLAB HOT LONG P8-P	10	6	50					80	0.0							1377						
251	BOTTOM SLAB HOT LONG P8-P	10	4	50					78	0.0							1343						
252	BOTTOM SLAB HOT LONG P8-P	10	4	50					80	0.0							1377						
253	BOTTOM SLAB HOT LONG P8-P	5	4	50					24	9.0							109						
254	BOTTOM SLAB HOT LONG P8-P	5	4	50					27	6.0							113						
255	BOTTOM SLAB HOT LONG P8-P	5	4	50					12	6.0							1063						
256	BOT SLAB HOT LONG P9-HING	10	8	50					11	6.0							489						
257	BOT SLAB HOT LONG P9-HING	5	12	50					14	6.0							374						
258	BOTTOM SLAB TOP TRANSV	5	195	61					18	0.0	1	0.0	1	0.0			225						
259	BOTTOM SLAB TOP LONGIT	5	112	50					21	2.0							4305						
260	BOTTOM SLAB TOP LONGIT	5	8	50					40	0.0							4673						
269	BOTTOM SLAB TOP LONGIT	5	8	50					30	9.0							257						
270	BOTTOM SLAB TOP LONGIT	14	8	50					38	3.0							319						
350	WEB LONGIT	4	84	50					35	0.0							2142						
351	WEB LONGIT	4	12	50					40	0.0							2244						
352	WEB LONGIT	10	6	50					33	6.0							269						
353	WEB LONGIT	10	6	50					58	0.0							1497						
354	WEB LONGIT	10	6	50					56	0.0							1444						
355	WEB LONGIT	8	6	50					41	6.0							1071						
356	WEB LONGIT	8	6	50					50	0.0													

S= Bar is included in substructure quantities.

F= Bar to be field welded.

T= Tie or StIRRUP.

H= A.S.T.M. A-432.

V= Bar dimensions vary between dimensions shown on this line and the following line.

S= Bar is included in substructure quantities.

F= Bar to be field welded.

T= Tie or StIRRUP.

H= A.S.T.M. A-432.

V= Bar dimensions vary between dimensions shown on this line and the following line.

FED. ROAD DIST. NO.	STATE	FED. AID PROJ. NO.	SHEET NO.	TOTAL SHEETS
6	WASH.	I-405-3(29)118	293	297

MARK NO.	LOCATION	SIZE	NO. REQD.	BEND TYPE	THE OR STIRRUP	FIELD WELD	SUBSTR.	VARIES	NO. EACH	DIMENSIONS (Out to out)										LENGTH	WEIGHT		
										U		W		X		Y		Z				θ ₁	θ ₂
										Ft.	In.	Ft.	In.	Ft.	In.	Ft.	In.	Ft.	In.				
85	NW STRUCT PIER 13 FTC LONG	11	39	50						20	0.0							3719					
86	NW STRUCT PIER 13 FTC TRAN	11	39	50						20	0.0							3739					
87	NW STRUCT PIER 13 FTC DOWL	11	26	54						7	6.0							1278					
89	NW STRUCT PIER 14 FTG LONG	11	39	50						20	6.0							4030					
90	NW STRUCT PIER 14 FTG TRAN	11	39	50						20	6.0							4030					
91	NW STRUCT PIER 14 FTG DOWL	11	26	54						11	11.0							1646					
92	NW STRUCT PIER 15 FTG LONG	11	39	50						20	6.0							2254					
93	NW STRUCT PIER 15 FTG TRAN	11	39	50						20	6.0							2254					
94	NW STRUCT PIER 15 FTG DOWL	11	20	54						5	9.0							1789					
95	NW STRUCT PIER 15 FTG DOWL	11	20	54						5	9.0							1789					
111	NW STRUCT COL 13 TIES	4	48	66						1	6.0							558					
136	NW STRUCT COL 13 VERT	11	26	50						138	1.0							5261					
111	NW STRUCT COL 14 TIES	4	48	66						5	9.0							519					
138	NW STRUCT COL 14 VERT	11	26	50						35	8.0							4927					
111	NW STRUCT COL 15 TIES	4	36	66						5	9.0							467					
139	NW STRUCT COL 15 VERT	14	14	50						20	8.0							2213					
140	NW STRUCT COL 15 VERT	14	14	50						25	8.0							2742					
200	BOTTOM SLAB BOT TRANSV	5	215	61						19	8.0	1	0.0	1	0.0			4747					
203	BOT SLAB BOT LONG HIN-P13	5	2	50						14	6.0							30					
204	BOT SLAB BOT LONG HIN-P13	5	2	50						8	6.0							18					
205	BOT SLAB BOT LONG HIN-P13	14	6	54						57	9.0							2718					
206	BOT SLAB BOT LONG HIN-P13	14	6	54						57	6.0							2718					
207	BOT SLAB BOT LONG HIN-P13	14	6	54						61	9.0							2712					
208	BOT SLAB BOT LONG HIN-P13	14	6	50						60	6.0							2901					
209	BOT SLAB BOT LONG HIN-P13	14	6	54						49	3.0							2261					
210	BOT SLAB BOT LONG HIN-P13	14	6	50						68	0.0							3182					
211	BOT SLAB BOT LONG HIN-P13	14	6	50						66	6.0							2983					
212	BOT SLAB BOT LONG HIN-P13	14	6	50						27	0.0							113					
213	BOT SLAB BOT LONG HIN-P13	14	6	50						36	9.0							230					
214	BOT SLAB BOT LONG HIN-P13	14	6	50						35	6.0							543					
215	BOT SLAB BOT LONG HIN-P13	14	4	50						32	9.0							1446					
217	BOT SLAB BOT LONG P13-P14	14	4	50						30	3.0							2008					
218	BOT SLAB BOT LONG P13-P14	14	4	50						40	0.0							1224					
219	BOT SLAB BOT LONG P13-P14	14	4	50						29	6.0							185					
220	BOT SLAB BOT LONG P13-P14	14	4	50						24	0.0							100					
222	BOT SLAB BOT LONG P13-P14	14	2	50						35	2.0							538					
22	BOT SLAB BOT LONG P13-P14	14	4	50						72	3.0							1125					
224	BOT SLAB BOT LONG P13-P14	14	4	50						42	3.0							1293					
225	BOT SLAB BOT LONG P13-P14	14	4	50						56	3.0							1721					
226	BOT SLAB BOT LONG P13-P14	14	4	50						72	6.0							1155					
227	BOT SLAB BOT LONG P13-P14	14	6	50						66	3.0							3041					
228	BOT SLAB BOT LONG P13-P14	14	6	50						76	3.0							3500					
229	BOT SLAB BOT LONG P13-P14	14	5	50						24	9.0							103					
230	BOT SLAB BOT LONG P13-P14	14	5	50						29	6.0							123					
231	BOT SLAB BOT LONG P13-P14	14	2	50						31	6.0							482					
258	BOT SLAB BOT LONG P13-P14	14	2	50						77	6.0							1186					
259	BOT SLAB BOT LONG P13-P14	14	2	50						76	3.0							1147					
239	BOT SLAB BOT LONG P14-P15	14	6	50						47	4.0							2119					
240	BOT SLAB BOT LONG P14-P15	14	6	50						45	0.0							2119					
241	BOT SLAB BOT LONG P14-P15	14	6	50						77	6.0							3557					
242	BOT SLAB BOT LONG P14-P15	14	6	50						69	6.0							3190					
243	BOT SLAB BOT LONG P14-P15	14	6	50						60	6.0							2777					
244	BOT SLAB BOT LONG P14-P15	14	6	50						48	3.0							2215					
245	BOT SLAB BOT LONG P14-P15	14	6	50						25	0.0							1147					
246	BOT SLAB BOT LONG P14-P15	14	6	50						64	8.0							3014					
247	BOT SLAB BOT LONG P14-P15	14	6	50						75	3.0							3454					
248	BOT SLAB BOT LONG P14-P15	14	6	50						41	8.0							1867					
249	BOT SLAB BOT LONG P14-P15	14	6	50						39	8.0							1867					
250	BOT SLAB BOT LONG P14-P15	14	6	50						22	6.0							141					
251	BOT SLAB BOT LONG P14-P15	14	6	50						42	6.0							89					
252	BOT SLAB BOT LONG P14-P15	14	6	50						28	6.0							59					
253	BOT SLAB BOT LONG P14-P15	14	6	50						18	6.0							77					
254	BOT SLAB BOT LONG P15-HIN	10	16	50						14	0.0							58					
255	BOTTOM SLAB TOP LONGIT	5	125	80						24	6.0							409					
256	BOTTOM SLAB TOP LONGIT	5	8	50						25	5.0							656					
257	BOTTOM SLAB TOP LONGIT	5	8	50						21	2.0							4747					
258	BOTTOM SLAB TOP LONGIT	5	8	50						40	0.0							5340					
259	BOTTOM SLAB TOP LONGIT	5	8	50						16	0.0							22					
257	BOTTOM SLAB TOP LONGIT	5	8	50						22	0.0							22					

MARK NO.	LOCATION	SIZE	NO. REQD.	BEND TYPE	THE OR STIRRUP	FIELD WELD	SUBSTR.	VARIES	NO. EACH	DIMENSIONS (Out to out)										LENGTH	WEIGHT		
										U		W		X		Y		Z				θ ₁	θ ₂
										Ft.	In.	Ft.	In.	Ft.	In.	Ft.	In.	Ft.	In.				
350	WEB LONGIT	4	96	50						30	6.0							229					
351	WEB LONGIT	4	12	50						40	0.0							2565					
352	WEB LONGIT	10	6	50						28	6.0							180					
353	WEB LONGIT	10	6	50						58	0.0							1497					
354	WEB LONGIT	10	6	50						62	0.0							1601					
355	WEB LONGIT	10	6	50						54	0.0							1394					
356	WEB LONGIT	8	6	50						50	0.0							801					
357	WEB LONGIT	8	12	50						2	22	0.0						320					
358	WEB LONGIT	8	12	50						18	0.0							320					
359	WEB STIRRUPS	5	2454	64						19	6.0	4	10.5					14239					
365	DIAPH HORIZ	5	36	50						19	8.0							738					
366	DIAPH STIRRUPS	4	216	64						6	0.0	4	7.0					7					



S= Bar is included in substructure quantities.
 F= Bar to be field welded.
 T= Tie or Stirrup.
 H= A.S.T.M. A-432.
 V= Bar dimensions vary between dimensions shown on this line and the following line.

MARK NO.	LOCATION	SIZE	NO. REQD.	BEND TYPE	TIE OR STIRRUP	FIELD WELD	SUBSTR.	VARIES	NO. EACH	DIMENSIONS (Out to out)										LENGTH		WEIGHT Lbs.		
										U		W		X		Y		Z		θ ₁	θ ₂		Ft.	In.
										Ft.	In.	Ft.	In.	Ft.	In.	Ft.	In.	Ft.	In.					
430	ROADWAY SLAB TOP LG P13-15	5	8	50					27	6.0							27	6.	229					
431	ROADWAY SLAB TOP LG P13-15	5	4	50					11	6.0							11	6.	48					
432	ROADWAY SLAB TOP LG P13-15	5	15	50					15	3.0							15	3.	64					
433	ROADWAY SLAB TOP LG P13-15	5	4	50					22	0.0							22	0.	92					
434	ROADWAY SLAB TOP LG P13-15	8	2	50					60	0.0							60	0.	320					
435	ROADWAY SLAB TOP LG P13-15	8	1	50					40	0.0							40	0.	107					
436	ROADWAY SLAB TOP LG P13-15	8	1	50					34	6.0							34	6.	92					
437	ROADWAY SLAB TOP LG P13-15	5	2	50					40	0.0							40	0.	83					
438	ROADWAY SLAB TOP LG P13-15	5	2	50					35	0.0							35	0.	73					
439	ROADWAY SLAB TOP LG P13-15	5	8	50					39	0.0							39	0.	325					
440	ROADWAY SLAB TOP LG P13-15	5	8	50					37	0.0							37	0.	309					
441	ROADWAY SLAB TOP LG P13-15	11	2	50					41	0.0							41	0.	436					
442	ROADWAY SLAB TOP LG P13-15	11	2	50					37	0.0							37	0.	393					
443	ROADWAY SLAB TOP LG P13-15	11	2	50					39	0.0							39	0.	414					
444	ROADWAY SLAB TOP LG P13-15	5	4	50					18	0.0							18	0.	75					
445	ROADWAY SLAB TOP LG P13-15	5	2	50					15	0.0							15	0.	63					
446	ROADWAY SLAB TOP LG P13-15	5	4	50					22	0.0							22	0.	46					
447	ROADWAY SLAB TOP LG P13-15	5	4	50					24	0.0							24	0.	100					
448	ROADWAY SLAB TOP LG AT P14	14	6	50					29	0.0							29	0.	121					
449	ROADWAY SLAB TOP LG AT P14	14	6	50					15	0.0							15	0.	688					
450	ROADWAY SLAB TOP LG AT P14	14	6	50					21	0.0							21	0.	964					
451	ROADWAY SLAB TOP LG AT P14	14	6	50					25	0.0							25	0.	1147					
452	ROADWAY SLAB TOP LG AT P14	14	6	50					30	0.0							30	0.	1377					
453	ROADWAY SLAB TOP LG AT P14	14	6	50					35	0.0							35	0.	1606					
454	ROADWAY SLAB TOP LG AT P14	14	6	50					42	0.0							42	0.	1924					
455	ROADWAY SLAB TOP LG AT P14	14	6	50					49	0.0							49	0.	2249					
456	ROADWAY SLAB TOP LG AT P14	14	6	50					58	0.0							58	0.	2662					
457	ROADWAY SLAB TOP LG AT P14	14	6	50					66	0.0							66	0.	3029					
458	ROADWAY SLAB TOP LG P14-15	5	2	50					76	0.0							76	0.	3488					
459	ROADWAY SLAB TOP LG P14-15	5	2	50					14	0.0							14	0.	29					
460	ROADWAY SLAB TOP LG P14-15	5	4	50					18	0.0							18	0.	75					
461	ROADWAY SLAB TOP LG P14-15	5	2	50					10	0.0							10	0.	21					
462	ROADWAY SLAB TOP LG P14-15	5	6	50					24	0.0							24	0.	150					
463	ROADWAY SLAB TOP LG P14-15	5	4	50					28	0.0							28	0.	117					
464	ROADWAY SLAB TOP LG P14-15	8	2	50					70	0.0							70	0.	374					
465	ROADWAY SLAB TOP LG P14-15	8	1	50					25	0.0							25	0.	67					
466	ROADWAY SLAB TOP LG P14-15	8	1	50					19	6.0							19	6.	52					
467	ROADWAY SLAB TOP LG P14-15	5	2	50					40	0.0							40	0.	83					
468	ROADWAY SLAB TOP LG P14-15	5	2	50					35	0.0							35	0.	73					
469	ROADWAY SLAB TOP LG P14-15	5	2	50					39	0.0							39	0.	325					
470	ROADWAY SLAB TOP LG P14-15	5	8	50					37	0.0							37	0.	309					
471	ROADWAY SLAB TOP LG P14-15	11	2	50					53	0.0							53	0.	563					
472	ROADWAY SLAB TOP LG P14-15	11	2	50					49	0.0							49	0.	521					
473	ROADWAY SLAB TOP LG P14-15	11	2	50					51	0.0							51	0.	542					
474	ROADWAY SLAB TOP LG AT P15	14	4	54					20	0.0							20	0.	209					
475	ROADWAY SLAB TOP LG AT P15	14	4	54					26	0.0							26	0.	163					
476	ROADWAY SLAB TOP LG AT P15	14	4	54					29	0.0							29	0.	121					
477	ROADWAY SLAB TOP LG AT P15	14	4	54					35	7.							35	7.	1089					
478	ROADWAY SLAB TOP LG AT P15	14	4	54					33	6.							33	6.	513					
479	ROADWAY SLAB TOP LG AT P15	14	4	54					36	6.0							36	6.	1181					
480	ROADWAY SLAB TOP LG AT P15	14	2	50					36	6.0							36	6.	958					
481	ROADWAY SLAB TOP LG AT P15	14	2	50					41	7.							41	7.	1272					
482	ROADWAY SLAB TOP LG AT P15	14	2	50					39	6.							39	6.	604					
483	ROADWAY SLAB TOP LG AT P15	14	4	54					44	7.							44	7.	1364					
484	ROADWAY SLAB TOP LG AT P15	14	4	54					42	6.							42	6.	650					
485	ROADWAY SLAB BOT TRANSV	6	614	50					48	7.							48	7.	2230					
486	ROADWAY SLAB BOT LONGIT	5	288	50					53	7.							53	7.	2459					
487	ROADWAY SLAB BOT LONGIT	5	288	50					21	0.							21	0.	19367					
488	ROADWAY SLAB BOT LONGIT	5	18	50					40	0.							40	0.	12015					
489	ROADWAY SLAB BOT LONGIT	5	18	50					20	9.							20	9.	390					
593	ROADWAY SLAB BOT LONGIT	6	51	50					24	0.0							24	0.	544					
594	ROADWAY SLAB BOT LONGIT	6	8	50					32	3.0							32	3.	544					
596	SLAB CANT TRANS BOT	5	656	69					45	0.0							45	0.	3447					
597	SLAB DOWEL TO CURB	5	876	69					3	0.0							3	0.	403					
650	CURB LONGIT SOUTH	4	95	50					1	0.0							1	0.	2706					
651	CURB LONGIT SOUTH	4	95	50					3	0.0							3	0.	2654					
652	CURB LONGIT NORTH	4	95	50					1	3.0							1	3.	2654					
653	CURB LONGIT NORTH	4	95	50					3	0.0							3	0.	2929					
654	CURB TRANSV	4	457	65	T				15	9.0							15	9.	929					
655	RAIL BASE VERT I.S. FACE	5	914	65	T				13	4.0							13	4.	45					
656	RAIL BASE VERT O.S. FACE	4	457	64	T				16	9.0							16	9.	1063					
657	RAIL BASE LONGIT SOUTH	4	78	50					14	3.0							14	3.	48					
658	RAIL BASE LONGIT SOUTH	4	2	50					1	6.							1	6.	458					
659	RAIL BASE LONGIT NORTH	4	78	50					3	2.							3	2.	3092					
660	RAIL BASE LONGIT NORTH	4	2	50					2	0.5							2	0.	801					
661	RAIL BASE LONGIT SOUTH	6	78	50					7	9.0							7	9.	404					
662	RAIL BASE LONGIT SOUTH	6	2	50					4	10.0							4	10.	6					
663	RAIL BASE VERT NORTH	6	78	50					8	3.0							8	3.	430					
664	RAIL BASE VERT NORTH	6	2	50					5	8.0							5	8.	8					
700	LIGHT STD ANCHORAGE	6	24	64					7	9.0							7	9.	908					
701	LIGHT STD ANCHORAGE	6	12	65					4	10.0							4	10.	15					
									8	3.0							8	3.	967					
									5	8.0							5	8.	17					
									5	0.0							5	0.	86					
									2	0.5							2	0.	86					
									8.5	2							8.5	2	56					

UNIT	NO.	DESCRIPTION	WEIGHT
Substructure	A-432	GRAND TOTAL	.0
Substructure	A-15/A-40R	GRAND TOTAL	43960
Superstructure	A-432	GRAND TOTAL	1126
Superstructure	A-15/A-40R	GRAND TOTAL	267749

S= Bar is included in substructure quantities.
 F= Bar to be field welded.
 T= Tie or Stirrup.
 H= A.S.T.M. A-432.
 V= Bar dimensions vary between dimensions shown on this line and the following line.

MARK NO.	LOCATION	SIZE	NO. REQD.	BEND TYPE	TIE OR STIRRUP	FIELD WELD	SUBSTR.	VARIES	NO. EACH	DIMENSIONS (Out to out)										LENGTH		WEIGHT Lbs.		
										U		W		X		Y		Z		θ ₁	θ ₂		Ft.	In.
										Ft.	In.	Ft.	In.	Ft.	In.	Ft.	In.	Ft.	In.					

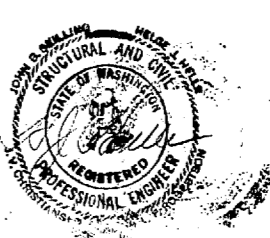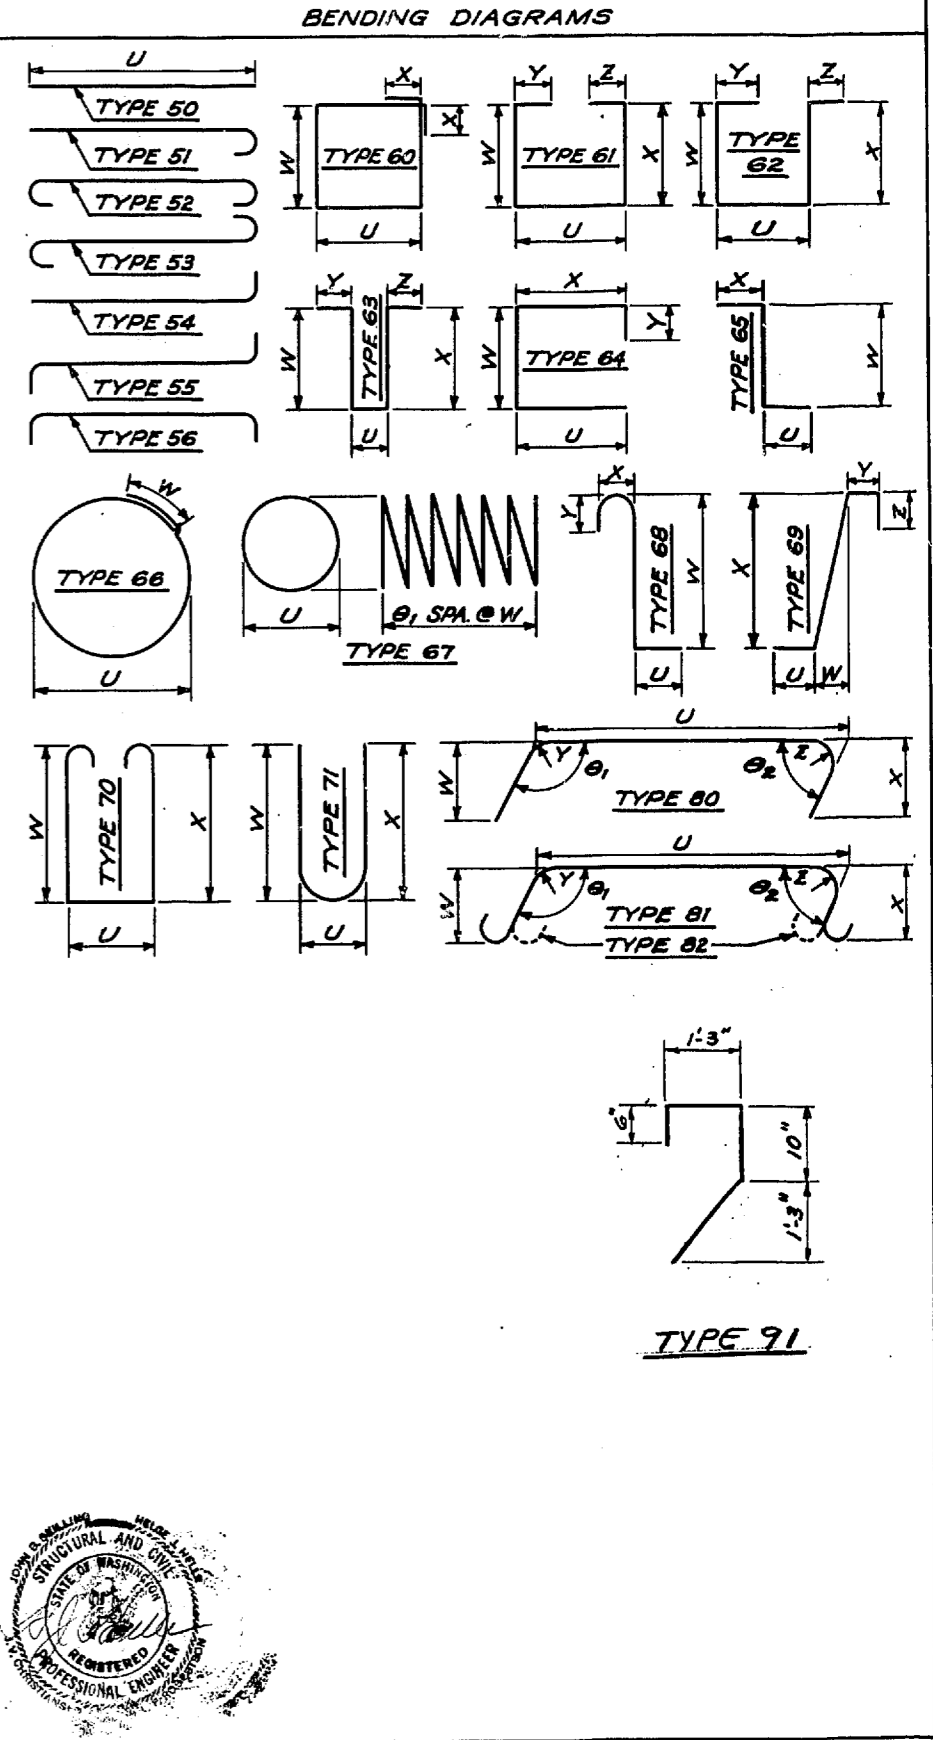

SR 405
 MP 23.49 TO MP 23.76
 WOODINVILLE INTERCHANGE
 KING COUNTY
 N-W&N-E STRUCTURE
 BAR LIST N-W UNIT 5

WASHINGTON STATE HIGHWAY COMMISSION
 DEPARTMENT OF HIGHWAYS
 OLYMPIA, WASHINGTON
 GEORGE D. ZAHN, CHAIRMAN
 F. L. METCALSON
 H. WALSH
 BARRY FERGUSON
 JOHN N. RUPP
 BRIDGE ENGINEER

APPROVED December 7, 1967
 SHEET 294 OF 297 SHEETS
 CONTRACT NO. 8382

S- Bar is included in substructure quantities.

F- Bar to be field welded.

T- Tie or Stirrup.

H- A.S.T.M. A-432.

V- Bar dimensions vary between dimensions shown on this line and the following line.

Table with columns: MARK NO., LOCATION, SIZE, NO. REQ'D., BEND TYPE, FIELD WELD, TIE OR STIRRUP, SUBSTR., A-432, VARIATIONS, DIMENSIONS (Out to out) U, W, X, Y, Z, theta 1, theta 2, LENGTH, WEIGHT.

S- Bar is included in substructure quantities.

F- Bar to be field welded.


T- Tie or Stirrup.

H- A.S.T.M. A-432.

V- Bar dimensions vary between dimensions shown on this line and the following line.

Table with columns: MARK NO., LOCATION, SIZE, NO. REQ'D., BEND TYPE, FIELD WELD, TIE OR STIRRUP, SUBSTR., A-432, VARIATIONS, DIMENSIONS (Out to out) U, W, X, Y, Z, theta 1, theta 2, LENGTH, WEIGHT.

Table with columns: FED. ROAD DIV. NO., STATE, FED. AID PROJ. NO., SHEET NO., TOTAL SHEETS.

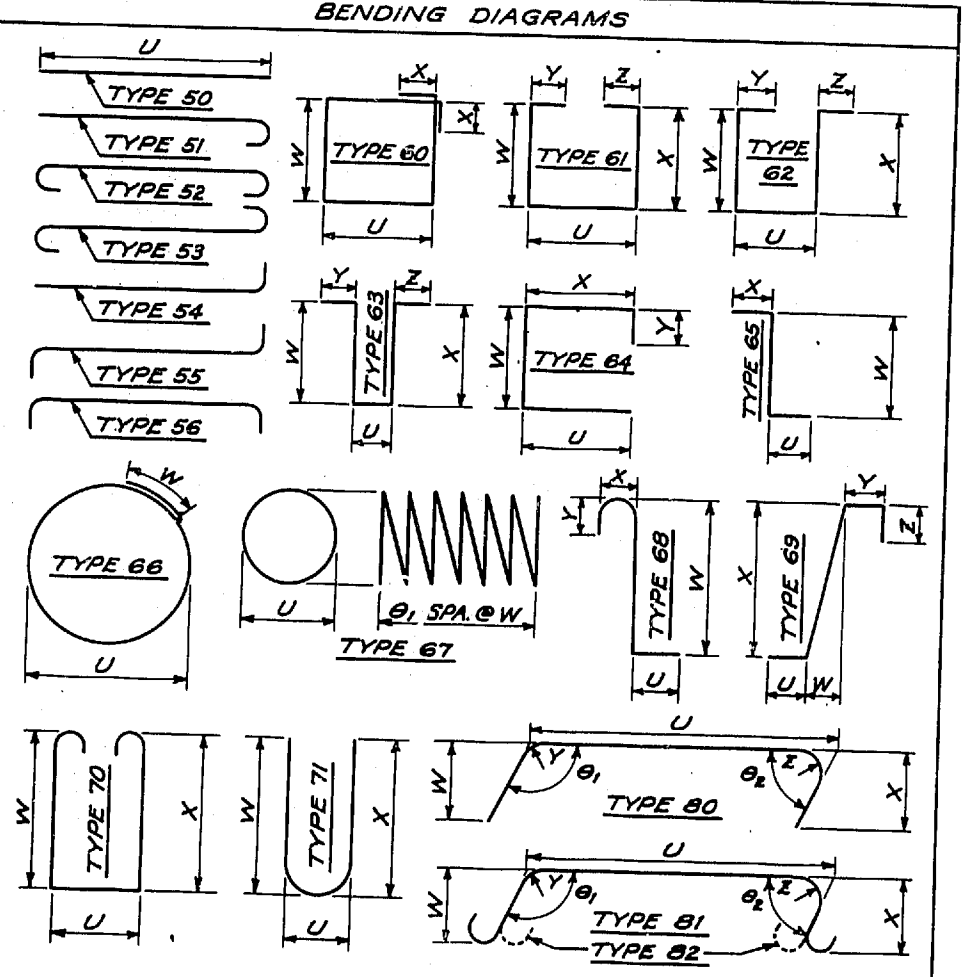

VARIOUS STEEL REINFORCING BARS, INCLUDING THOSE IN CROSSBEAMS, ARE SHOWN AS STRAIGHT ON THE "BAR LIST" SHEETS OF THE ATTACHED PLANS. THE CONTRACTOR SHALL BEND THESE BARS AS REQUIRED TO CONFORM TO THE GEOMETRY OF THE STRUCTURE AND AS DETAILED ON THE PLANS.



SR 405 MP 23.49 TO MP 23.76 WOODINVILLE INTERCHANGE KING COUNTY N-W & N-E STRUCTURE BAR LIST N-E UNIT 2

WASHINGTON STATE HIGHWAY COMMISSION DEPARTMENT OF HIGHWAYS OLYMPIA, WASHINGTON




APPROVED December 7, 1967 As Built Changes in Red Ink SHEET 295 of 297 SHEETS CONTRACT NO. 8382

S- Bar is included in substructure quantities.
 F- Bar to be field welded.
 T- Tie or Stirrup.

H- A.S.T.M. A-432.
 V- Bar dimensions vary between dimensions shown on this line and the following line.

MARK NO.	LOCATION	SIZE	NO.	REG'D.	BEND TYPE	TIE OR STIRRUP	FIELD WELDED	SUBSTR.	A-432	VARIES	DIMENSIONS (Out to out)										LENGTH	WEIGHT		
											U		W		X		Y		Z				θ ₁	θ ₂
											Ft.	In.	Ft.	In.	Ft.	In.	Ft.	In.	Ft.	In.				
N-E UNIT 3																								
104	NE STRUCT PIER 7 FTG LONG	11	26	50														17	0.0	2360				
105	NE STRUCT PIER 7 FTG TRAN	11	39	50														20	6.0	3700				
106	NE STRUCT PIER 7 FTG DOWL	11	19	50														17	0.0	934				
107	NE STRUCT PIER 8 FTG LONG	9	27	50														17	0.0	1257				
108	NE STRUCT PIER 8 FTG TRAN	9	27	50														17	0.0	1257				
109	NE STRUCT PIER 8 FTG DOWL	11	19	54														17	0.0	1257				
143	NE STRUCT COL 7 TIES	4	40	66														9	0.0	909				
143	NE STRUCT COL 7 VERT	11	19	50														16	3.0	435				
143	NE STRUCT COL 8 TIES	4	15	66														38	0.0	3836				
151	NE STRUCT COL 8 VERT	11	19	50														16	3.0	163				
200	BOTTOM SLAB ROT TRANSV	5	130	61														20	1.0	2027				
203	BOTTOM SLAB ROT LONG P7	5	4	50														12	0.0	2870				
204	BOTTOM SLAB ROT LONG P7	5	4	50														12	0.0	50				
205	BOTTOM SLAB ROT LONG P7	5	4	50														40	0.0	167				
206	BOTTOM SLAB ROT LONG P7	11	4	50														35	10.0	100				
207	BOTTOM SLAB ROT LONG P7	14	4	50														51	6.0	762				
208	BOTTOM SLAB ROT LONG P7	14	4	50														52	2.0	1576				
209	BOTTOM SLAB ROT LONG P7	14	4	50														62	2.0	1902				
210	BOTTOM SLAB ROT LONG P7	14	4	54														71	2.0	2241				
211	BOTTOM SLAB ROT LONG P7	14	4	54														73	3.0	2343				
212	BOTTOM SLAB ROT LONG P7	14	4	54														77	7.0	2425				
213	BOTTOM SLAB ROT LONG P7	11	2	50														82	3.0	2517				
214	BOTTOM SLAB ROT LONG P7	11	2	50														32	6.0	345				
215	BOTTOM SLAB ROT LONG P7	11	2	50														44	2.0	469				
216	BOTTOM SLAB ROT LONG P7	11	2	50														52	10.0	561				
217	BOTTOM SLAB ROT LONG P7	11	2	50														60	2.0	639				
218	BOTTOM SLAB ROT LONG P7	11	2	54														66	0.0	701				
219	BOTTOM SLAB ROT LONG P7	11	2	54														71	8.0	780				
220	BOTTOM SLAB ROT LONG P7	11	2	54														73	5.0	803				
221	BOTTOM SLAB ROT LONG P7	11	2	54														75	7.0	828				
222	BOTTOM SLAB ROT LONG P7	11	2	54														77	11.0	846				
225	BOTTOM SLAB ROT LONG P7	11	2	54														79	7.0	867				
225	BOTTOM SLAB ROT LONG AT P7	11	2	50														81	7.0	867				
226	BOTTOM SLAB ROT LONG AT P7	11	2	50														28	8.0	305				
227	BOTTOM SLAB ROT LONG AT P7	11	2	50														34	2.0	363				
228	BOTTOM SLAB ROT LONG AT P7	11	2	50														39	10.0	847				
229	BOTTOM SLAB ROT LONG AT P7	5	6	50														33	0.0	207				
230	BOTTOM SLAB ROT LONG AT P7	5	6	50														26	0.0	108				
231	BOTTOM SLAB ROT LONG AT P7	5	6	50														27	0.0	113				
232	BOTTOM SLAB ROT LONG AT P7	11	2	50														29	2.0	197				
233	BOTTOM SLAB ROT LONG AT P7	11	2	50														33	8.0	350				
234	BOTTOM SLAB ROT LONG AT P7	11	2	50														40	8.0	432				
237	BOTTOM SLAB ROT LONG AT P7	11	2	50														33	8.0	350				
238	BOTTOM SLAB ROT LONG AT P7	11	2	50														40	8.0	432				
239	BOTTOM SLAB ROT LONG AT P7	11	2	50														32	4.0	1031				
240	BOTTOM SLAB ROT LONG AT P7	11	2	50														45	2.0	1440				
241	BOTTOM SLAB ROT LONG AT P7	11	2	50														53	8.0	1711				
242	BOTTOM SLAB ROT LONG AT P7	11	2	50														61	4.0	1955				
243	BOTTOM SLAB ROT LONG AT P7	11	2	50														67	8.0	2157				
246	BOTTOM SLAB ROT LONG AT P7	11	2	50														75	8.0	2412				
247	BOTTOM SLAB ROT LONG AT P7	11	2	50														78	2.0	2492				
248	BOTTOM SLAB ROT LONG AT P7	5	4	50														62	0.0	669				
249	BOTTOM SLAB ROT LONG AT P7	5	4	50														31	0.0	179				
250	BOTTOM SLAB ROT LONG AT P7	5	4	50														25	0.0	209				
251	BOTTOM SLAB ROT LONG AT P7	5	4	50														21	2.0	2670				
350	INT & EXT WEB LONGIT TOP	10	6	50														40	0.0	3738				
351	INT & EXT WEB LONGIT TOP	10	6	50														53	0.0	1368				
352	INT & EXT WEB LONGIT TOP	8	6	50														43	6.0	1123				
353	INT & EXT WEB LONGIT TOP	8	6	50														50	0.0	801				
354	INT & EXT WEB LONGIT TOP	8	6	50														22	0.0	352				
355	INT & EXT WEB LONGIT CENT	4	60	50														40	0.0	689				
356	INT & EXT WEB LONGIT CENT	4	60	50														8	0.0	1603				
399	INT & EXT WEB STIRRUPS	5	1254	64	T													9	0.0	32				
360	DIAPHRAM HORIZ	4	144	64	T													5	7.0	7276				
361	DIAPHRAM HORIZ	4	144	64	T													19	8.0	492				
362	CROSS BEAM TOP P 7x8	14	20	50														4	7.0	513				
363	CROSS BEAM TOP P 7x8	14	11	61														23	6.0	3995				
364	CROSS BEAM TOP P 7x8	7	24	50														19	4.0	2146				
365	CROSS BEAM TOP P 7x8	7	24	50														19	8.0	969				
366	CROSS BEAM STIRRUPS	6	44	61														5	9.0	969				
720	PAVT SEAM LONG	1	3	0														4	7.0	1107				
721	END DIAP LONG	4	2	50	T													7	0.0	876				
742	END DIAP LONG	5	8	50	T													22	6.0	30				
743	END DIAP LONG	10	6	50	T													19	6.0	163				
723	END DIAP STIRRUP	5	20	62	T													19	6.0	503				
724	PAVT SEAM TIES	4	4	0														4	0.0	240				
750	END WALL VERT	4	8	50	T													10	11.0	228				
751	END WALL VERT	5	10	65	T													8	0.0	110				
752	END WALL VERT	5	6	64	T													4	8.5	61				
753	END WALL VERT	5	6	64	T													8	0.0	34				
630	HINGE DIAGONAL	11	21	98														6	0.0	195				
631	BRG SUPPORT HORIZ	14	21	50														4	6.5	1126				
632	BRG SUPPORT STIRRUPS	5	24	61</																				

WOODINVILLE INTERCHANGE

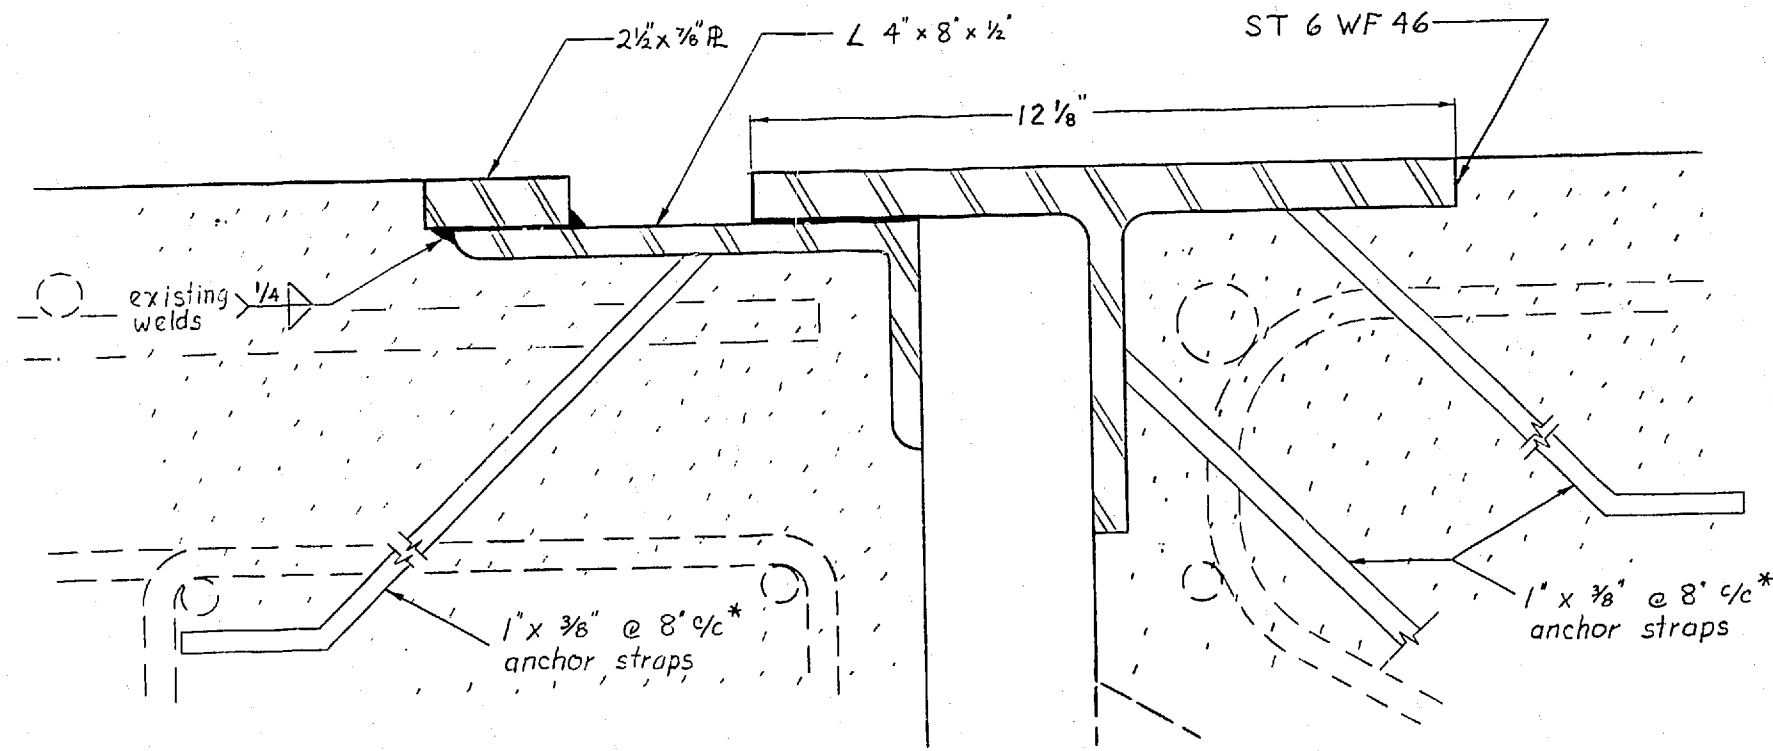

EXISTING EXPANSION JOINT DETAIL-TYPICAL

* spacing is approximate


Bridge No.	Joint Location	Length (note 2)	Skew	Exp. System	"Δ" (in)			Dimensions	
					@ 0°F	@ 64°F	@ 100°F	b"	t"
405/70W	W 853+06	33'-0"	0°	1, 2, 3 or 4	4 1/4	2 1/4	1	4 3/4	7/8"
"	W 856+59	33'-0"	0°	"	3 3/4	2 1/4	1 1/2	5	"
"	W 860+06	46'-0"	0°	"	4 1/4	2 7/16	1 3/8	5 1/4	"
"	W 863+41	33'-0"	0°	"	3 1/2	2 1/2	1 7/8	5	"
405/70S-E	S-E 69+19	25'-0"	0°	"	3 1/2	2 3/8	2	5	"
"	S-E 72+37	25'-0"	0°	"	3	2 3/8	2	5	"
405/70E	E 850+07	33'-0"	0°	"	3	2 3/8	1 3/4	5	"
"	E 853+26	33'-0"	0°	"	3 1/2	2	1 1/8	5	"
"	E 856+81	33'-0"	0°	"	4 1/4	2 3/8	1 3/8	5 1/2	"
"	E 860+30	59'-0"	0°	"	3 3/8	2 3/8	1 1/16	5 1/4	"
"	E 863+58	45'-0"	0°	"	4 1/8	2 1/2	1 1/2	5 1/4	"
405/70N-E	N-E 50+88	40'-0"	0°	"	2 1/4	2 1/16	1 7/8	5	"
"	N-E 53+11	23'-0"	0°	"	2 3/8	1 7/8	1 1/4	5	"
"	N-E 55+98	23'-0"	0°	"	4	2 3/8	1 13/16	5	"
405/70N-W	N-W 53+11	24'-0"	0°	"	3 3/8	2 1/16	1 7/16	5	"
"	N-W 56+38	24'-0"	0°	"	4	2 7/16	1 1/2	5	"
"	N-W 59+37	24'-0"	0°	"	3 3/4	2 3/8	1 1/2	5	"
"	N-W 62+31	24'-0"	0°	"	3 1/4	2	1 1/4	5	"
522/30W-S	W-S 45+83	33'-0"	0°	"	3 3/8	2 1/16	1 5/16	5	"
"	W-S 50+22	33'-0"	0°	"	2 7/8	2 1/16	1 9/16	5	"
"	W-S 53+66	33'-0"	0°	"	3 1/2	2	1 1/8	4 1/2	"
"	W-S 58+33	33'-0"	0°	"	2 7/8	2	1 7/16	5	"
"	W-S 61+88	33'-0"	0°	"	3 1/2	2 1/16	1 1/4	5	"
"	W-S 66+16	33'-0"	0°	"	3 3/16	2 3/16	1 7/8	5	"
522/30E-S	E-S 77+96	45'-0"	35° ±	4 only	3 3/8	2 1/4	1 3/8	5	7/8"

Expansion dam systems and dimensions have been selected based on joint movement histories.

List of Expansion Dam Systems	Range
1 Acme Trojan TR-400	3/4 - 4 3/4
2 Watson-Bowman WABO Elastoflex	1/2 - 4 1/2
3 Fel-Pro Felspan T-40 ACS	1/2 - 4 1/2
4 On-Flex On-flex E-Last-On w/model #40 membrane	1" - 5"

Dimensions A, B, & C will vary with each manufacturer.

5/8" φ x 2 1/4" stud welded bolts, stagger spacing to give uniform distribution not to exceed 9" parallel to & of joint and to permit placing of welded wire fabric.

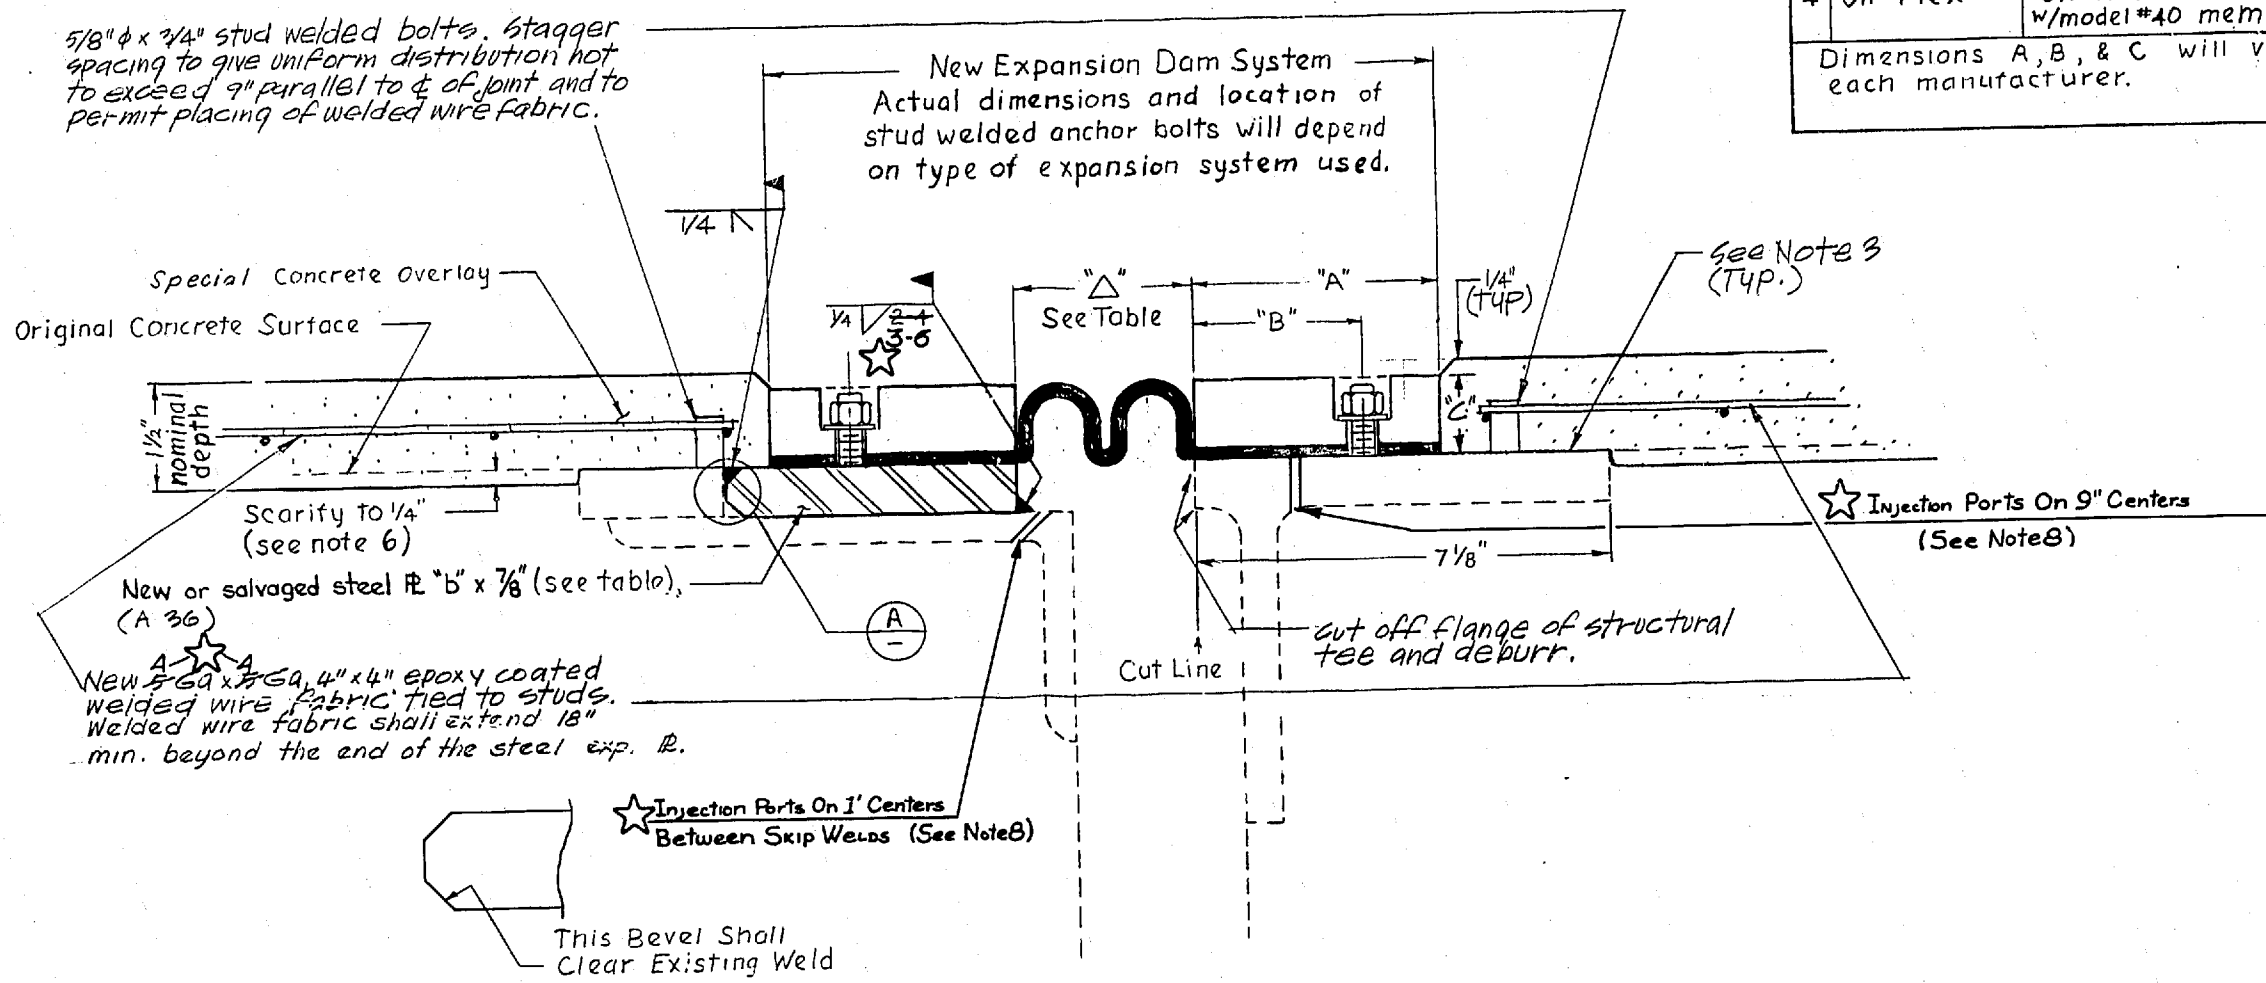


MODIFIED EXPANSION DAM DETAIL TYPICAL

- NOTES
- EXPANSION DAM SYSTEMS SHALL BE IN PLACE BEFORE PLACEMENT OF THE CONCRETE OVERLAY AND SHALL BE INSTALLED PER MANUFACTURER'S SPECIFICATIONS.
 - MODIFY EACH EXPANSION JOINT FULL LENGTH CURB TO CURB. CONTRACTOR SHALL VERIFY ACTUAL LENGTH REQUIRED AT EACH JOINT.
 - IMMEDIATELY PRIOR TO PLACEMENT OF THE OVERLAY, APPLY AN EPOXY RESIN BONDING AGENT TO ALL STEEL SURFACES TO BE COVERED BY THE OVERLAY.
 - THE DEPTH OF THE OVERLAY AT THE EXPANSION DAM WILL VARY WITH THE EXPANSION SYSTEM CHOSEN. THE OVERLAY SHALL BE FEATHERED AWAY FROM THE JOINT AT A RATE OF 0.10 INCHES IN 10 FEET TO THE NOMINAL OVERLAY DEPTH.
 - USE 5/8" DIA. STUD WELDED ANCHOR BOLTS WHENEVER POSSIBLE (1/2" DIA. MINIMUM). SIZE, INSTALLATION, AND LOCATION OF BOLTS SHALL CONFORM TO THE EXPANSION DAM MANUFACTURER'S SPECIFICATIONS.
 - CARE SHALL BE EXERCISED DURING SCARIFICATION OF THE CONCRETE BRIDGE DECK TO PREVENT DAMAGE TO THE EXISTING EXPANSION PLATES AND ANCHORAGES.
 - BOLT HOLE CAVITIES IN EXPANSION JOINT PANELS SHALL BE CLEANED AND FILLED WITH MANUFACTURER'S RECOMMENDED SEALANT AFTER JOINT SYSTEM HAS BEEN INSTALLED AND CHECKED FOR LEAKAGE.
- ☆ B. Change Order No. 3, Item No. 46, & Change Order No. 7 Item No. 48

☆ As-Built Changes 1-24-89

Bridge Design Engineer: <i>[Signature]</i> Supervisor: <i>[Signature]</i> Reviewed By: <i>[Signature]</i> Design-1 By: <i>[Signature]</i> Checked By: <i>[Signature]</i> Detailed By: <i>[Signature]</i> Architect: <i>[Signature]</i>	9/84 Added Note # 7 REGION NO. 10 STATE WASH FED. AID PROJ. NO. JR-405-3 (521) FHWA DEMO. NO. 39 JOB NUMBER 84W054 CONTRACT NO. 2814	BRIDGES AND STRUCTURES Washington State Department of Transportation May 14, 1984 APPROVED <i>[Signature]</i>	SR 405 WOODINVILLE 1/4 BRIDGE DECKS - RESURFACING EXPANSION DAM MODIFICATION DETAILS SR 405/112	BRIDGE SHEET NO. 1 SHEET 10 OF 22 SHEETS
--	--	--	--	---

WOODINVILLE INTERCHANGE

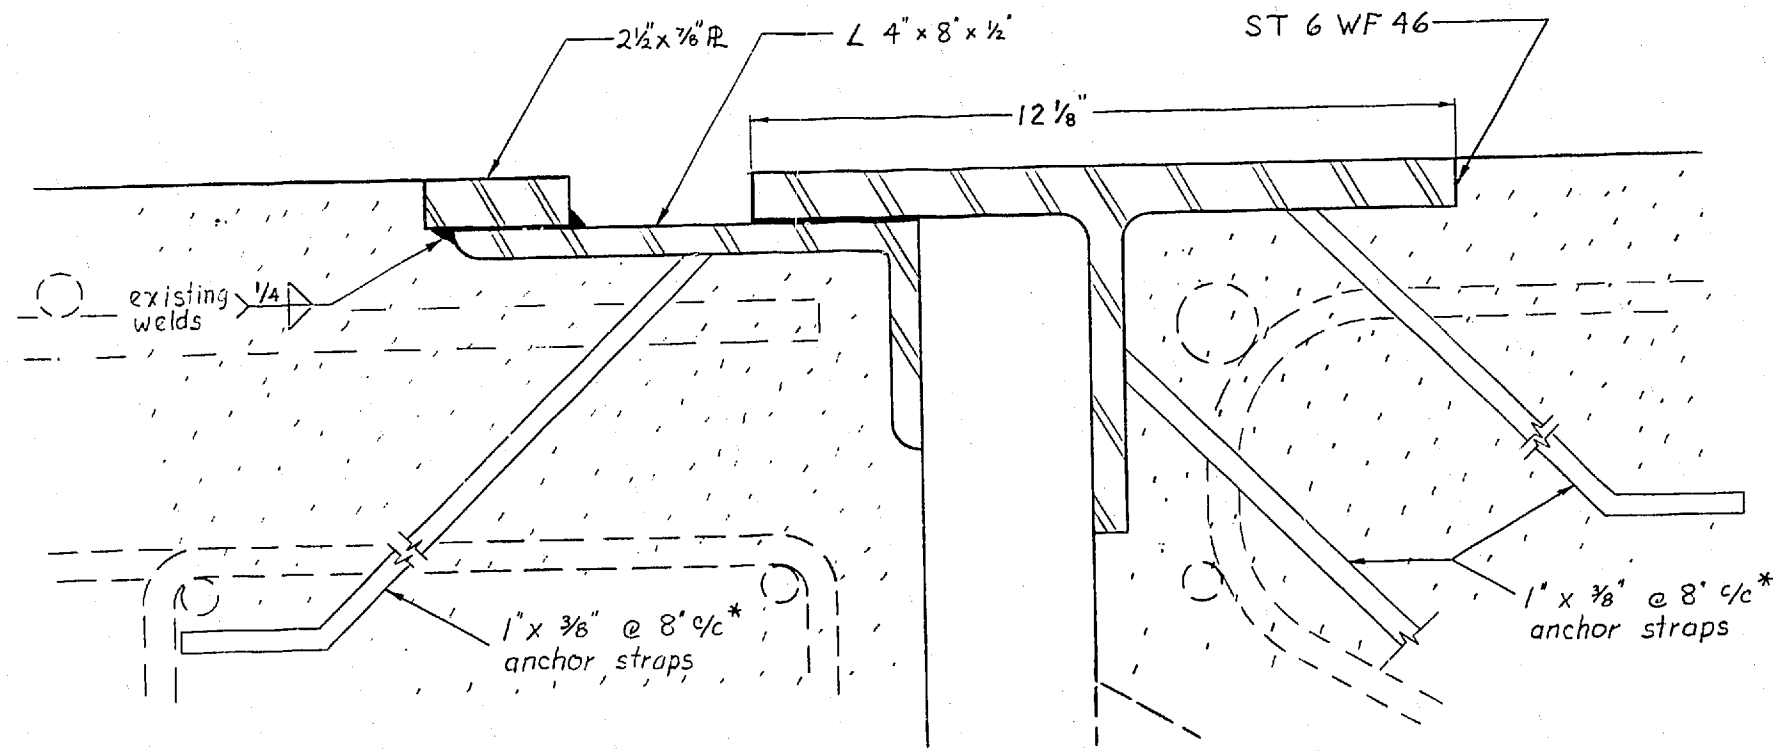

EXISTING EXPANSION JOINT DETAIL-TYPICAL

* spacing is approximate


Bridge No.	Joint Location	Length (note 2)	Skew	Exp. System	"Δ" (in)			Dimensions	
					@ 0°F	@ 64°F	@ 100°F	b"	t"
405/70W	W 853+06	33'-0"	0°	1, 2, 3 or 4	4 1/4	2 1/4	1	4 3/4	7/8"
"	W 856+59	33'-0"	0°	"	3 3/4	2 1/4	1 1/2	5	"
"	W 860+06	46'-0"	0°	"	4 1/4	2 7/16	1 3/8	5 1/4	"
"	W 863+41	33'-0"	0°	"	3 1/2	2 1/2	1 7/8	5	"
405/70S-E	S-E 69+19	25'-0"	0°	"	3 1/2	2 3/8	2	5	"
"	S-E 72+37	25'-0"	0°	"	3	2 3/8	2	5	"
405/70E	E 850+07	33'-0"	0°	"	3	2 3/8	1 3/4	5	"
"	E 853+26	33'-0"	0°	"	3 1/2	2	1 1/8	5	"
"	E 856+81	33'-0"	0°	"	4 1/4	2 3/8	1 3/8	5 1/2	"
"	E 860+30	59'-0"	0°	"	3 3/8	2 3/8	1 1/16	5 1/4	"
"	E 863+58	45'-0"	0°	"	4 1/8	2 1/8	1 1/2	5 1/4	"
405/70N-E	N-E 50+88	40'-0"	0°	"	2 1/4	2 1/16	1 7/8	5	"
"	N-E 53+11	23'-0"	0°	"	2 3/8	1 7/8	1 1/4	5	"
"	N-E 55+98	23'-0"	0°	"	4	2 3/8	1 13/16	5	"
405/70N-W	N-W 53+11	24'-0"	0°	"	3 3/8	2 1/16	1 7/16	5	"
"	N-W 56+38	24'-0"	0°	"	4	2 7/16	1 1/2	5	"
"	N-W 59+37	24'-0"	0°	"	3 3/4	2 3/8	1 1/2	5	"
"	N-W 62+31	24'-0"	0°	"	3 1/4	2	1 1/4	5	"
522/30W-S	W-S 45+83	33'-0"	0°	"	3 3/8	2 1/16	1 5/16	5	"
"	W-S 50+22	33'-0"	0°	"	2 7/8	2 1/16	1 9/16	5	"
"	W-S 53+66	33'-0"	0°	"	3 1/2	2	1 1/8	4 1/2	"
"	W-S 58+33	33'-0"	0°	"	2 7/8	2	1 7/16	5	"
"	W-S 61+88	33'-0"	0°	"	3 1/2	2 1/16	1 1/4	5	"
"	W-S 66+16	33'-0"	0°	"	3 3/16	2 3/16	1 7/8	5	"
522/30E-S	E-S 77+96	45'-0"	35° ±	4 only	3 3/8	2 1/4	1 3/8	5	7/8"

Expansion dam systems and dimensions have been selected based on joint movement histories.

List of Expansion Dam Systems	Range
1 Acme Trojan TR-400	3/4 - 4 3/4
2 Watson-Bowman WABO Elastoflex	1/2 - 4 1/2
3 Fel-Pro Felspan T-40 ACS	1/2 - 4 1/2
4 On-Flex On-flex E-Last-On w/model #40 membrane	1" - 5"

Dimensions A, B, & C will vary with each manufacturer.

5/8" φ x 2 1/4" stud welded bolts, stagger spacing to give uniform distribution not to exceed 9" parallel to & of joint and to permit placing of welded wire fabric.

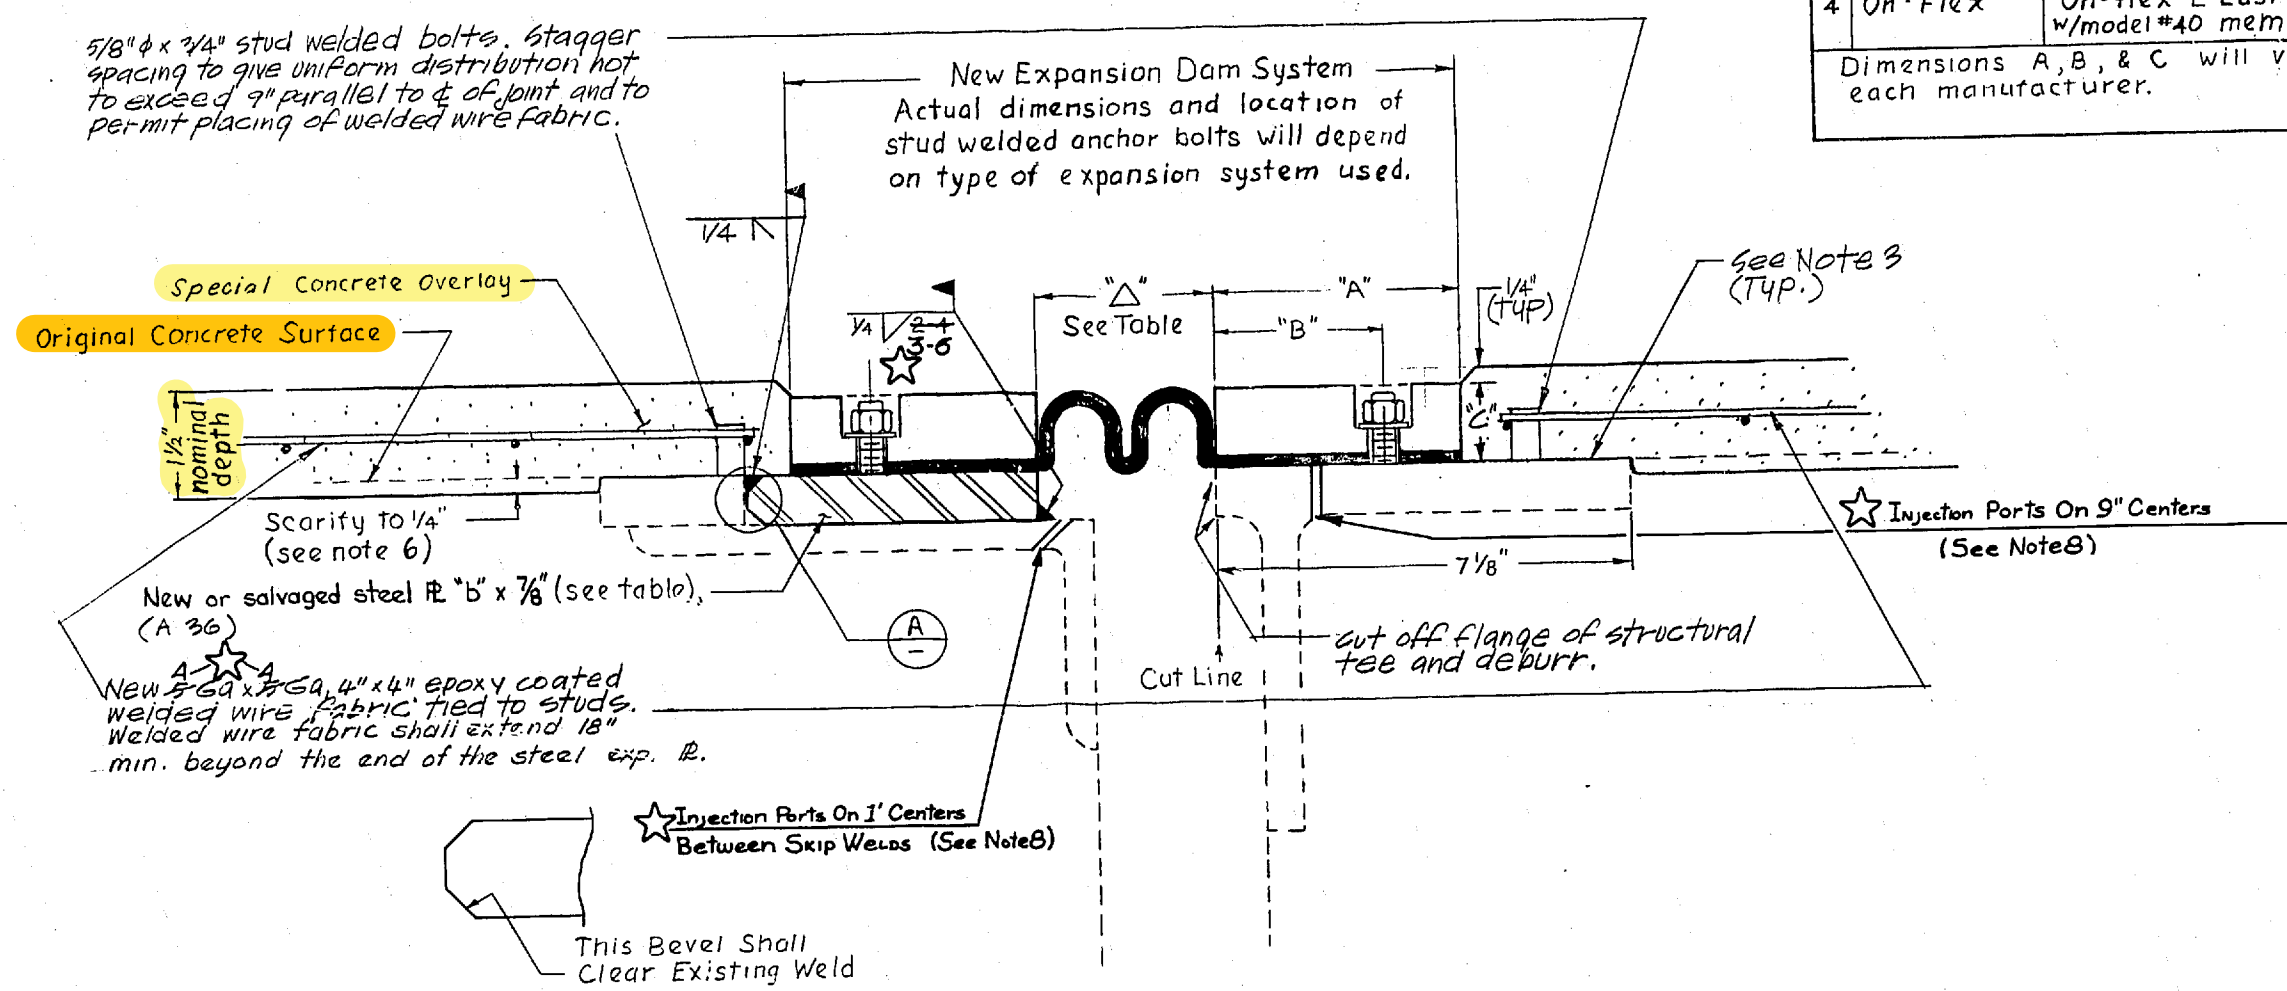

MODIFIED EXPANSION DAM DETAIL TYPICAL

- NOTES
- EXPANSION DAM SYSTEMS SHALL BE IN PLACE BEFORE PLACEMENT OF THE CONCRETE OVERLAY AND SHALL BE INSTALLED PER MANUFACTURER'S SPECIFICATIONS.
 - MODIFY EACH EXPANSION JOINT FULL LENGTH CURB TO CURB. CONTRACTOR SHALL VERIFY ACTUAL LENGTH REQUIRED AT EACH JOINT.
 - IMMEDIATELY PRIOR TO PLACEMENT OF THE OVERLAY, APPLY AN EPOXY RESIN BONDING AGENT TO ALL STEEL SURFACES TO BE COVERED BY THE OVERLAY.
 - THE DEPTH OF THE OVERLAY AT THE EXPANSION DAM WILL VARY WITH THE EXPANSION SYSTEM CHOSEN. THE OVERLAY SHALL BE FEATHERED AWAY FROM THE JOINT AT A RATE OF 0.10 INCHES IN 10 FEET TO THE NOMINAL OVERLAY DEPTH.
 - USE 5/8" DIA. STUD WELDED ANCHOR BOLTS WHENEVER POSSIBLE (1/2" DIA. MINIMUM). SIZE, INSTALLATION, AND LOCATION OF BOLTS SHALL CONFORM TO THE EXPANSION DAM MANUFACTURER'S SPECIFICATIONS.
 - CARE SHALL BE EXERCISED DURING SCARIFICATION OF THE CONCRETE BRIDGE DECK TO PREVENT DAMAGE TO THE EXISTING EXPANSION PLATES AND ANCHORAGES.
 - BOLT HOLE CAVITIES IN EXPANSION JOINT PANELS SHALL BE CLEANED AND FILLED WITH MANUFACTURER'S RECOMMENDED SEALANT AFTER JOINT SYSTEM HAS BEEN INSTALLED AND CHECKED FOR LEAKAGE.
- ☆ B. Change Order No. 3, Item No. 46, & Change Order No. 7 Item No. 48

☆ As-Built Changes 1-24-89

Bridge Design Engineer: <i>[Signature]</i>	9/84	Added Note # 7	1	JFD	OK
Supervisor: <i>[Signature]</i>					
Reviewed By: <i>[Signature]</i>					
Design-1 By: <i>[Signature]</i>					
Checked By: <i>[Signature]</i>					
Detailed By: <i>[Signature]</i>					
Architect					
Preliminary Plan By	DATE	REVISION	BY	APP'D	

BRIDGES AND STRUCTURES

REGION NO. 10 STATE WASH. FED. AID PROJ. NO. JR-405-3 (521) FHWA DEMO. NO. 39

JOB NUMBER 84W054 CONTRACT NO. 2814

May 14, 1984 APPROVED *[Signature]*

Washington State Department of Transportation


SR 405 WOODVILLE 1/3 BRIDGE DECKS - RESURFACING

EXPANSION DAM MODIFICATION DETAILS

SR 405/112

BRIDGE SHEET NO. 1

SHEET 10 OF 22 SHEETS

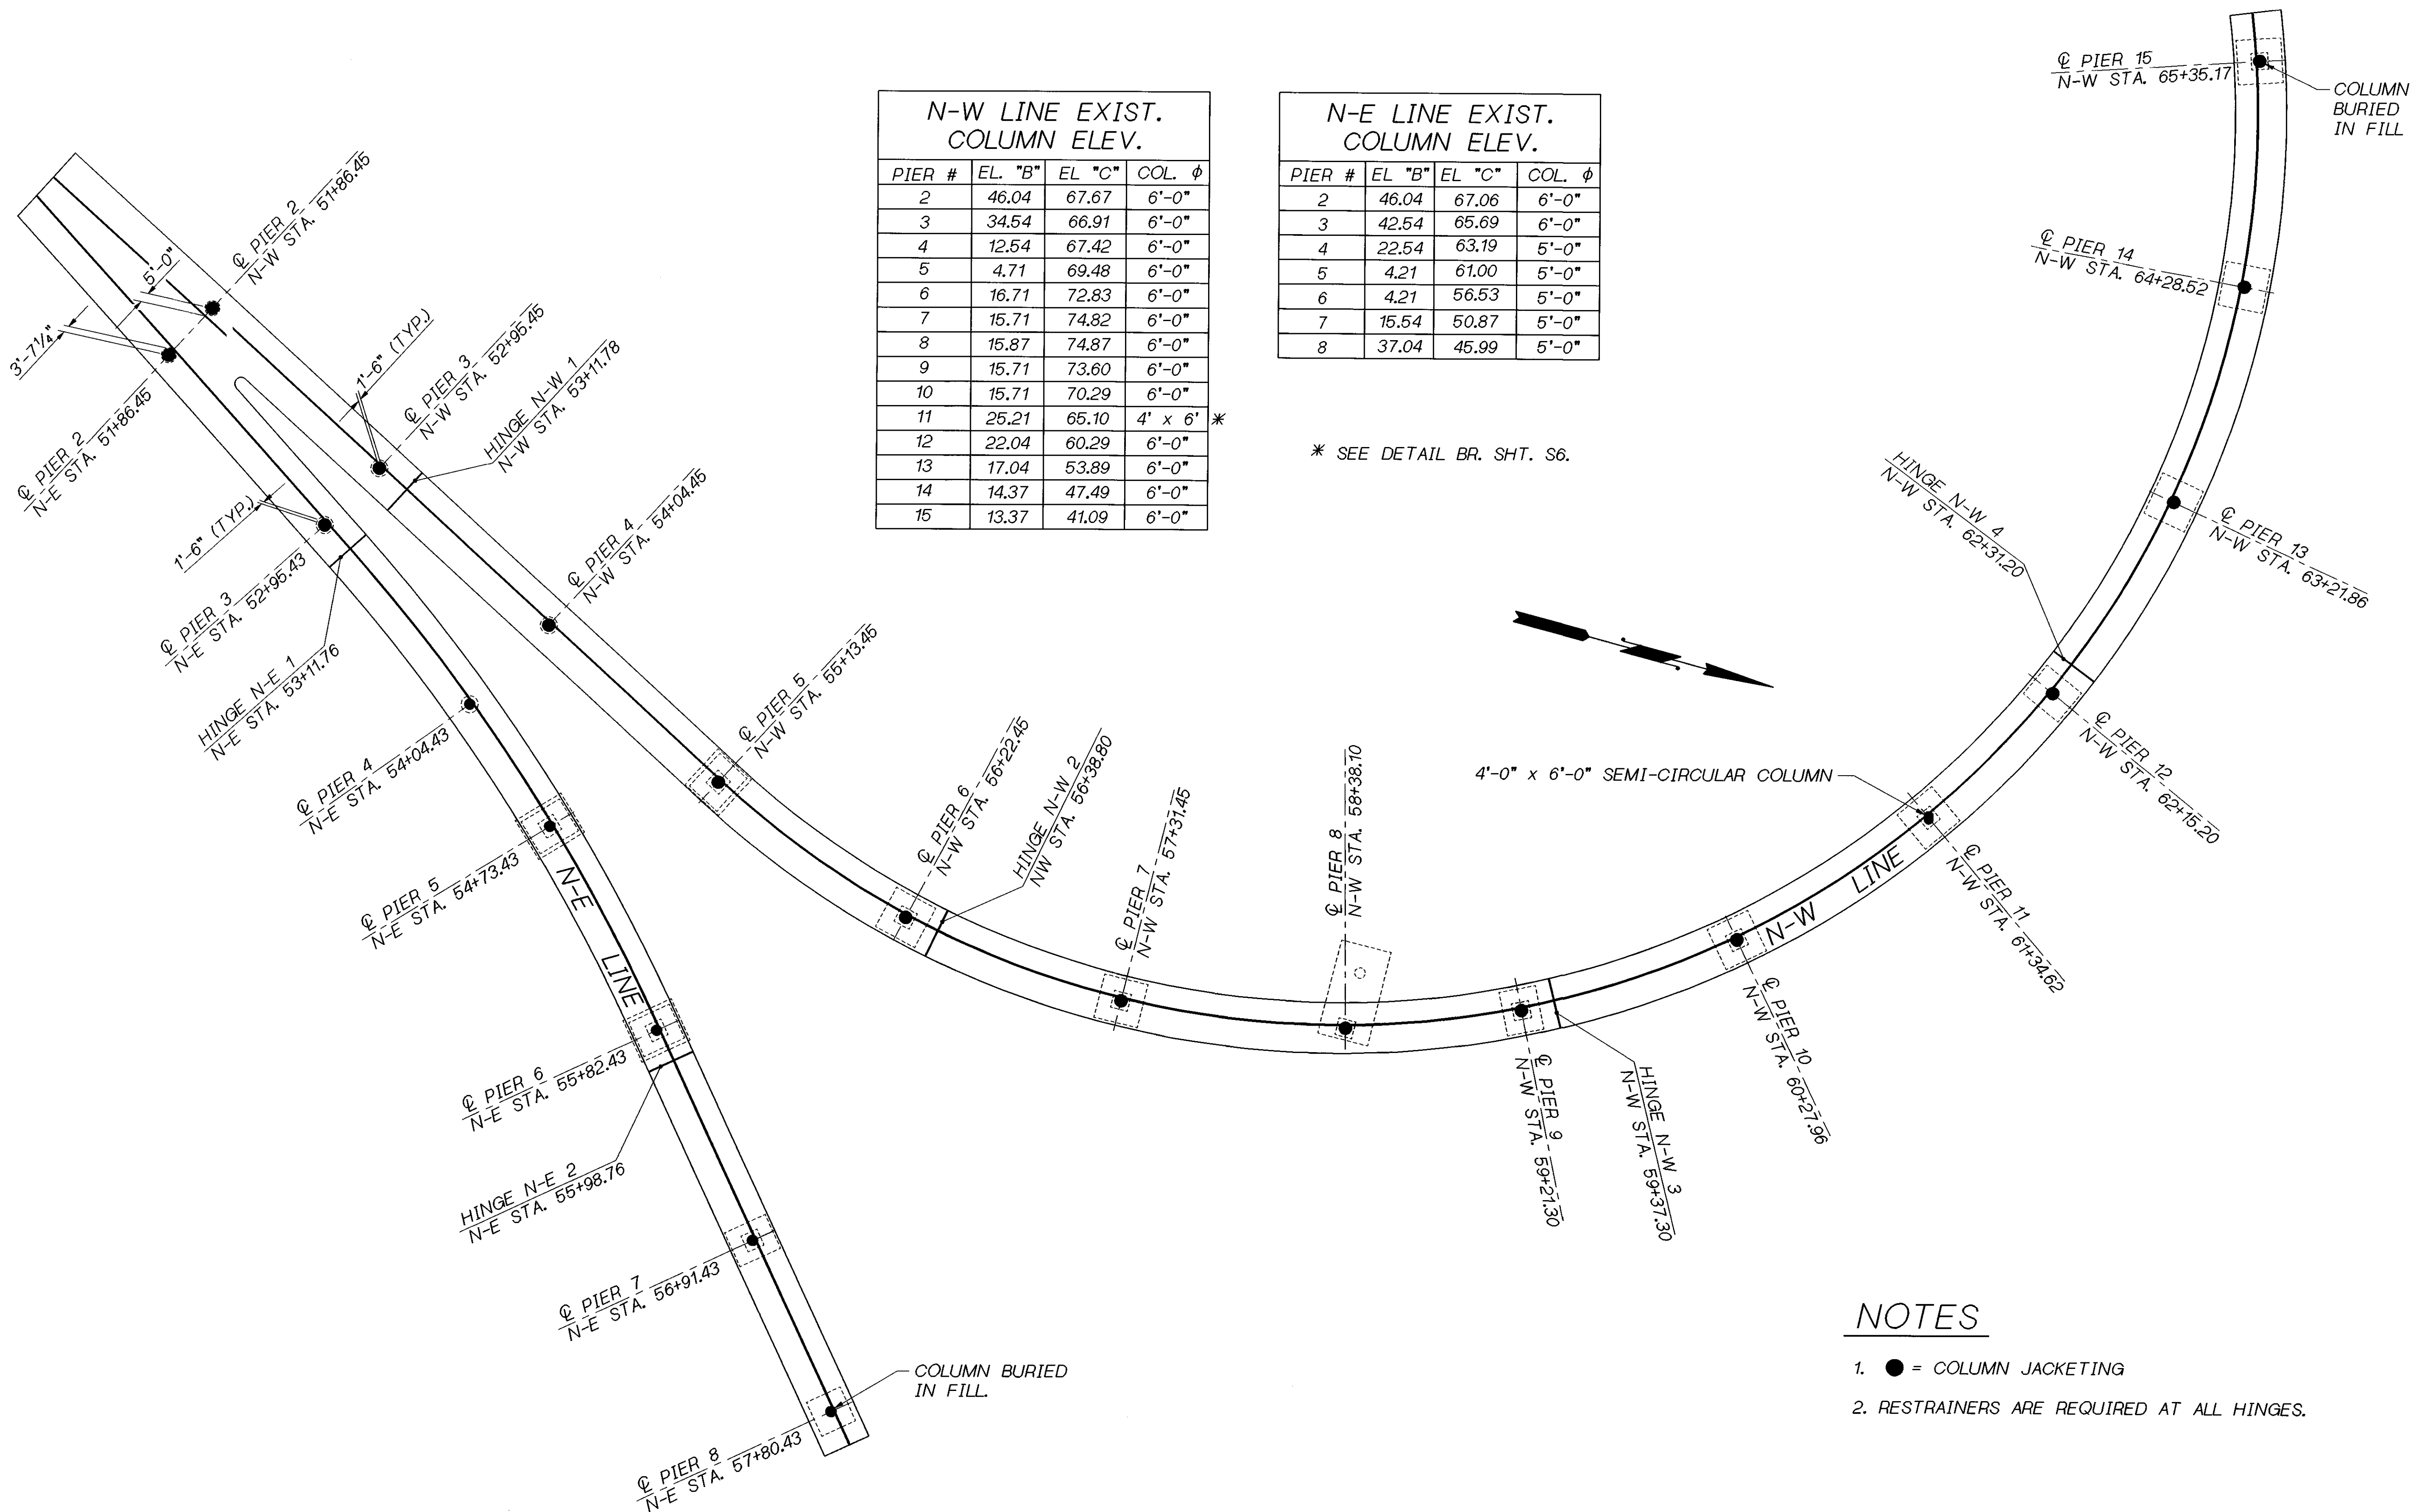

N-W LINE EXIST. COLUMN ELEV.

PIER #	EL. "B"	EL. "C"	COL. ϕ
2	46.04	67.67	6'-0"
3	34.54	66.91	6'-0"
4	12.54	67.42	6'-0"
5	4.71	69.48	6'-0"
6	16.71	72.83	6'-0"
7	15.71	74.82	6'-0"
8	15.87	74.87	6'-0"
9	15.71	73.60	6'-0"
10	15.71	70.29	6'-0"
11	25.21	65.10	4' x 6' *
12	22.04	60.29	6'-0"
13	17.04	53.89	6'-0"
14	14.37	47.49	6'-0"
15	13.37	41.09	6'-0"

N-E LINE EXIST. COLUMN ELEV.

PIER #	EL. "B"	EL. "C"	COL. ϕ
2	46.04	67.06	6'-0"
3	42.54	65.69	6'-0"
4	22.54	63.19	5'-0"
5	4.21	61.00	5'-0"
6	4.21	56.53	5'-0"
7	15.54	50.87	5'-0"
8	37.04	45.99	5'-0"

* SEE DETAIL BR. SHT. S6.

NOTES

- = COLUMN JACKETING
- RESTRAINERS ARE REQUIRED AT ALL HINGES.

Bridge Design Engr. C. C. RUTH									
Supervisor J. A. VAN LUND									
Designed By T.M. MOORE 4/95									
Checked By J. MERTH 5/95									
Detailed By V.B. SCHICCHI 4/95									
Bridge Projects Engr.									
Prelim. Plan By									
Architect/Specialist	DATE	REVISION	BY	APP'D					

BRIDGE AND STRUCTURES OFFICE

JOHN A. VAN LUND
SUPERVISING BRIDGE ENGINEER
6/4/96
[EXPIRES 12/23/97]


CHARLES C. RUTH
REGISTERED PROFESSIONAL ENGINEER
6.5.96
BRIDGE DESIGN ENGINEER
[EXPIRES 5/3/98]

Washington State Department of Transportation



SR 405
WOODINVILLE INTERCHANGE
HOV WIDENING
SEISMIC RETROFIT

RETROFIT LAYOUTS AND
COLUMN JACKETING - NW

BRIDGE SHEET NO. S3
SHEET 413 OF 452 SHEETS

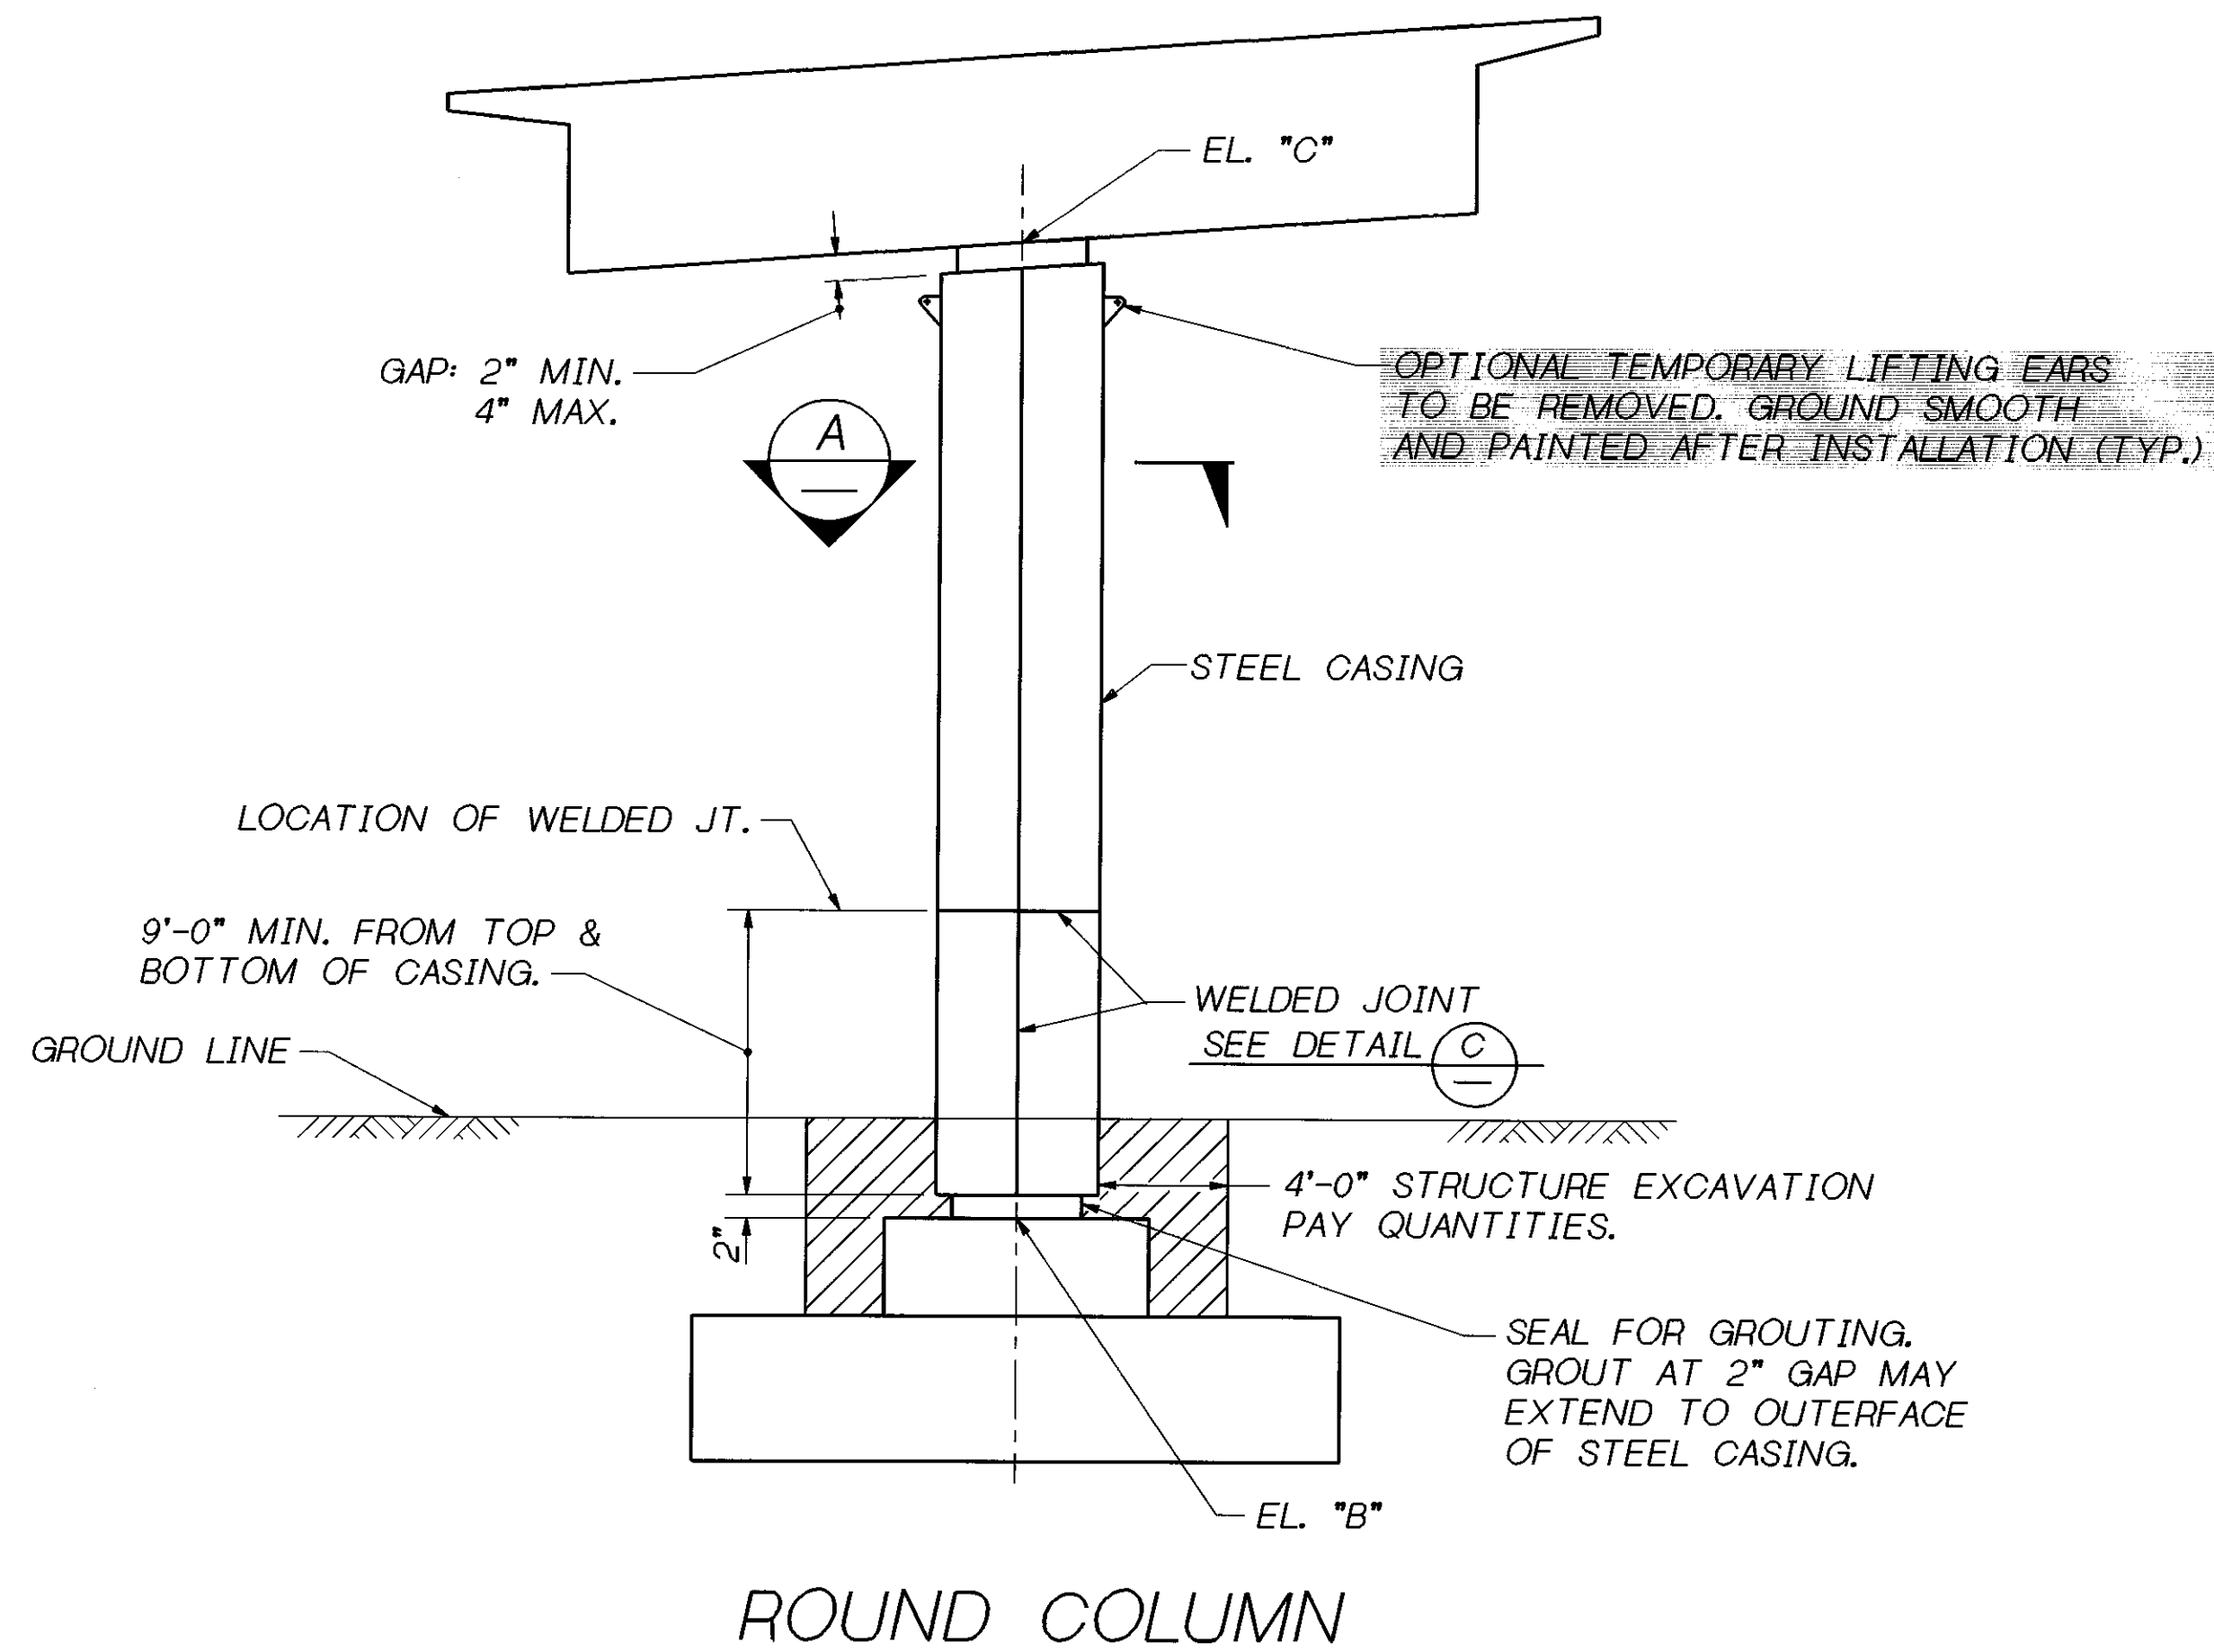

ROUND COLUMN

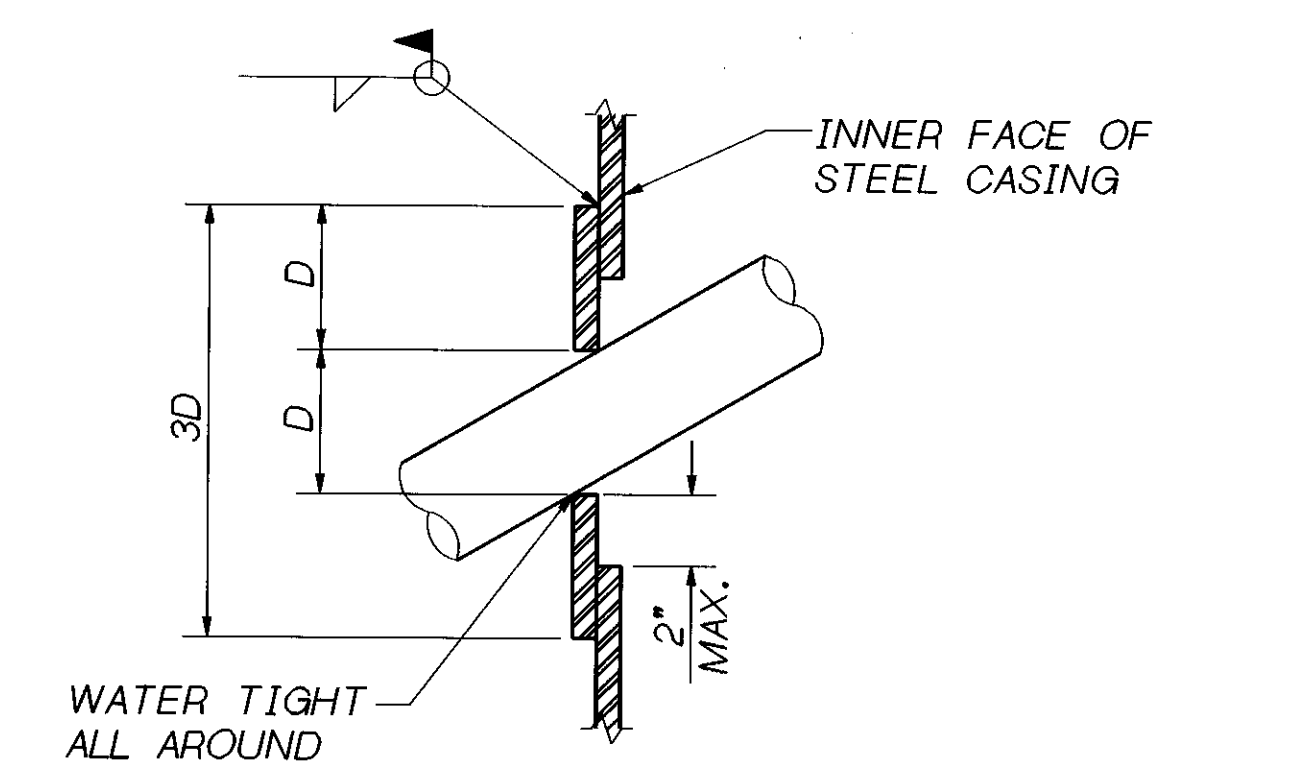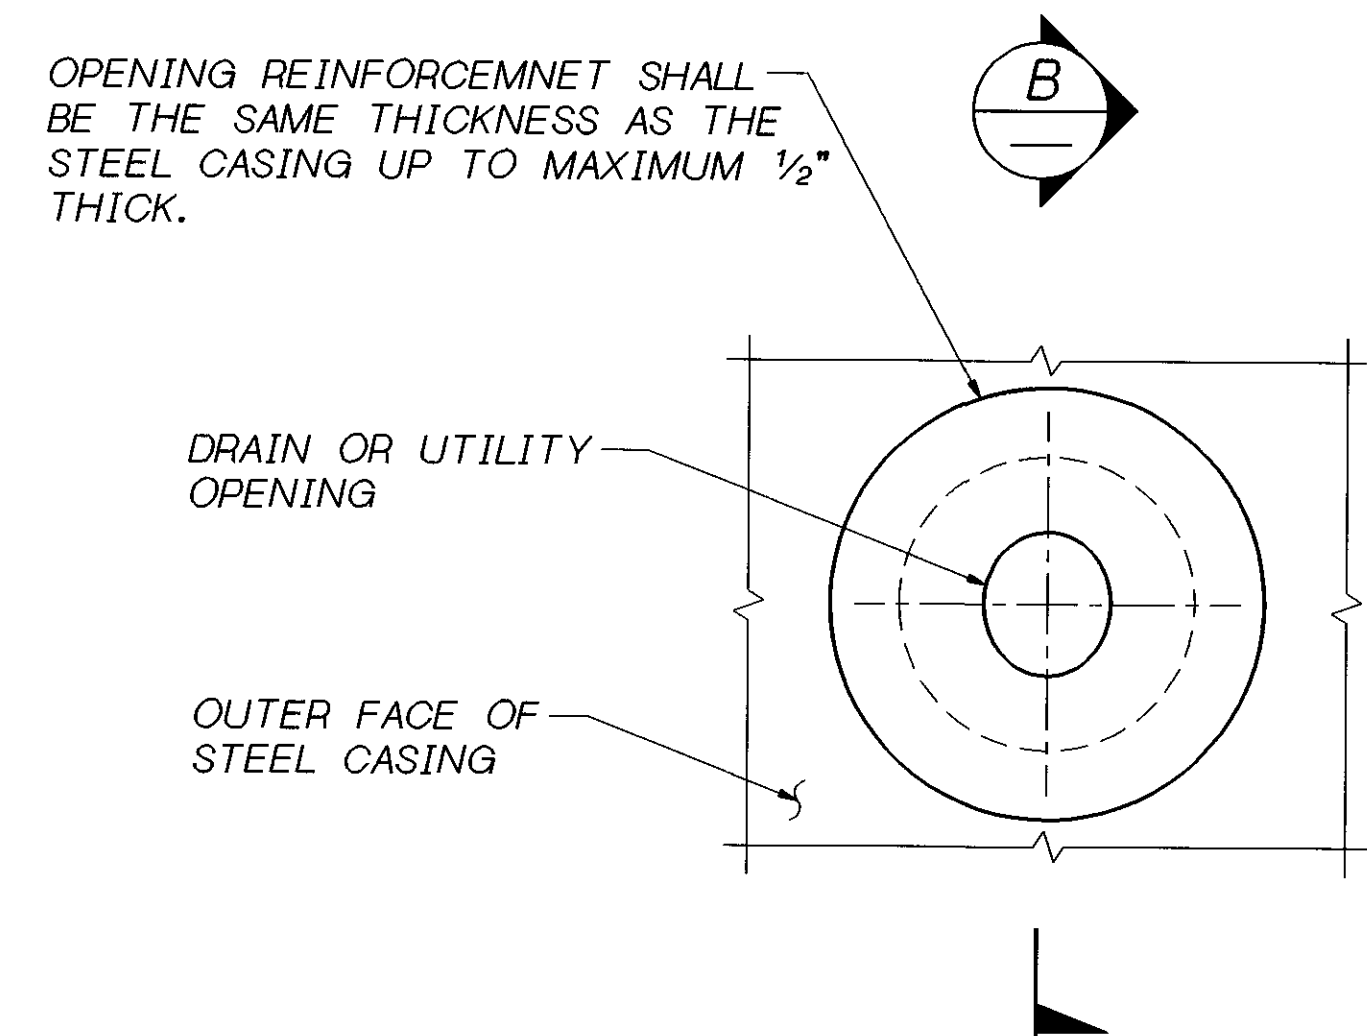


SECTION B
D = PIPE EXTENSION OUTSIDE DIAMETER

NOTE: OPENING REINFORCEMENT REQUIRED FOR DRAIN OR UTILITY OPENINGS LARGER THAN 4".
DRAINS WILL BE PLUGGED ON THE FOLLOWING BRIDGES (OPENING IN JACKET IS NOT REQUIRED):
SOUTHBOUND PIERS - EXIST. COLUMNS 4, 6, 7, 8 & 11
NORTHBOUND PIERS - EXIST. COLUMNS 2, 6 & 8

CASING OPENING


NOTES

1. APPROPRIATE INJECTION NOZZLES TO BE PROVIDED ON CASING, AND SHALL BE REMOVED, GROUND FLUSH AND PAINTED FOLLOWING COMPLETION OF GROUTING OPERATION.
2. ALL VOIDS BETWEEN STEEL CASING AND EXISTING COLUMN SURFACE SHALL BE FILLED WITH CEMENT GROUT.
3. THE LOCATION AND NUMBER OF VERTICAL AND HORIZONTAL WELDS SHALL BE DETERMINED BY THE CONTRACTOR, AND SUBJECT TO THE APPROVAL OF THE ENGINEER. THE LOCATION OF CASING WELDS ARE FOR ILLUSTRATION. THERE SHALL BE NO SKIP WELDS.
4. CASING THICKNESS SHALL BE 1/4" FOR CIRCULAR COLUMNS 4'-0" DIA. OR LESS AND 3/8" FOR COLUMNS OVER 4'-0" DIA. THE THICKNESS OF CASING FOR SEMI-CIRCULAR SHAPED COLUMNS IS 1/2".
5. CASINGS SHALL BE FABRICATED FROM AASHTO M 183 STRUCTURAL STEEL AND PAINTED IN ACCORDANCE TO THE SPECIAL PROVISIONS.
6. ELEVATIONS SHOWN ON LAYOUT SHEETS ARE BASED ON AS-BUILT DRAWINGS. THE CONTRACTOR SHALL FIELD MEASURE ELEVATIONS PRIOR TO FABRICATION OF CASING.
7. EXISTING COLUMNS THAT HAVE DRAIN PIPE OR CONDUIT MOUNTED ON SURFACE THAT IS TO REMAIN SHALL BE CAREFULLY REMOVED, JACKET INSTALLED AND REPLACED IN KIND. REATTACHMENT DETAILS SHALL BE SUBMITTED TO THE ENGINEER FOR APPROVAL.

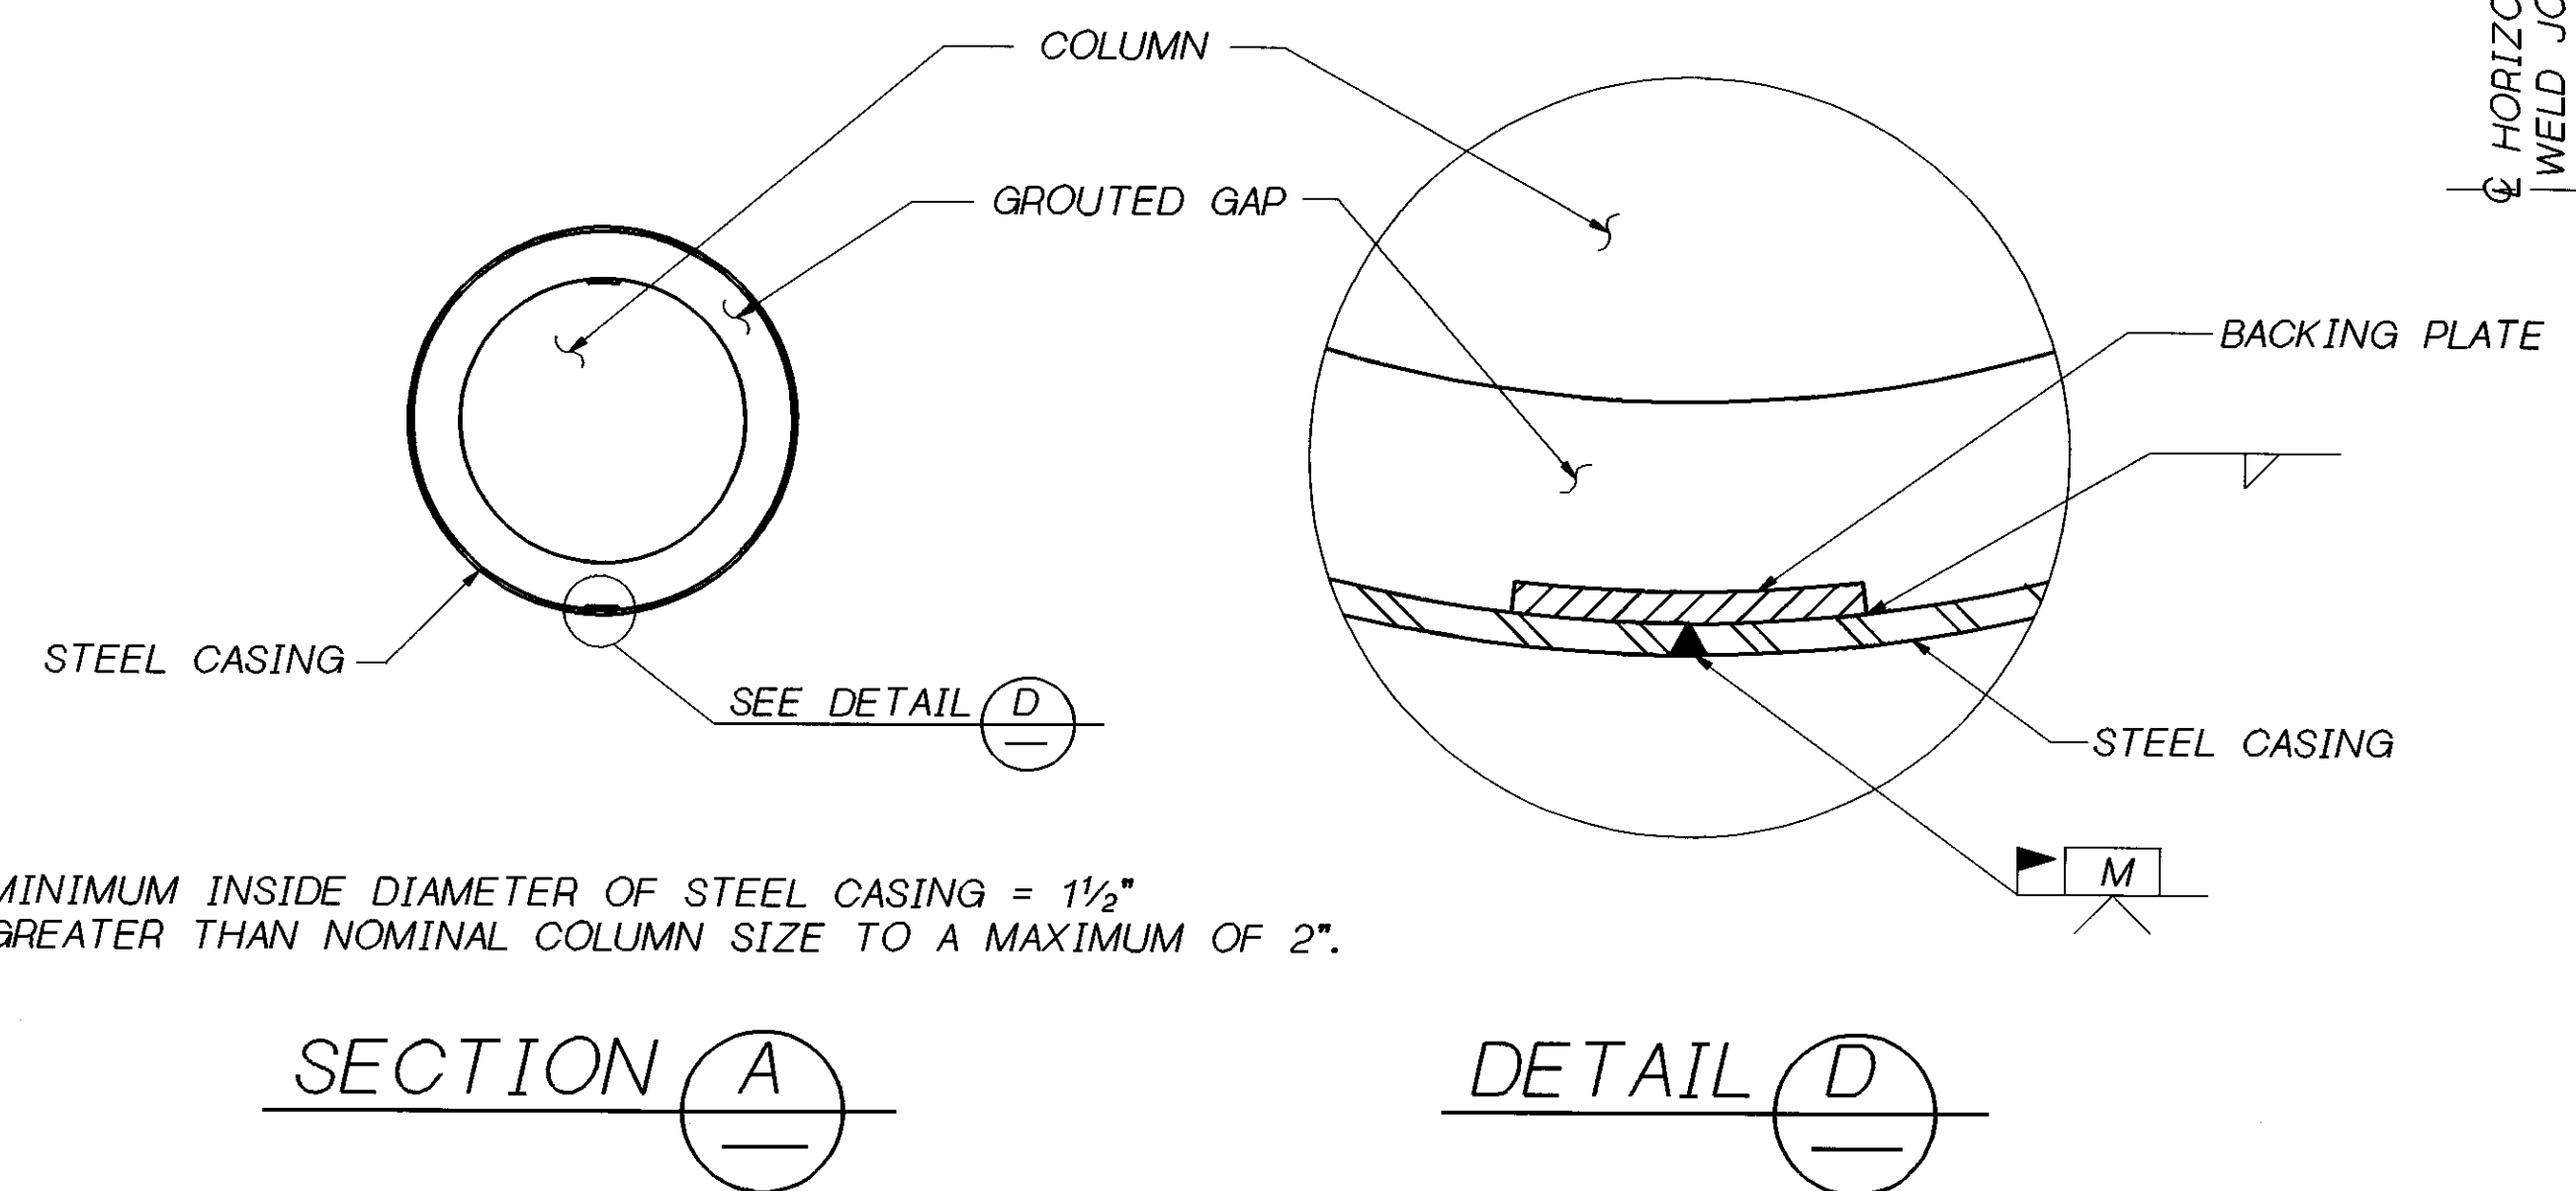

SECTION A

DETAIL D

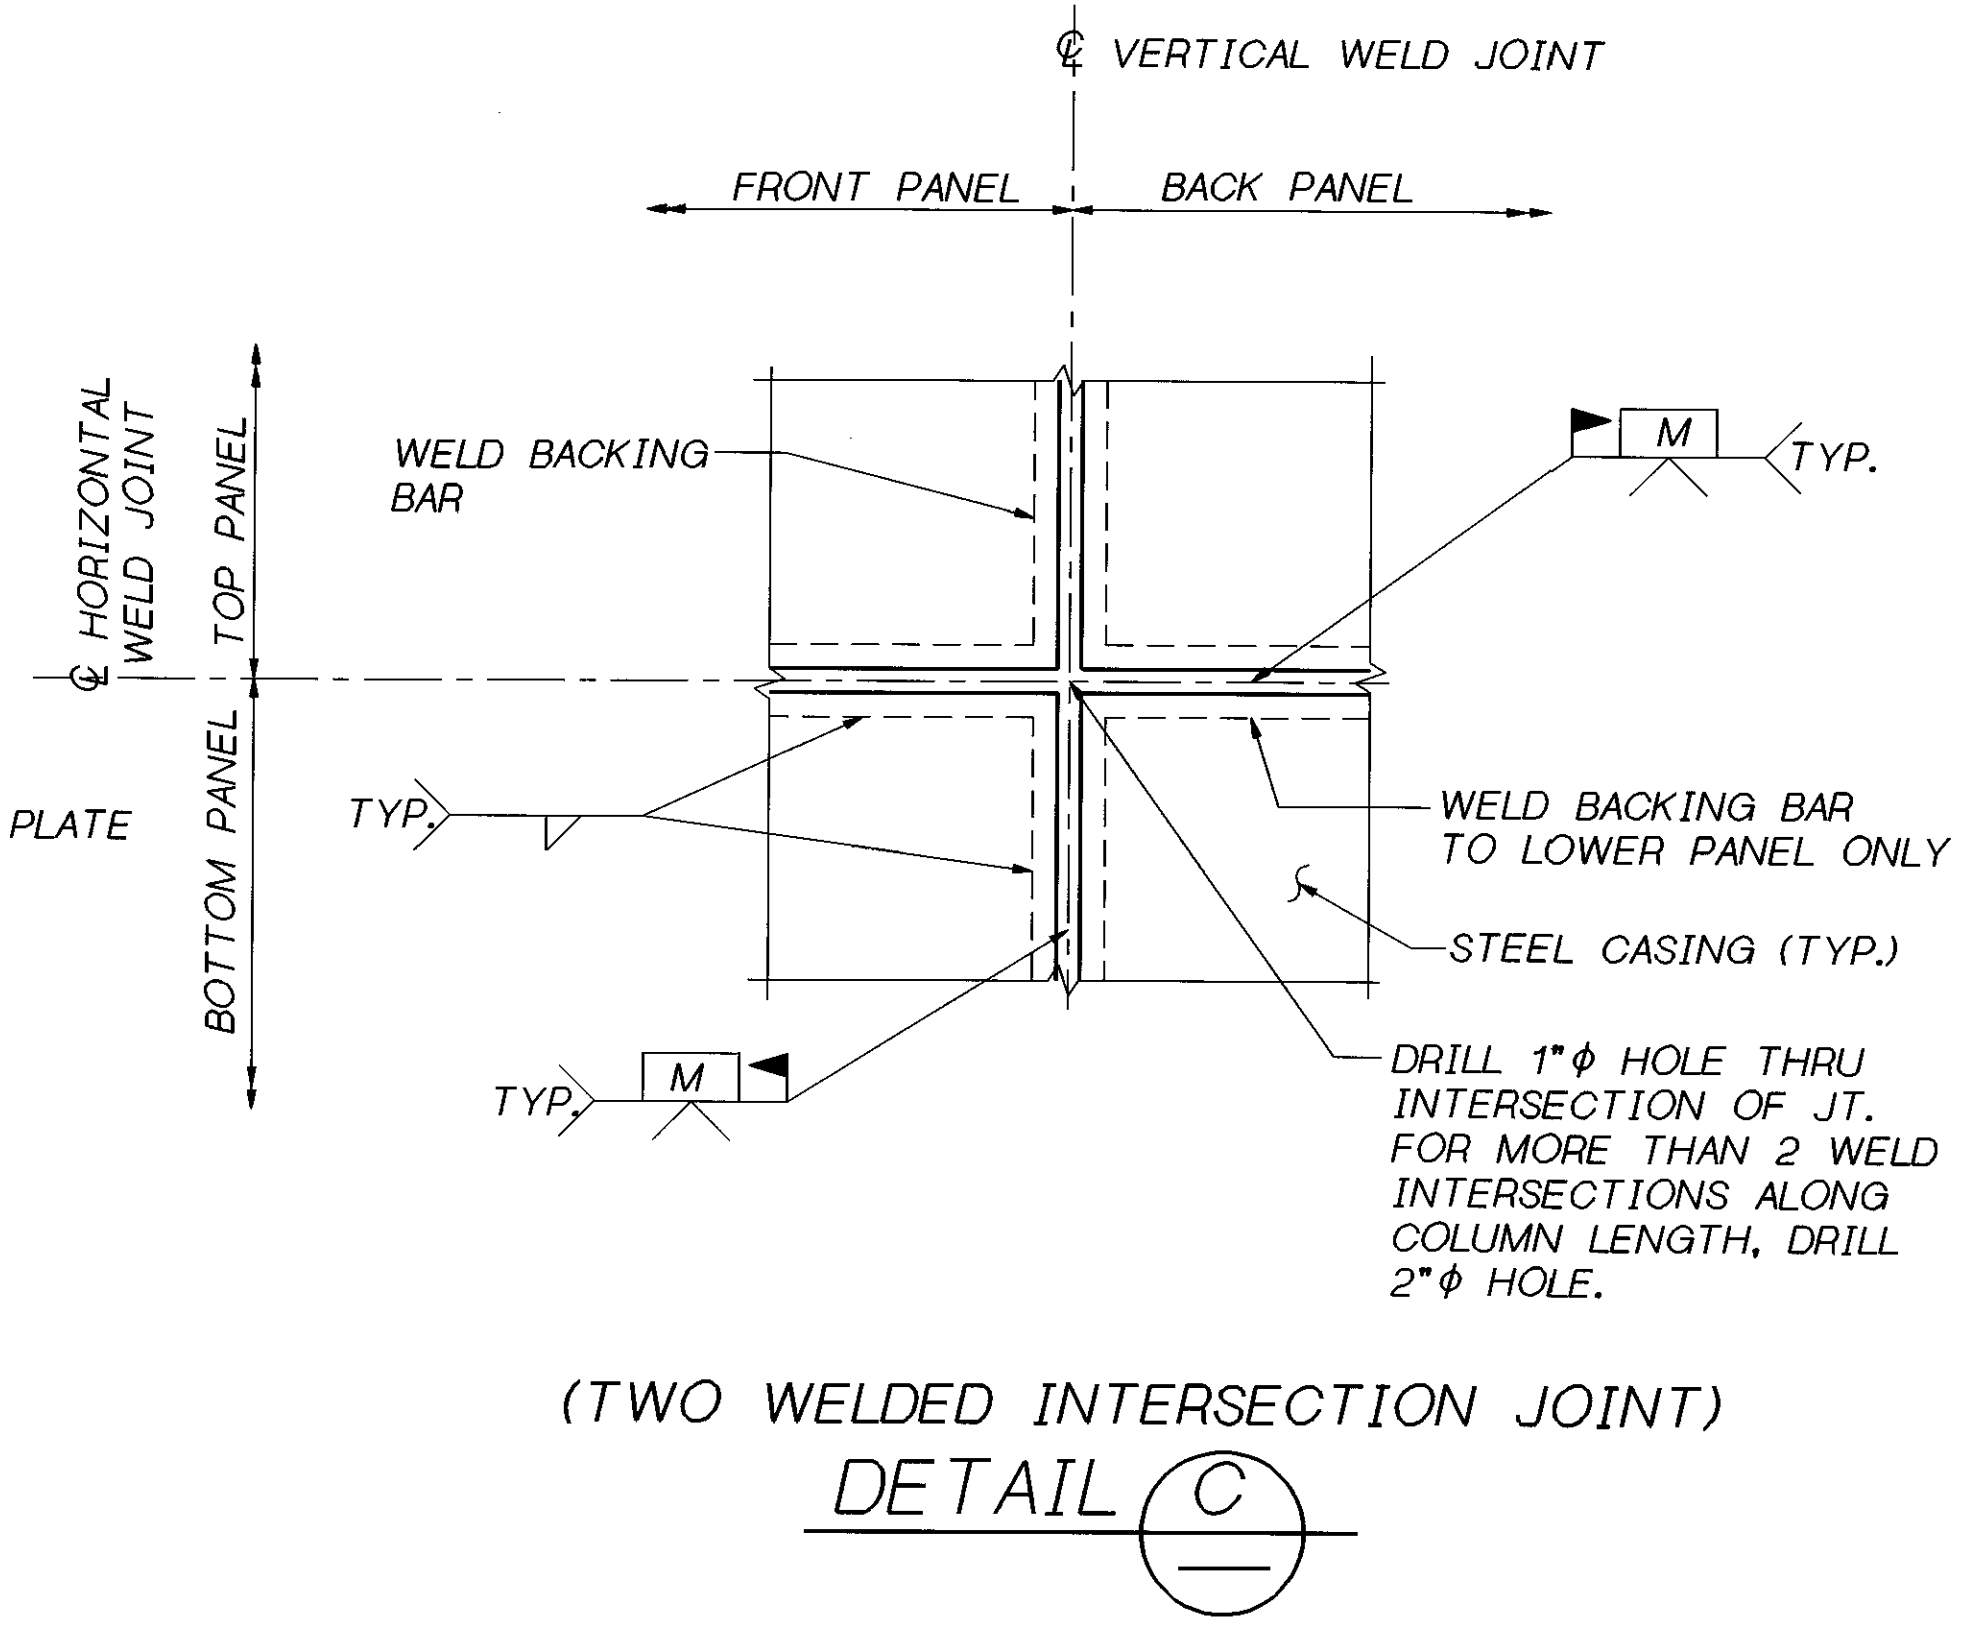

(TWO WELDED INTERSECTION JOINT)
DETAIL C

SR 405 JOB NO. 7056 SHEET S5

Bridge Design Engr. C. C. RUTH				REGION NO.	STATE	FED. AID PROJ. NO.	SHEET NO.	TOTAL SHEETS
Supervisor J. A. VAN LUND				10	WASH.			
Designed By T.M. MOORE 1/96								
Checked By J. MERTH								
Detailed By J. PLESHA 1/96								
Bridge Projects Engr.								
Prelim. Plan By	7-31-96	REVISED NOTE	IMOL					
Architect/Specialist	DATE	REVISION	BY APP'D	4944				

BRIDGE AND STRUCTURES OFFICE

JOHN A. VAN LUND
REGISTERED PROFESSIONAL ENGINEER
EXPIRES 12/23/97

CHARLES C. RUTH
REGISTERED PROFESSIONAL ENGINEER
EXPIRES 5/3/98

7-25-96
SUPERVISING BRIDGE DESIGN ENGINEER

7-25-96
BRIDGE DESIGN ENGINEER


Washington State Department of Transportation

SR 405
WOODINVILLE INTERCHANGE
HOV WIDENING
SEISMIC RETROFIT

COLUMN JACKETING DETAILS


BRIDGE SHEET NO. S5
SHEET 415 OF 452 SHEETS

SR 405 JOB NO. 1056 SHEET S6

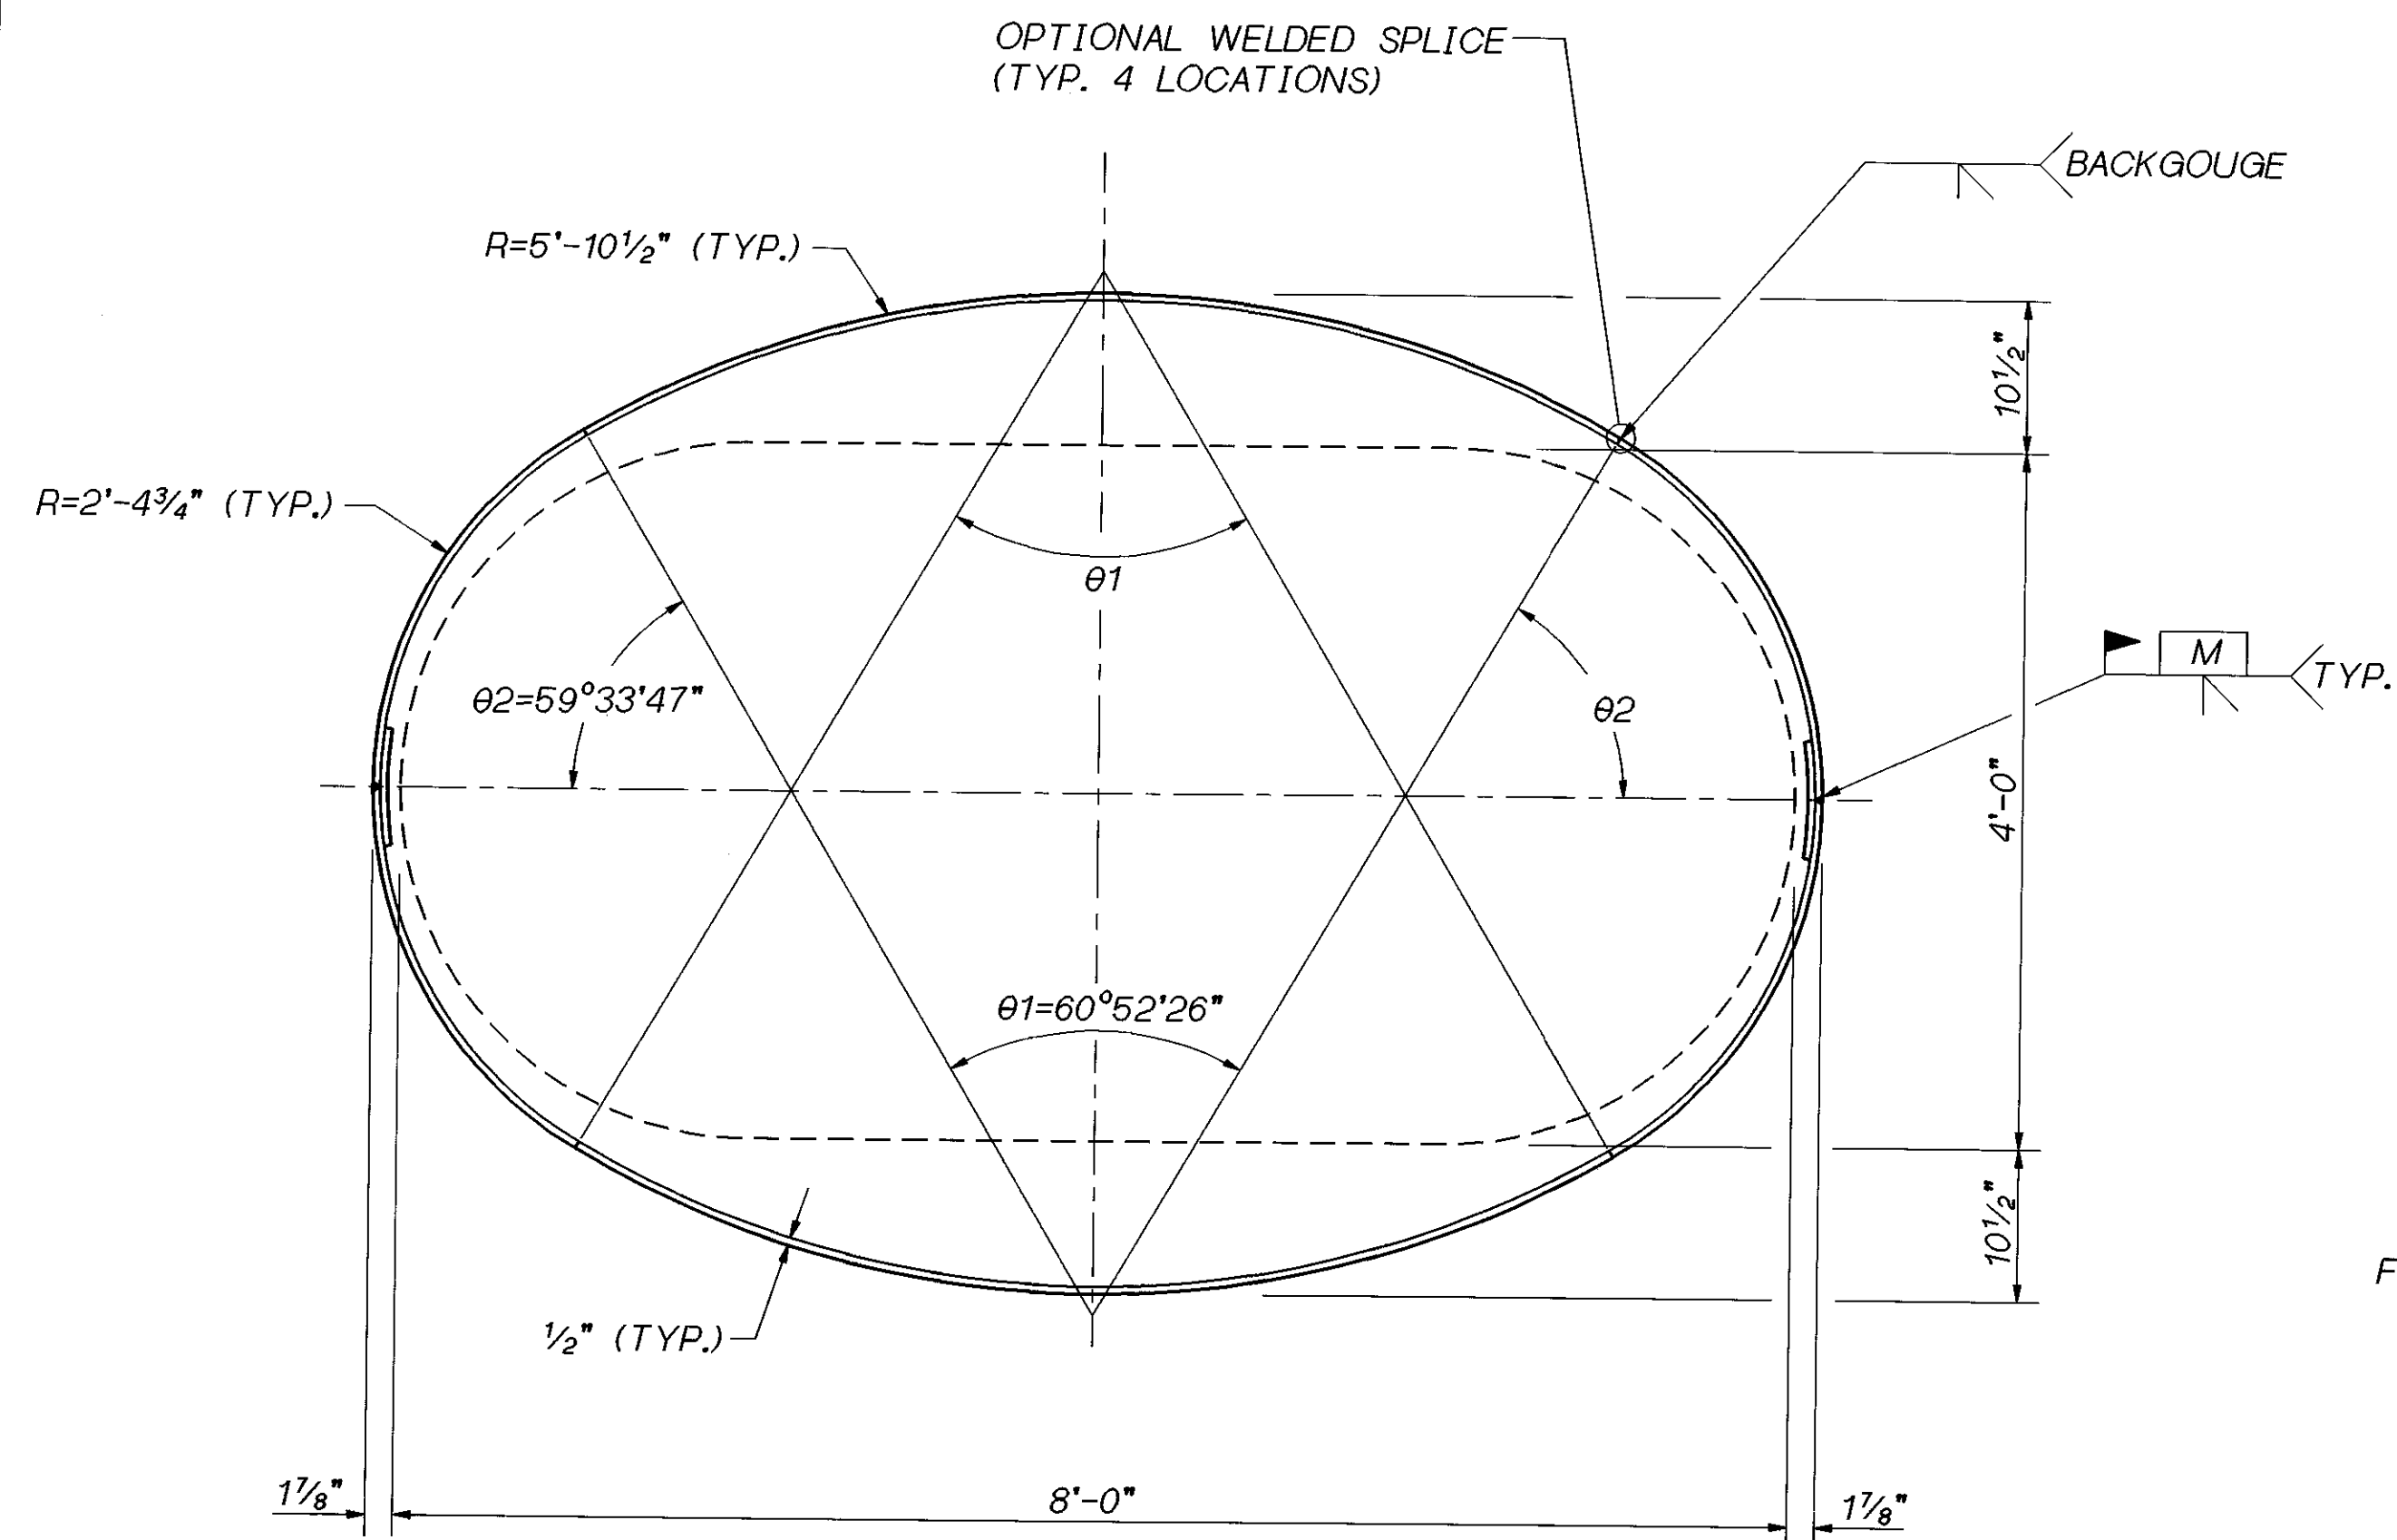


PIER 12 W-S COLUMN JACKET

FOR NOTES SEE BRIDGE SHEET S5.

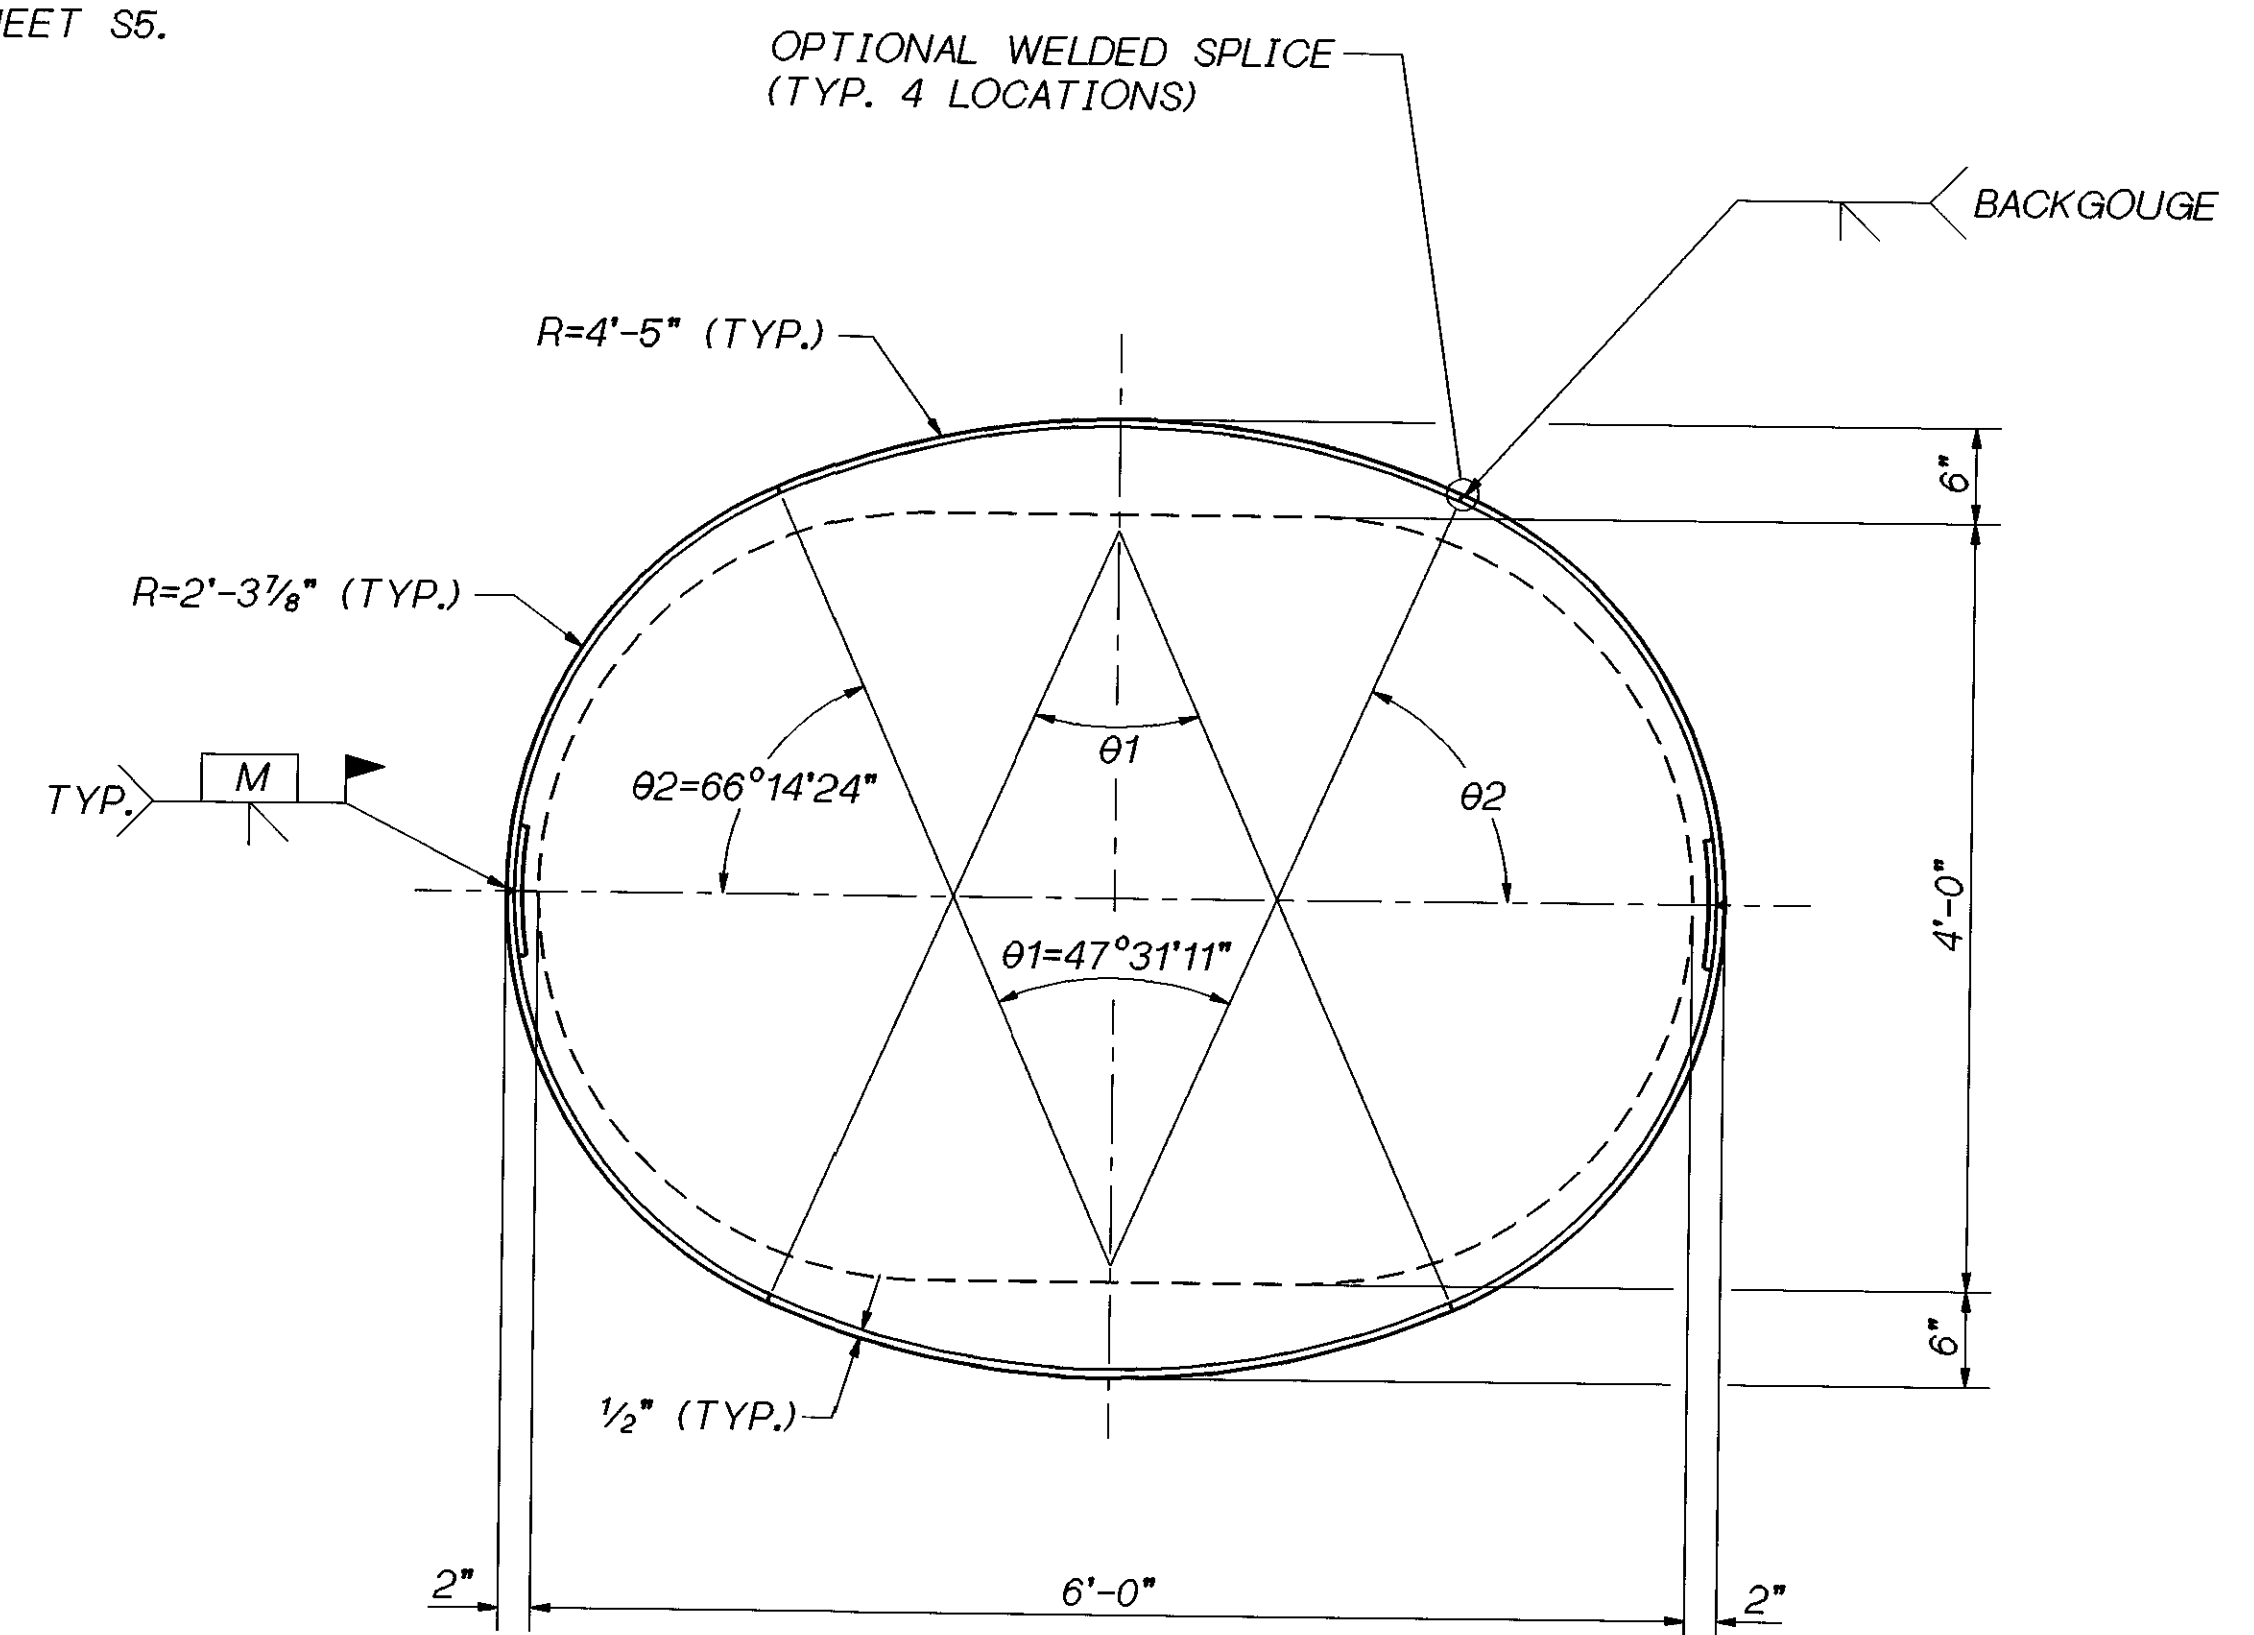


PIER 11 NW COLUMN JACKET


Bridge Design Engr. C. C. RUTH				REGION NO.	STATE	FED. AID PROJ. NO.	SHEET NO.	TOTAL SHEETS
Supervisor J. A. VAN LUND				10	WASH.			
Designed By T.M. MOORE 1/96								
Checked By J. MERTH 1/96								
Detailled By V.B. SCHIACCHI 1/96								
Bridge Projects Engr.				JOB NUMBER				
Prelim. Plan By				96W020				
Architect/Specialist	DATE	REVISION	BY	APP'D				

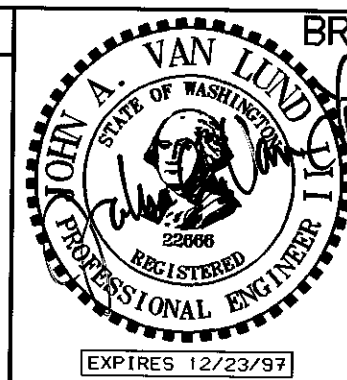

BRIDGE AND STRUCTURES OFFICE
 6/4/96
 SUPERVISING BRIDGE ENGINEER

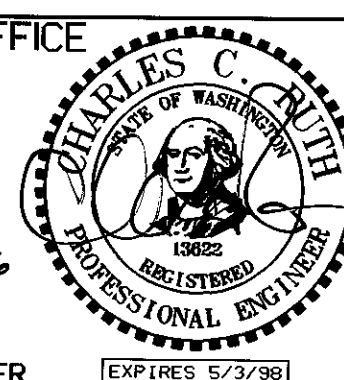

6-5-96
 BRIDGE DESIGN ENGINEER

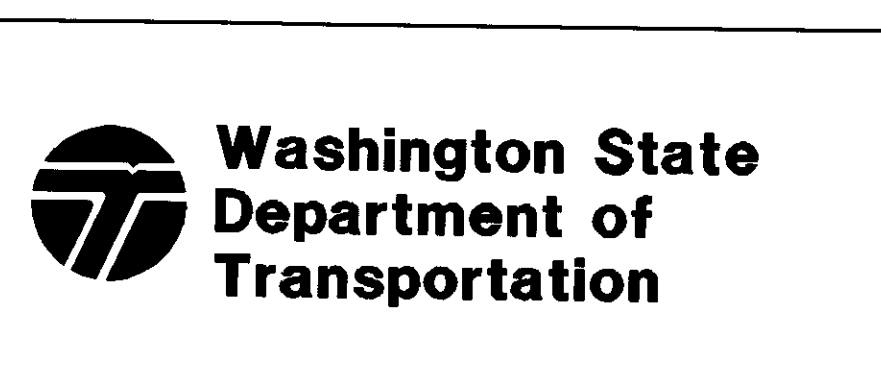


SR 405
 WOODINVILLE INTERCHANGE
 HOV WIDENING
 SEISMIC RETROFIT
 COLUMN JACKETING DETAILS

BRIDGE SHEET NO. S6
 SHEET 416 OF 452 SHEETS


31-MAY-96

405_70WROOT:\000000.FGB.RETRO.FGB\JAX_COLUMN.FGB:1


SR 405 JOB NO. 7056 SHEET S7

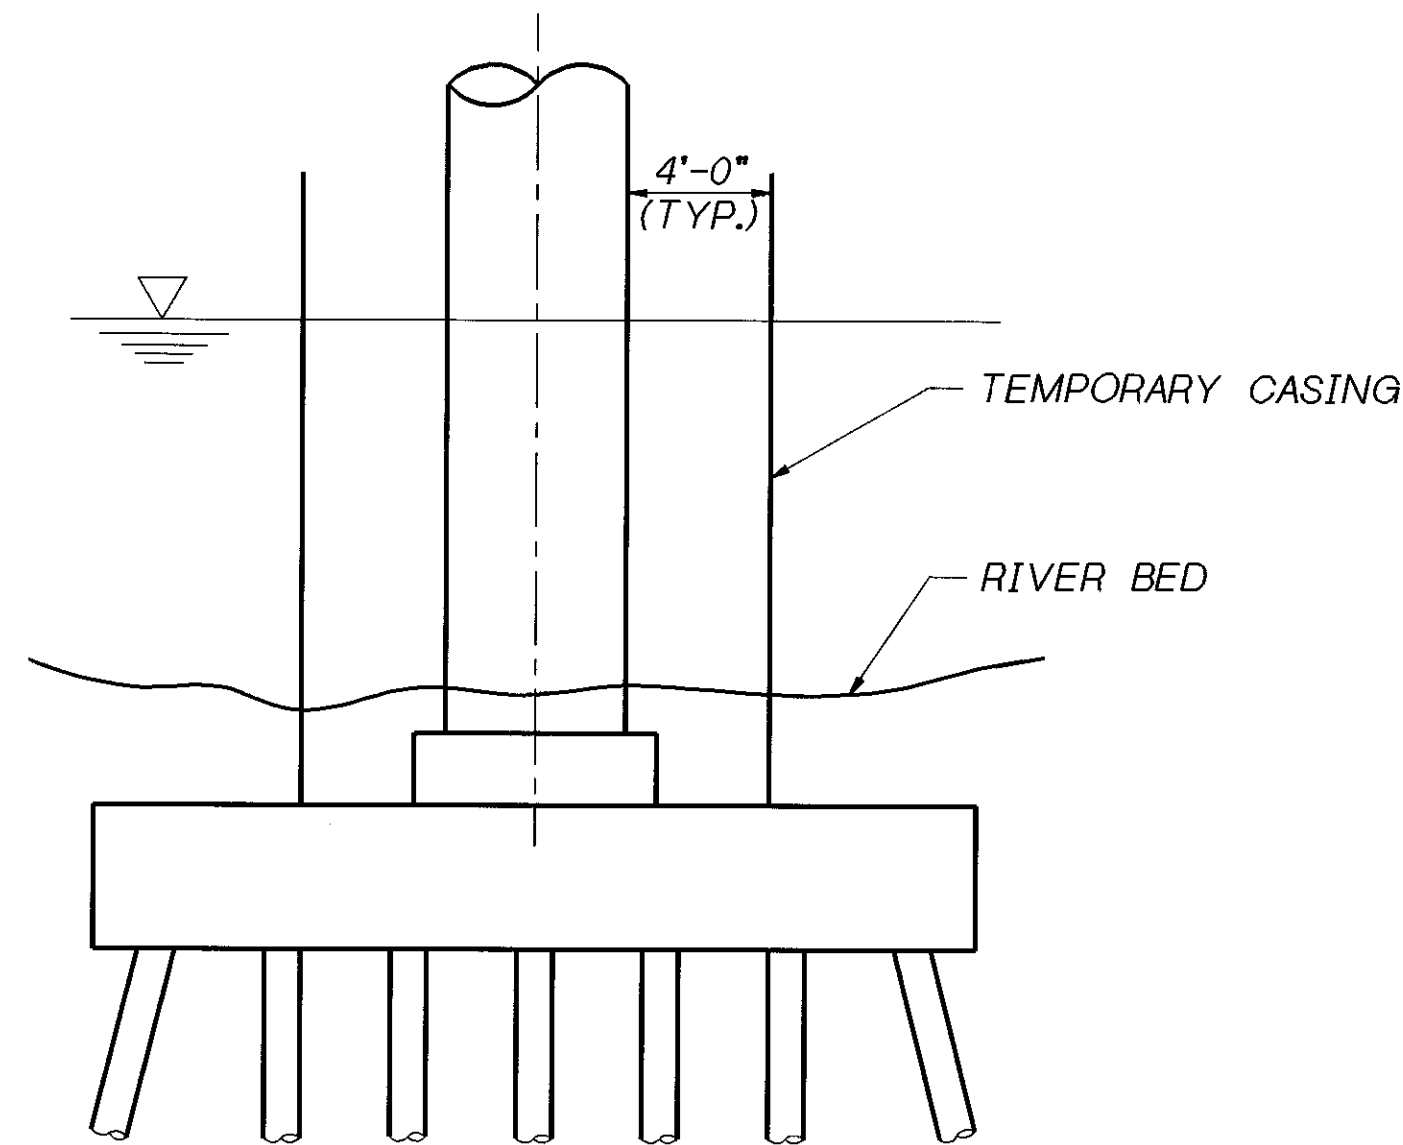


STAGE I
SET TEMPORARY CASING TO TOP OF FOOTING OR BELOW TOP OF EXISTING SHAFT.

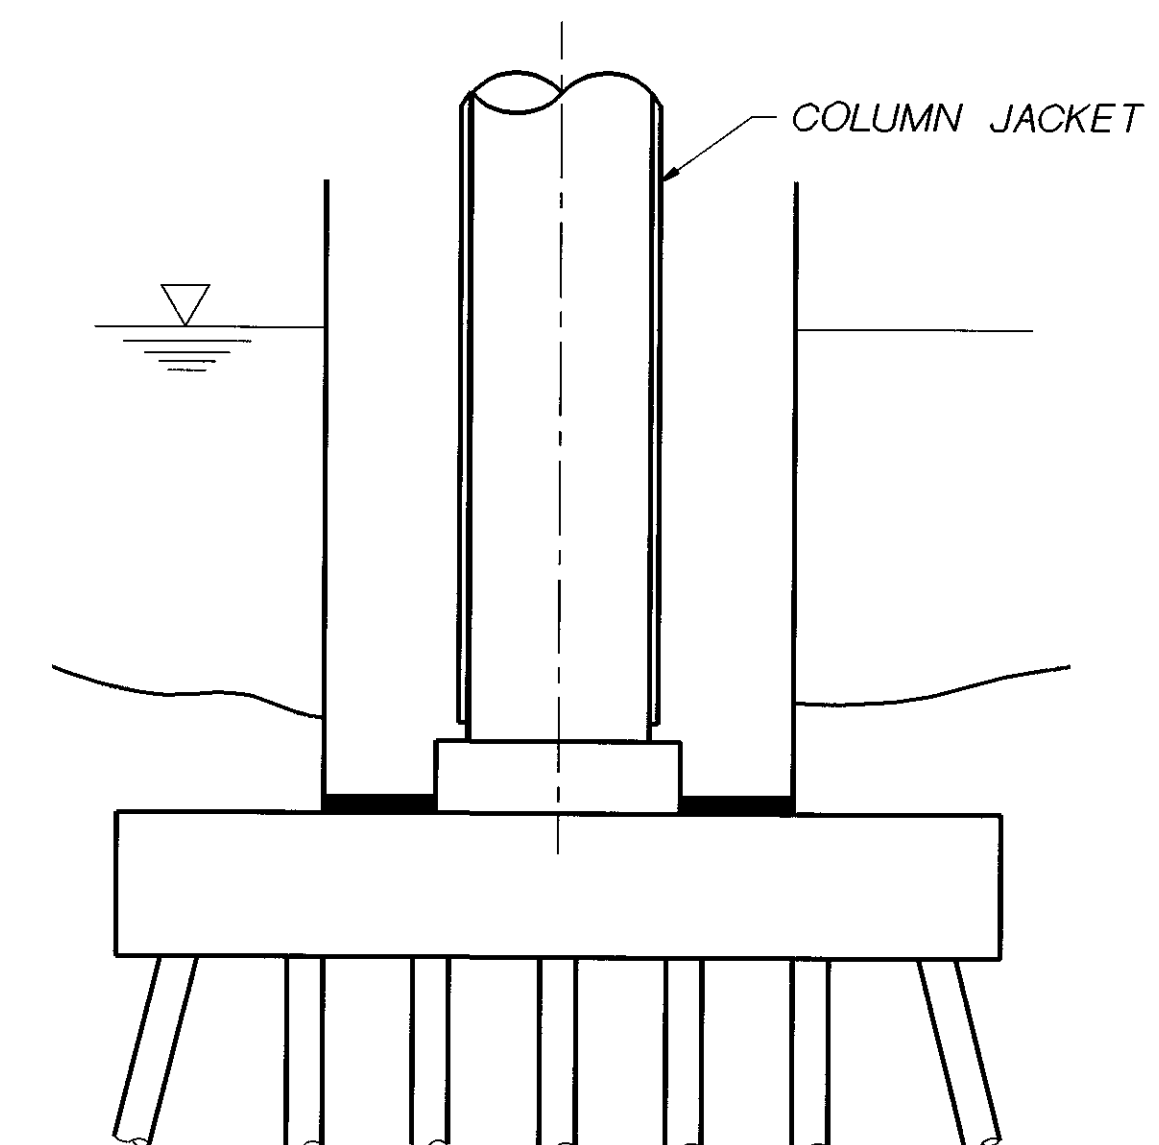

STAGE III
INSTALL STEEL JACKET ON COLUMN. GROUT INSIDE OF JACKET. PAINT JACKET.

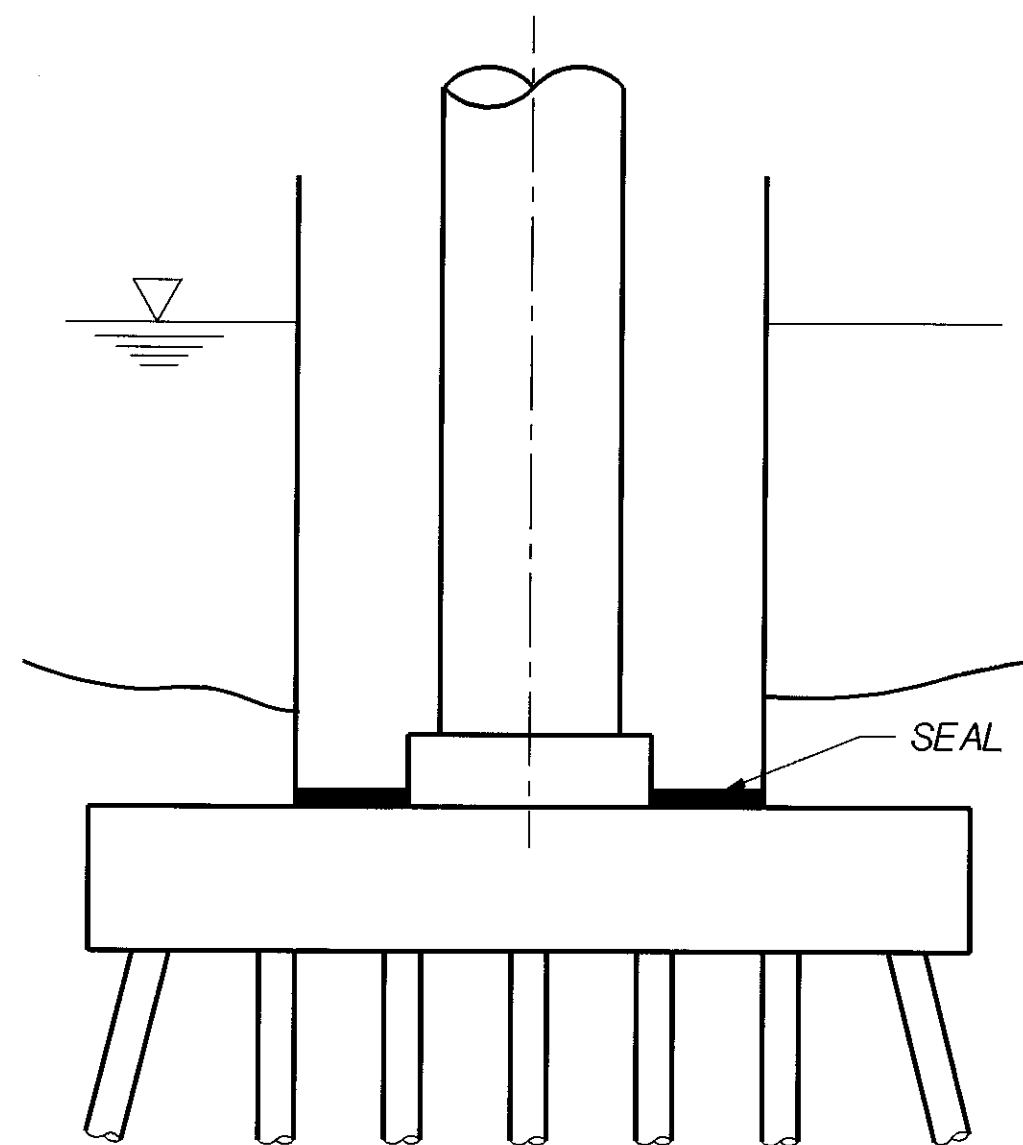


STAGE II
EXCAVATE TO TOP OF FOOTING. SEAL CASING AND DEWATER AS DESIGNED BY THE CONTRACTOR.

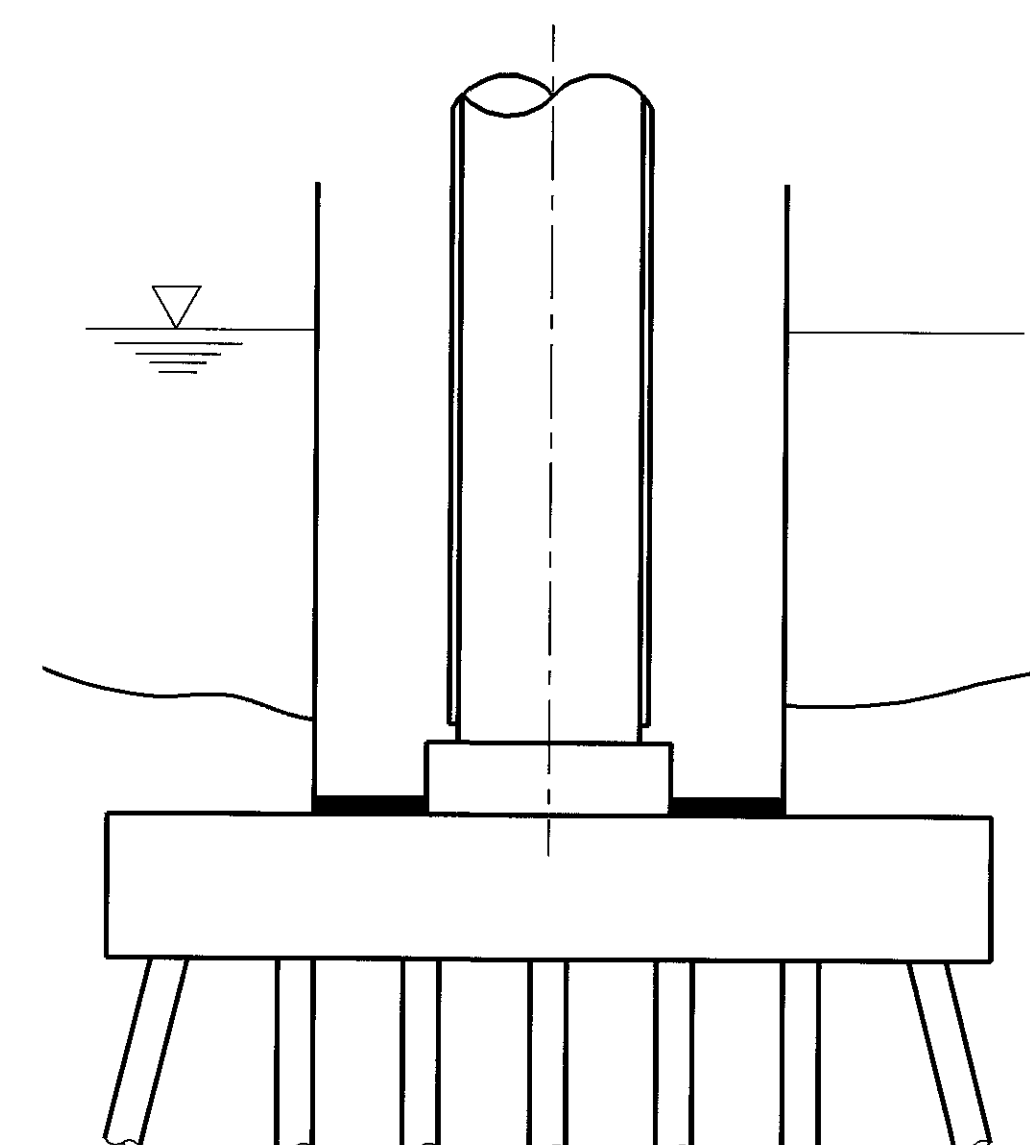


STAGE IV
REMOVE TEMPORARY CASING.

Bridge Design Engr. C. C. RUTH				REGION NO.	STATE	FED. AID PROJ. NO.	SHEET NO.	TOTAL SHEETS
Supervisor J. A. VAN LUND				10	WASH.			
Designed By T.M. MOORE 1/96				JOB NUMBER				
Checked By J. MERTH 2/96				96W020				
Detailed By V.B. SCHICCHI 2/96								
Bridge Projects Engr.								
Prelim. Plan By								
Architect/Specialist	DATE	REVISION	BY	APP'D	4944			

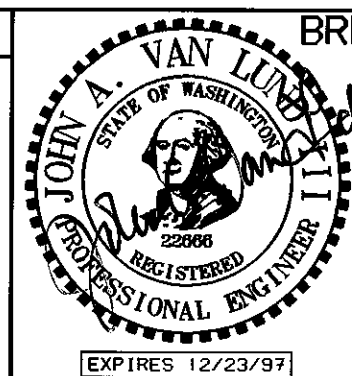

BRIDGE AND STRUCTURES OFFICE

6/4/96
SUPERVISING
BRIDGE
ENGINEER

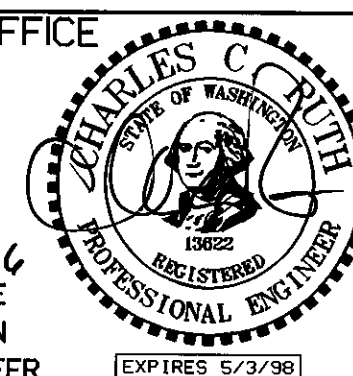

6-5-96
BRIDGE
DESIGN
ENGINEER




**Washington State
Department of
Transportation**

31-MAY-96


SR 405
WOODINVILLE INTERCHANGE
HOV WIDENING
SEISMIC RETROFIT
COLUMN JACKETING
RIVER CONSTRUCTION SEQUENCE

BRIDGE SHEET NO. S7
SHEET 417 OF 452 SHEETS



405_70WROOT:\000000.FGB.RETRO.FGB\JAX_RIVER.FGB.1

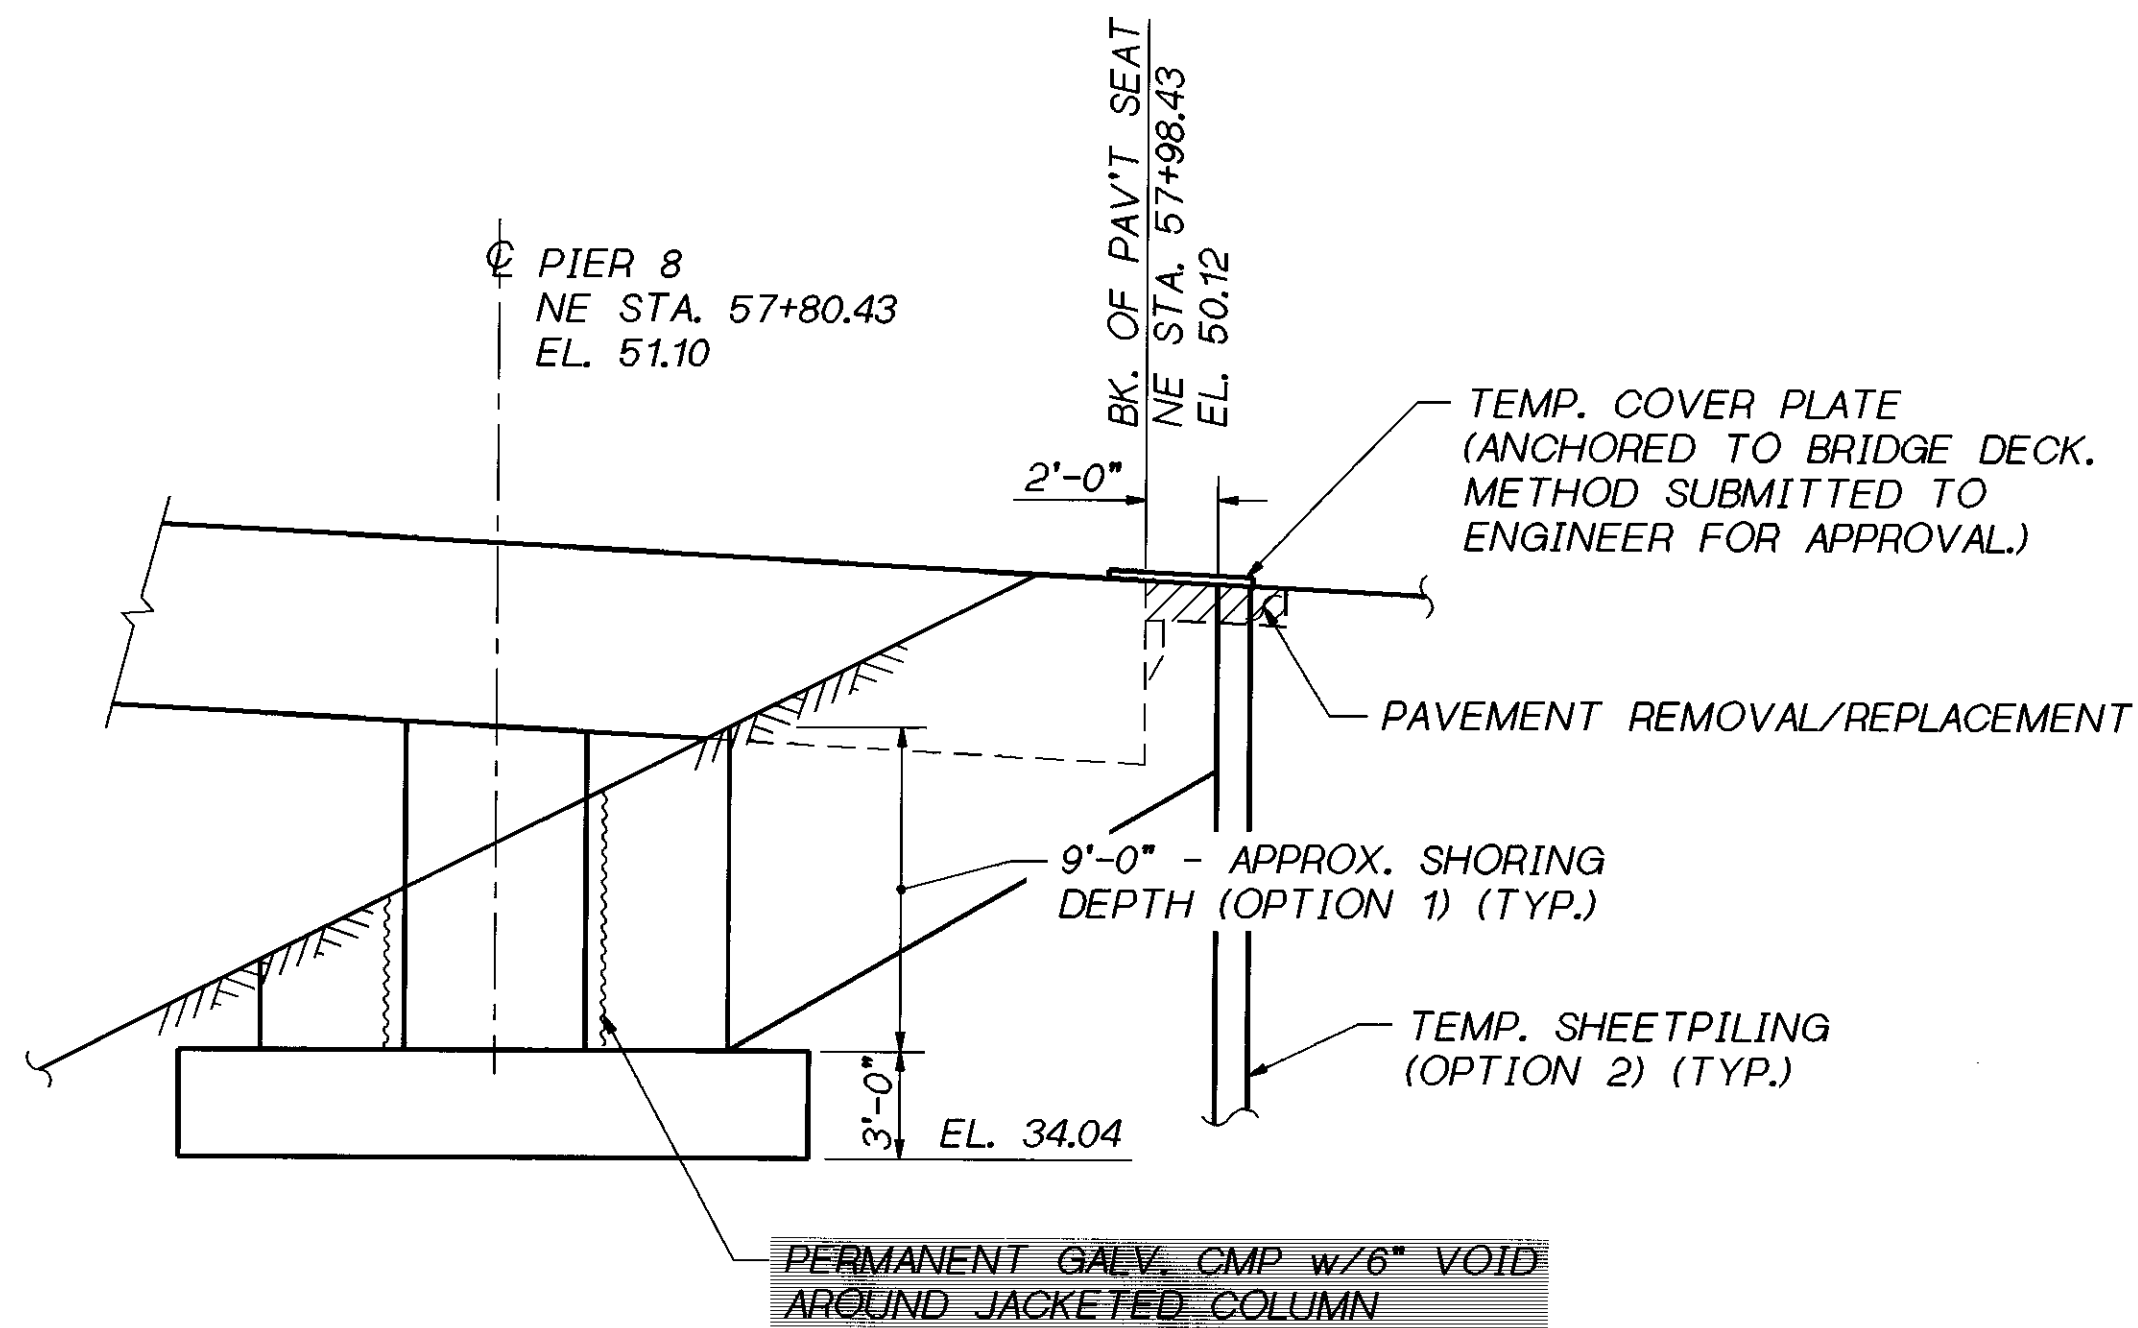

ELEVATION - NE LINE PIER 8

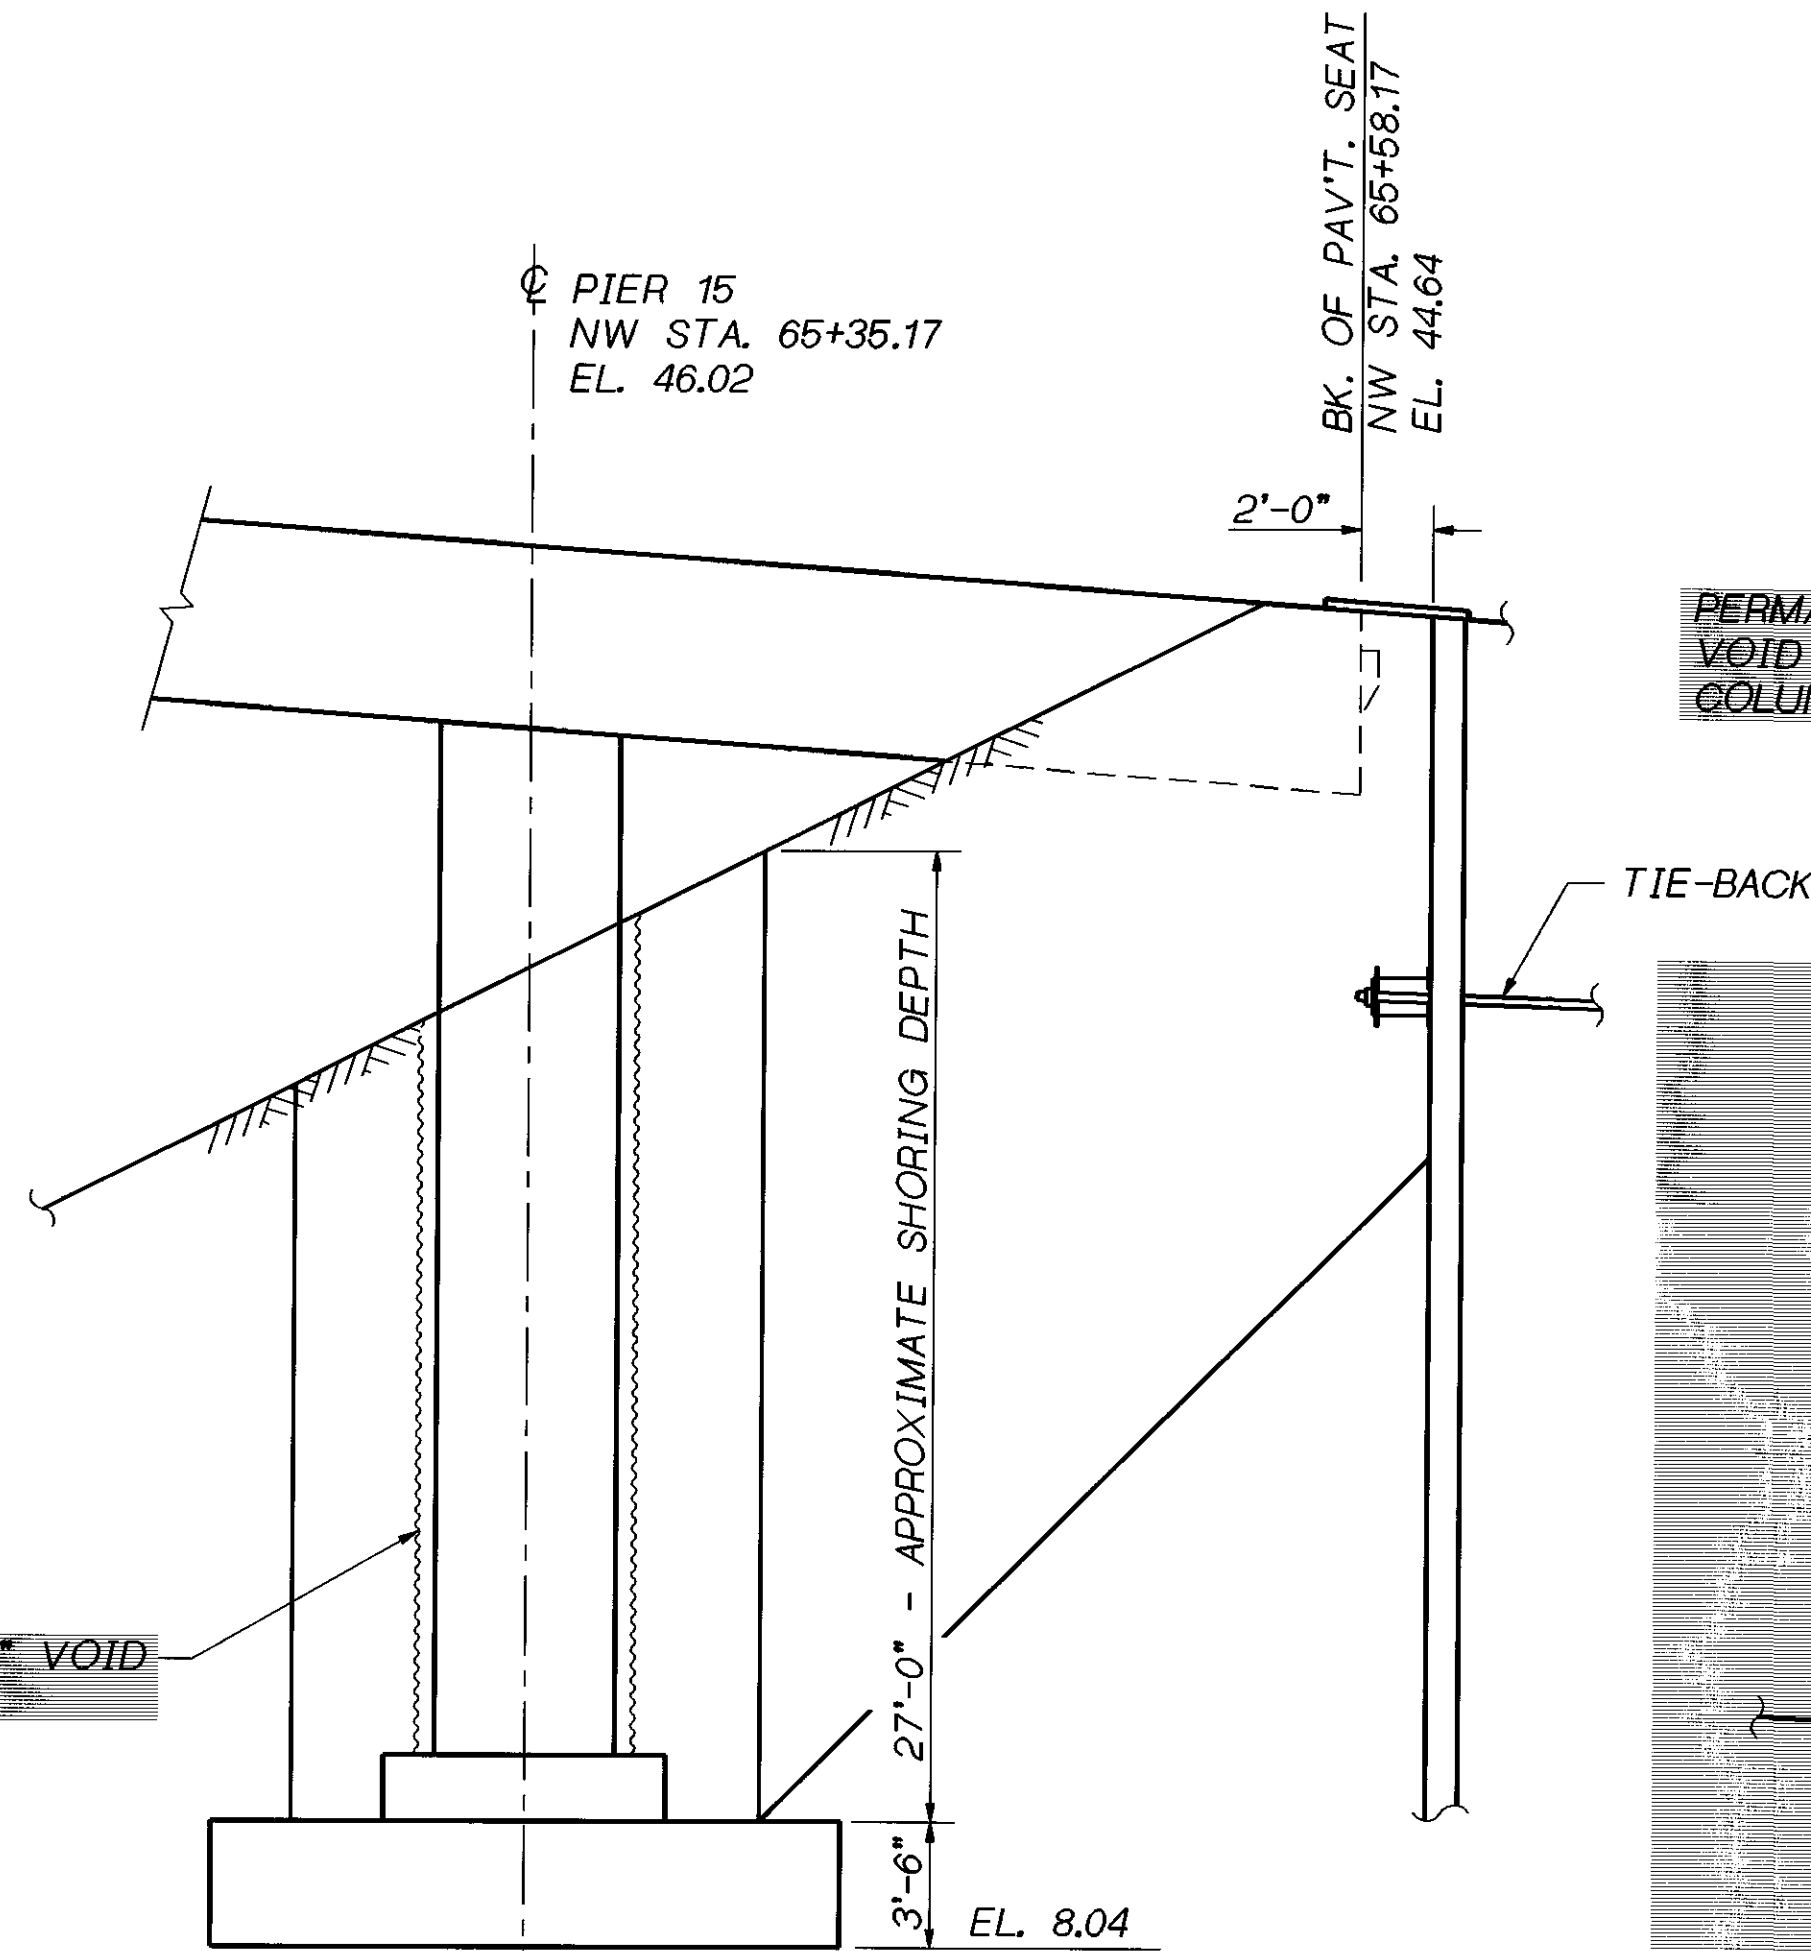

ELEVATION - NW LINE PIER 15

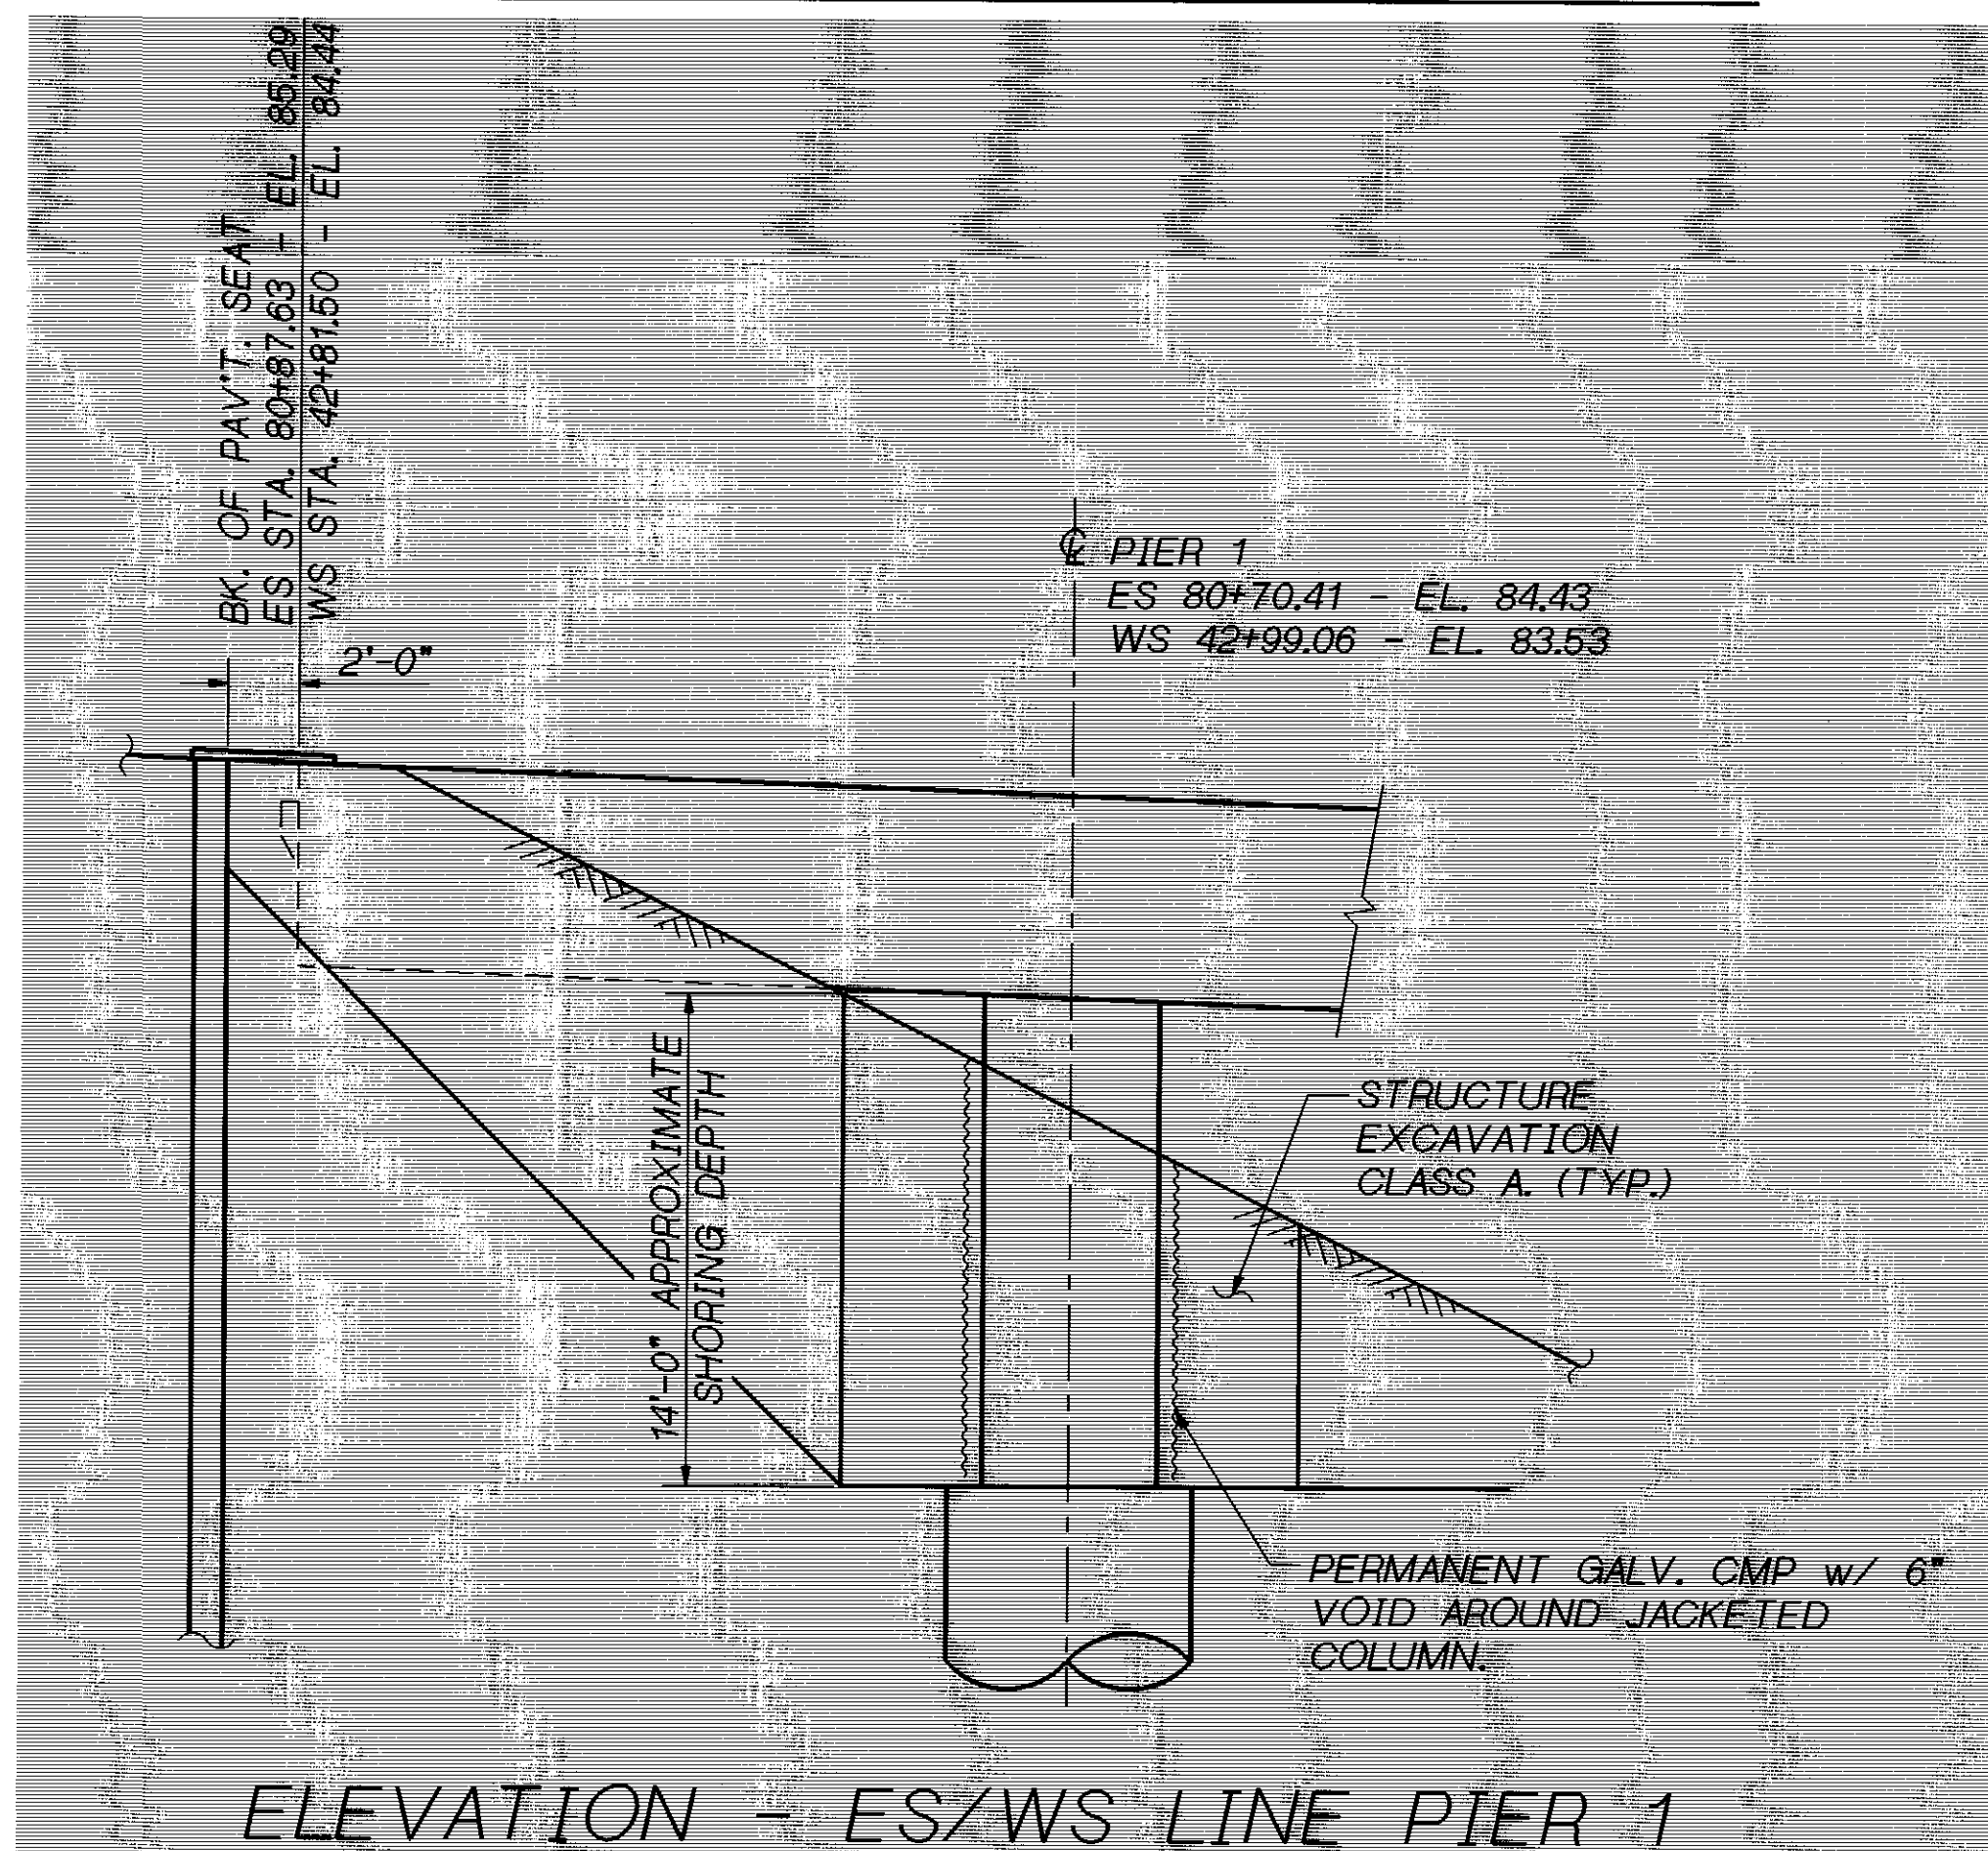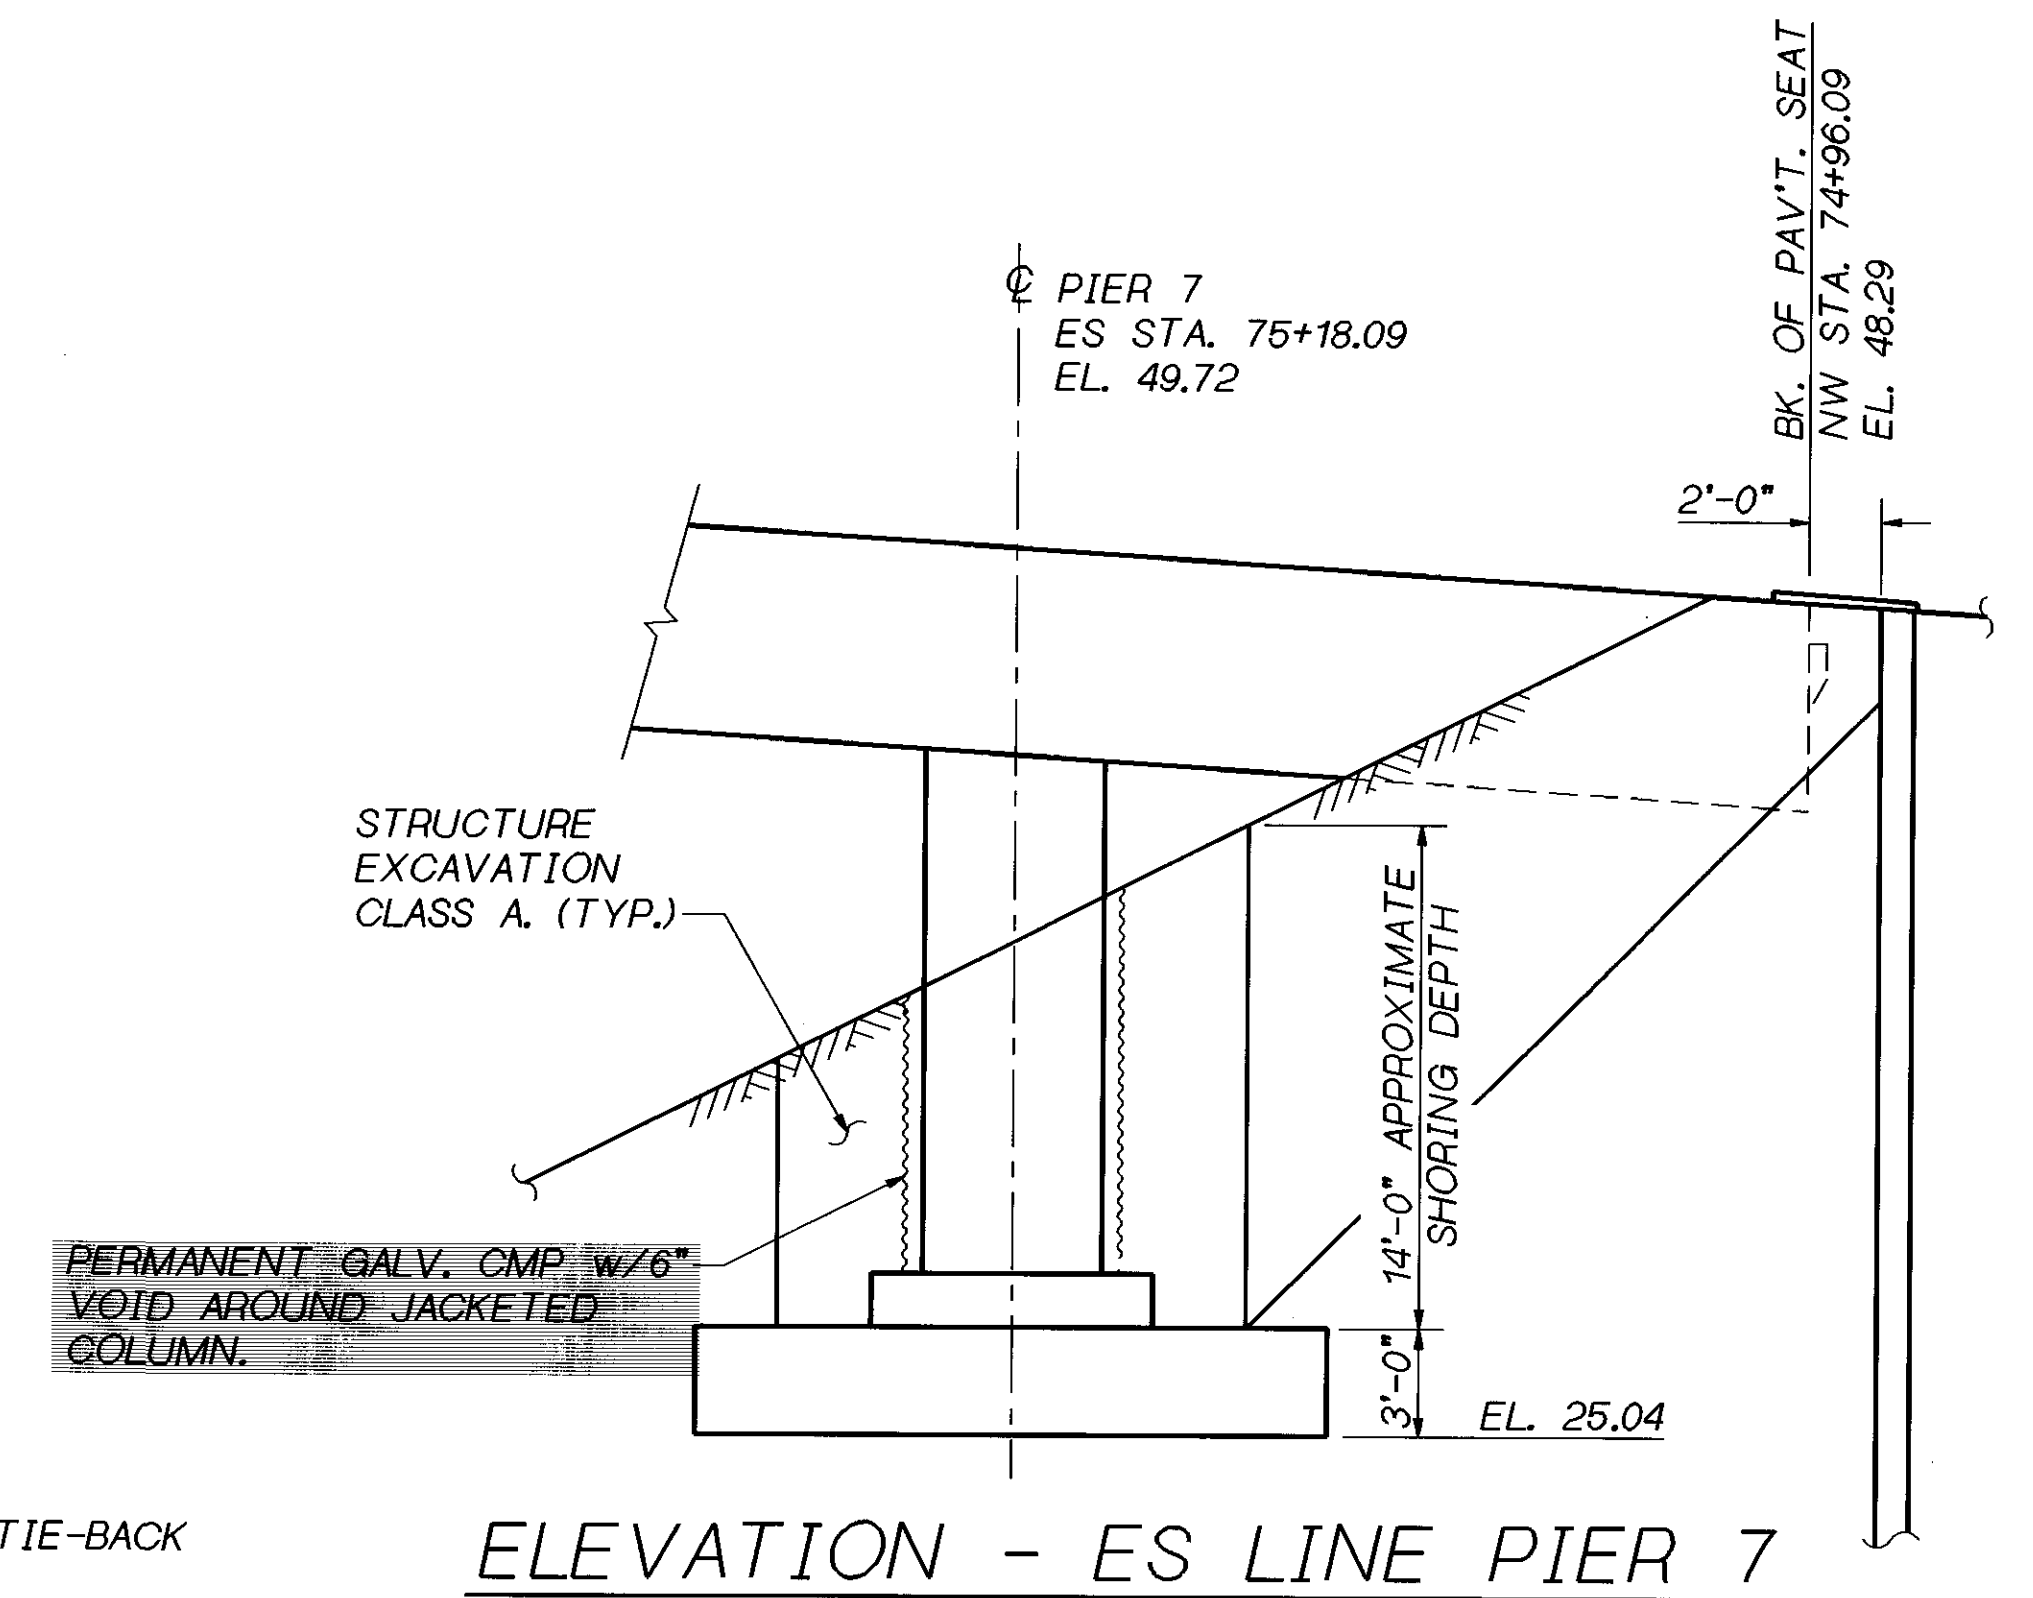

SHORING NOTES:

1. PAY QUANTITIES BASED ON OPTION 1.
2. METHOD OF SHORING SHALL BE DESIGNED AND DETAILED BY THE CONTRACTOR IN ACCORDANCE TO STD. SPEC.
3. NO CONCRETE APPROACH SLABS ARE PRESENT FOR THESE PIERS SHOWN.
4. RELOCATE EXISTING UTILITIES THAT INTERFERE WITH SHORING WALL.

SR 405 JOB NO. 7056 SHEET 58

Bridge Design Engr. C. C. RUTH	405_70RETROFIT - (FGB) JAX_END_PRS. FGB; 1	REGION NO.	STATE	FED. AID PROJ. NO.	SHEET NO.	TOTAL SHEETS
Supervisor J. A. VAN LUND		10	WASH.			
Designed By T.M.M. MOORE 1/96						
Checked By J. MERTH 2/96						
Detailled By V.B. SCHICCHI 2/96						
Bridge Projects Engr.						
Prelim. Plan By	8/96 ADDED ES/WS PIER 1 & GALV. CALLOUT. TM CL					
Architect/Specialist	DATE	REVISION	BY	APP'D	4944	

BRIDGE AND STRUCTURES OFFICE

JOHN A. VAN LUND
PROFESSIONAL ENGINEER
8-8-96
SUPERVISING BRIDGE ENGINEER
[EXPIRES 12/23/97]


CHARLES C. RUTH
PROFESSIONAL ENGINEER
8-8-96
BRIDGE DESIGN ENGINEER
[EXPIRES 5/3/98]

Washington State Department of Transportation

SR 405
WOODINVILLE INTERCHANGE
HOV WIDENING
SEISMIC RETROFIT

COLUMN JACKETING
END PIER EXCAVATION

BRIDGE SHEET NO. 58
SHEET 418 OF 452 SHEETS

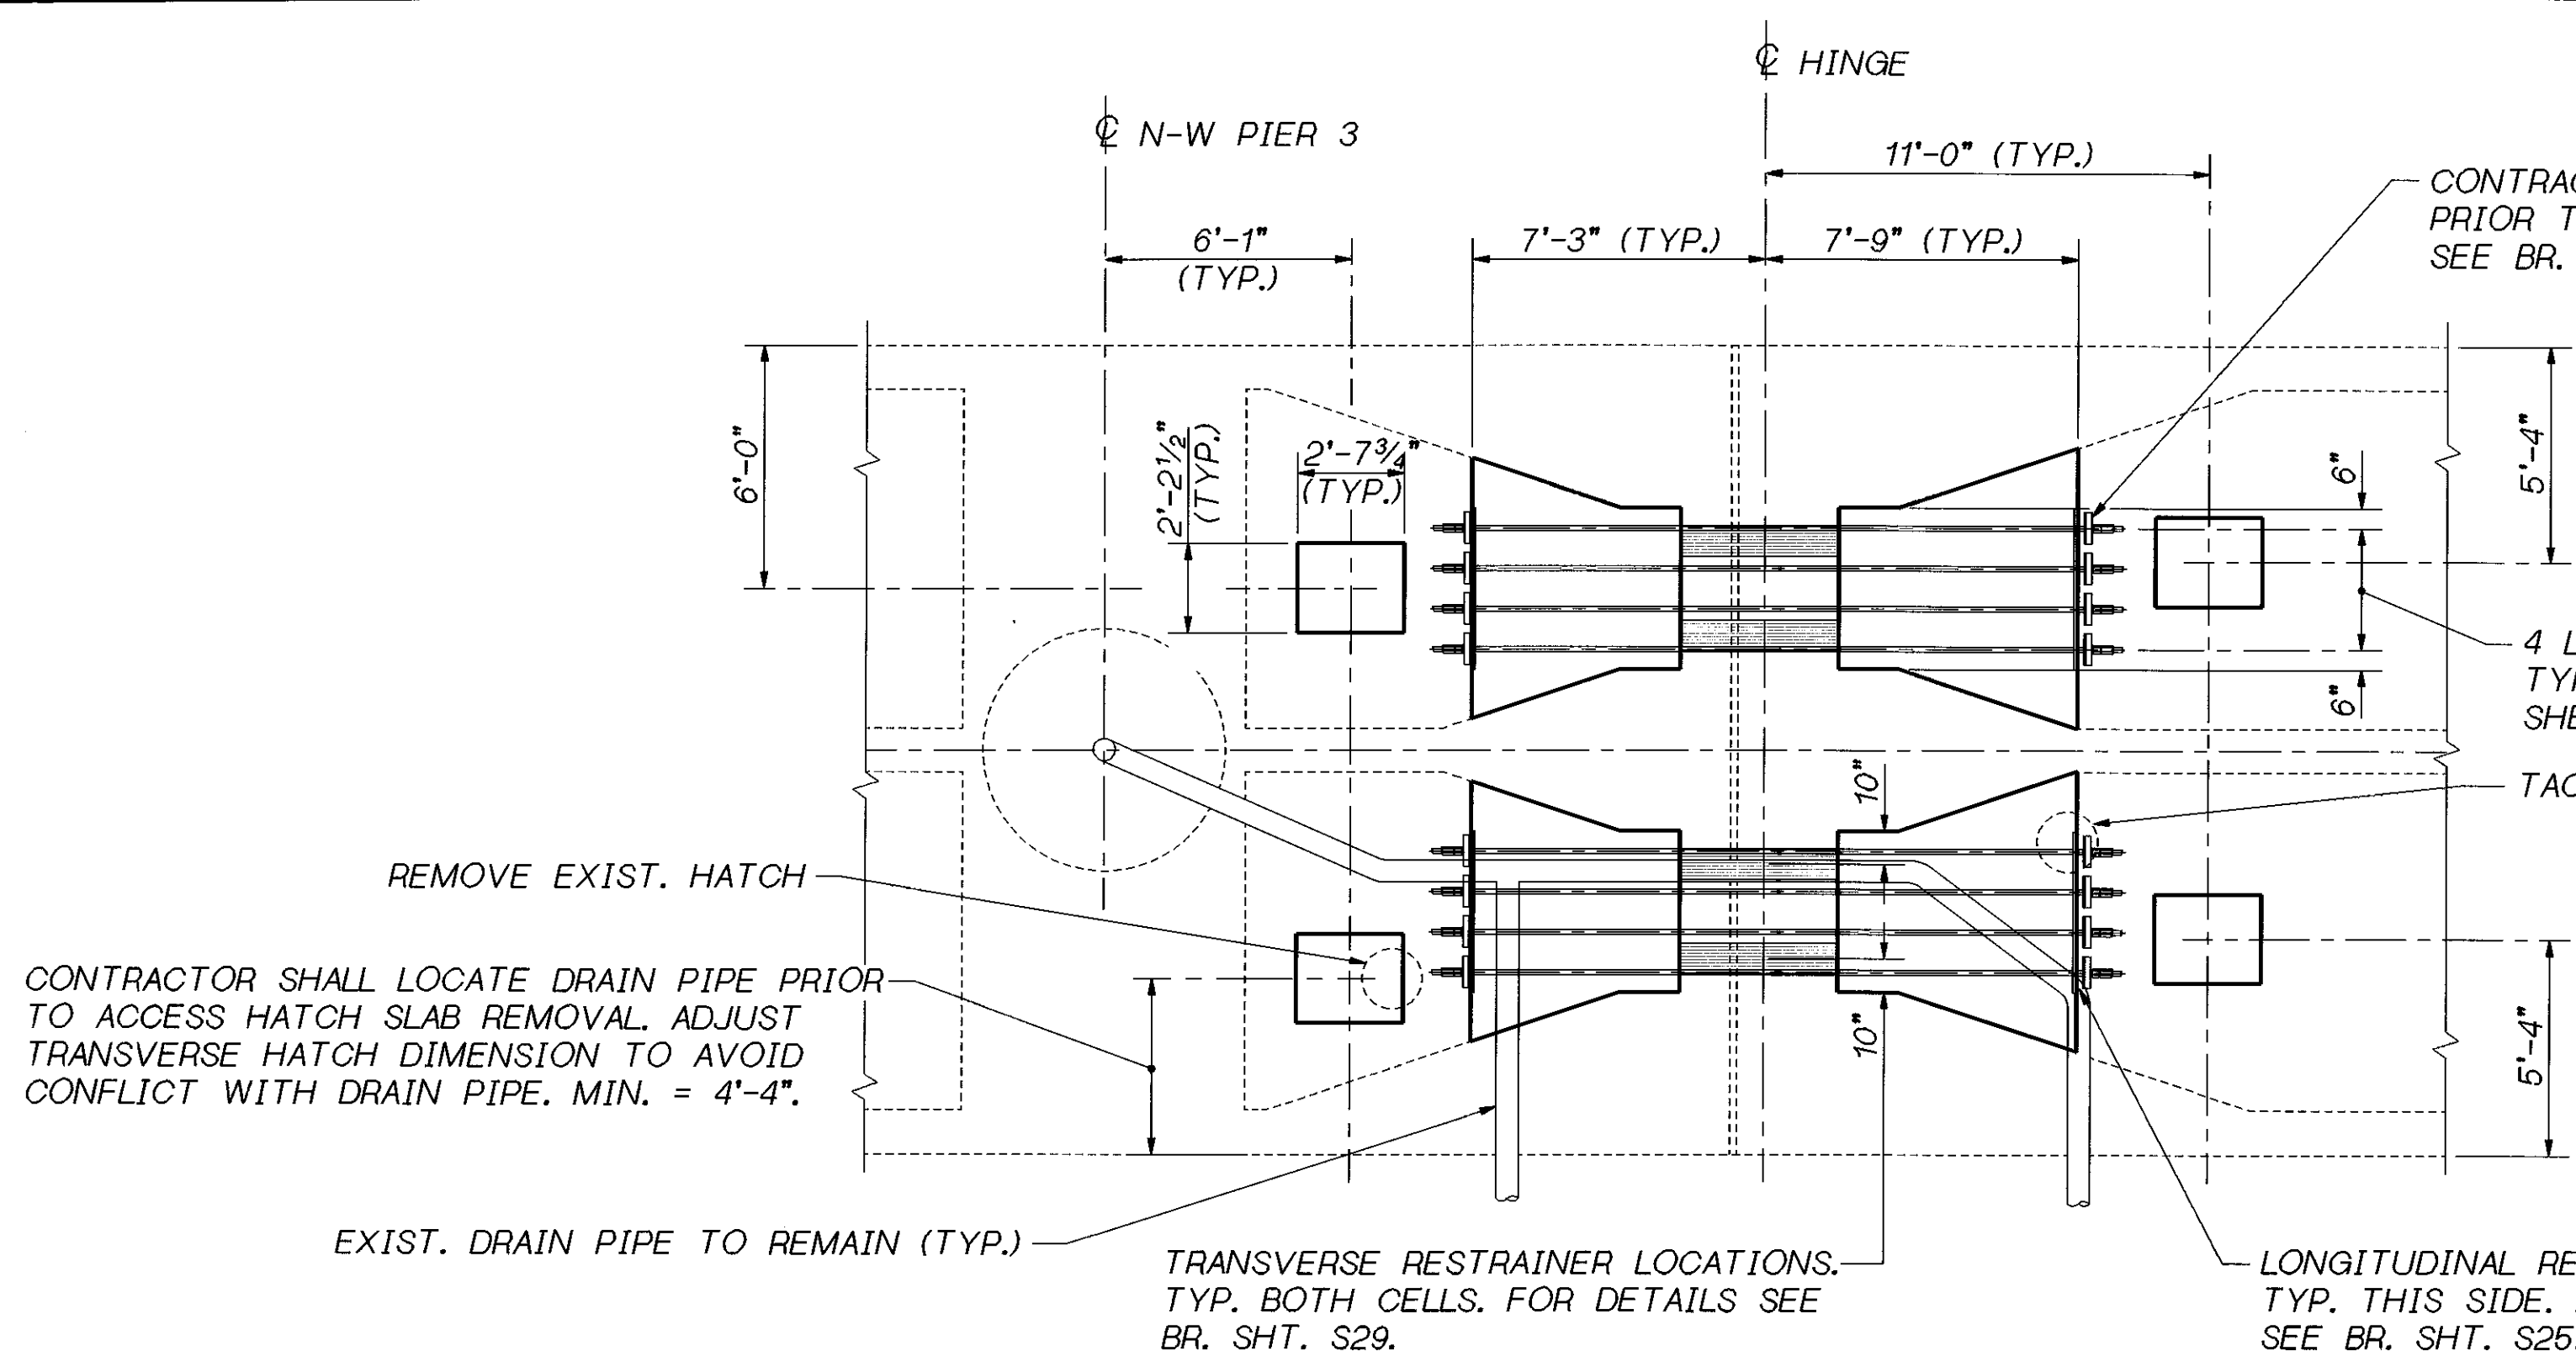


RESTRAINER LAYOUT - N-W 1
FOR REINFORCEMENT DETAILS SEE BR. SHT. S22.

REMOVE EXIST. HATCH
CONTRACTOR SHALL LOCATE DRAIN PIPE PRIOR TO ACCESS HATCH SLAB REMOVAL. ADJUST TRANSVERSE HATCH DIMENSION TO AVOID CONFLICT WITH DRAIN PIPE. MIN. = 4'-4".

EXIST. DRAIN PIPE TO REMAIN (TYP.)

TRANSVERSE RESTRAINER LOCATIONS. TYP. BOTH CELLS. FOR DETAILS SEE BR. SHT. S29.

LONGITUDINAL RESTRAINER GAP TYP. THIS SIDE. FOR DIMENSIONS SEE BR. SHT. S25.

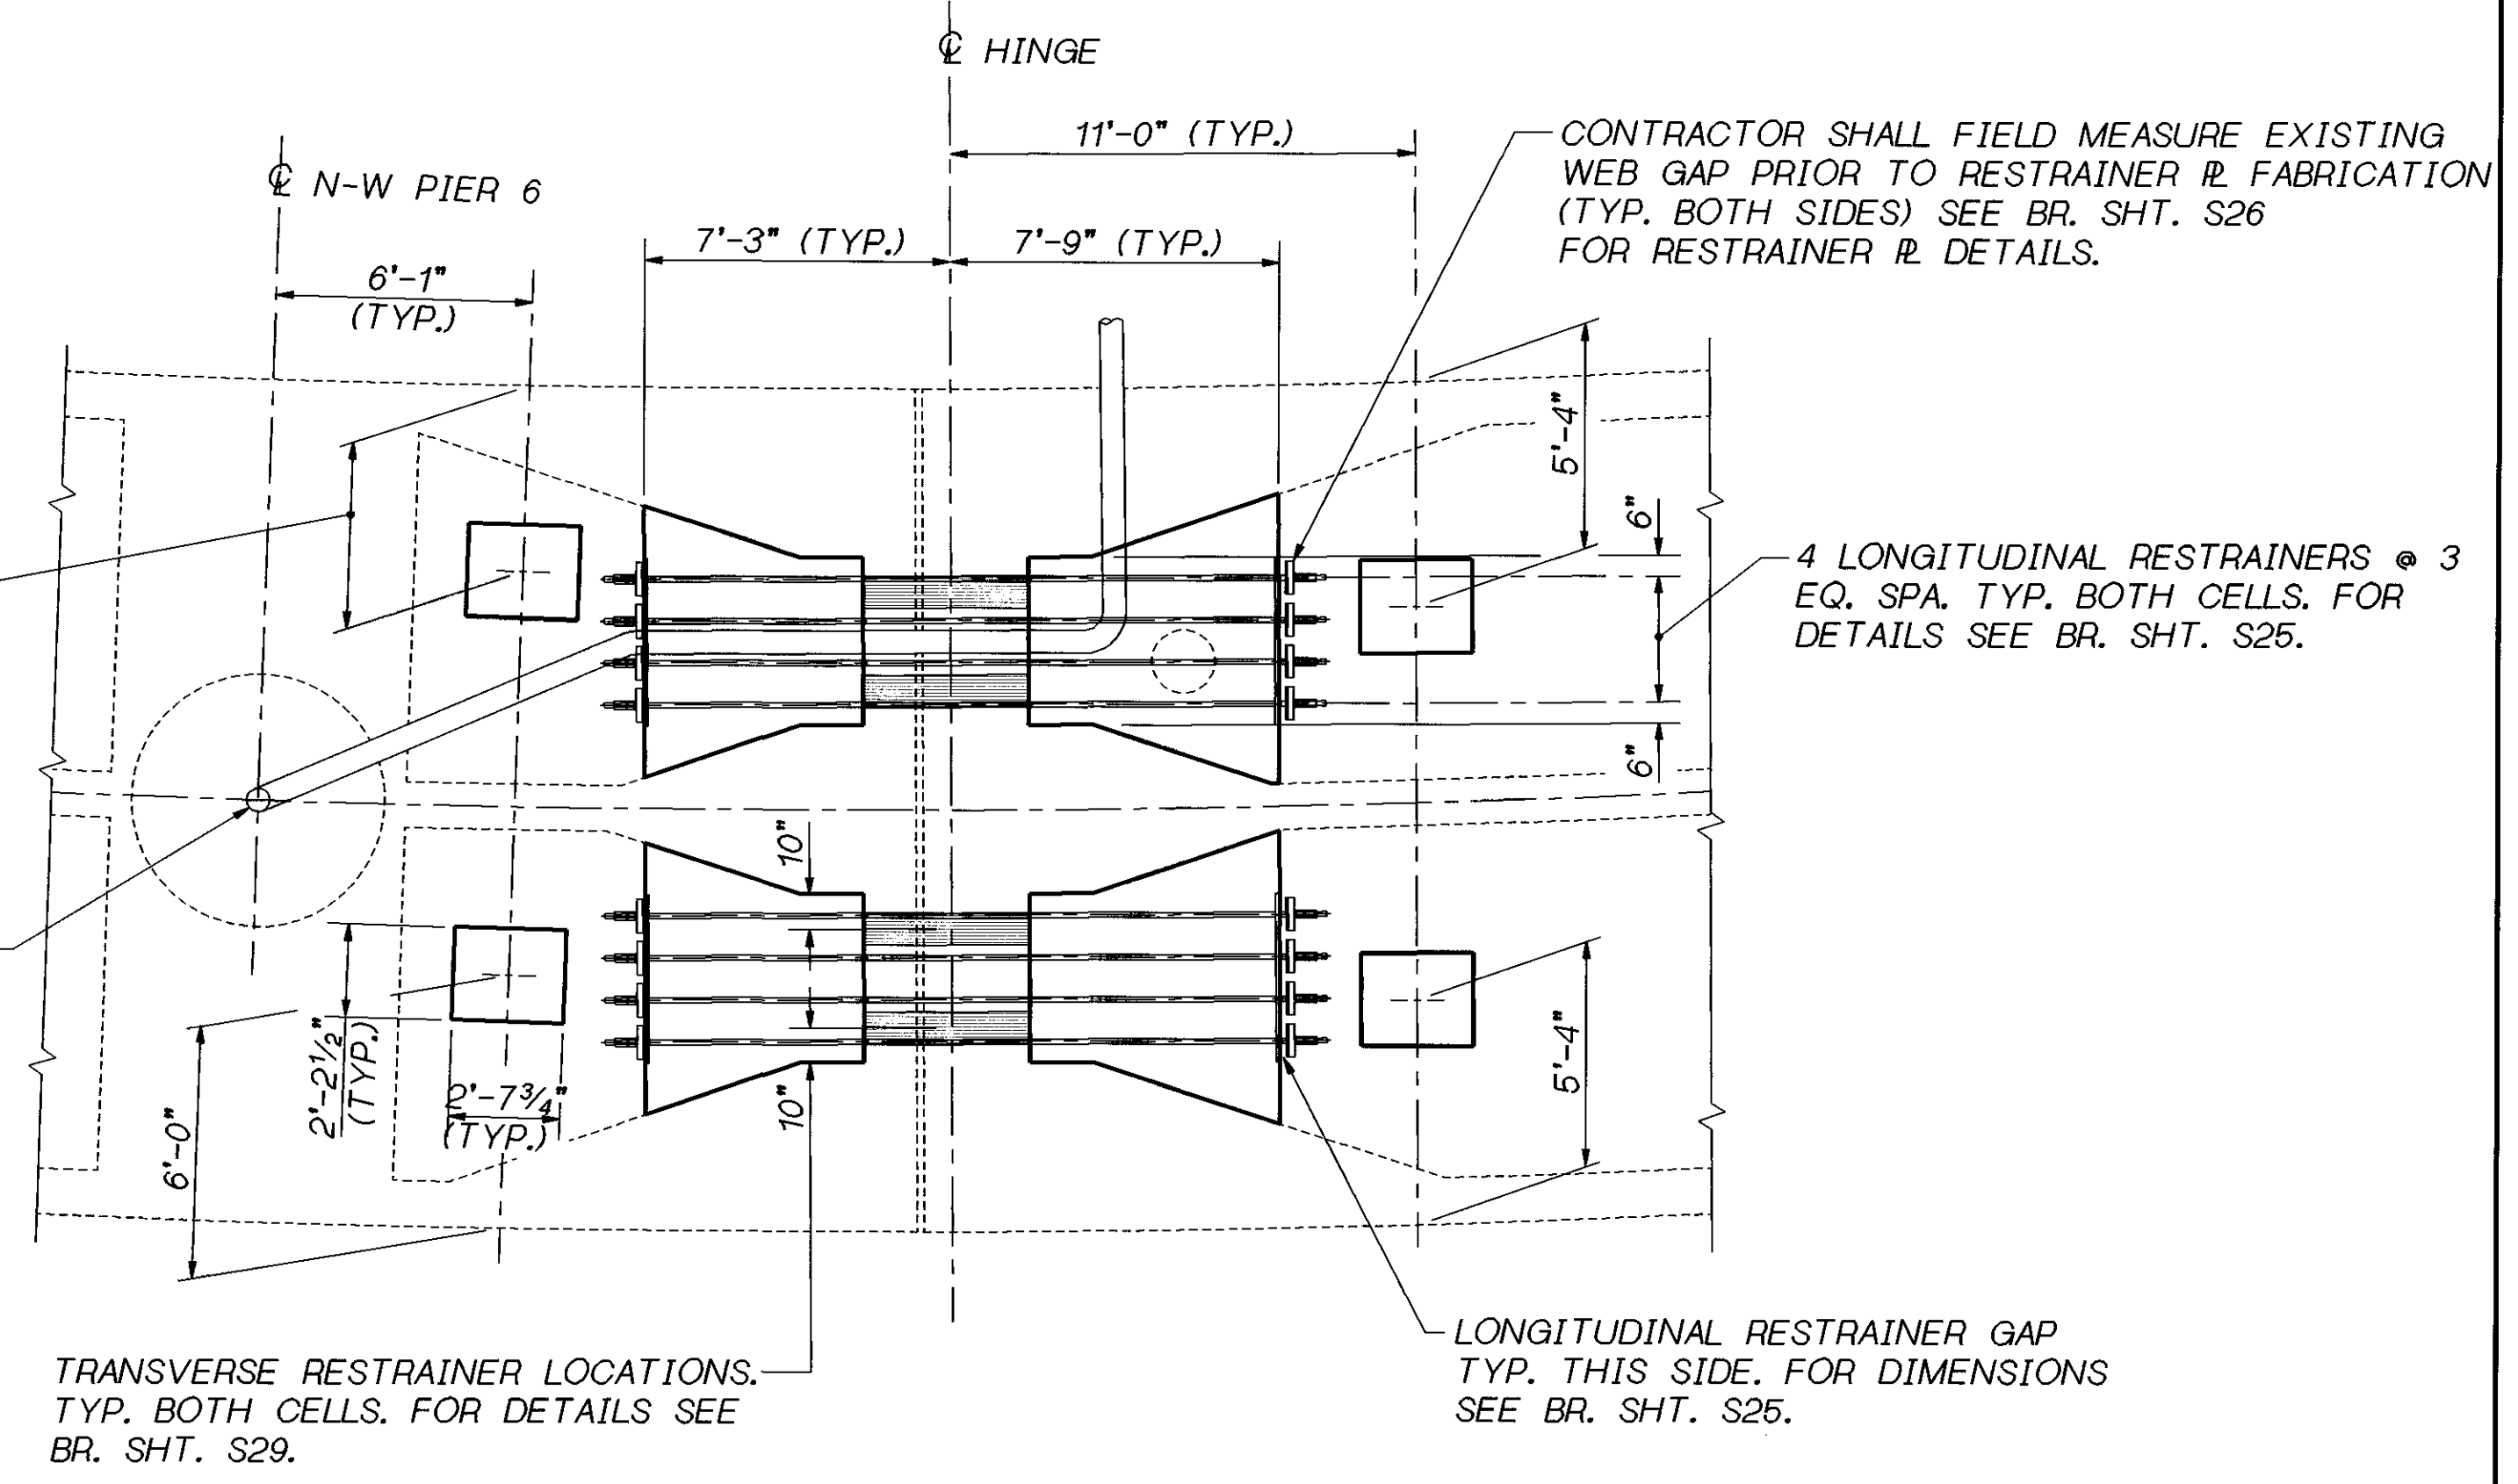

RESTRAINER LAYOUT - NW 2
FOR REINFORCEMENT DETAILS SEE BR. SHT. S22.
TACK WELD EXISTING ACCESS HATCH SHUT.
RESTRAINERS ARE NORMAL TO ϕ OF HINGE

CONTRACTOR SHALL LOCATE DRAIN PIPE PRIOR TO ACCESS HATCH SLAB REMOVAL. ADJUST TRANSVERSE HATCH DIMENSION TO AVOID CONFLICT WITH DRAIN PIPE. MIN. = 4'-4".

EXIST. DRAIN PIPE TO REMAIN (TYP.)

TRANSVERSE RESTRAINER LOCATIONS. TYP. BOTH CELLS. FOR DETAILS SEE BR. SHT. S29.

LONGITUDINAL RESTRAINER GAP TYP. THIS SIDE. FOR DIMENSIONS SEE BR. SHT. S25.

SR 405 JOB NO. 7056 SHEET S16

Bridge Design Engr. C. C. RUTH	REGION NO.	STATE	FED. AID PROJ. NO.	SHEET NO.	TOTAL SHEETS
Supervisor J. A. VAN LUND	10	WASH.			
Designed By J. MERTH 2/96	JOB NUMBER 96W020				
Checked By J. WEI 2/96	4944				
Detailed By V.B. SCHICCHI 2/96					
Bridge Projects Engr.					
Prelim. Plan By					
Architect/Specialist	DATE	REVISION	BY	APP'D	

BRIDGE AND STRUCTURES OFFICE
JOHN A. VAN LUND SUPERVISING BRIDGE ENGINEER 6/4/96
CHARLES C. RUTH BRIDGE DESIGN ENGINEER 6.5.96

Washington State Department of Transportation

Washington State Department of Transportation


SR 405
WOODINVILLE INTERCHANGE
HOV WIDENING
SEISMIC RETROFIT

RESTRAINER LAYOUT
N-W 1, N-W 2

BRIDGE SHEET NO. S16
SHEET 426 OF 452 SHEETS

CONTRACTOR SHALL LOCATE DRAIN PIPE PRIOR TO ACCESS HATCH SLAB REMOVAL. ADJUST TRANSVERSE HATCH DIMENSION TO AVOID CONFLICT WITH DRAIN PIPE. MIN. = 4'-6".


CONTRACTOR SHALL FIELD MEASURE EXISTING WEB GAP PRIOR TO RESTRAINER & FABRICATION (TYP. BOTH CELLS) SEE BR. SHT. S26 FOR RESTRAINER & DETAILS.

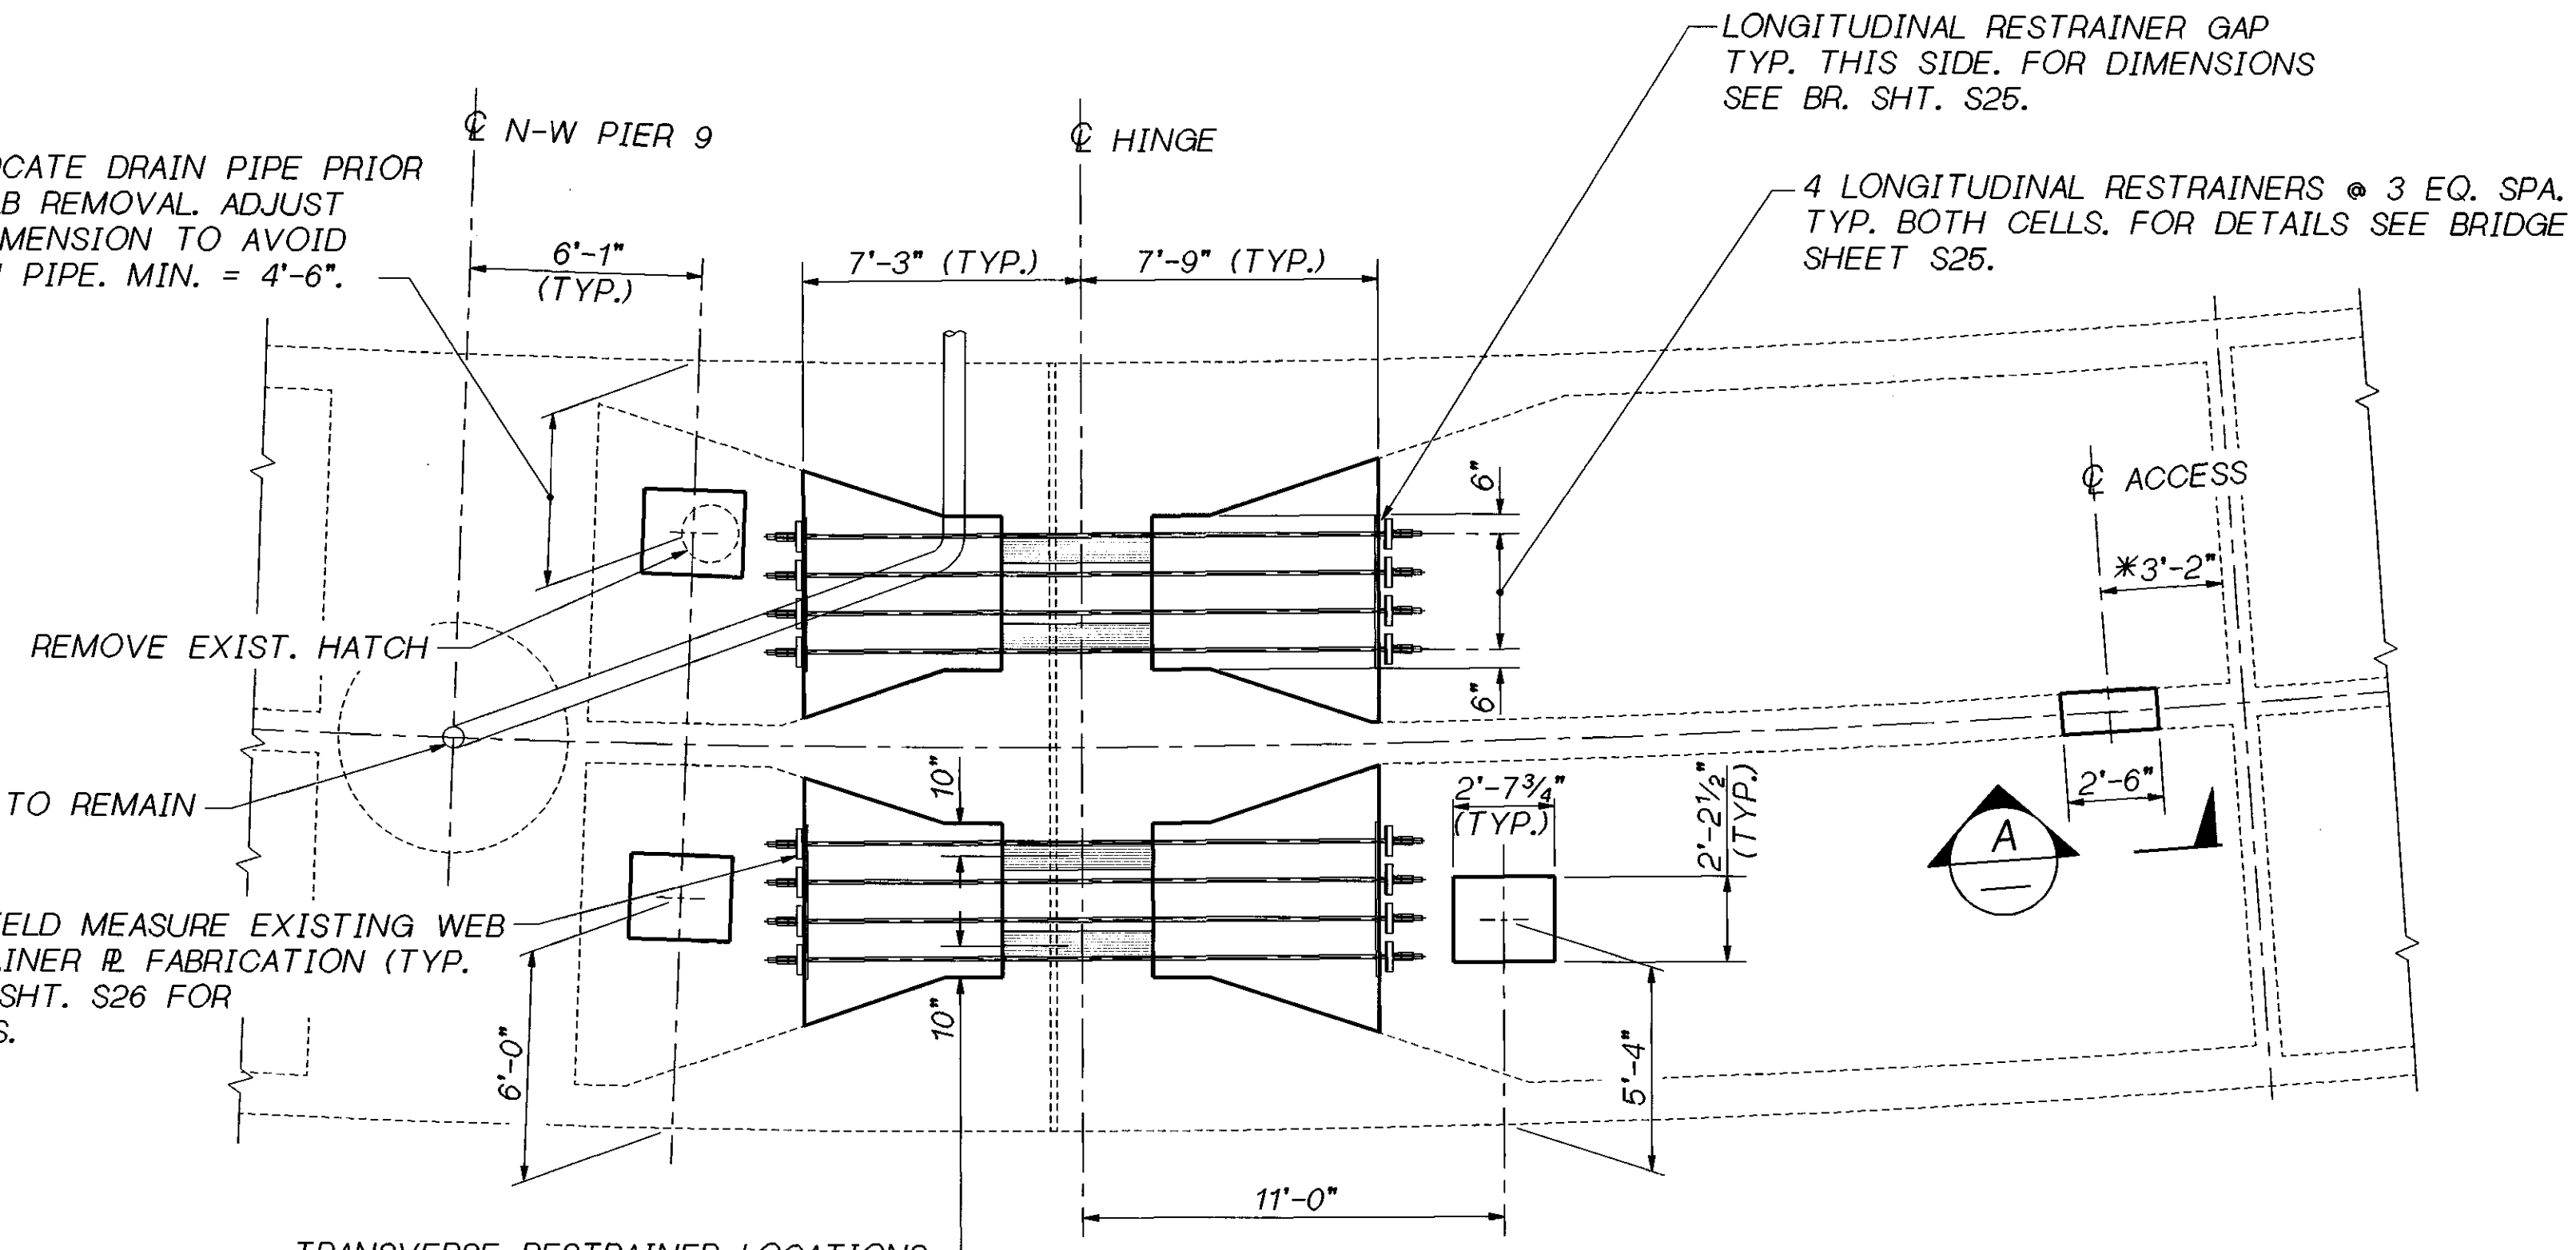

TRANSVERSE RESTRAINER LOCATIONS. TYP. BOTH CELLS. FOR DETAILS SEE BR. SHT. S29.


RESTRAINER LAYOUT - N-W 3

FOR REINFORCEMENT DETAILS SEE BR. SHT. S22. RESTRAINERS ARE NORMAL TO ϕ HINGE.

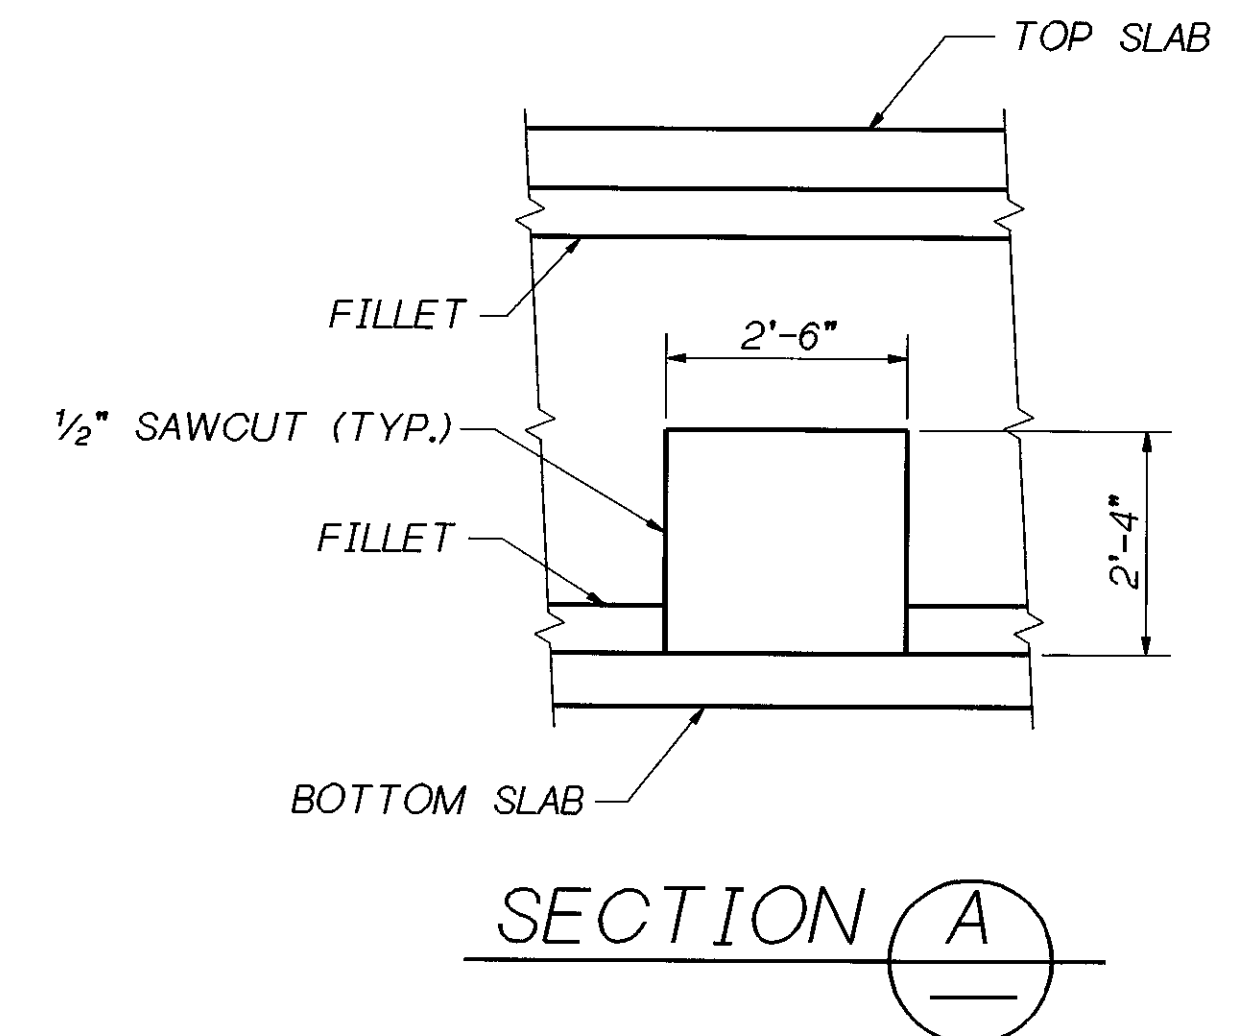

CONTRACTOR SHALL LOCATE DRAIN PIPE PRIOR TO ACCESS HATCH SLAB REMOVAL. ADJUST TRANSVERSE HATCH DIMENSION TO AVOID CONFLICT WITH DRAIN PIPE. MIN. = 4'-6".

CONTRACTOR SHALL FIELD MEASURE EXISTING WEB GAP PRIOR TO RESTRAINER & FABRICATION (TYP. BOTH CELLS) SEE BR. SHT. S26 FOR RESTRAINER & DETAILS.

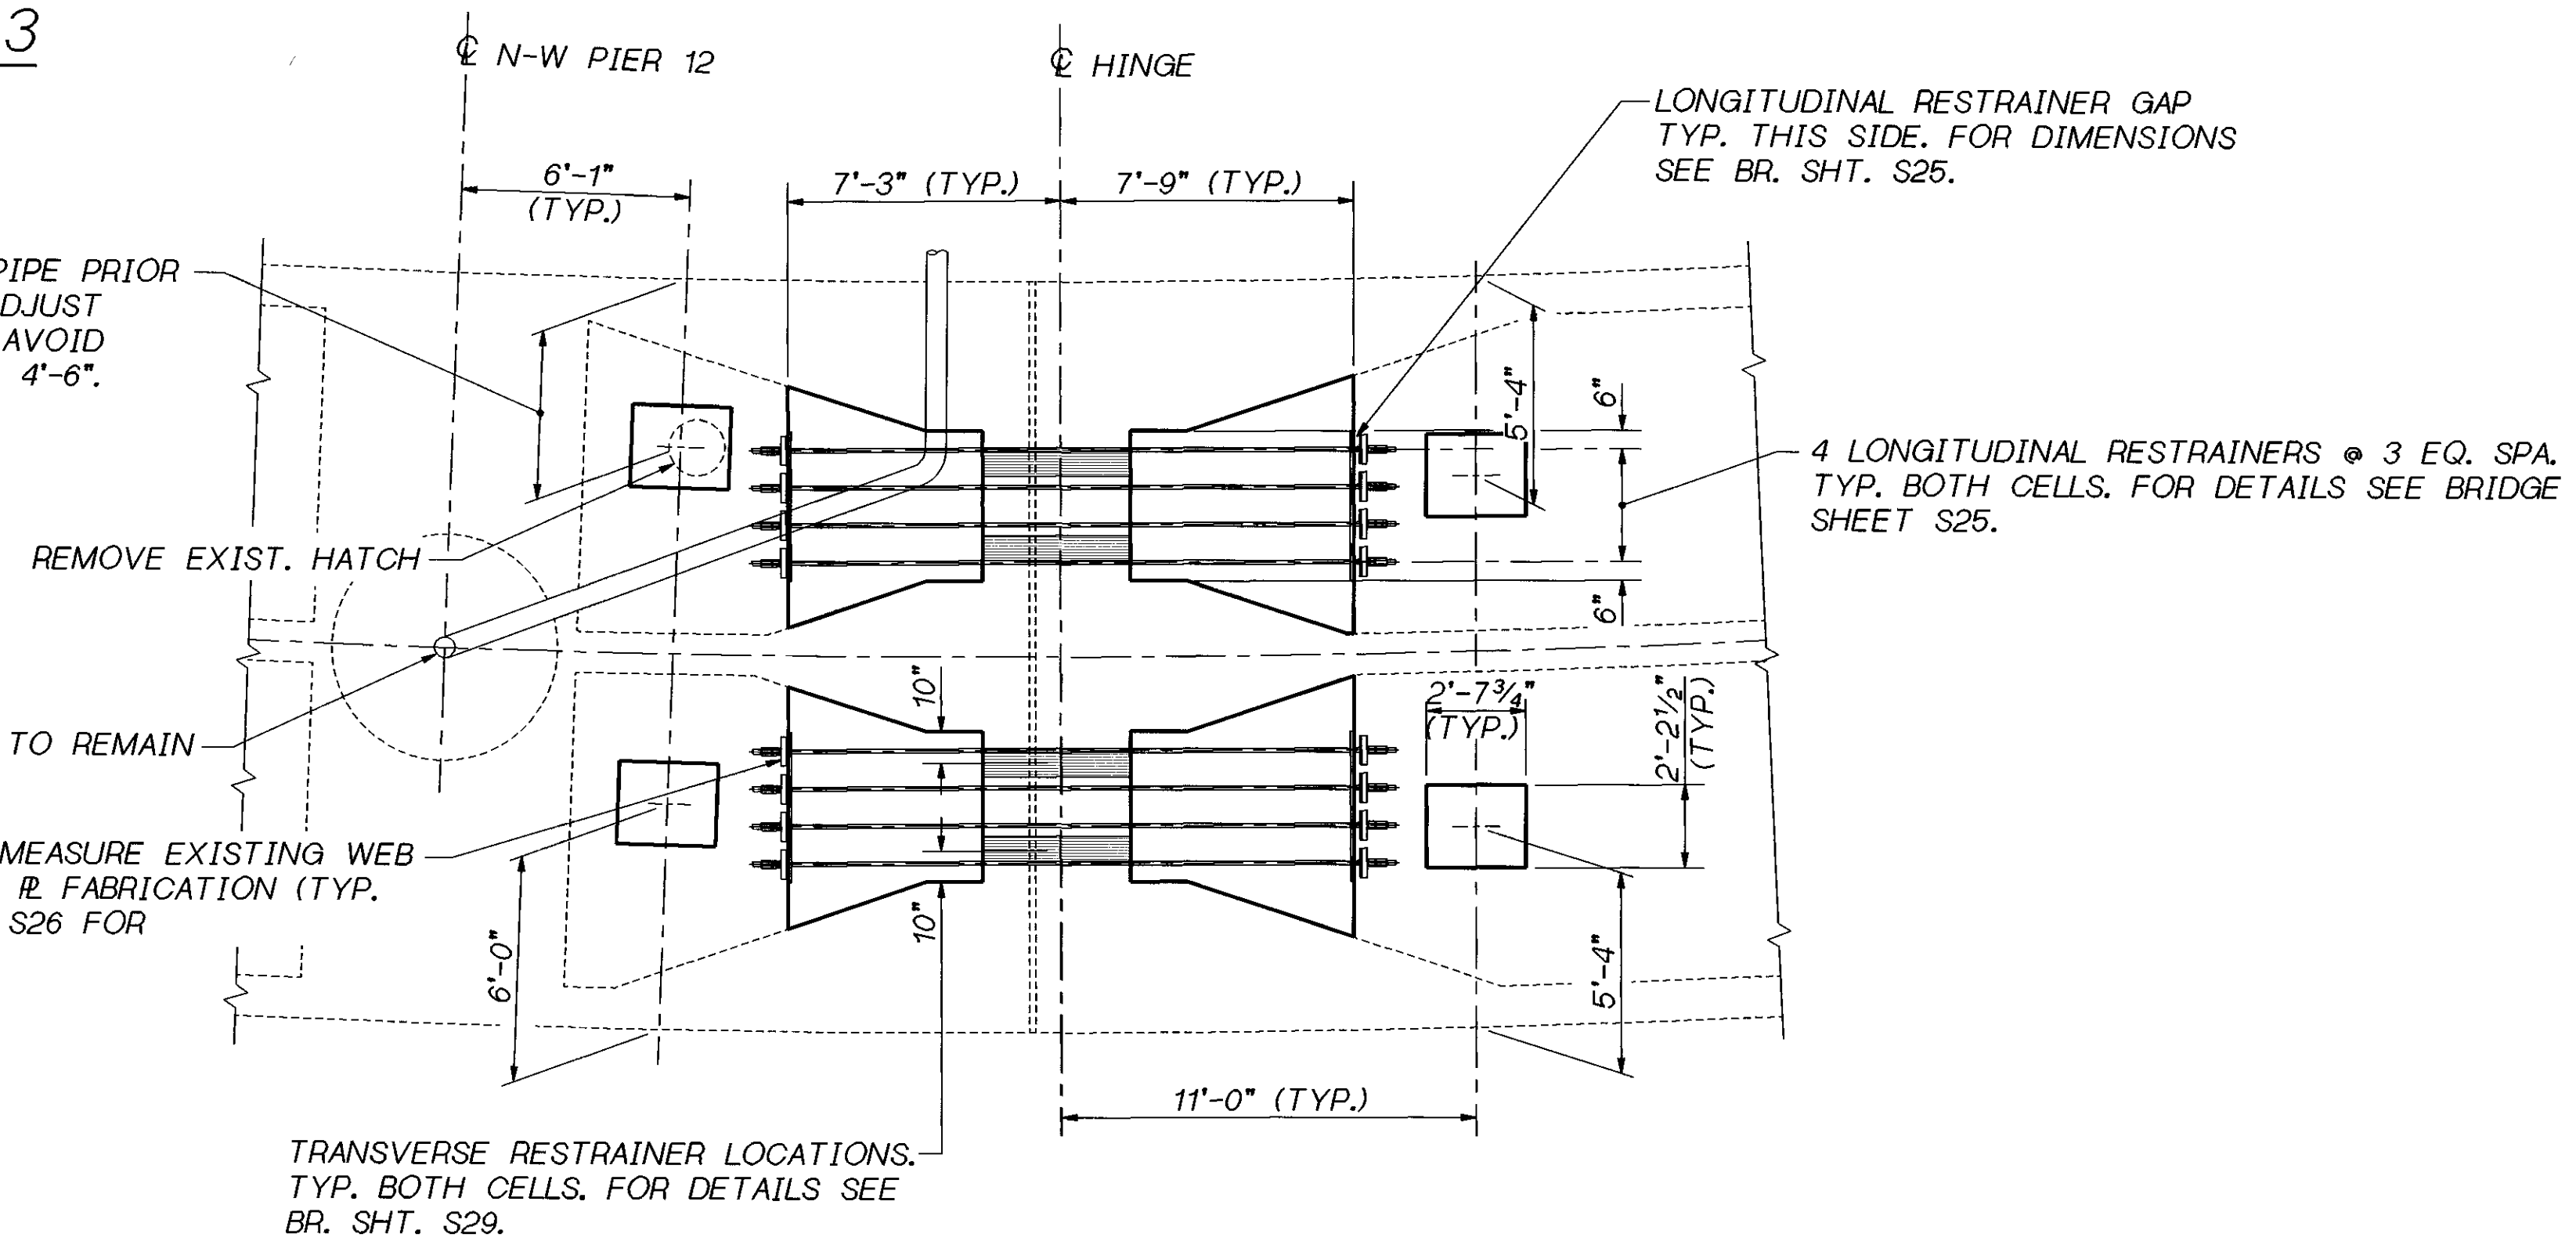

TRANSVERSE RESTRAINER LOCATIONS. TYP. BOTH CELLS. FOR DETAILS SEE BR. SHT. S29.

RESTRAINER LAYOUT - N-W 4

FOR REINFORCEMENT DETAILS SEE BR. SHT. S22. RESTRAINERS ARE NORMAL TO ϕ HINGE.

SR JOB NO. SHEET S17

Bridge Design Engr.	C. C. RUTH								
Supervisor	J. A. VAN LUND								
Designed By	J. MERTH	2/96							
Checked By	J. WEI	2/96							
Detailed By	V.B. SCHICCHI	2/96							
Bridge Projects Engr.									
Prelim. Plan By									
Architect/Specialist									

REGION NO.	STATE	FED. AID PROJ. NO.	SHEET NO.	TOTAL SHEETS
10	WASH.			
JOB NUMBER				
96W020				
DATE	REVISION	BY	APP'D	
				4944

BRIDGE AND STRUCTURES OFFICE

6/5/96
SUPERVISING
BRIDGE
ENGINEER

6-5-96
BRIDGE
DESIGN
ENGINEER

JOHN A. VAN LUND
REGISTERED PROFESSIONAL ENGINEER
EXPIRES 12/23/97

CHARLES C. RUTH
REGISTERED PROFESSIONAL ENGINEER
EXPIRES 5/23/98


Washington State
Department of
Transportation

SR 405
WOODINVILLE INTERCHANGE
HOV WIDENING
SEISMIC RETROFIT

RESTRAINER LAYOUTS
N-W 3, N-W 4

BRIDGE SHEET NO. S17
SHEET 427 OF 452 SHEETS


SR 405 JOB NO. 7056 SHEET S22

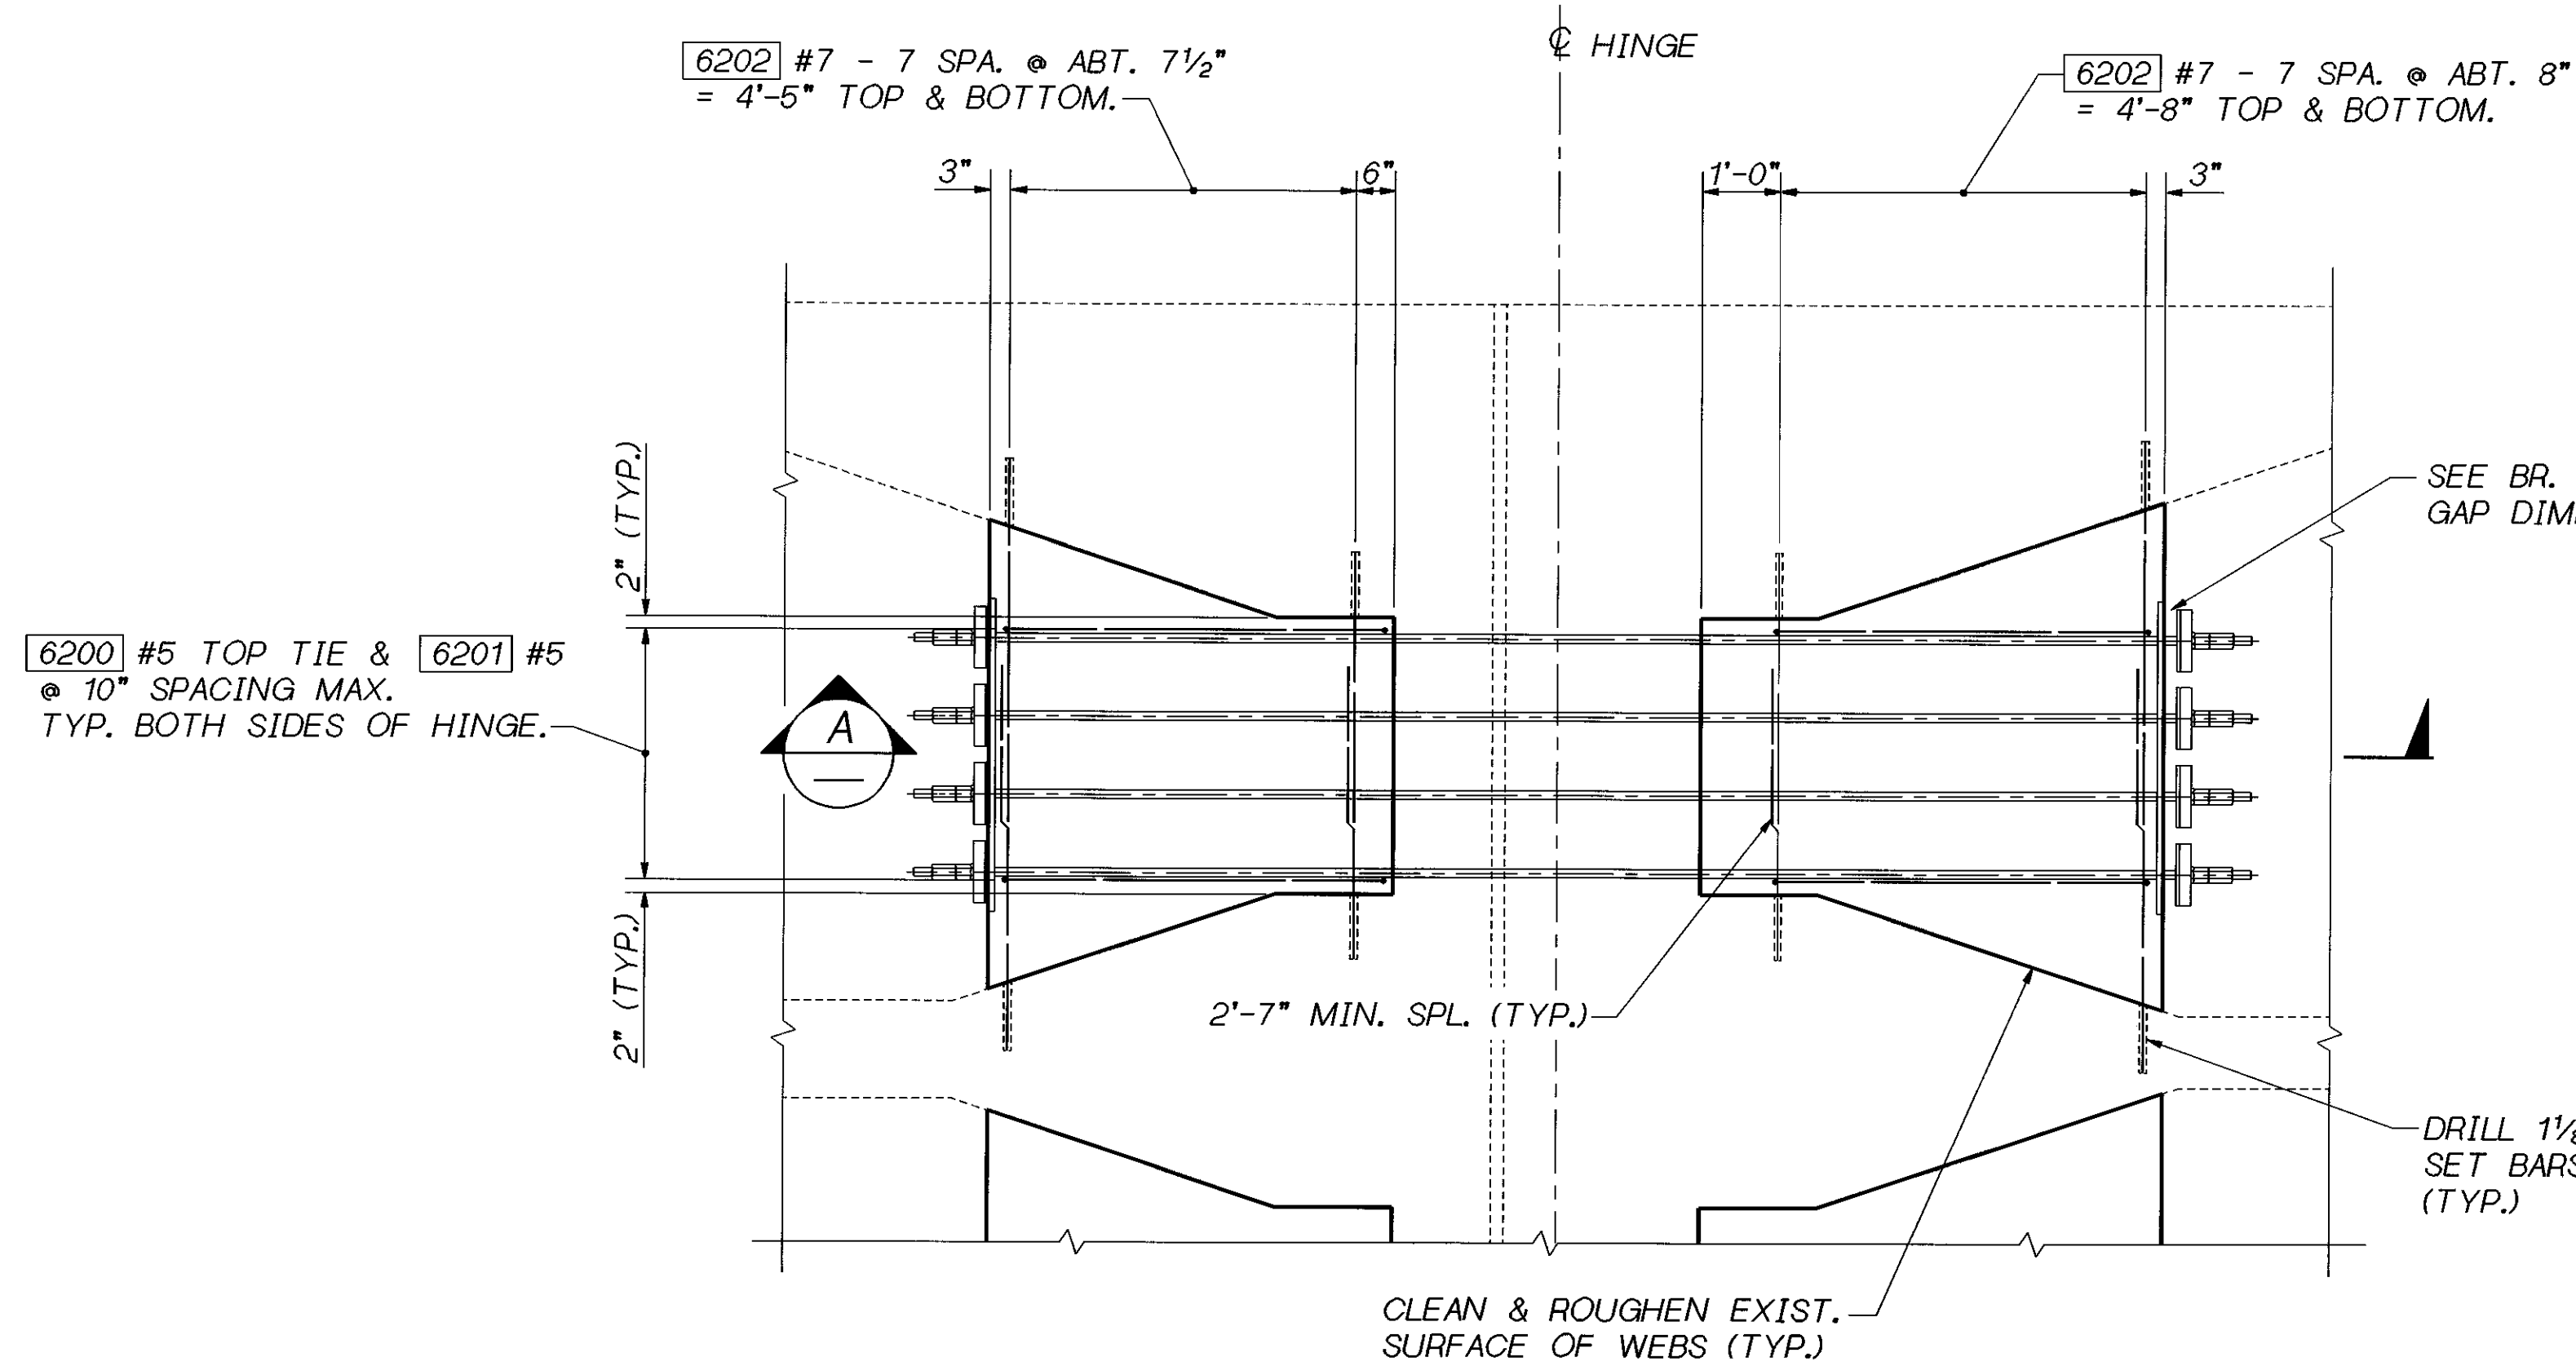

TYPICAL REINFORCEMENT
REINF. FOR 3 RESTRAINERS PER CELL SIMILAR.

FOR HINGES LL-1, LL-2, LL-3, N-W 1, N-W 2, N-W 3,
N-W 4, S-E 1, N-E 1, N-E 2, W-S 1,
W-S 2, W-S 3, W-S 4 & W-S 5.

* CONTRACTOR SHALL LOCATE EXISTING WEB REINFORCEMENT PRIOR TO DRILLING. ADJUST LOCATION OF DRILLED HOLE TO CLEAR EXISTING REINFORCEMENT.

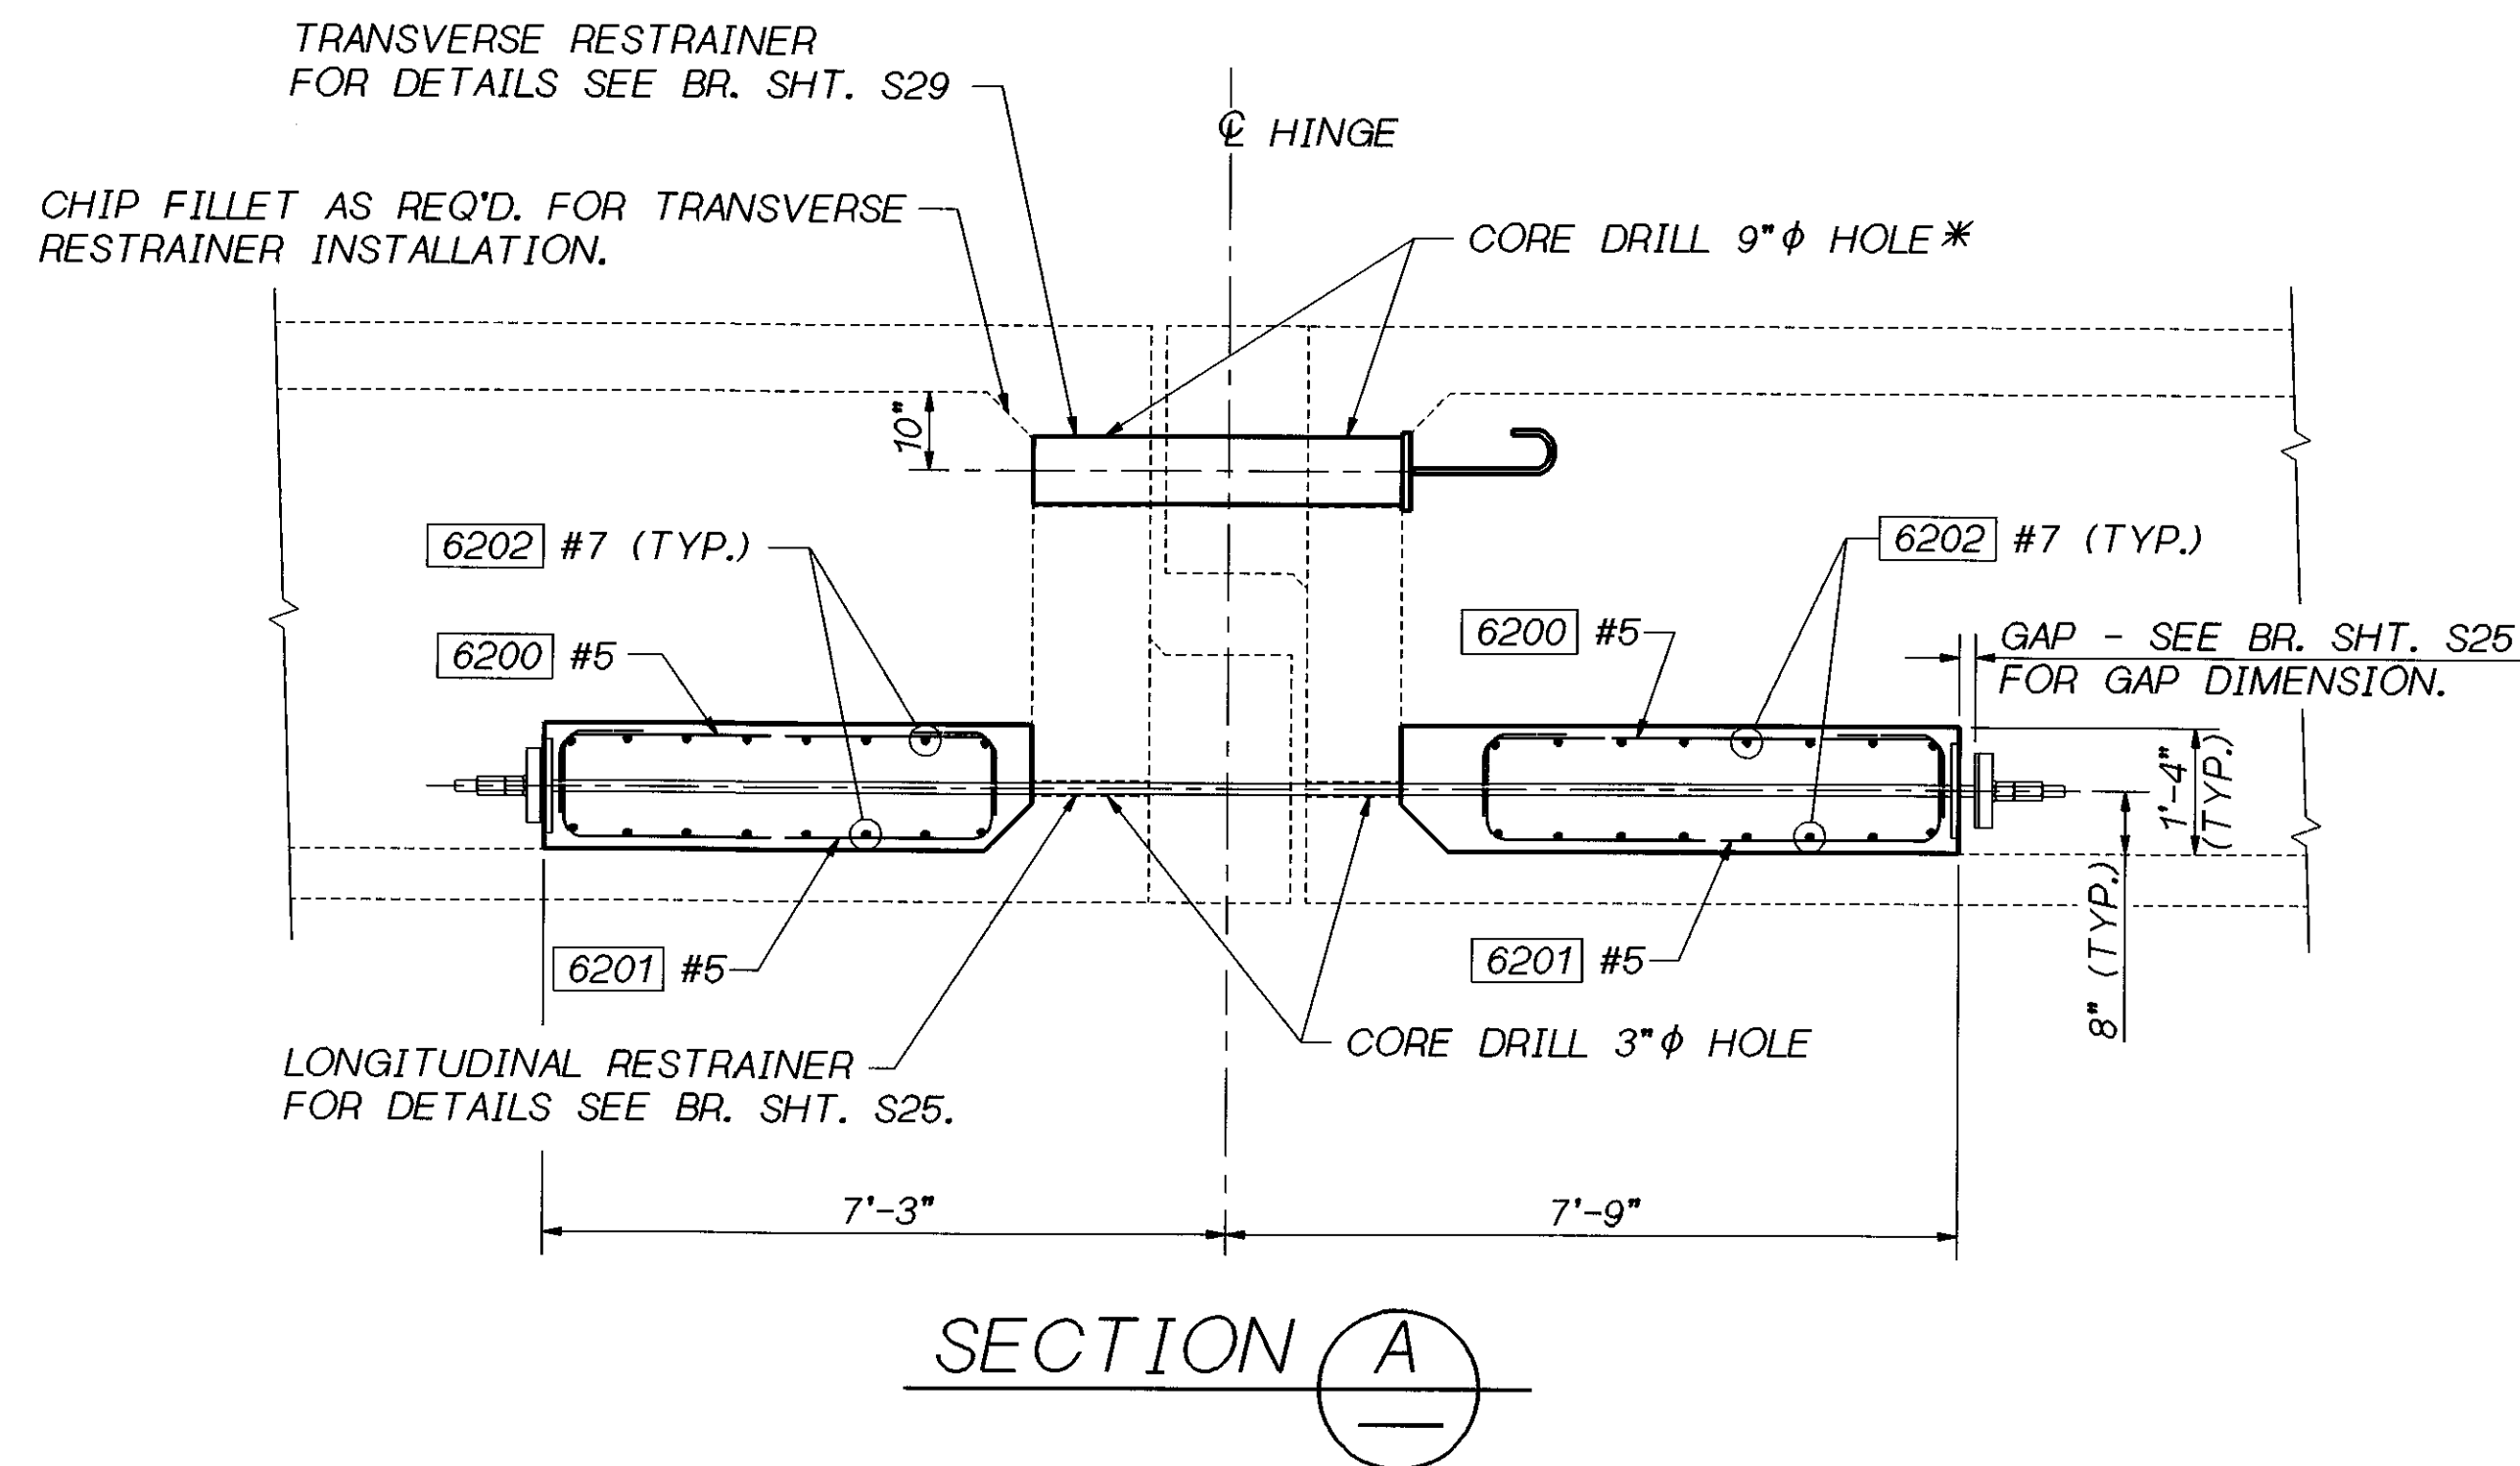

Bridge Design Engr. C. C. RUTH				REGION NO.	STATE	FED. AID PROJ. NO.	SHEET NO.	TOTAL SHEETS
Supervisor J. A. VAN LUND				10	WASH.			
Designed By J. MERTH	2/96			JOB NUMBER				
Checked By J. WEI	2/96			96W020				
Detailed By V.B. SCHICCHI	11/95	2/96						
Bridge Projects Engr.								
Prelim. Plan By								
Architect/Specialist	DATE	REVISION	BY	APP'D				

BRIDGE AND STRUCTURES OFFICE

6/5/96
SUPERVISING BRIDGE ENGINEER

6-5-96
BRIDGE DESIGN ENGINEER

Washington State Department of Transportation


SR 405
WOODINVILLE INTERCHANGE
HOV WIDENING
SEISMIC RETROFIT

**BOLSTER REINFORCING
TYPICAL DETAILS**

BRIDGE SHEET NO. S22
SHEET 432 OF 452 SHEETS

31-MAY-96

405_70WROOT-1:000000.FGB.RETRO.FGB\FOUR_RESTR_REINF.FGB:1

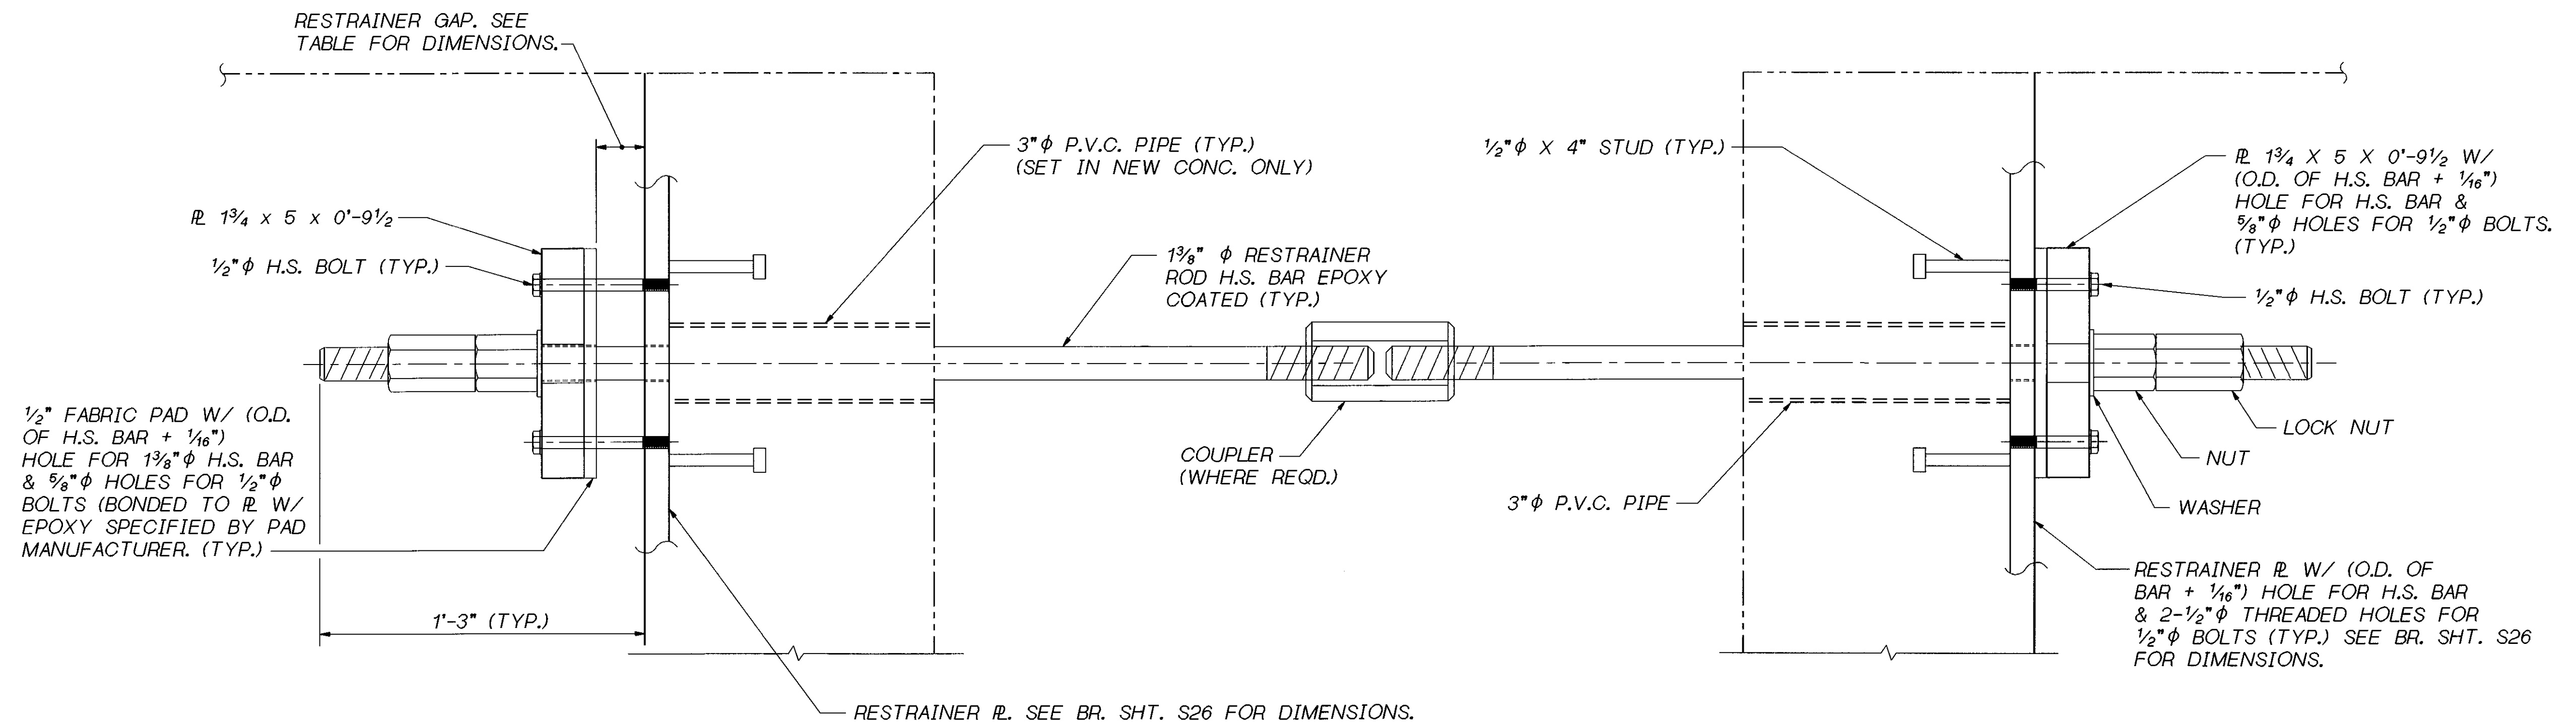

TYPICAL LONGITUDINAL RESTRAINER DETAIL
PLAN VIEW

NOTE:

ALL PLATES AND HARDWARE SHALL BE FABRICATED FROM AASHTO M183 STRUCTURAL STEEL AND SHALL BE HOT-DIPPED GALVANIZED PER AASHTO M111.

LONGIT. RESTR. GAP				
BRIDGE	HINGE #	40 F	64 F	80 F
SB	1	2 1/8"	2 3/4"	3 1/8"
	2	2"	2 5/8"	3"
	3	2"	2 5/8"	3"
S-E	1	1 1/8"	2 1/2"	2 3/4"
N-W	1	1 5/8"	2 1/8"	2 3/8"
	2	1 7/8"	2 3/8"	2 3/4"
	3	1 3/4"	2 1/4"	2 5/8"
	4	1 3/4"	2 3/8"	2 3/4"
N-E	1	1 1/2"	2"	2 1/4"
	2	1 1/2"	2"	2 1/8"
W-S	1	2 1/8"	2 3/4"	3 1/4"
	2	2 1/4"	3"	3 3/8"
	3	2 3/8"	3 1/8"	3 1/2"
	4	2 3/8"	3 1/8"	3 5/8"
	5	2 1/4"	3"	3 3/8"
E-S	1	1 3/4"	2 1/4"	2 5/8"

NOTE: TEMPERATURE IN ABOVE TABLE REFERS TO TEMPERATURE OF AMBIENT AIR AT TIME OF INSTALLATION.

LONGITUDINAL RESTRAINER SHOWN IS TYPICAL FOR HINGES LL-1, LL-2, LL-3, N-W 1, N-W 2, N-W 3, N-W 4, N-E 1, N-E 2, S-E 1, W-S 1, W-S 2, W-S 3, W-S 4, W-S 5 & E-S 1

SR 405 JOB NO. 7056 SHEET S25

Bridge Design Engr. C. C. RUTH									
Supervisor J. A. VAN LUND									
Designed By J. MERTH	2/96								
Checked By J. WEI	2/96								
Detailed By V.B. SCHICCHI	2/96								
Bridge Projects Engr.									
Prelim. Plan By									
Architect/Specialist	DATE	REVISION	BY	APP'D	4944				

REGION NO.	STATE	FED. AID PROJ. NO.	SHEET NO.	TOTAL SHEETS
10	WASH.			
JOB NUMBER				
96W020				

BRIDGE AND STRUCTURES OFFICE

JOHN A. VAN LUND
PROFESSIONAL ENGINEER

CHARLES C. RUTH
PROFESSIONAL ENGINEER


**Washington State
Department of
Transportation**

SR 405
WOODINVILLE INTERCHANGE
HOV WIDENING
SEISMIC RETROFIT


RESTRAINER DETAILS
LONGITUDINAL

BRIDGE SHEET NO.
S25


SHEET
435
OF
452
SHEETS

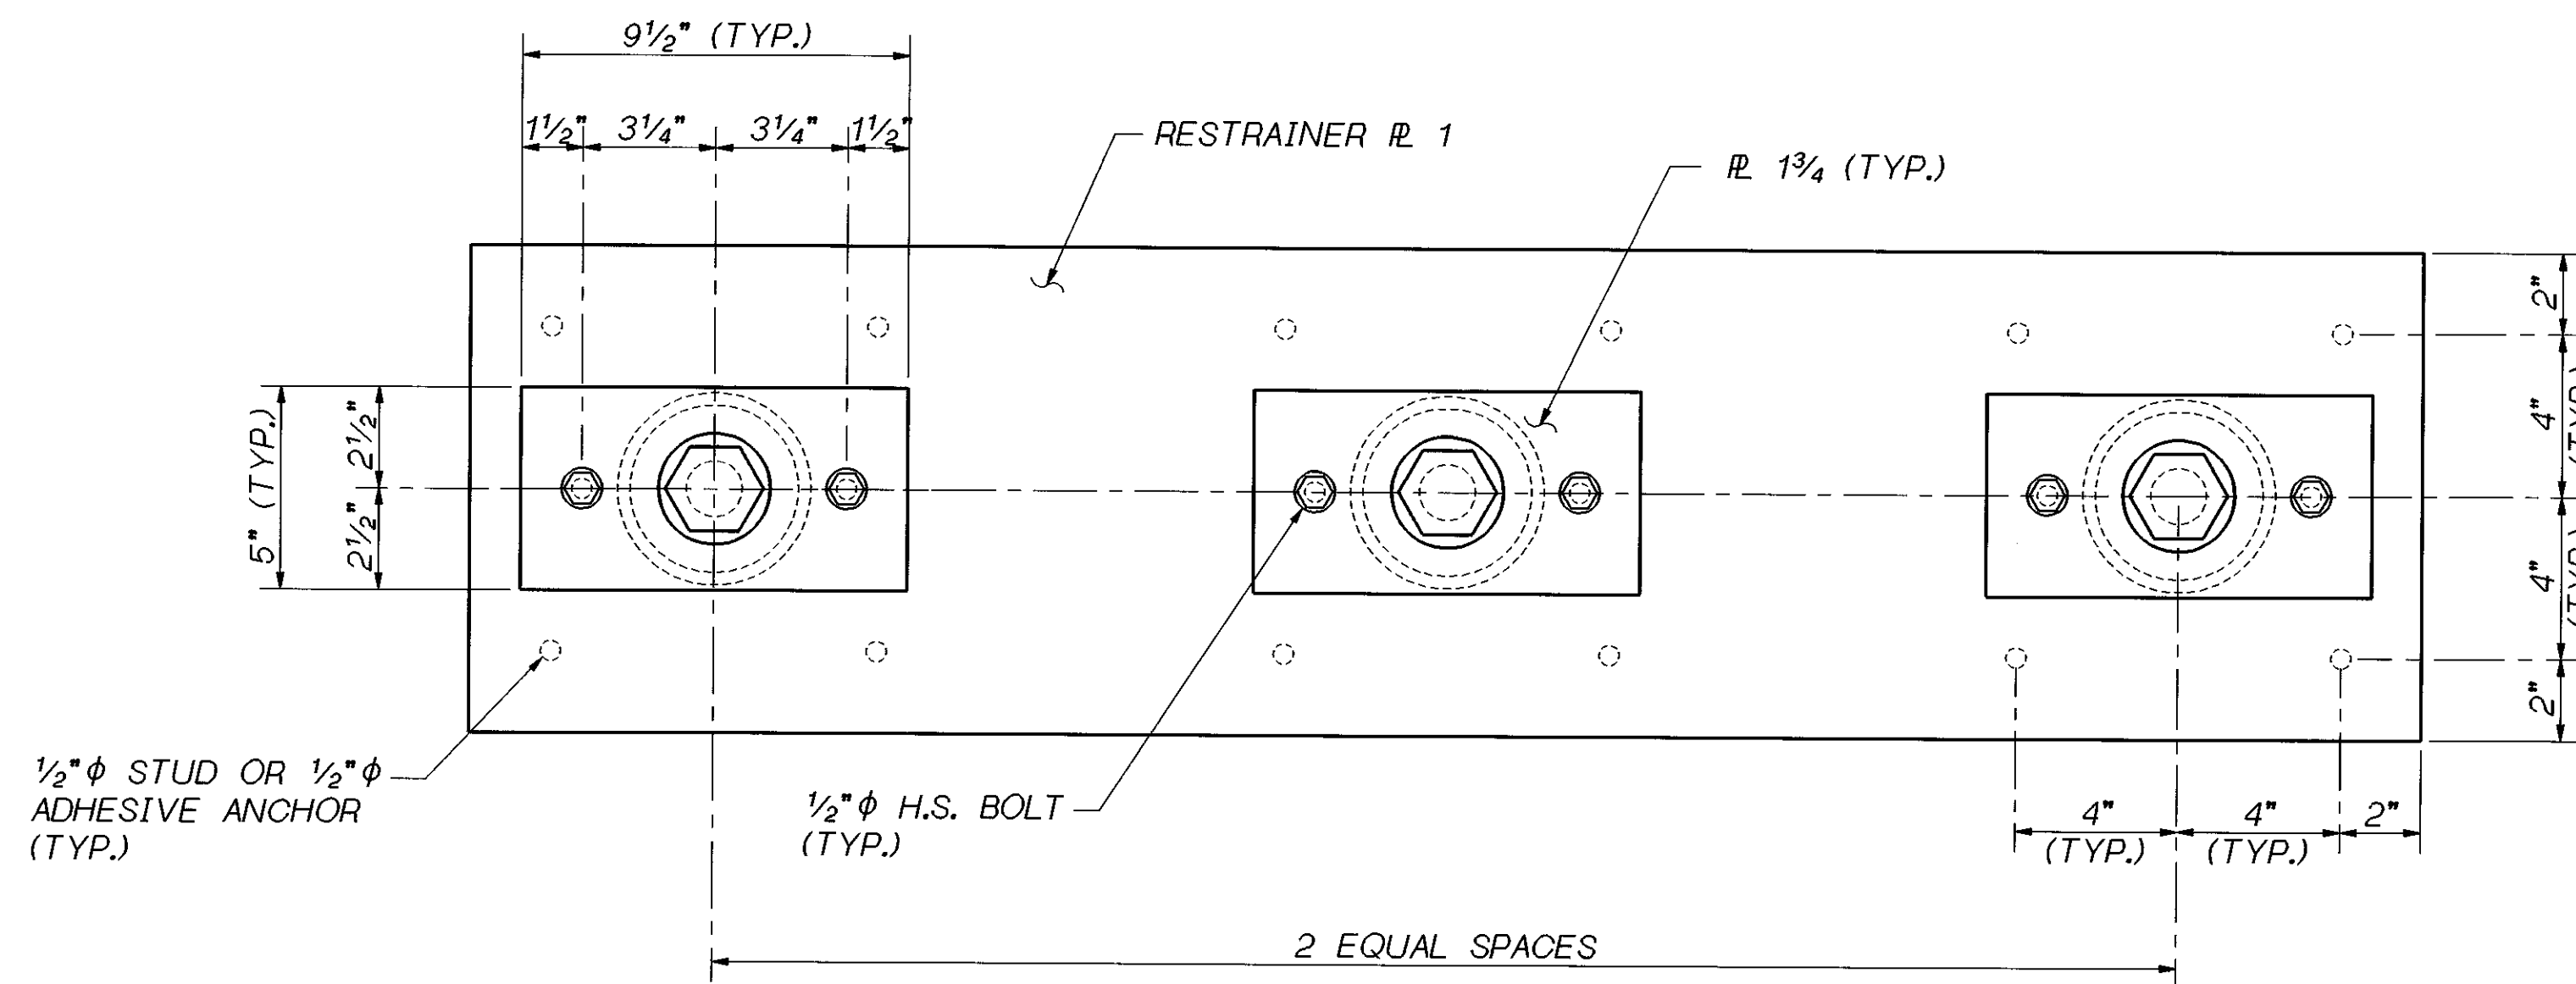

LONGITUDINAL RESTRAINER - END VIEW
 TYP. FOR 3 RESTRAINER ASSEMBLY. CONTRACTOR SHALL FIELD MEASURE WEB GAP PRIOR TO RESTRAINER PLATE FABRICATION.

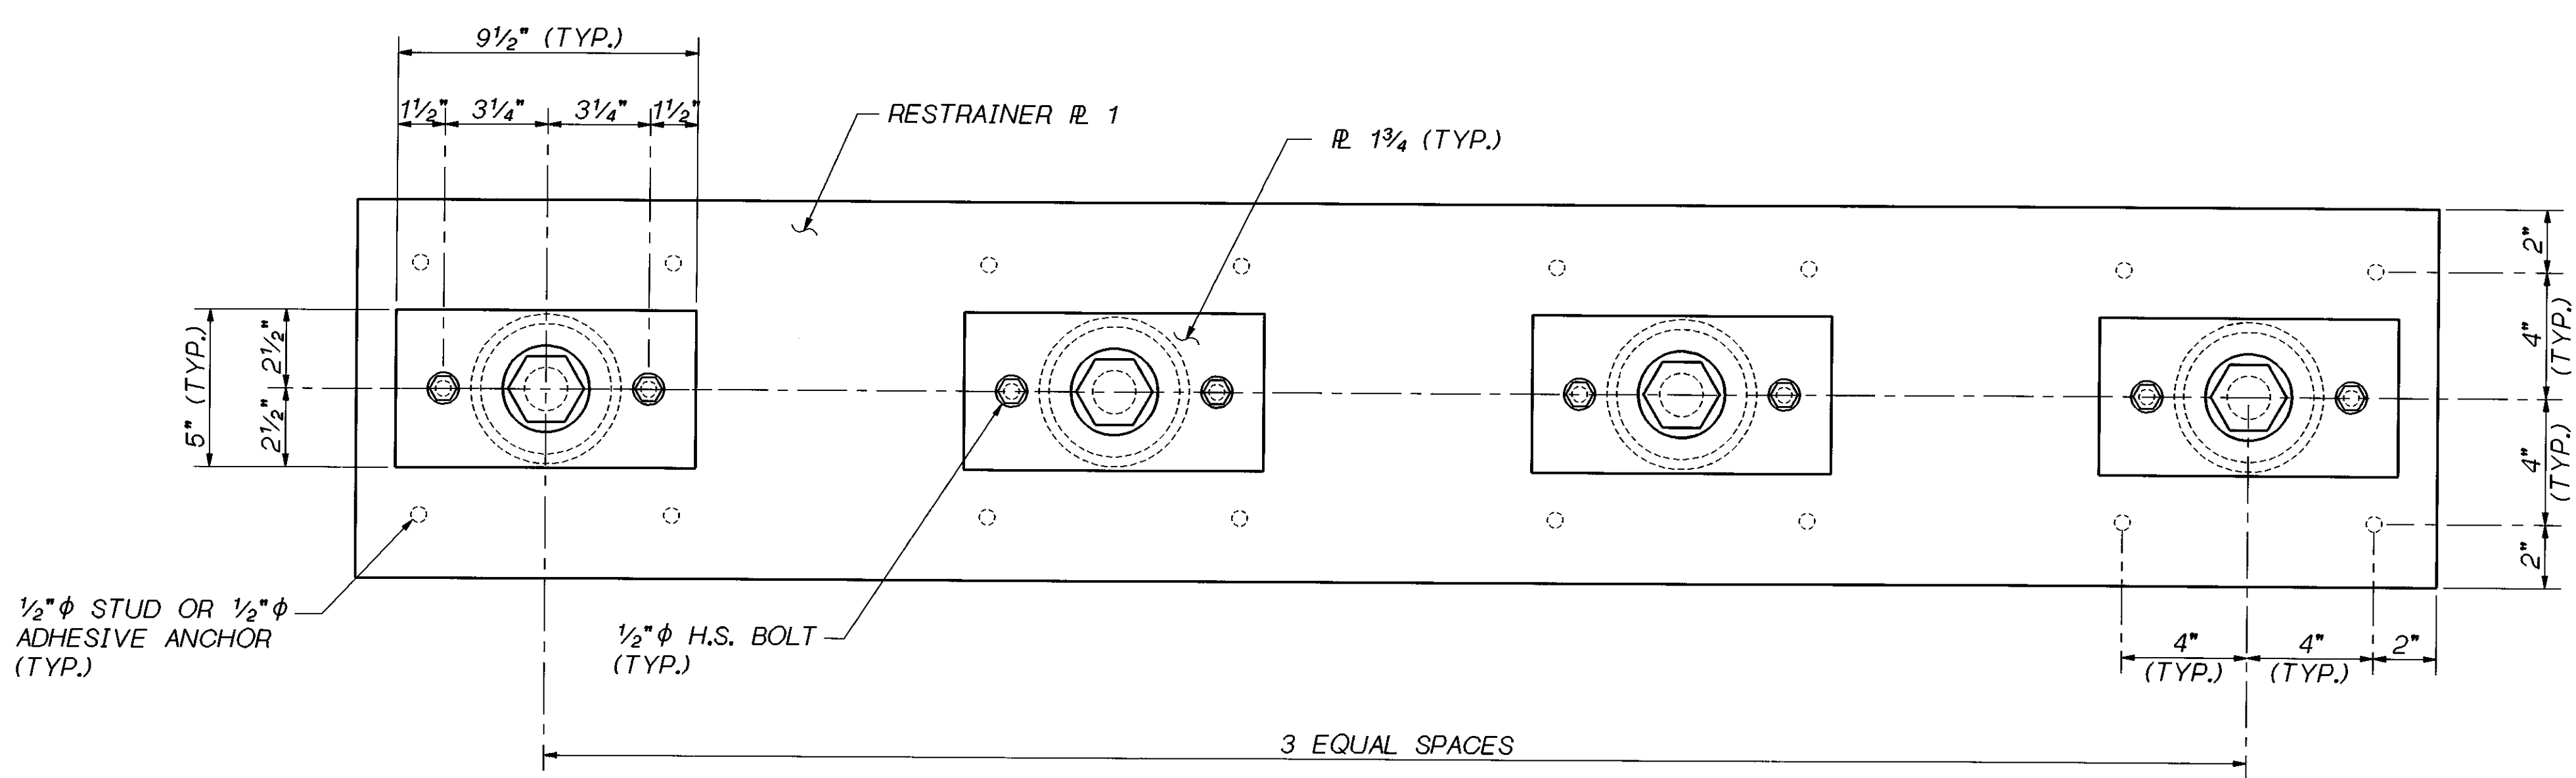

LONGITUDINAL RESTRAINER - END VIEW
 TYP. FOR 4 RESTRAINER ASSEMBLY. CONTRACTOR SHALL FIELD MEASURE WEB GAP PRIOR TO RESTRAINER PLATE FABRICATION.

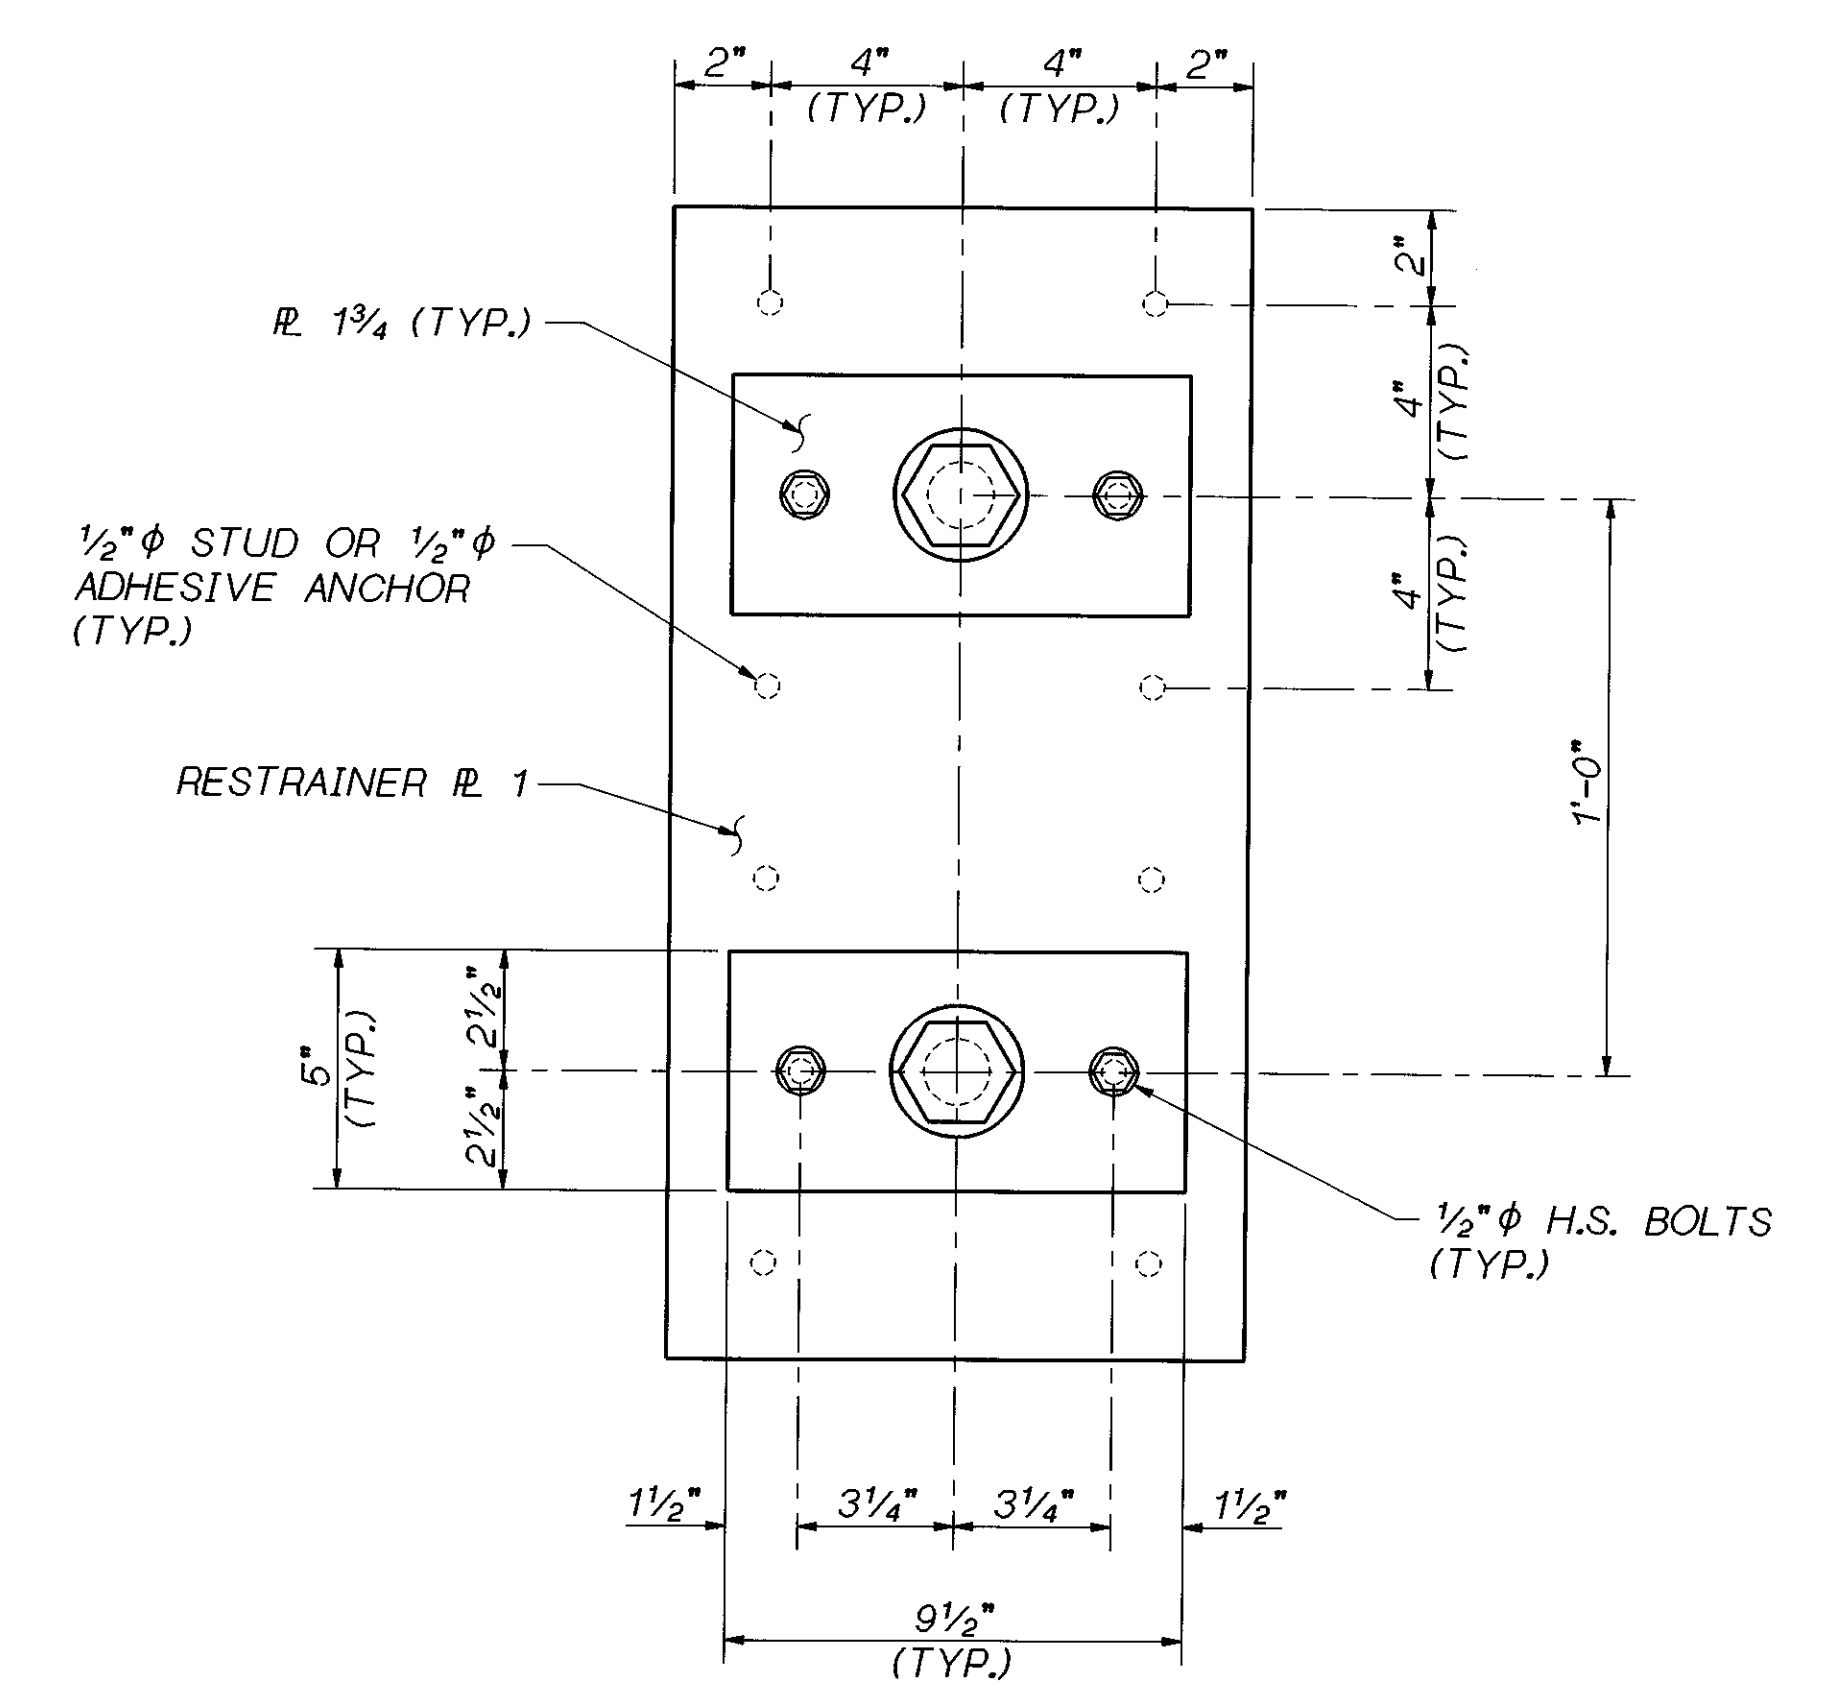

LONGITUDINAL RESTRAINER END VIEW
 TYPICAL FOR WIDENED SECTION

PLATES SHOWN ARE TYPICAL FOR HINGES
 LL-1, LL-2, LL-3, N-W 1, N-W 2, N-W 3,
 N-W 4, N-E 1, N-E 2, S-E 1, W-S 1, W-S 2,
 W-S 3, W-S 4, W-S 5 & E-S 1.

SR 405 JOB NO. 1056 SHEET S26

Bridge Design Engr.	C. C. RUTH	REGION NO.		STATE	WASH.	FED. AID PROJ. NO.		SHEET NO.		TOTAL SHEETS	
Supervisor	J. A. VAN LUND										
Designed By	J. MERTH										
Checked By	J. WEI										
Detailed By	V.B. SCHICCHI										
Bridge Projects Engr.											
Prelim. Plan By											
Architect/Specialist		DATE		REVISION		BY	APP'D				

REGION NO.	10	STATE	WASH.	FED. AID PROJ. NO.		SHEET NO.		TOTAL SHEETS	
JOB NUMBER	96W020								
DATE	4/9/94								


BRIDGE AND STRUCTURES OFFICE

J. A. VAN LUND
 REGISTERED PROFESSIONAL ENGINEER
 EXPIRES 12/23/97

6/5/96
 SUPERVISING BRIDGE ENGINEER


CHARLES C. RUTH
 REGISTERED PROFESSIONAL ENGINEER
 EXPIRES 5/3/98

6-5-96
 BRIDGE DESIGN ENGINEER

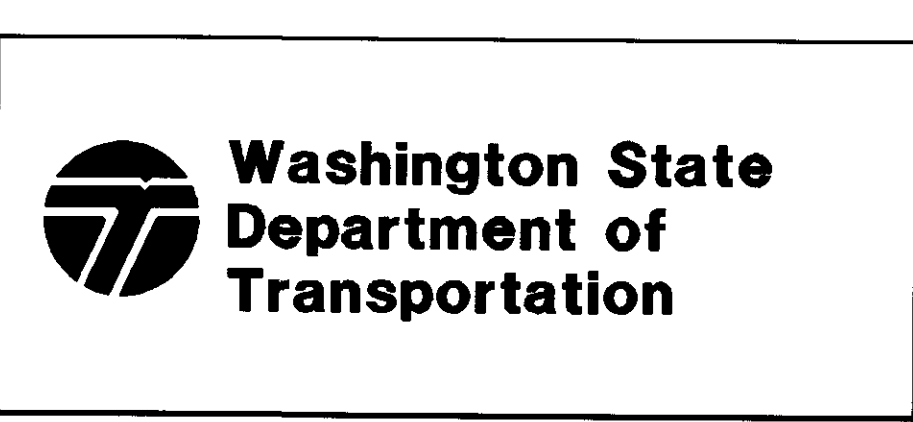


SR 405
 WOODINVILLE INTERCHANGE
 HOV WIDENING
 SEISMIC RETROFIT
**RESTRAINER DETAILS
 PLATES**


BRIDGE SHEET NO. S26
 SHEET 436 OF 452 SHEETS

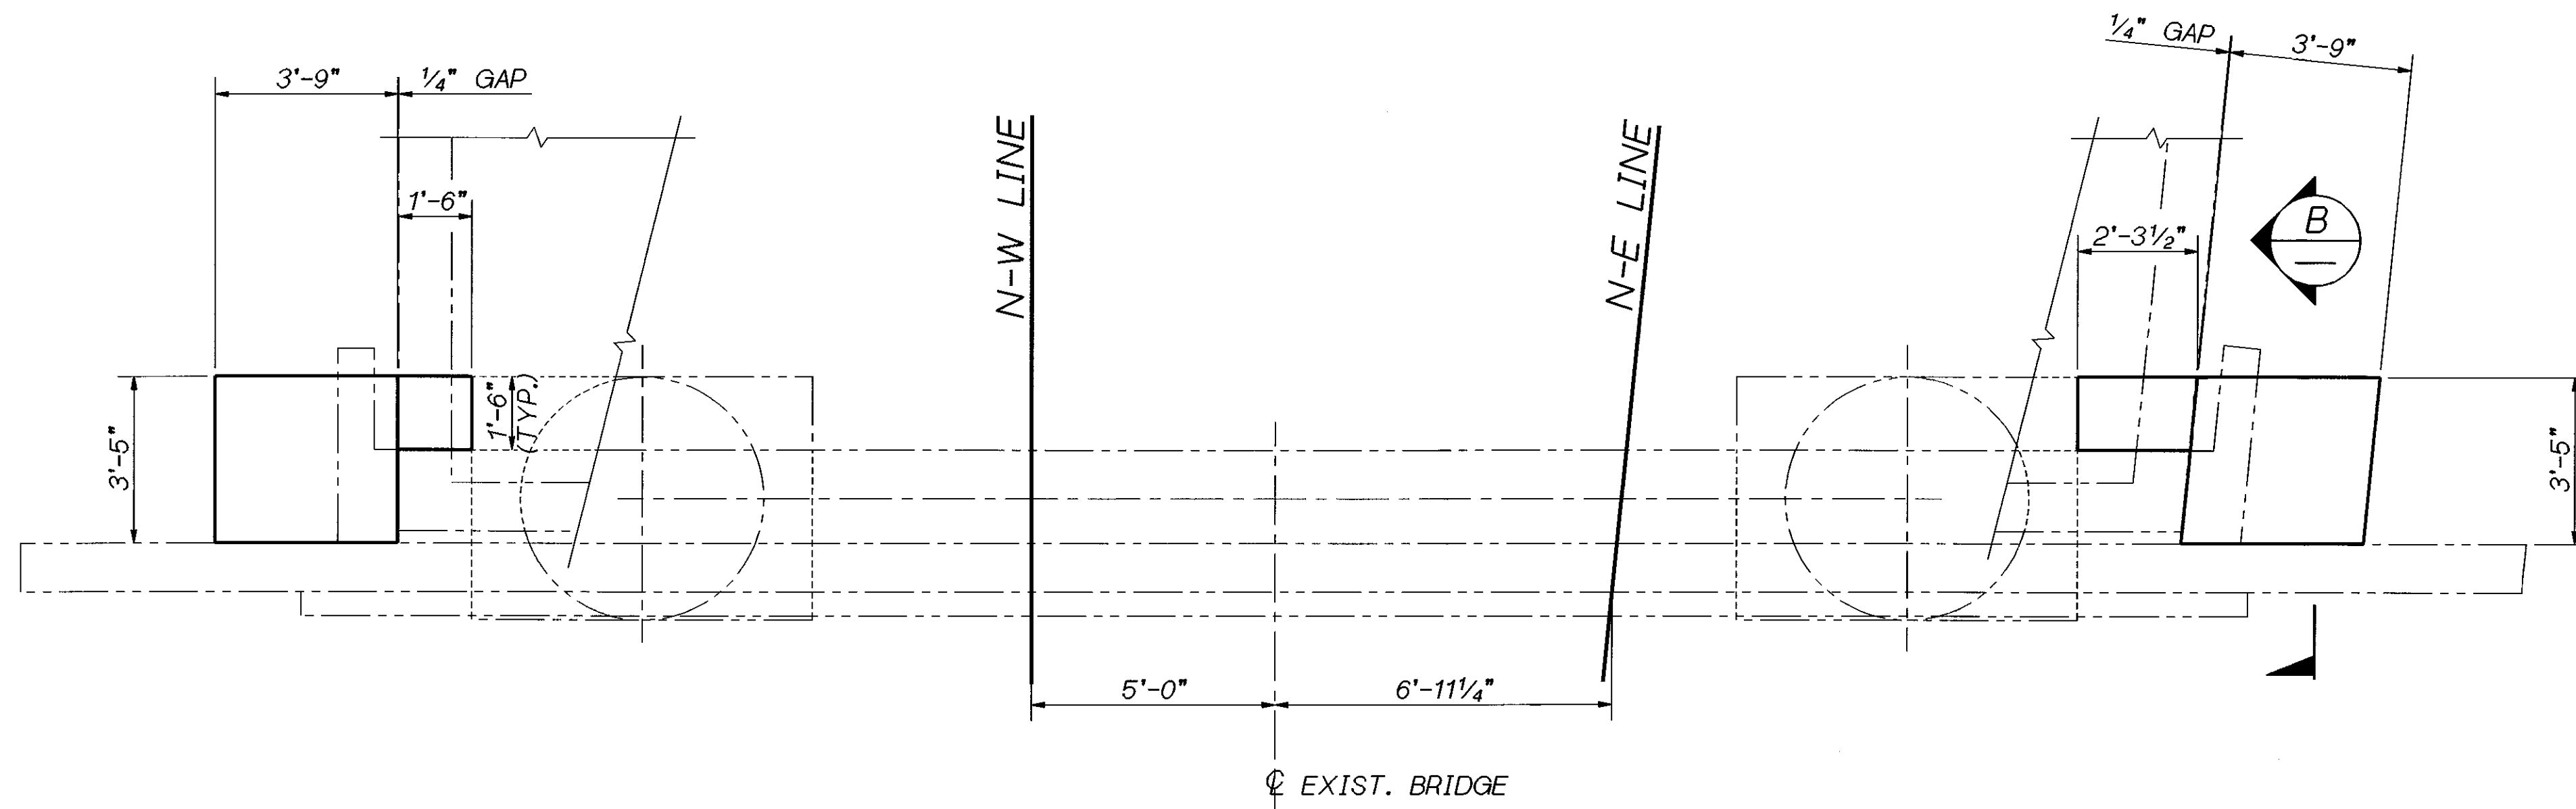


PLAN

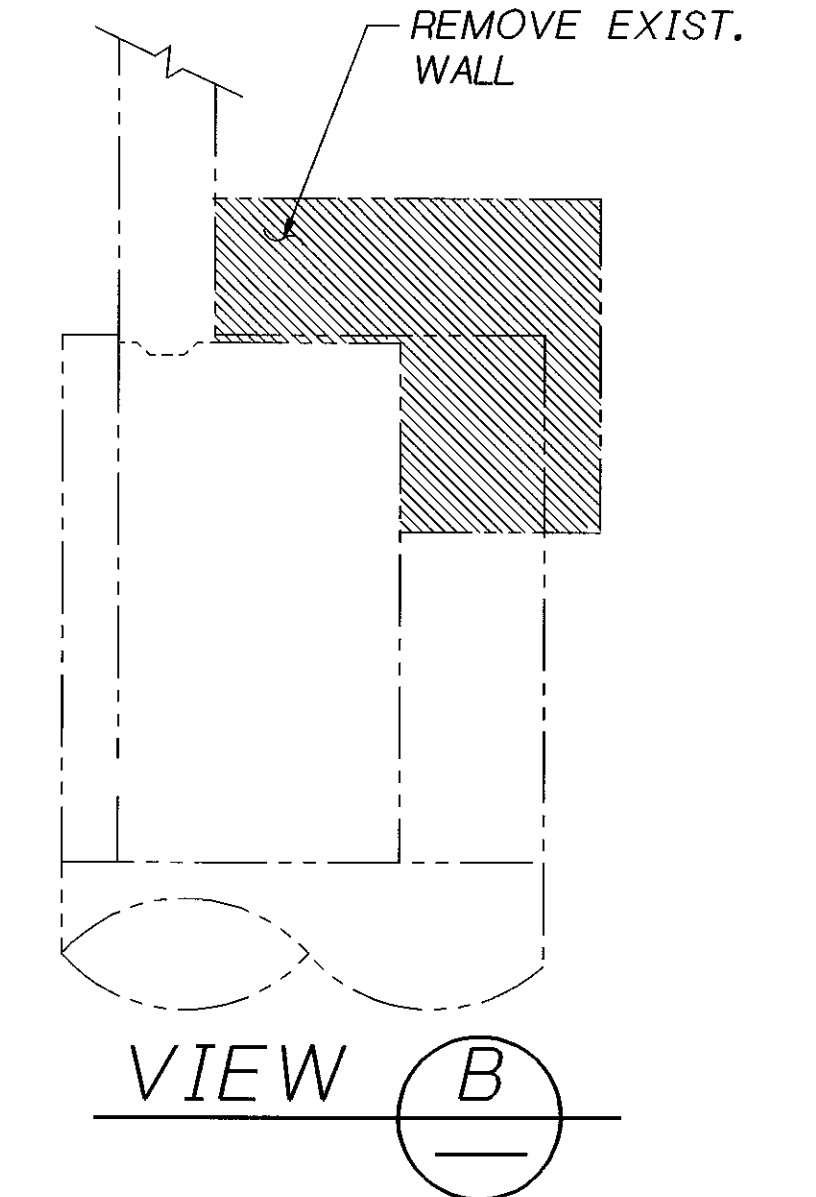

VIEW B
REMOVAL DETAIL

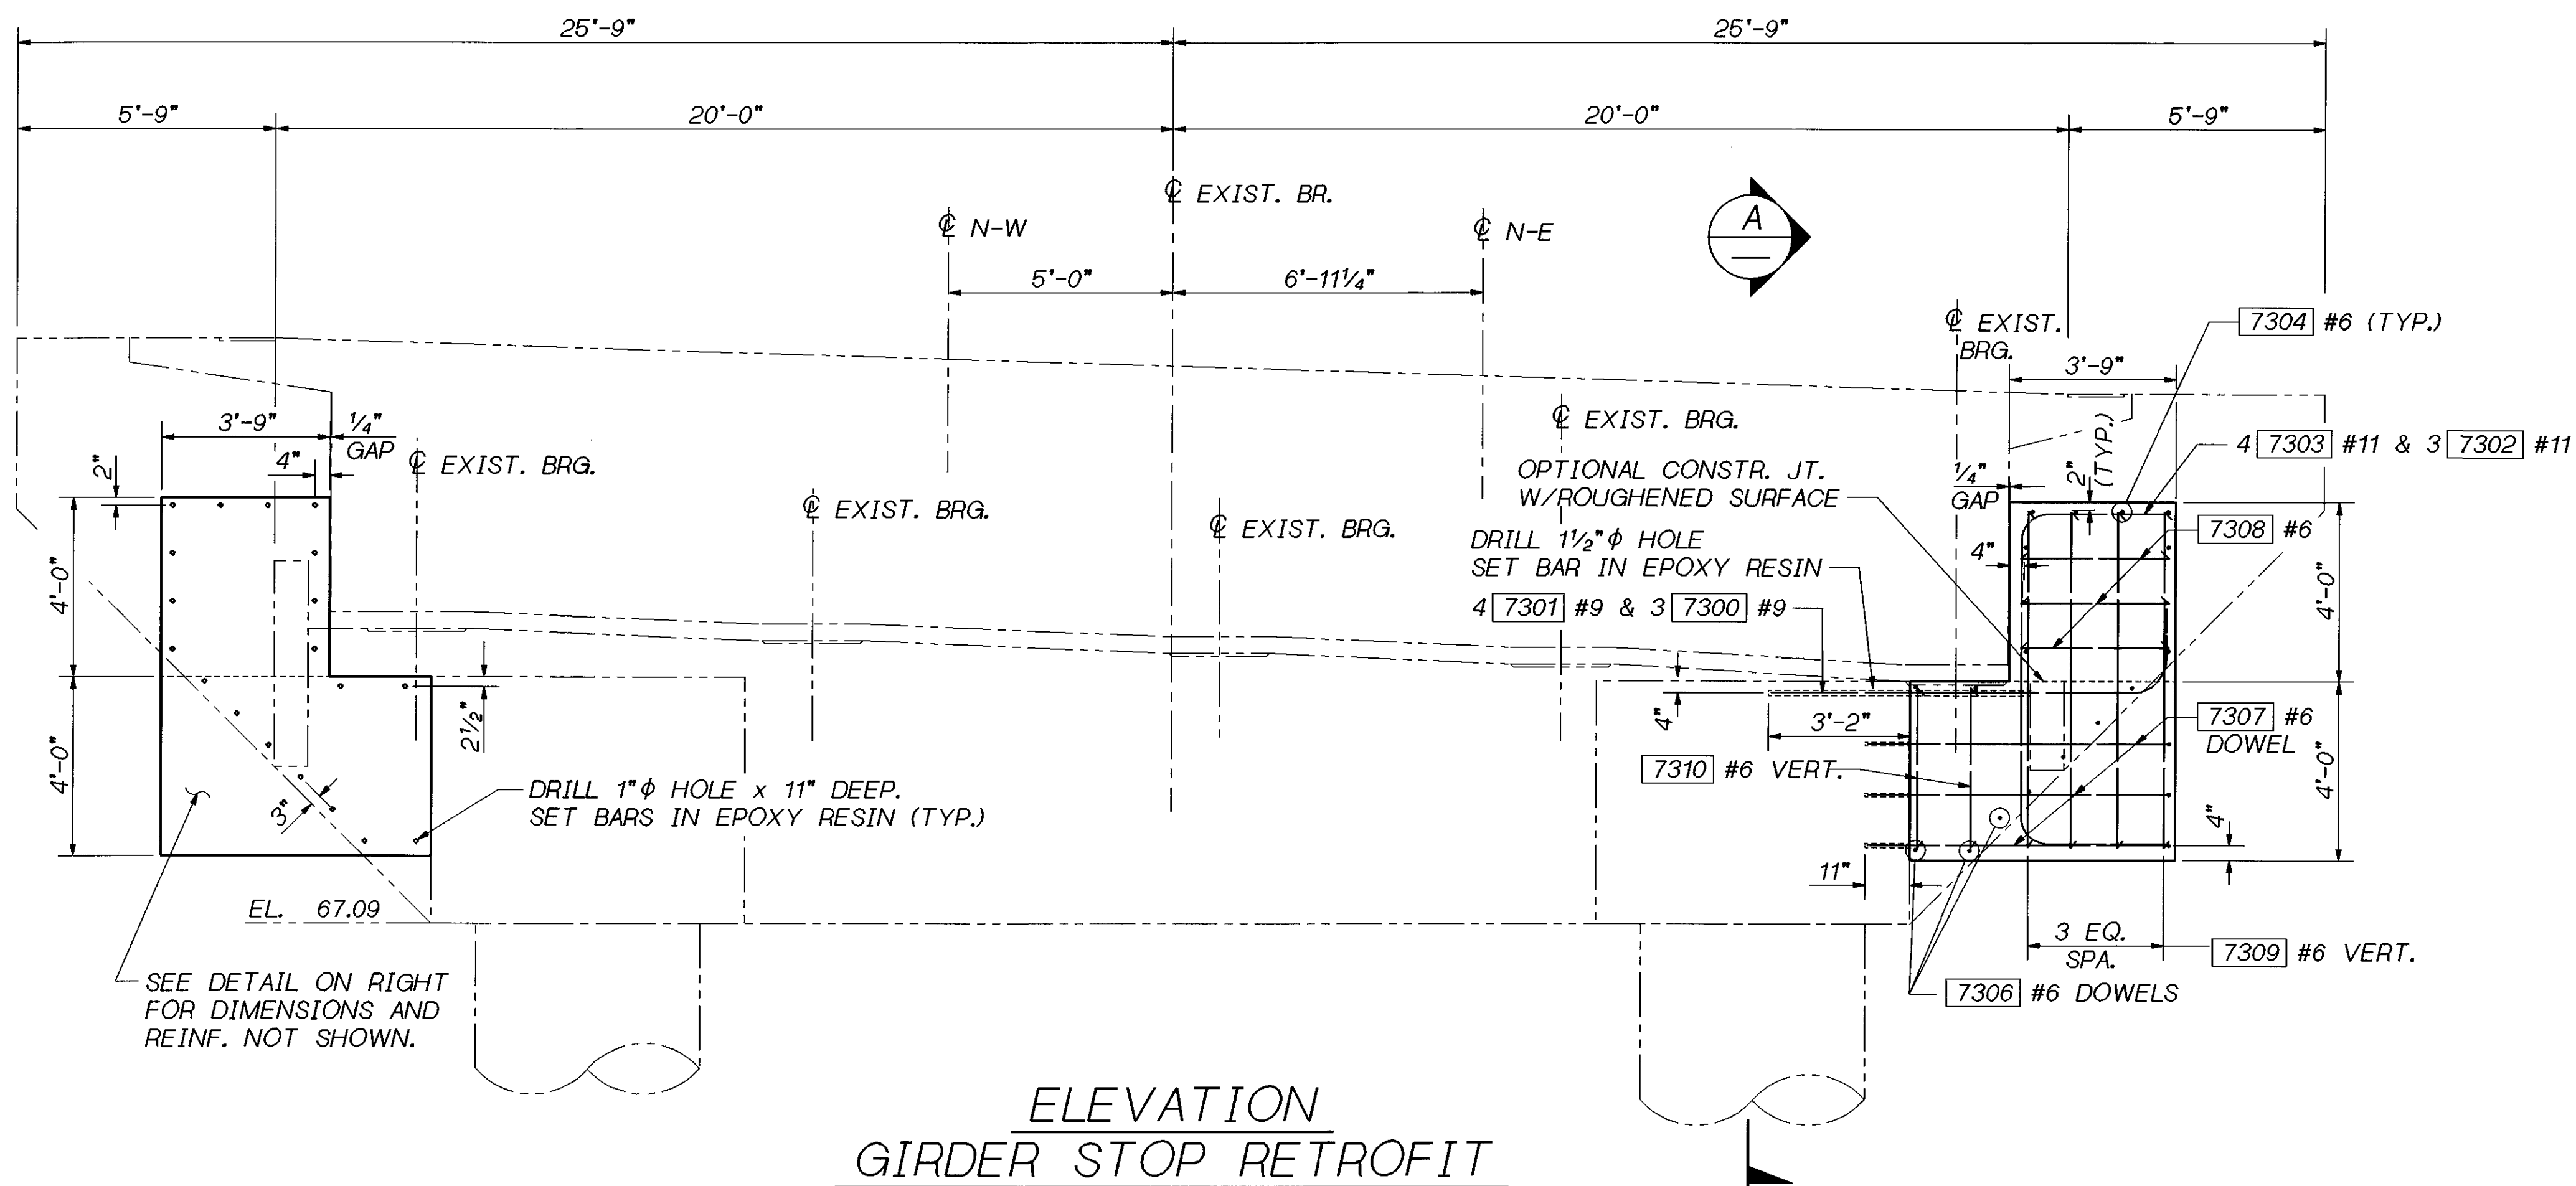

ELEVATION
GIRDER STOP RETROFIT

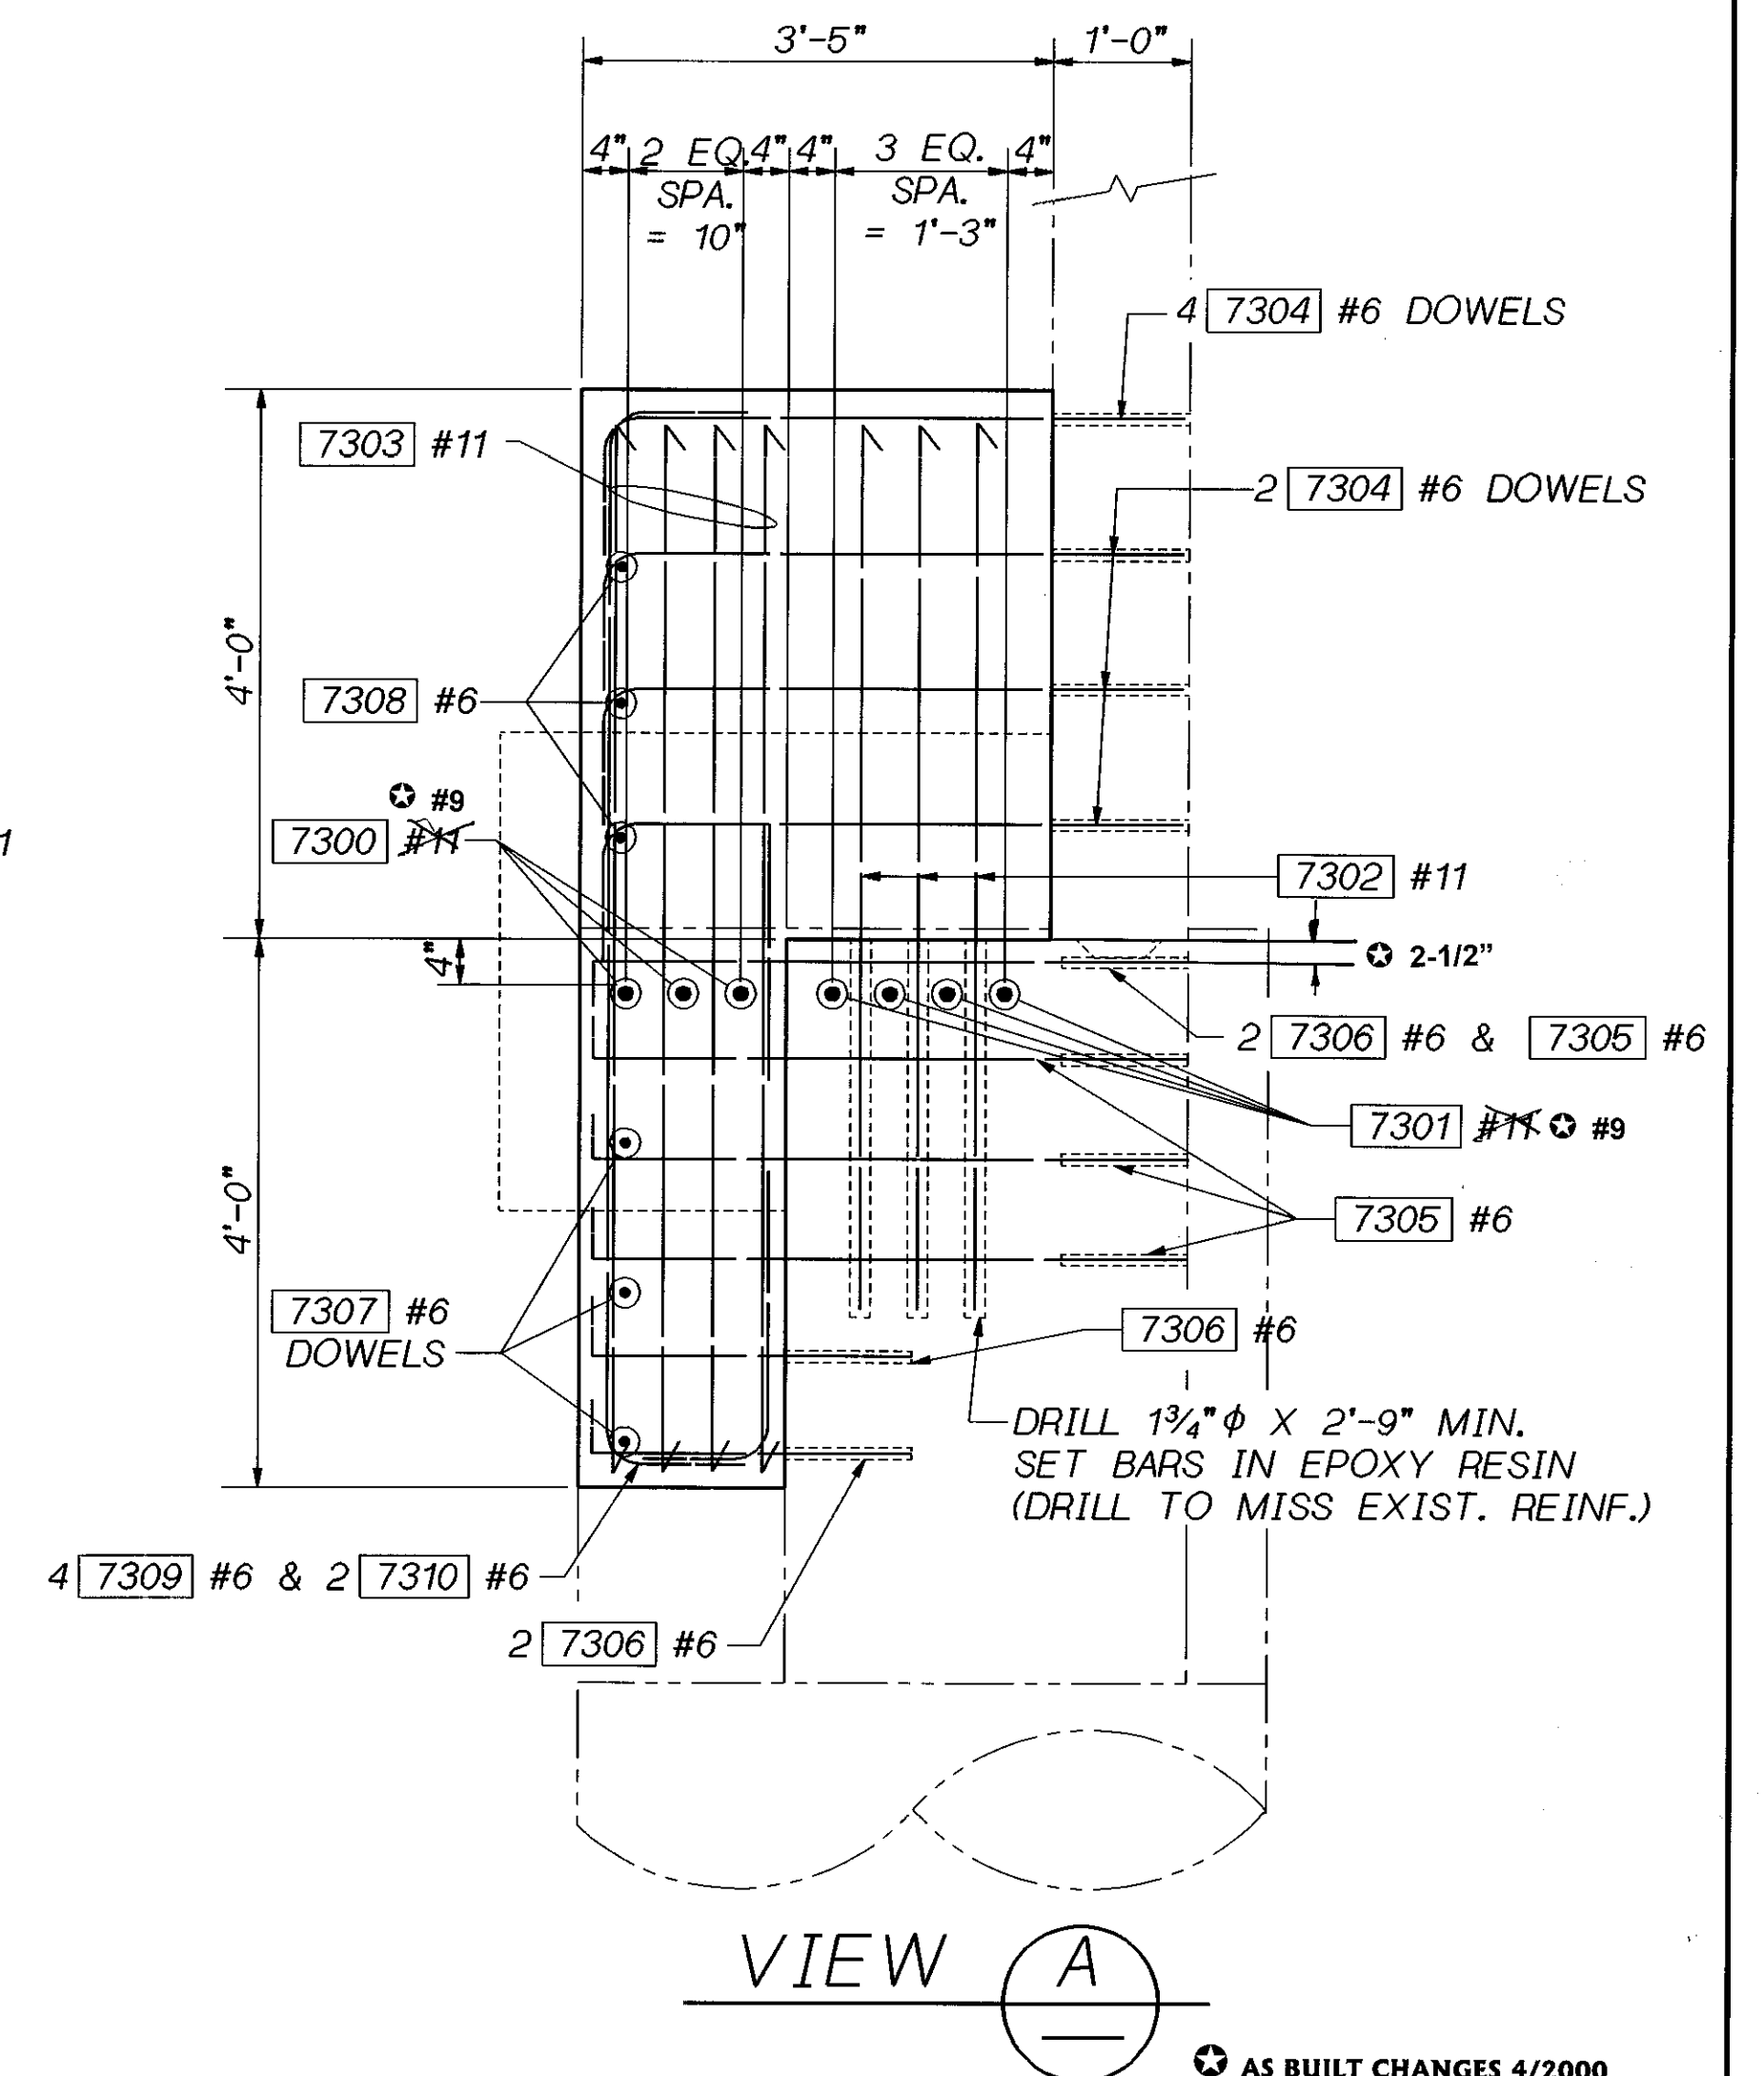

VIEW A

SR 405 JOB NO. 7056 SHEET S41

Bridge Design Engr.	C. C. RUTH	REGION NO.		STATE	WASH.	FED. AID PROJ. NO.		SHEET NO.		TOTAL SHEETS	
Supervisor	J. A. VAN LUND	JOB NUMBER	96W020								
Designed By	M. SHEIKHIZADEH	DATE		REVISION		BY	APP'D				
Checked By	T.M. MOORE										
Detailed By	L. ANDREOTTI										
Bridge Projects Engr.											
Prelim. Plan By											
Architect/Specialist											

REGION NO.		STATE	WASH.	FED. AID PROJ. NO.		SHEET NO.		TOTAL SHEETS	
JOB NUMBER	96W020								
DATE	4/9/96								
REVISION									
BY									
APP'D									

BRIDGE AND STRUCTURES OFFICE

JOHN A. VAN LUND
PROFESSIONAL ENGINEER
EXPIRES 12/23/97

6/5/96
SUPERVISING
BRIDGE
ENGINEER

CHARLES C. RUTH
PROFESSIONAL ENGINEER
EXPIRES 5/3/98

6.5.96
BRIDGE
DESIGN
ENGINEER

Washington State
Department of
Transportation

SR 405
WOODINVILLE INTERCHANGE
HOV WIDENING
SEISMIC RETROFIT

NW & NE RAMP
PIER 1 RETROFIT

BRIDGE SHEET NO. S41
SHEET 451 OF 452 SHEETS

AS BUILT CHANGES 4/2000

31-MAY-96

405_70WR001-[000000.FGB.RETRO.FGB]NW_NE_1_SHAFT.FGB;1